


DEPARTMENT OF PUBLIC WORKS
DIVISION OF ENGINEERING

CITY & COUNTY OF HONOLULU


JOB NO. 42-75

PART II - KAHEKILI HIGHWAY SHOULDER IMPROVEMENTS

FROM LIKELIKE HIGHWAY TO KEAAHALA ROAD
AND FROM HAIKU ROAD TO HUI IWA ROAD

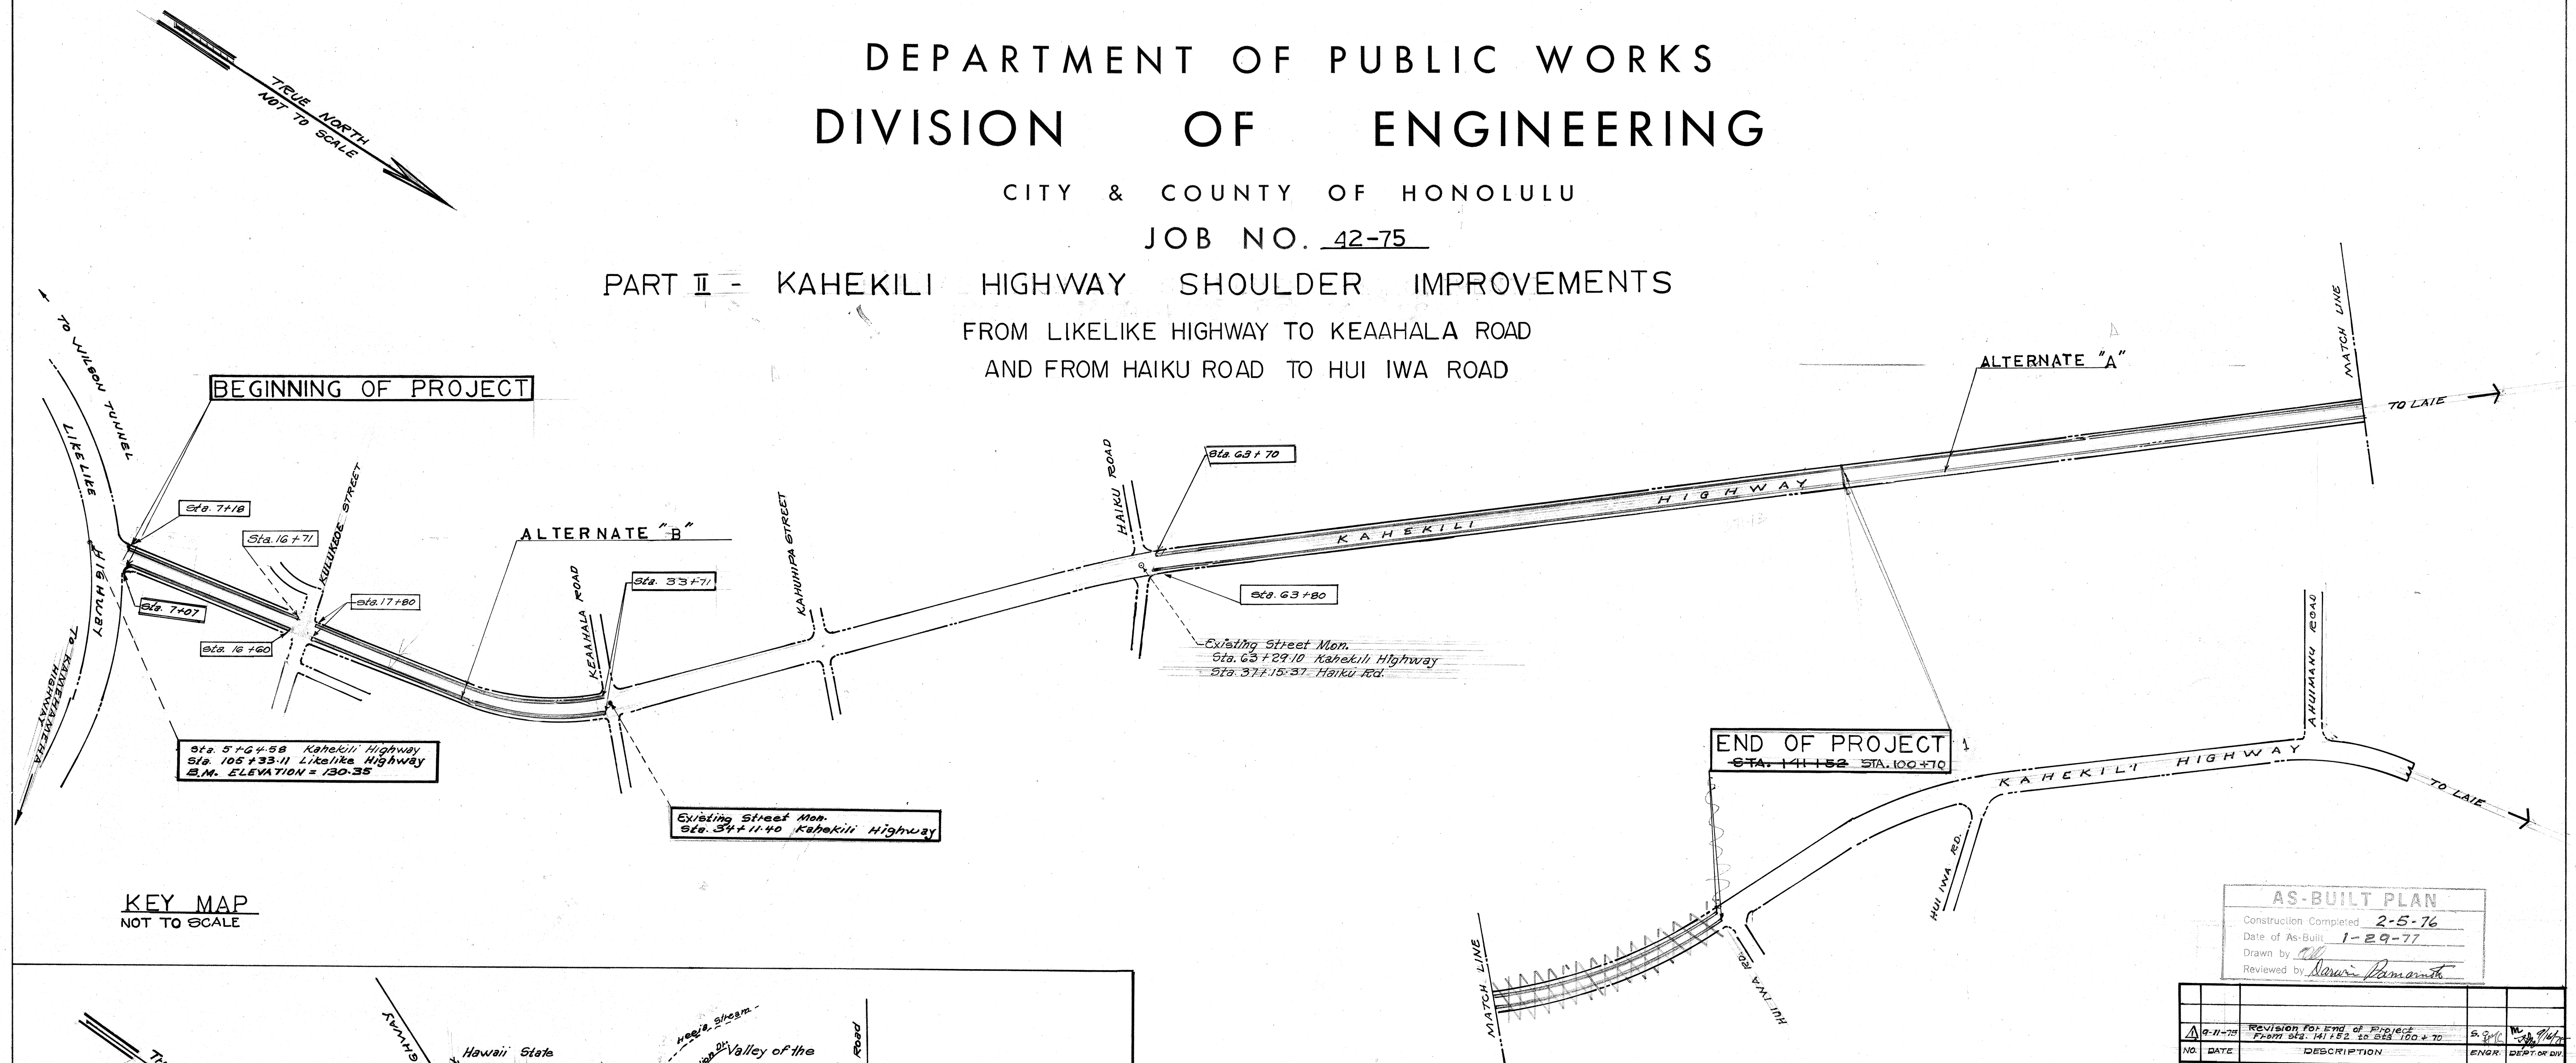

KEY MAP
NOT TO SCALE

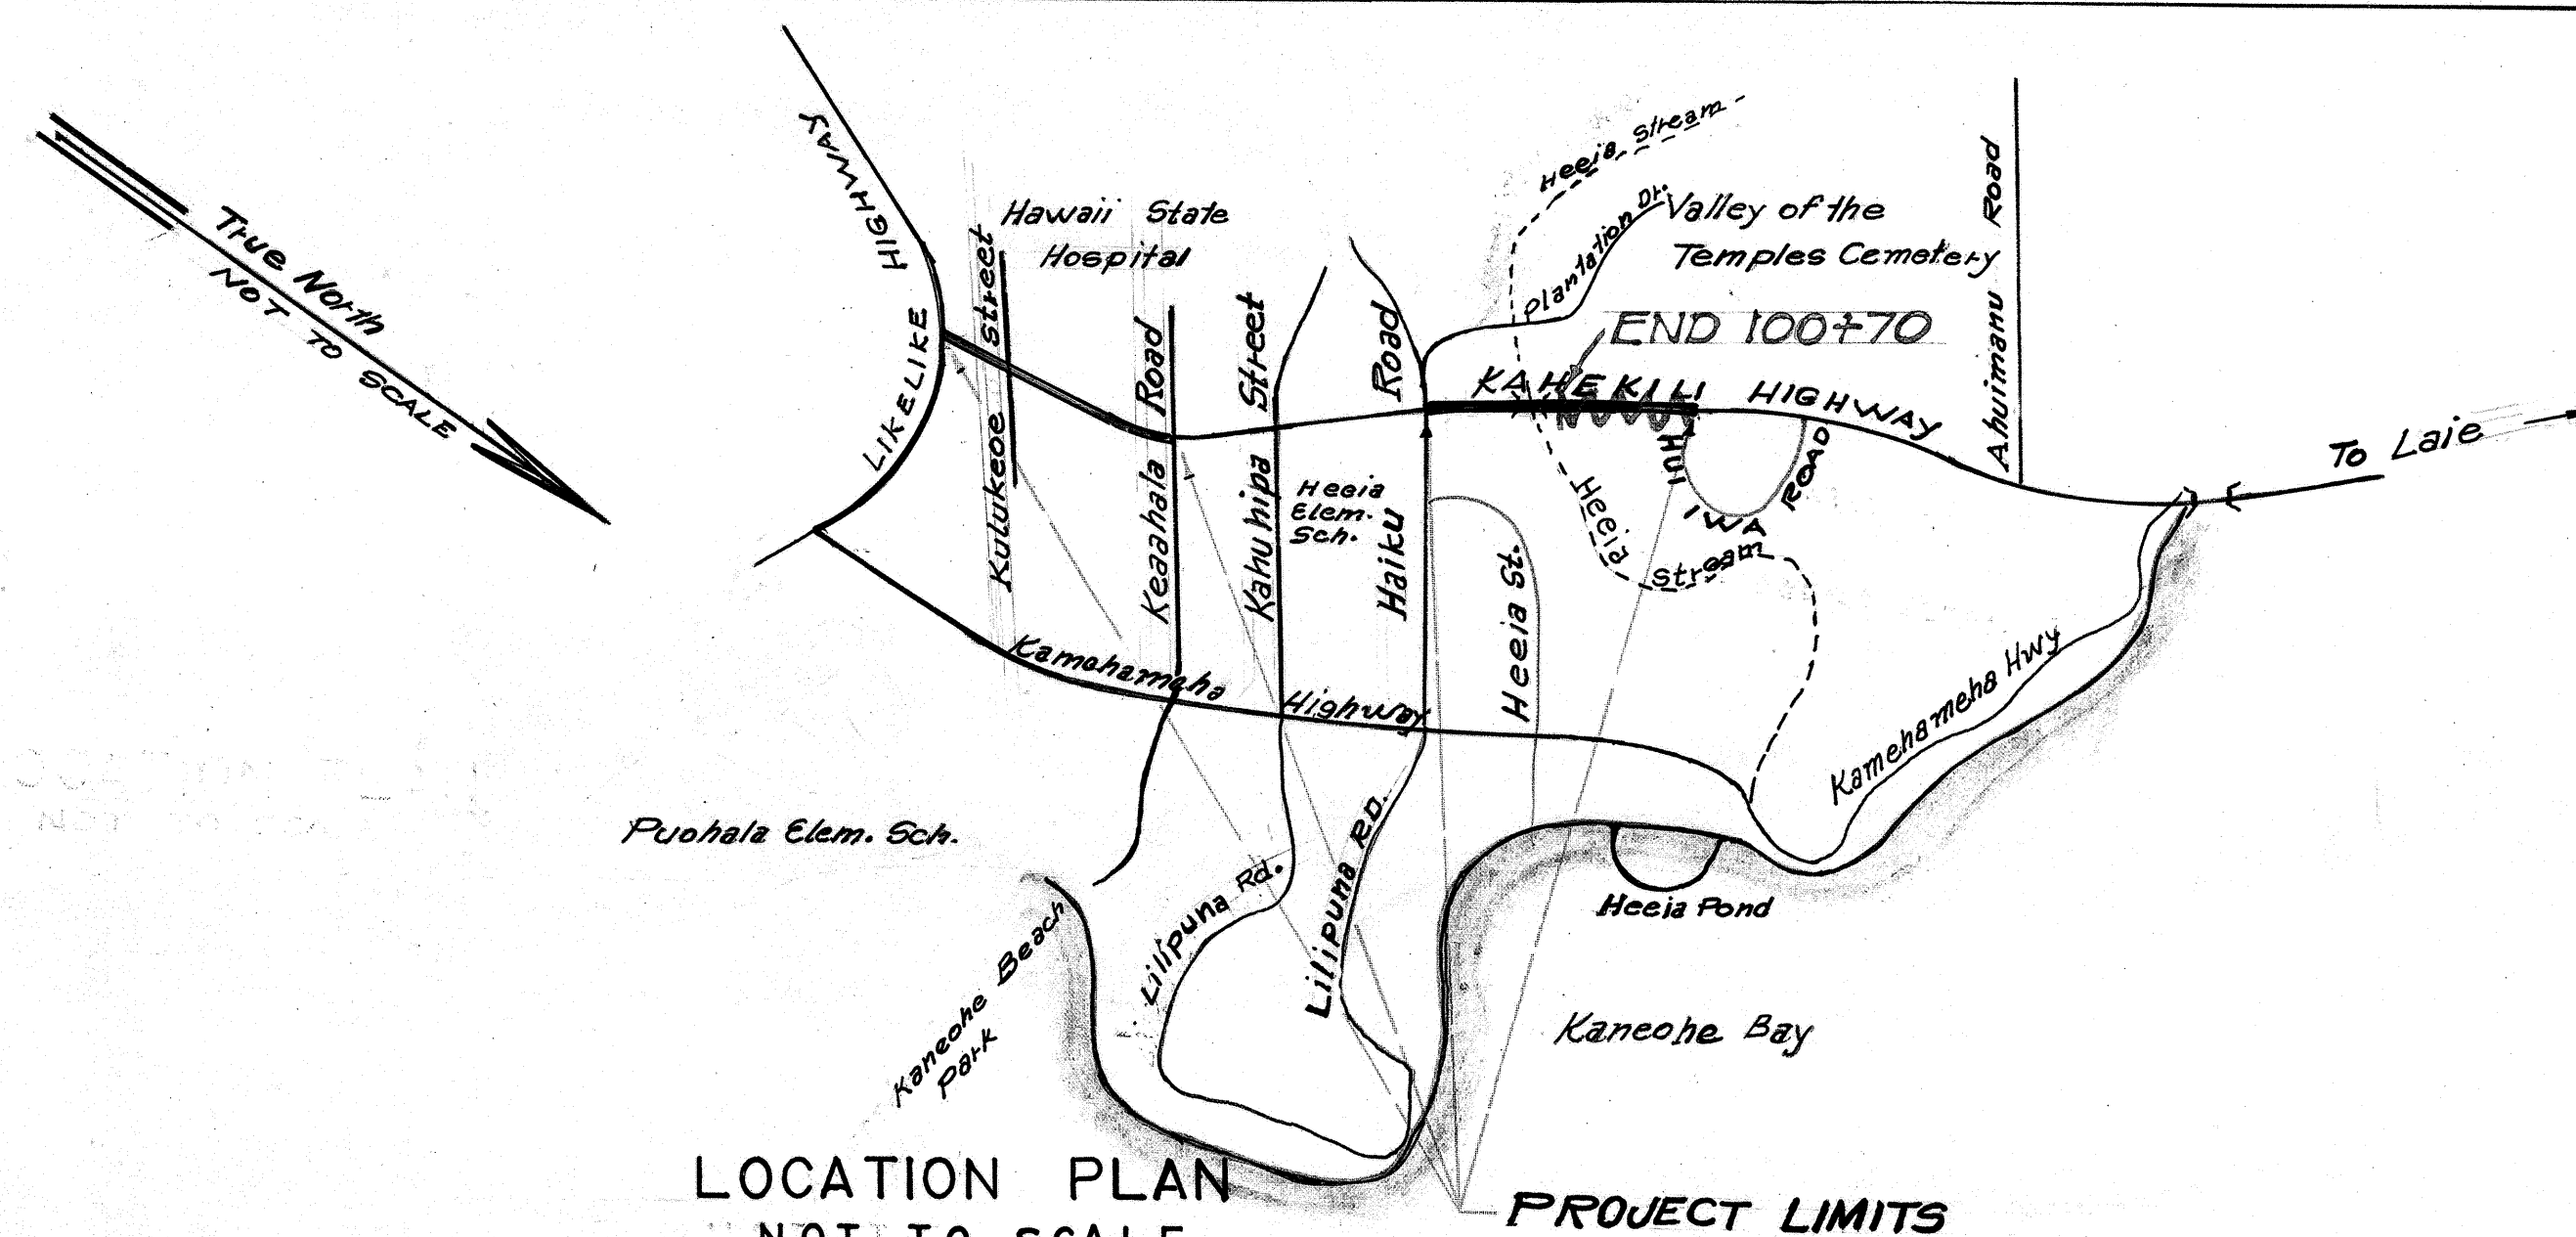

GENERAL NOTES:

1. All Construction shall be done in accordance with the Standard Specifications for Public Works Construction, November, 1968, and Standard Details of February, 1973 of the Dept. of Public Works, City and County of Honolulu.
2. The Contractor at his own expense, shall keep the project area and surrounding area free from dust nuisance. The work shall be in conformance with the air pollution control standards and regulations of the State Department of Health.
3. The Contractor shall remove all silt and debris resulting from his work and deposited in drainage facilities, roadways and other areas. The costs incurred for any necessary remedial action by the Chief Engineer shall be payable by the Contractor.

APPROVED:

Wallace Miyahara
FOR DIRECTOR AND CHIEF ENGINEER
DEPARTMENT OF PUBLIC WORKS
CITY AND COUNTY OF HONOLULU

6/10/75
DATE

AS BUILT

AS-BUILT PLAN			
Construction Completed		2-5-76	
Date of As-Built		1-29-77	
Drawn by		[Signature]	
Reviewed by		[Signature]	
NO.	DATE	DESCRIPTION	ENGR.
1	9-11-75	Revision for End of Project from Sta. 141+52 to Sta. 100+70	[Signature]
REVISIONS			APPROV.