


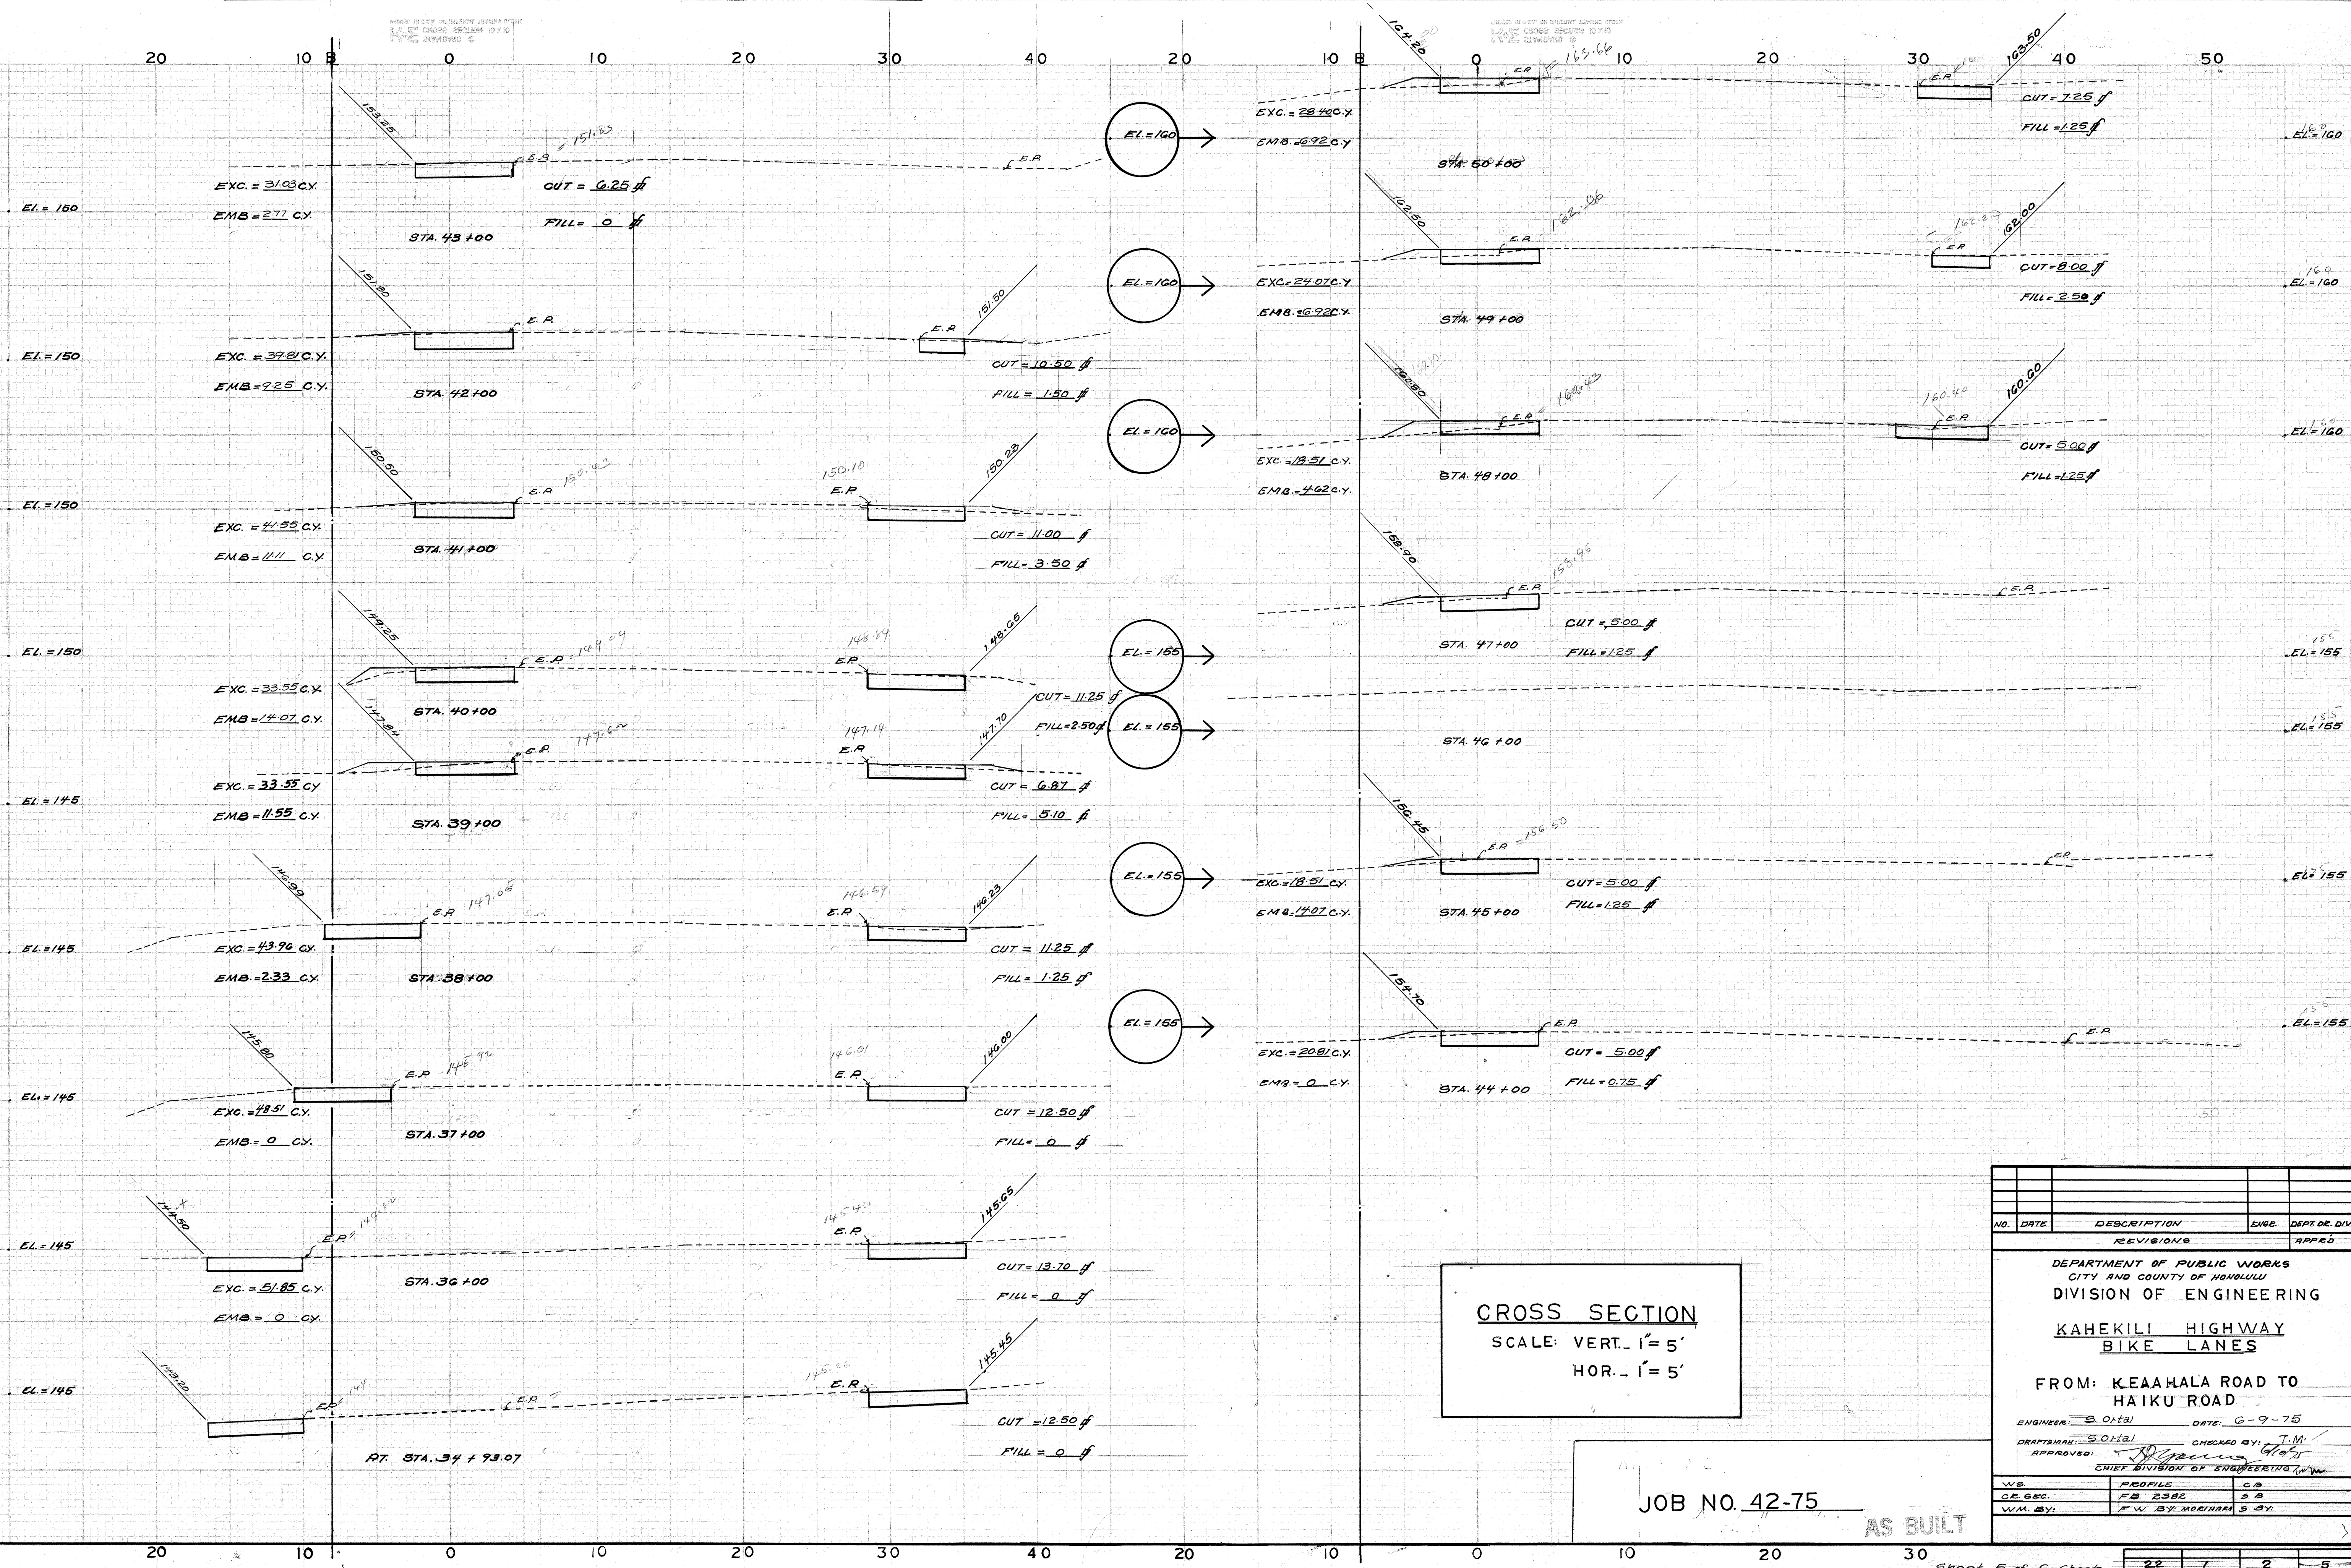


CROSS SECTION
 SCALE: VERT. 1" = 5'
 HOR. 1" = 5'

JOB NO. 42-75
 AS BUILT

NO.	DATE	DESCRIPTION	ENG.	DEPT. OR DIV.
		REVISIONS		APPROVED
DEPARTMENT OF PUBLIC WORKS CITY AND COUNTY OF HONOLULU DIVISION OF ENGINEERING <u>KAHEKILI HIGHWAY</u> <u>BIKE LANES</u> FROM: KEAAHALA ROAD TO HAIKU ROAD				
ENGINEER:	S. Ota	DATE:	G-9-75	
DRAFTSMAN:	S. Ota	CHECKED BY:	T.M.	
APPROVED:	<i>Spencer</i>		DATE:	6-10-75
CHIEF DIVISION OF ENGINEERING				
W.B.	PROFILE	C.B.		
C.E. SEC.	F.B. 2382	S.B.		
W.M. BY:	F.W. BY: MOE/NRM	S. BY:		

22	1	2	3
----	---	---	---

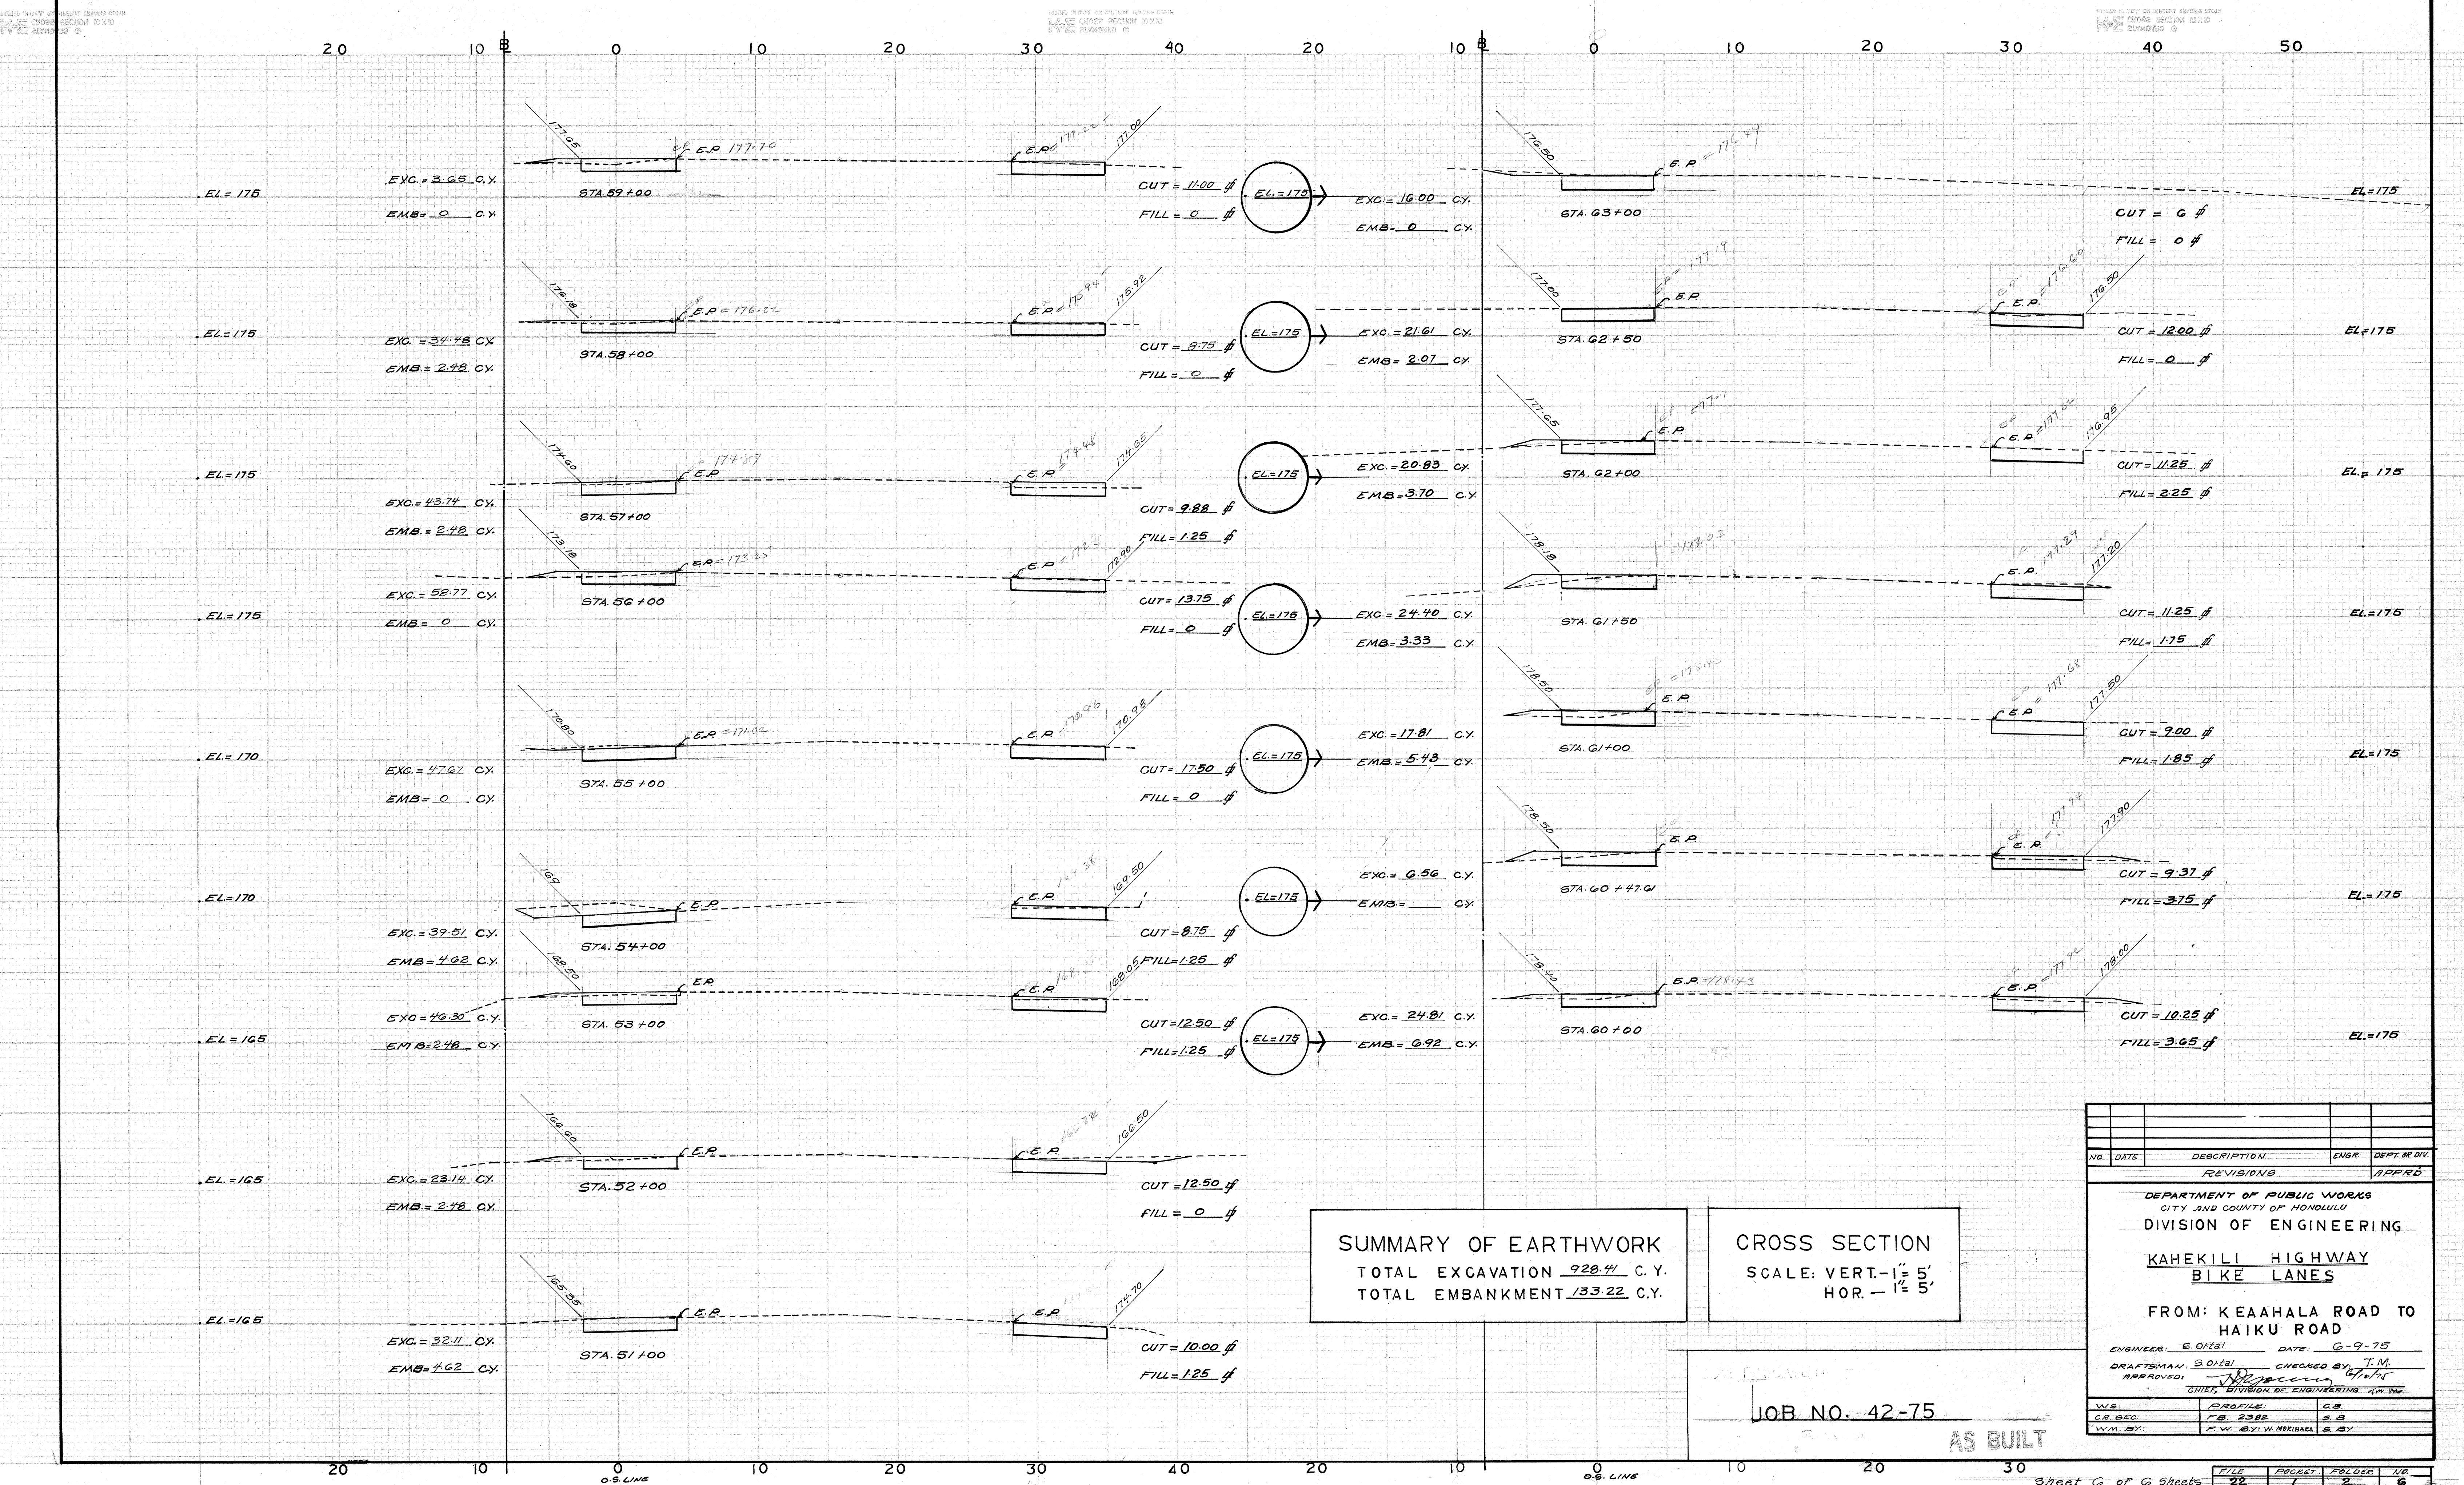

NO.	DATE	DESCRIPTION	ENGR.	DEPT. DIV.
		REVISIONS		APPROD
DEPARTMENT OF PUBLIC WORKS CITY AND COUNTY OF HONOLULU DIVISION OF ENGINEERING KAHEKILI HIGHWAY BIKE LANES FROM: KEAAHALA ROAD TO HAIKU ROAD ENGINEER: S. Ohtani DATE: 6-9-75 DRAFTSMAN: S. Ohtani CHECKED BY: T.M. APPROVED: [Signature] 6/1/75 CHIEF, DIVISION OF ENGINEERING (A-100) W.B. [Signature] C.B. [Signature] C.B. [Signature] F.B. [Signature] W.M. [Signature] F.W. [Signature]				

Sheet 6 of 6 Sheets

FILE	PROJECT	FOLDER	NO.
22	1	2	6