


DEPARTMENT OF PUBLIC WORKS
DIVISION OF ENGINEERING

CITY & COUNTY OF HONOLULU

JOB NO. 42-75

PART I - KAHEKILI HIGHWAY BIKE LANES
FROM KEAAHALA ROAD TO
HAIKU ROAD
Kaneohe, OAHU, HAWAII

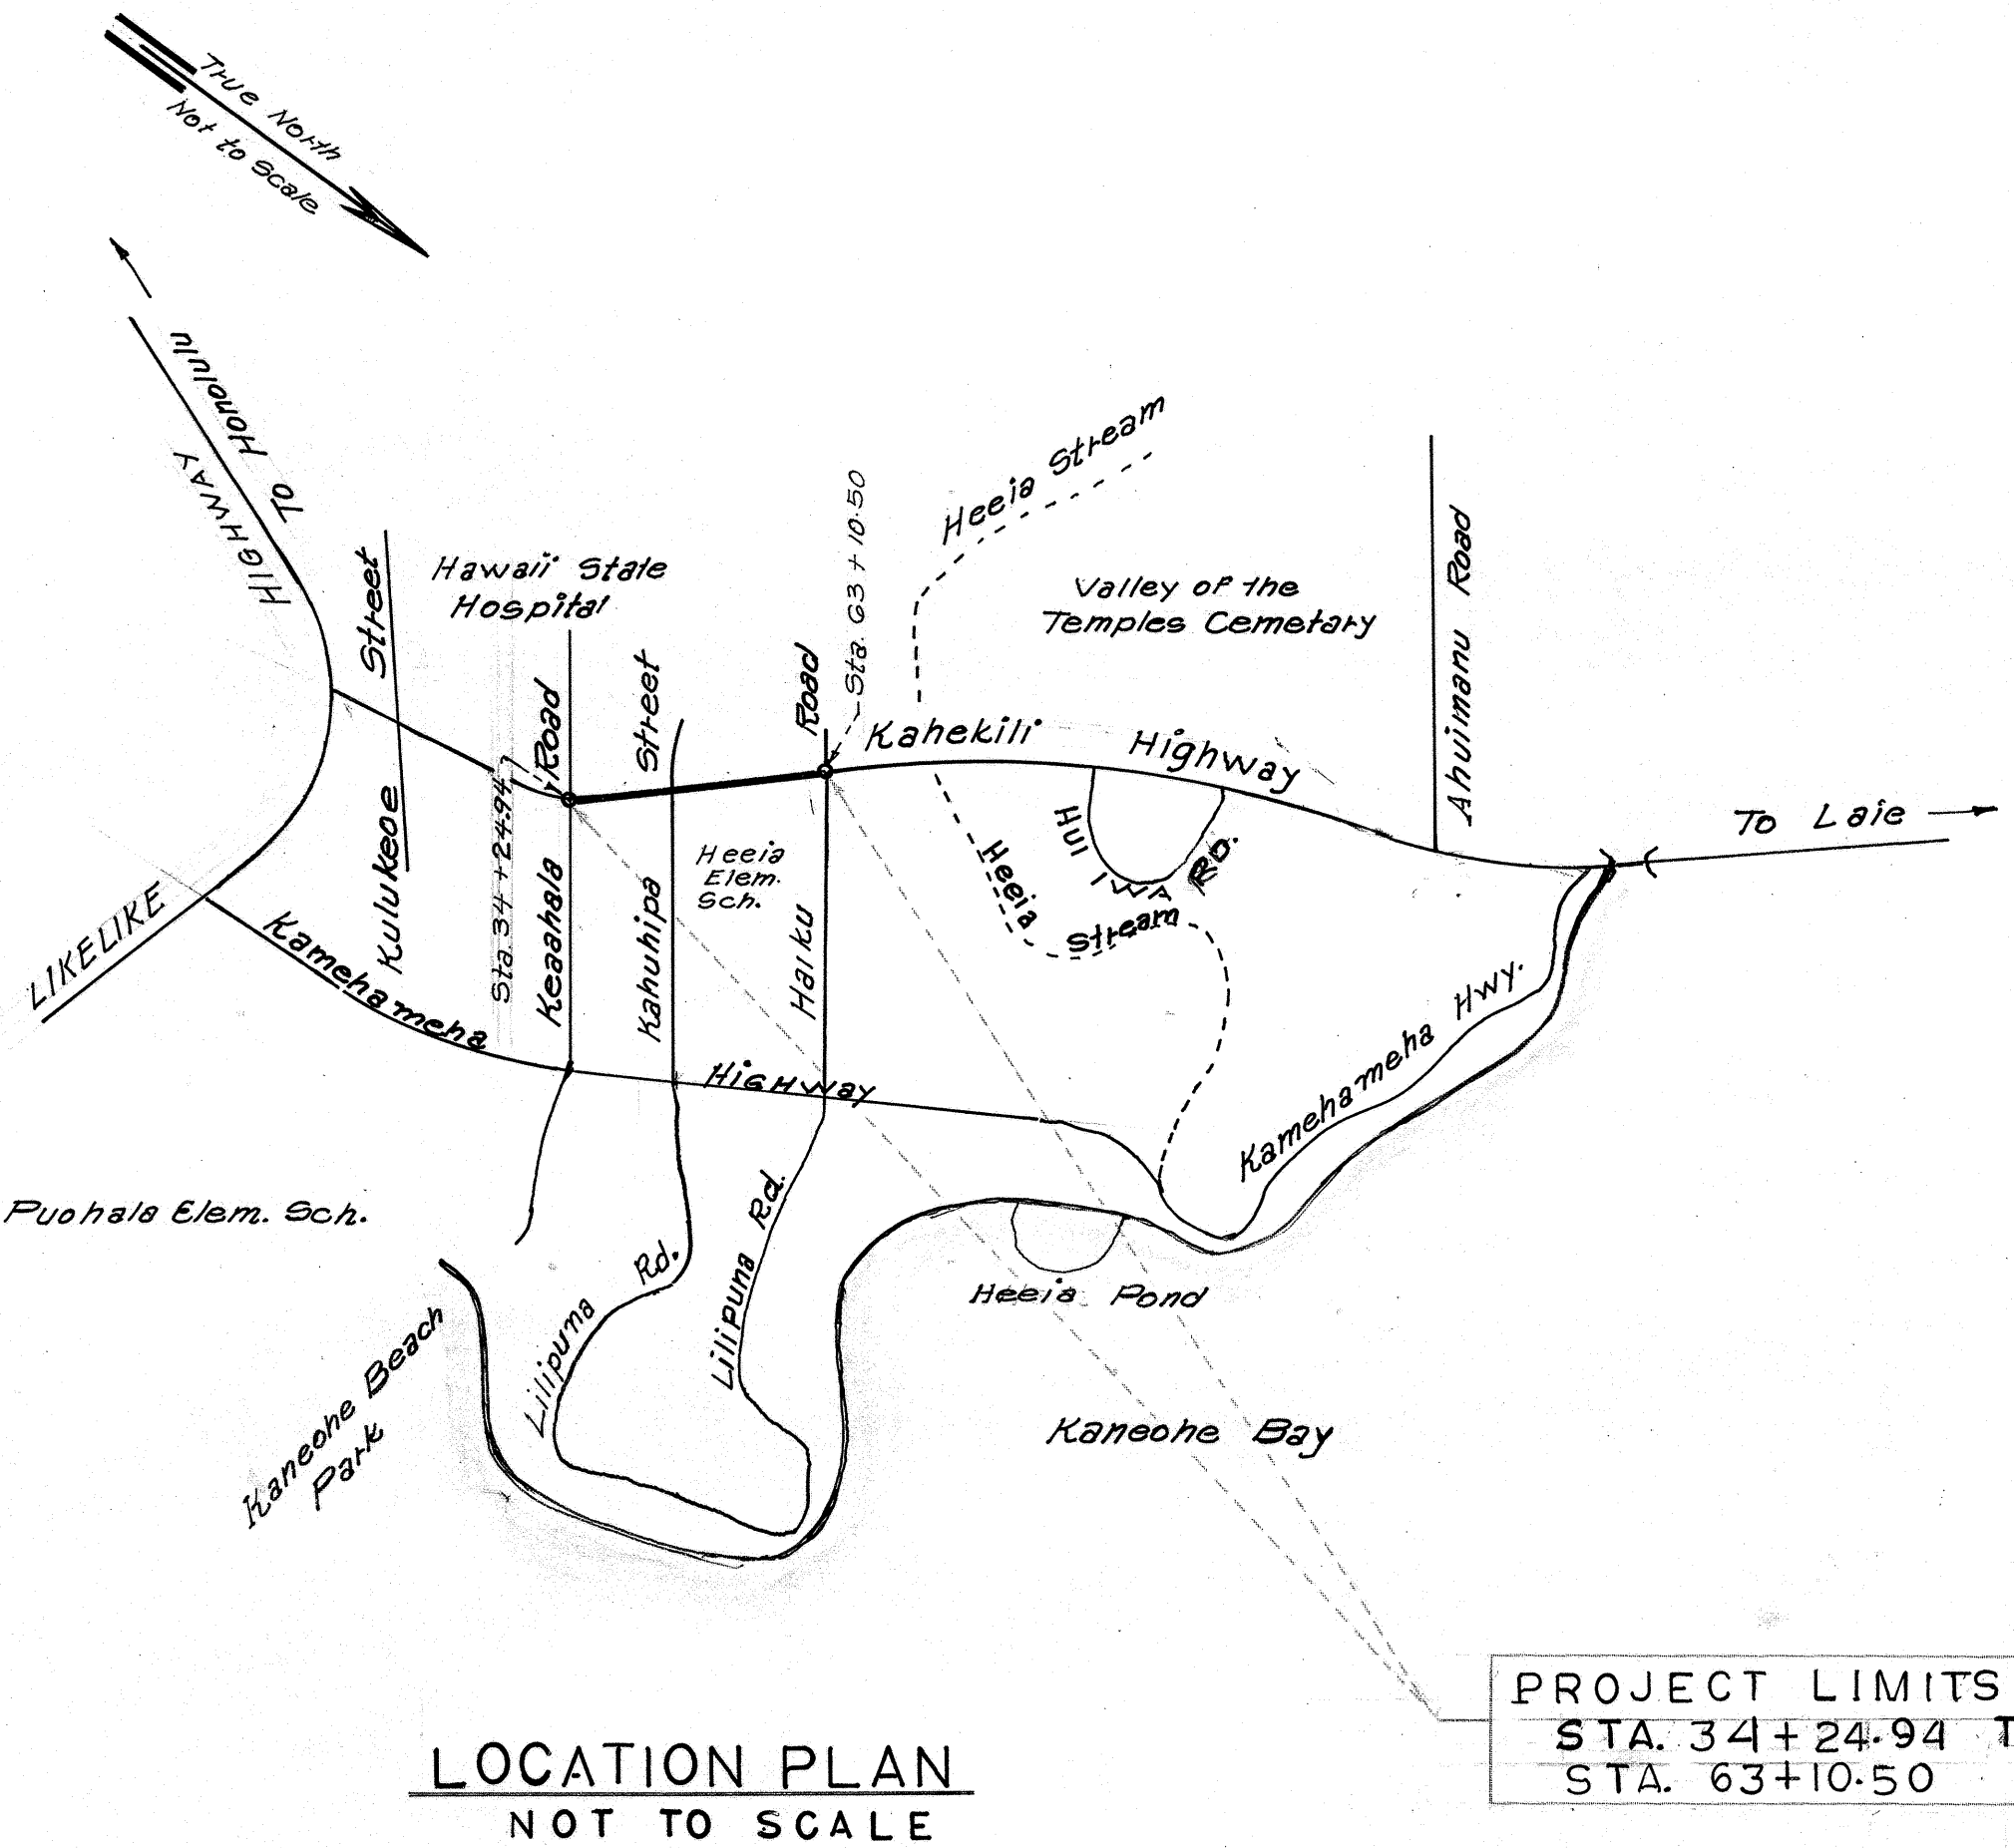

INDEX

DESCRIPTION	SHEET NO.
TITLE SHEET	1
PLAN AND PROFILE	2-4
CROSS SECTION	5-6

GENERAL NOTES:

1. All Construction shall be done in accordance with the Standard Specifications for Public Works Construction, November 1968, and Standard Details of February 1973 of the Dept. of Public Works City and County of Honolulu.
2. The Contractor at his own expense shall keep the project area and surrounding area free from dust nuisance. The work shall be in conformance with the air pollution control standards and regulations of the State Department of Health.
3. The Contractor shall remove all silt and debris resulting from his work and deposited in drainage, facilities, roadways, and other areas. The costs incurred for any necessary remedial action by the Chief Engineer shall be payable by the Contractor.
4. Construction debris and wastes shall be deposited at an appropriate site. The Contractor shall inform the Engineer of the location of disposal sites. The disposal site must also fulfill the requirements of the grading ordinance.

APPROVED:

DATE

Wallace Miyachina
FOR DIRECTOR, AND CHIEF ENGINEER
DEPT. OF PUBLIC WORKS

6/10/75

Roy Park
DEP. DIRECTOR, DEPT. OF
TRANSPORTATION SERVICES

6/10/75

L. G. Rathburn
Acting MANAGER AND CHIEF ENGINEER
BOARD OF WATER SUPPLY

6-10-75

AS BUILT