
(2	
INDEX TO DRAWINGS	
SHEET NO.	DESCRIPTION
	TITLE SHEET
* 2 - 5	FOOTBRIDGE DETAILS
 € C.O.3 S-1	SUPPLEMENTARY SHEET FOR FOOTBRIDGE DETAILS
-	
	,
Y (*)	



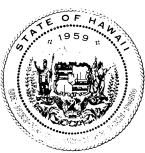


HAWAII

TRANSPORTATION DEPARTMENT OF -DIVISION HIGHWAYS

HONOLULU, HAWAII "AS BUILT' PLANS FOR CONSTRUCTION OF


KAMEHAMEHA HIGHWAY IMPROVEMENTS AT KAHALUU FOOTBRIDGES AT KAALAEA AND AUWAI PROJECT NO. 83E-01-73 (PHASE II)

KOOLAUPOKO DISTRICT OF ISLAND OF OAHU

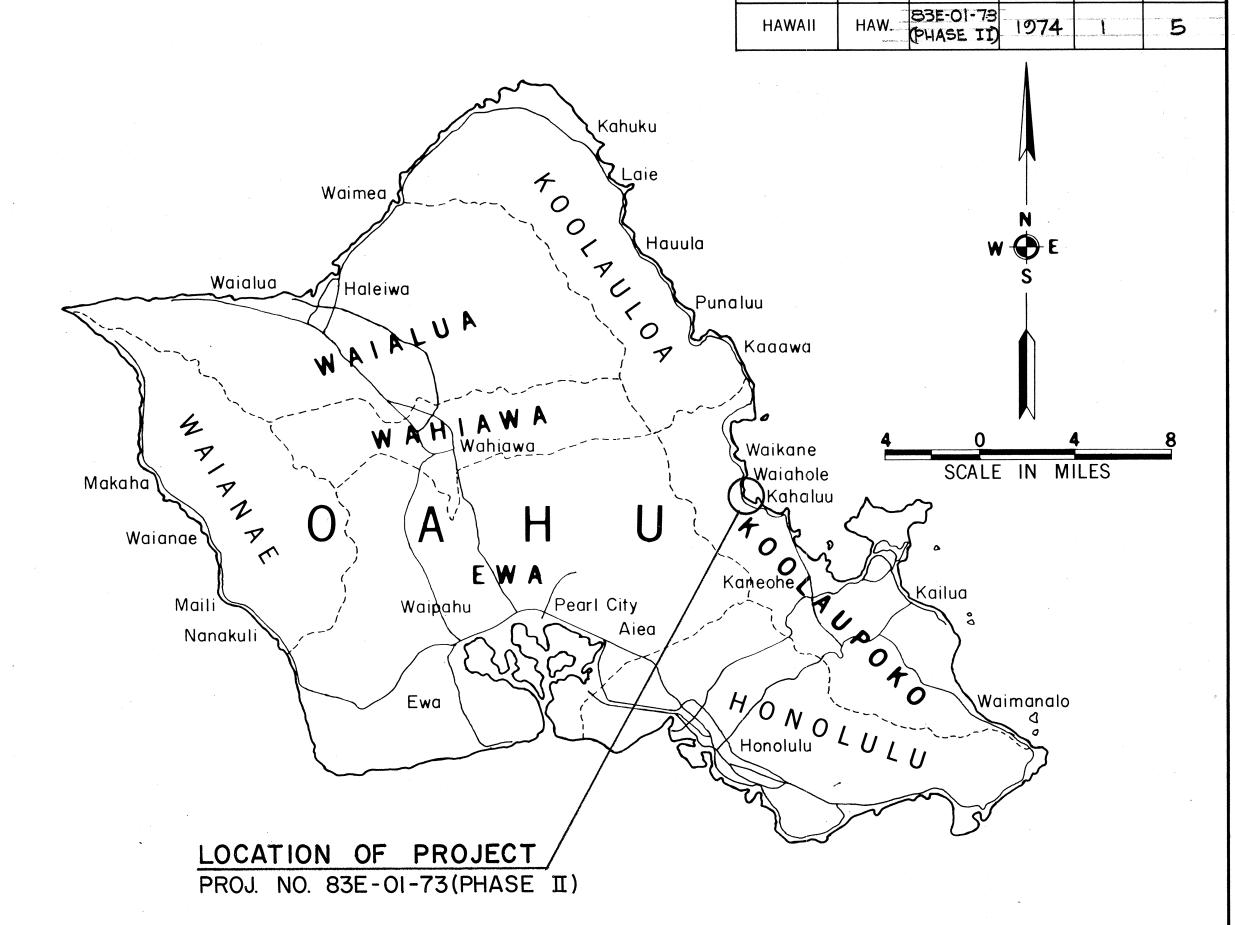

FED. ROAD DIST. NO.

STATE PROJ. NO. FISCAL SHEET YEAR NO.

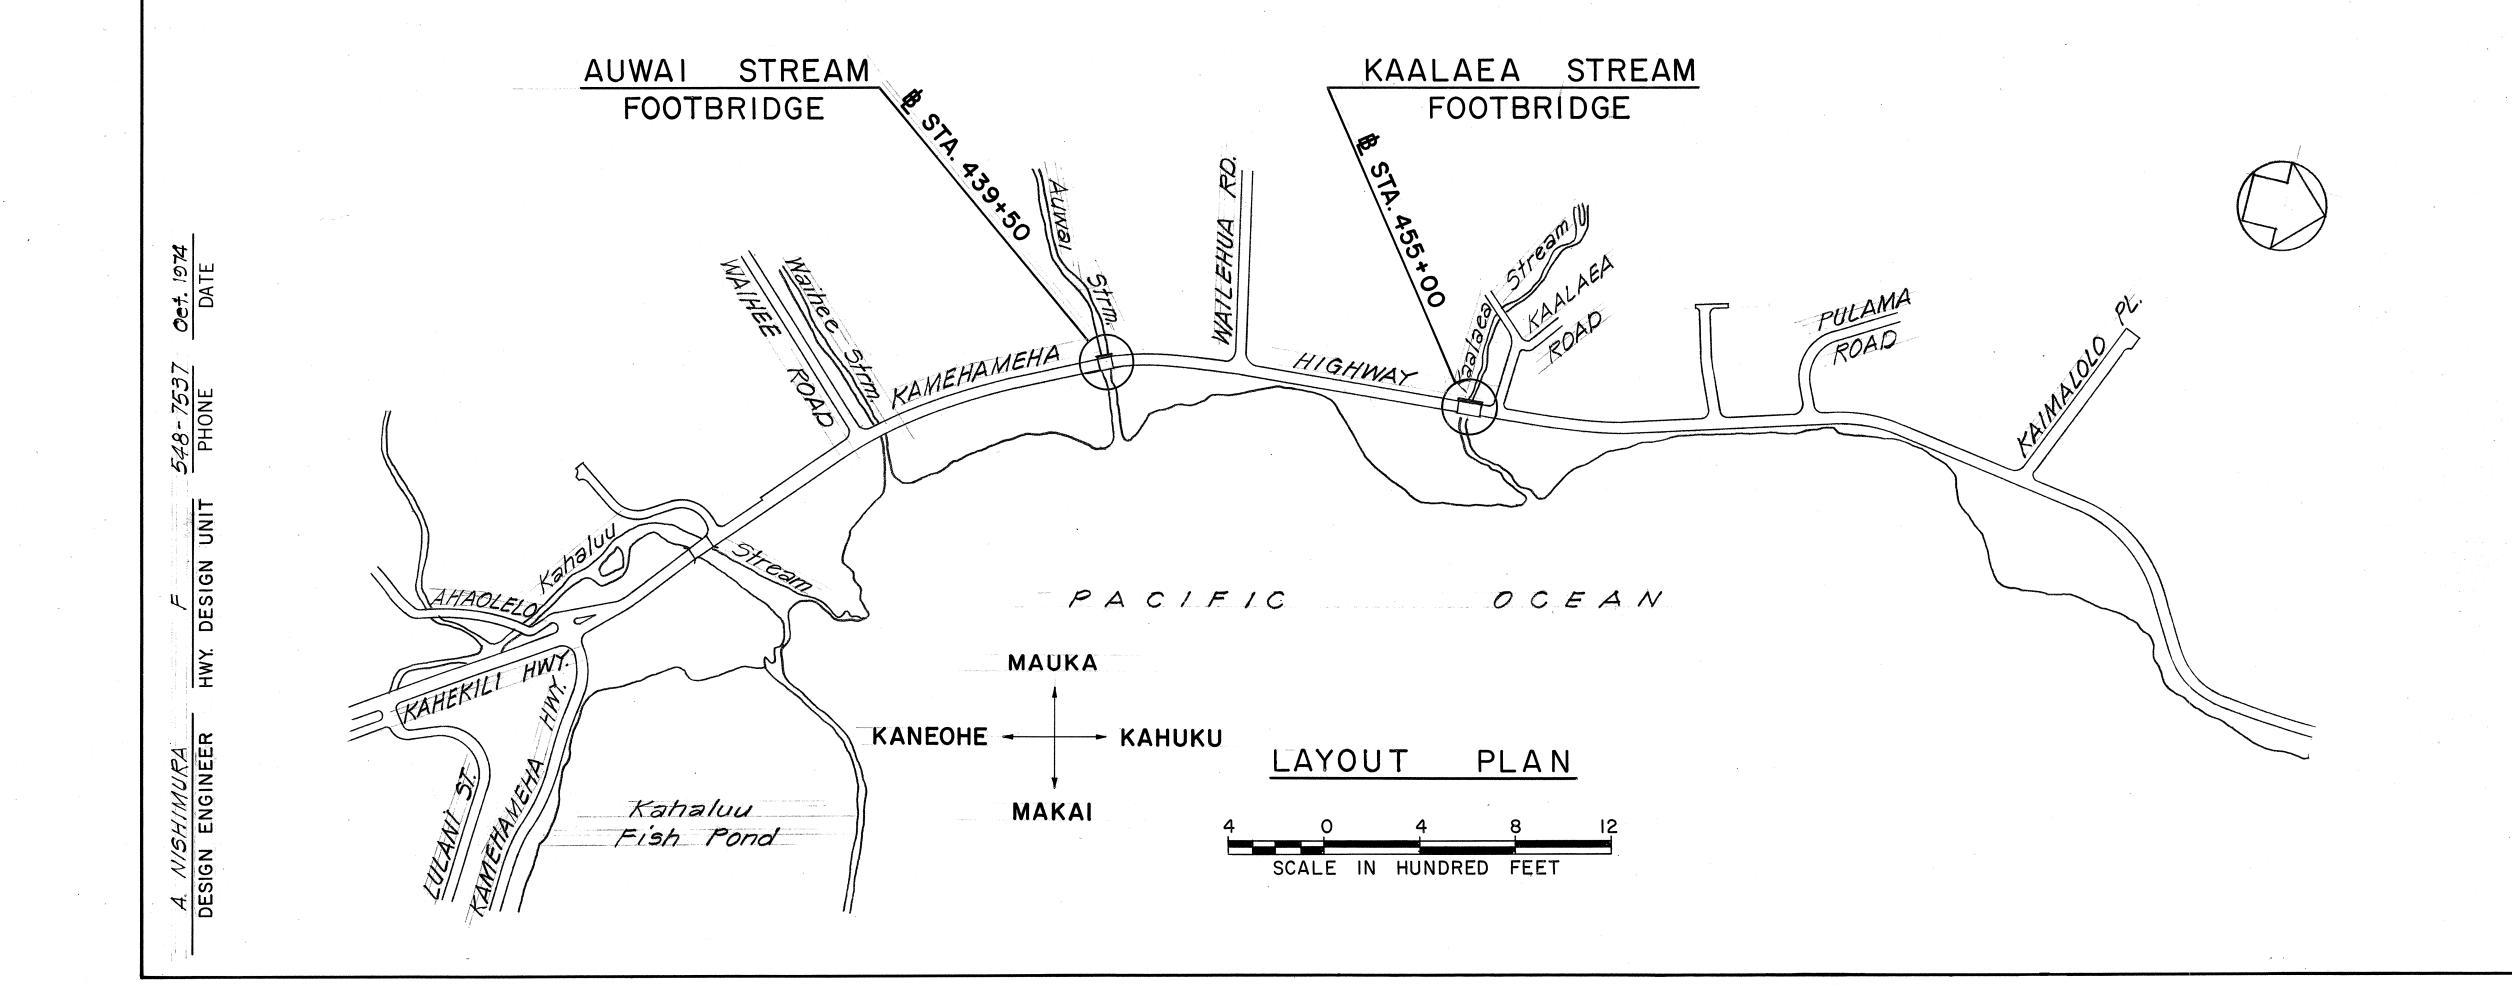

NOTE:

ALL CHANGES MADE DURING CONSTRUCTION HAVE BEEN INCORPORATED ON THESE PLANS IN RED EXCEPT CHANGES IN THE ORIGINAL THEORETICAL QUANTITIES.

DEPARTMENT OF TRANSPORTATION STATE OF HAWAII APPROVED:

FOR DIR. OF TRANSPORTATION