


[illegible]

FED. ROAD DIST. NO.	STATE	PROJ. NO.	FISCAL YEAR	SHEET NO.	TOTAL SHEET
HAWAII	HAW.	83B-01-73 83D-01-73	1974	1	6

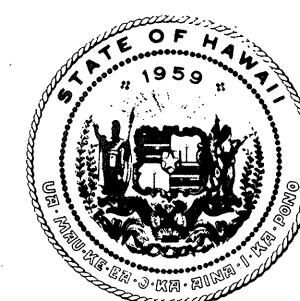

STATE OF HAWAII

DEPARTMENT OF TRANSPORTATION
HIGHWAYS DIVISION

HONOLULU, HAWAII


"AS - BUILT"

PLANS FOR INSTALLATION OF
STREETLIGHTS ON KAMEHAMEHA HIGHWAY
NEAR WAIMEA BAY

PROJECT NO. 83B-01-73

DISTRICTS OF
WAIALUA - KOOLAULOA
AND KOOLAUPOKO
ISLAND OF OAHU

SITE PLAN

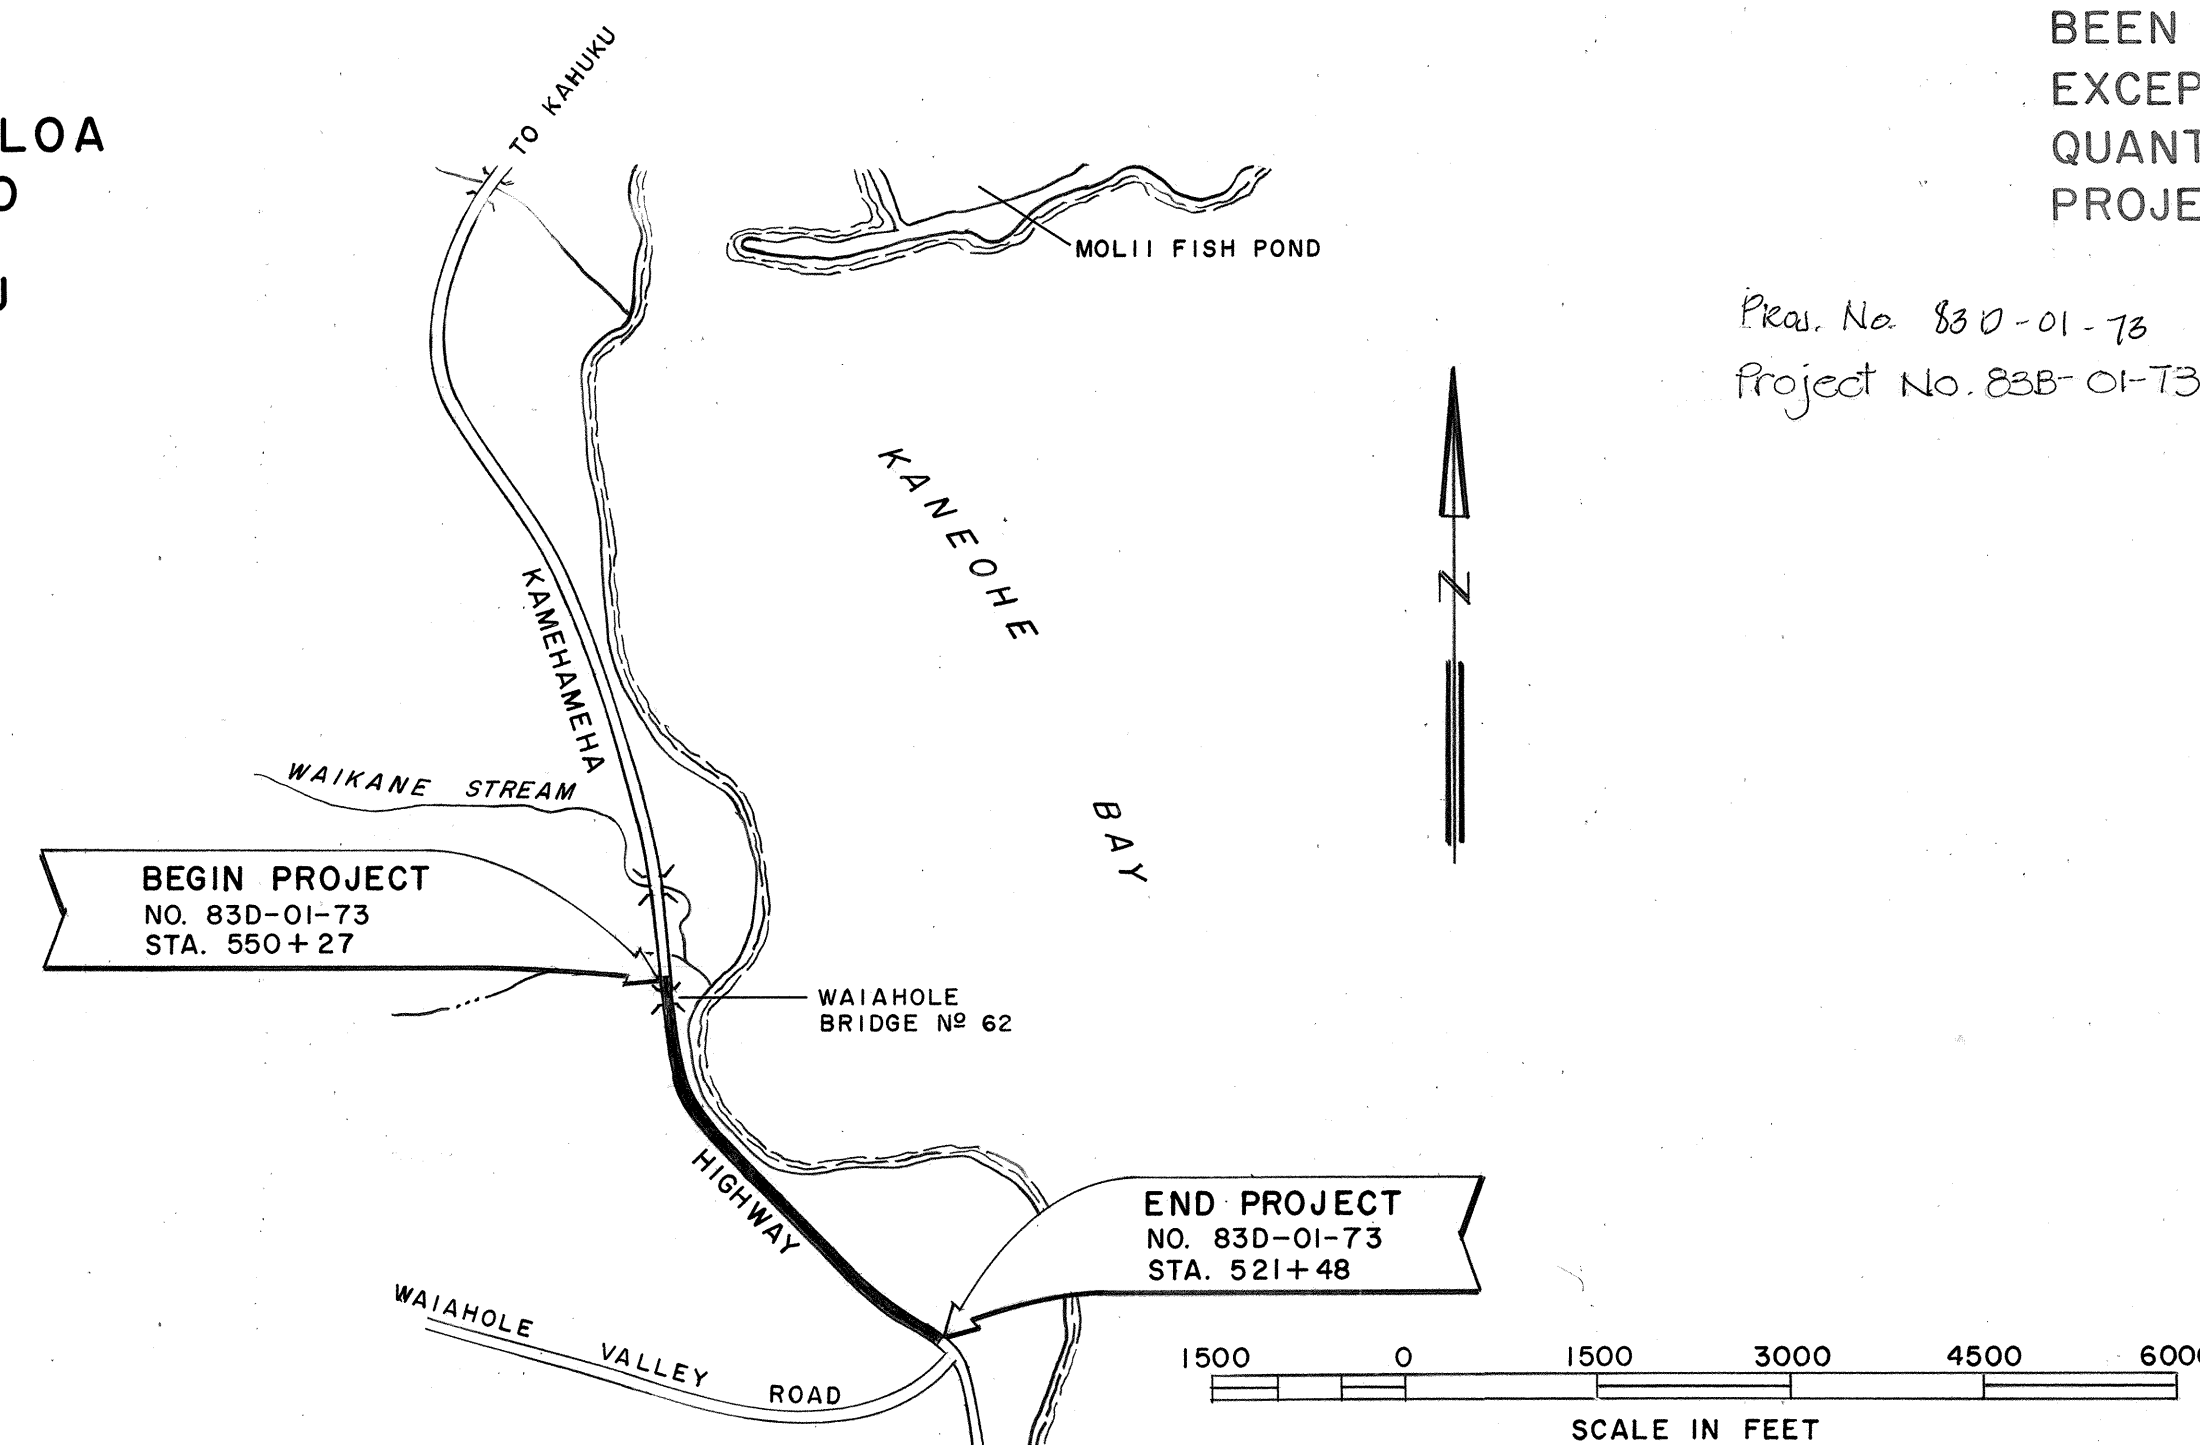

ALL CHANGES MADE DURING CONSTRUCTION HAVE
BEEN INCORPORATED ON THESE PLANS IN RED
EXCEPT CHANGES IN THE ORIGINAL THEORETICAL
QUANTITIES. FOR ACTUAL QUANTITIES, REFER TO
PROJECT LEDGER AND/OR COMPUTATION BOOK.

APPROVALS:

DEPARTMENT OF TRANSPORTATION
STATE OF HAWAII

THIS WORK WAS PREPARED BY M
OR UNDER MY SUPERVISION.