
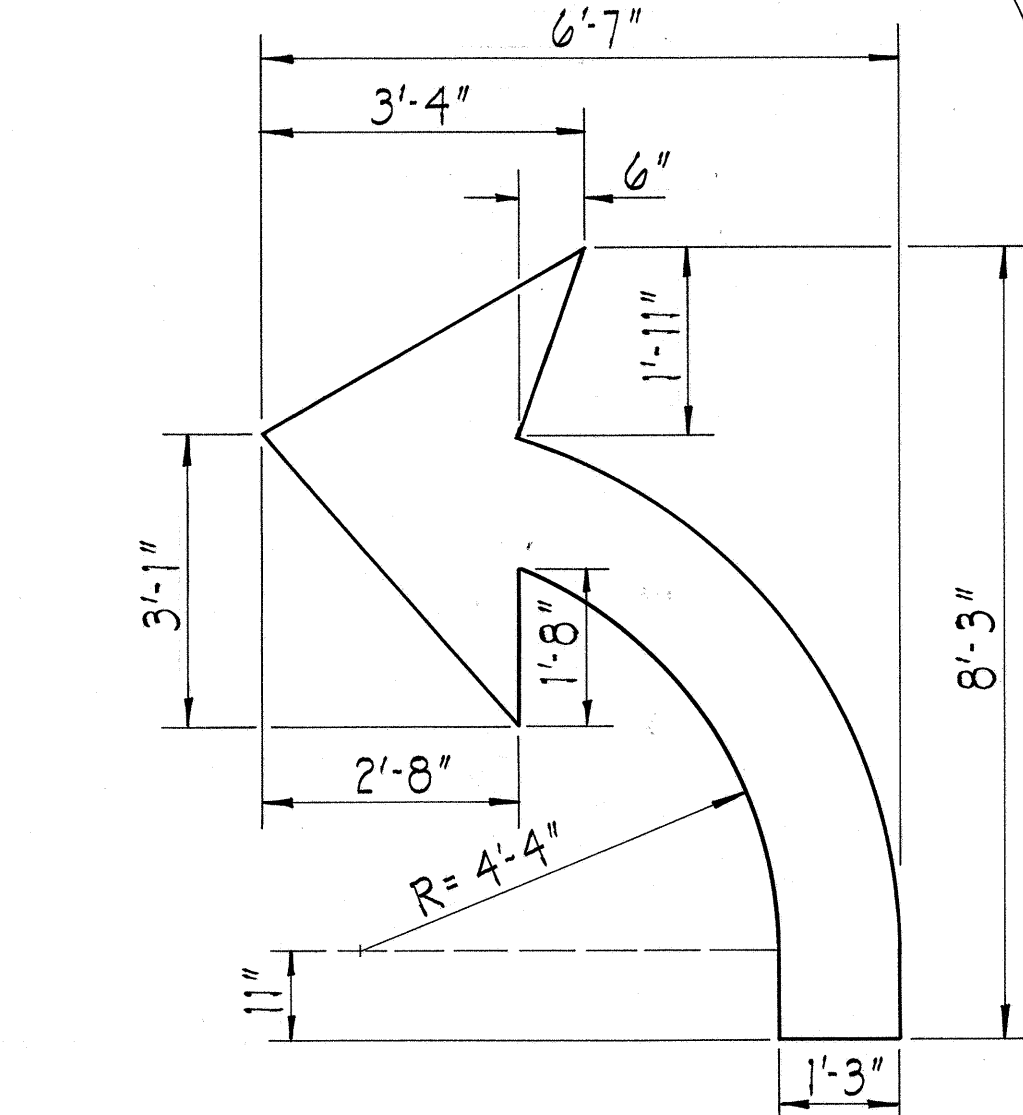



FED. ROAD DIST. NO.	STATE	PROJ. NO.	FISCAL YEAR	SHEET NO.	TOTAL SHEETS
HAWAII	HAW.	83F-02-75	1976	2	2

TRUE NORTH
Scale: 1" = 50'

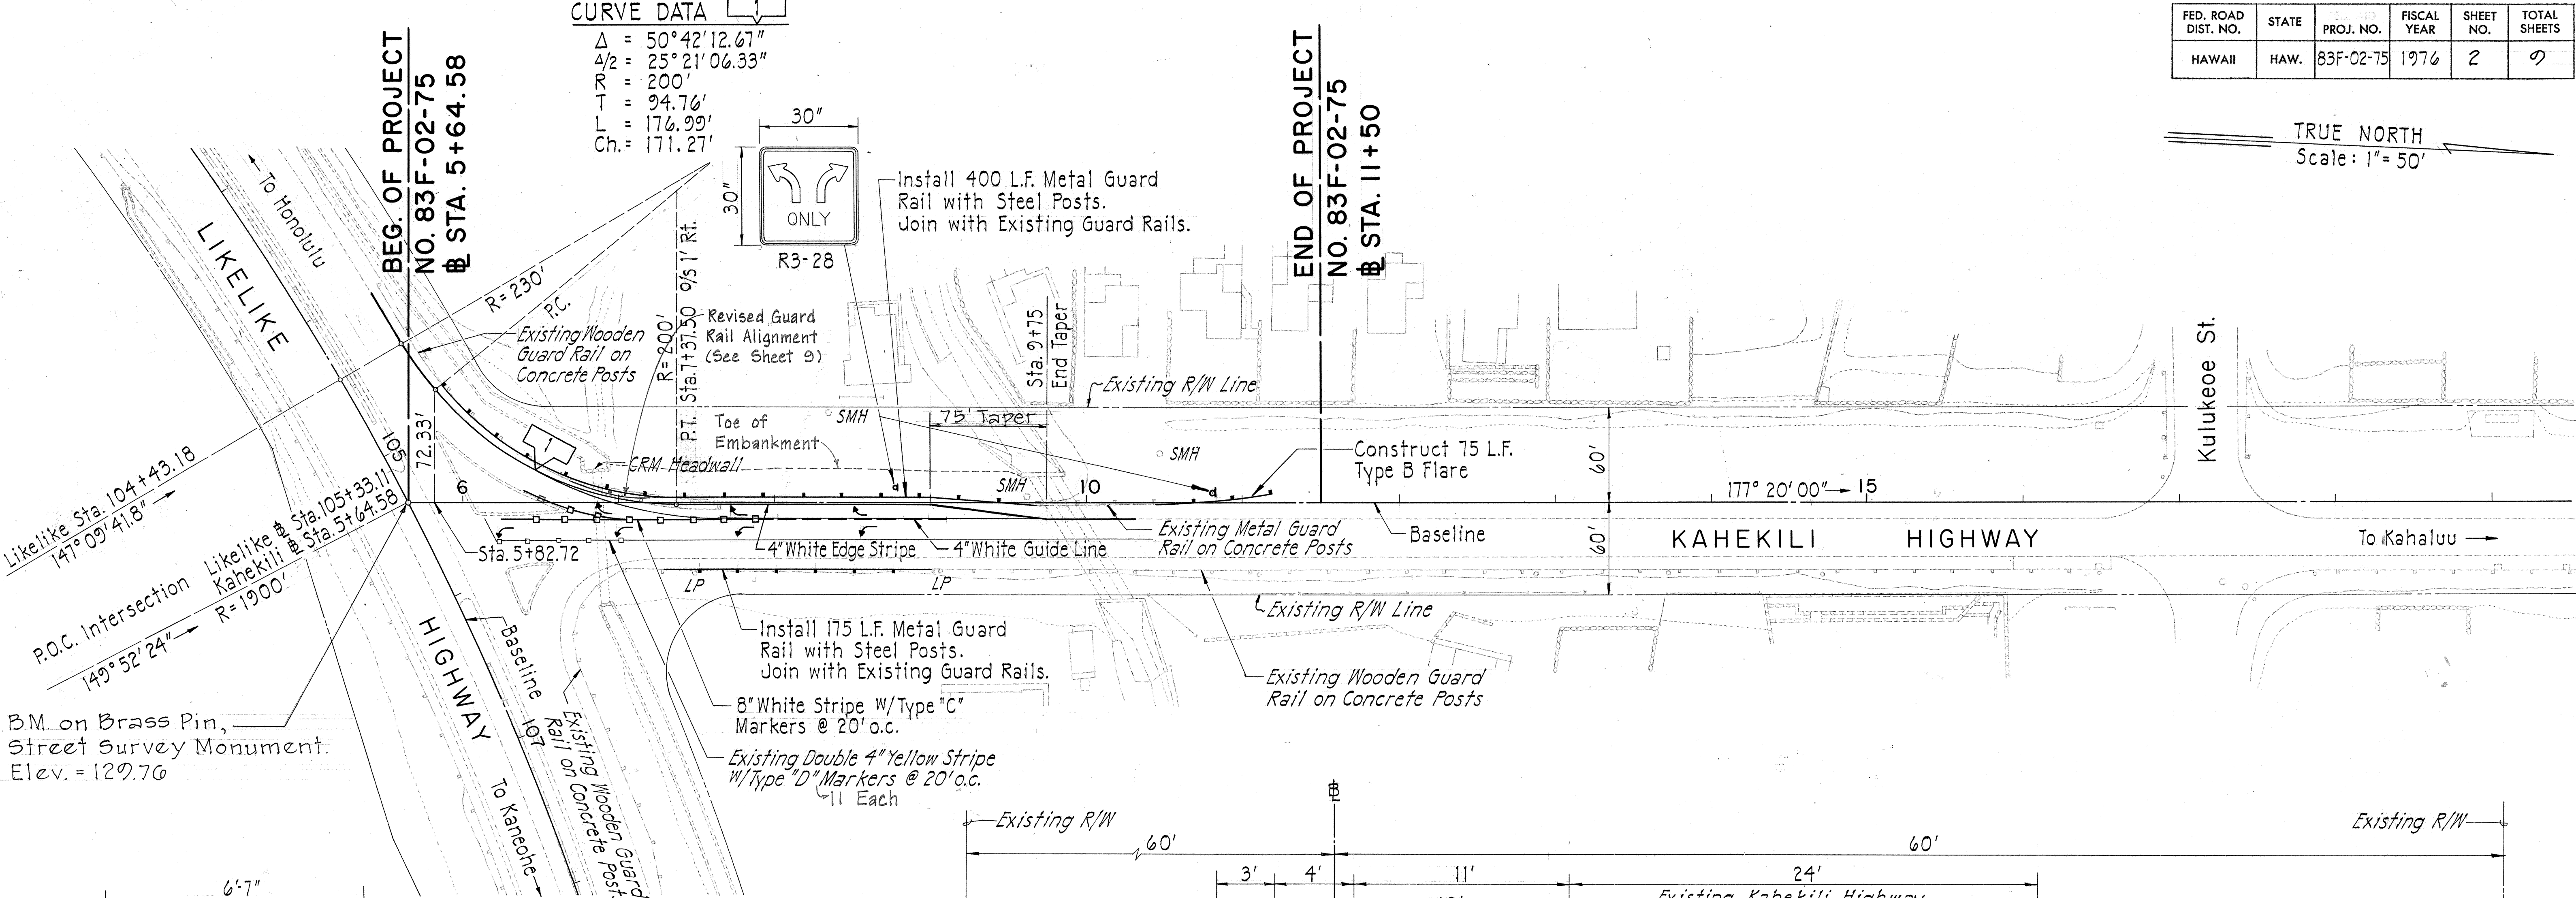

PAVEMENT ARROW

Scale: 1/2" = 1'-0"

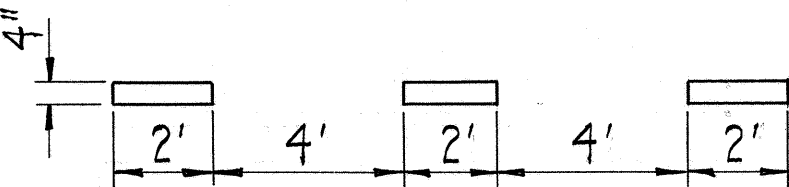


4" WHITE GUIDE LINE

ESTIMATED QUANTITIES	
DESCRIPTION	QUANT.
Type C Pavement Markers	10 Ea.
Sign (R3-28) w/ Post	2 Ea.
Pavement Striping	250 Ft.
Pavement Arrow	7 Ea.

GENERAL NOTES:

- Pavement markings shall conform to the Manual on Uniform Traffic Control Devices for Streets & Highways, 1971 and as shown on the plans.
- Layout of Pavement Markings shall be done by the Contractor and approved by the Engineer.
- Sign R3-28 is a variation of Sign R3-8 with arrow detail conforming to Sign R3-8.

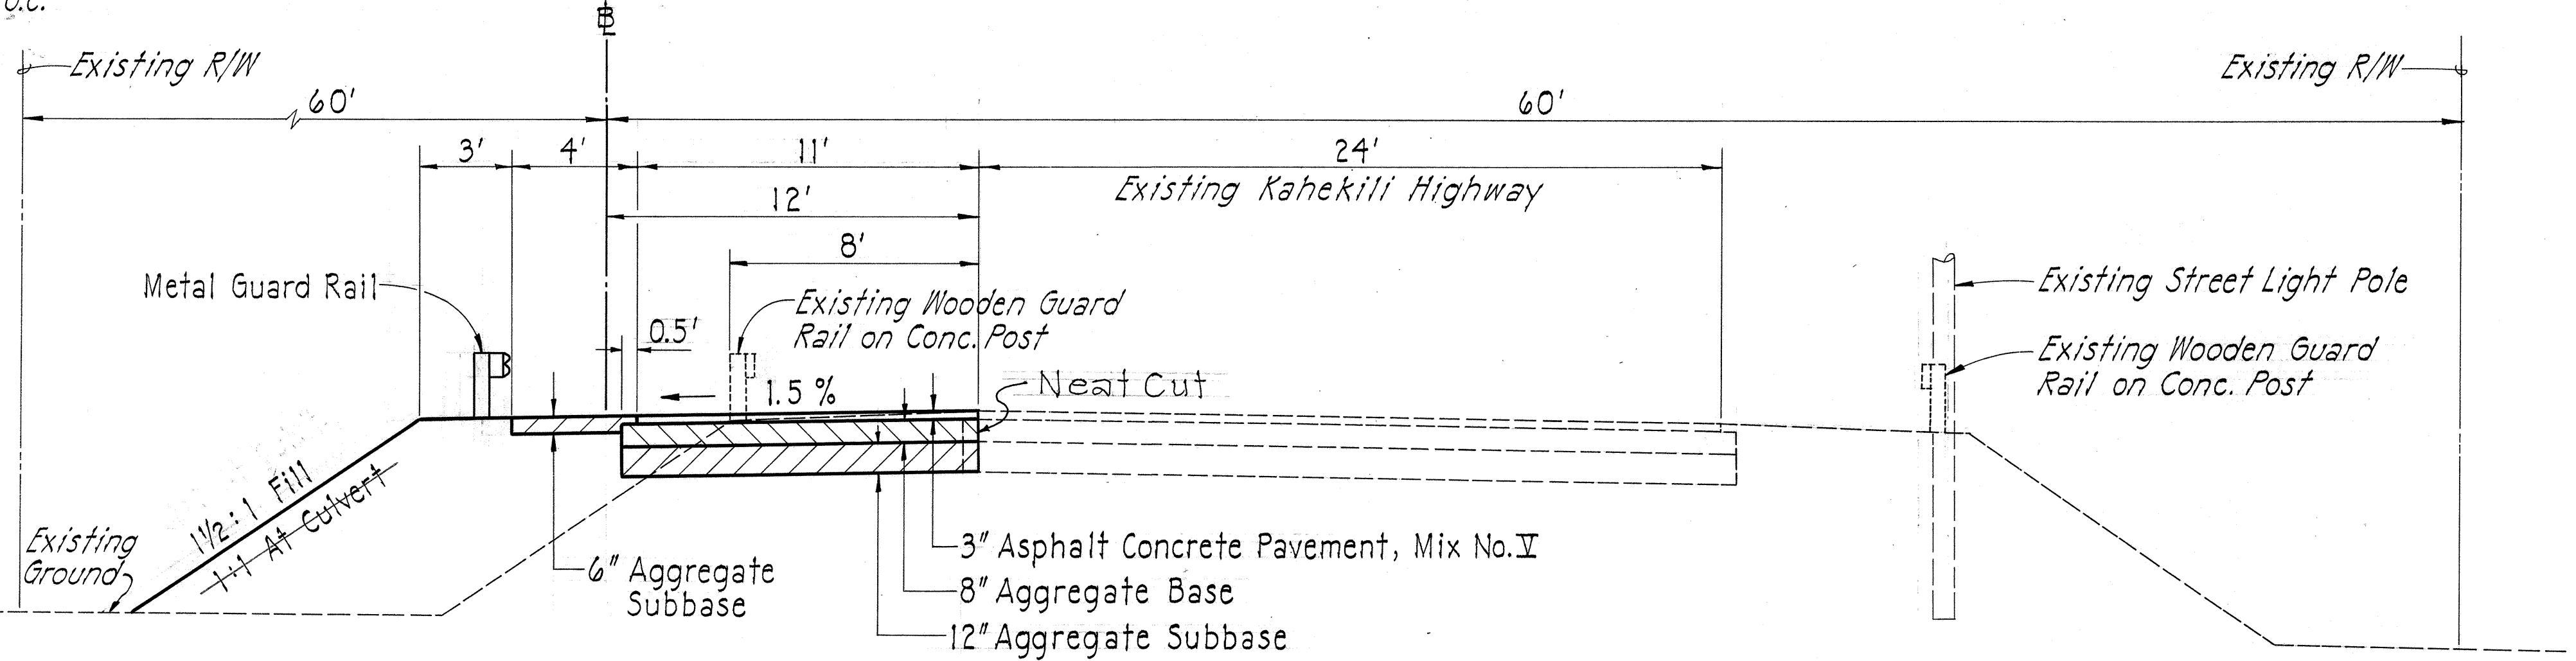

KAHEKILI HIGHWAY TYPICAL SECTION

Scale: 1/4" = 1'-0"

STATE OF HAWAII
DEPARTMENT OF TRANSPORTATION
HIGHWAYS DIVISION

KAHEKILI HIGHWAY
RIGHT TURN LANE AT
LIKELIKE HIGHWAY

PROJ. NO. 83F-02-75
Scale: As Noted Date: May, 1975
SHEET No. 1 OF 1 SHEETS

DATE	_____
SURVEY PLOTTED BY	_____
DRAWN BY	_____
DESIGNED BY	_____
CHECKED BY	_____
NOTE BOOK	_____
No.	_____