- 1	NDEX TO DRAWINGS
SHEET NO.	DESCRIPTION
ĺ	TITLE SHEET
2	PLAN AND DETAILS
3 - 8	STANDARD DETAILS
9	CROSS SECTIONS
	ł
*	
<ul> <li>с дователь запитель (долог)</li> <li>с то становы проведация применения проведация применения применения проведация применения применени</li></ul>	
enada (14 - 17 - 18 - 18 - 18 - 18 - 18 - 18 - 18	
· '	




STATE OF HAWAII


## DEPARTMENT OF TRANSPORTATION HIGHWAYS DIVISION

HONOLULU, HAWAII
PLANS FOR

KAHEKILI HIGHWAY
RIGHT TURN LANE AT
LIKELIKE HIGHWAY
PROJECT NO. 83F-02-75

DISTRICT OF KOOLAUPOKO ISLAND OF OAHU

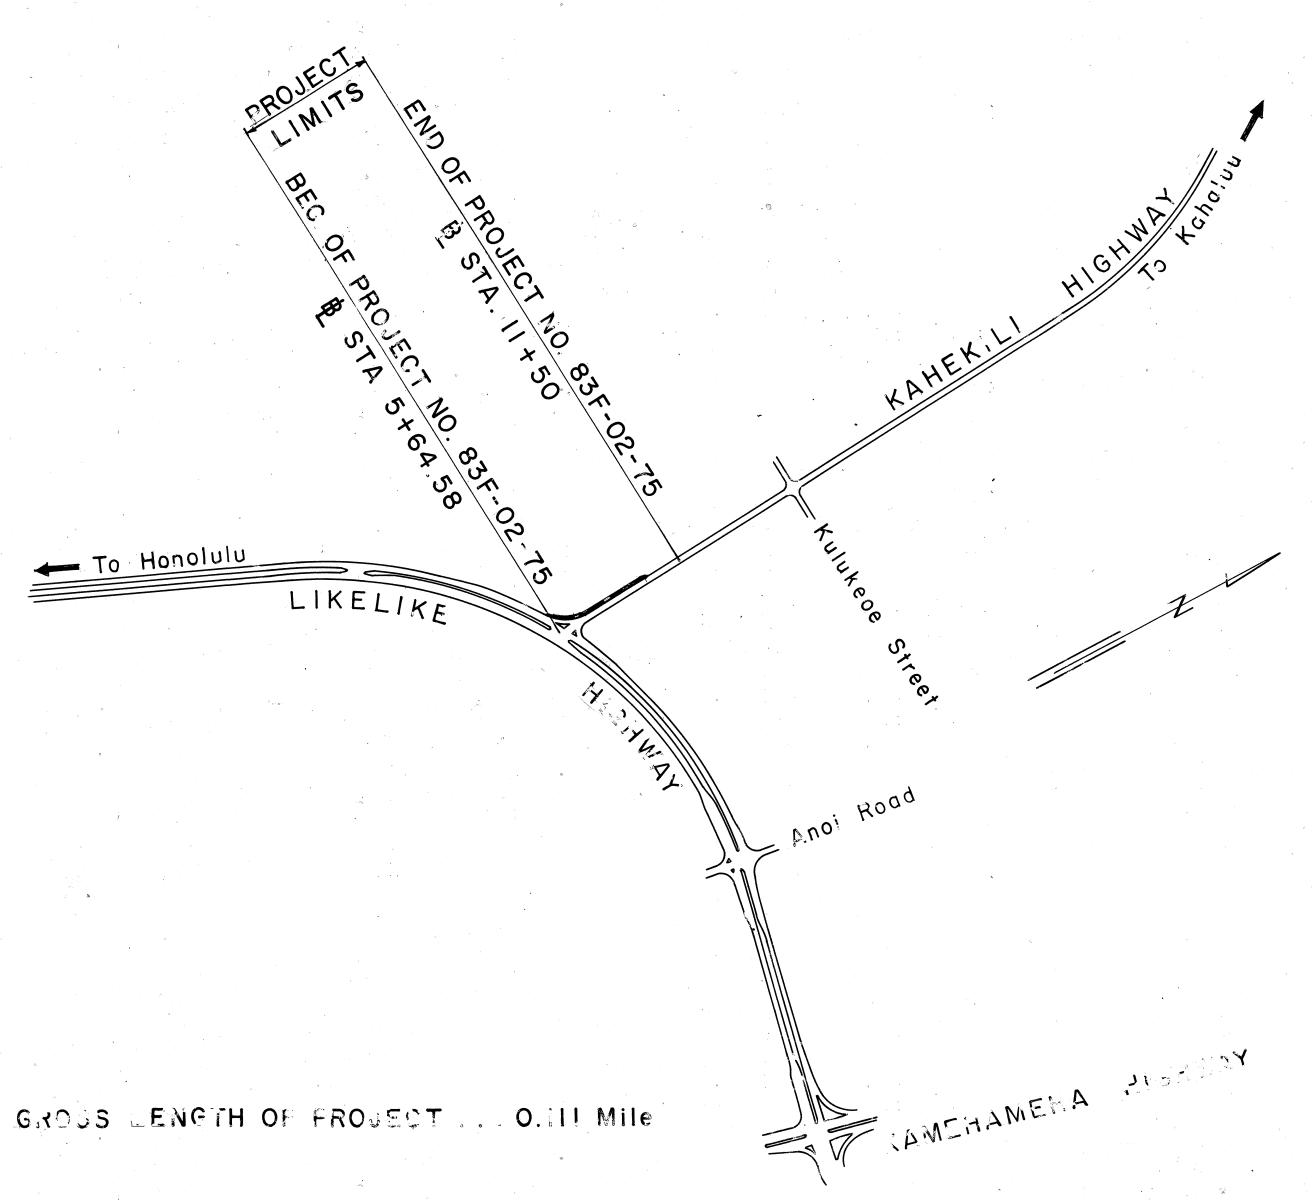

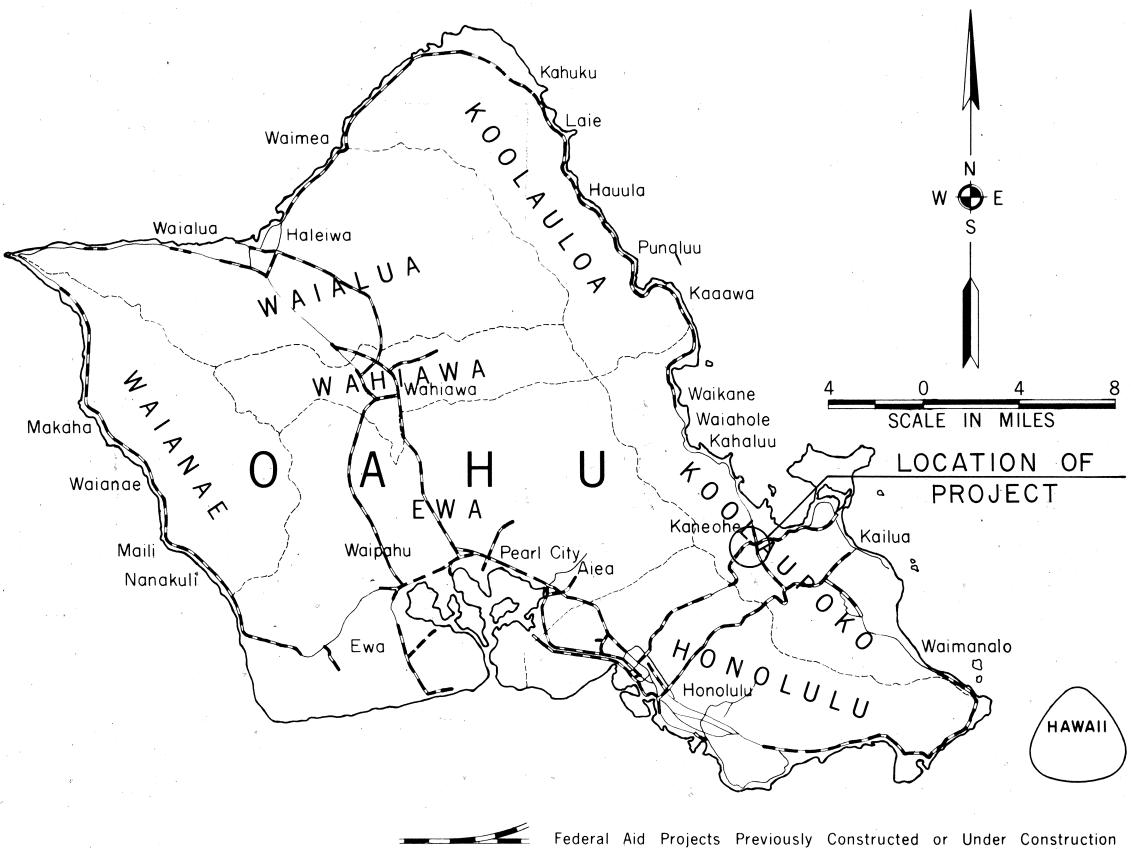

FED. ROAD DIST. NO.

STATE PROJ. NO. FISCAL SHEET TOTAL YEAR NO. SHEETS

HAW. 83F-02-75 1976

## AS BUILT PLANS

"ALL CHANGES MADE DURING CONSTRUCTION HAVE BEEN INCORPORATED ON THESE PLANS EXCEPT CHANGES IN THE ORIGINAL THEORETICAL QUANTITIES."

Robert y. Muronaka 12/23/75
RESIDENT ENGINEER DATE

DEPARTMENT OF TRANSPORTATION STATE OF HAWAII
APPROVED:
6. alney Honight 7/8/15
DIR. OF TRANSPORTATION DATE

01-9-

4