
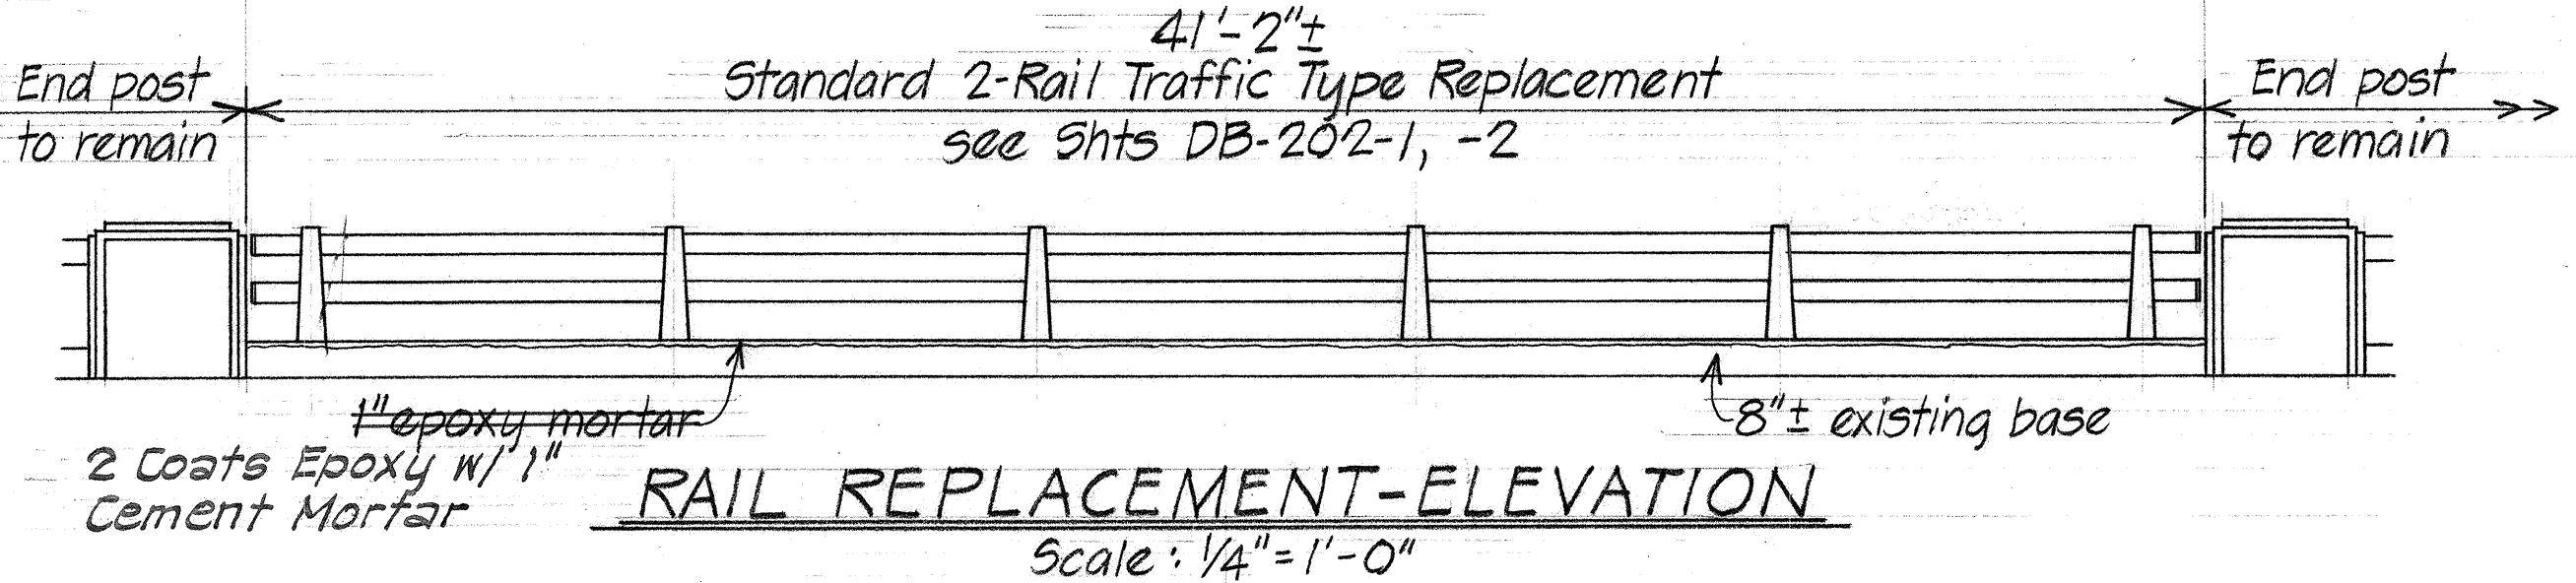
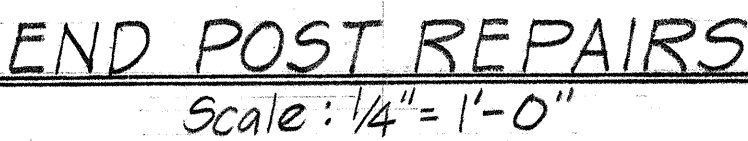
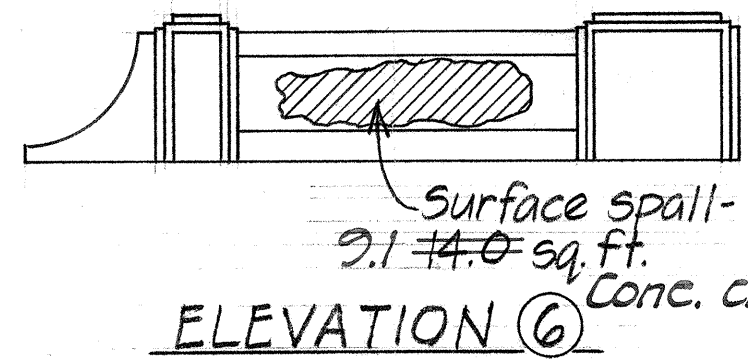
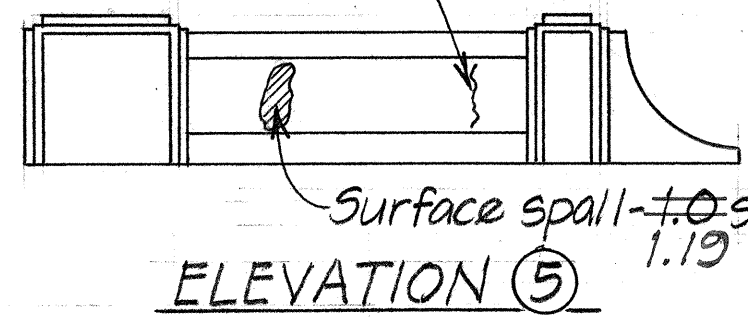
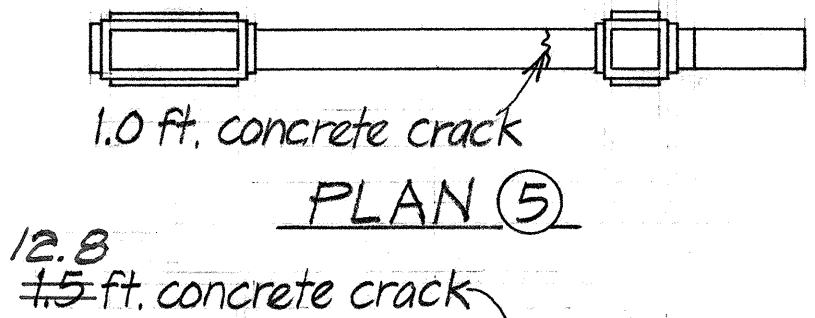
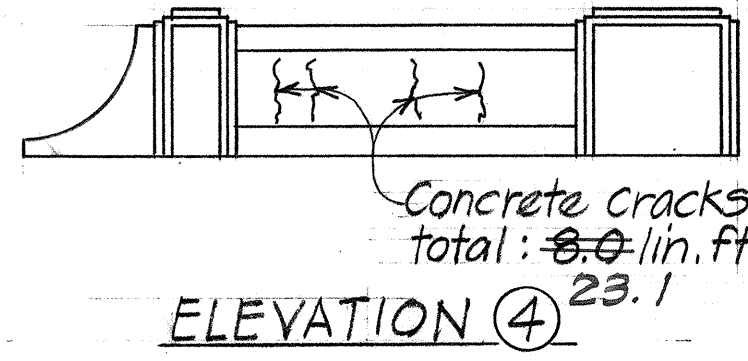
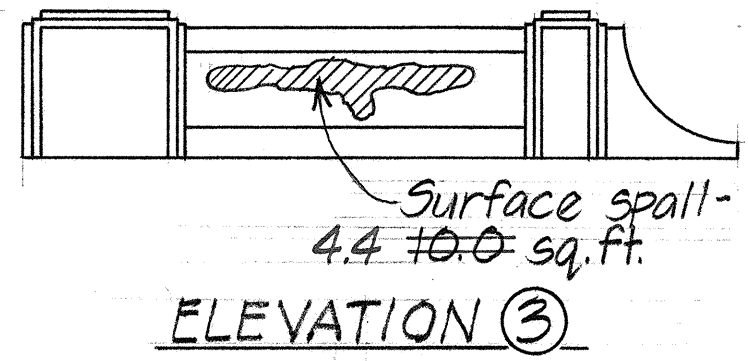
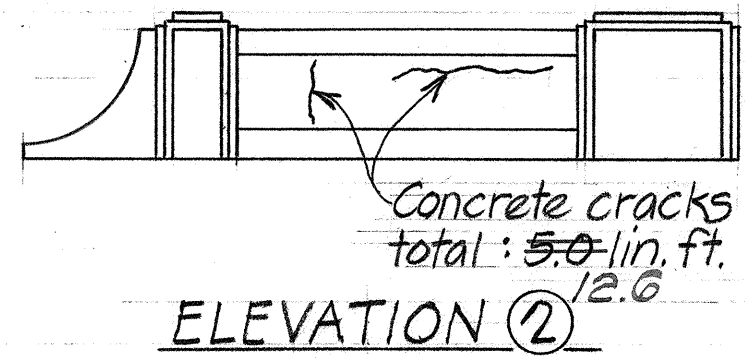
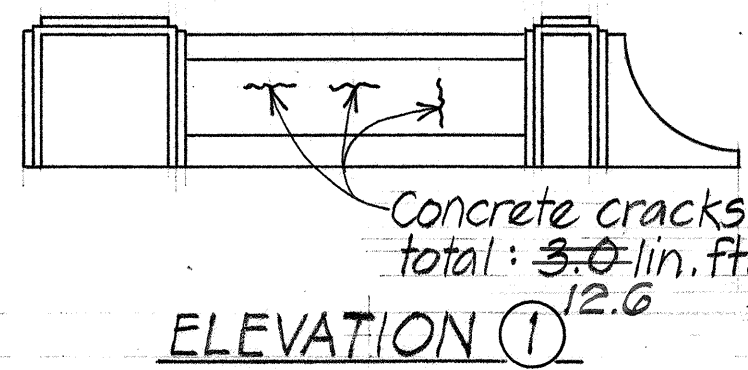
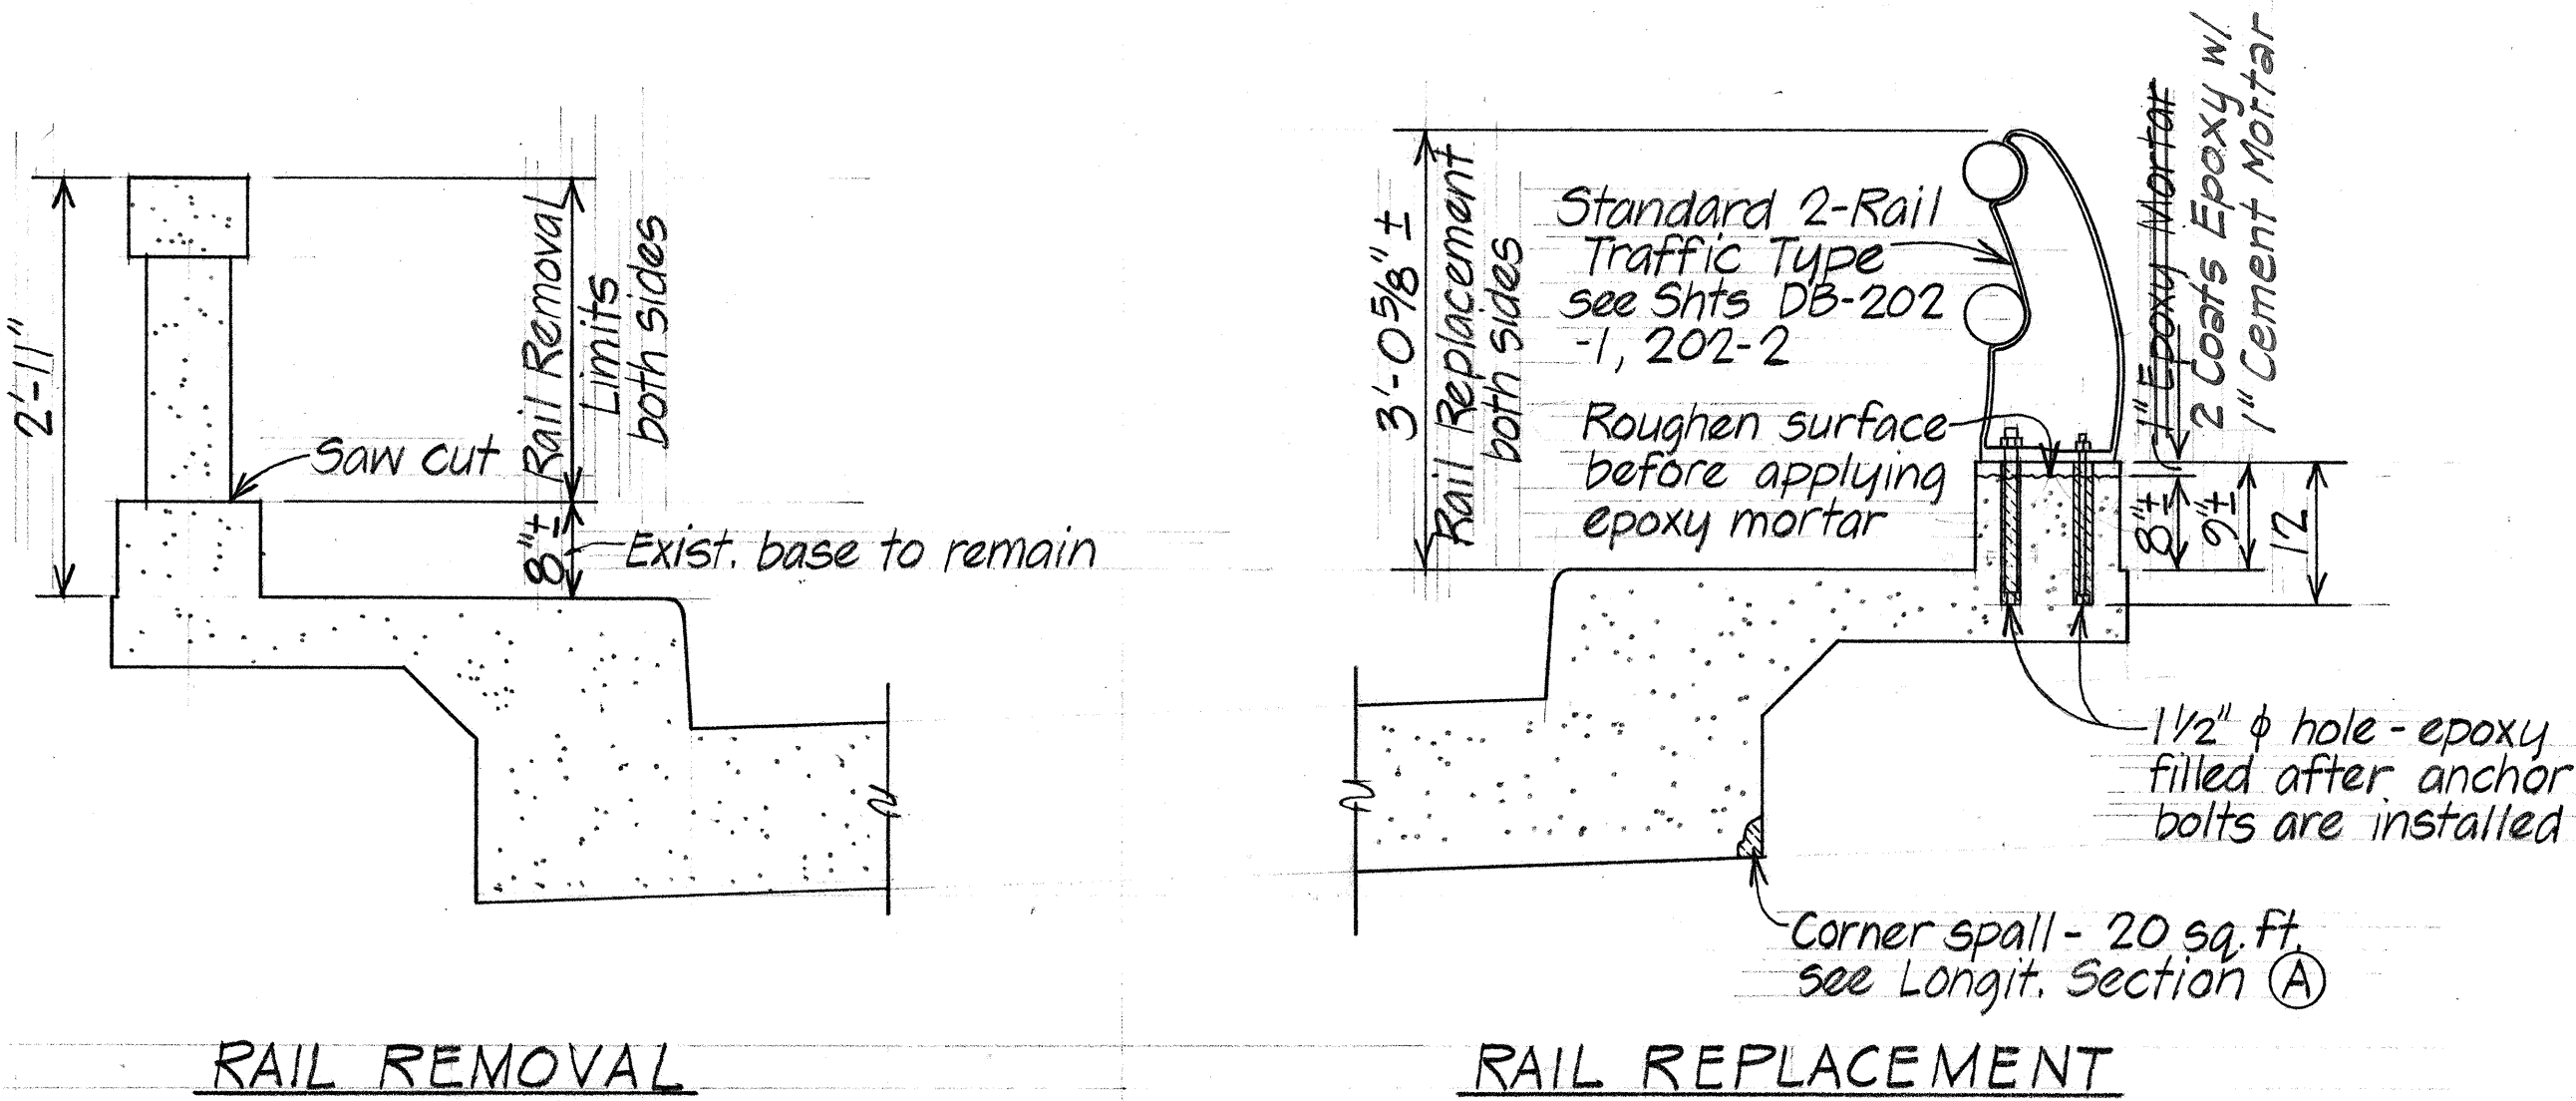
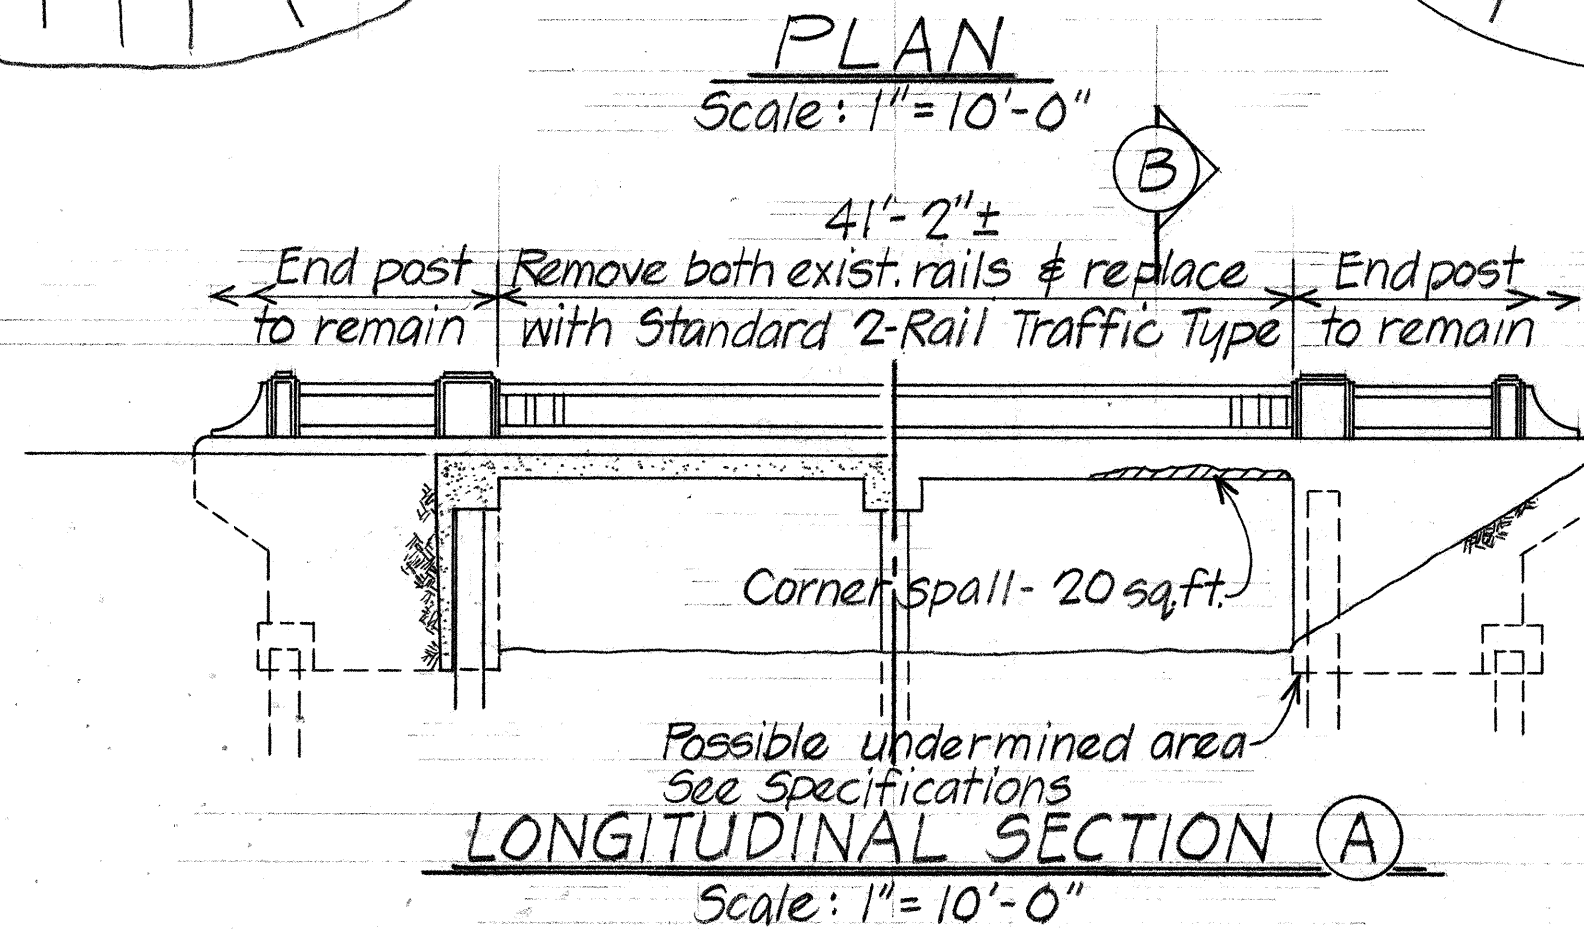


FED. ROAD DIST. NO.	STATE	PROJ. NO.	FISCAL YEAR	SHEET NO.	TOTAL SHEETS
HAWAII	HAW.	HWY-002-76M	1976	2	11

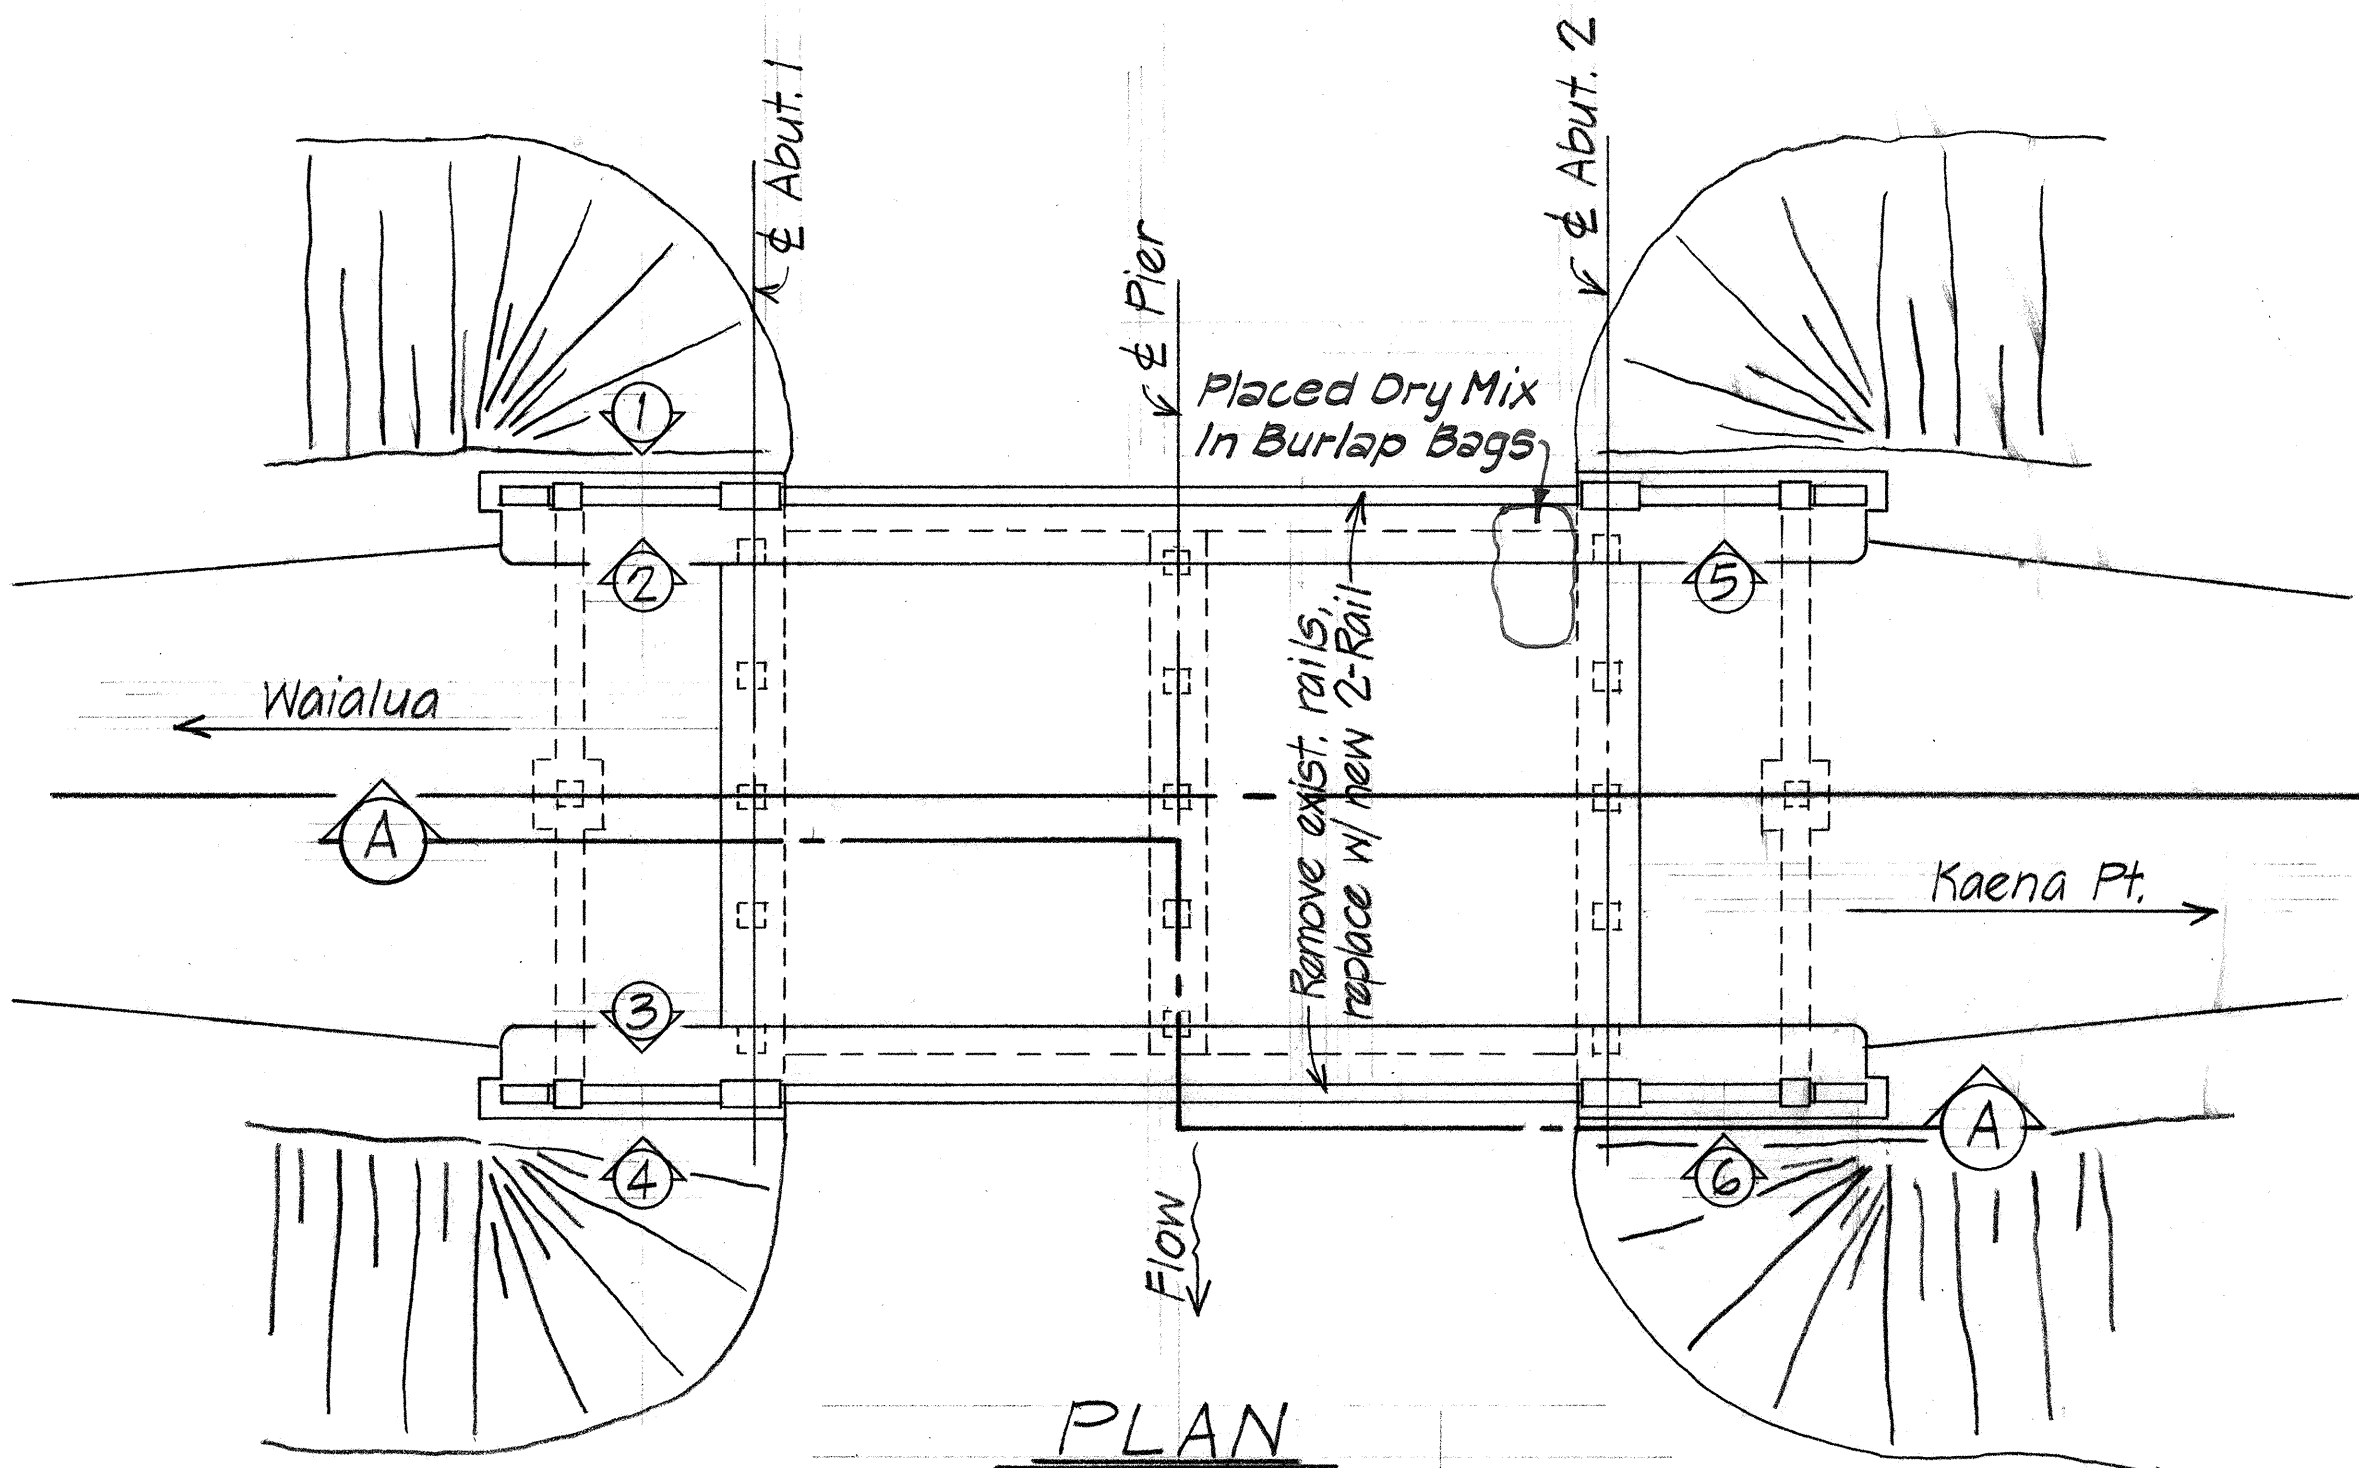

ESTIMATED QUANTITIES			
ITEM No	DESCRIPTION	UNIT	QUANTITY
202.07	Removal of Concrete Rails	Lump Sum	(83 Lin. Ft.)
507.20	Metal Bridge Railing - Two Rails Traffic Type	Lump Sum	(83 Lin. Ft.)
676.06	Repair of Spalled Concrete	Sq. Ft.	65 Sq. Ft.
677.05	Sealing Cracks in Concrete	Lin. Ft.	19 Lin. Ft.
678.04	Exploratory & Repair Work to the Substructure of Polipoli Bridge	F.A.	

- NOTES:**
1. The Contractor shall remove and dispose all debris from the construction site daily. The removing and disposing of debris shall be considered to be incidental to Removal of Concrete Rail and no additional payment will be made therefor.
 2. For the protection and safety of the public, the Contractor shall construct and install temporary railings at locations where existing railings were removed. Payment for the temporary railings shall be considered to be incidental to Removal of Concrete Rail and no additional payment will be made therefor.
 3. Locations of additional 20.0 sq. ft. of concrete spall repairs shall be directed by the Engineer.
 4. Drilling of anchor bolt holes, rail hardware, epoxy and epoxy mortar shall be incidental to the metal bridge rail and shall not be paid for separately.

STATE OF HAWAII
DEPARTMENT OF TRANSPORTATION
HIGHWAYS DIVISION
PLAN

REPAIRS TO POLIPOLI BRIDGE
FARRINGTON HIGHWAY
DISTRICT OF WAIALUA
M.P. 13.15
PROJ. NO. HWY-0-02-76M
Scale: As shown Date: June, 1976
SHEET No. 1 OF 1 SHEETS

SURVEY PLOTTED BY	DATE
DRAWN BY	
DESIGNED BY	
QUANTITIES BY	
CHECKED BY	