



FED. ROAD DIST. NO.	STATE	PROJ. NO.	FISCAL YEAR	SHEET NO.	TOTAL SHEETS
HAWAII	HAW.	83B-02-77M	1977	3	3

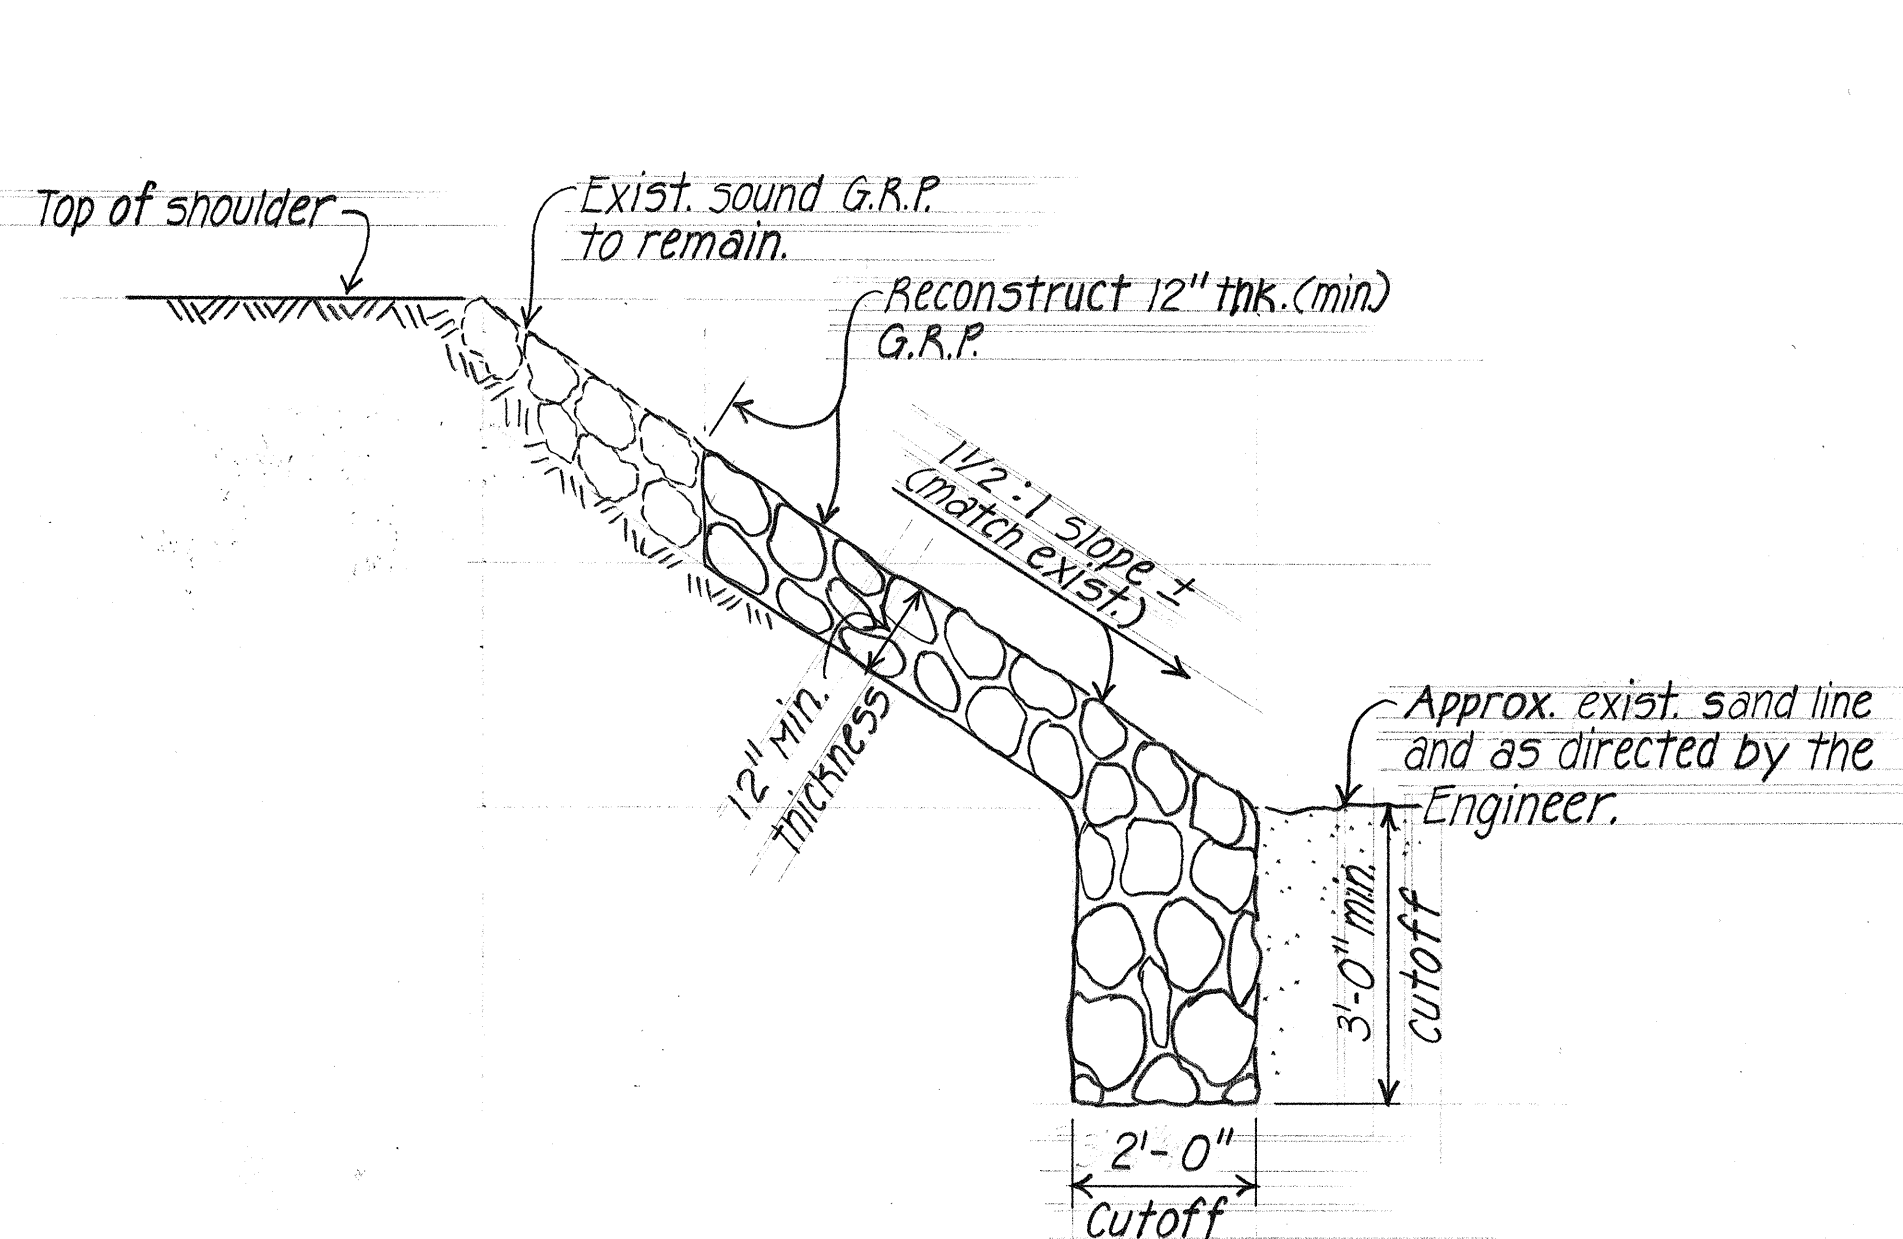


TYPICAL GROUTED RUBBLE PAVING

SECTION D
2 Scale: 1/2" = 1'-0"

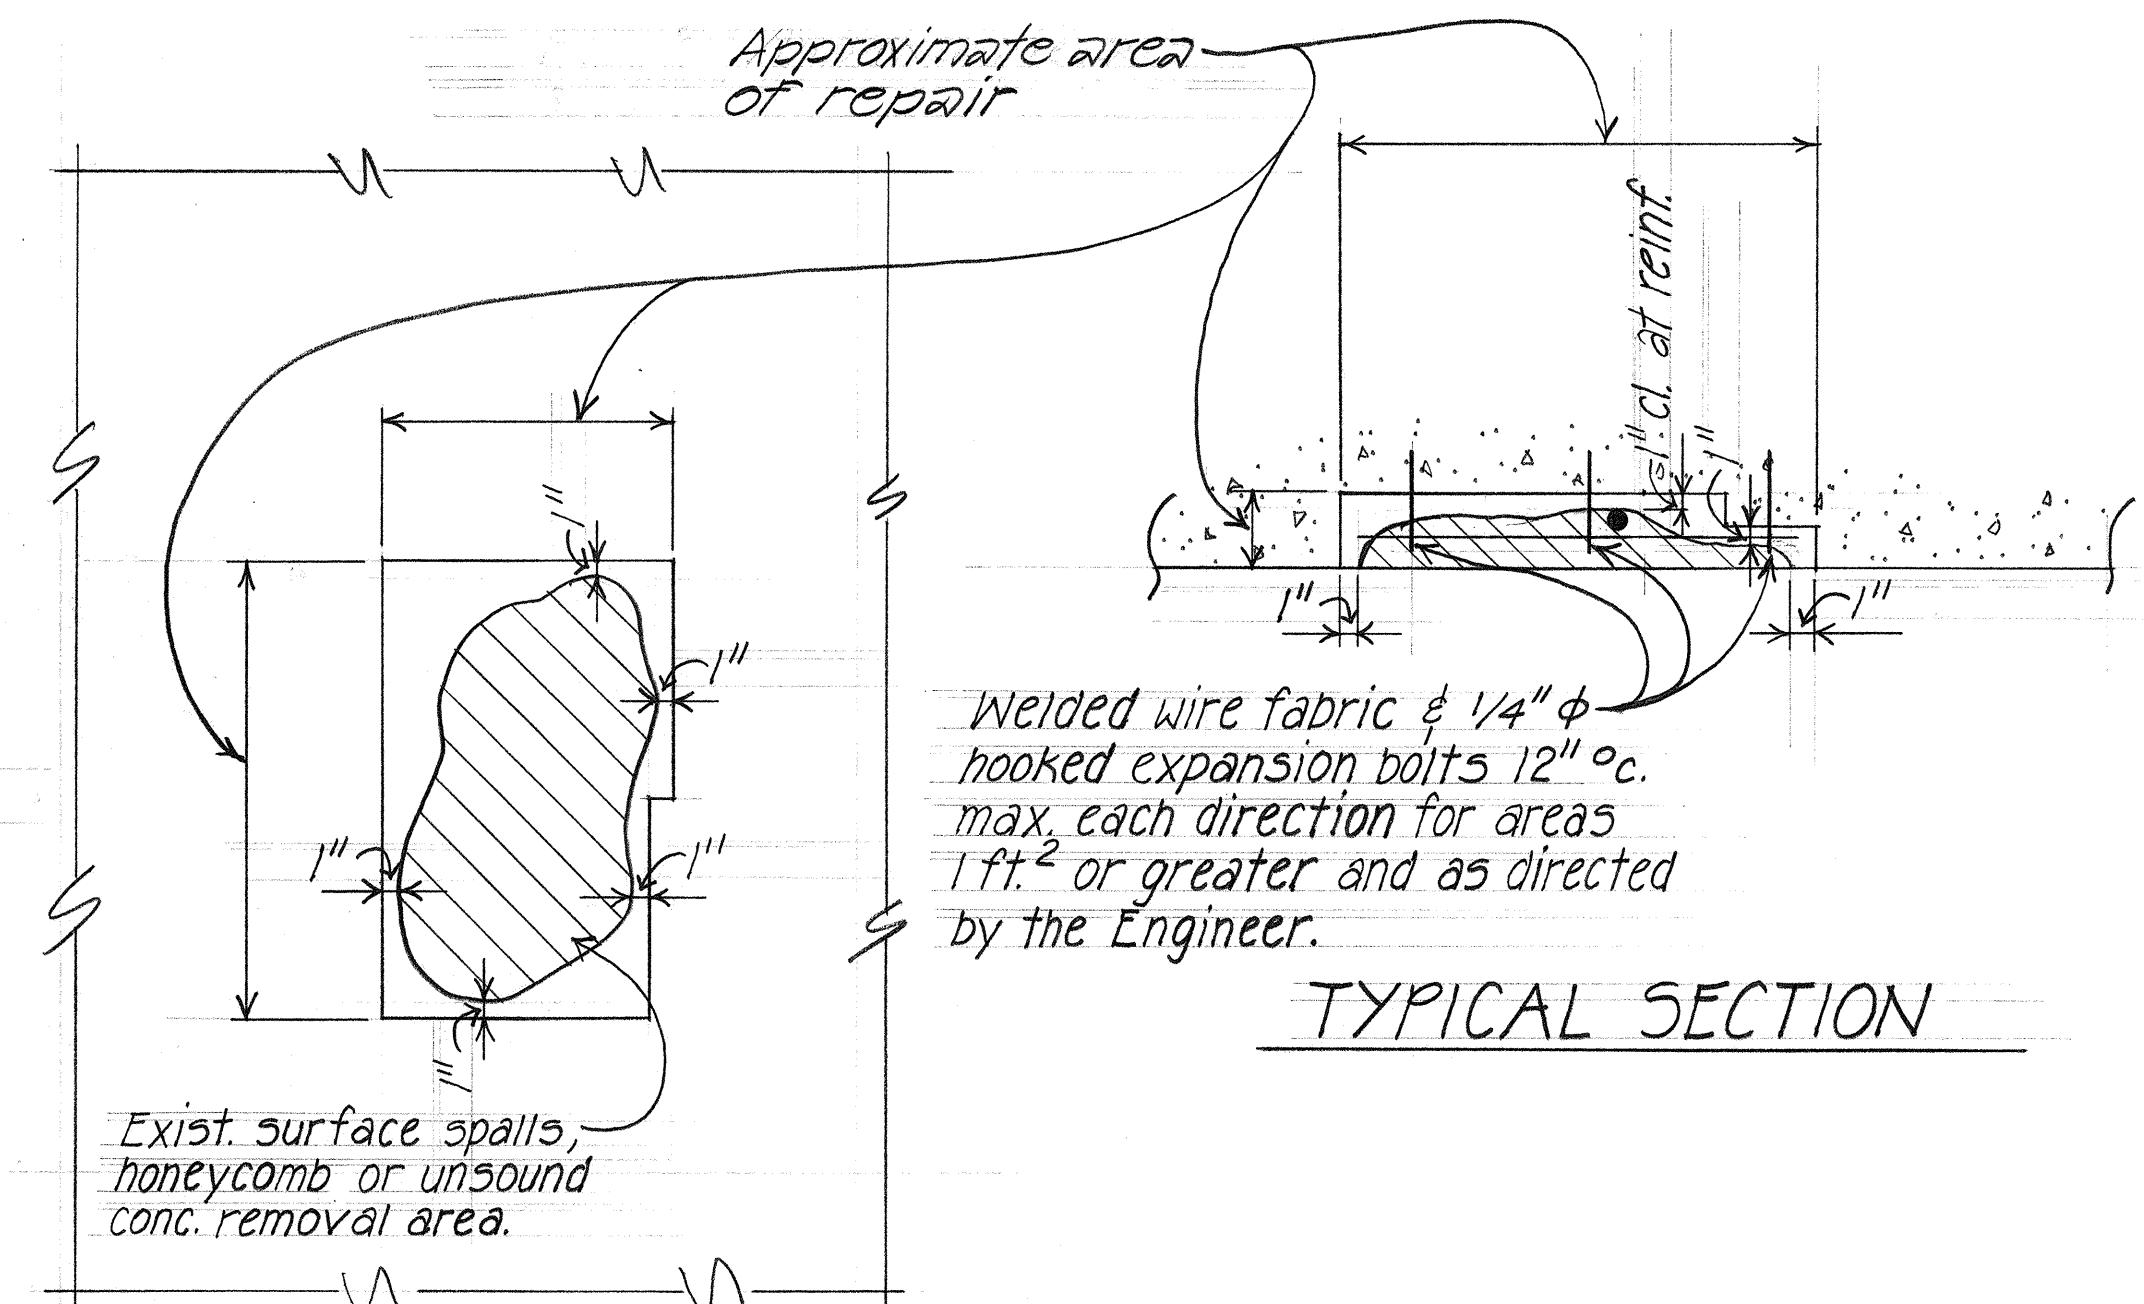


PLAN OR ELEVATION


TYPICAL REPAIRS AT CONCRETE SURFACE SPALLS, HONEYCOMB OR UNSOUND CONCRETE

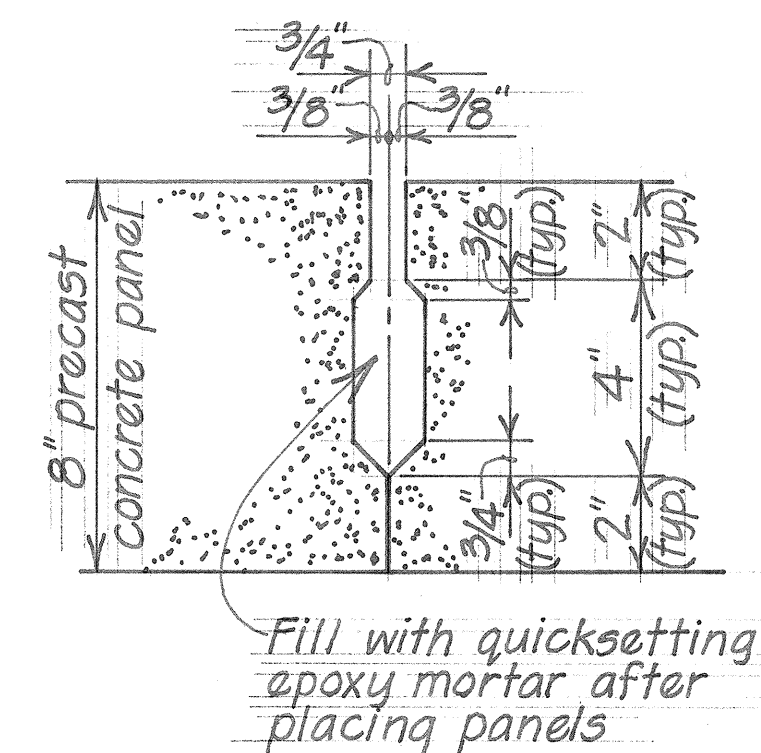


DETAIL B
2 AT FORMED JOINT Scale: 3" = 1'-0"

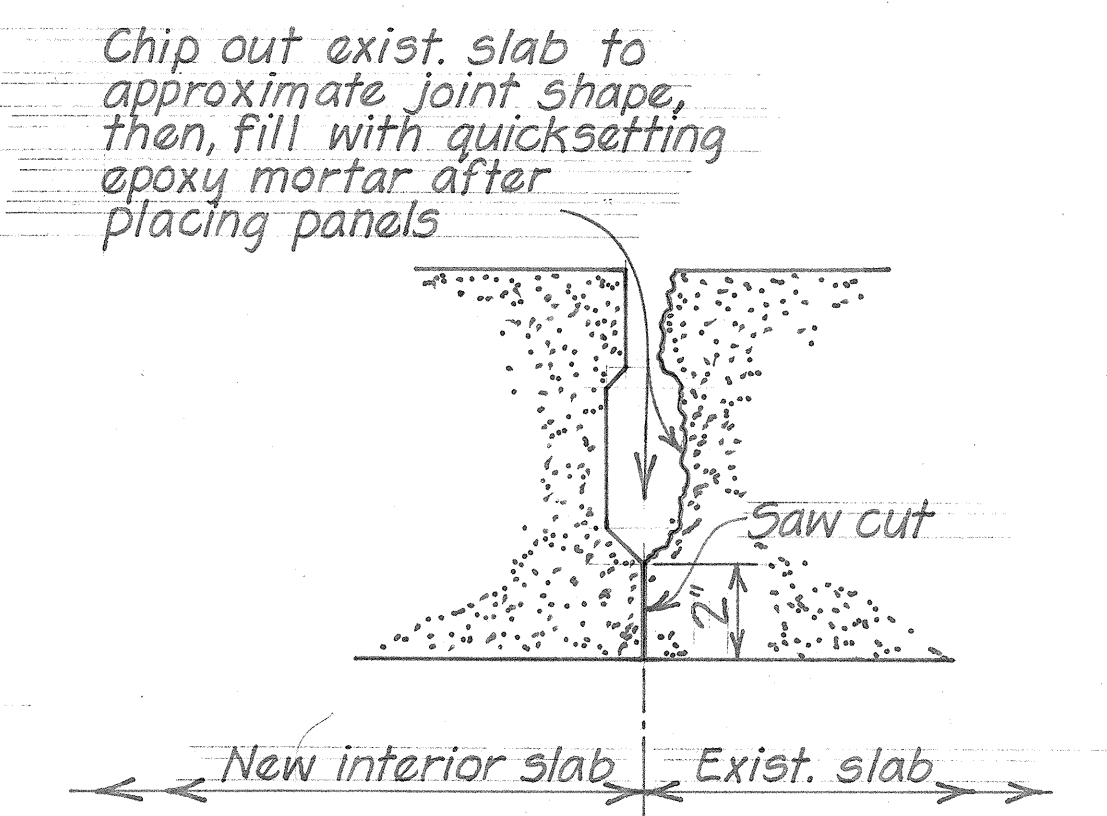


DETAIL A
2 AT SHAPED JOINT Scale: 3" = 1'-0"

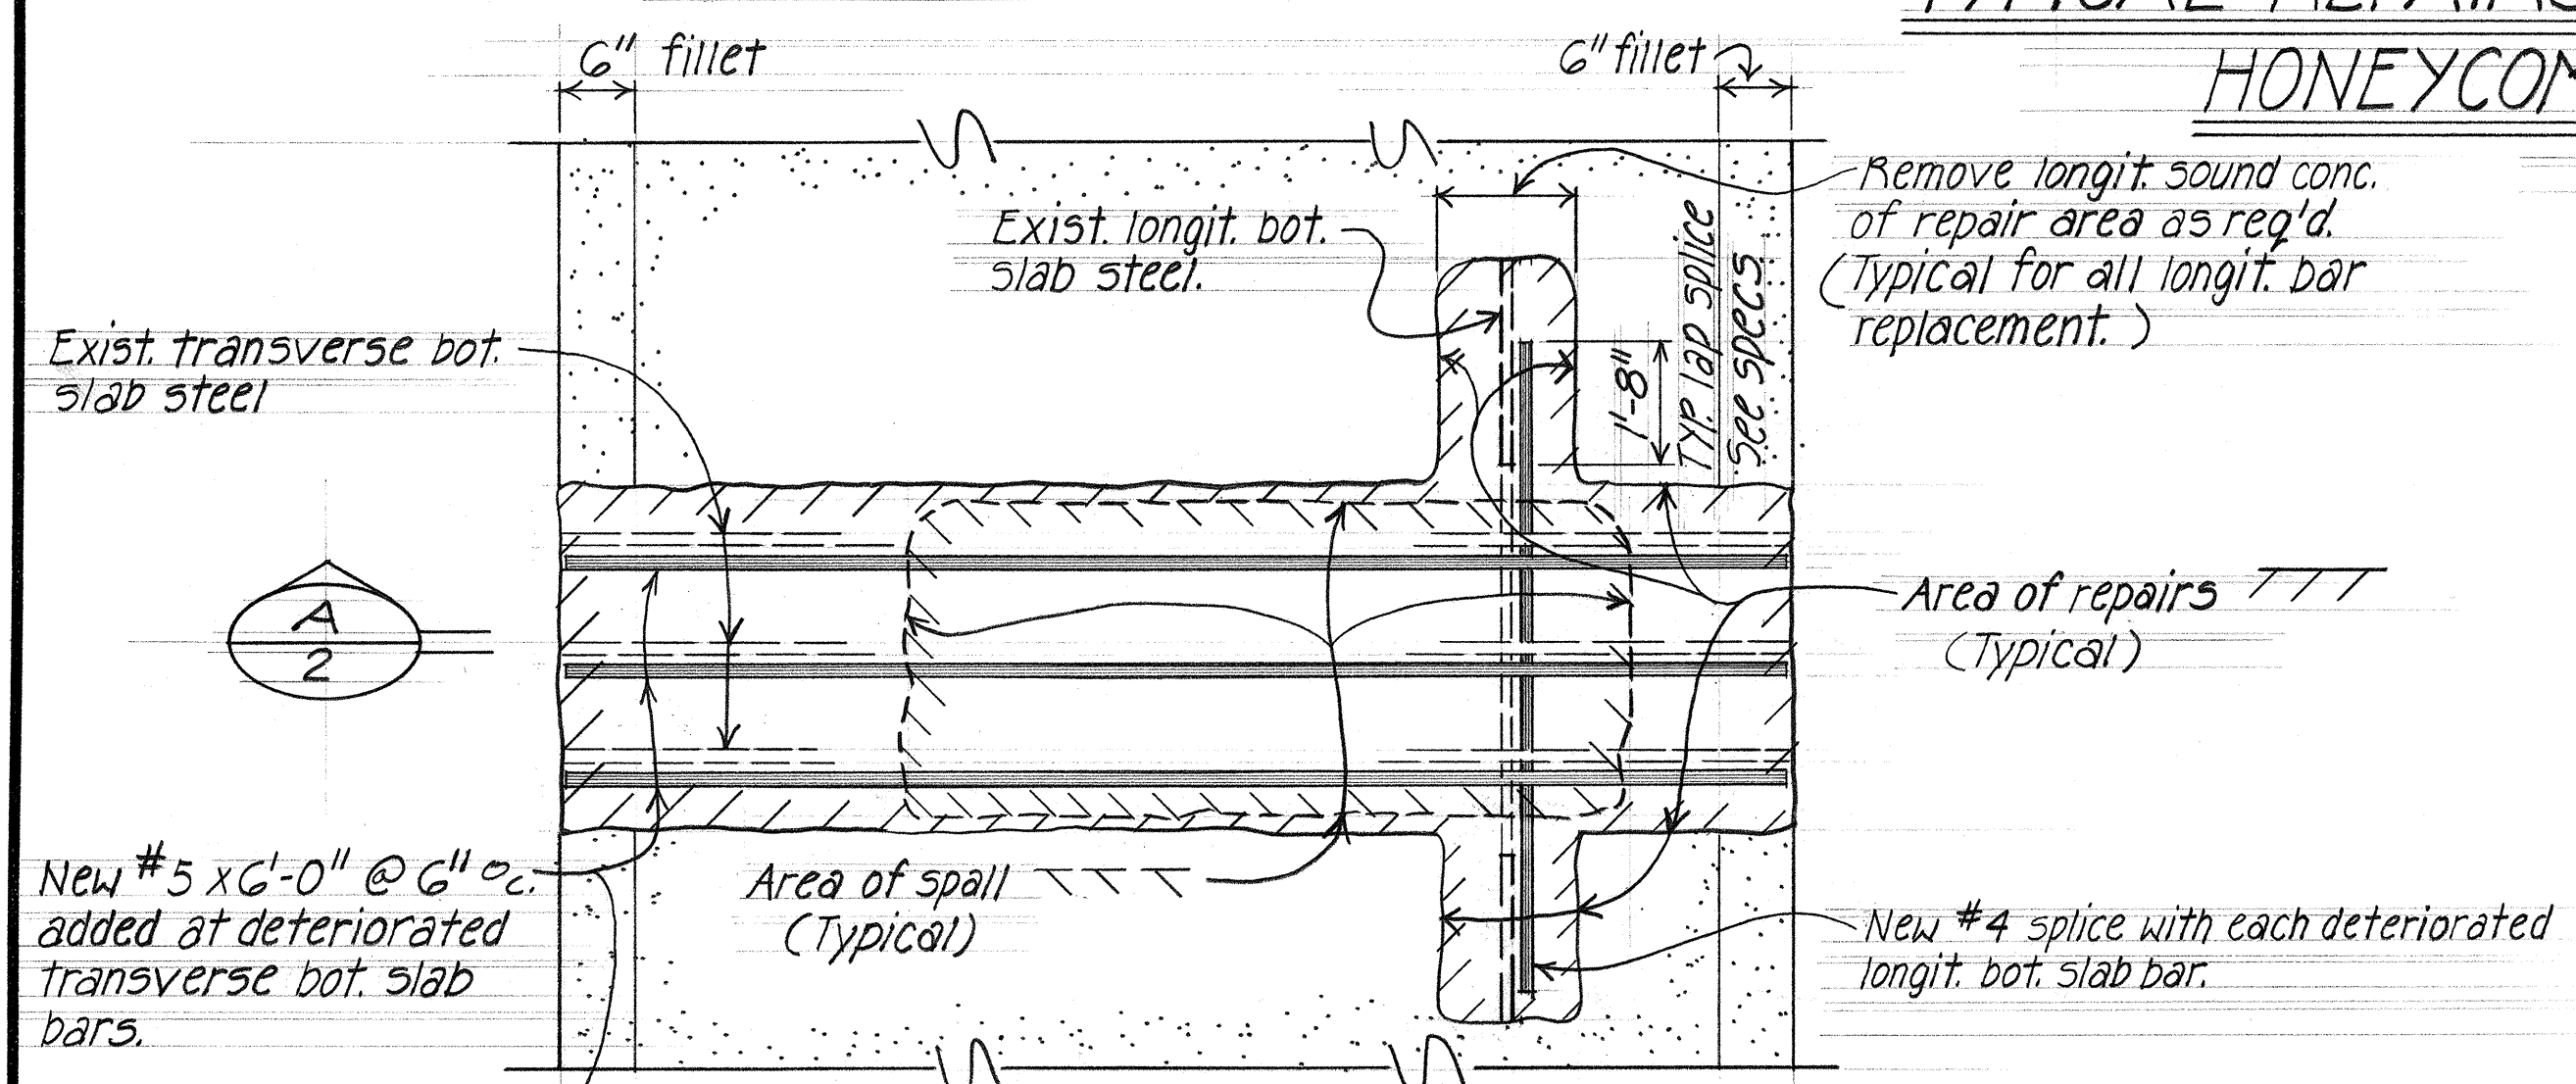

REFLECTED CEILING PLAN

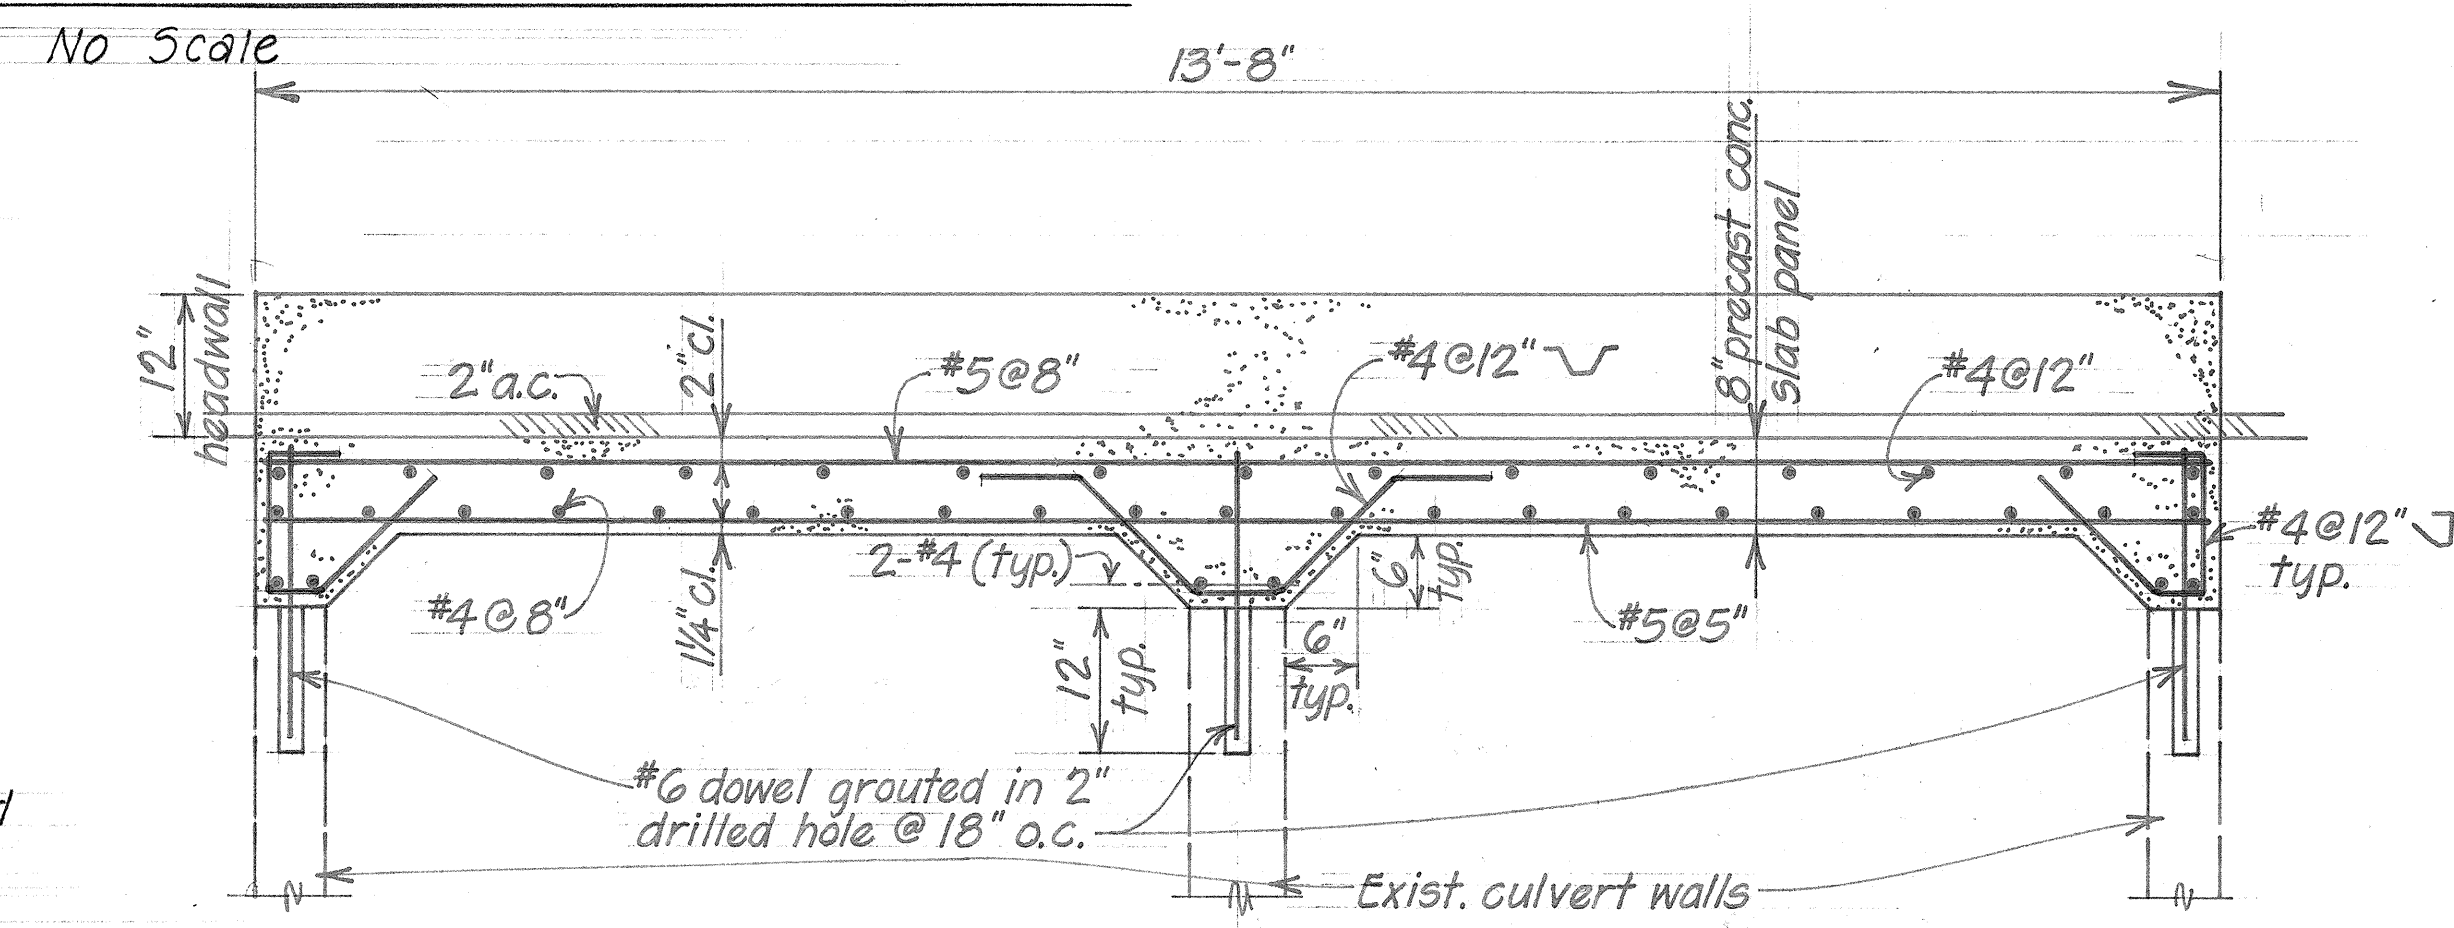


TYPICAL SECTION C
2 Scale: 3/4" = 1'-0"

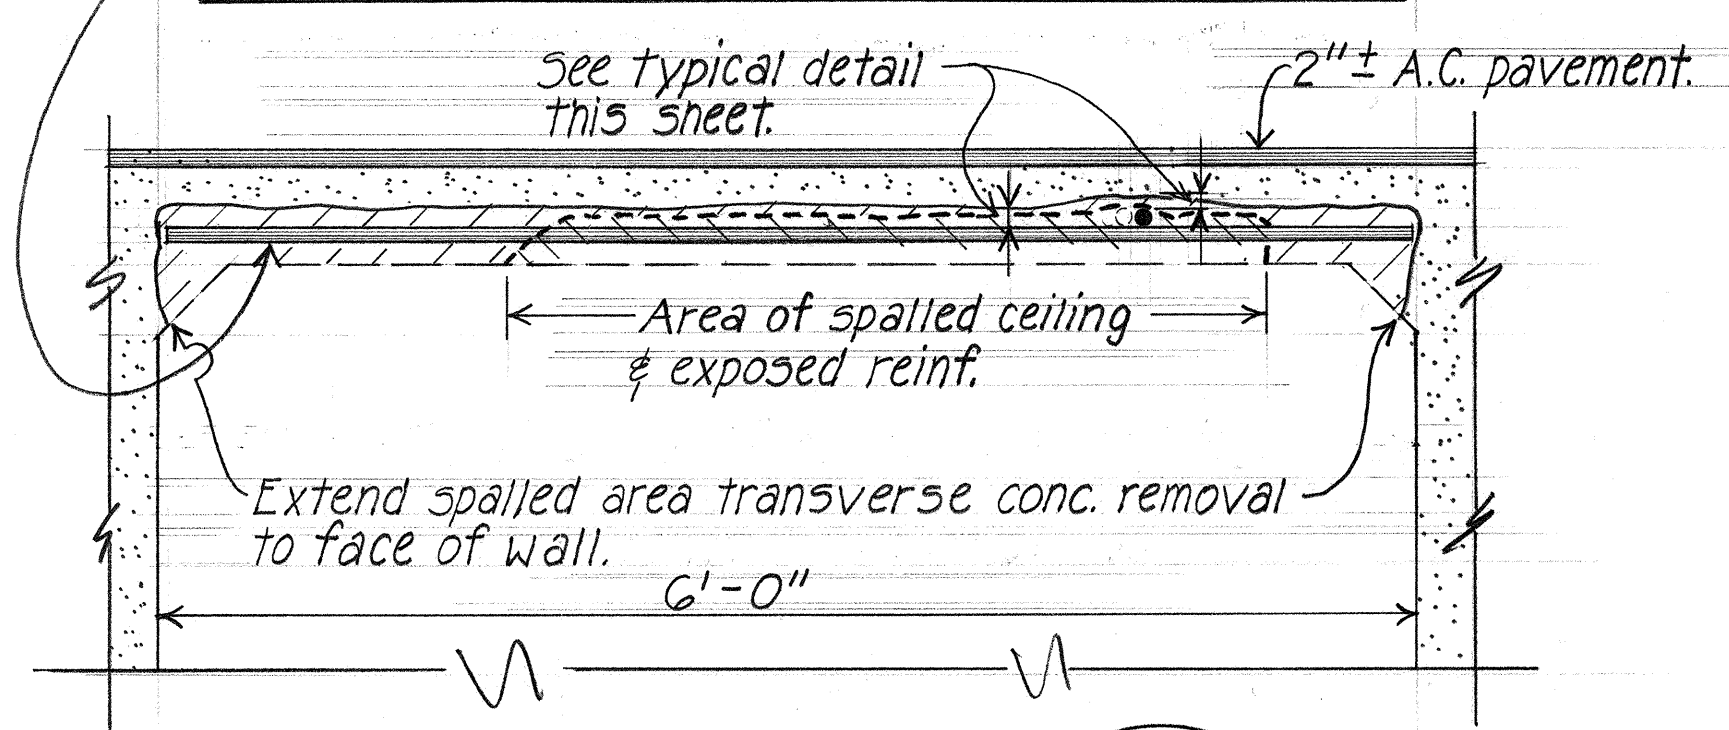

TYPICAL SECTION A
2

EXTERIOR SLAB PANEL DETAIL D
2 Scale: 1" = 1'-0"

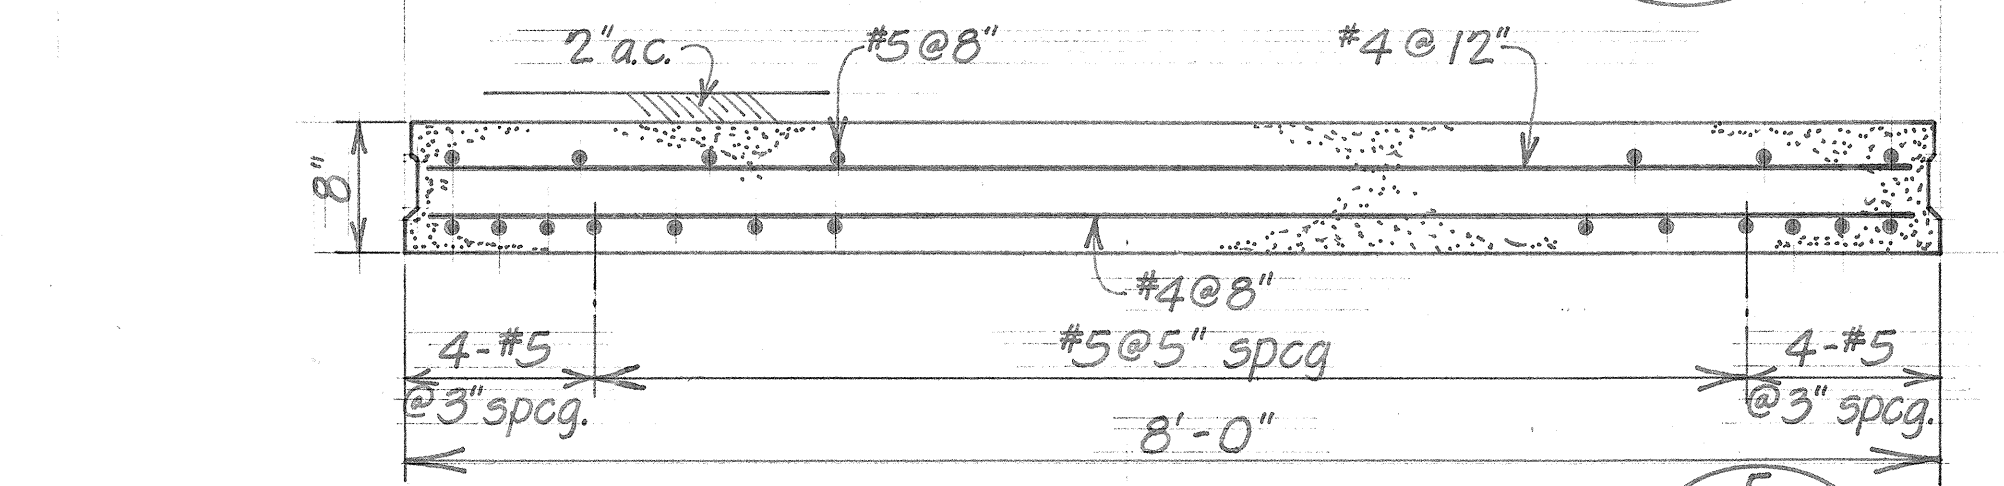

INTERIOR SLAB PANEL DETAIL E
2 Scale: 1" = 1'-0"

DIAGRAM-TYPICAL REPAIRS AT 16' SHORED SECTION CEILING SPALLED AREAS Not To Scale

STATE OF HAWAII
DEPARTMENT OF TRANSPORTATION
HIGHWAYS DIVISION

REPAIR TWIN 6'x3' BOX CULVERT

SECTIONS & DETAILS

Proj. No. 83B-02-77M
Scale: As noted Date: May 1976

SHEET NO. 2 OF 2 SHEETS

SURVEY PLOTTED BY	DATE
DRAWN BY	
TRACED BY	
NOTES BOOK	
CHECKED BY	