
/				
IN	DEX	ТО	DRAWINGS	
SHEET NO.			ESCRIPTION	-
	7/1/	e Sho	e e e	
	Plan	15,500	tions and Details	
3. The same of the	Sec	tions	and Details	
			,	-
		·		
				-
				-
				-
				_
				_
				_
				_
		······································	:	-
		·		_



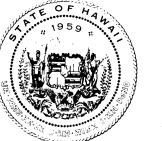

STATE OF HAWAII

DEPARTMENT OF TRANSPORTATION HIGHWAYS DIVISION

HONOLULU, HAWAII


"AS-BUILT"


PLAN5 TO


REPAIR TWIN 6'x 3' BOX CULVERT KAMEHAMEHA HIGHWAY AT MILEPOST 7.498

PROJECT No. 83B-02-77M

DISTRICT OF KOOLAULOA ISLAND OF OAHU

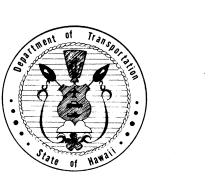

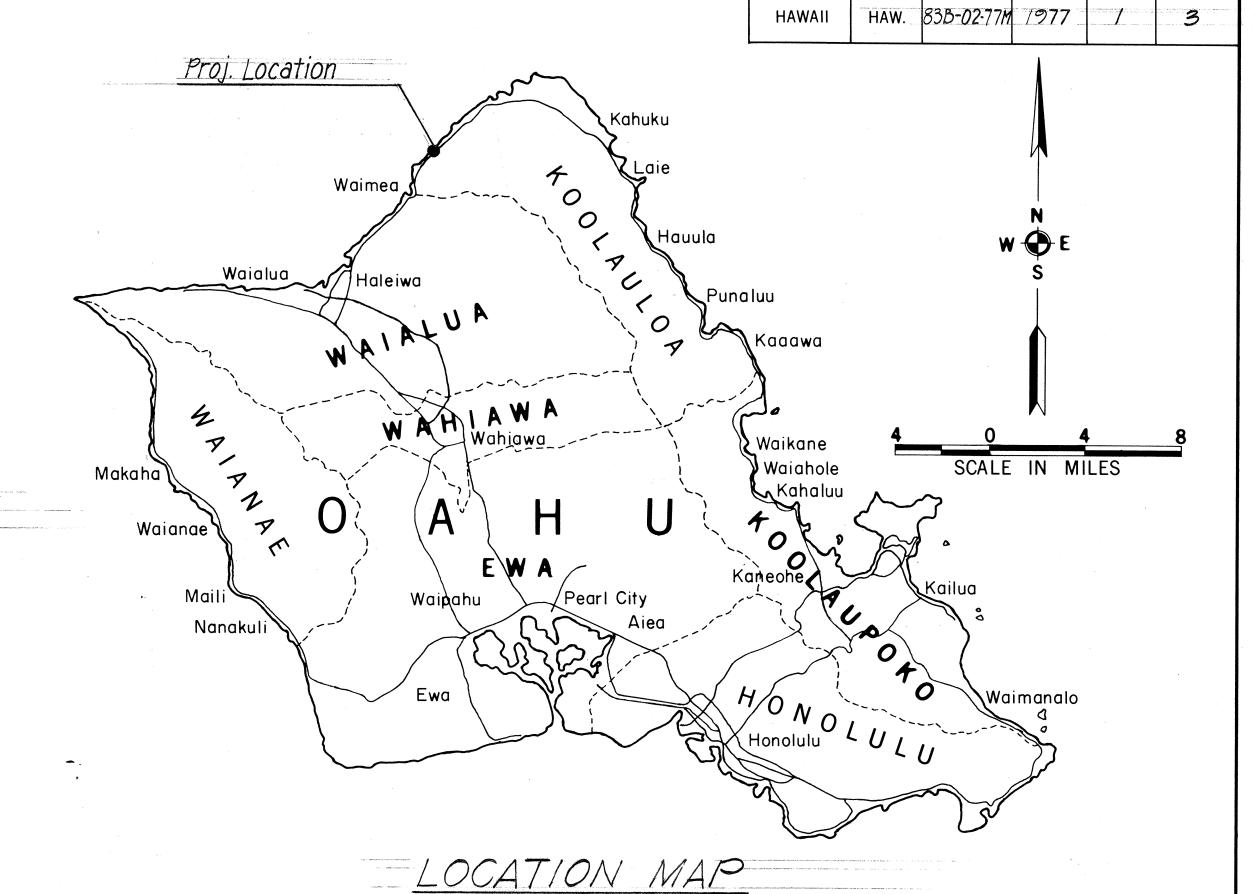

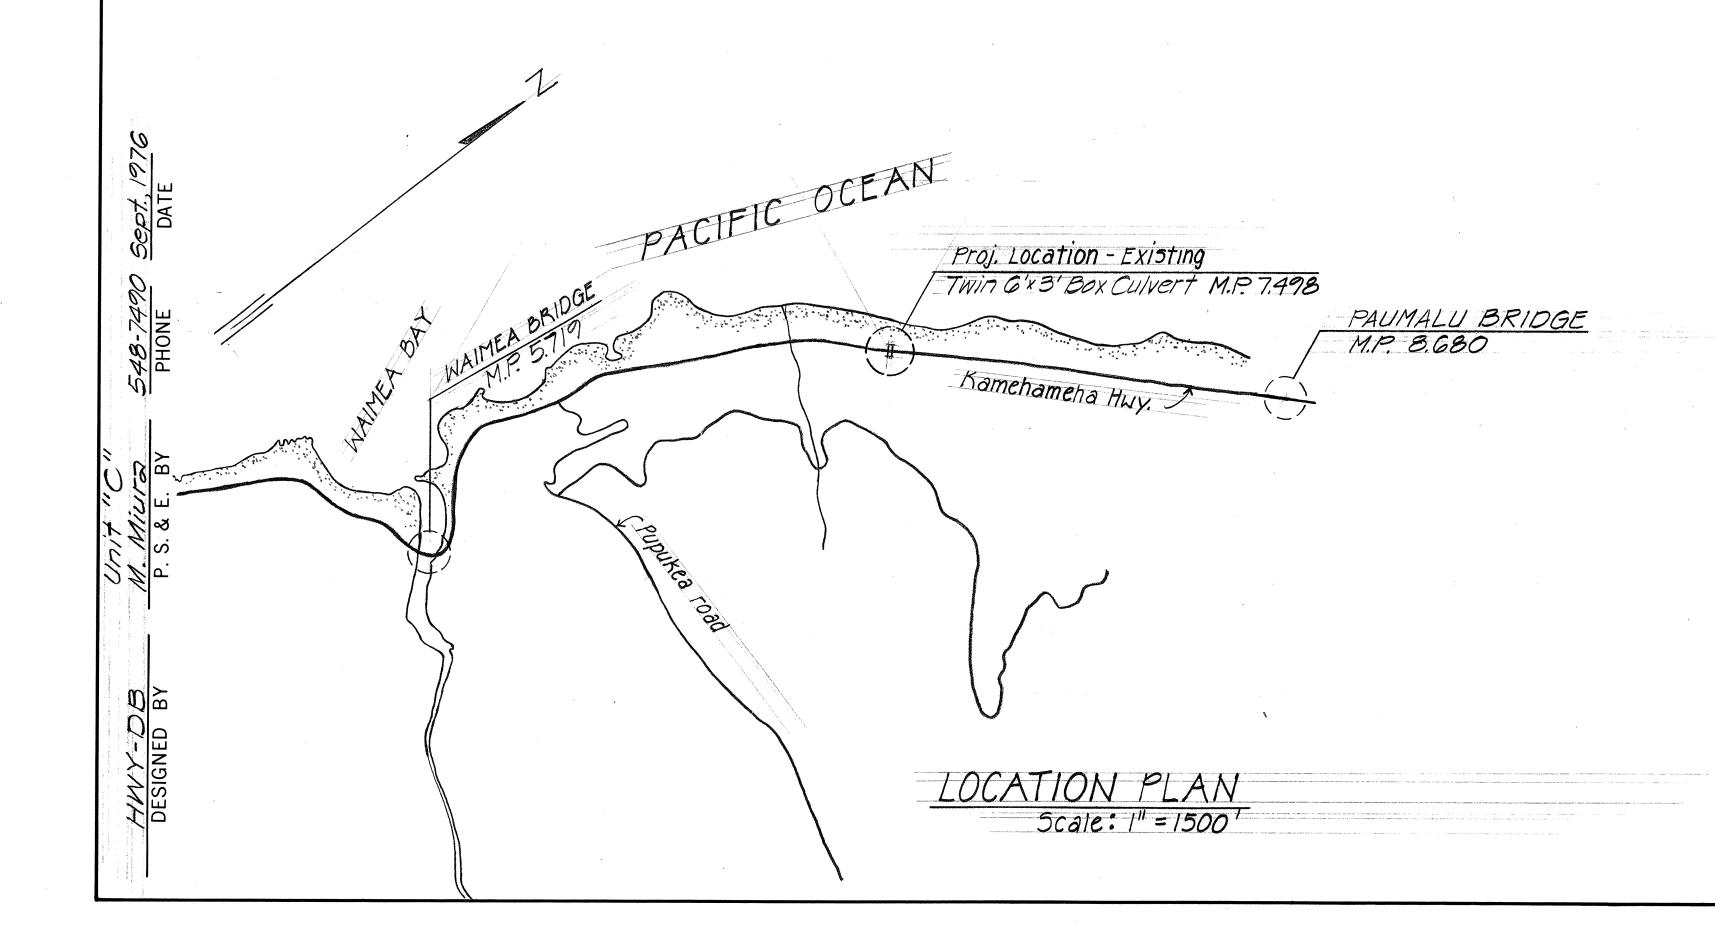

ALL CHANGES MADE DURING CONSTRUCTION HAVE BEEN INCORPORATED ON THESE PLANS IN RED EXCEPT CHANGES IN THE ORIGINAL THEORETICAL QUANTITIES. FOR ACTUAL QUANTITIES, REFER TO PROJECT LEDGER AND/OR COMPUTATION BOOK.

Sterling H. Morikawa RESIDENT ENGINEER

17 May 79 DATE

	DEPARTMENT OF TRANSPORTATION STATE OF HAWAII			
	APPROVED: R Higashionna	/ ,		
for	DIR. OF TRANSPORTATION	11/30/76 DATE		