
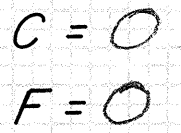
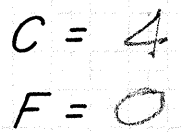
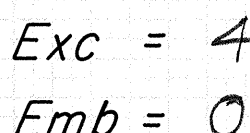
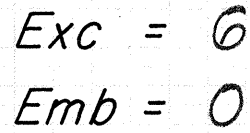
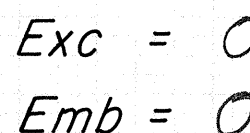
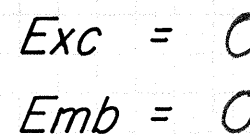


FED. ROAD DIST. NO.	STATE	FED. AID PROJ. NO.	FISCAL YEAR	SHEET NO.	TOTAL SHEET
HAWAII	HAW.	838-01-77M	1977	15	20

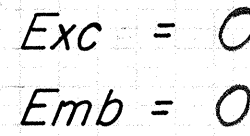


15

FED. ROAD DIST. NO.	STATE	FED. AID PROJ. NO.	FISCAL YEAR	SHEET NO.	TOTAL SHEETS
HAWAII	HAW.	83B-01-77M	1977	16	20

DESIGNED BY	DATE
DRAWN BY	
CHECKED BY	
IN CHARGE	
NOTED BY	
NO.	


DESIGNED BY	DATE
DRAWN BY	
CHECKED BY	
IN CHARGE	
NOTED BY	
NO.	

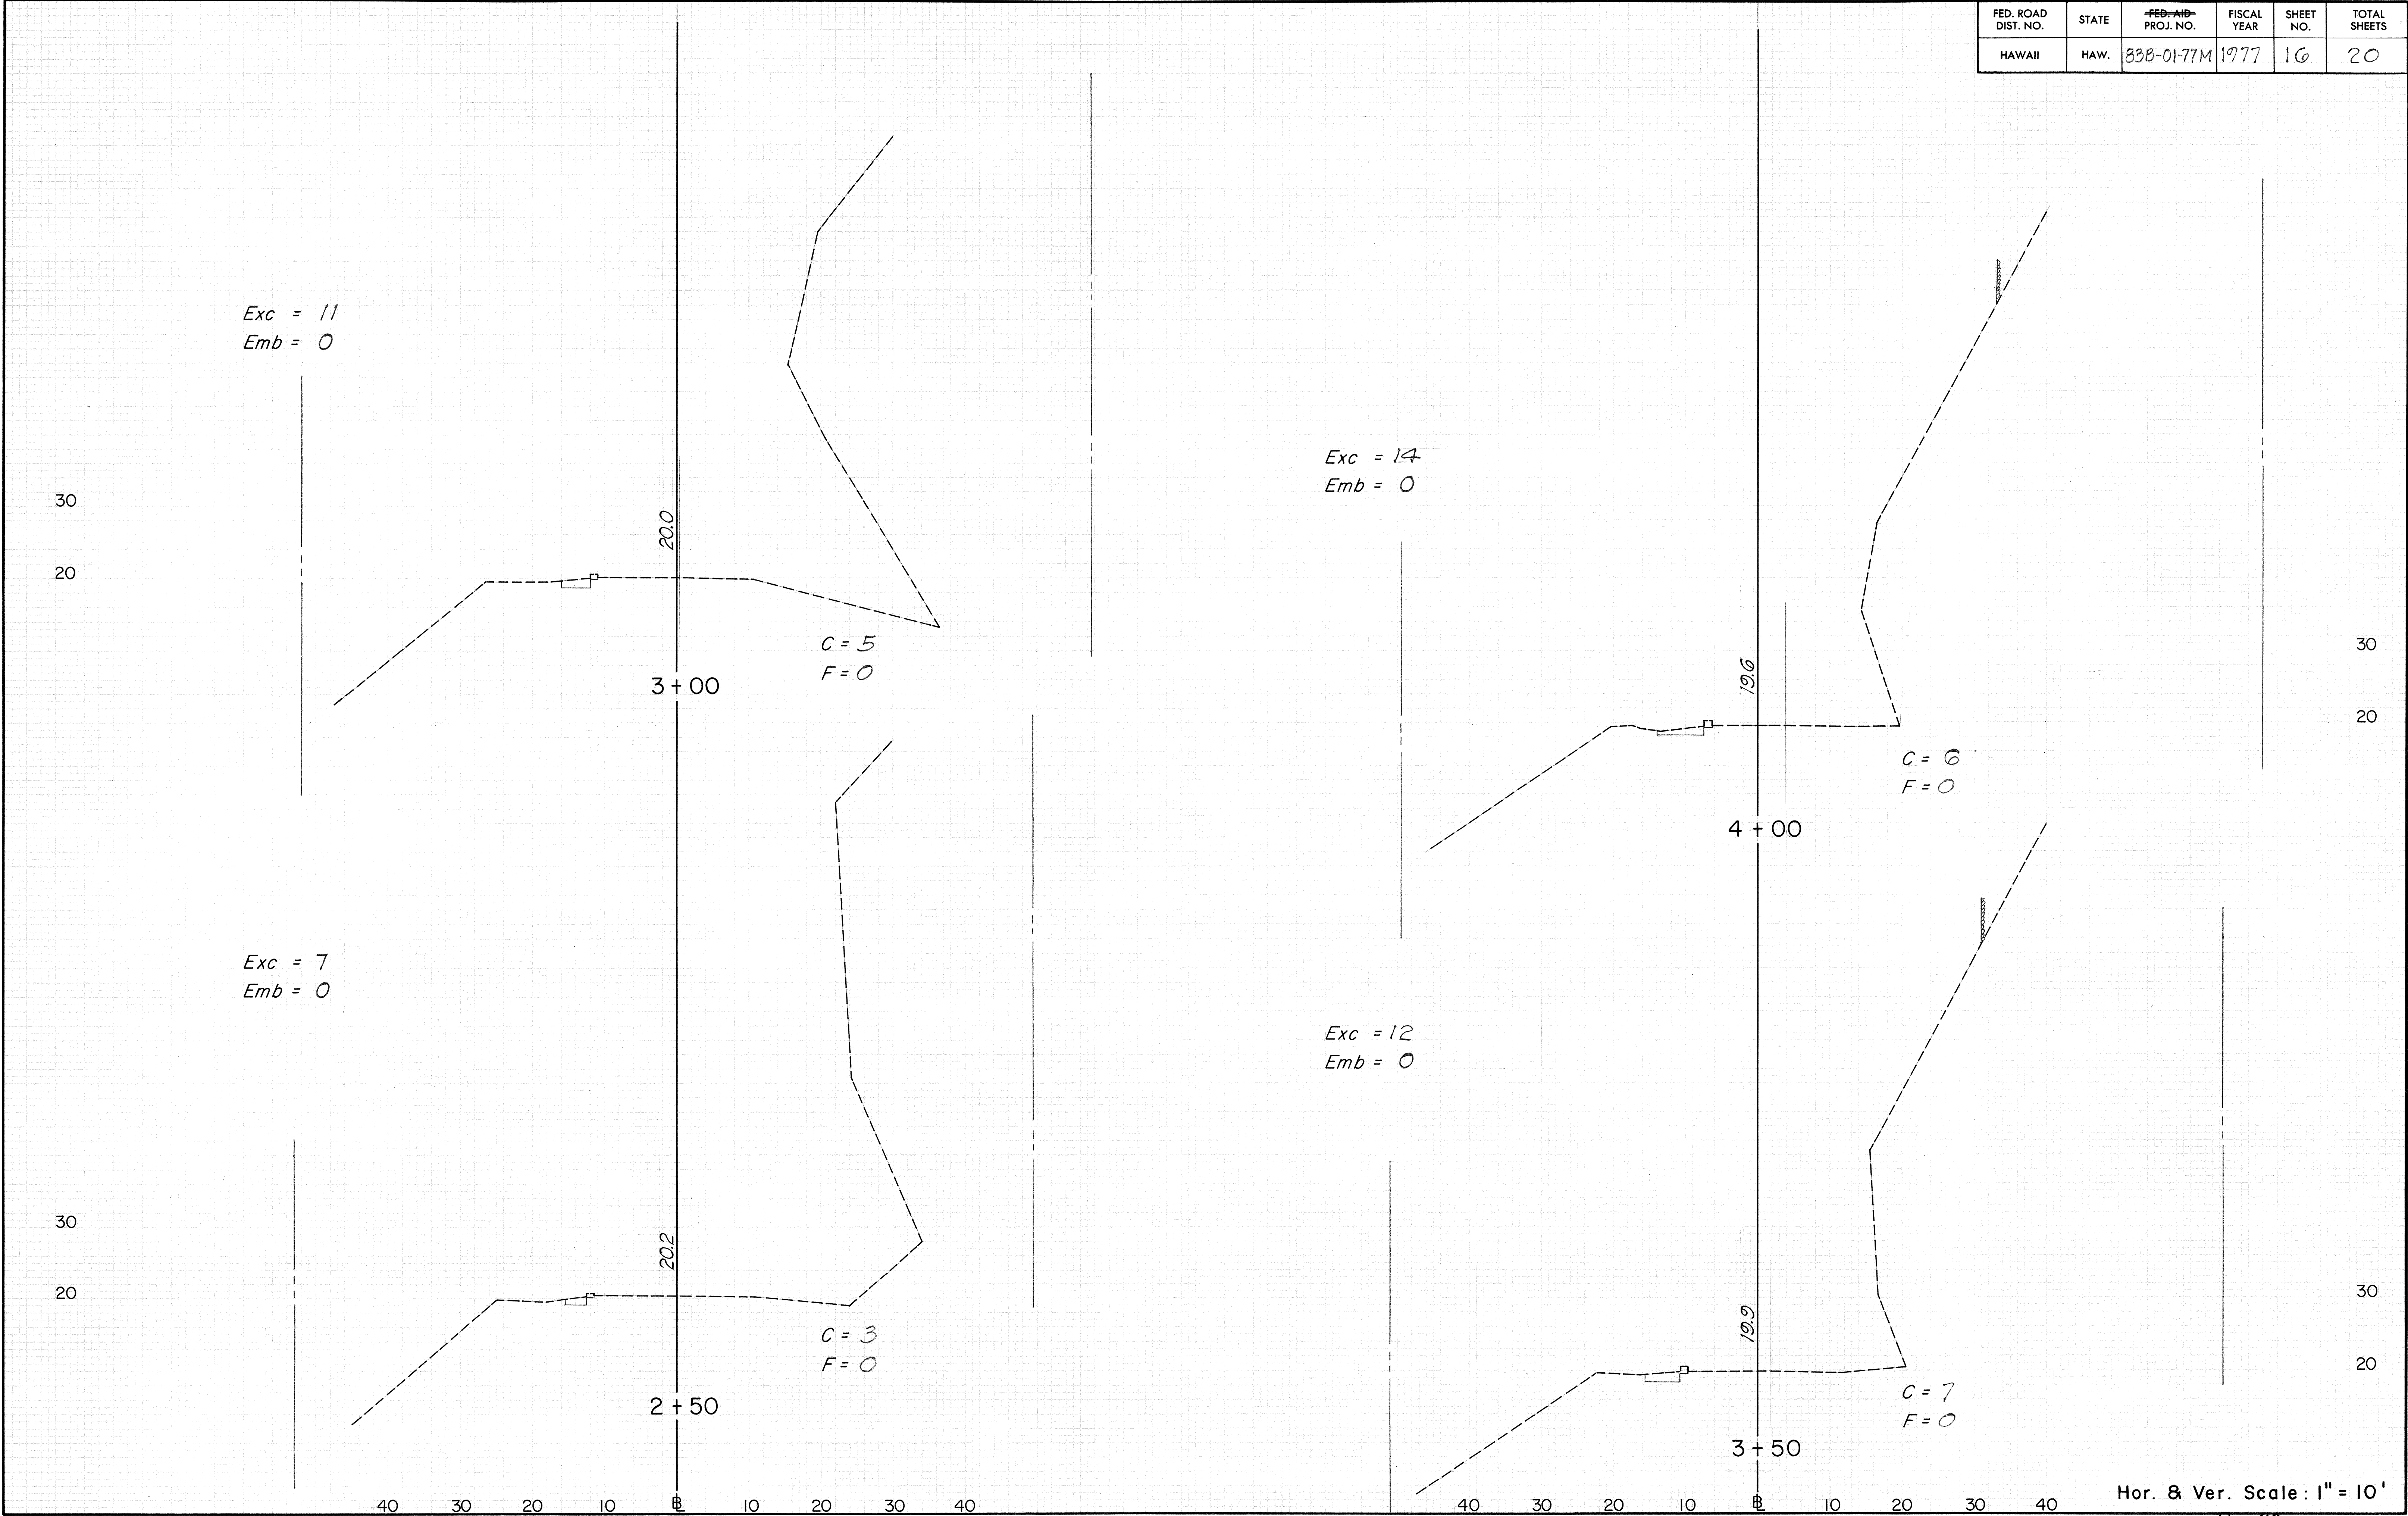

FED. ROAD DIST. NO.	STATE	FED. AID PROJ. NO.	FISCAL YEAR	SHEET NO.	TOTAL SHEETS
HAWAII	HAW.	83B-01-77M	1977	17	20

ORIGINAL SURVEY	DATE
NO.	BY
NOTE BOOK	NO.
AREA	NO.

ORIGINAL SURVEY	DATE
NO.	BY
NOTE BOOK	NO.
AREA	NO.

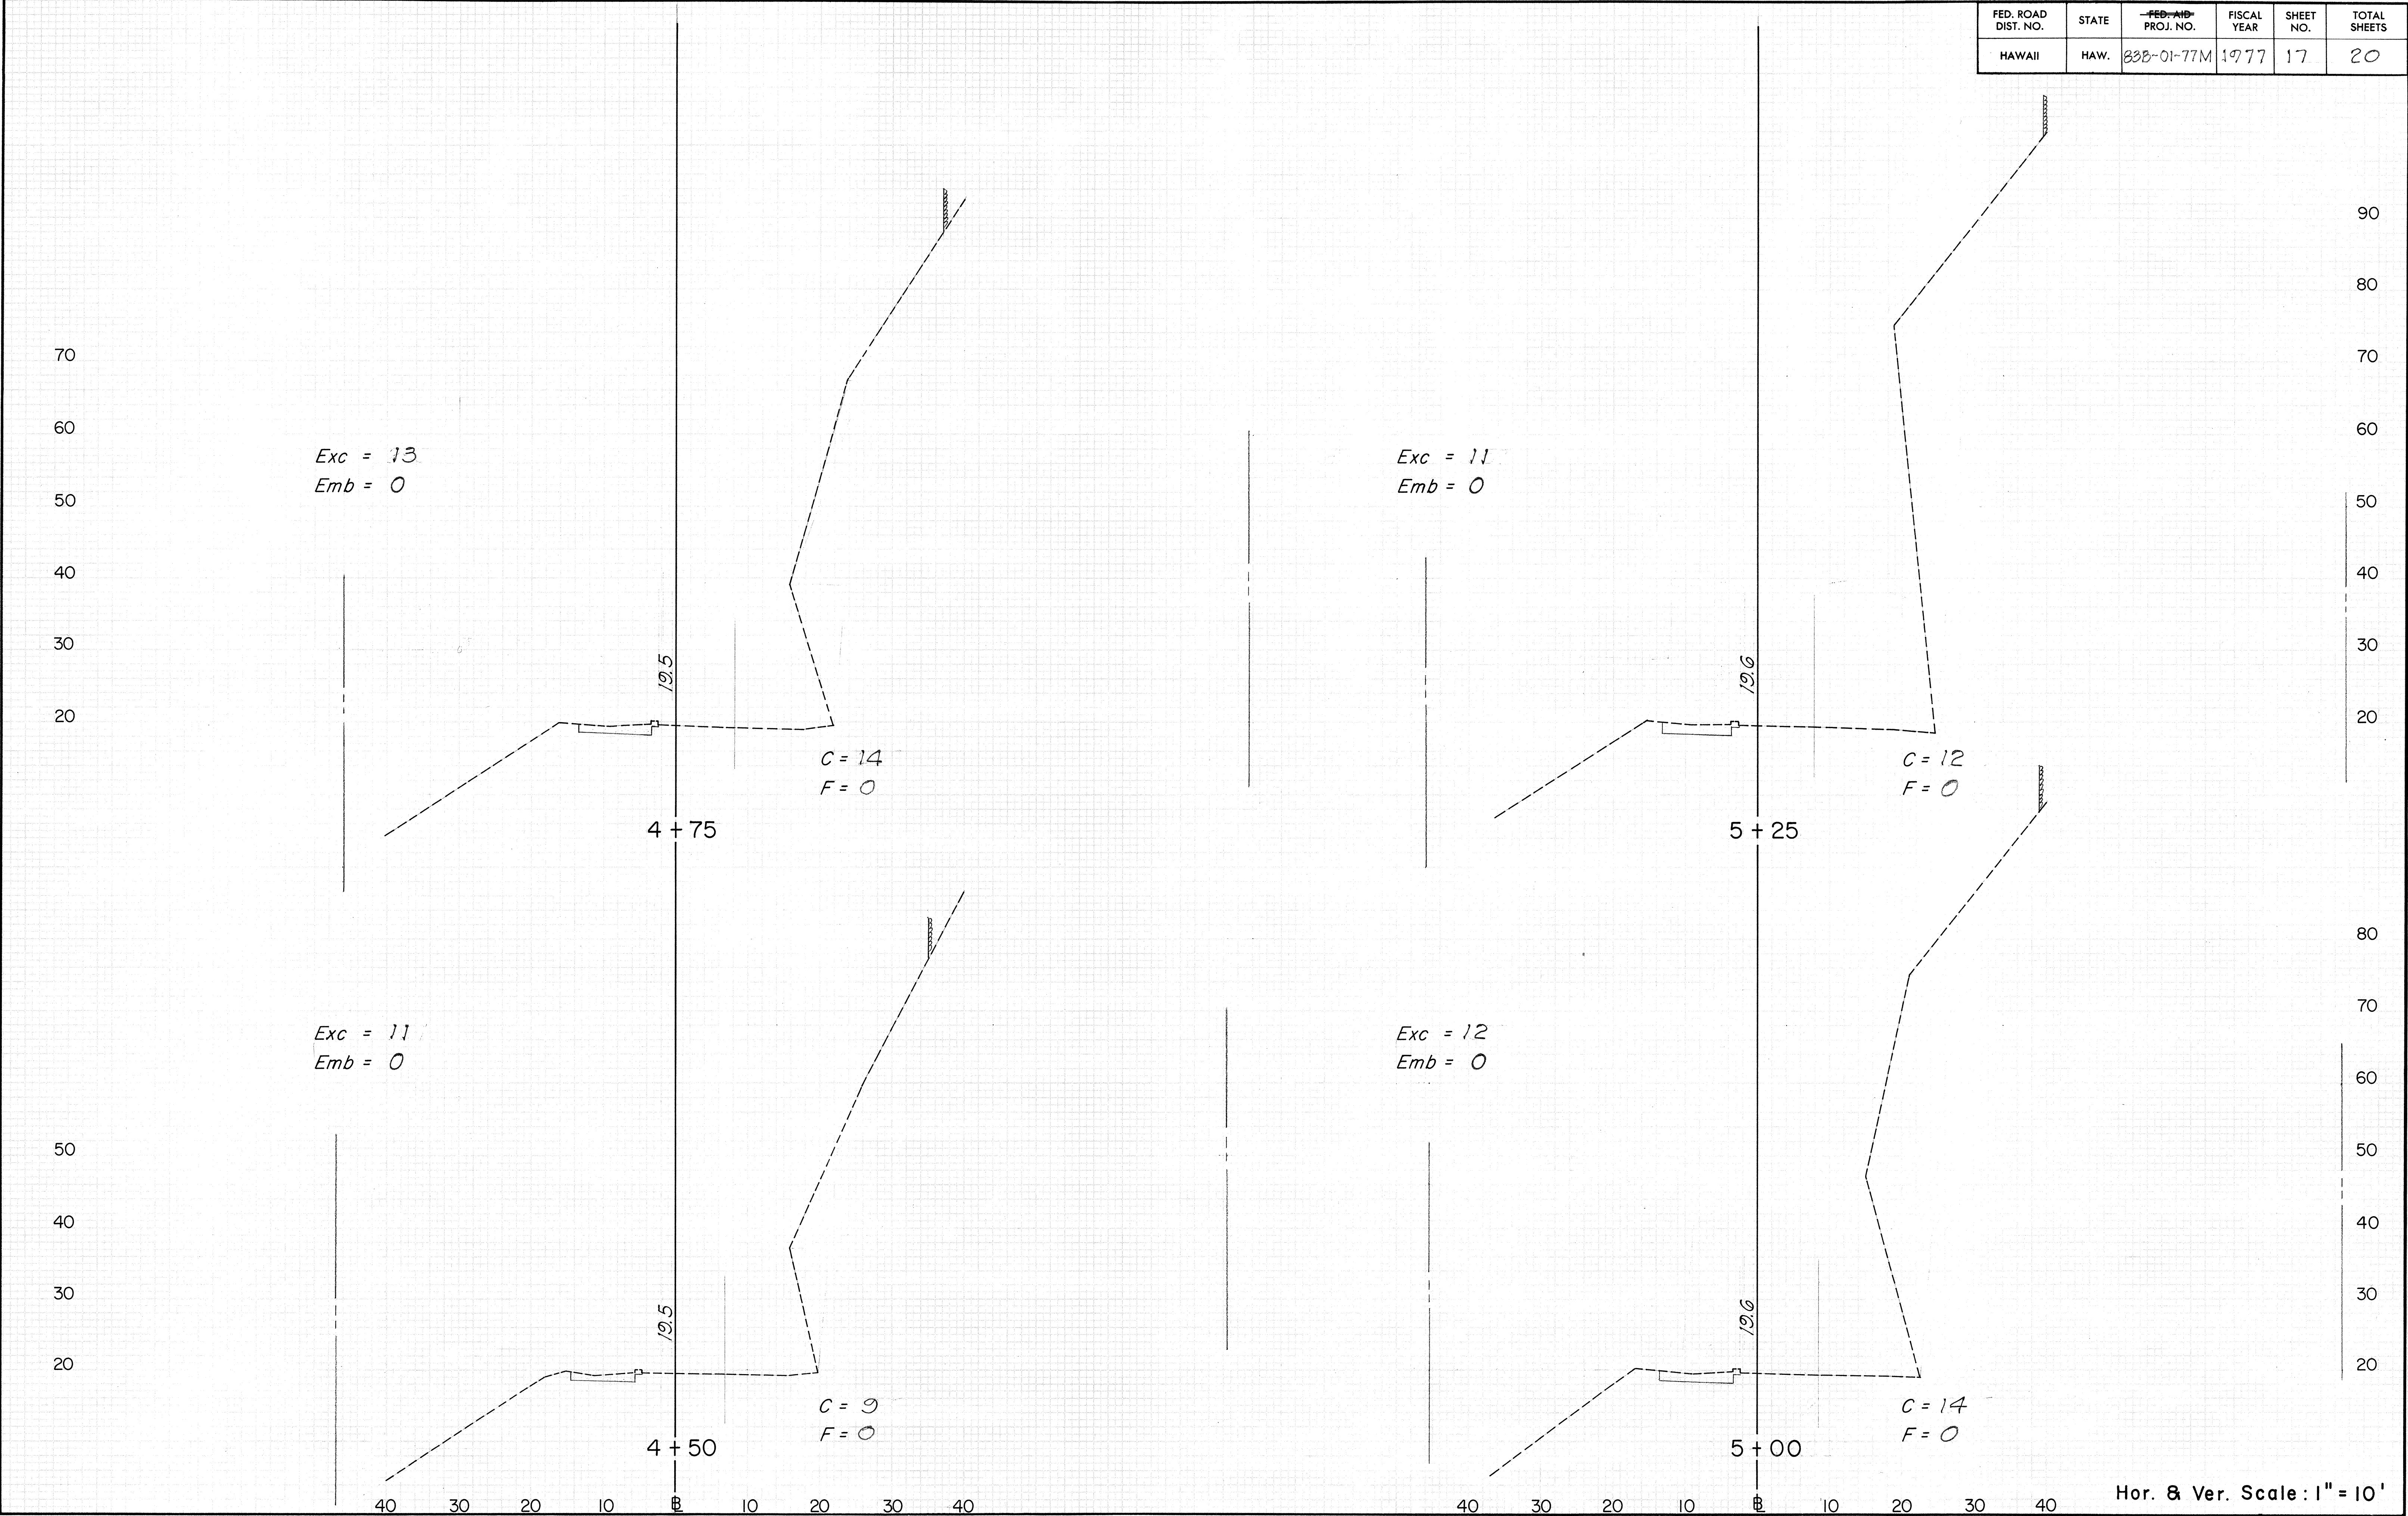


FED. ROAD DIST. NO.	STATE	FED. AID PROJ. NO.	FISCAL YEAR	SHEET NO.	TOTAL SHEETS
HAWAII	HAW.	83B-01-77M	1977	18	20


DESIGNED BY	DATE
CHECKED BY	
APPROVED BY	
PROJECT NO.	
SECTION NO.	
DATE	

DESIGNED BY	DATE
CHECKED BY	
APPROVED BY	
PROJECT NO.	
SECTION NO.	
DATE	




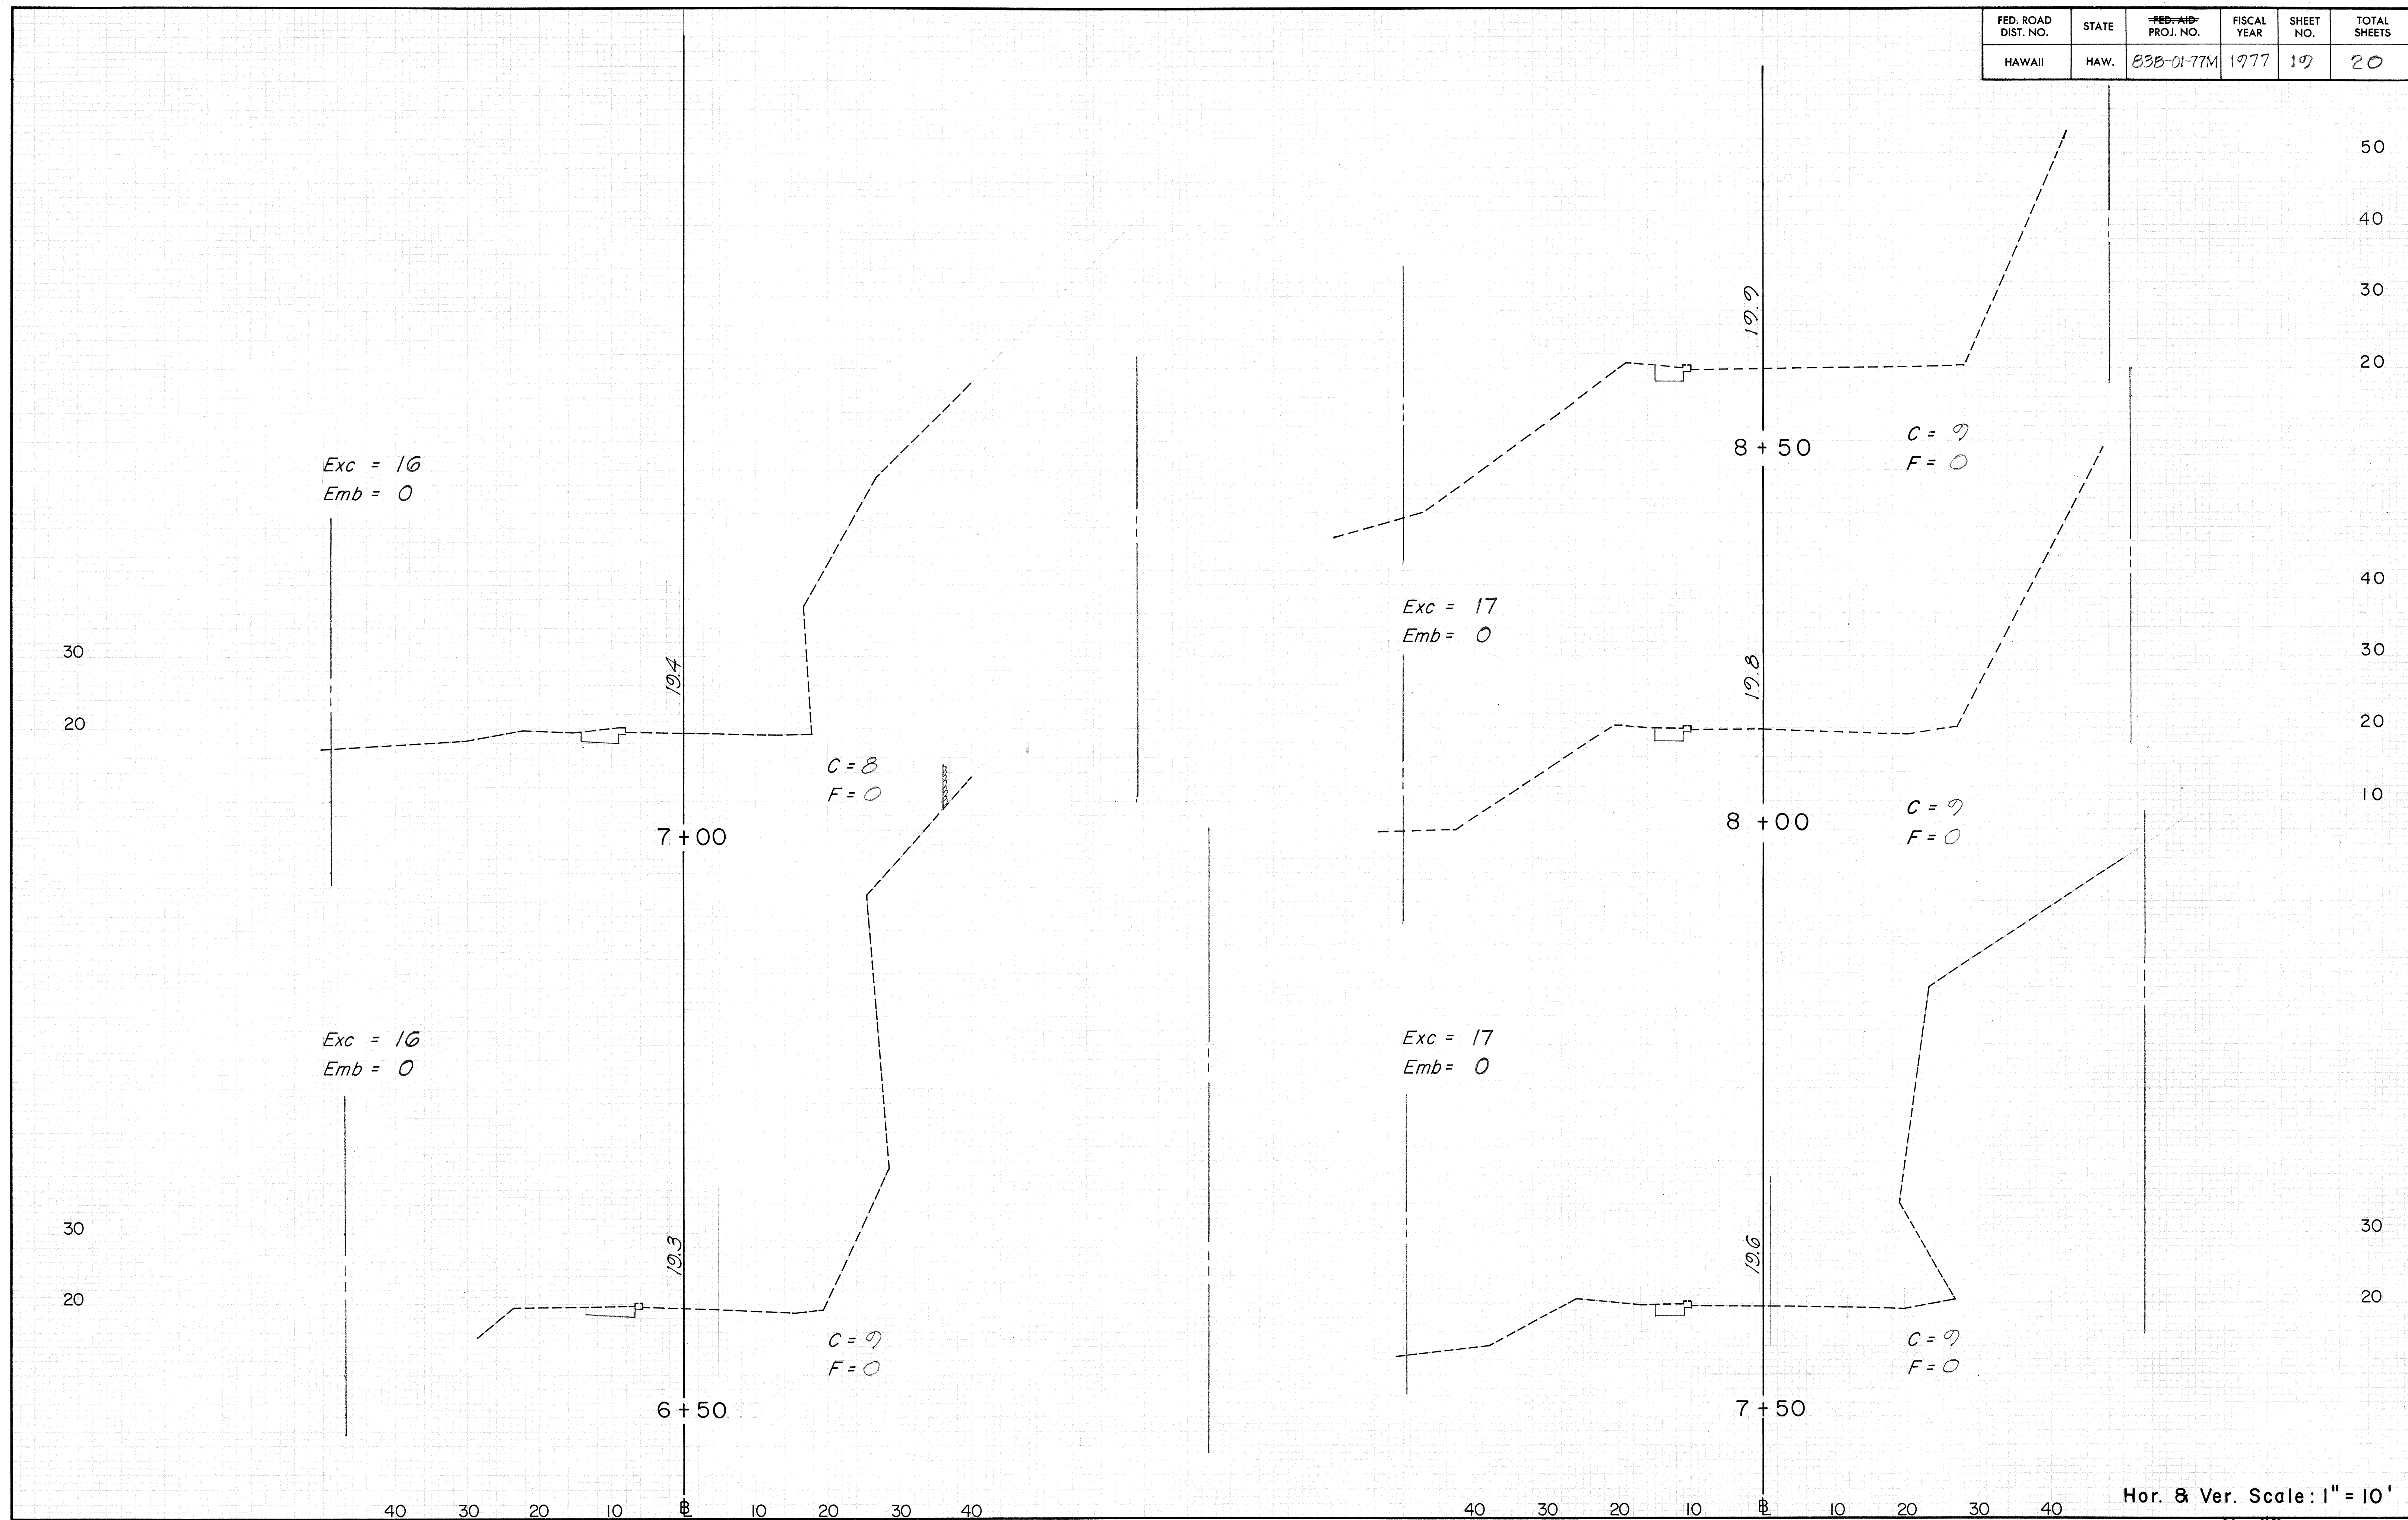

FED. ROAD DIST. NO.	STATE	PROJ. NO.	FISCAL YEAR	SHEET NO.	TOTAL SHEETS
HAWAII	HAW.	638-01-71M	1977	20	20

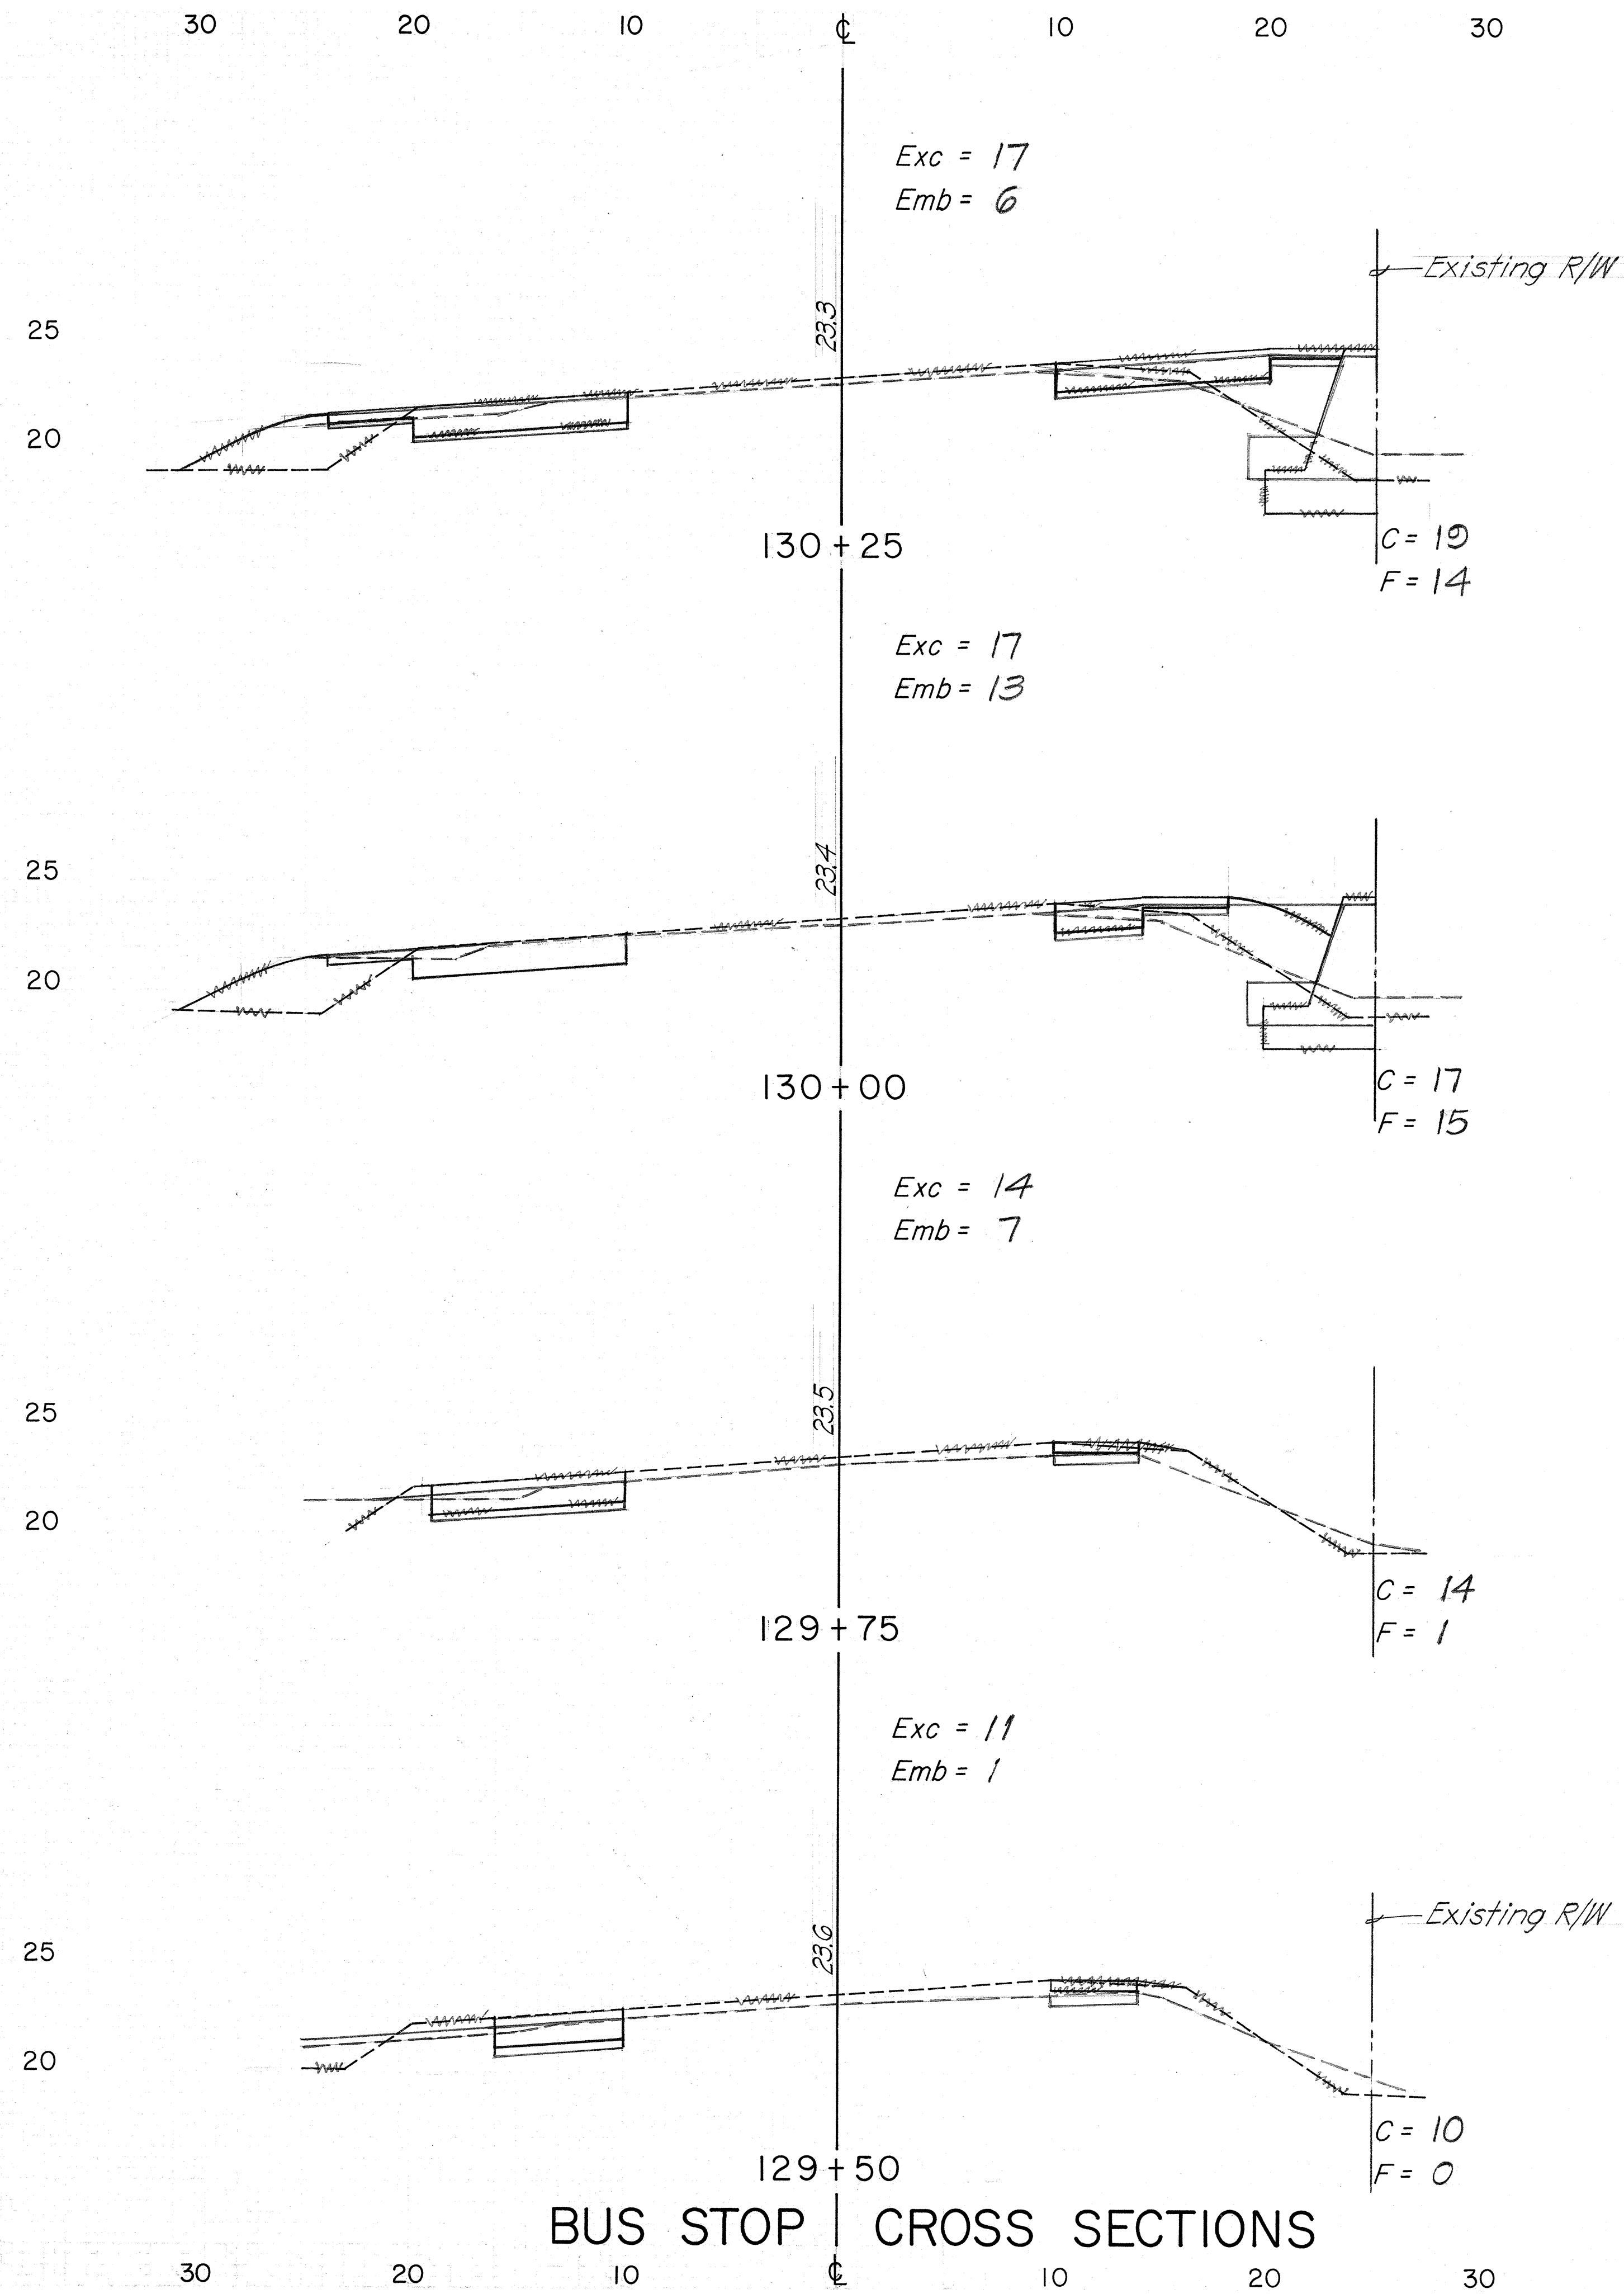

BUS STOP CROSS SECTIONS

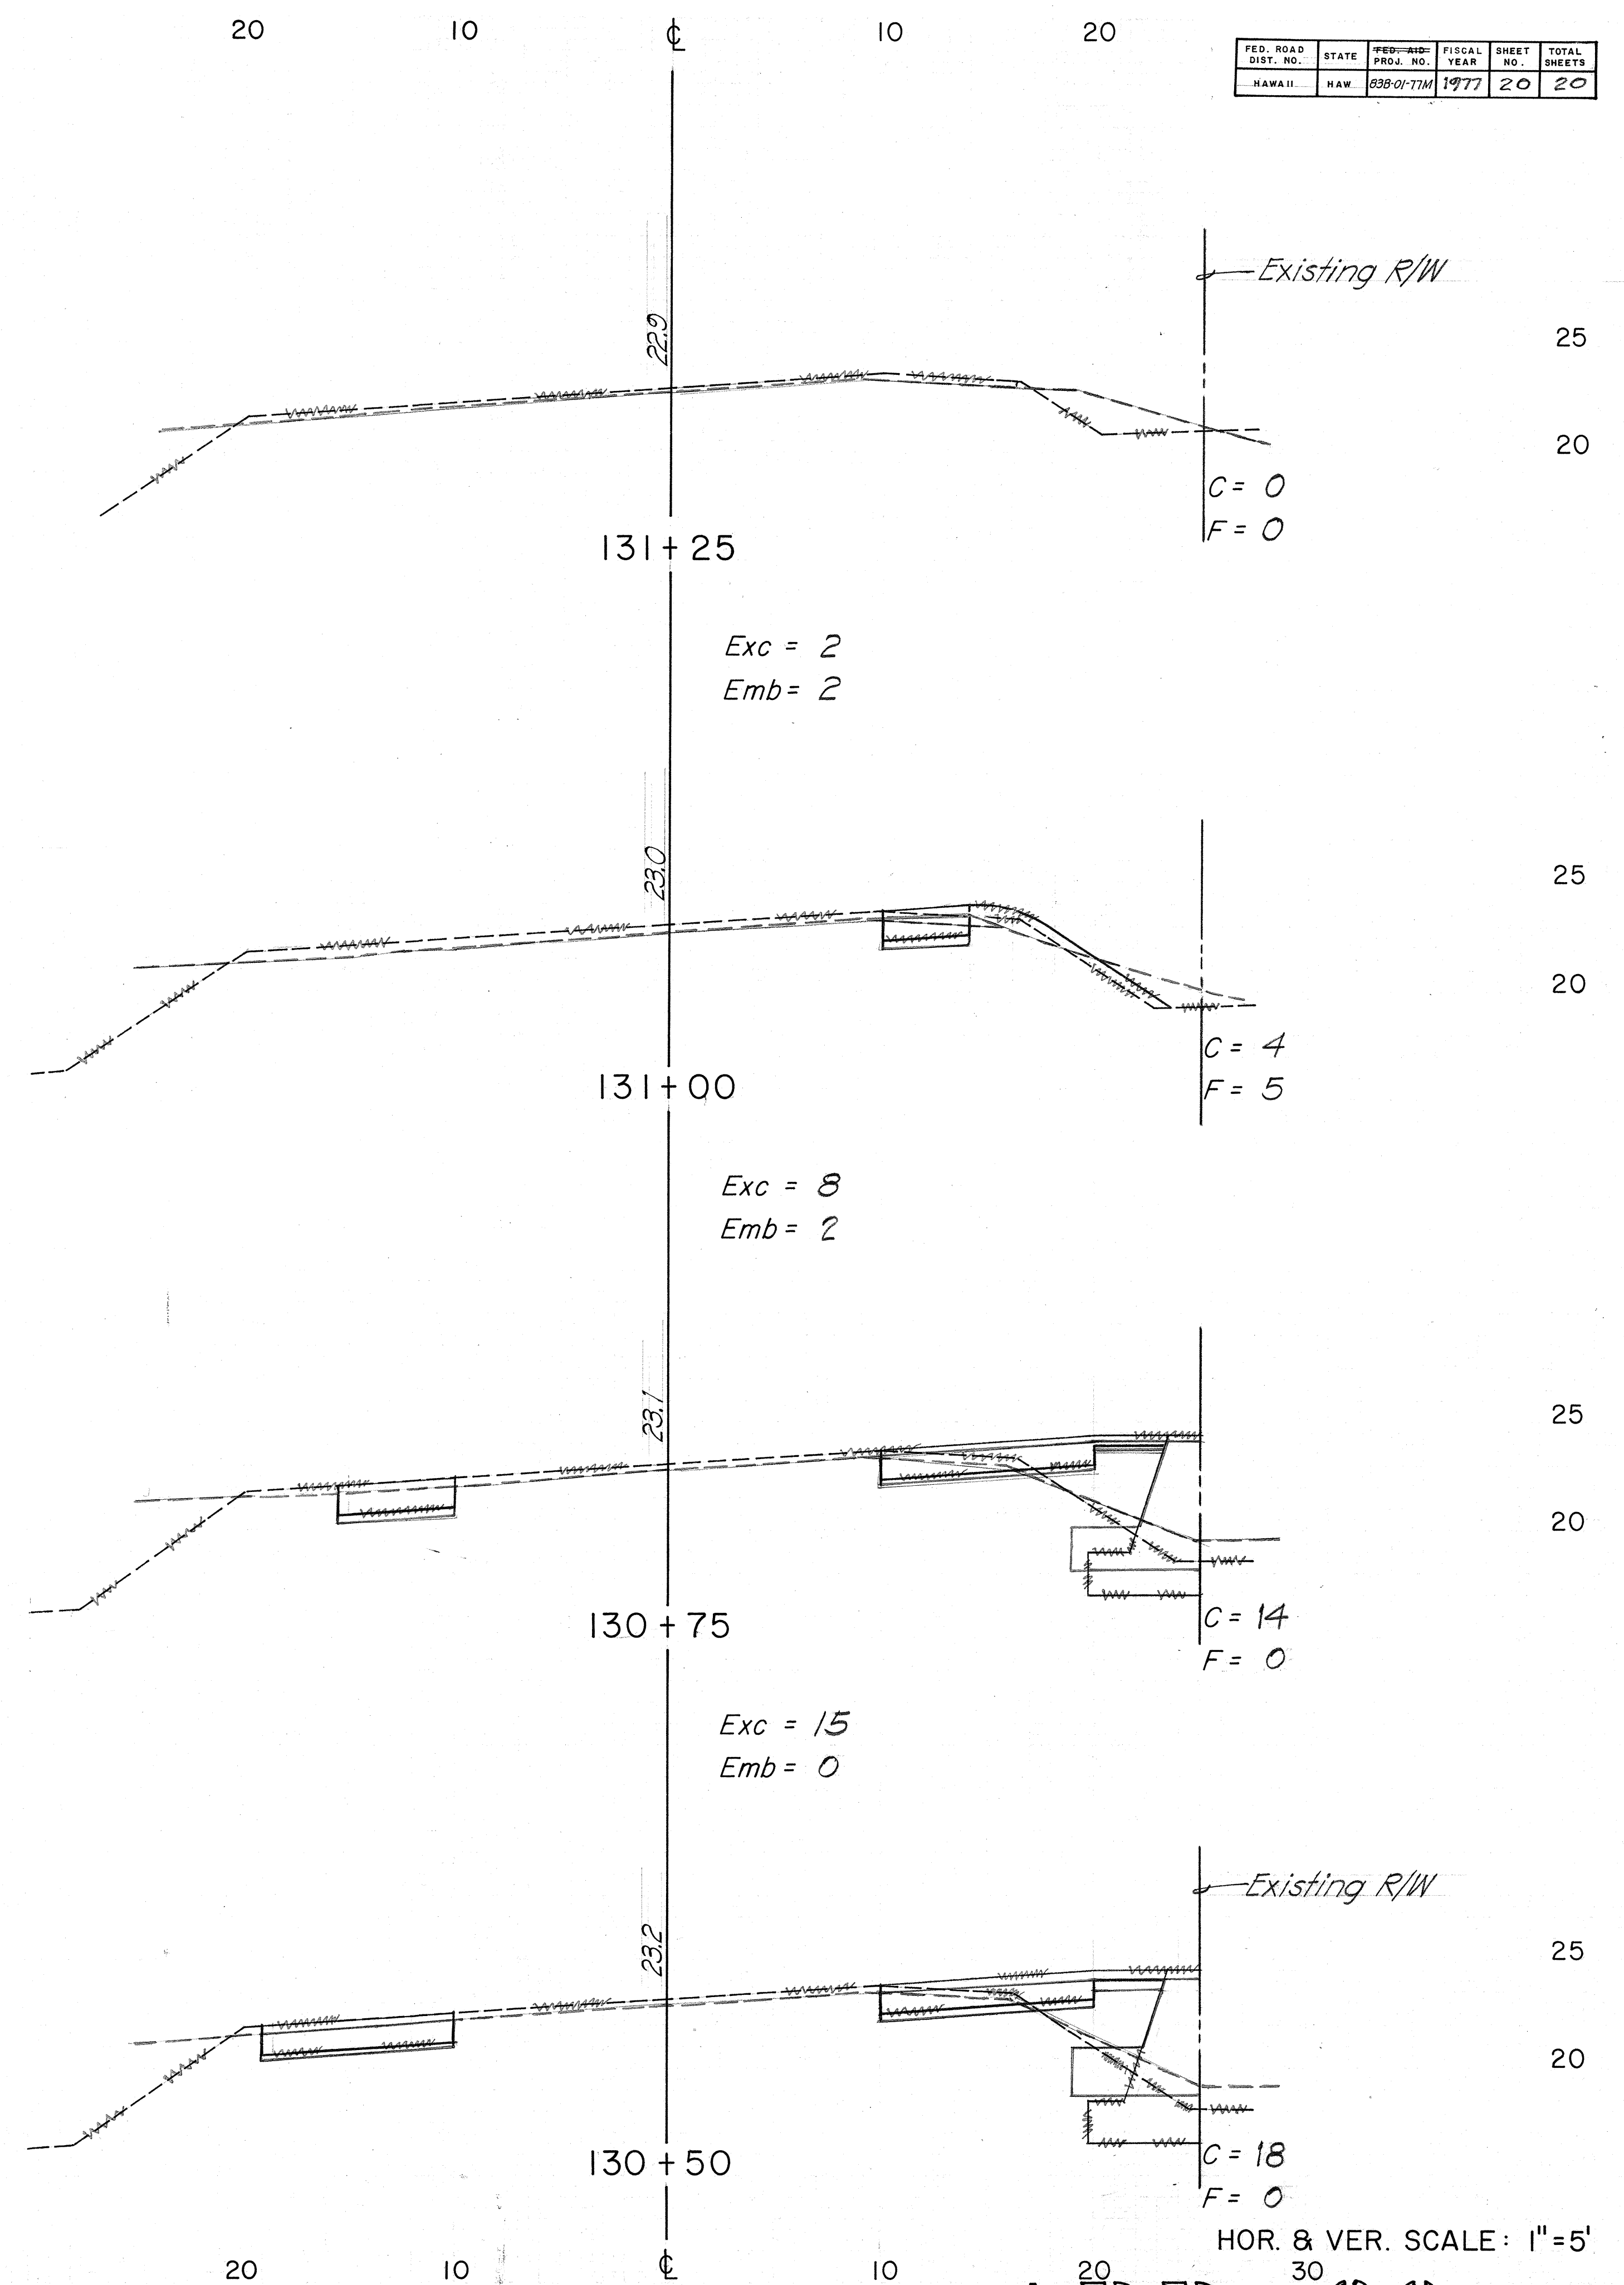

HOR. & VER. SCALE: 1"=5'

ADD. 20