
In	NDEX TO DRAWINGS
SHEET NO.	DESCRIPTION
	TITLE SHEET
2-3	TYPICAL SECTIONS & PLAN
4-14	STANDARD DETAILS
15 - 20	CROSS SECTIONS
¢.	
	,



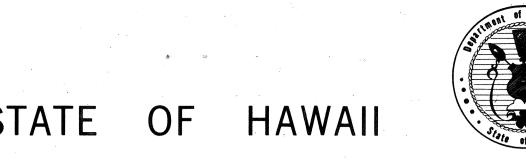

STATE OF

OF TRANSPORTATION DEPARTMENT LAND TRANSPORTATION FACILITIES DIVISION


> HONOLULU, HAWAII "AS - BUILT" PLANS FOR


KAMEHAMEHA HIGHWAY

IMPROVEMENTS FOR WAIMEA BAY ROCK OVERHANG

NO. 83B - 01 - 77M PROJECT

DISTRICT KOOLAULOA ISLAND OF OAHU

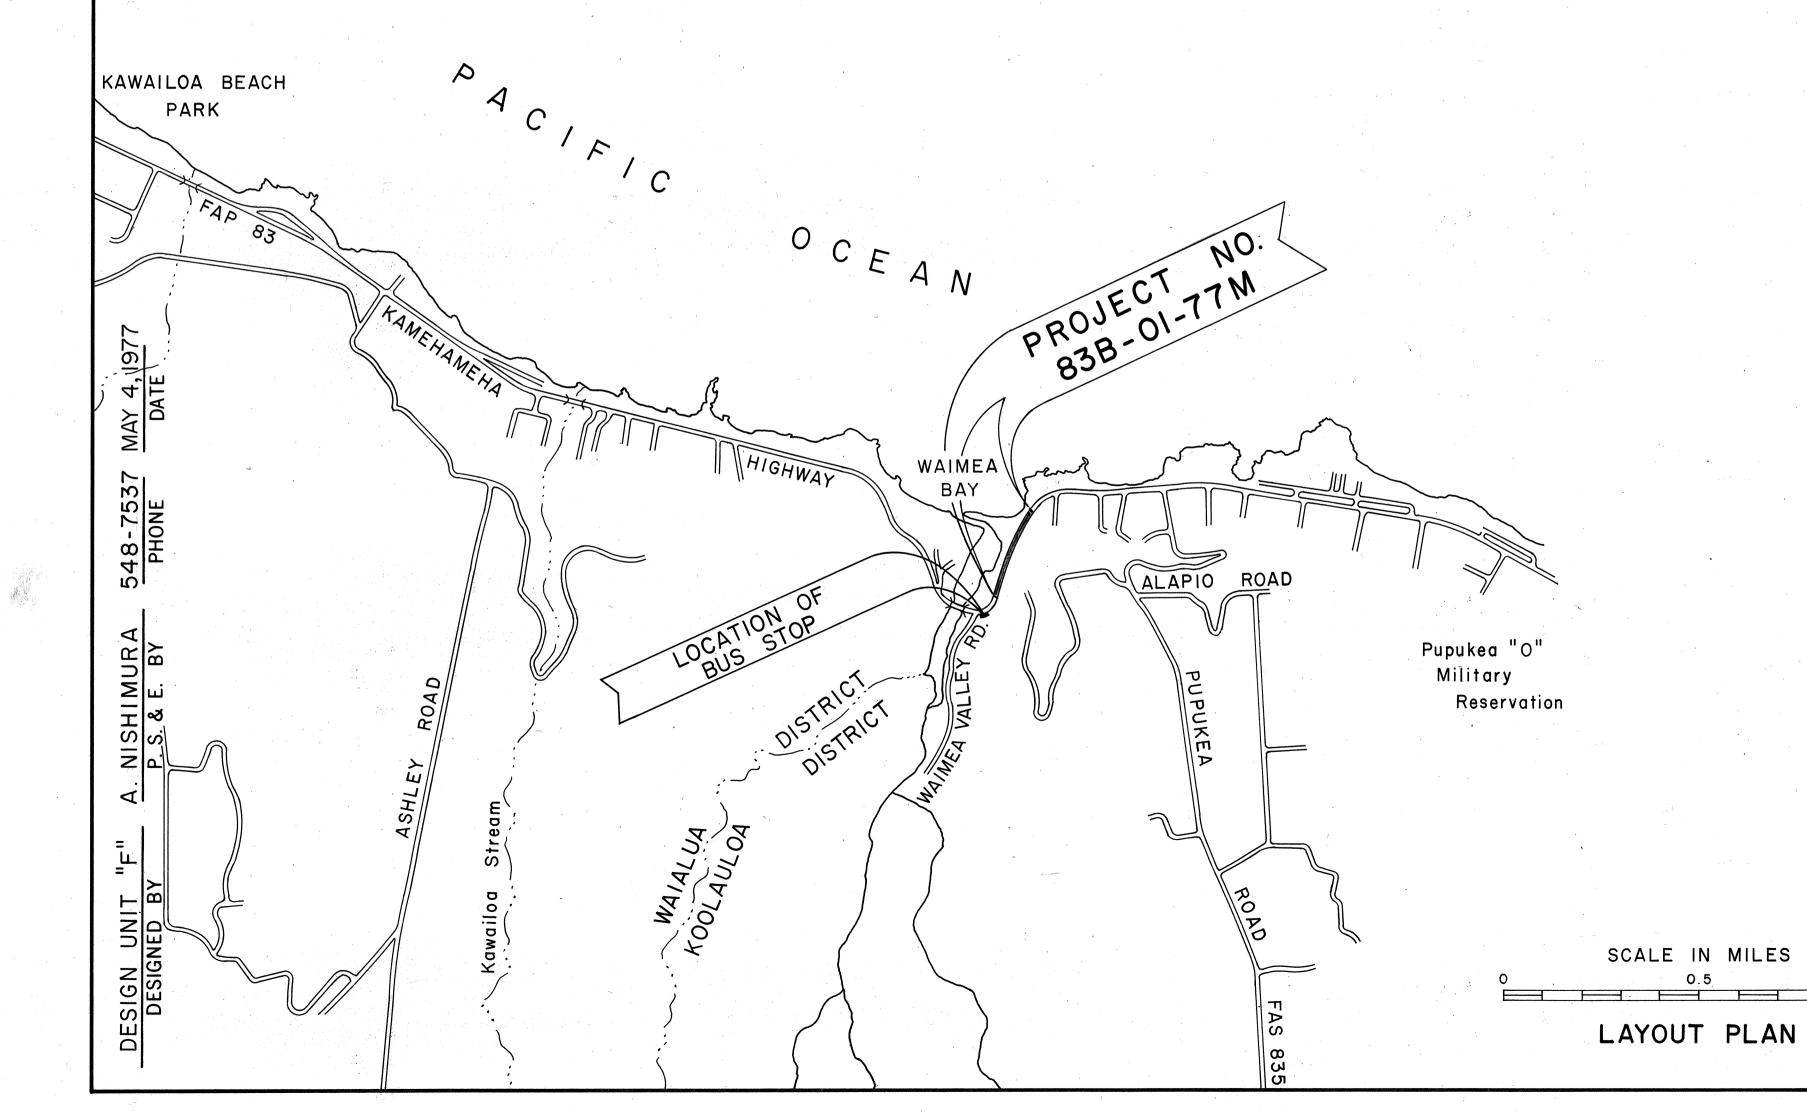

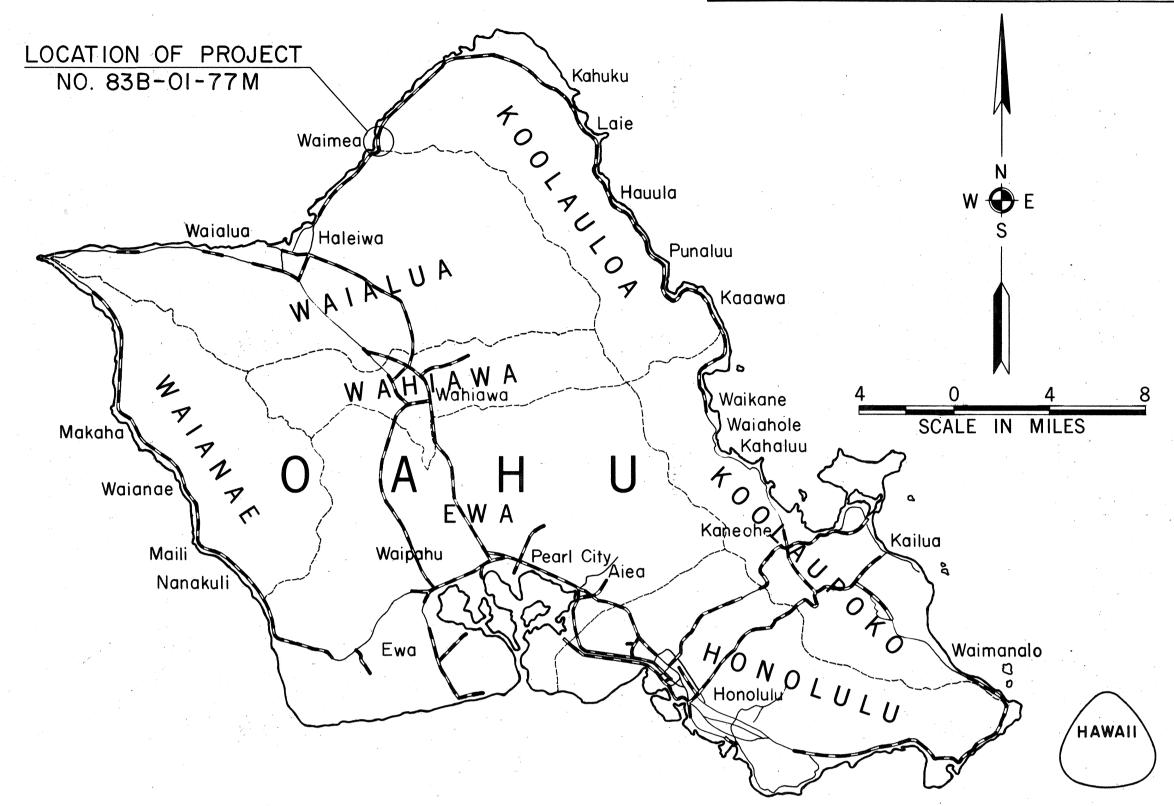

ALL CHANGES MADE DURING CONSTRUCTION HAVE EXCEPT CHANGES IN THE ORIGINAL THEORETICAL QUANTITIES. FOR ACTUAL QUANTITIES, REFER TO PROJECT LEDGER AND/OR COMPUTATION BOOK.

Federal Aid Projects Previously Constructed or Under Construction

10-25-18 DATE

FED. ROAD STATE PROJ. NO. FISCAL SHEET TOTAL YEAR NO. SHEETS

HAW. 83B-01-77M 1977

DEPARTMENT OF TRANSPORTATION STATE OF HAWAII APPROVED:

DIR. OF TRANSPORTATION

5/20/77