
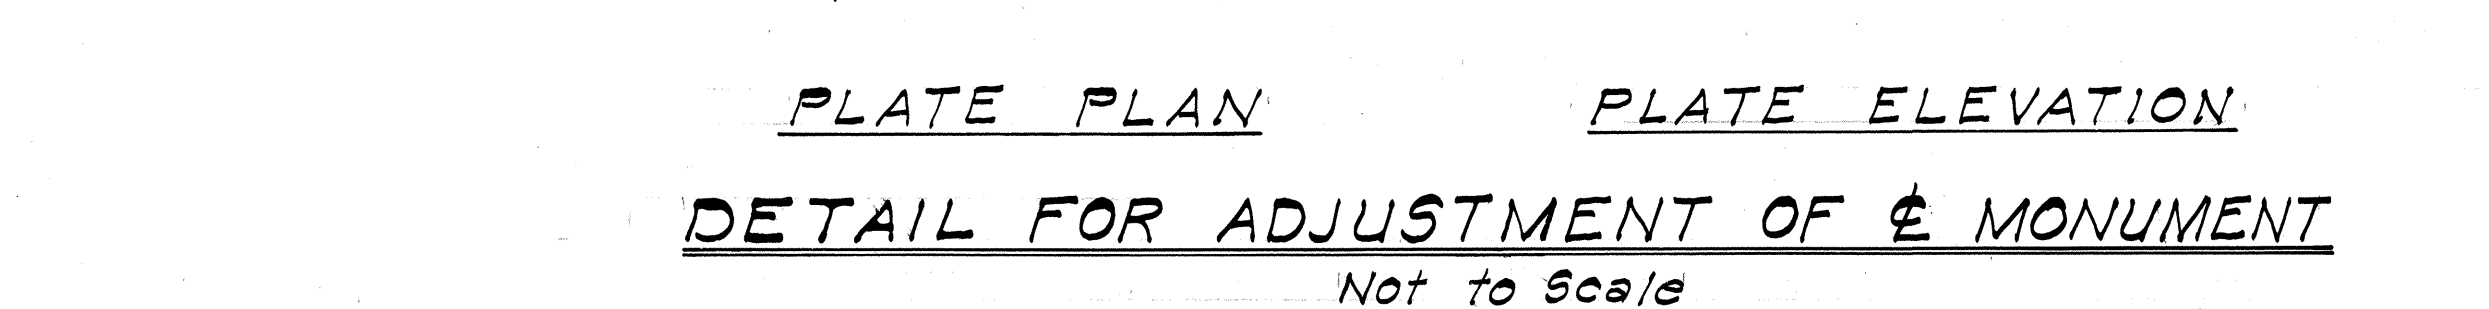
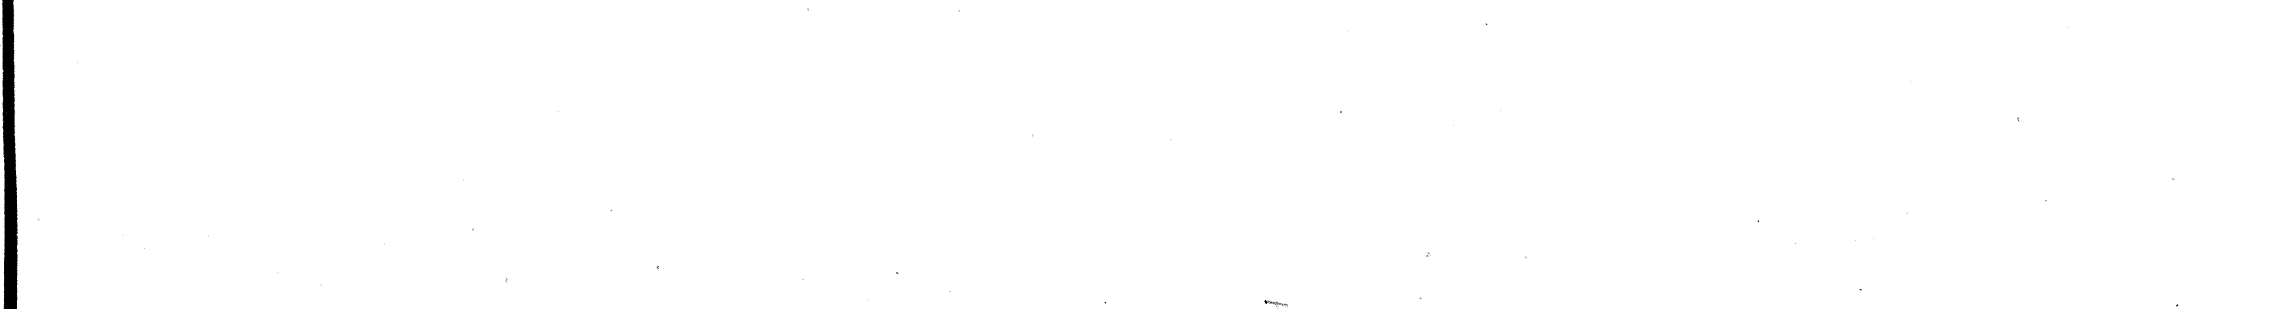
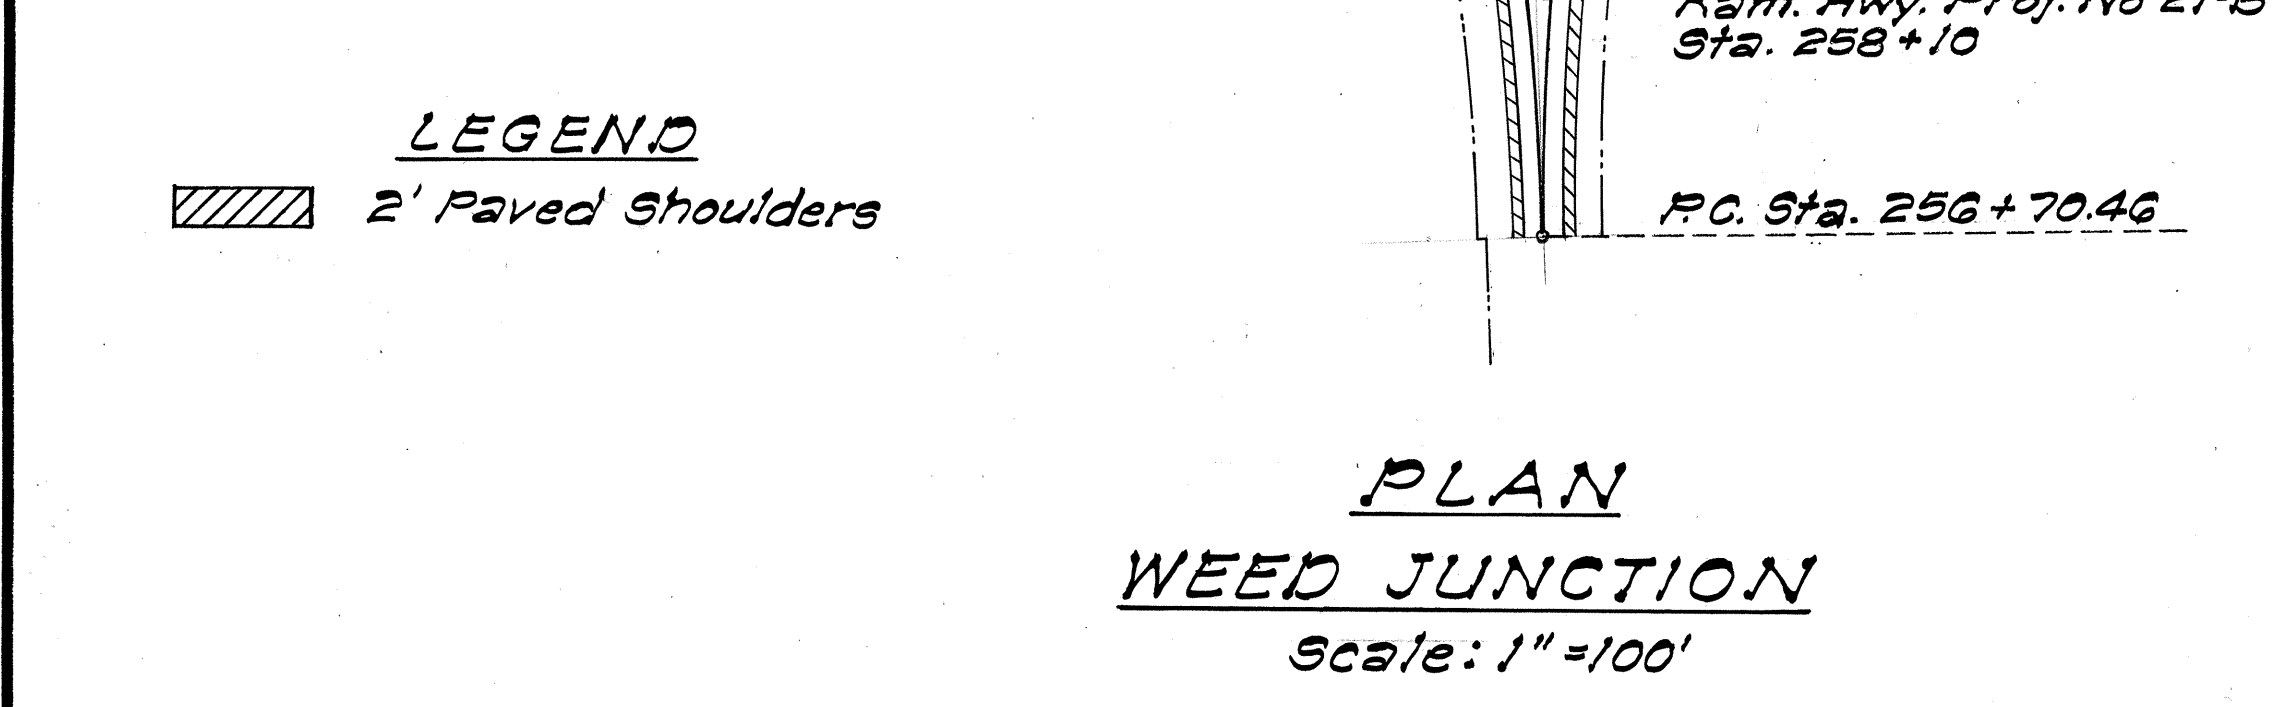
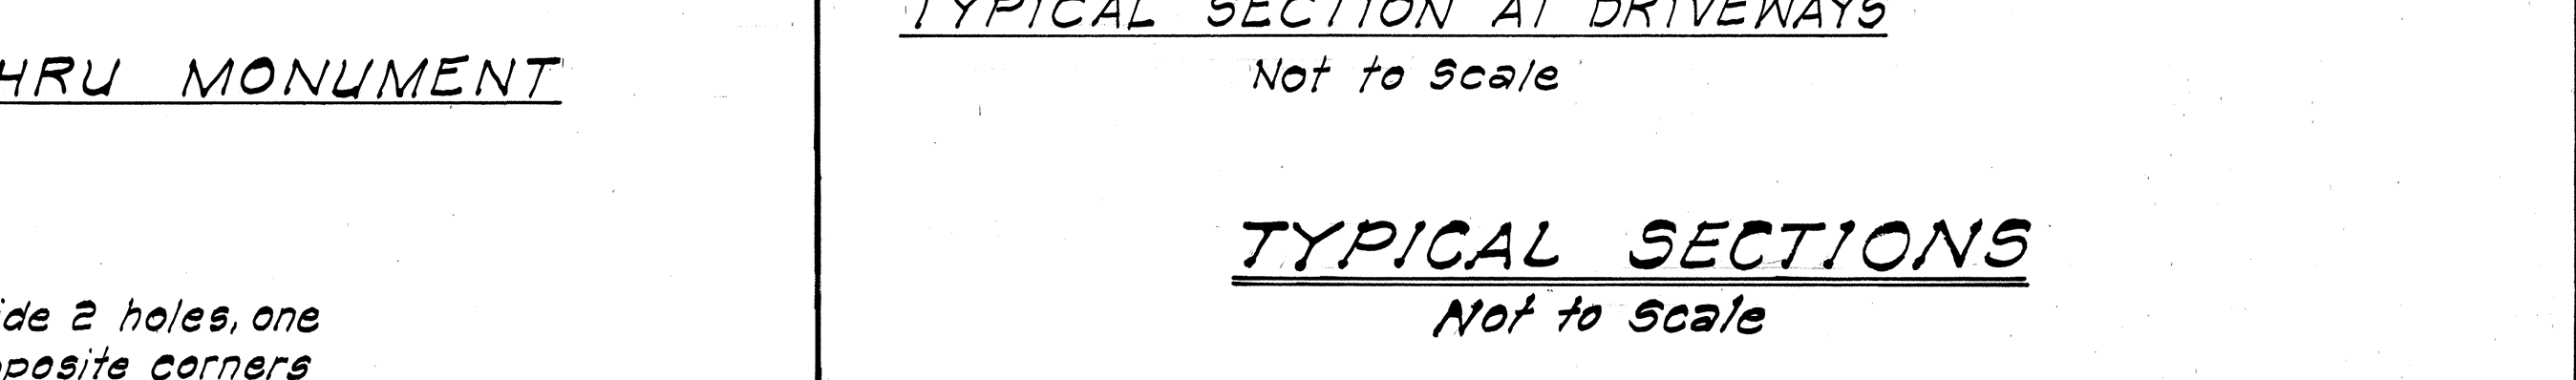
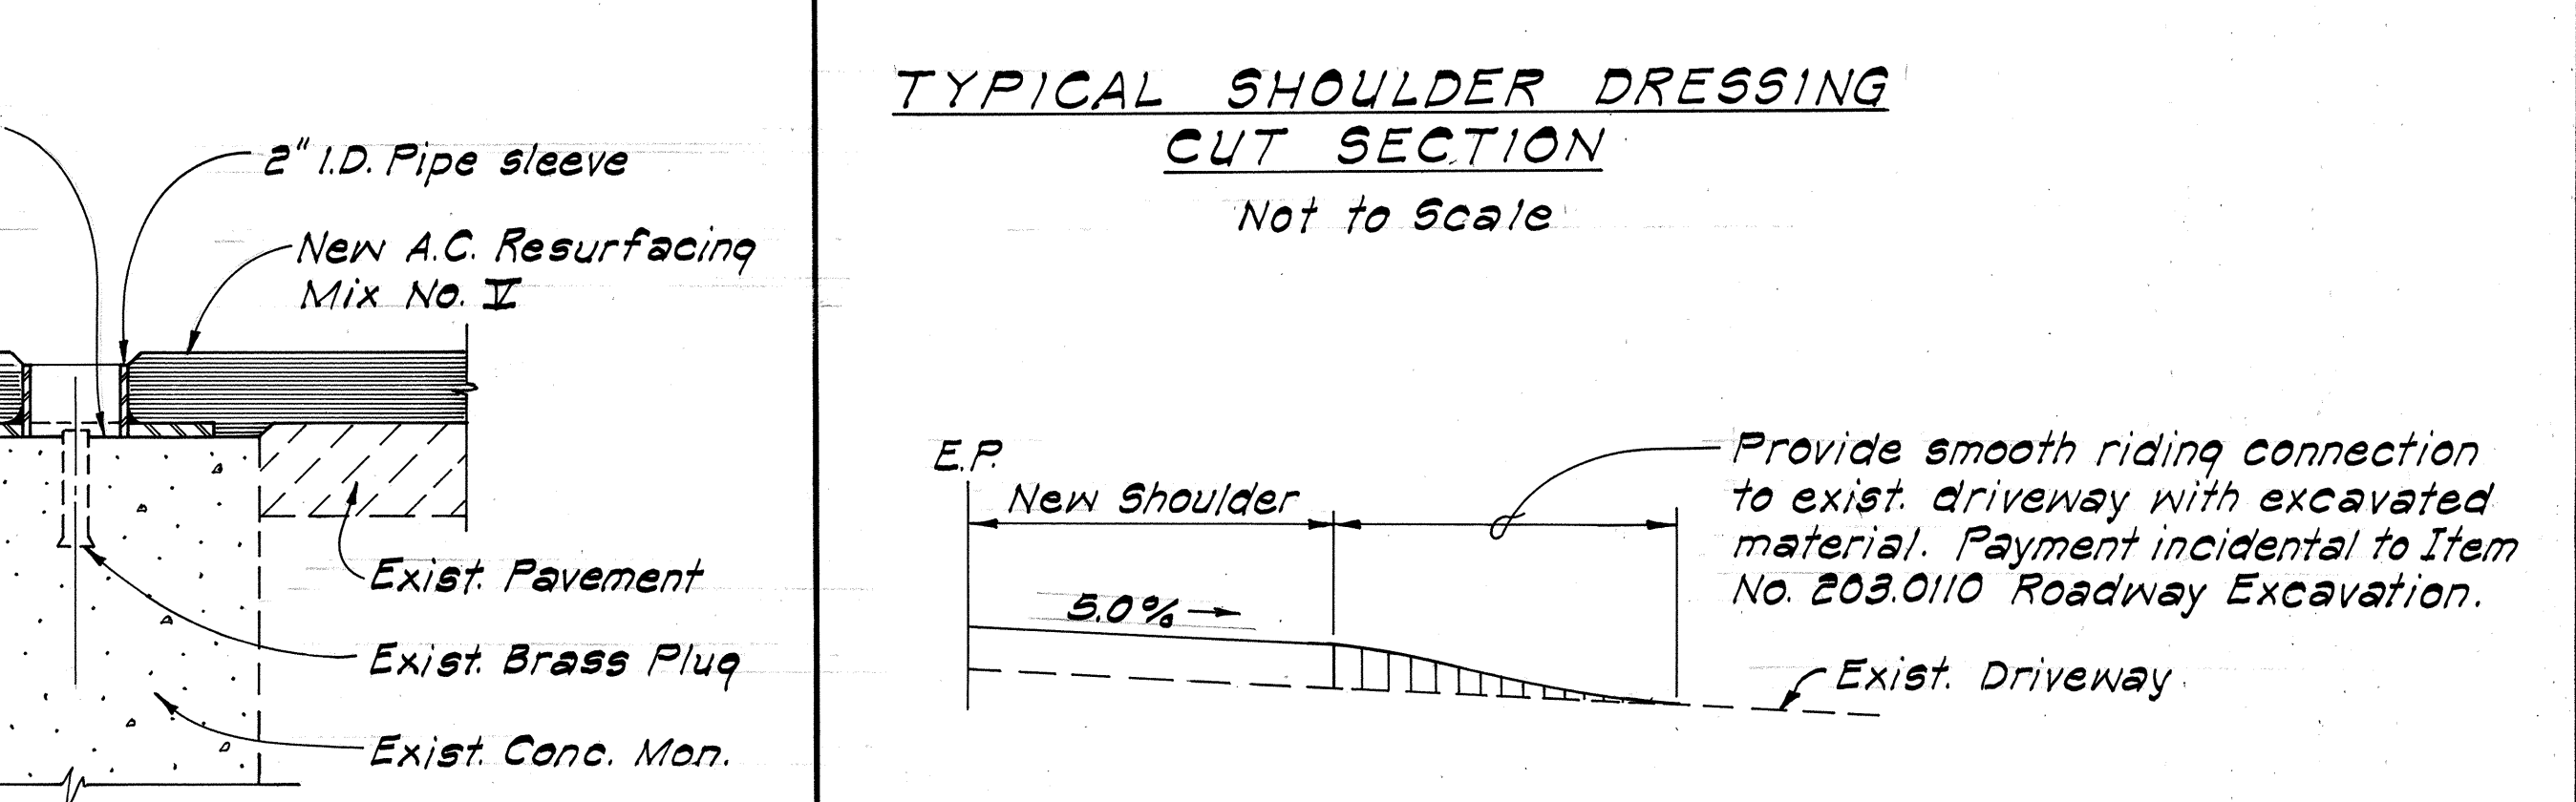
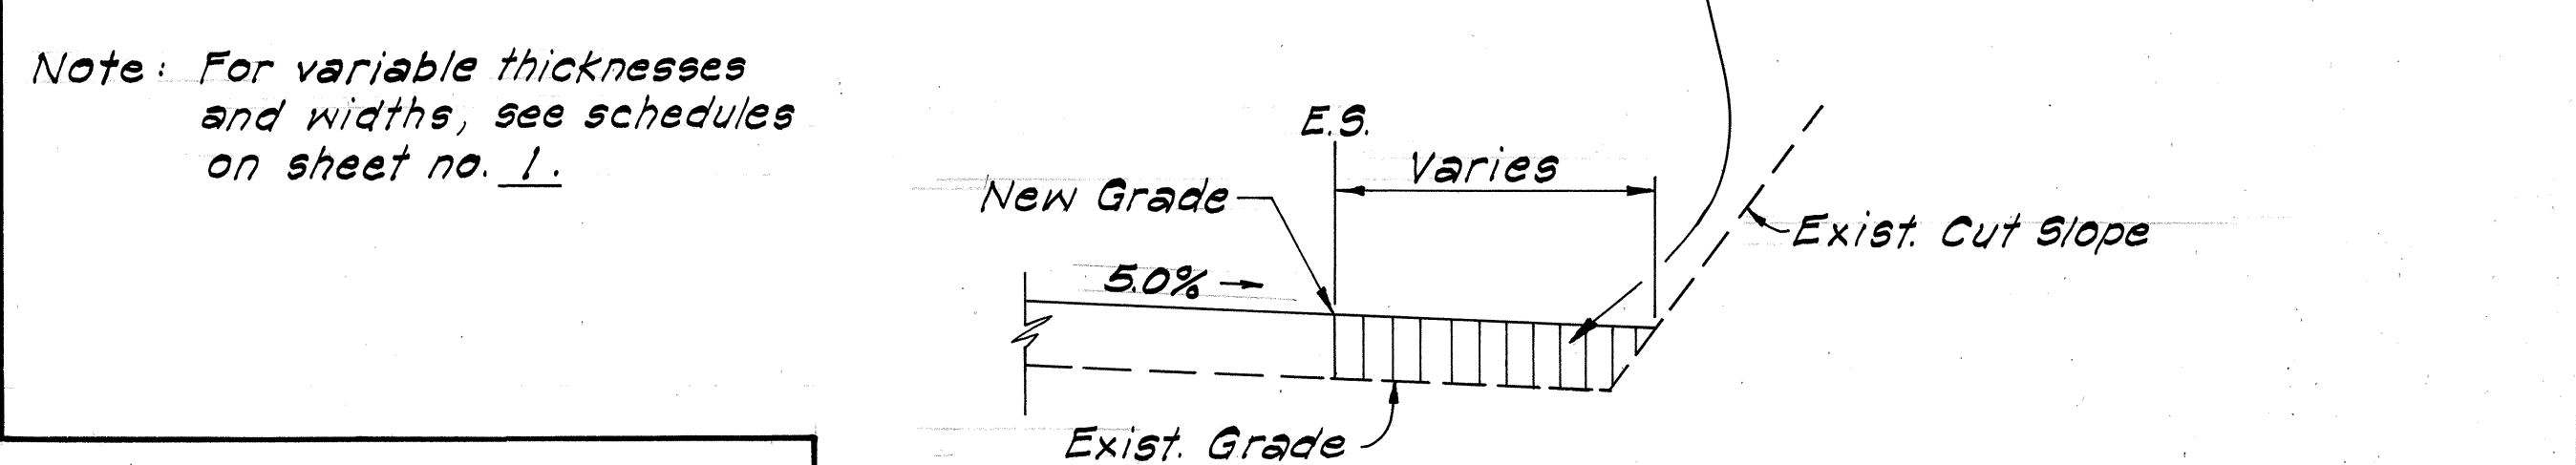
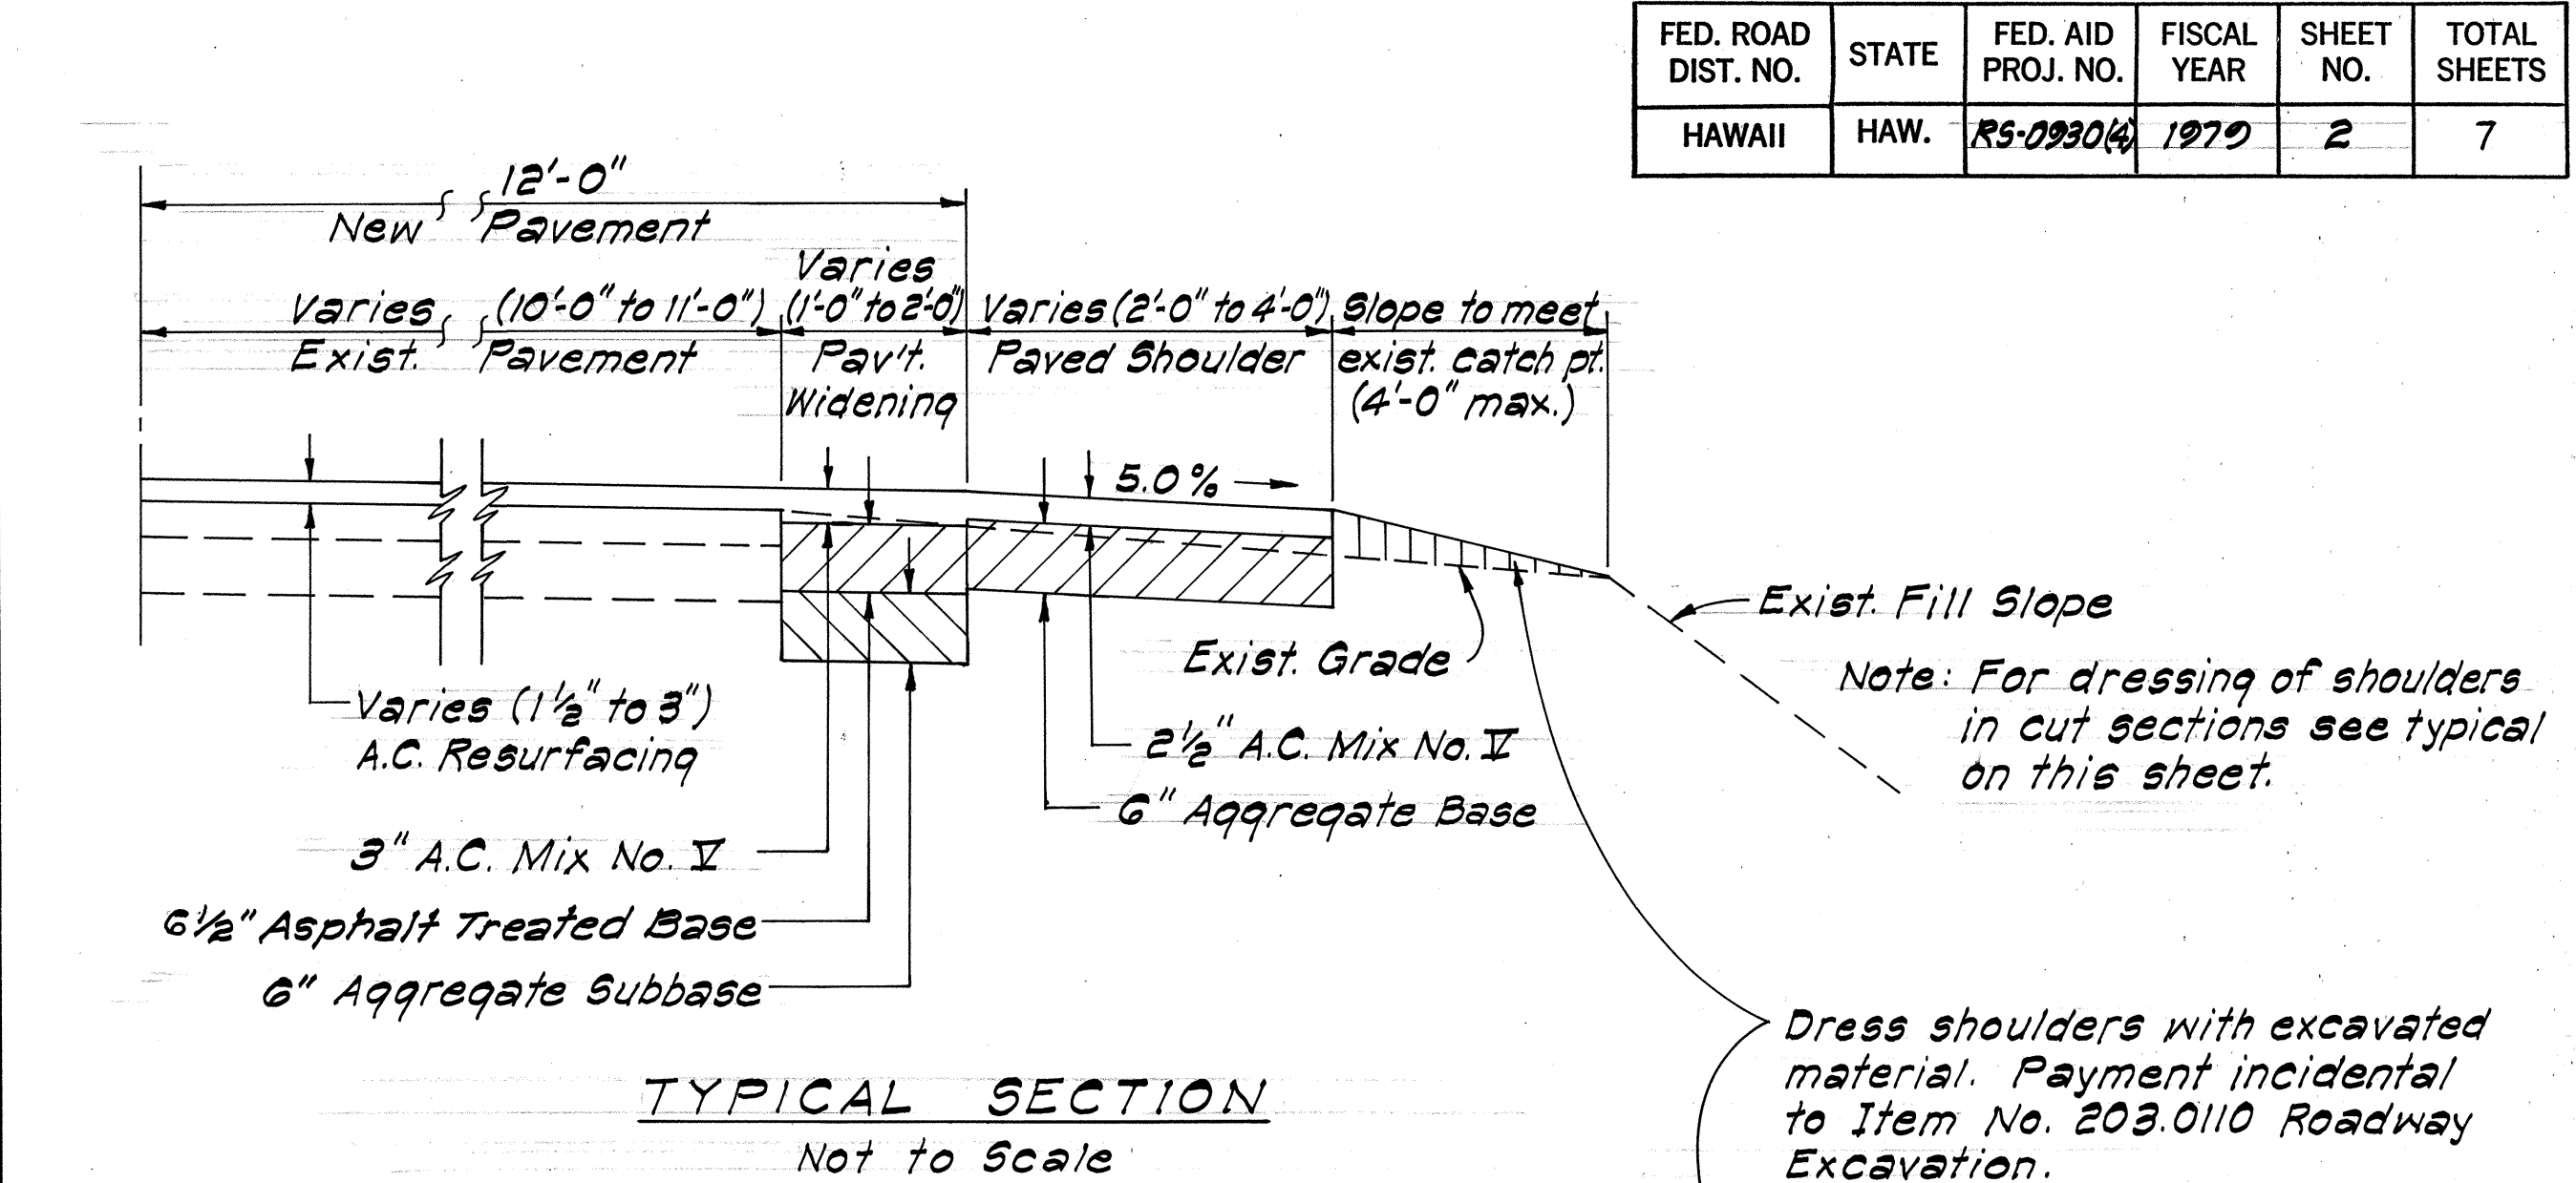


FED. ROAD DIST. NO.	STATE	FED. AID PROJ. NO.	FISCAL YEAR	SHEET NO.	TOTAL SHEETS
HAWAII	HAW.	RS-0930(4)	1979	2	7

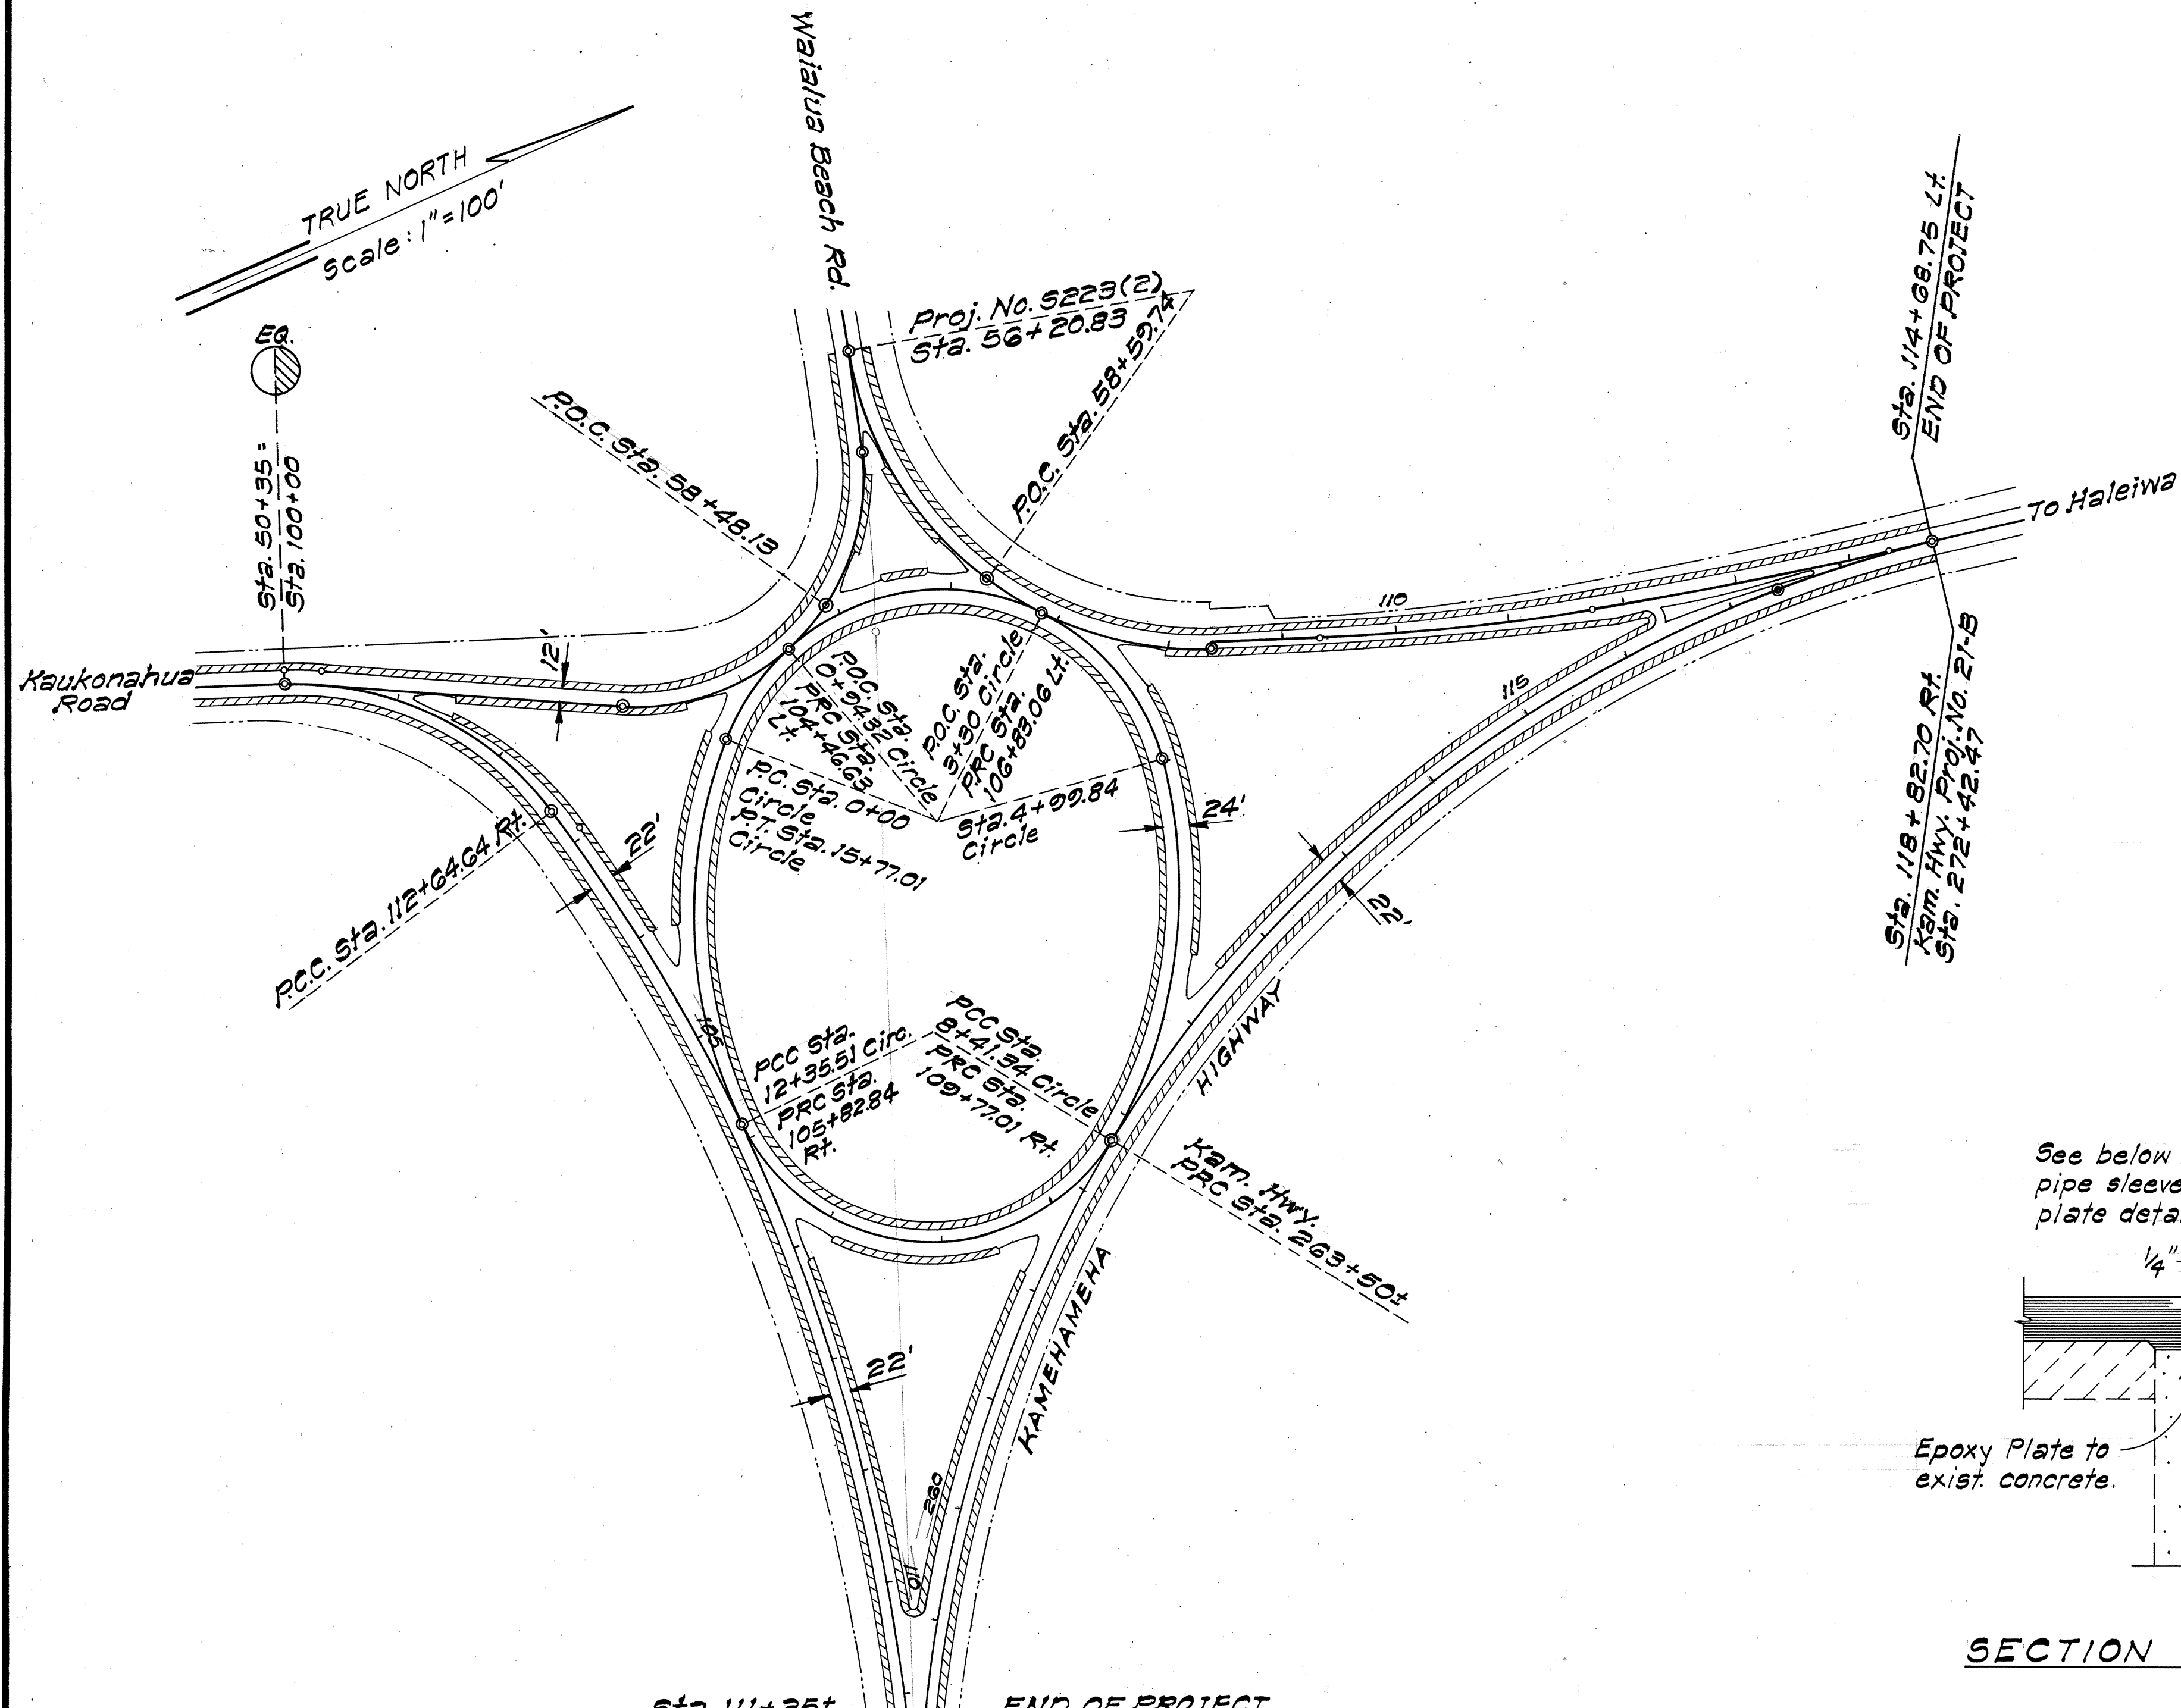

STATE OF HAWAII
DEPARTMENT OF TRANSPORTATION
LAND TRANSPORTATION FACILITIES DIVISION

**PLAN, TYPICAL SECTIONS
& MISCELLANEOUS DETAILS**
**KAUKONAHUA RD. RESURFACING
& SHOULDER IMPROVEMENTS**
K.A. PROJ. NO. RS-0930(4)
Scale: As Shown Date: June, 1978
SHEET NO. 1 OF 1 SHEETS