

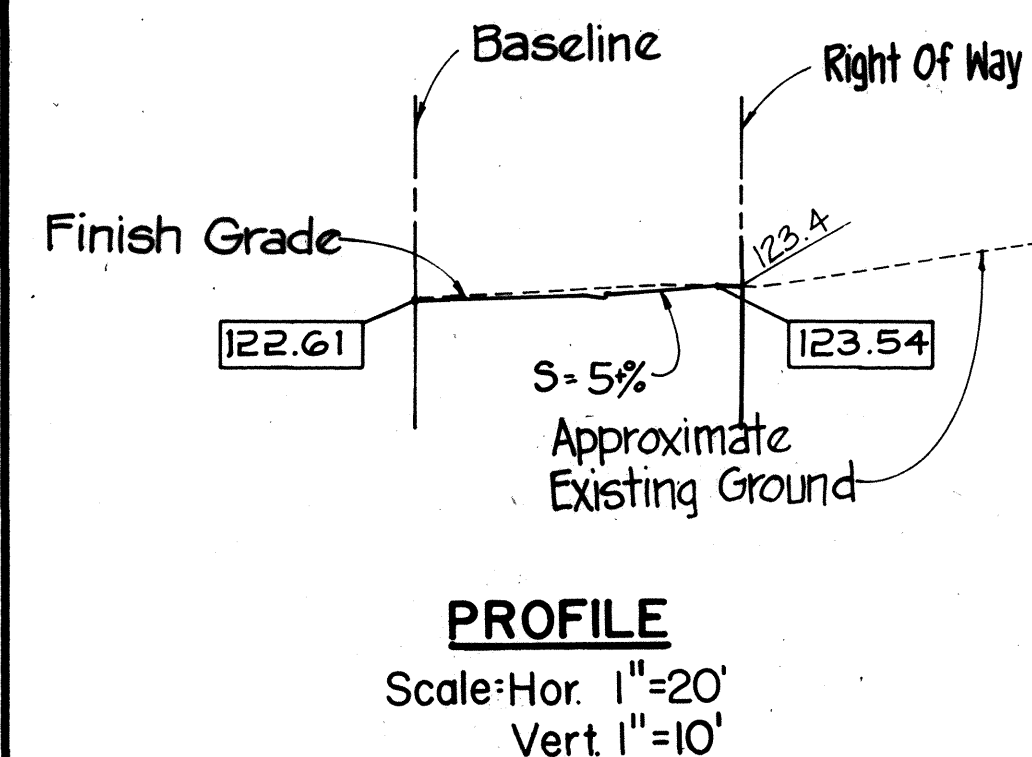



FED. ROAD DIST. NO.	STATE	FED. AID PROJ. NO.	FISCAL YEAR	SHEET NO.	TOTAL SHEETS
HAWAII	HAW.	F-083-1(10)	1978	22	160

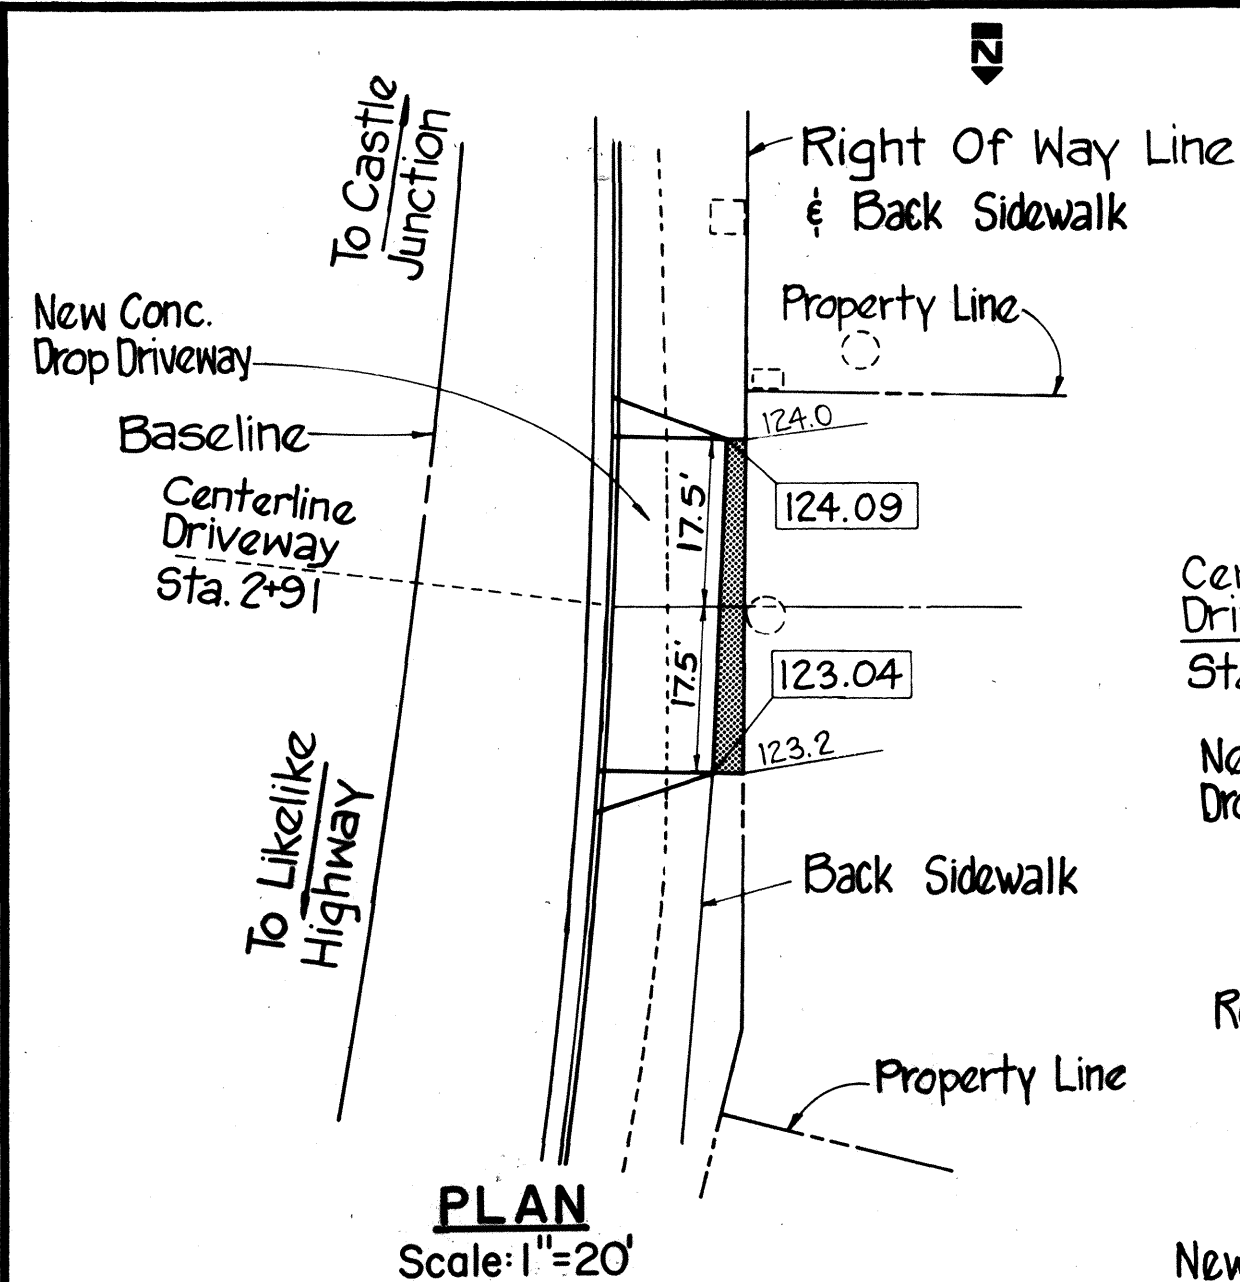



DRIVEWAY AT STA. 2+91

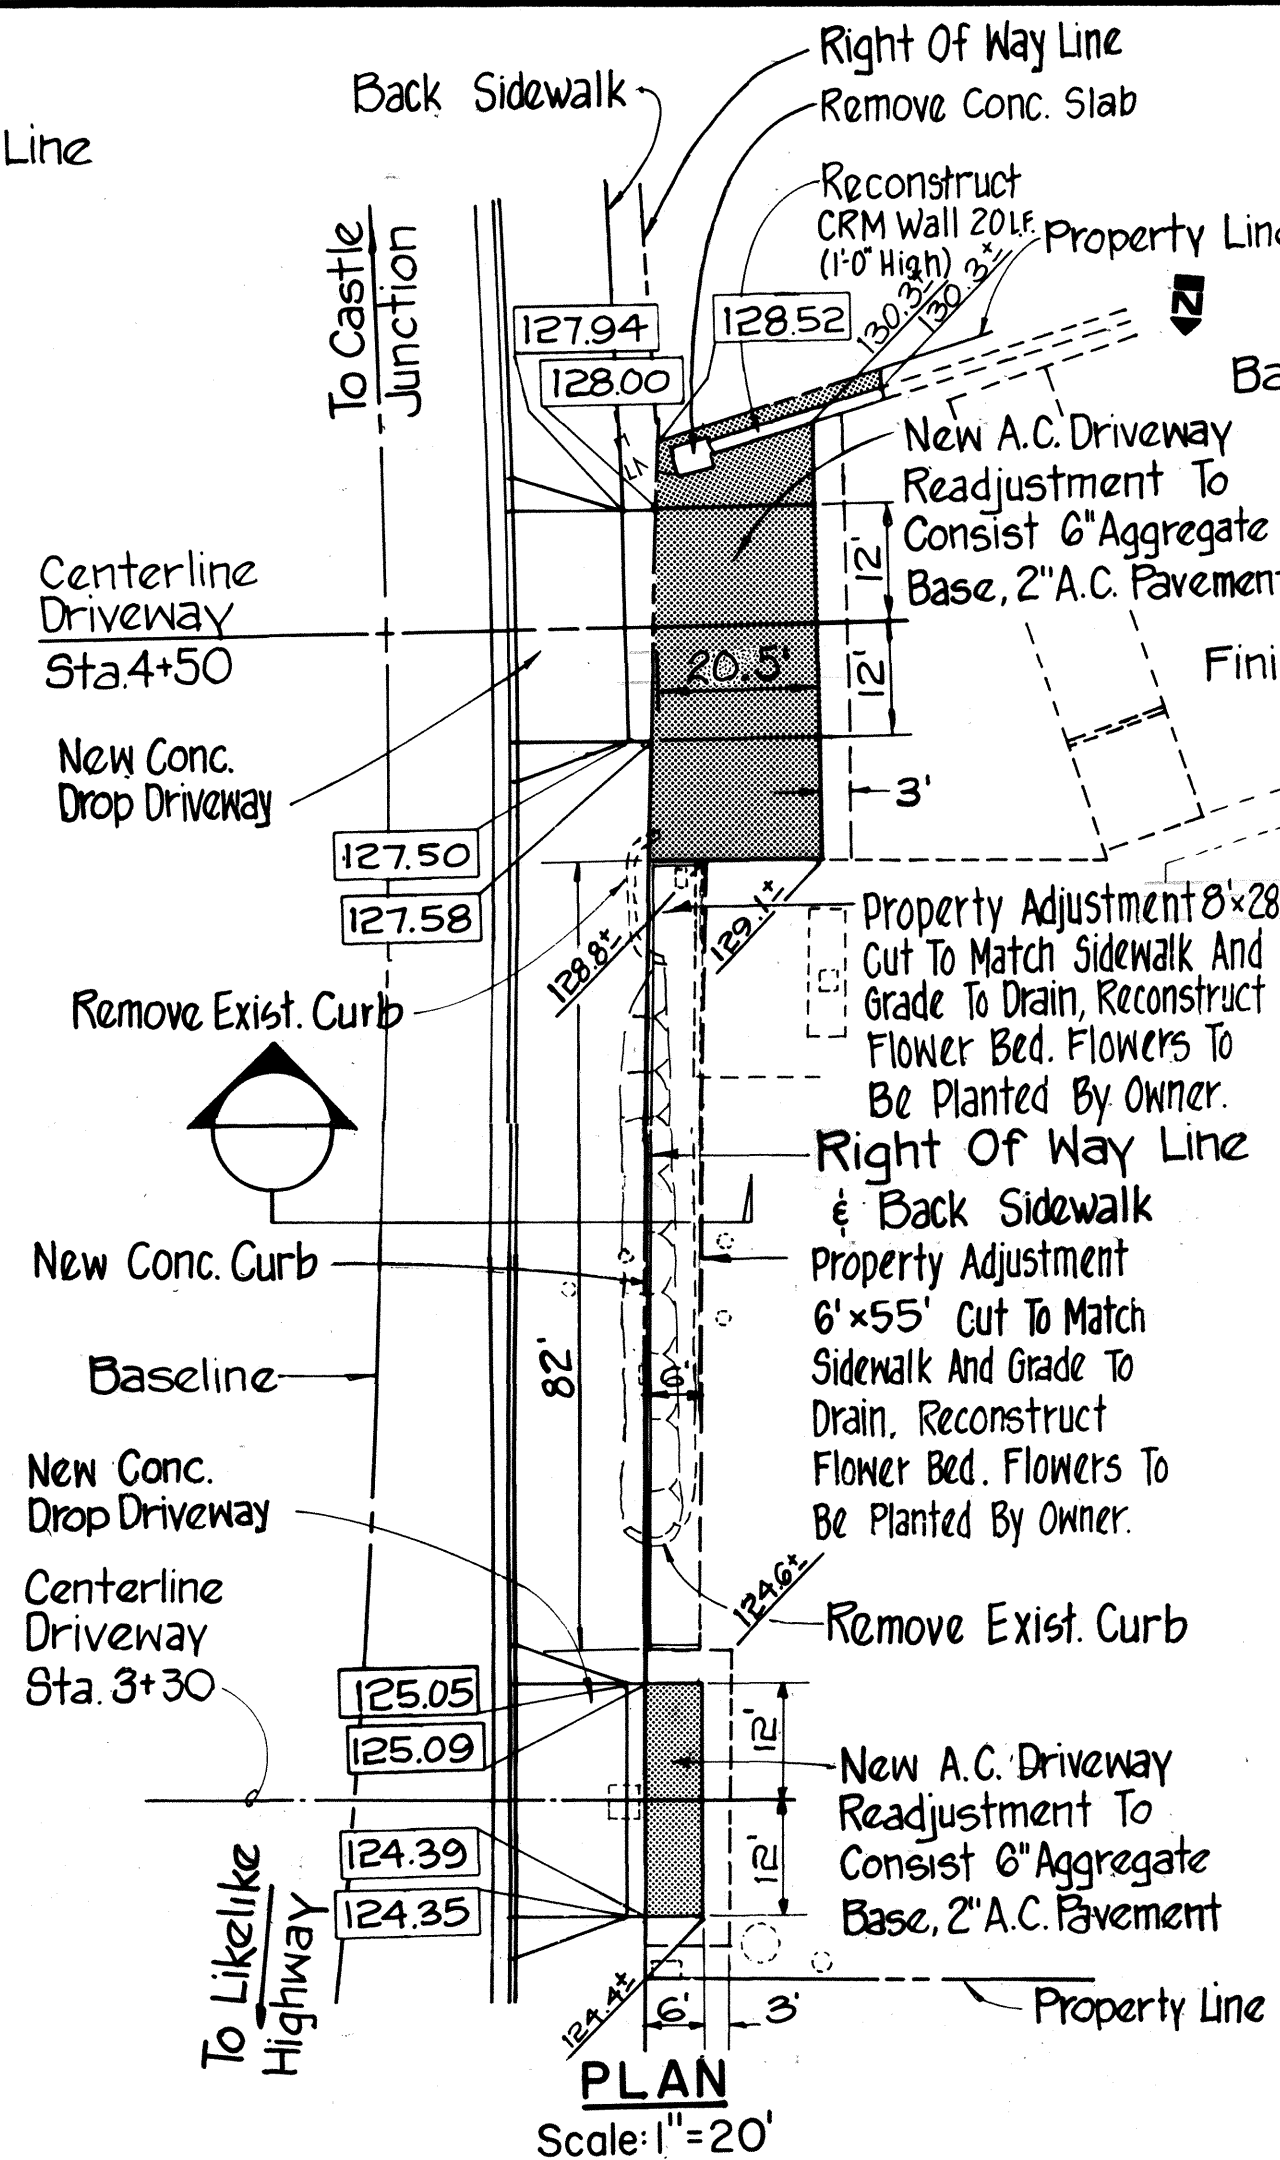

DRIVEWAY AT STA. 3+30 & 4+50

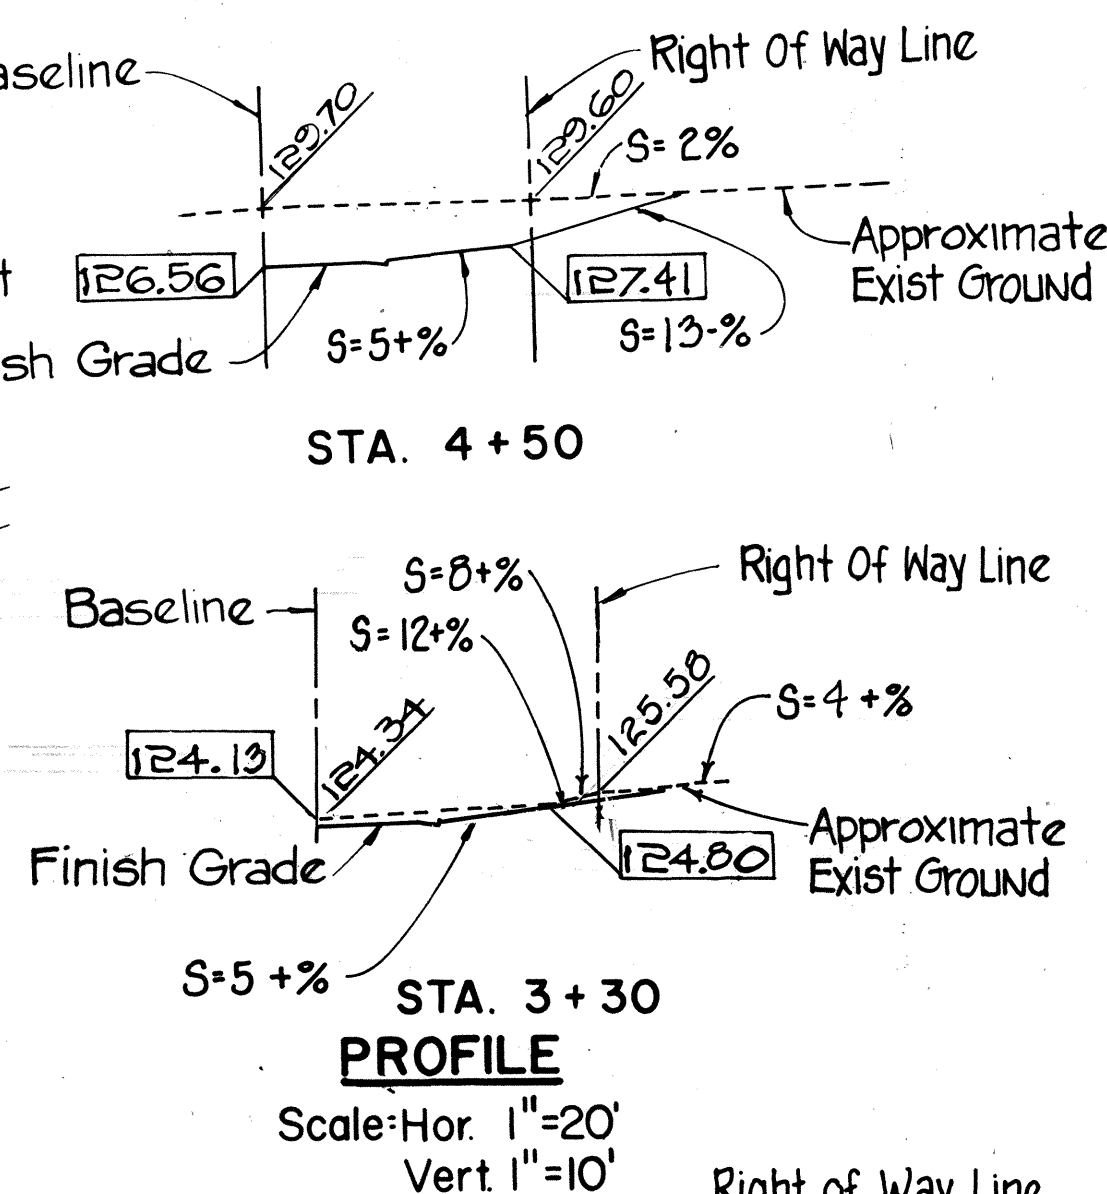

SECTION
Scale: 1"=2'-0"

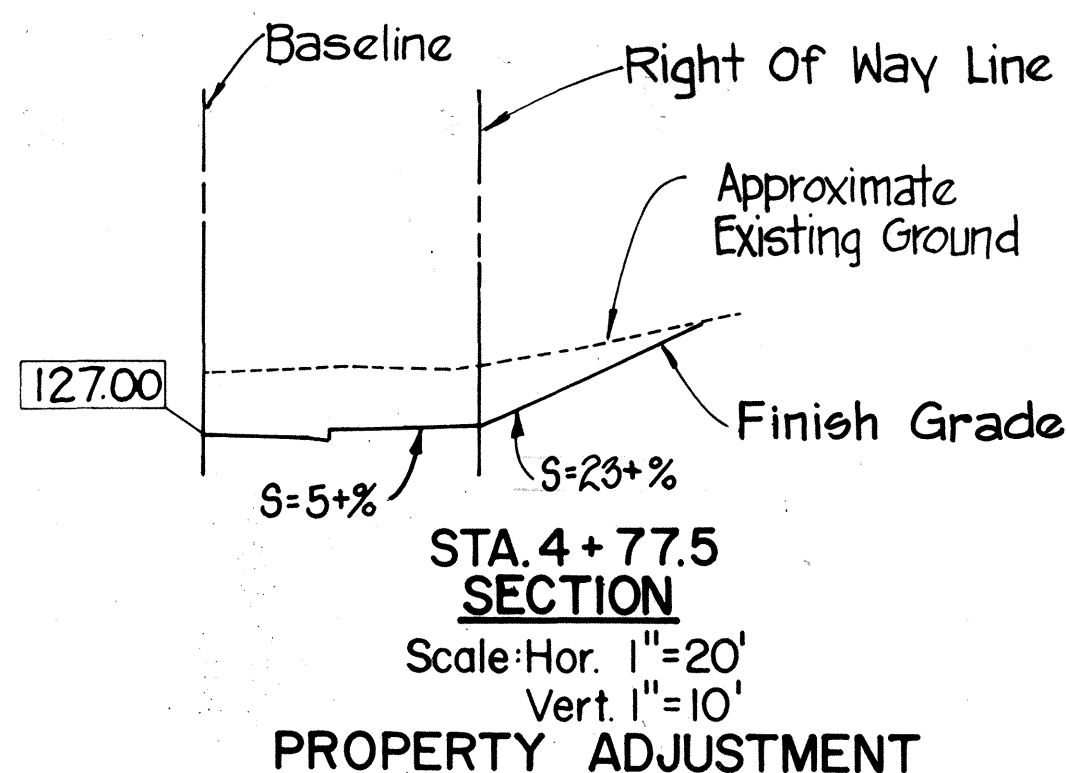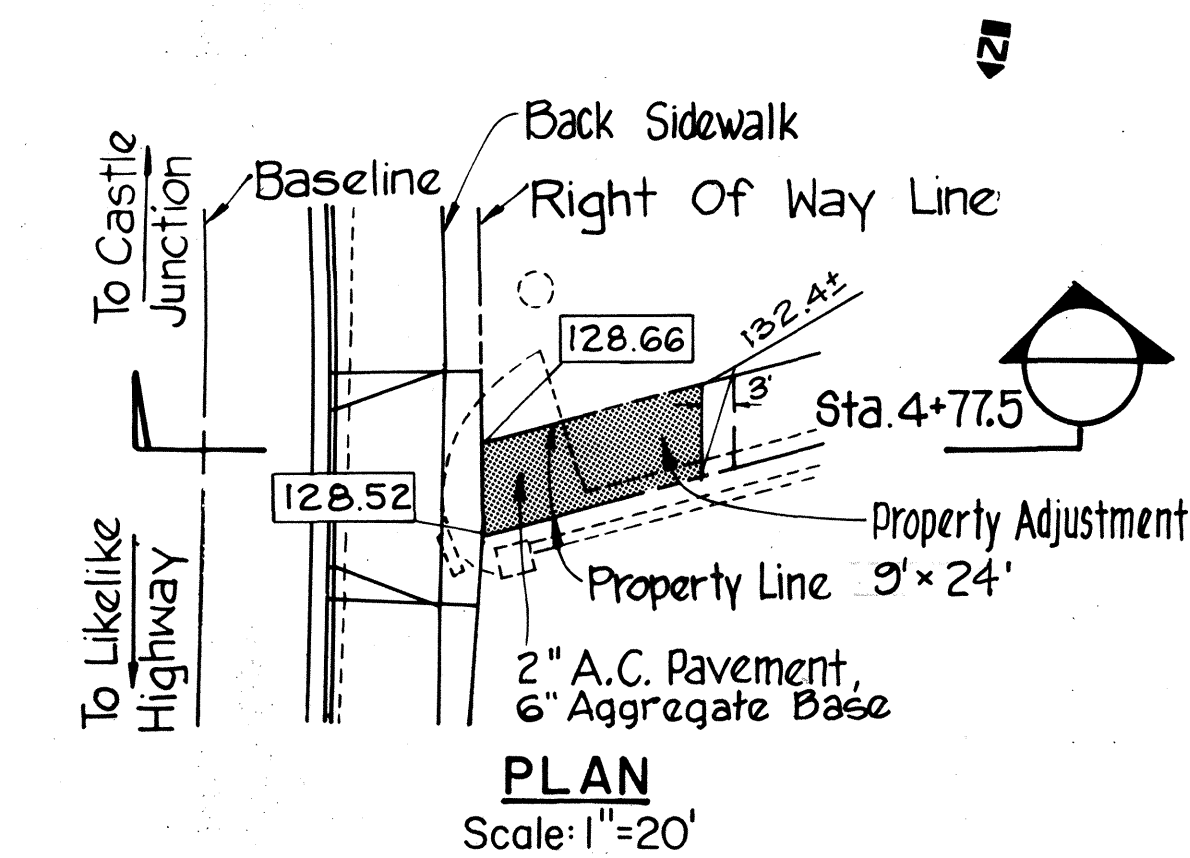


PROPERTY ADJUSTMENT

LEGEND



- 2" A.C. Pavement w/6" Aggregate Base
- Conc. Pavement
- Existing Elevation
- Finished Elevation
- Existing Ground

NOTES:


- Contractor shall be responsible for the restoration to original condition of any property damage caused by his operations.
- Contractor shall contact owner and/or tenant 10 working days prior to entering property for driveway or property adjustment.
- Damaged hedges & plants shall be replanted by the contractor unless otherwise noted.
- Cut & fill areas within private property shall be replanted with similar ground cover.

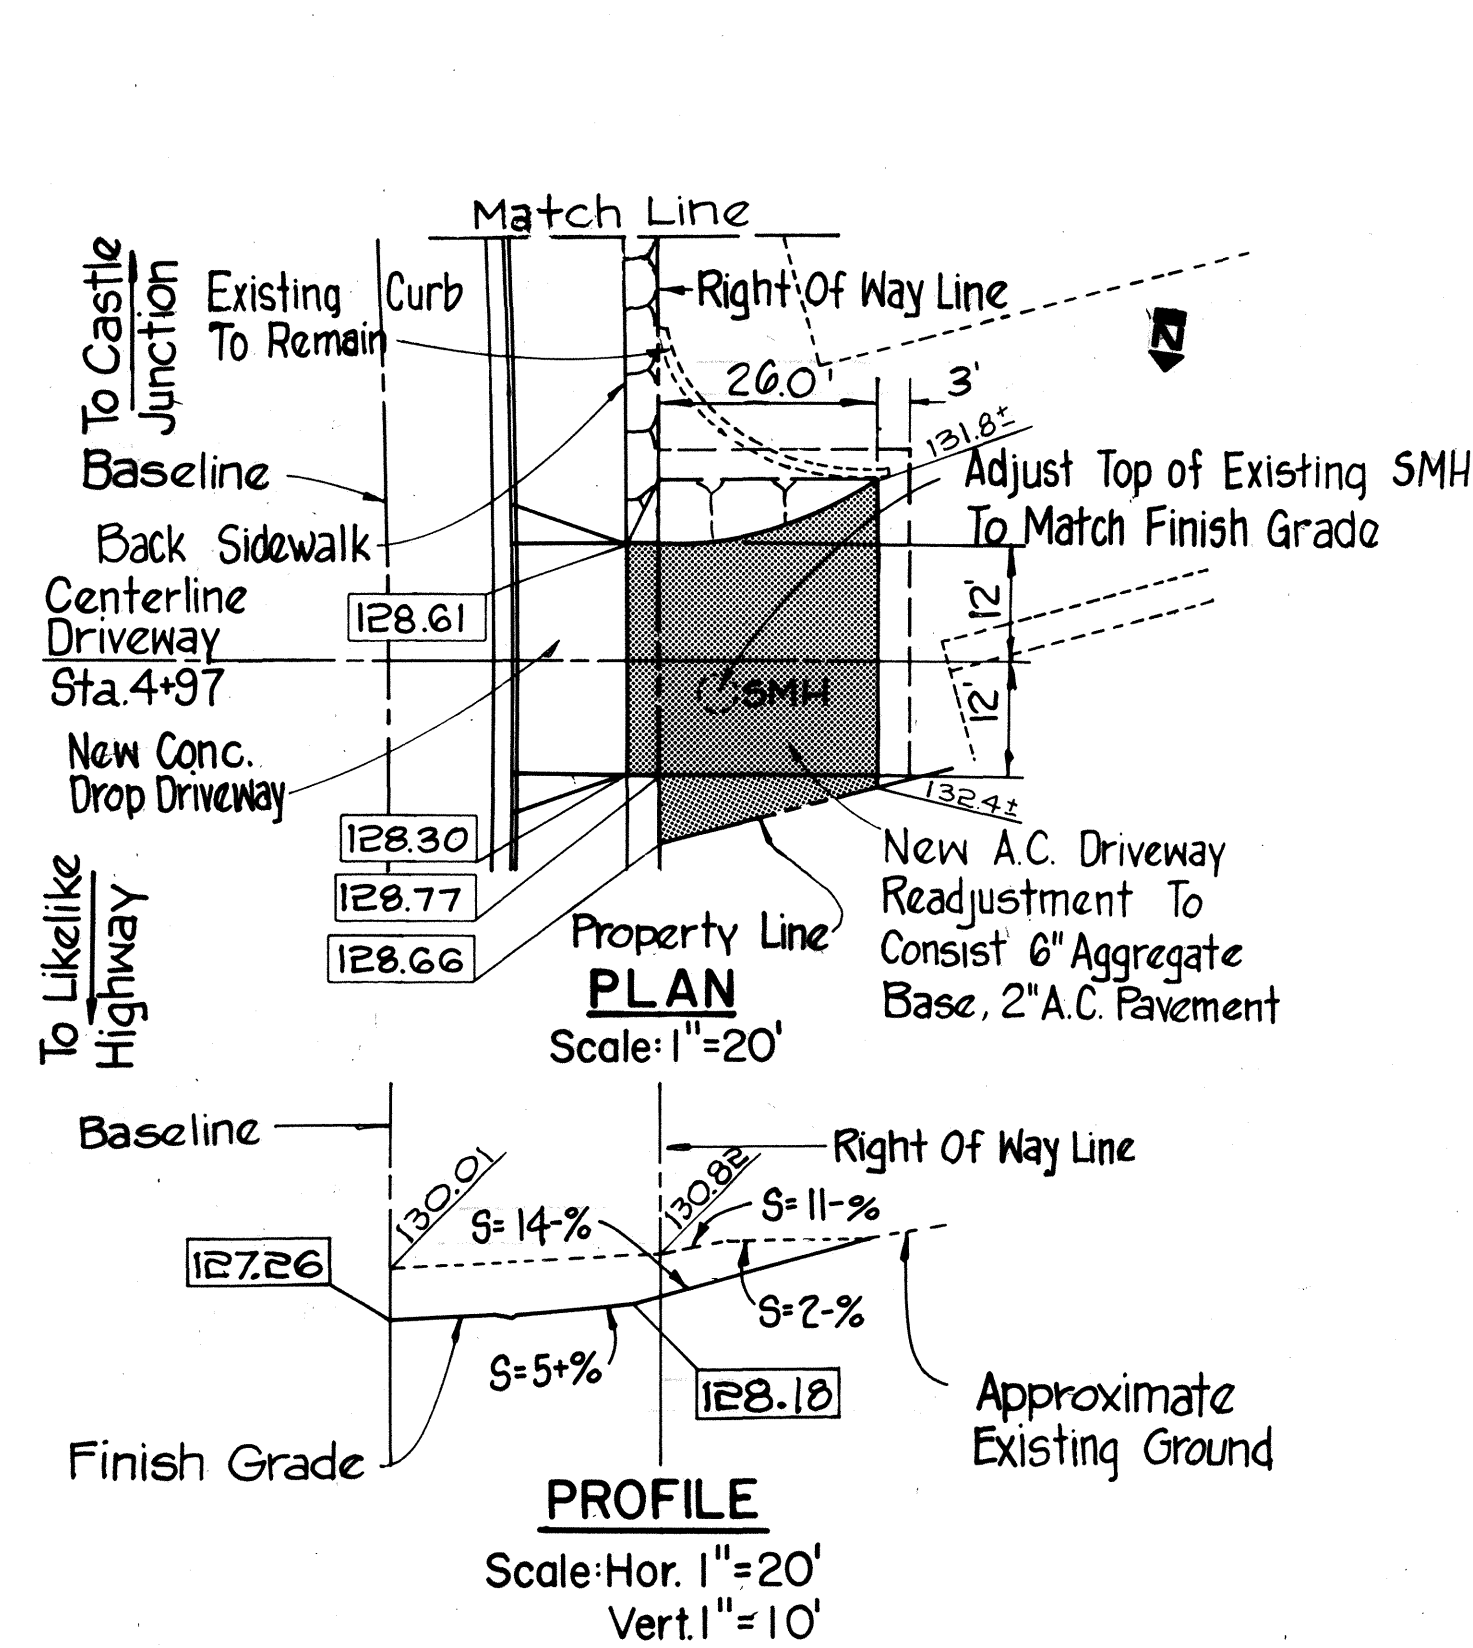

DRIVEWAY AT STA. 4+97

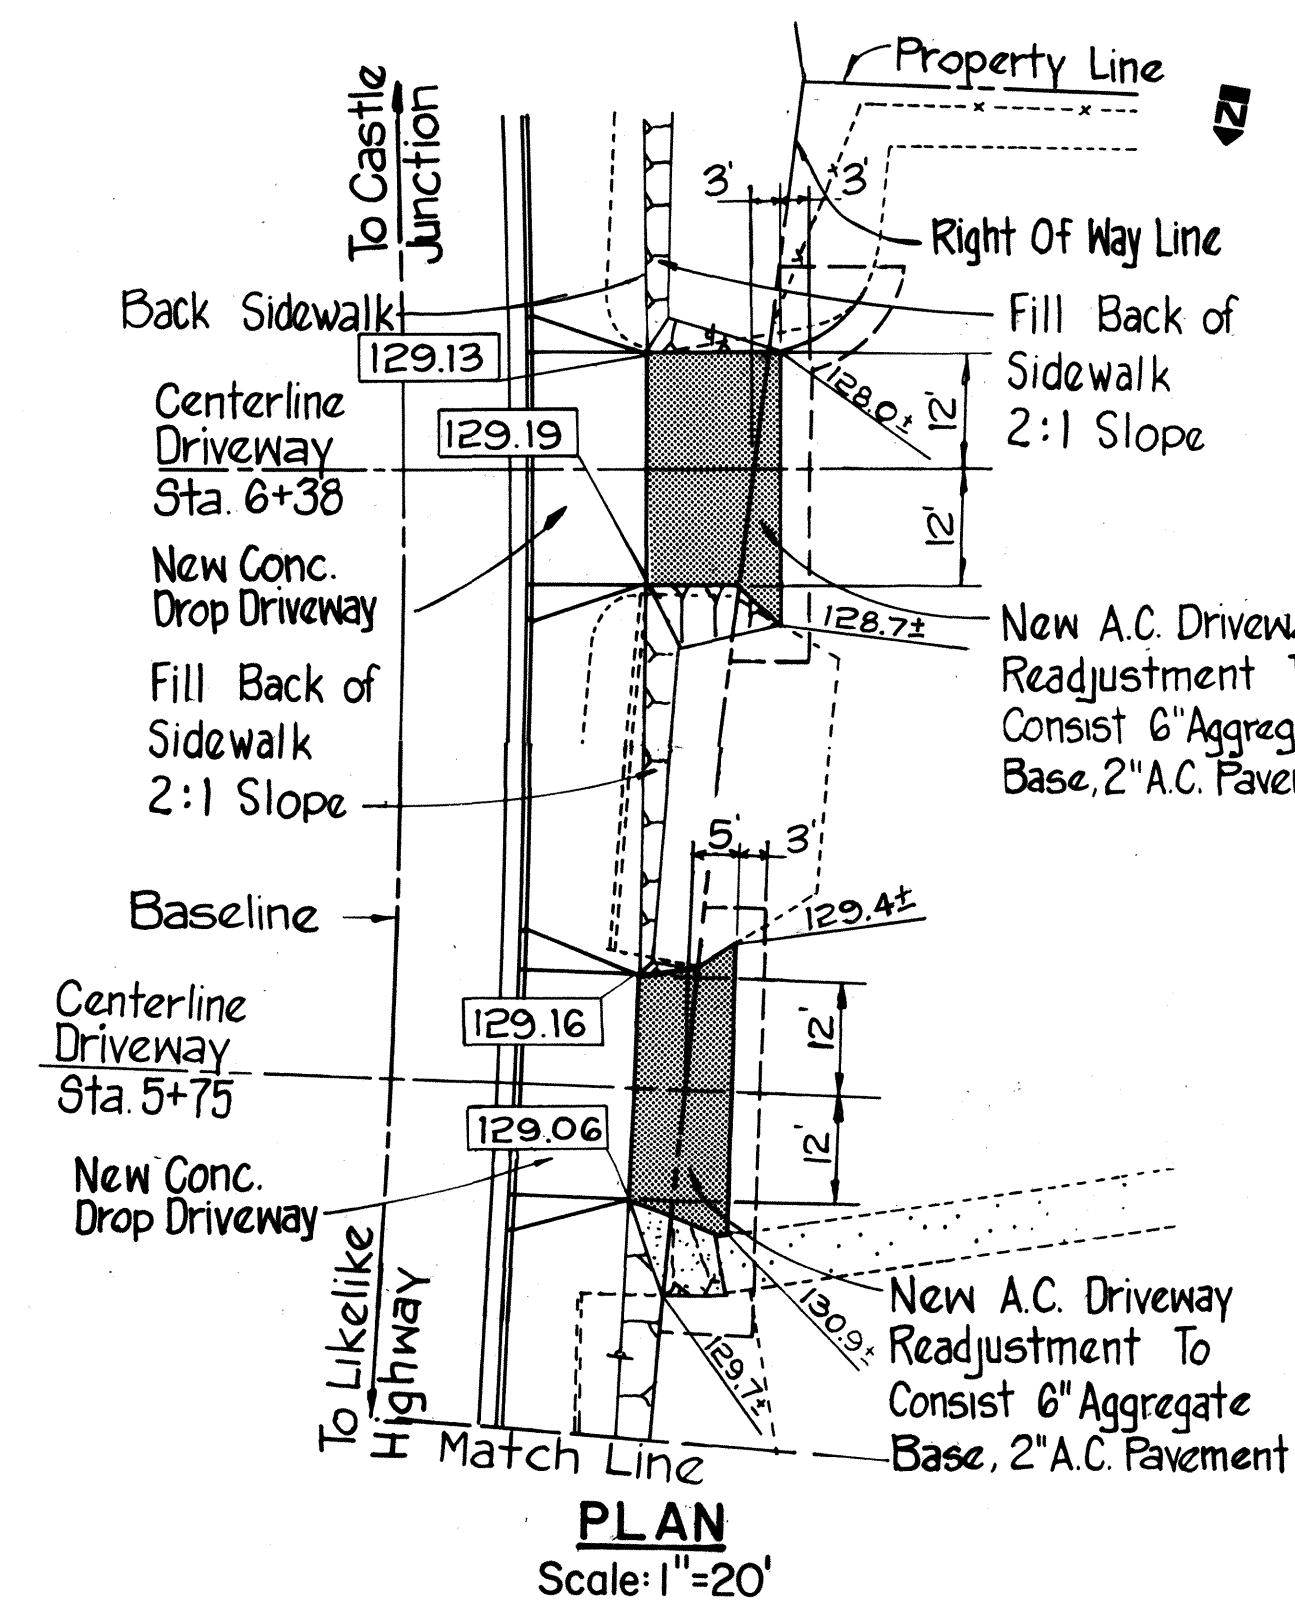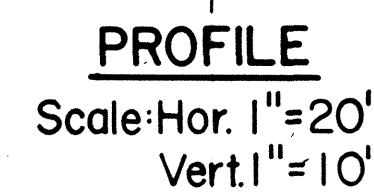


DRIVEWAY AT STA. 5+75 & 6+38

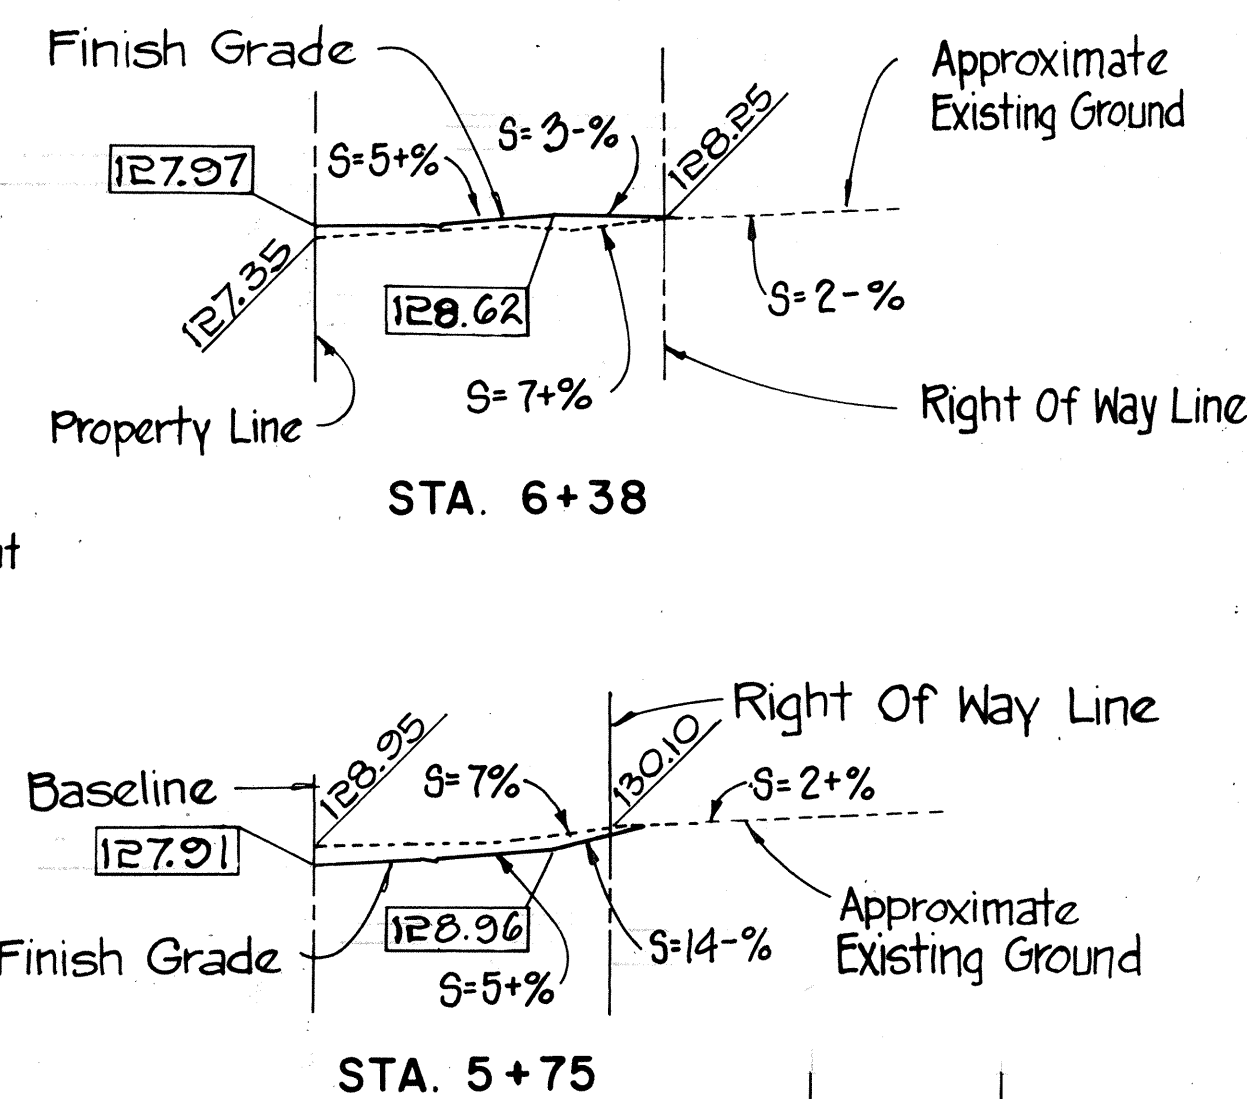

SECTION
Scale: 1"=2'-0"

1/3/79	Changed Grades & A.C. Driveway Width.
DATE	REVISION

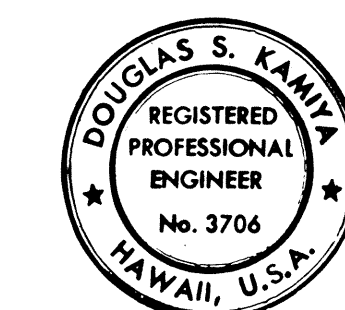

THIS WORK WAS PREPARED BY ME OR UNDER MY SUPERVISION.
Douglas S. Kania

STATE OF HAWAII
DEPARTMENT OF TRANSPORTATION
LAND TRANSPORTATION FACILITIES DIVISION







DRIVEWAY AND PROPERTY ADJUSTMENTS

KAMEHAMEHA HIGHWAY IMPROVEMENT
(LIKELIKE HIGHWAY TO KOOLAU VIEW DRIVE)
PROJECT NO. F-083-1(10)


SCALE: AS SHOWN DATE AUG 1978

SHEET No. 1 OF 8 SHEETS

FED. ROAD DIST. NO.	STATE	FED. AID PROJ. NO.	FISCAL YEAR	SHEET NO.	TOTAL SHEETS
HAWAII	HAW.	F-083-1(10)	1978	23	160

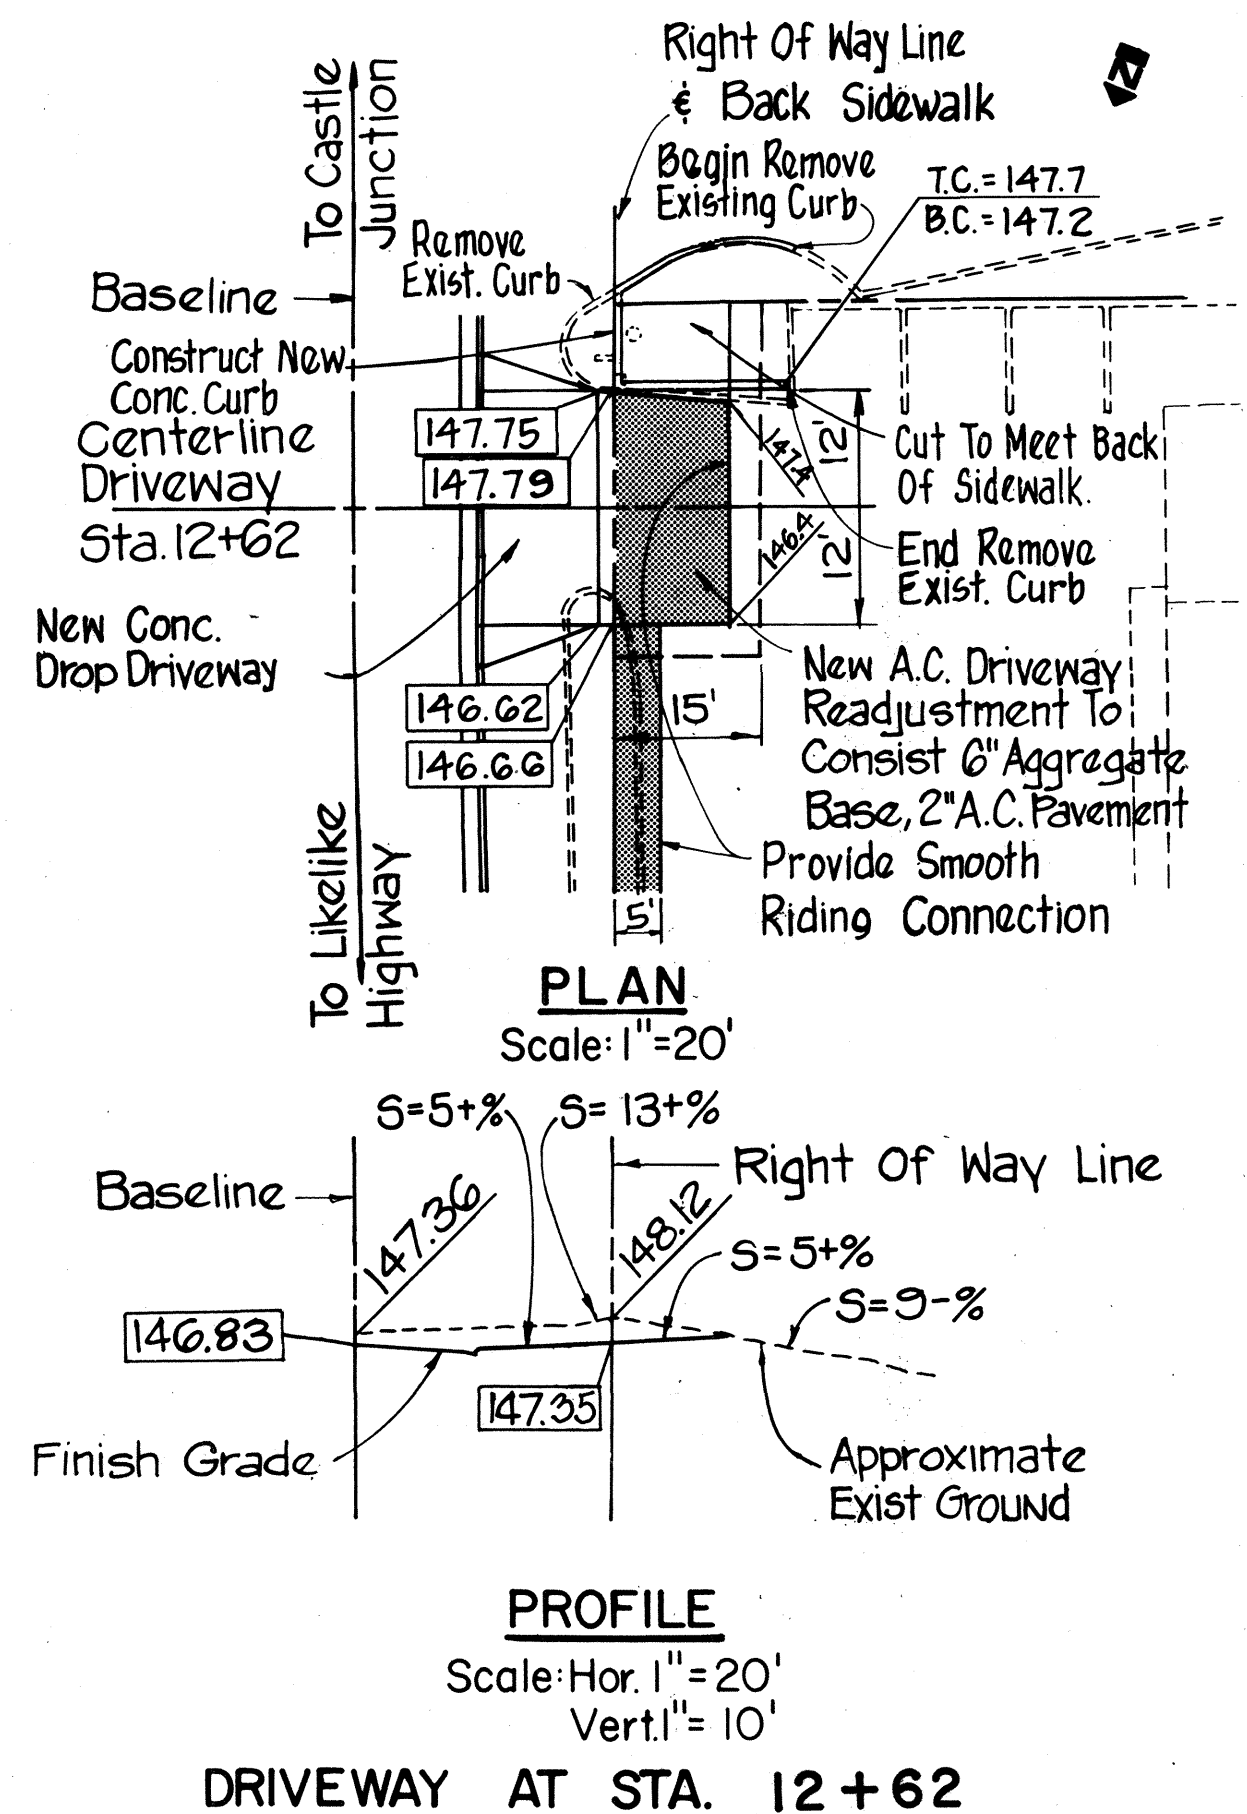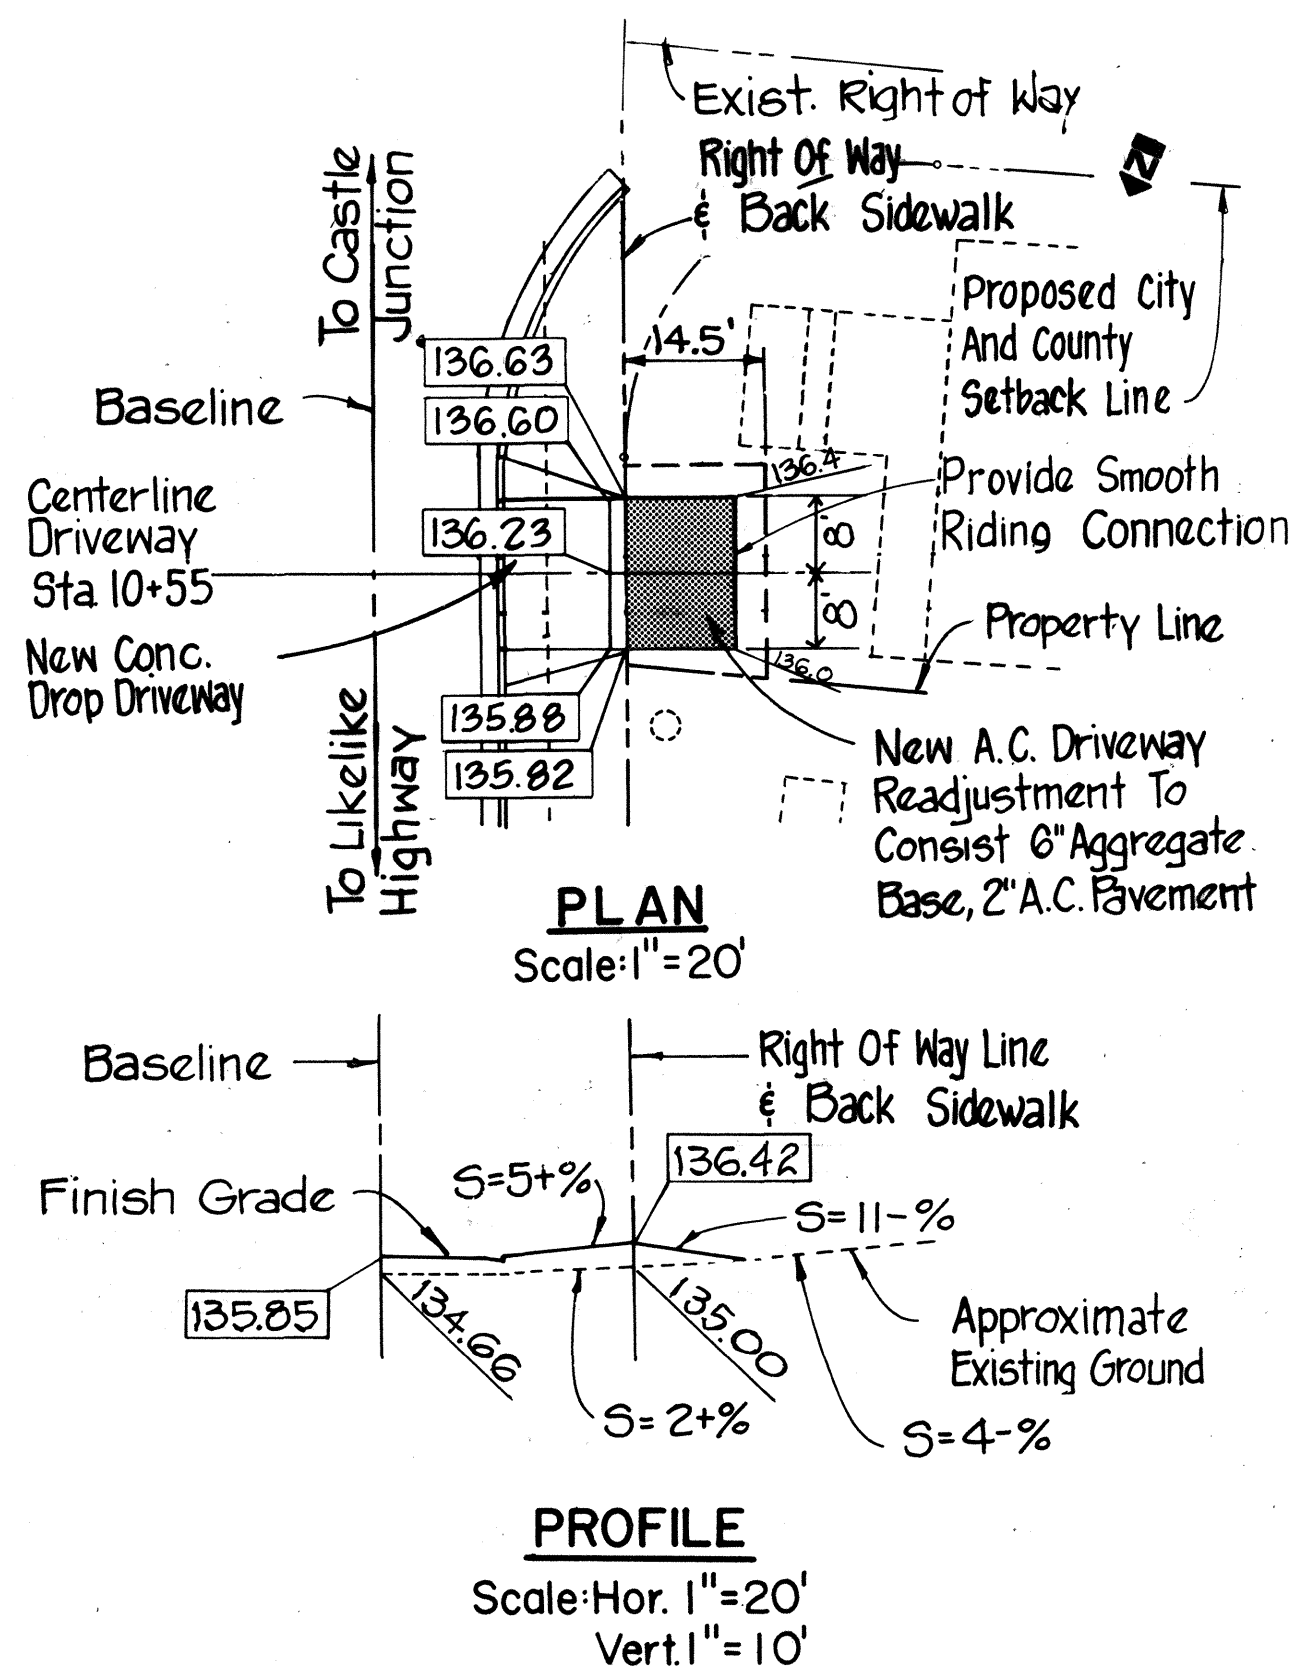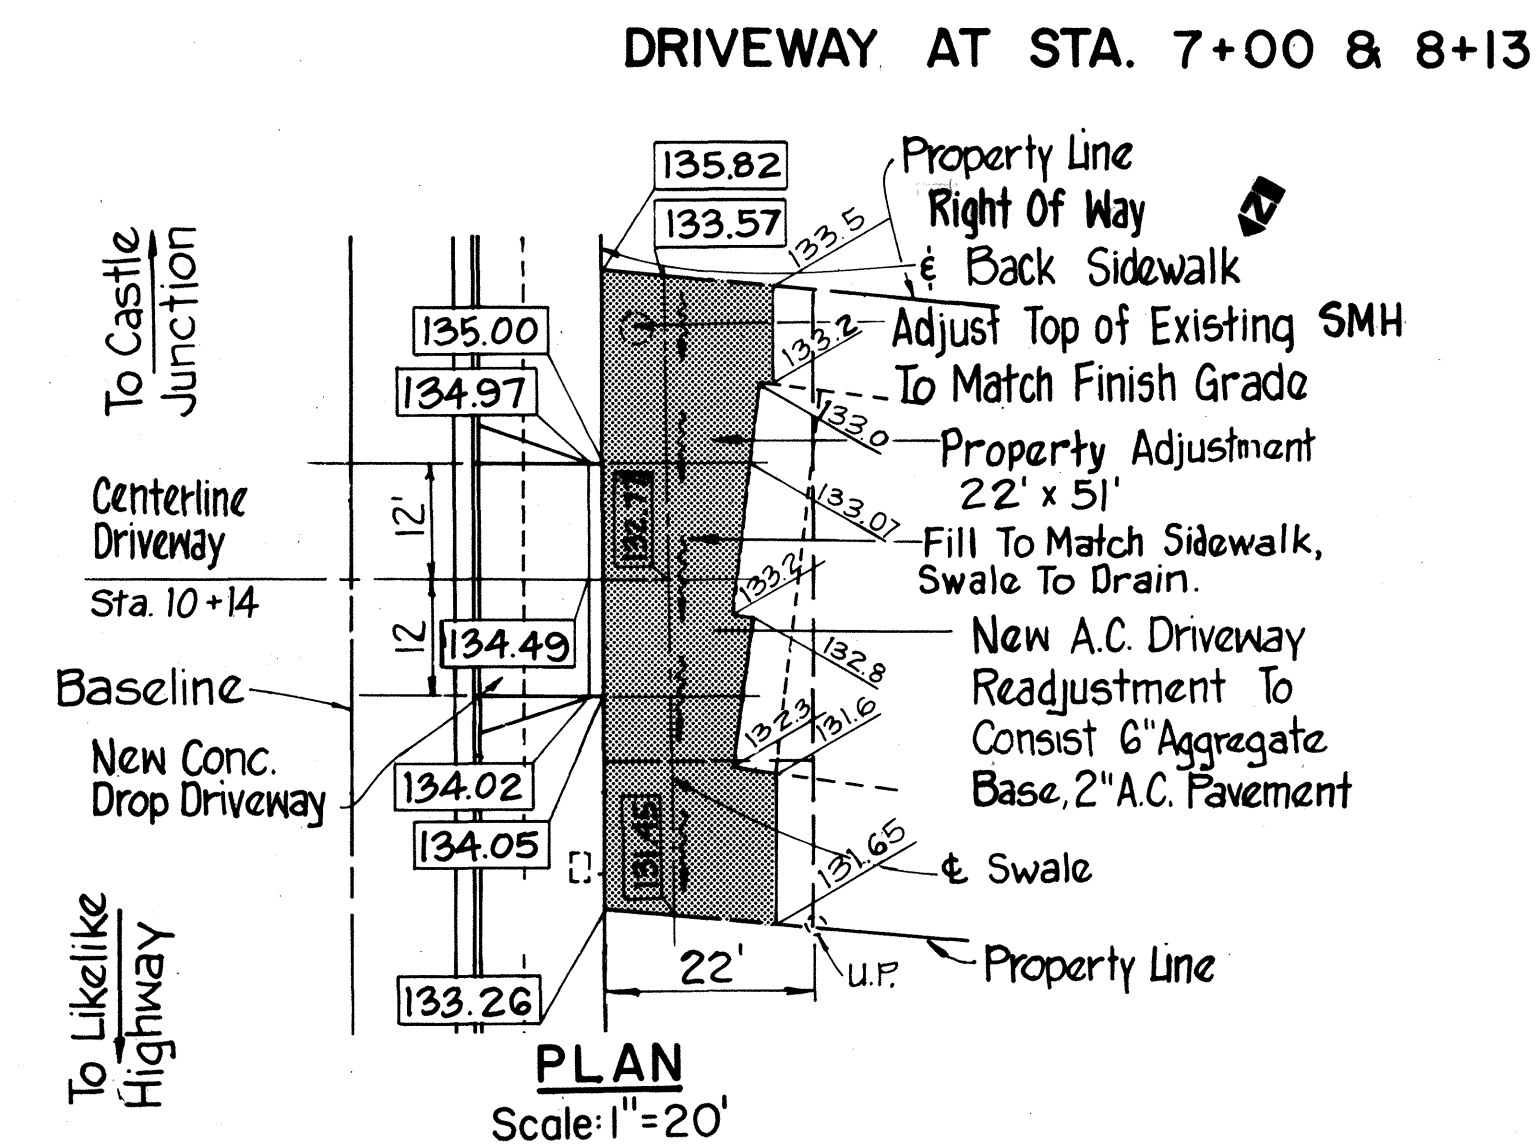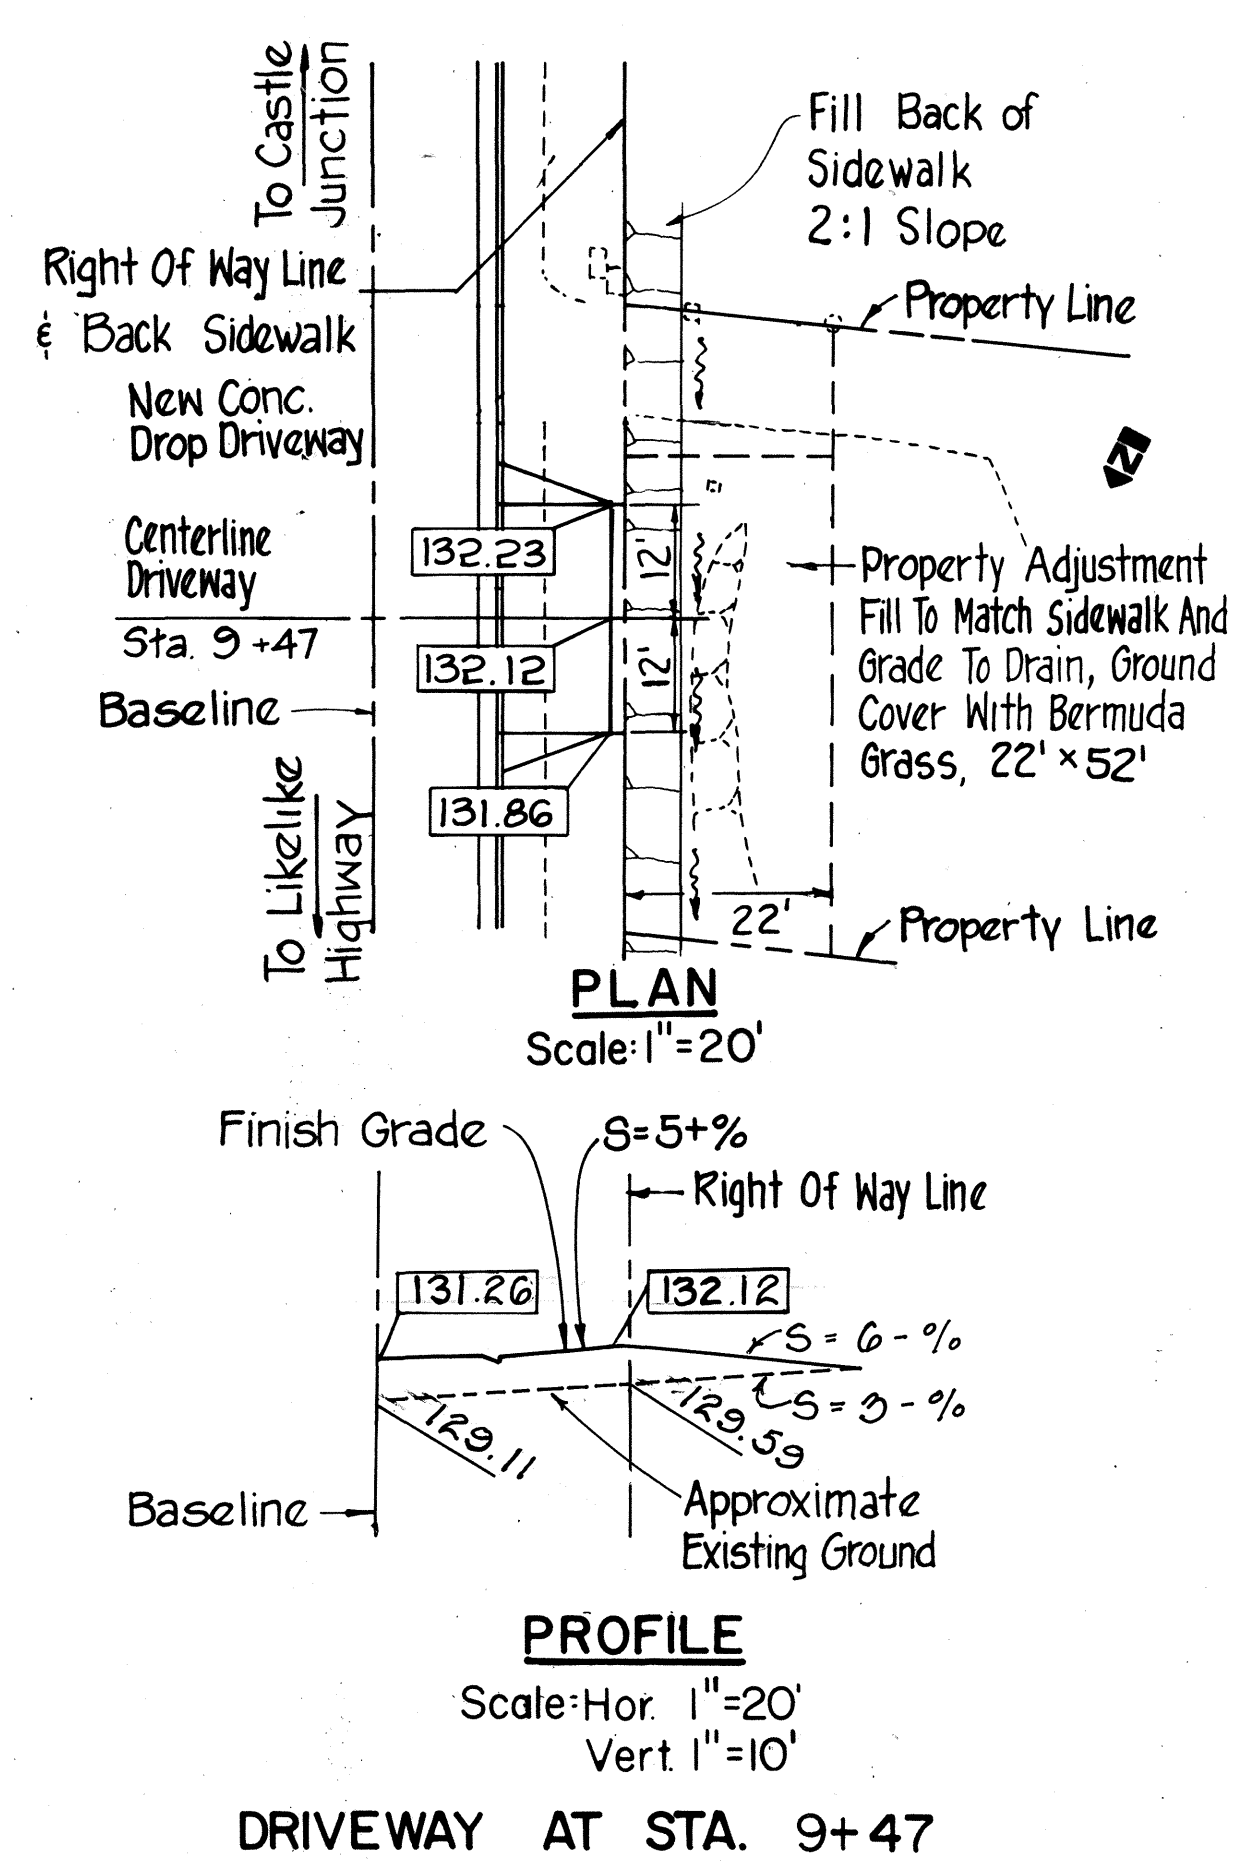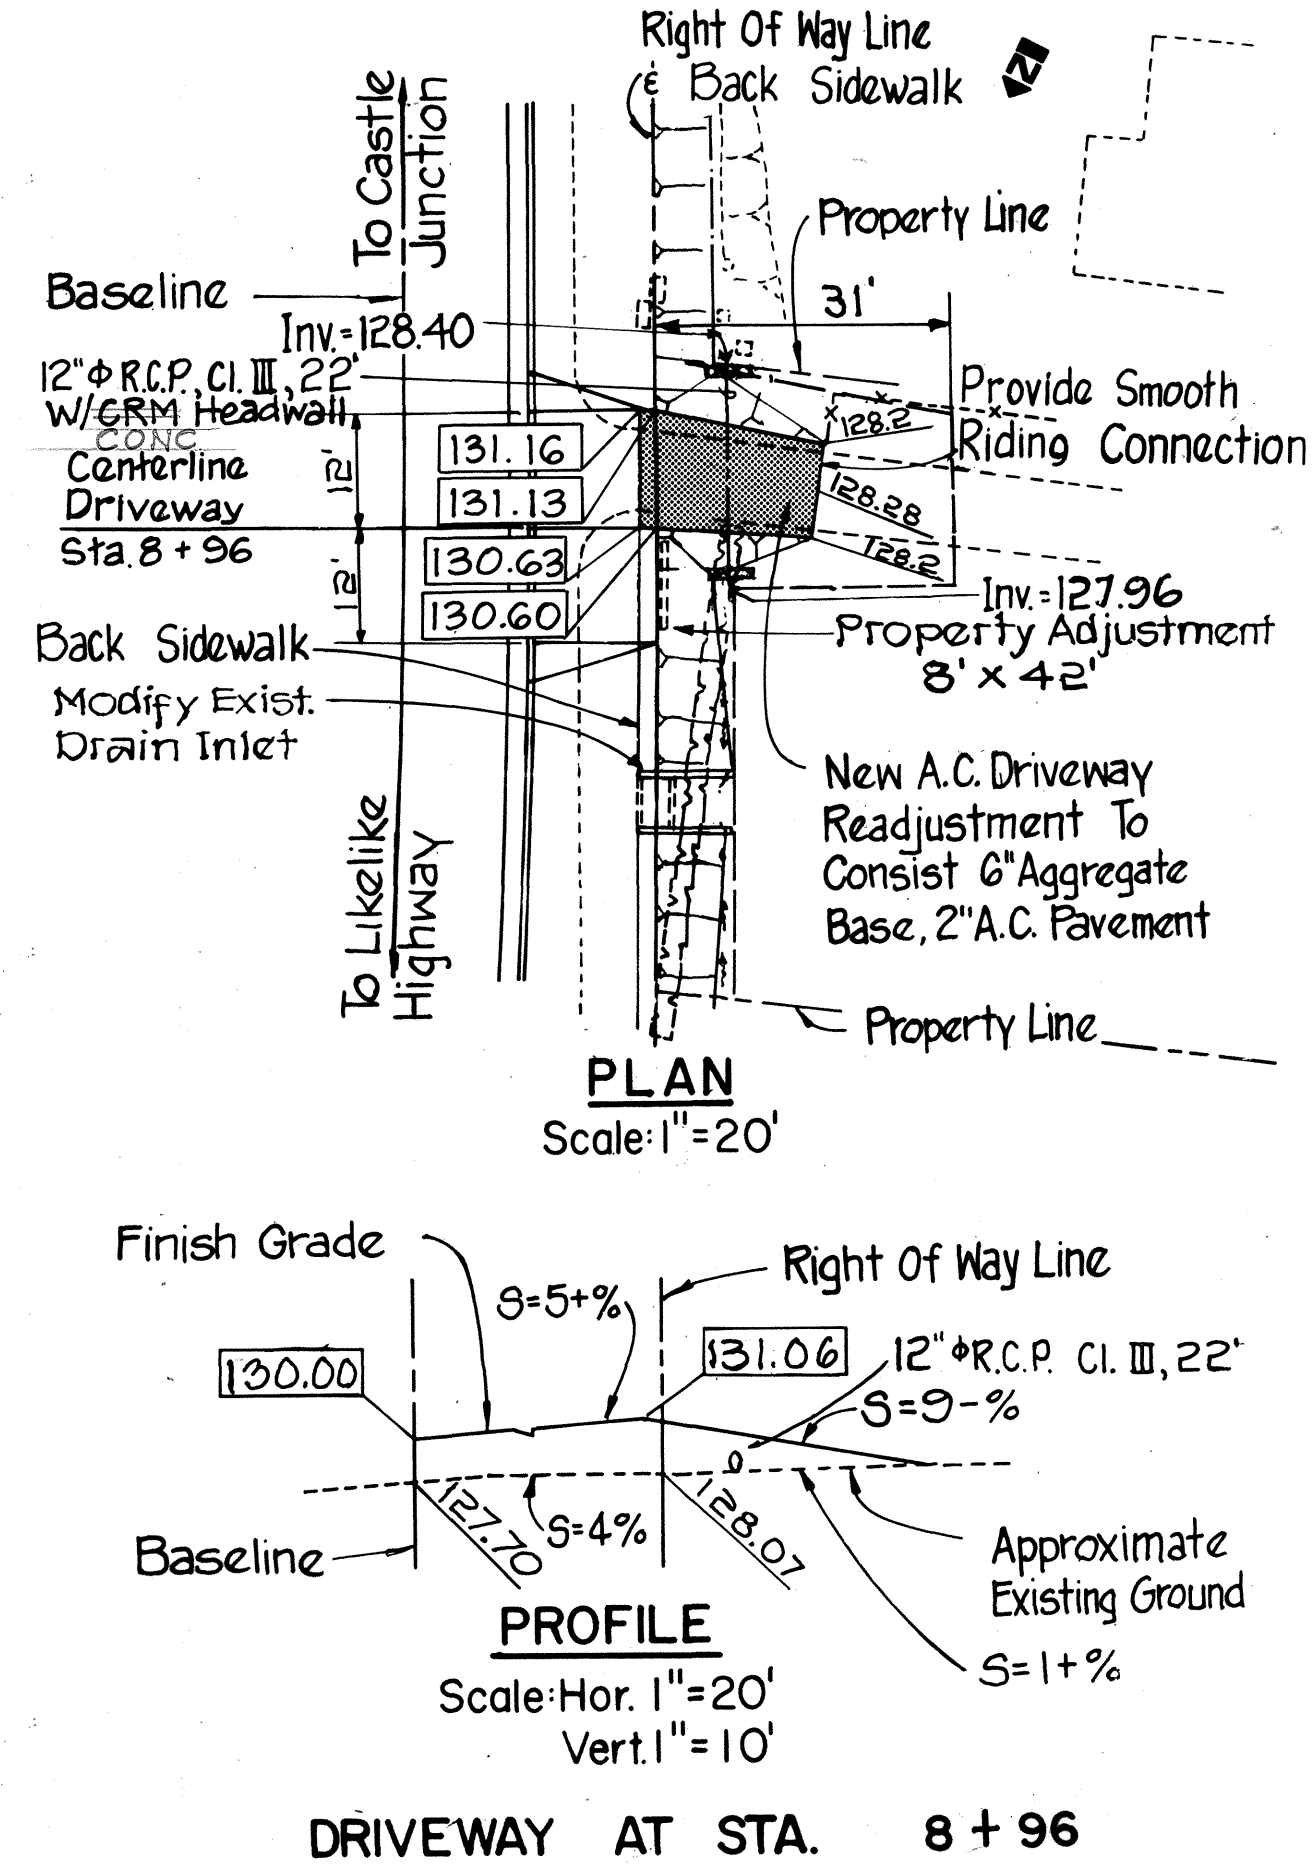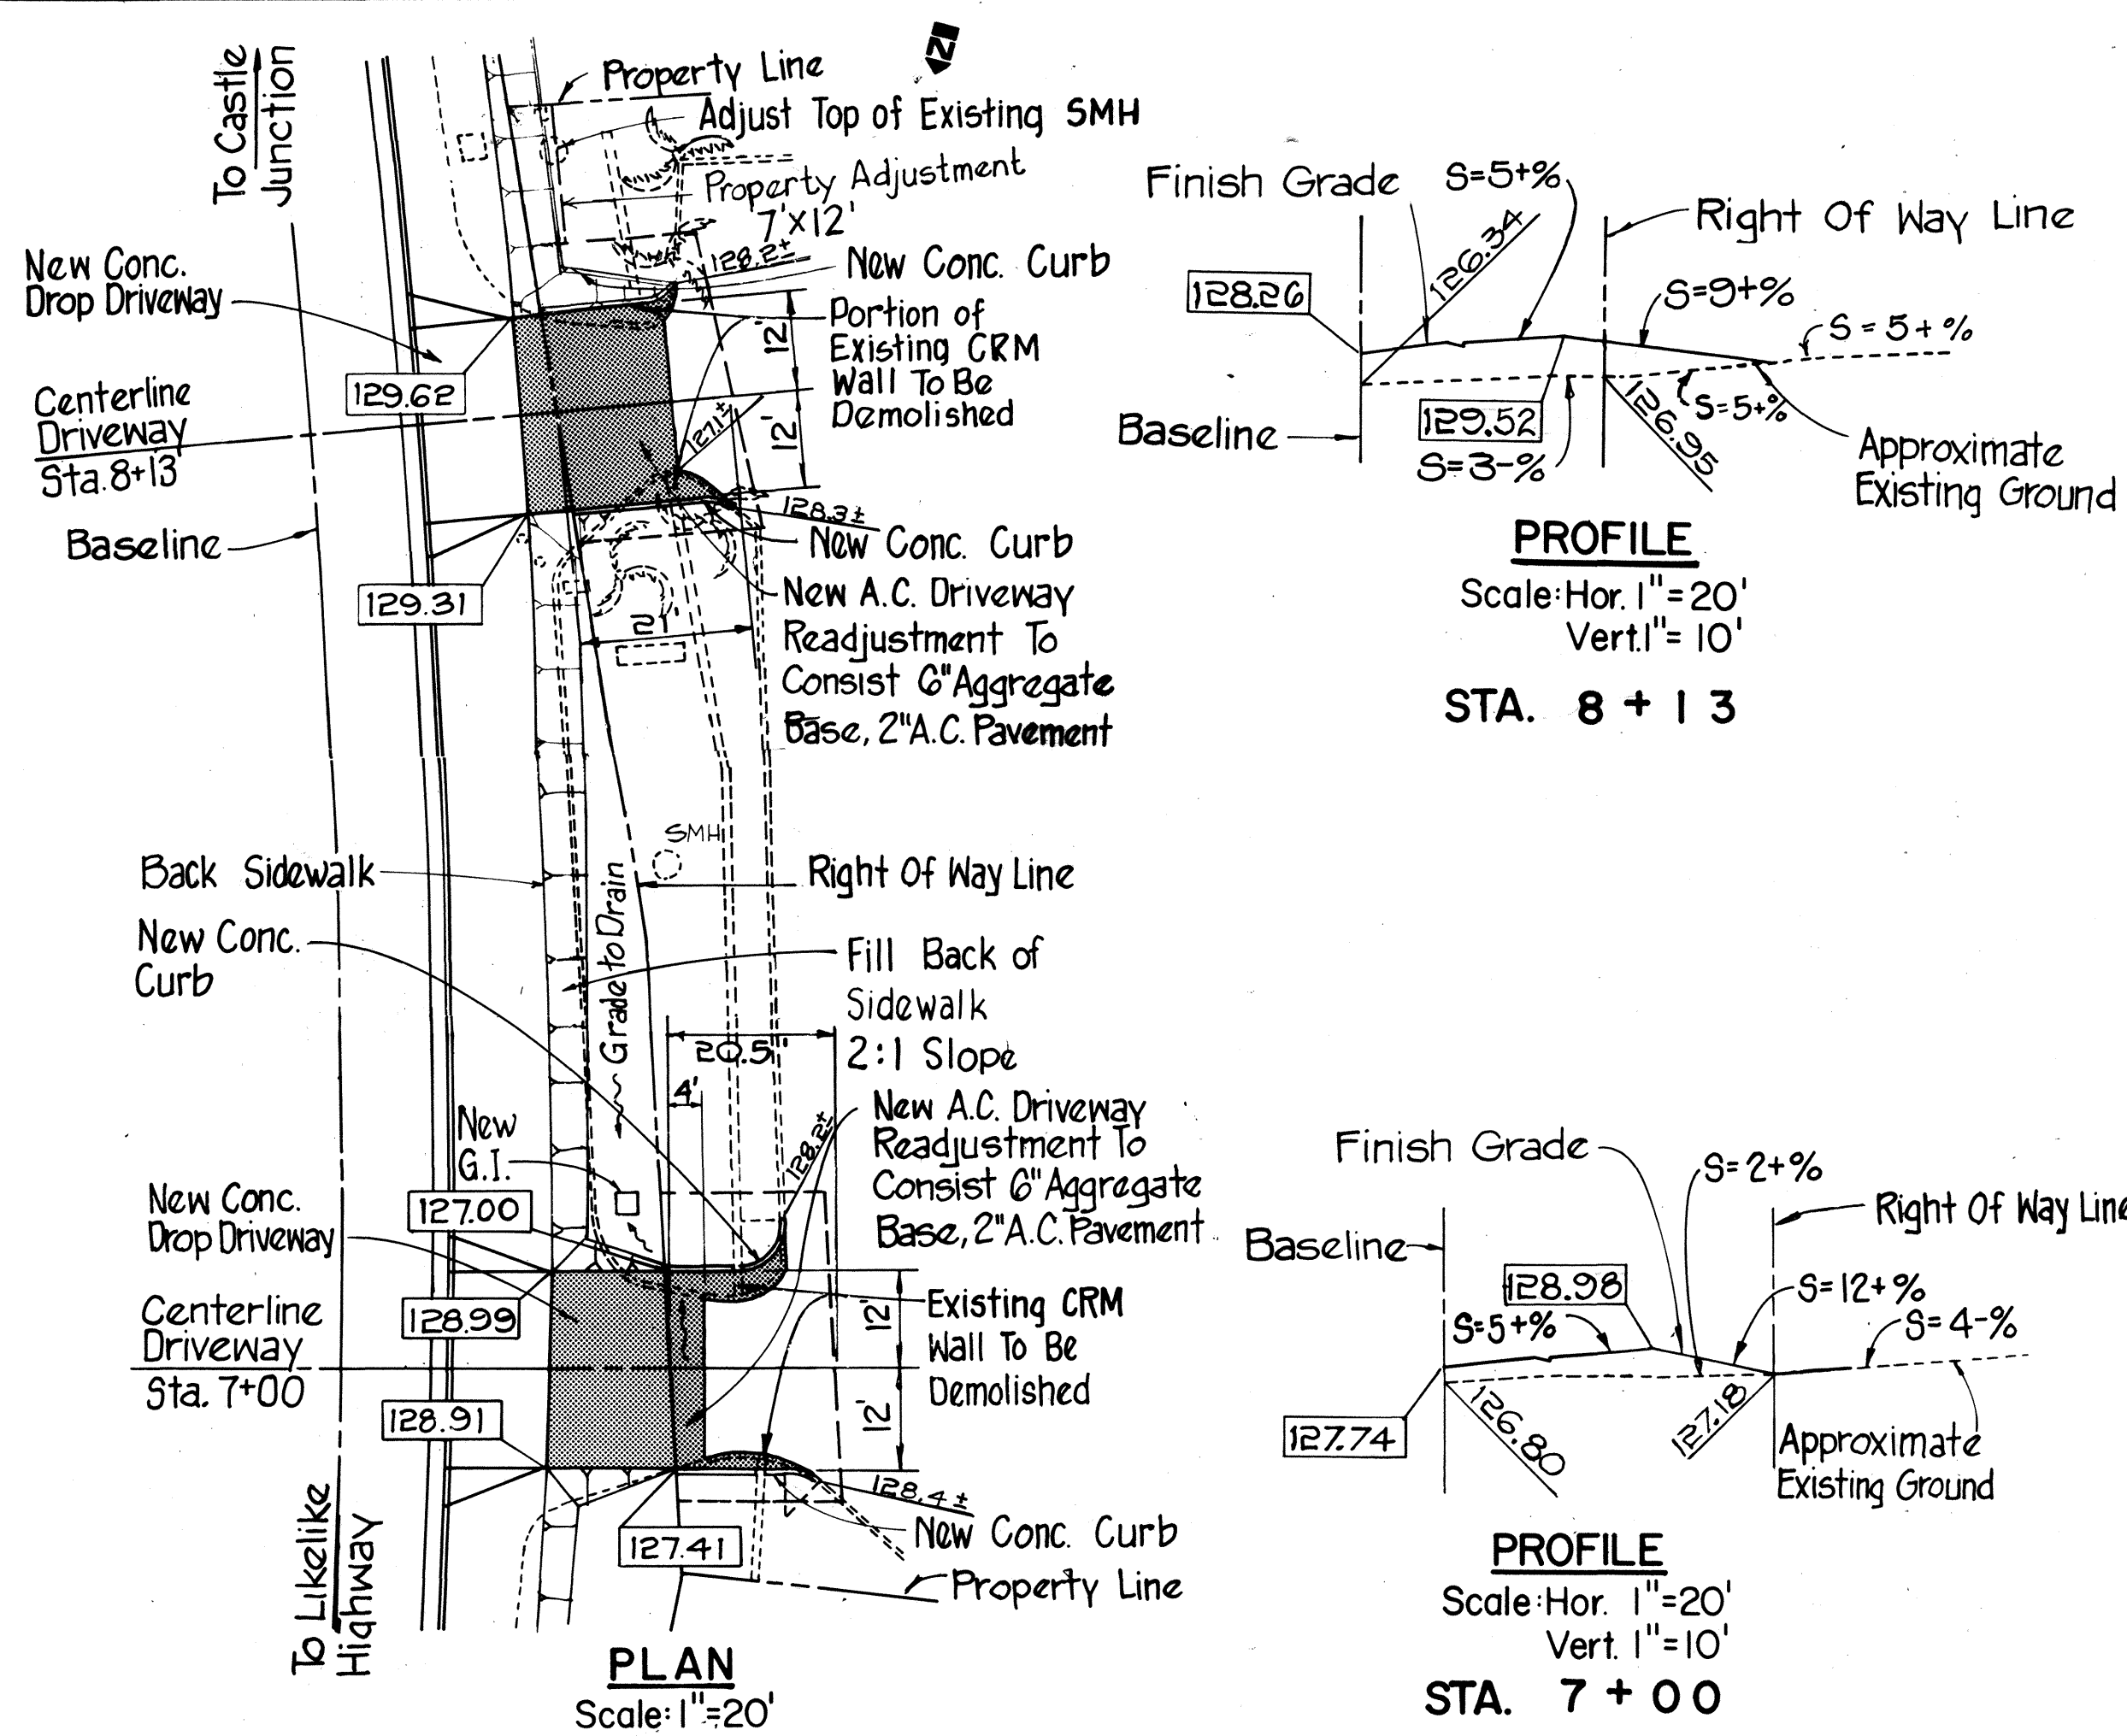

1/9/79	Changed Grades
DATE	REVISION

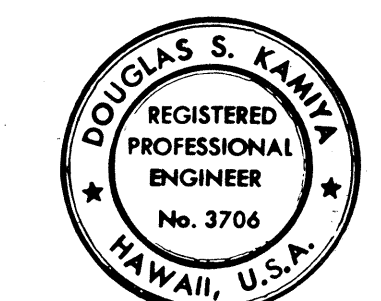

STATE OF HAWAII
DEPARTMENT OF TRANSPORTATION
LAND TRANSPORTATION FACILITIES DIVISION

DRIVEWAY AND PROPERTY ADJUSTMENTS






KAMEHAMEHA HIGHWAY IMPROVEMENT
(LIKELIKE HIGHWAY TO KOOLAU VIEW DRIVE)
PROJECT NO. F - 083 - 1(10)

SCALE: AS SHOWN DATE AUG 1978


SHEET No. 2 OF 8 SHEETS

C.O. 23

FED. ROAD DIST. NO.	STATE	FED. AID PROJ. NO.	FISCAL YEAR	SHEET NO.	TOTAL SHEETS
HAWAII	HAW.	F-083-1(10)	1978	24	160

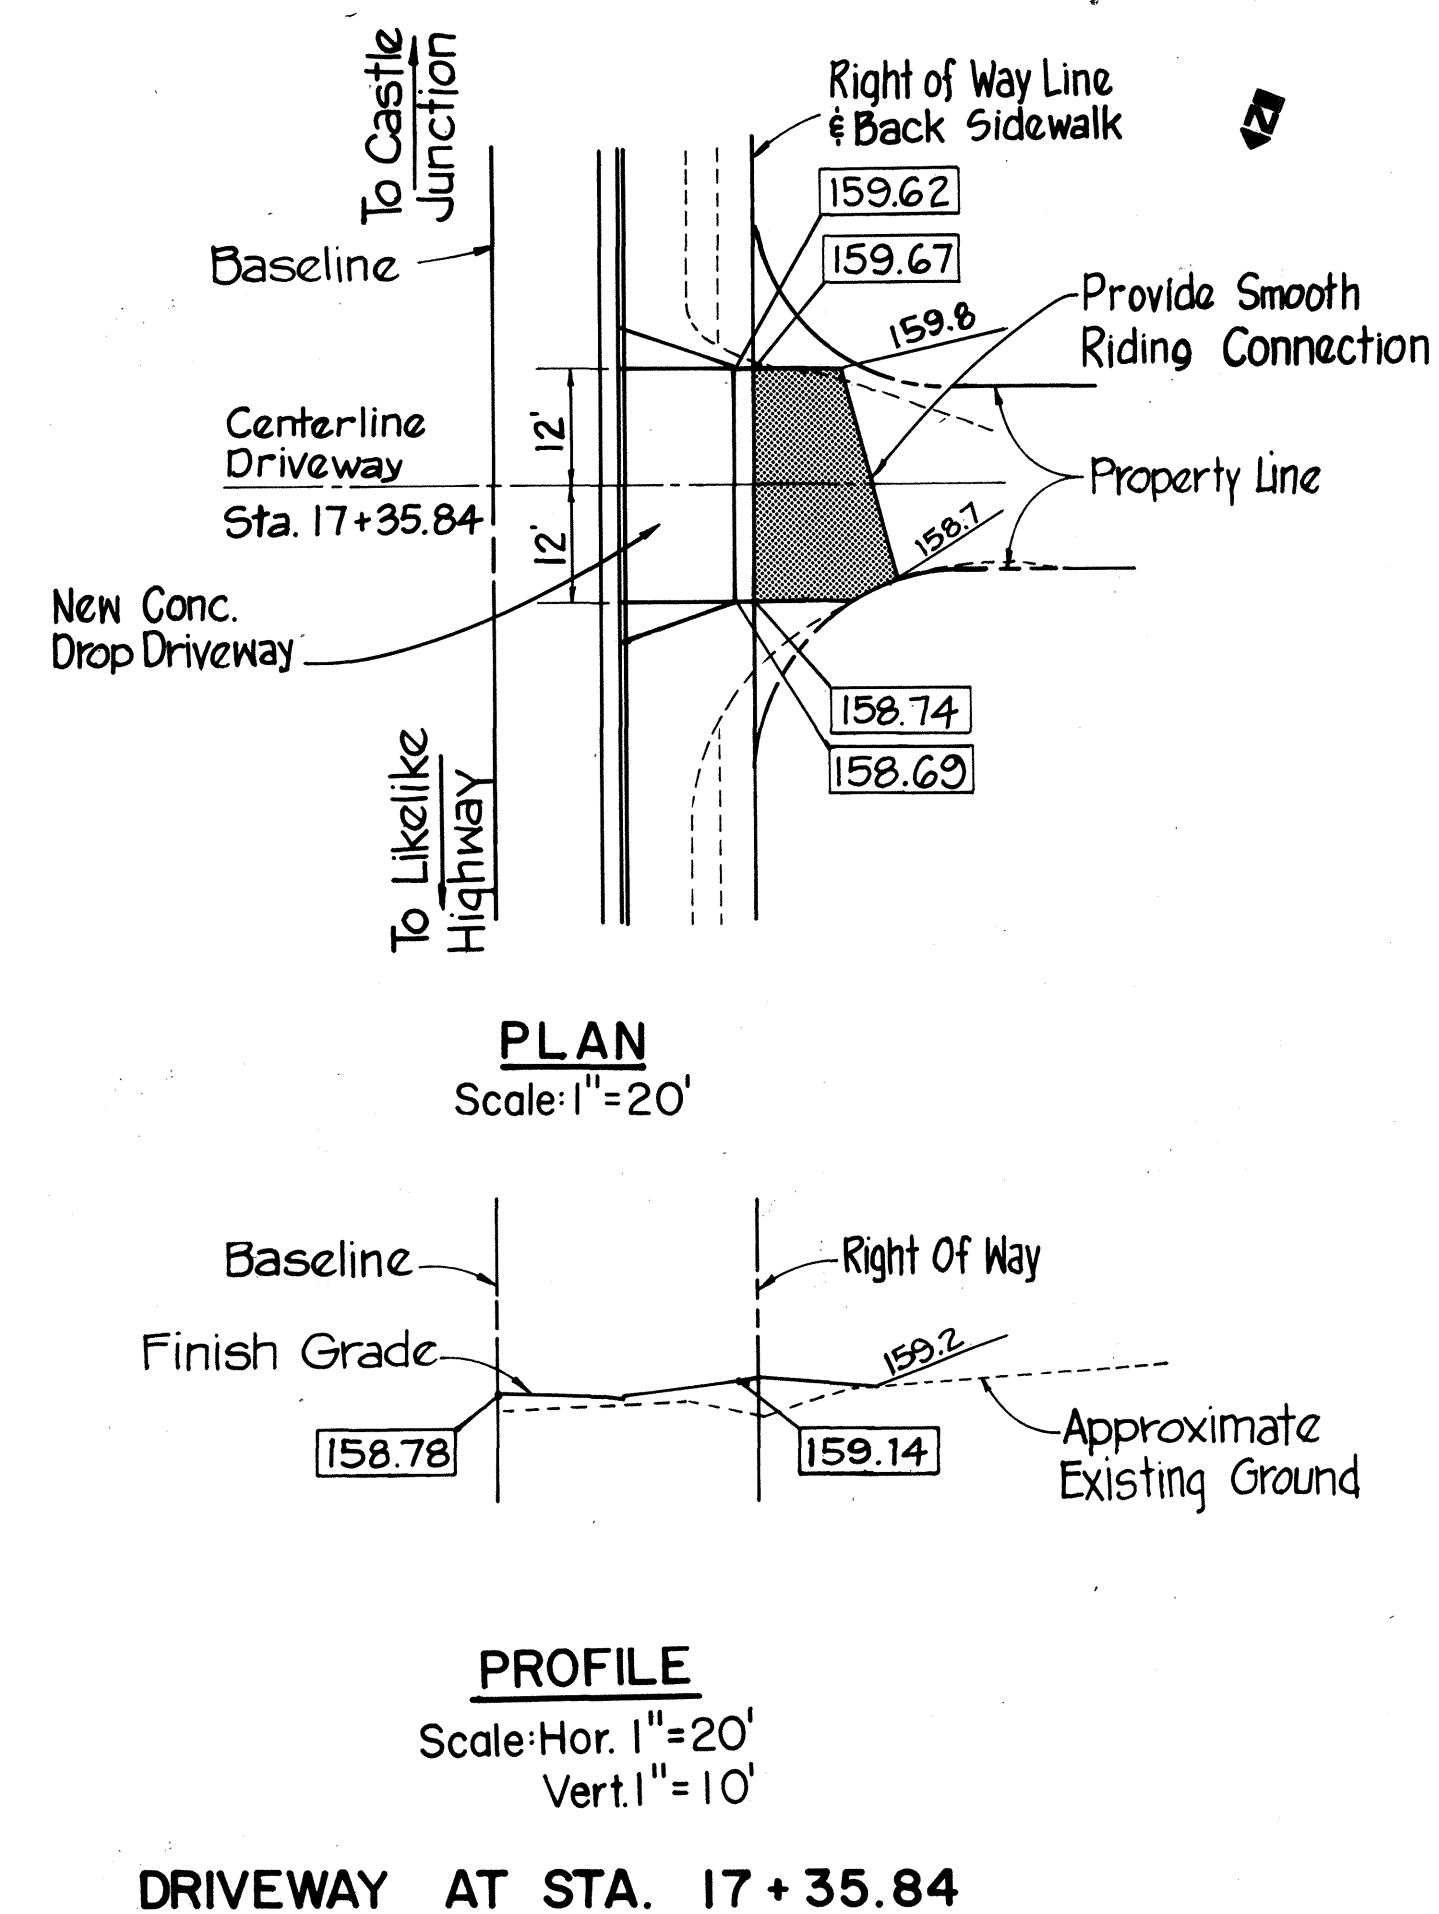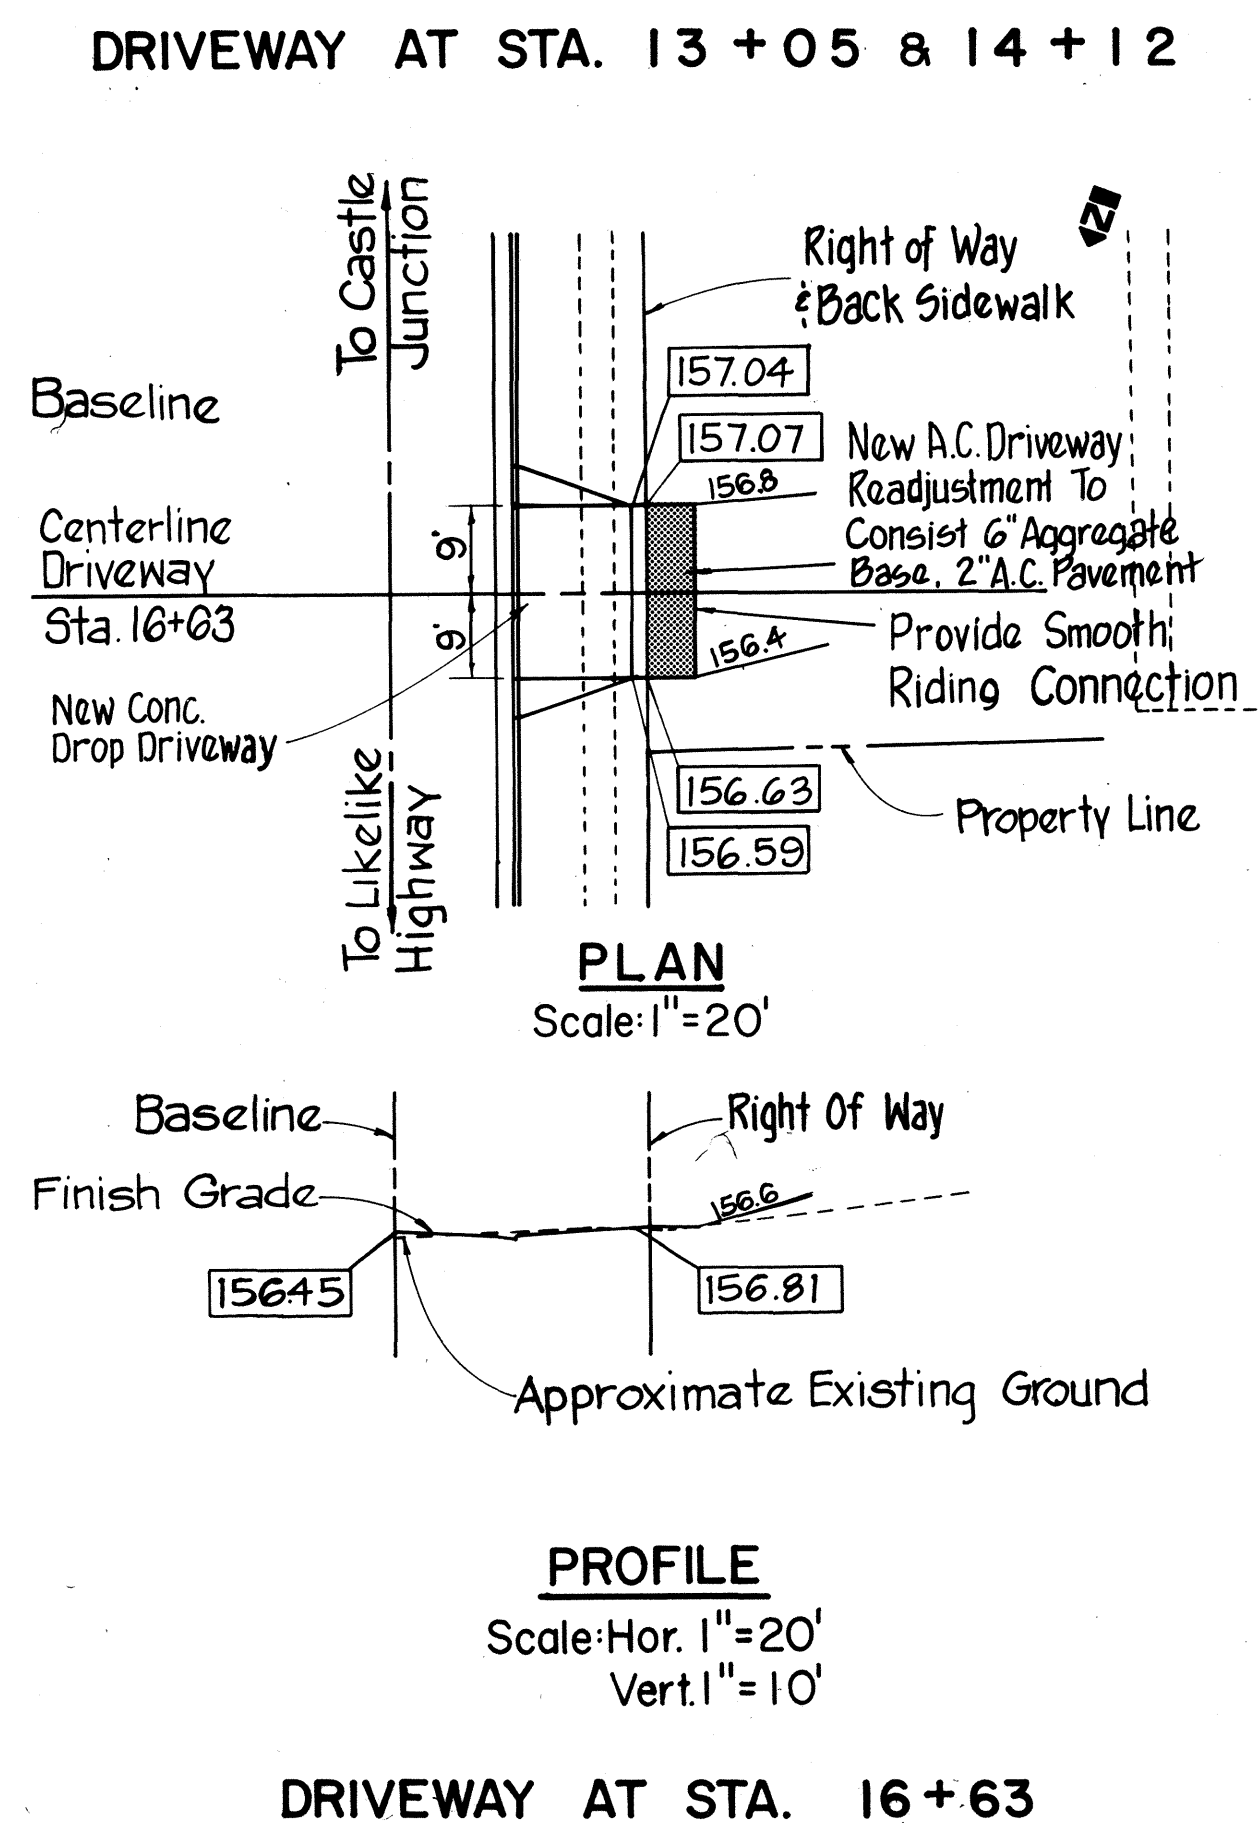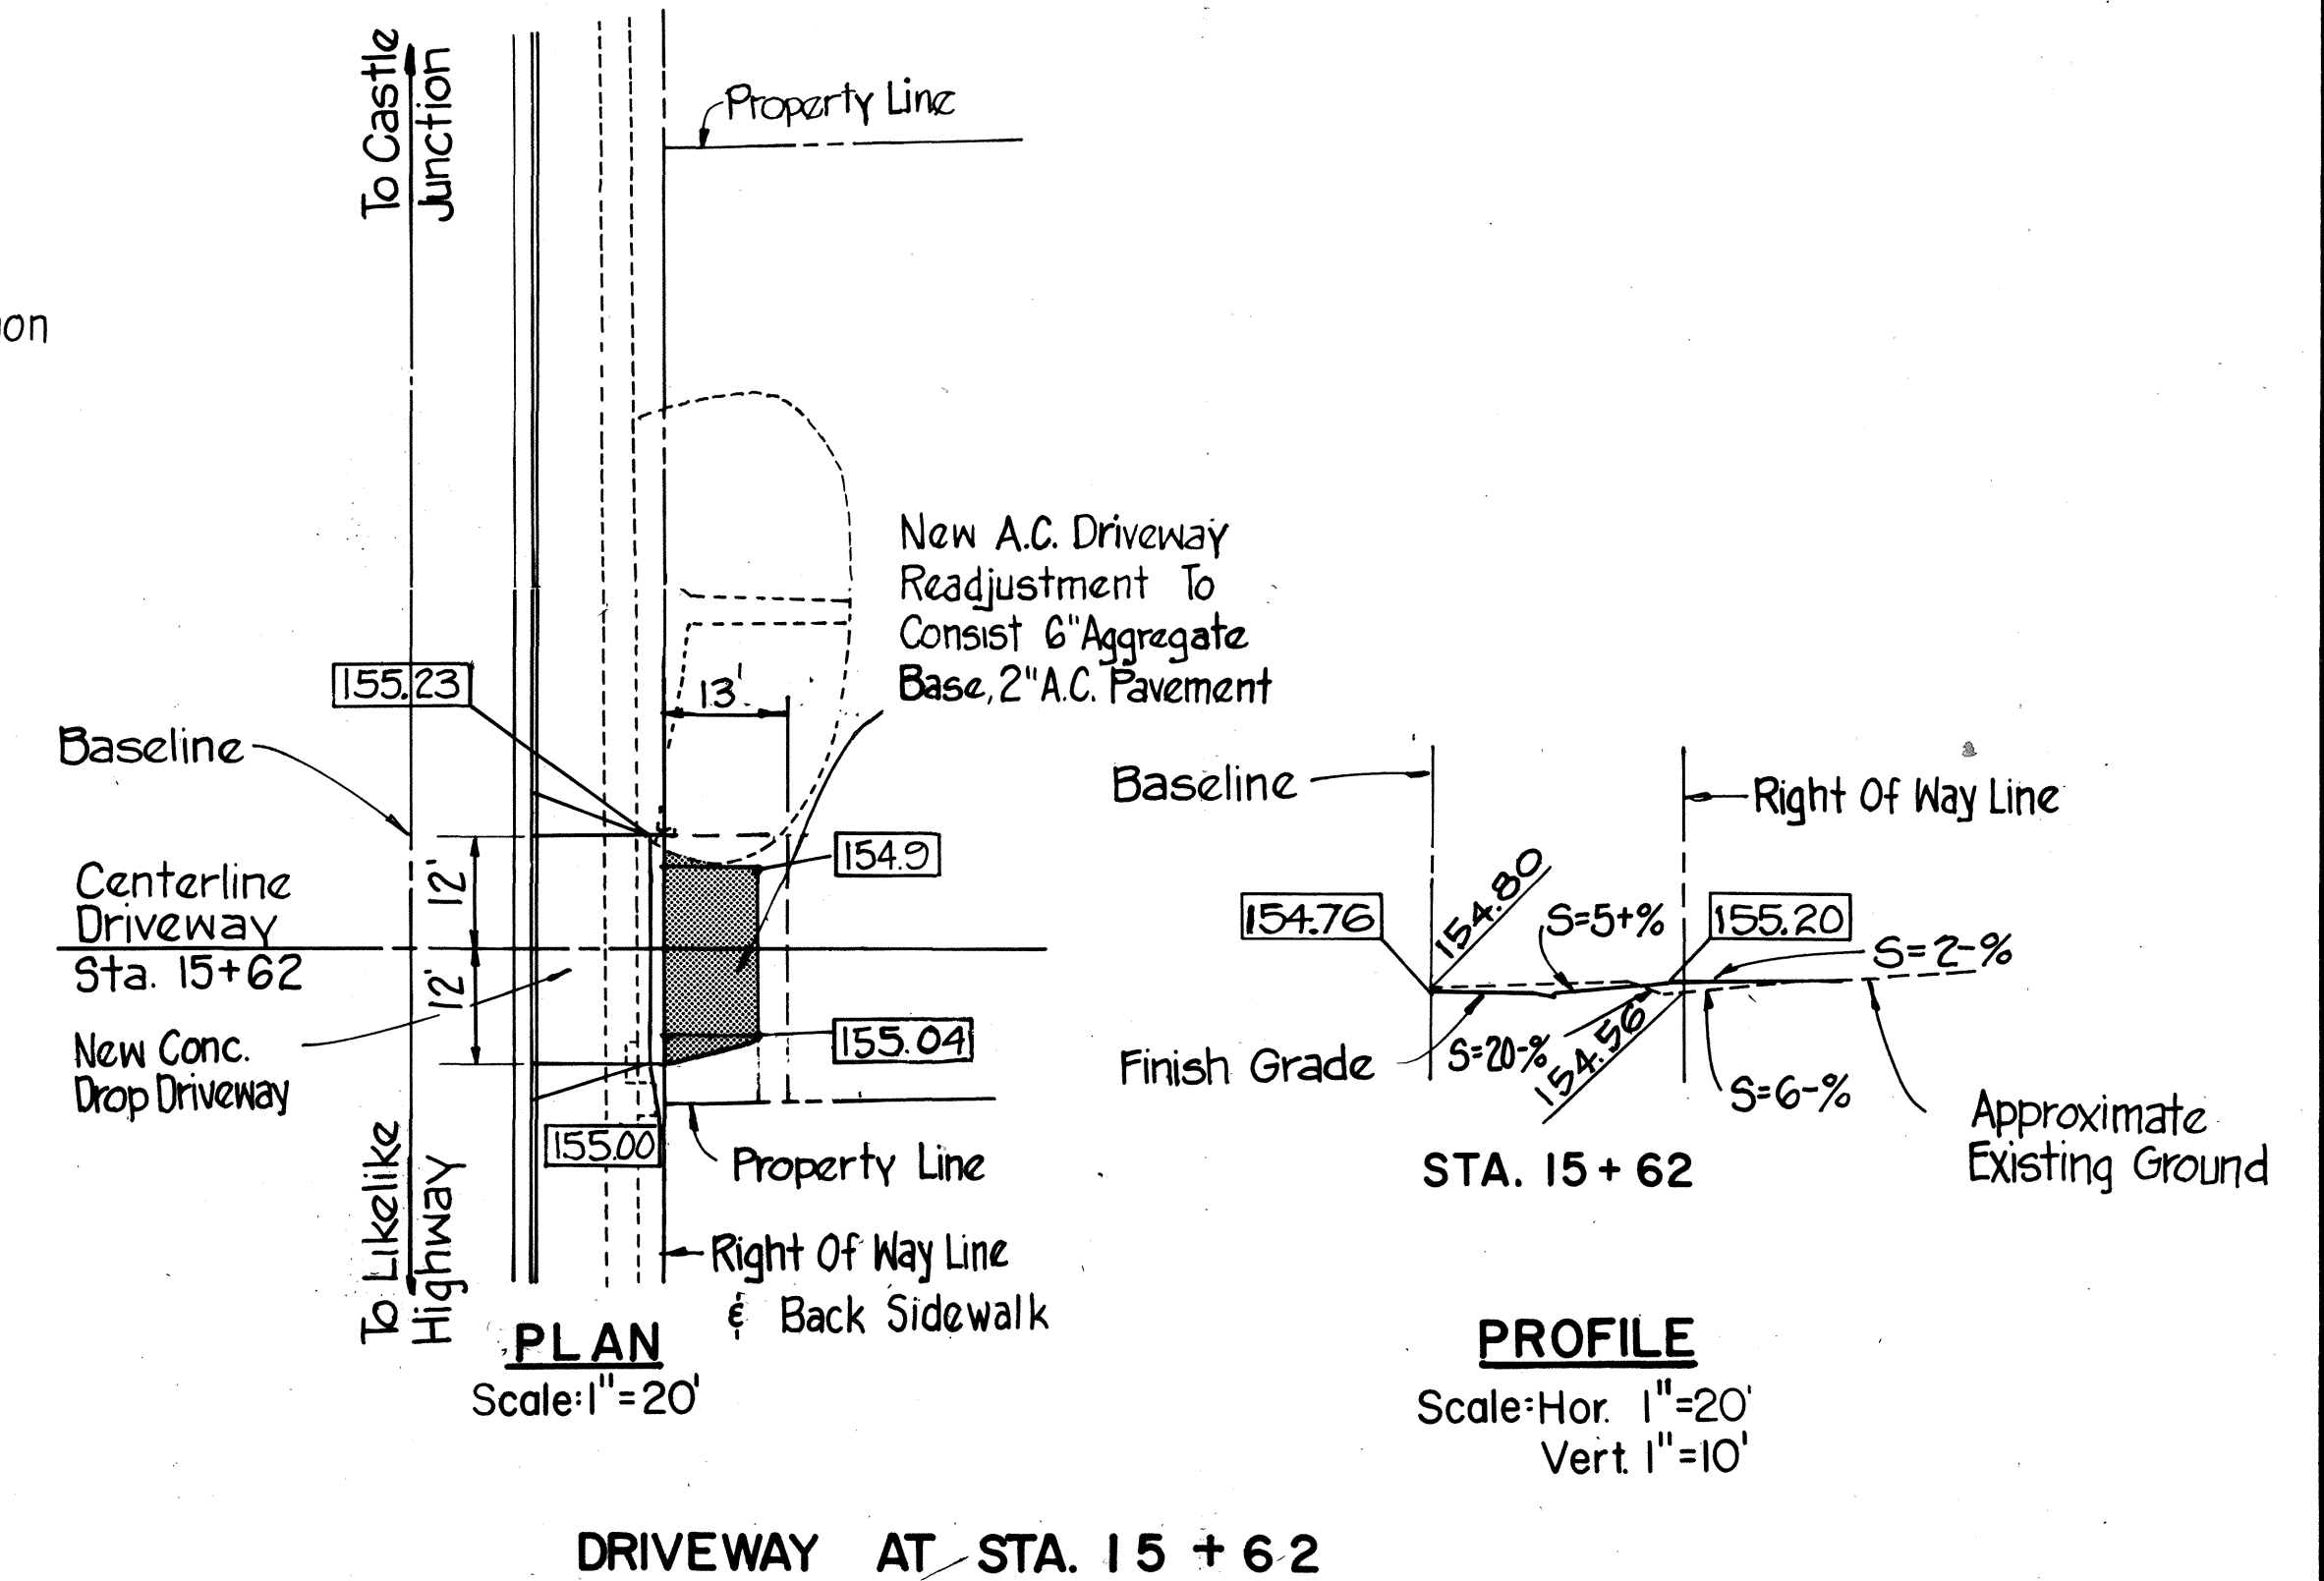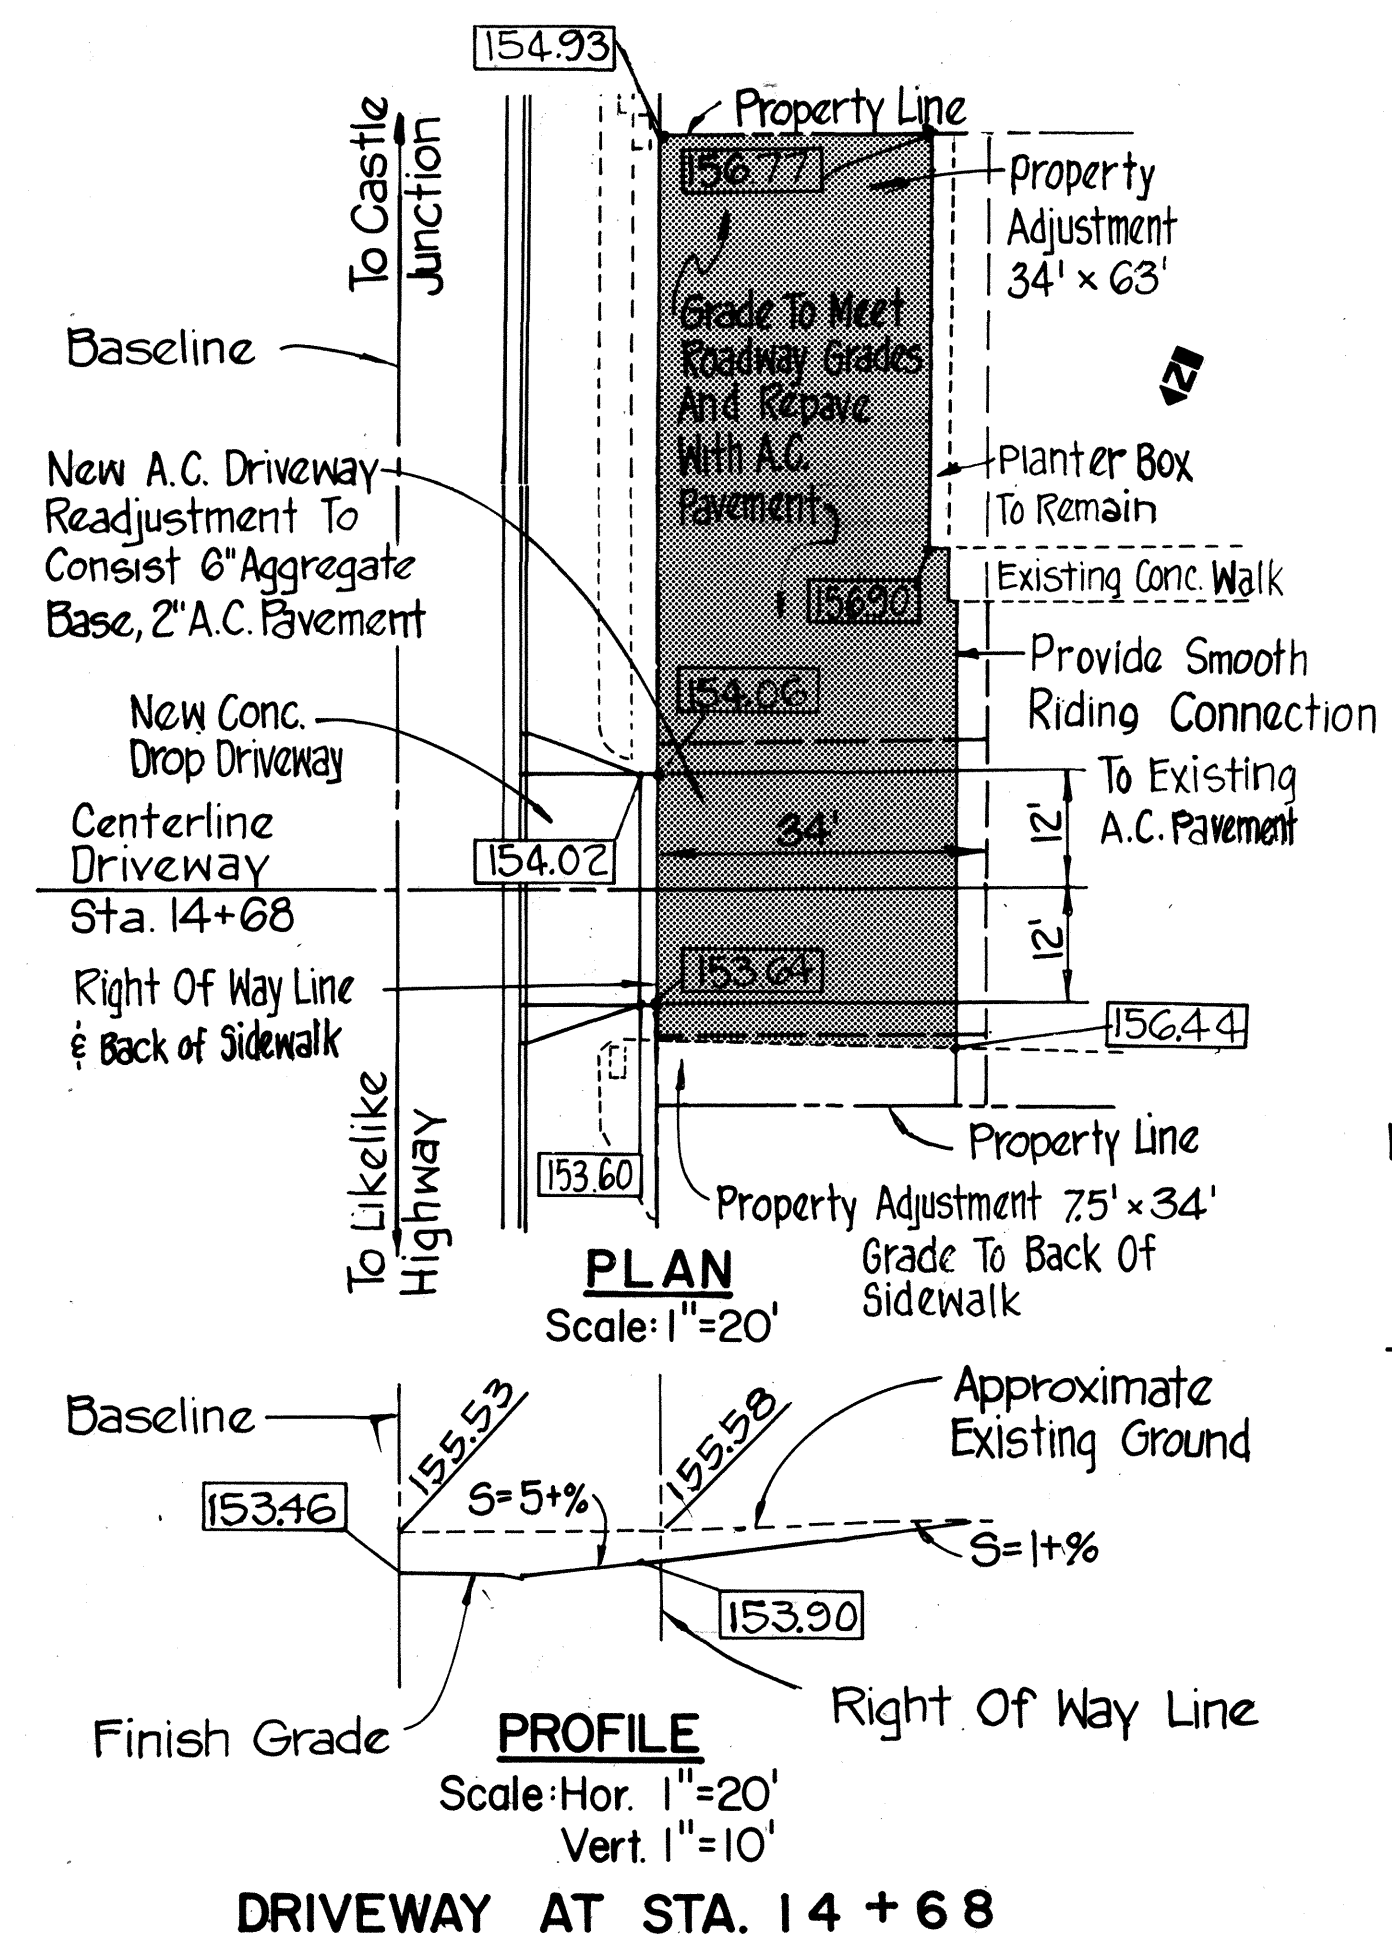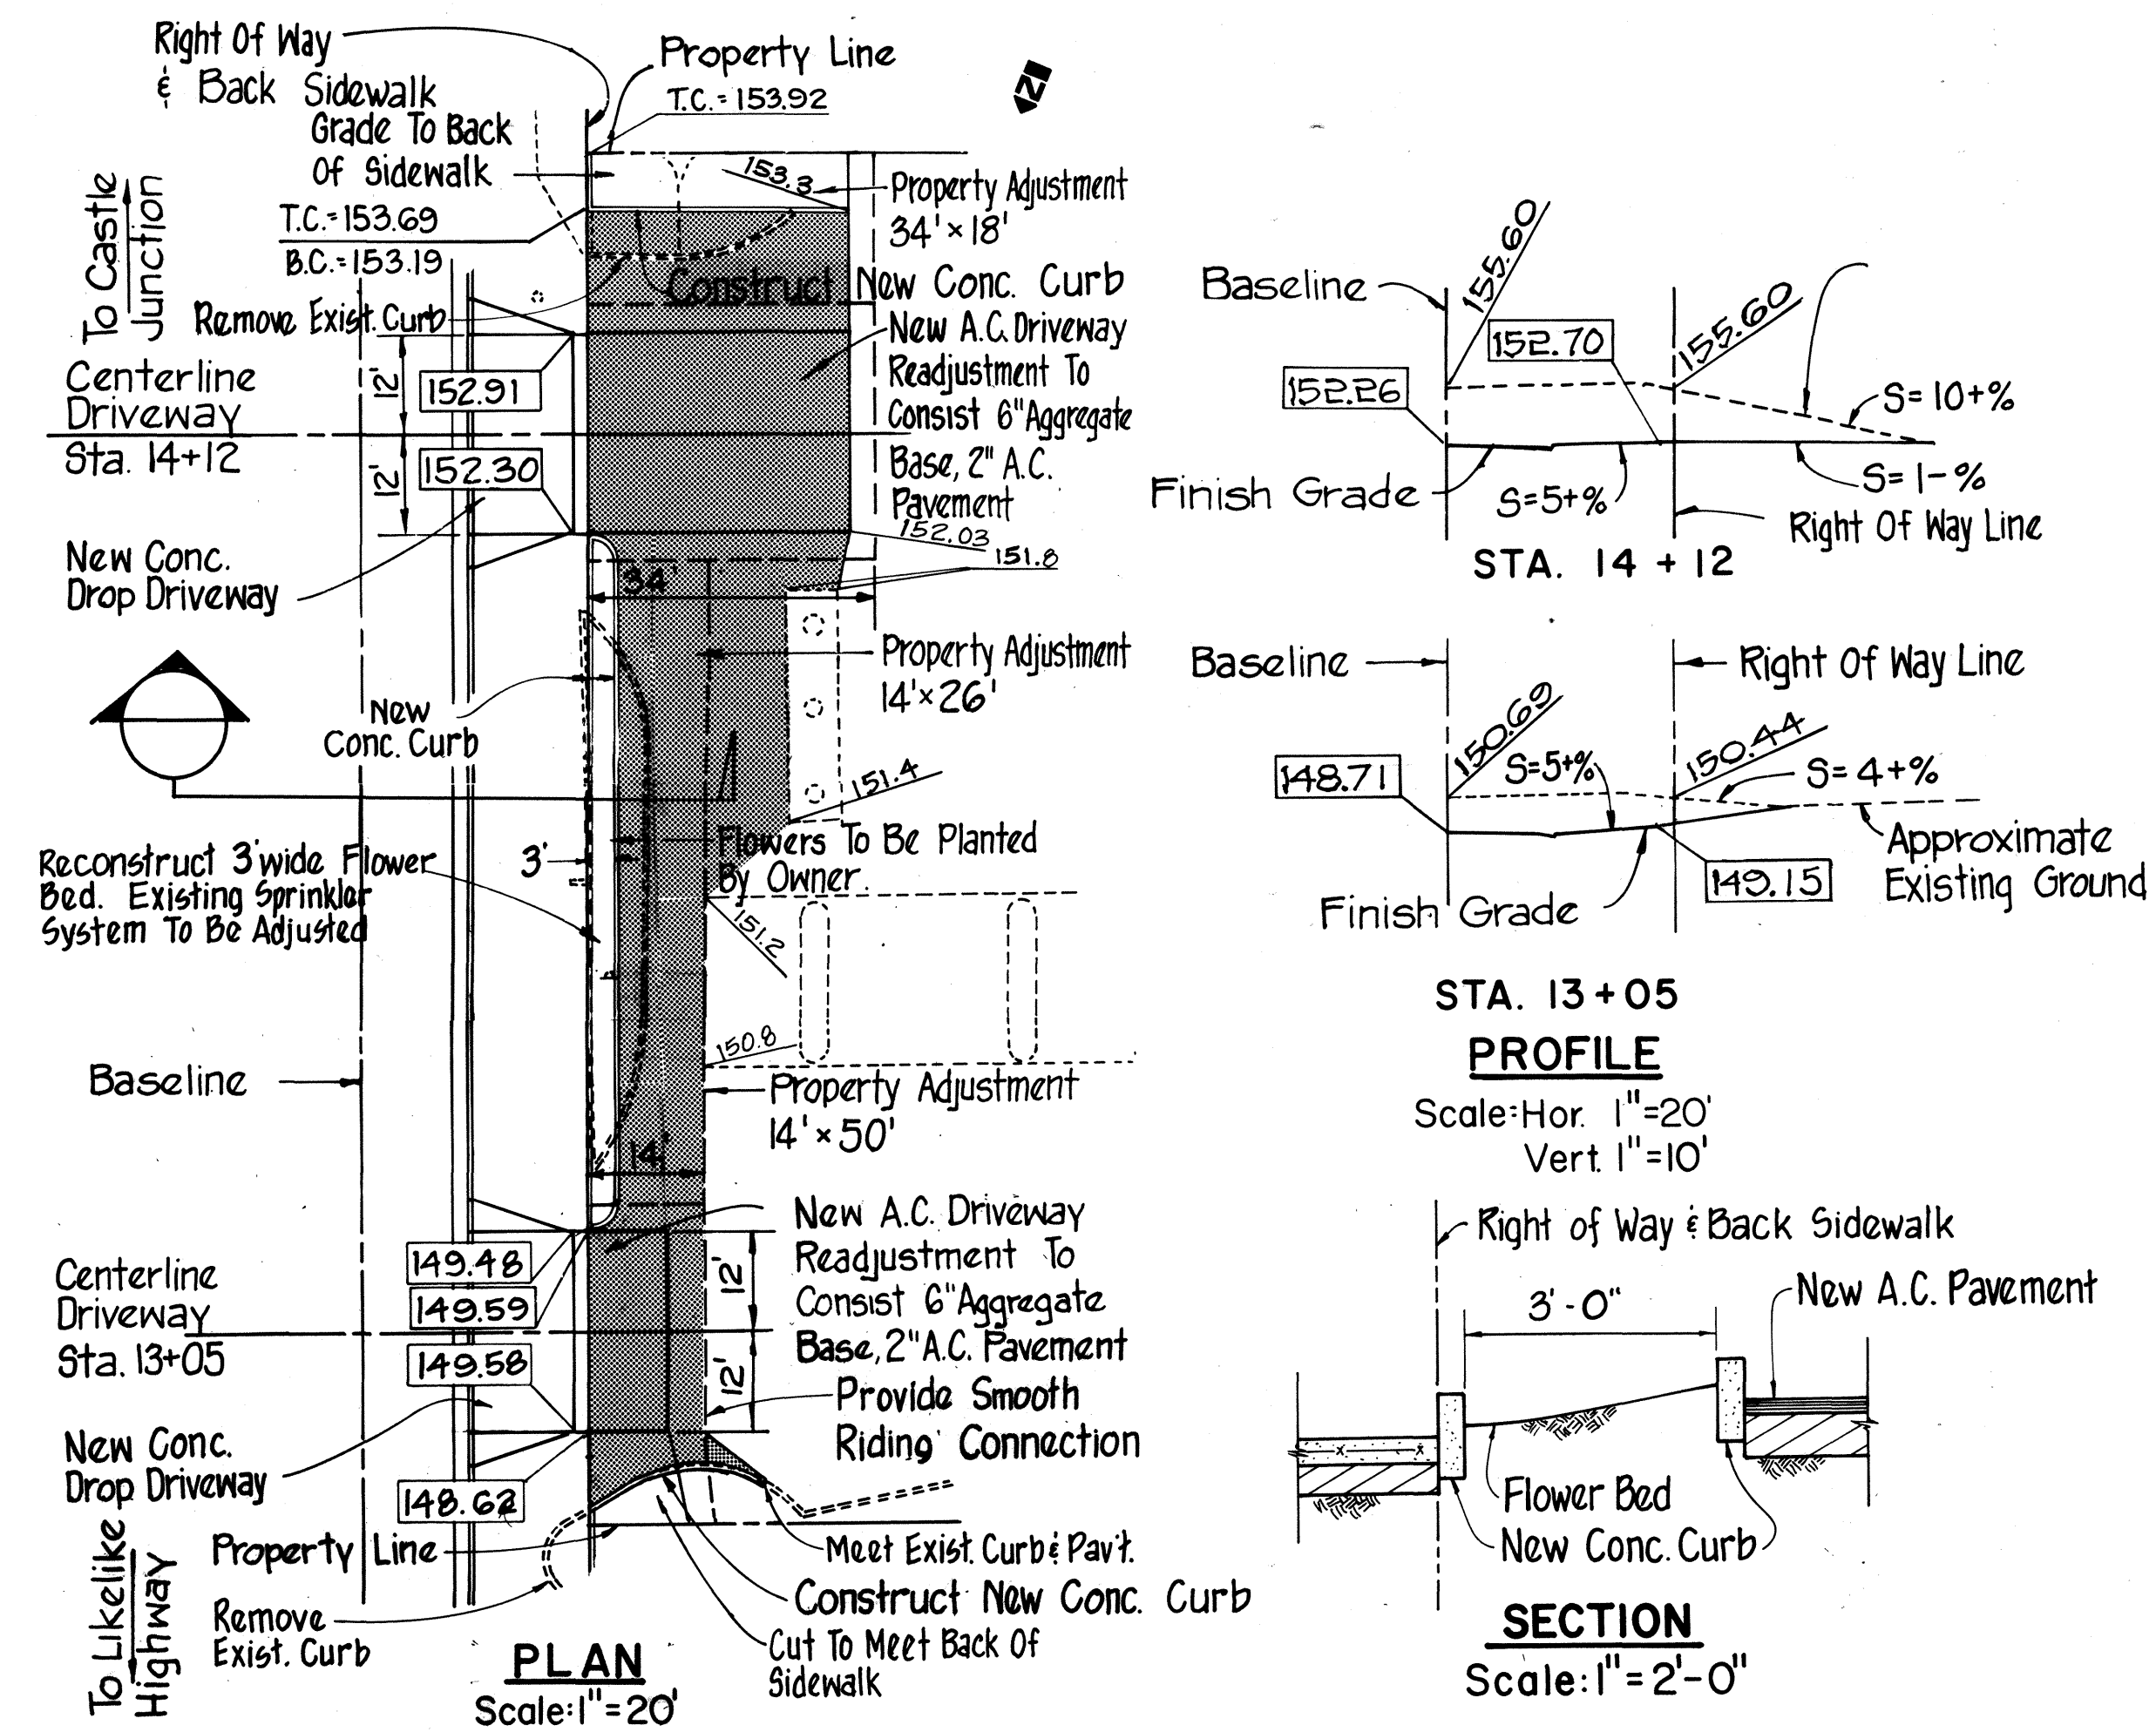

1/9/79	Changed Grades
DATE	REVISION

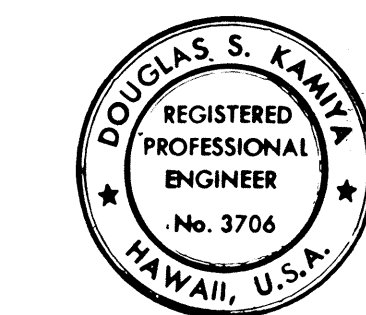

STATE OF HAWAII
DEPARTMENT OF TRANSPORTATION
LAND TRANSPORTATION FACILITIES DIVISION

DRIVEWAY AND PROPERTY
ADJUSTMENTS





KAMEHAMEHA HIGHWAY
IMPROVEMENT
(LIKEWISE HIGHWAY TO KOOLAU VIEW DRIVE)
PROJECT NO. F - 083 - 1(10)

SCALE: AS SHOWN DATE AUG 1978




SHEET No. 3 OF 8 SHEETS

ORIGINAL PLAN	SURVEY PLOTTED BY _____ DATE _____
NOTE BOOK	DRAWN BY _____
	TRACED BY _____
	DESIGNED BY _____
	QUANTITIES BY _____
No. _____	CHECKED BY _____


FED. ROAD DIST. NO.	STATE	FED. AID PROJ. NO.	FISCAL YEAR	SHEET NO.	TOTAL SHEETS
HAWAII	HAW.	F-083-1(10)	1978	25	160

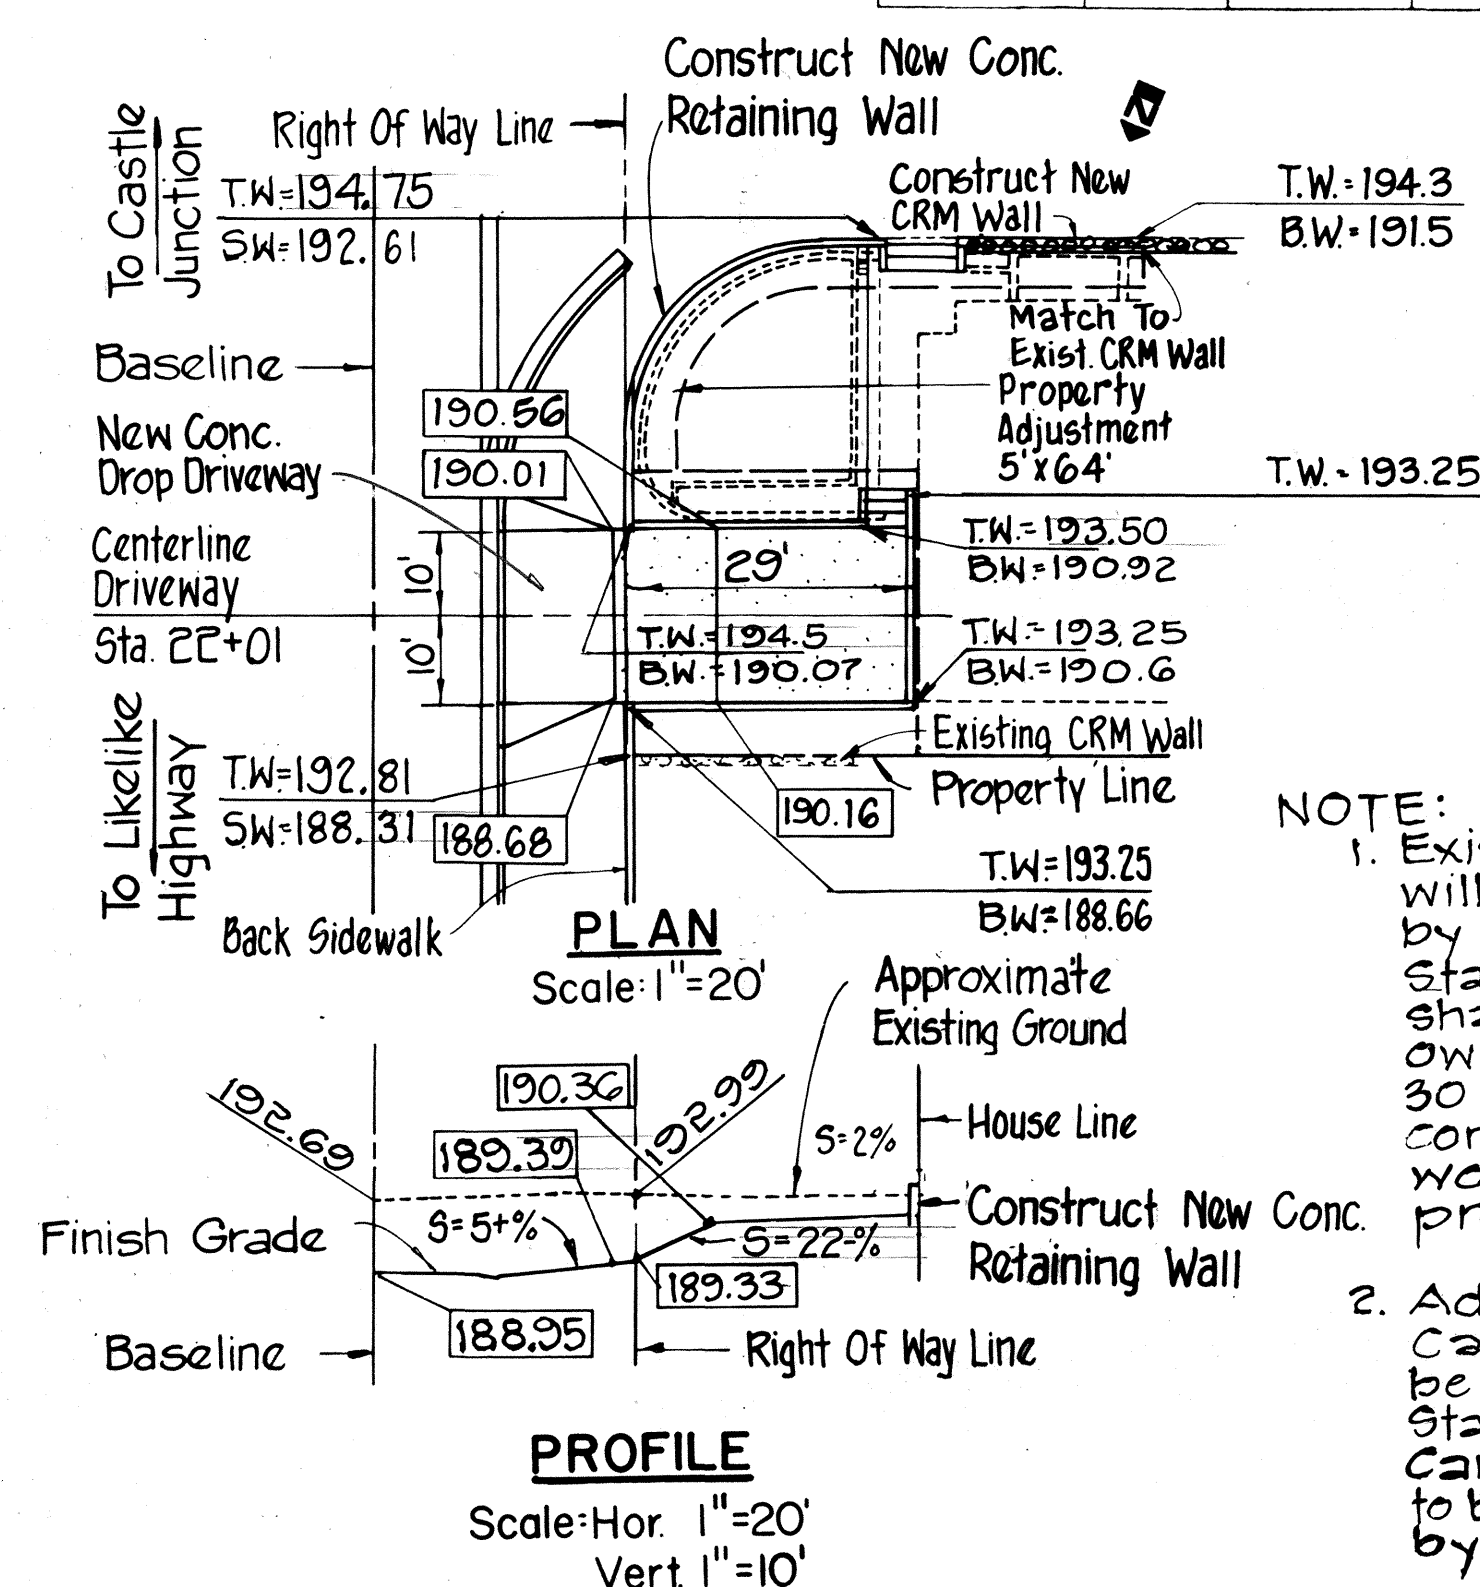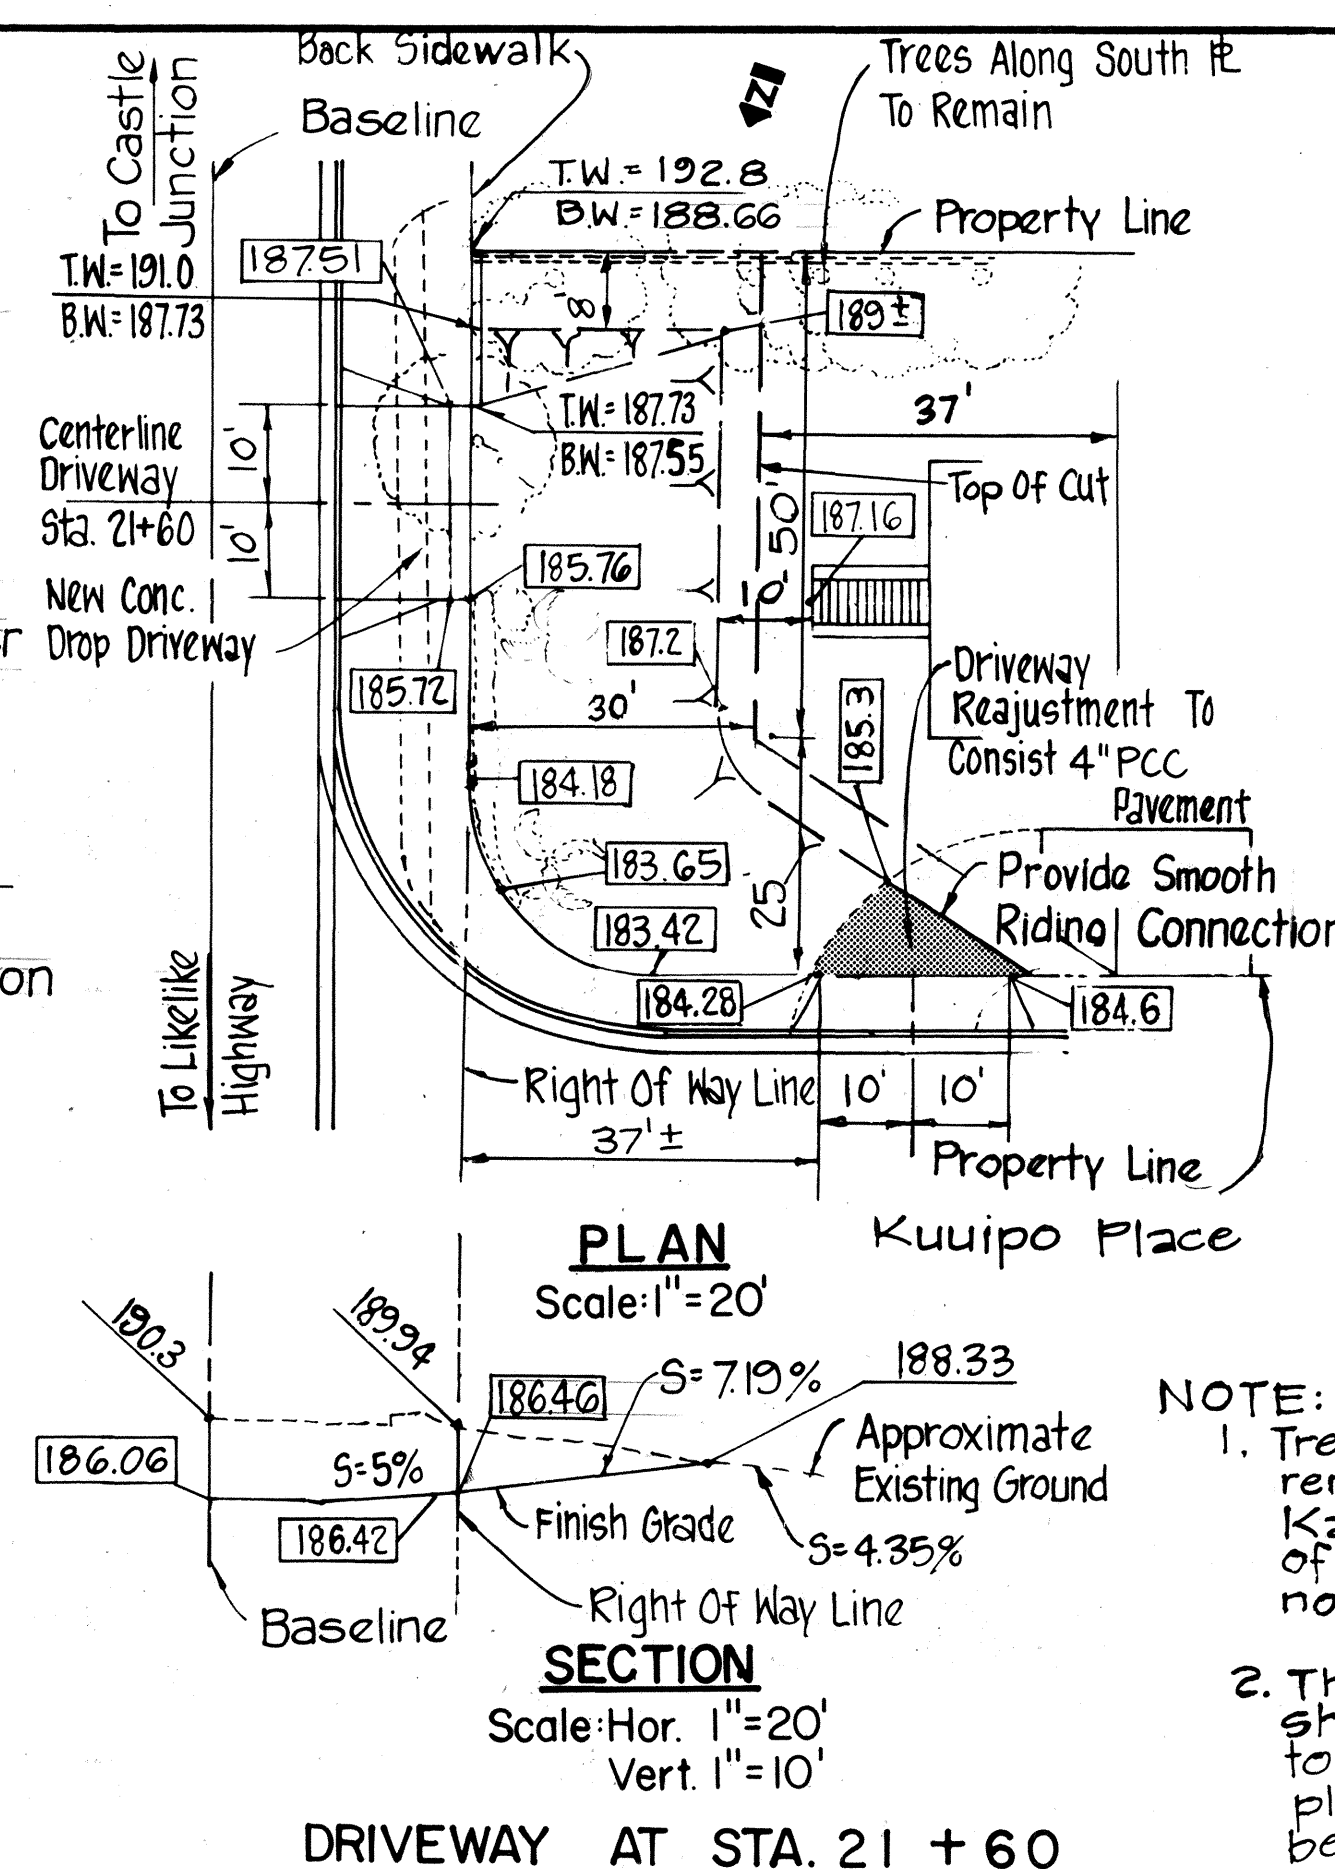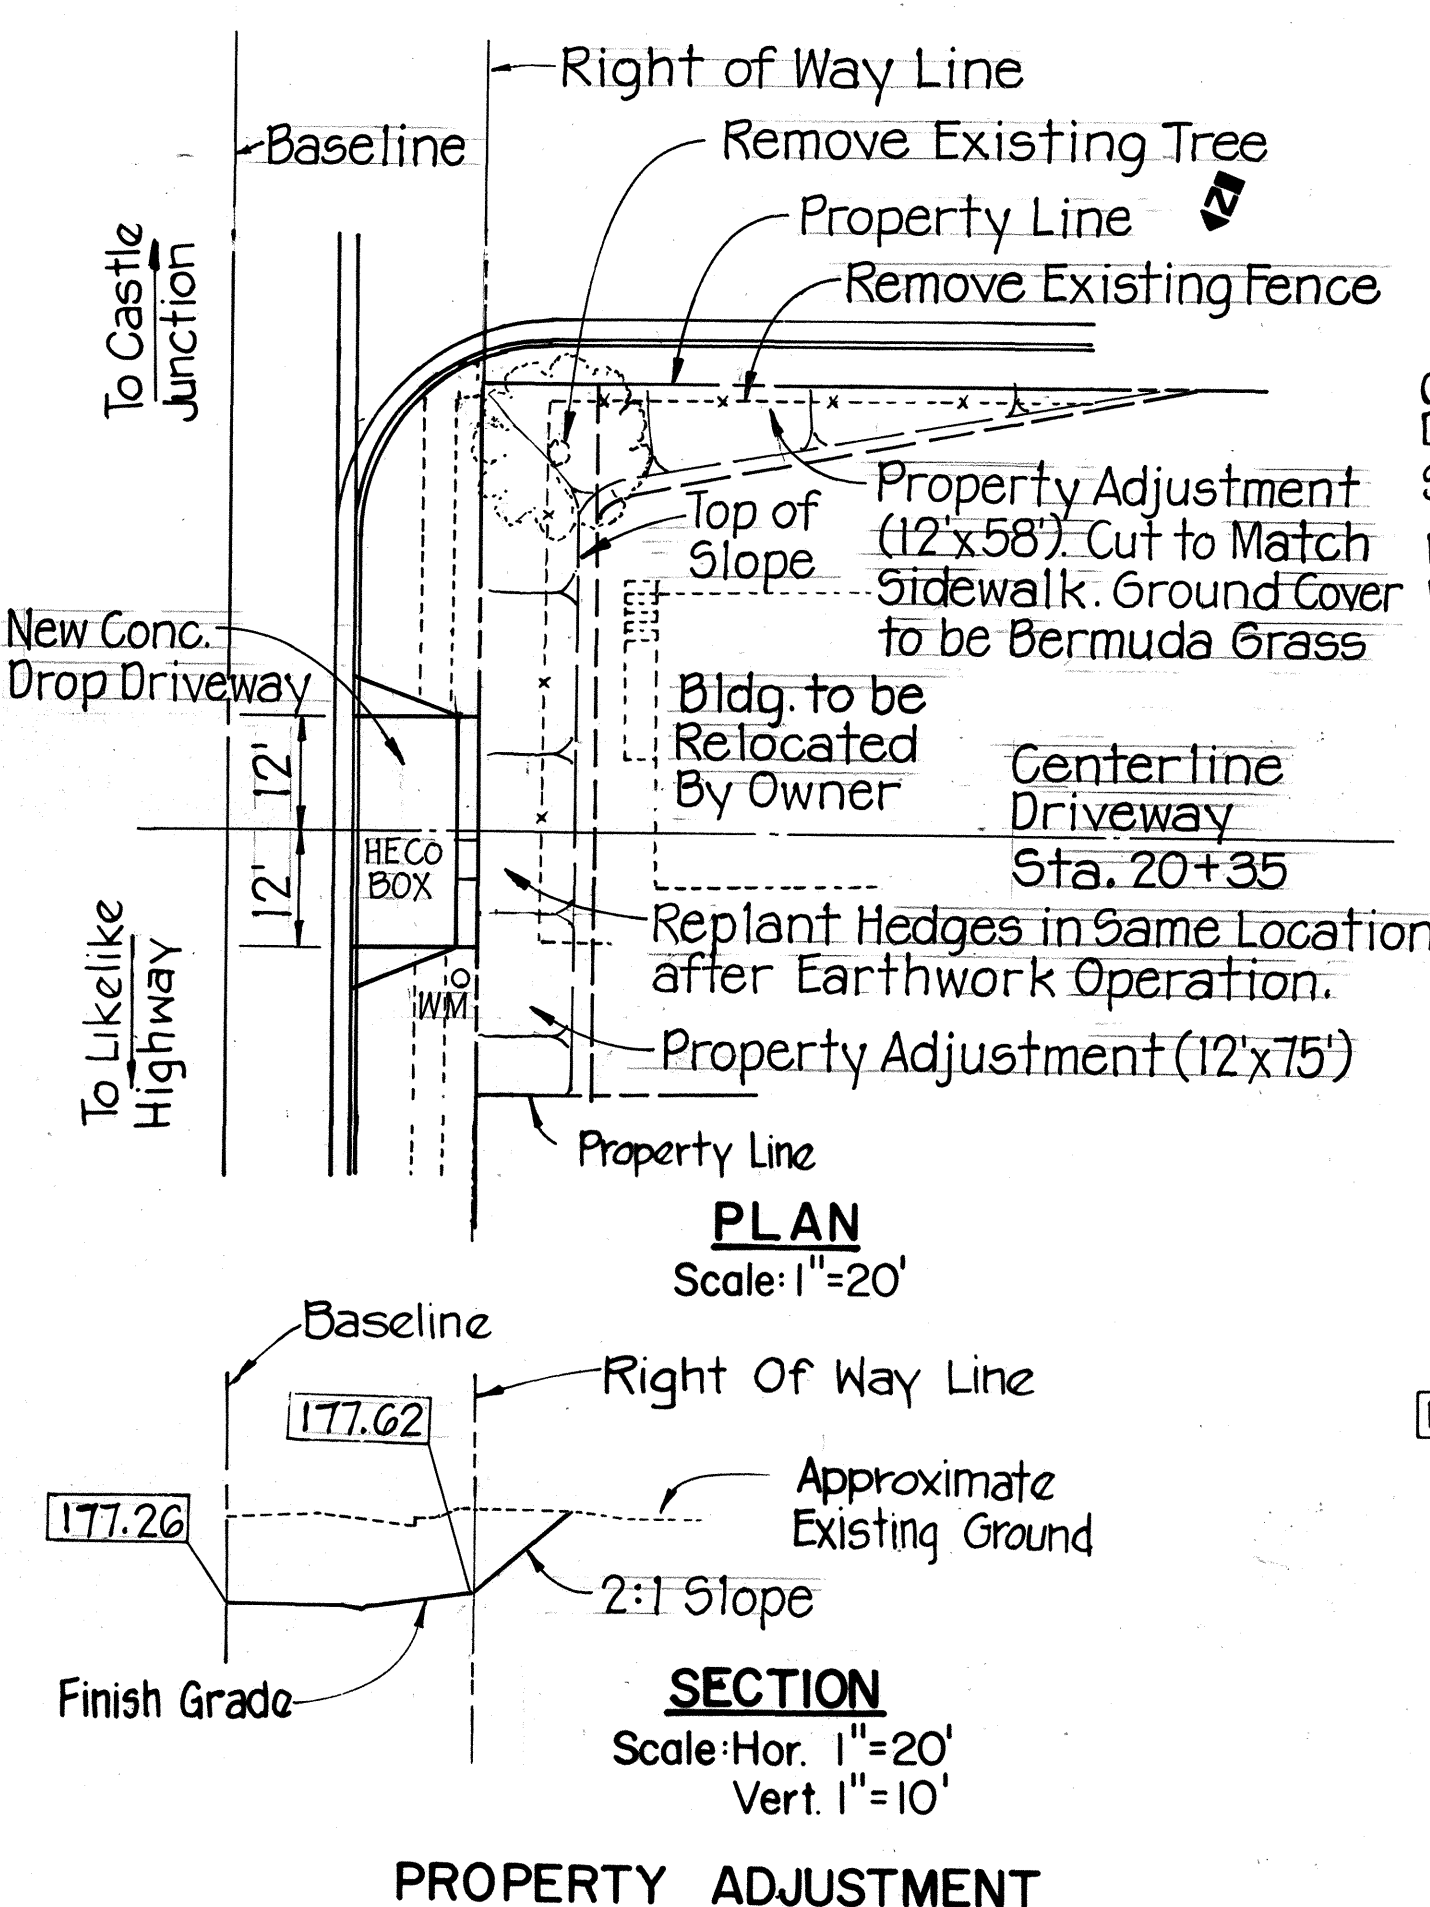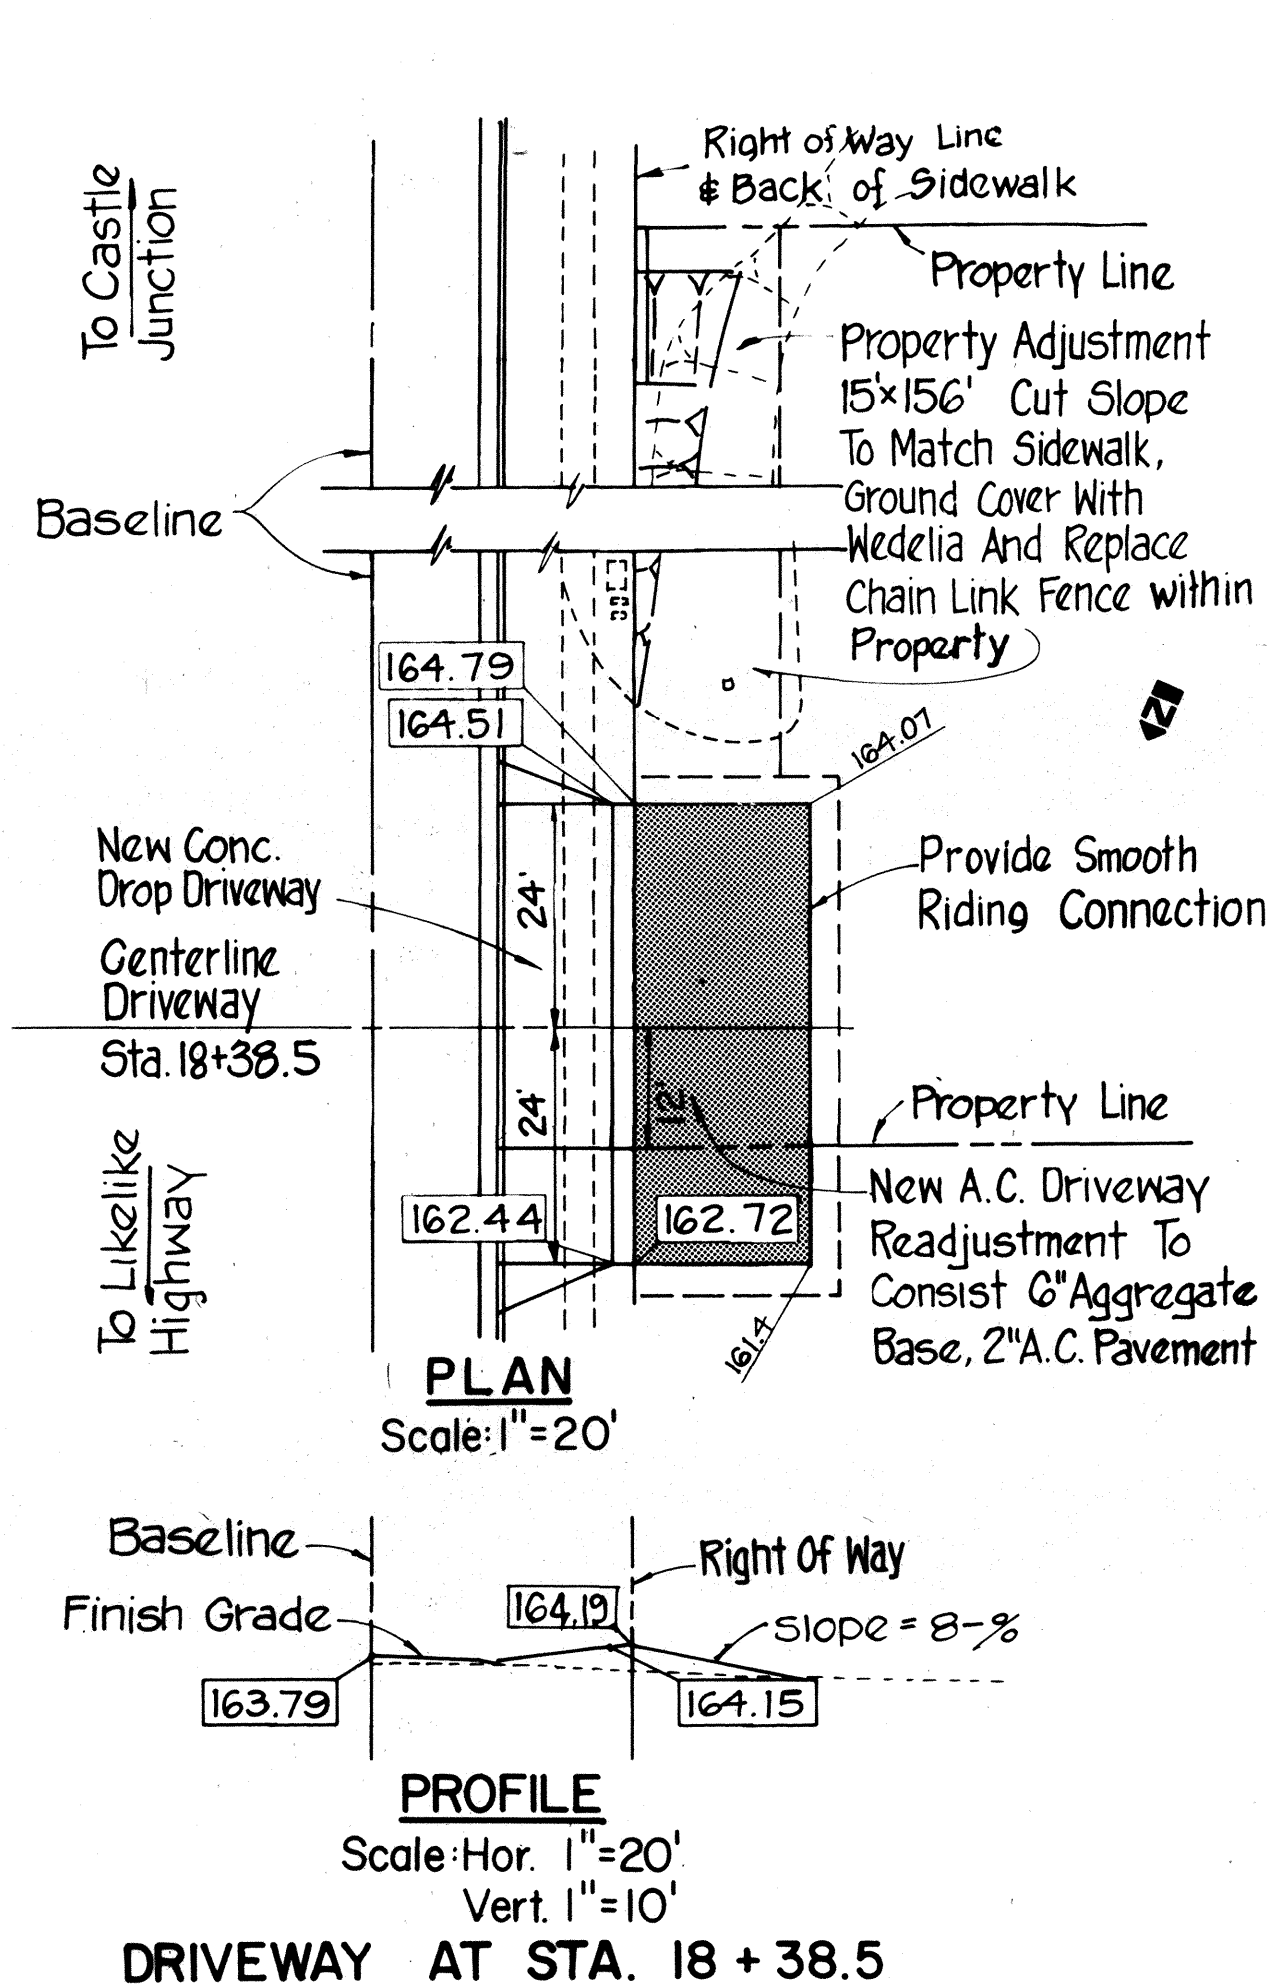

- NOTE:**
- Existing Carport will be removed by the owner. The State's Contractor shall notify the owner at least 30 days before commencing work on this property.
 - Adjustments to Carport Slab to be done by the State's Contractor. Carport structure to be reconstructed by owner.

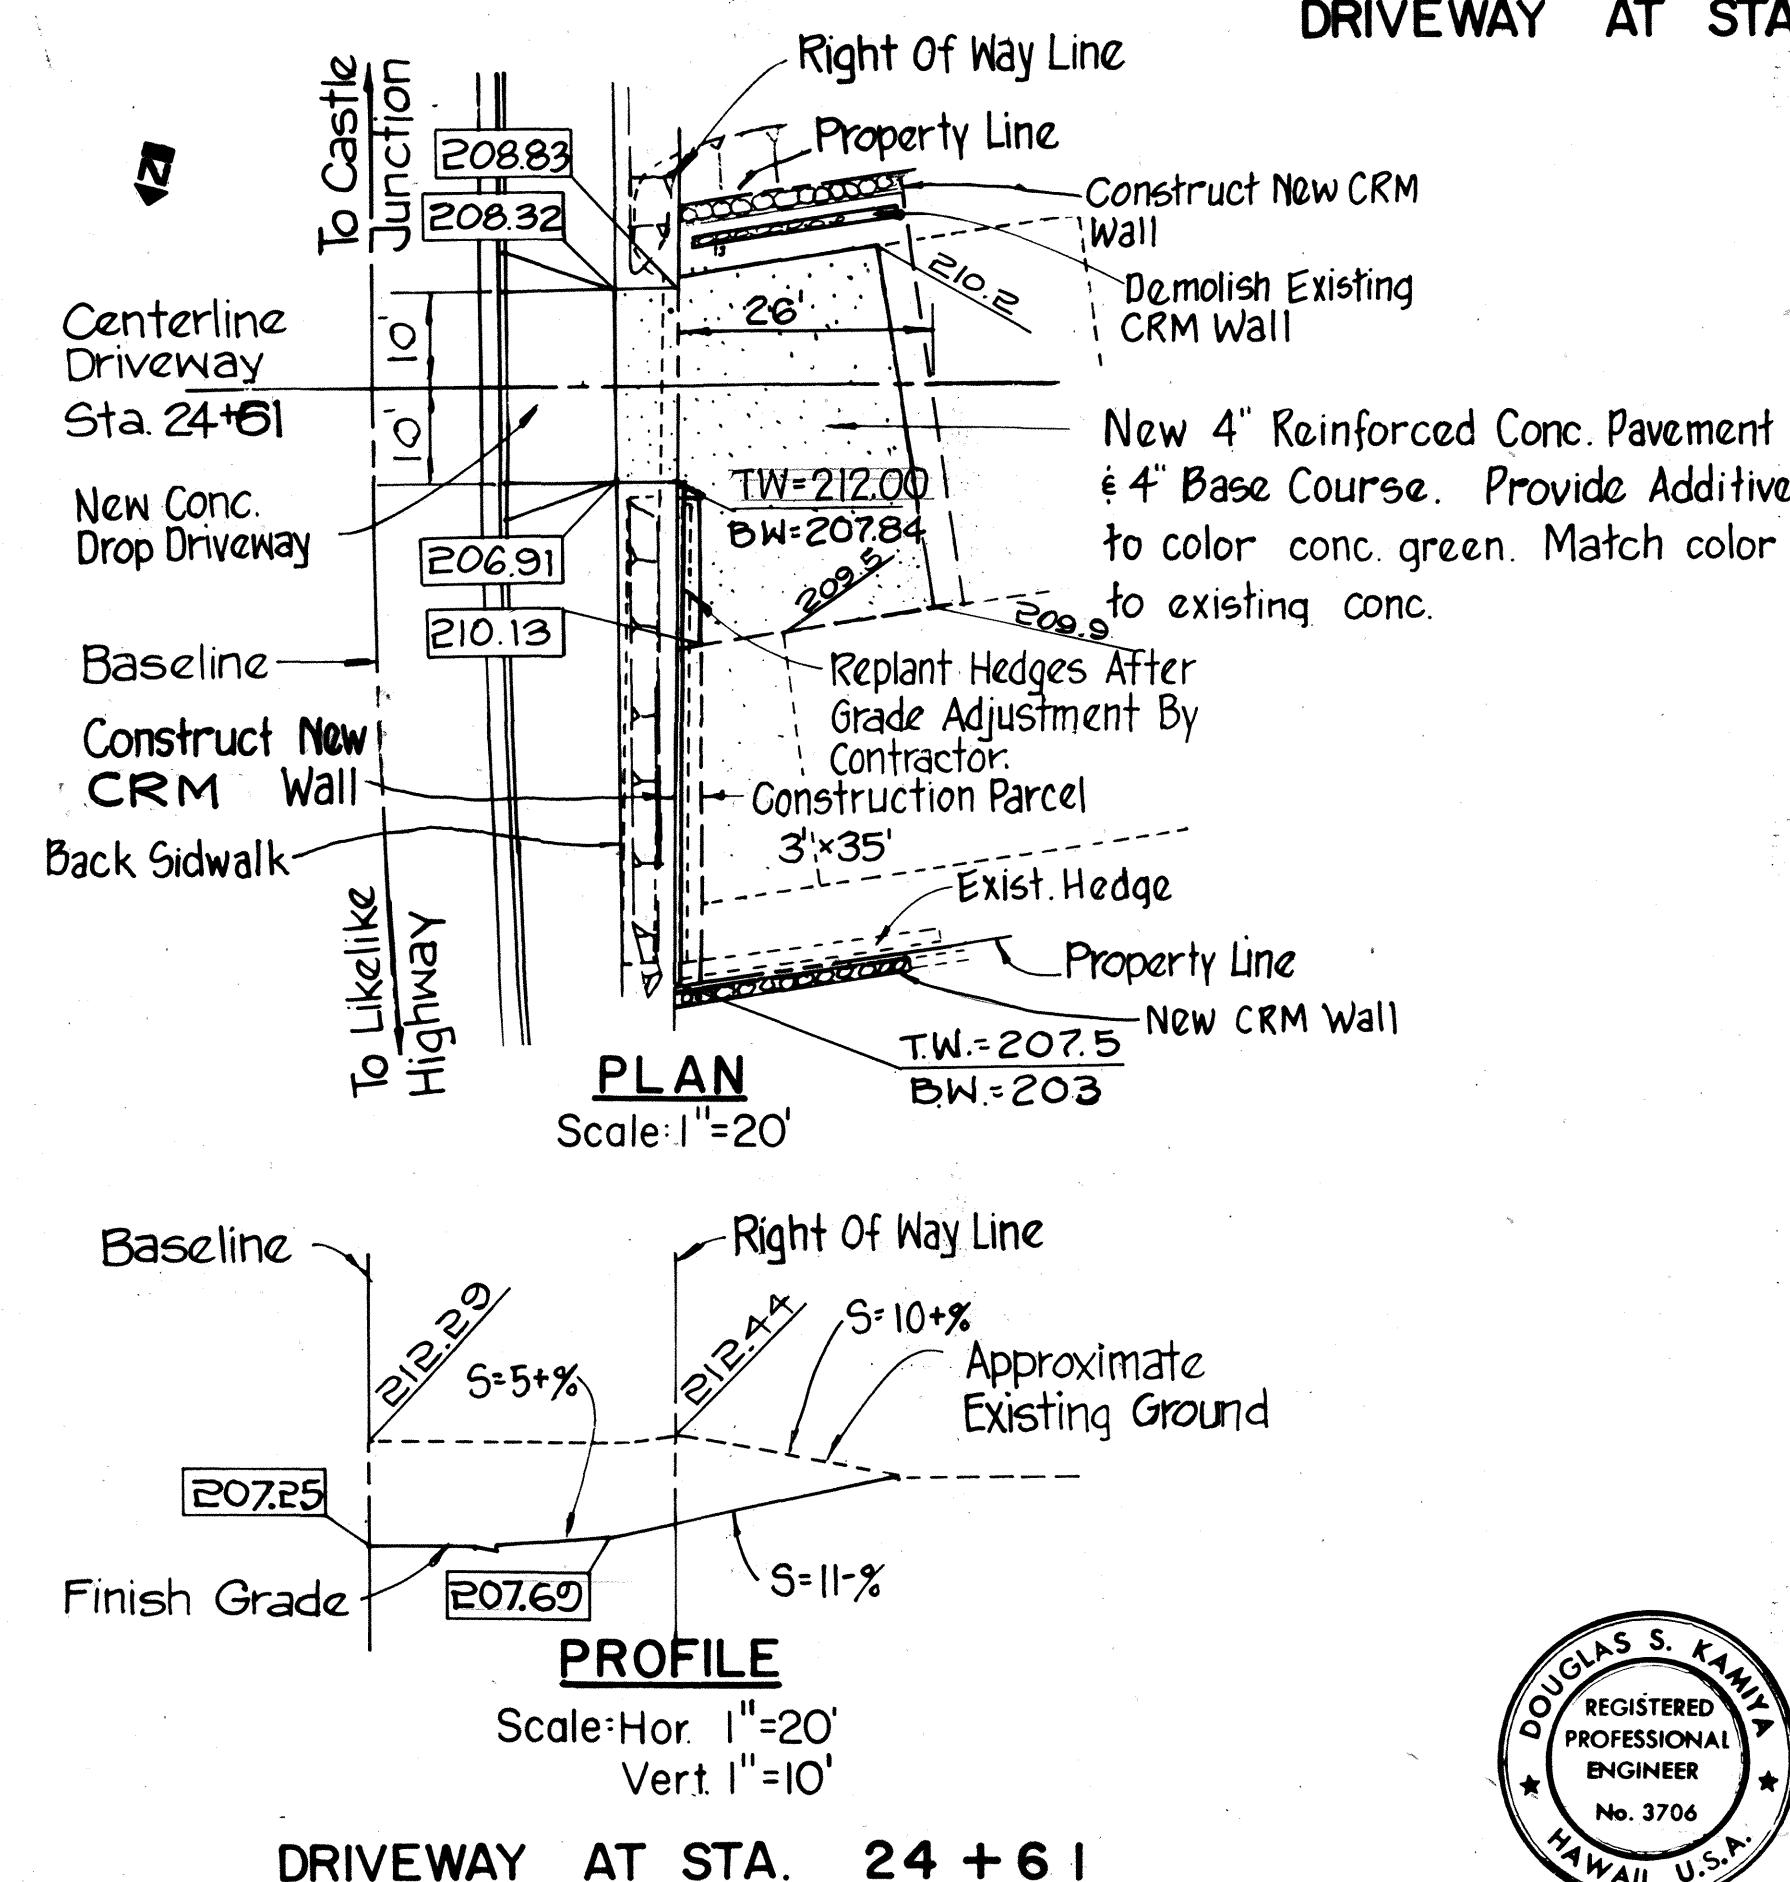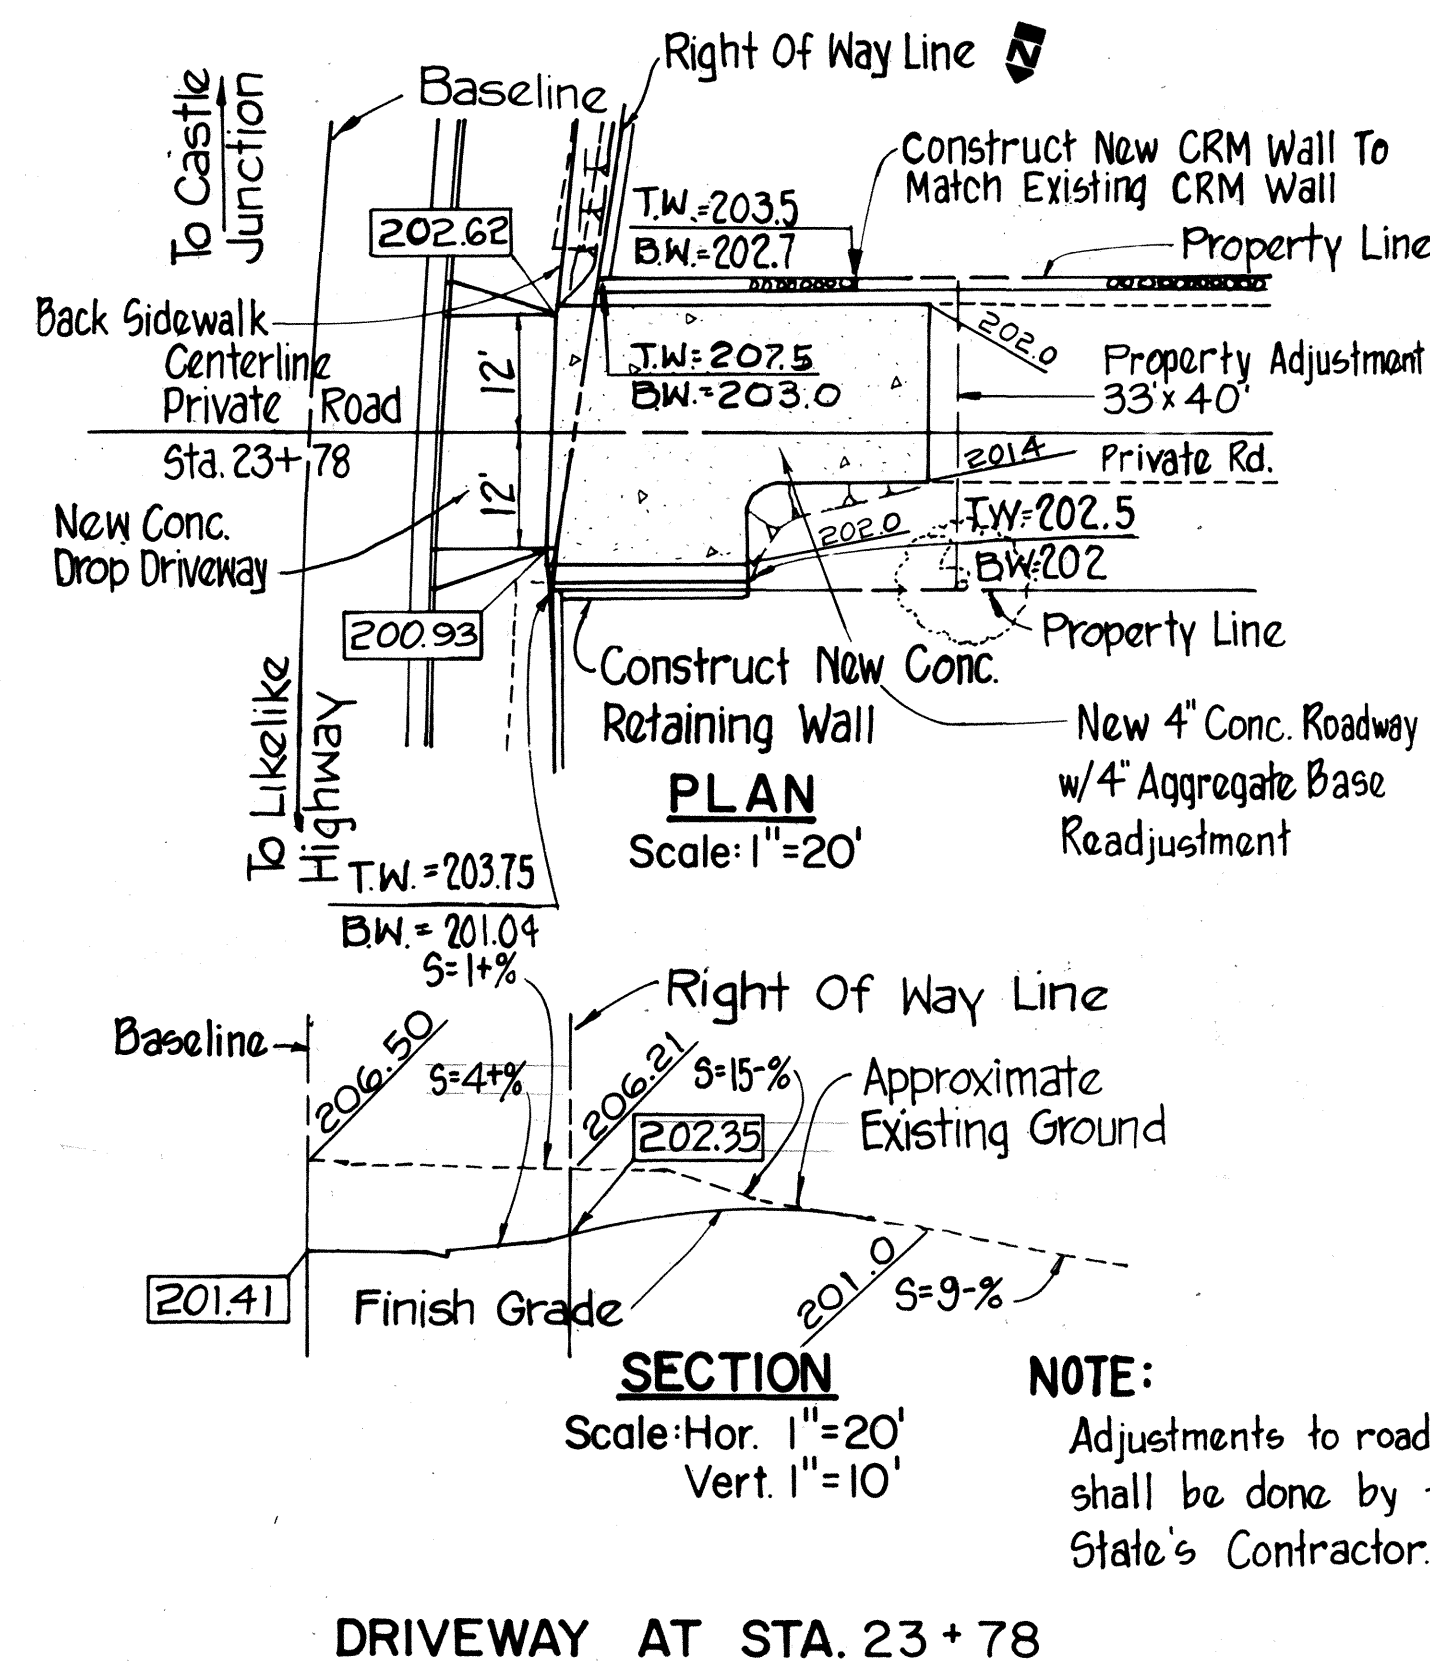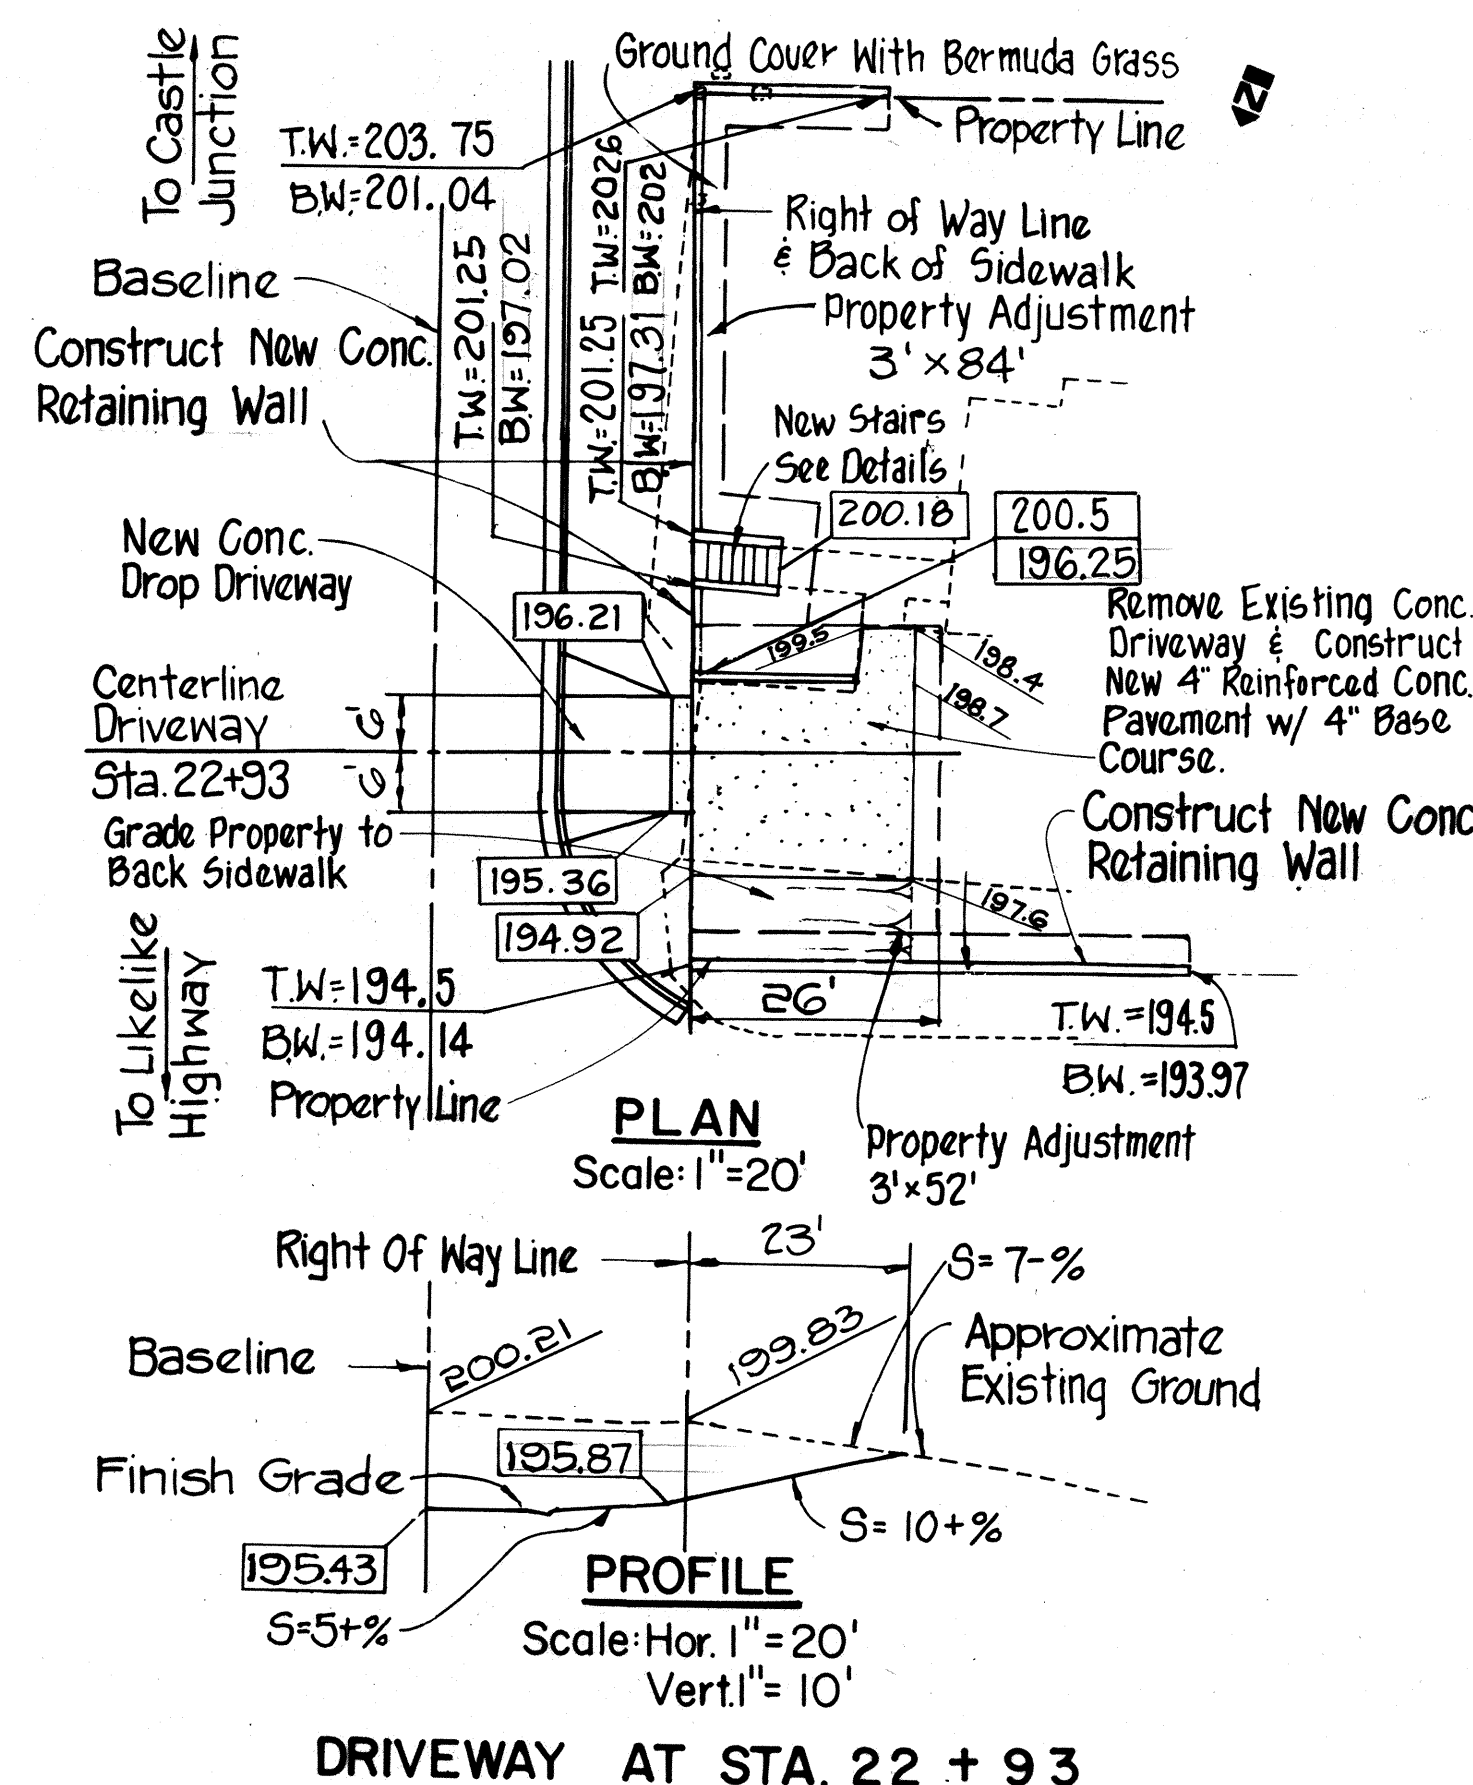

1/9/79	Deleted Retaining Wall #1
	Added Driveway @ Sta. 20+35
	Changed Grades
DATE	REVISION

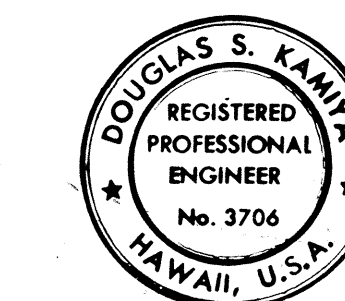

THIS WORK WAS PREPARED BY ME OR UNDER MY SUPERVISION.

Douglas S. Kama

STATE OF HAWAII
DEPARTMENT OF TRANSPORTATION
LAND TRANSPORTATION FACILITIES DIVISION


DRIVEWAY AND PROPERTY ADJUSTMENTS

KAMEHAMEHA HIGHWAY IMPROVEMENT
(LIKELIKE HIGHWAY TO KOOLAU VIEW DRIVE)
PROJECT NO. F-083-1(10)


SCALE: AS SHOWN DATE: 1/9/79

SHEET No. 4 OF 8 SHEETS


FED. ROAD DIST. NO.	STATE	FED. AID PROJ. NO.	FISCAL YEAR	SHEET NO.	TOTAL SHEETS
HAWAII	HAW.	F-083-1(10)	1978	26	160

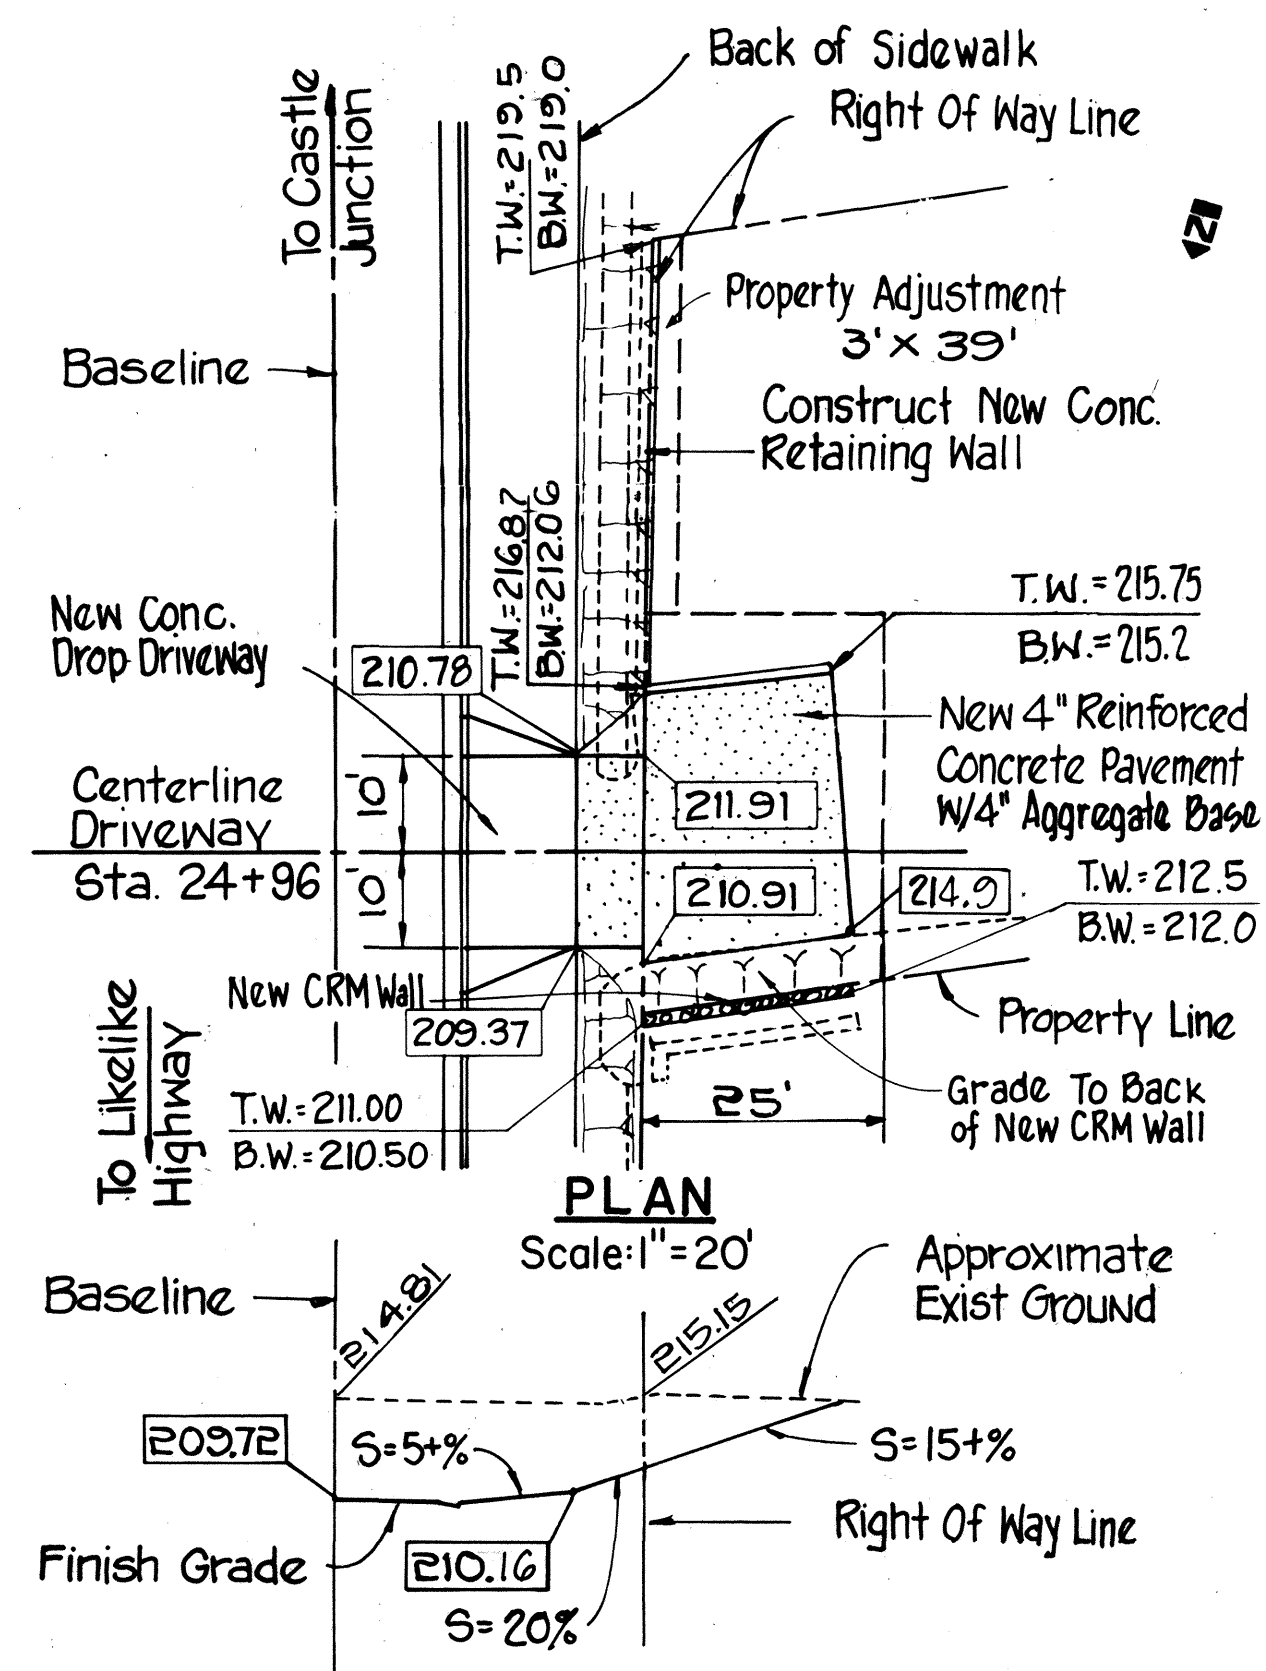


DRIVEWAY AT STA. 24 + 96

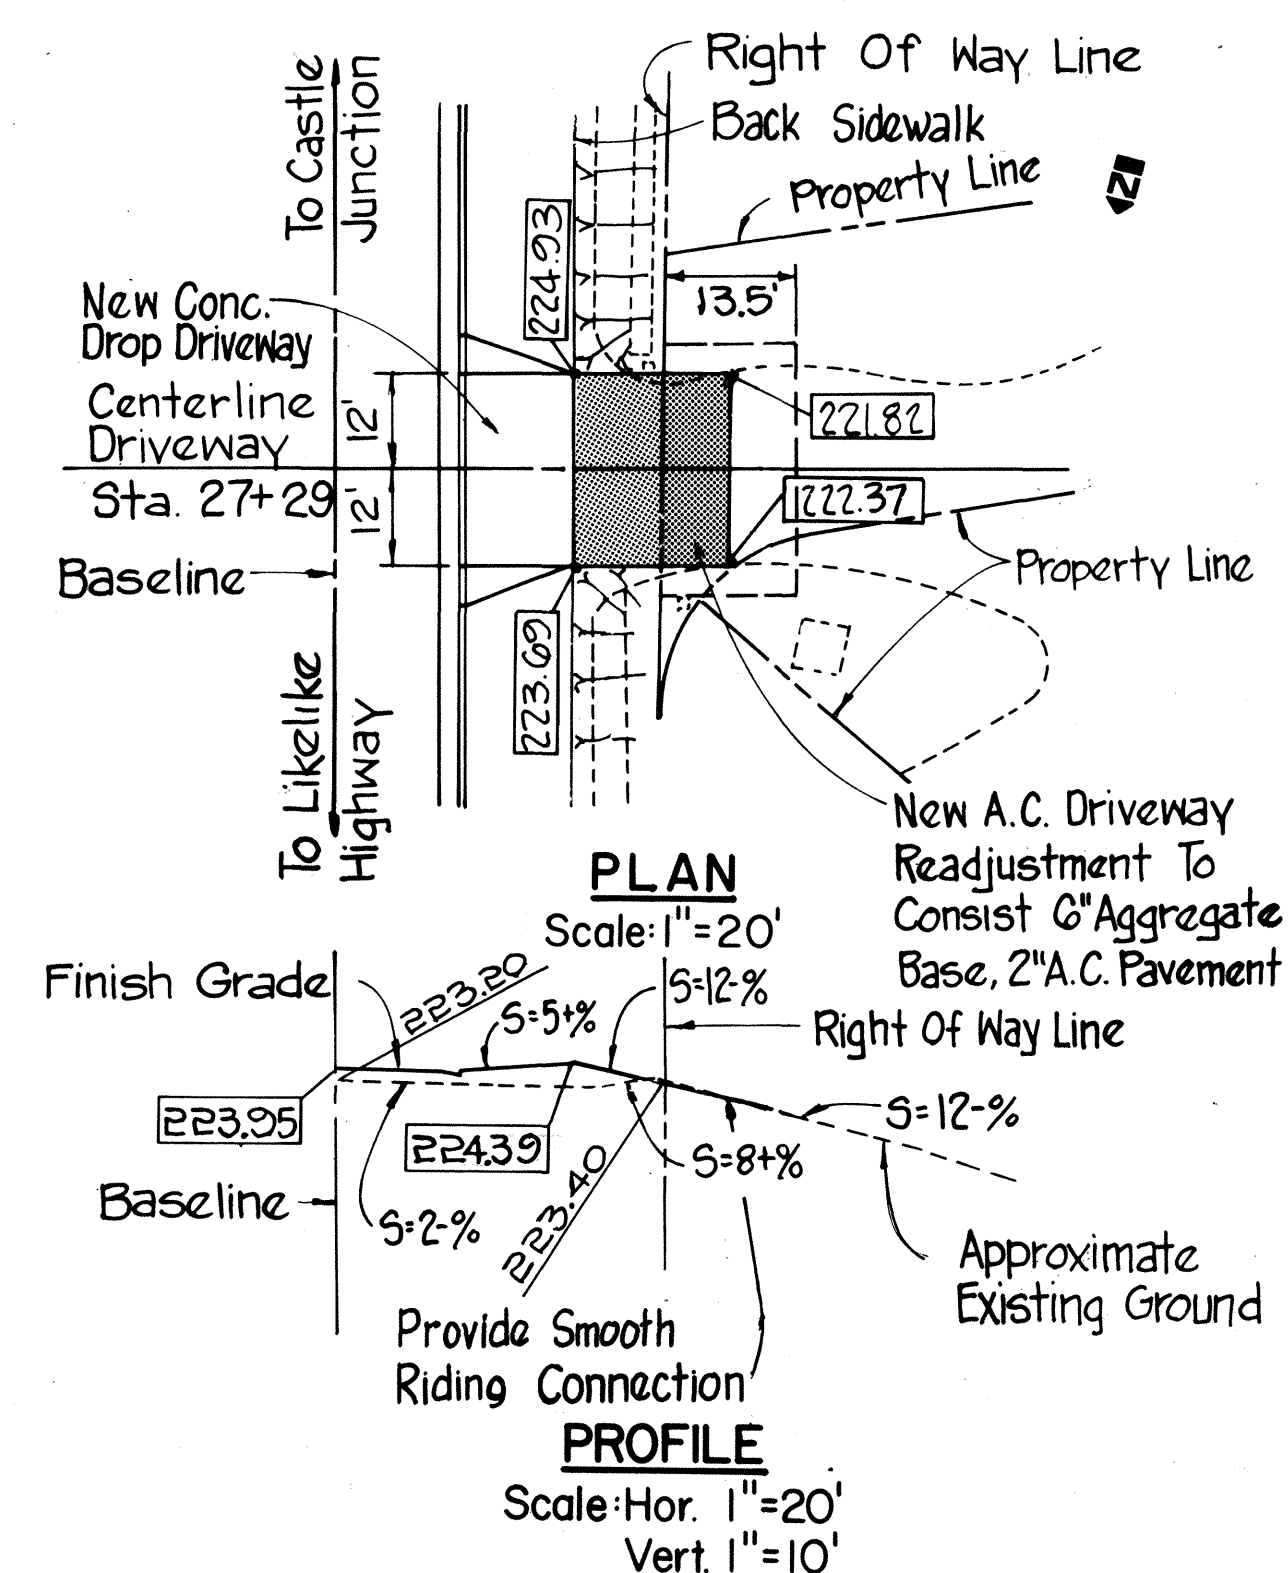


DRIVEWAY AT STA. 27 + 29

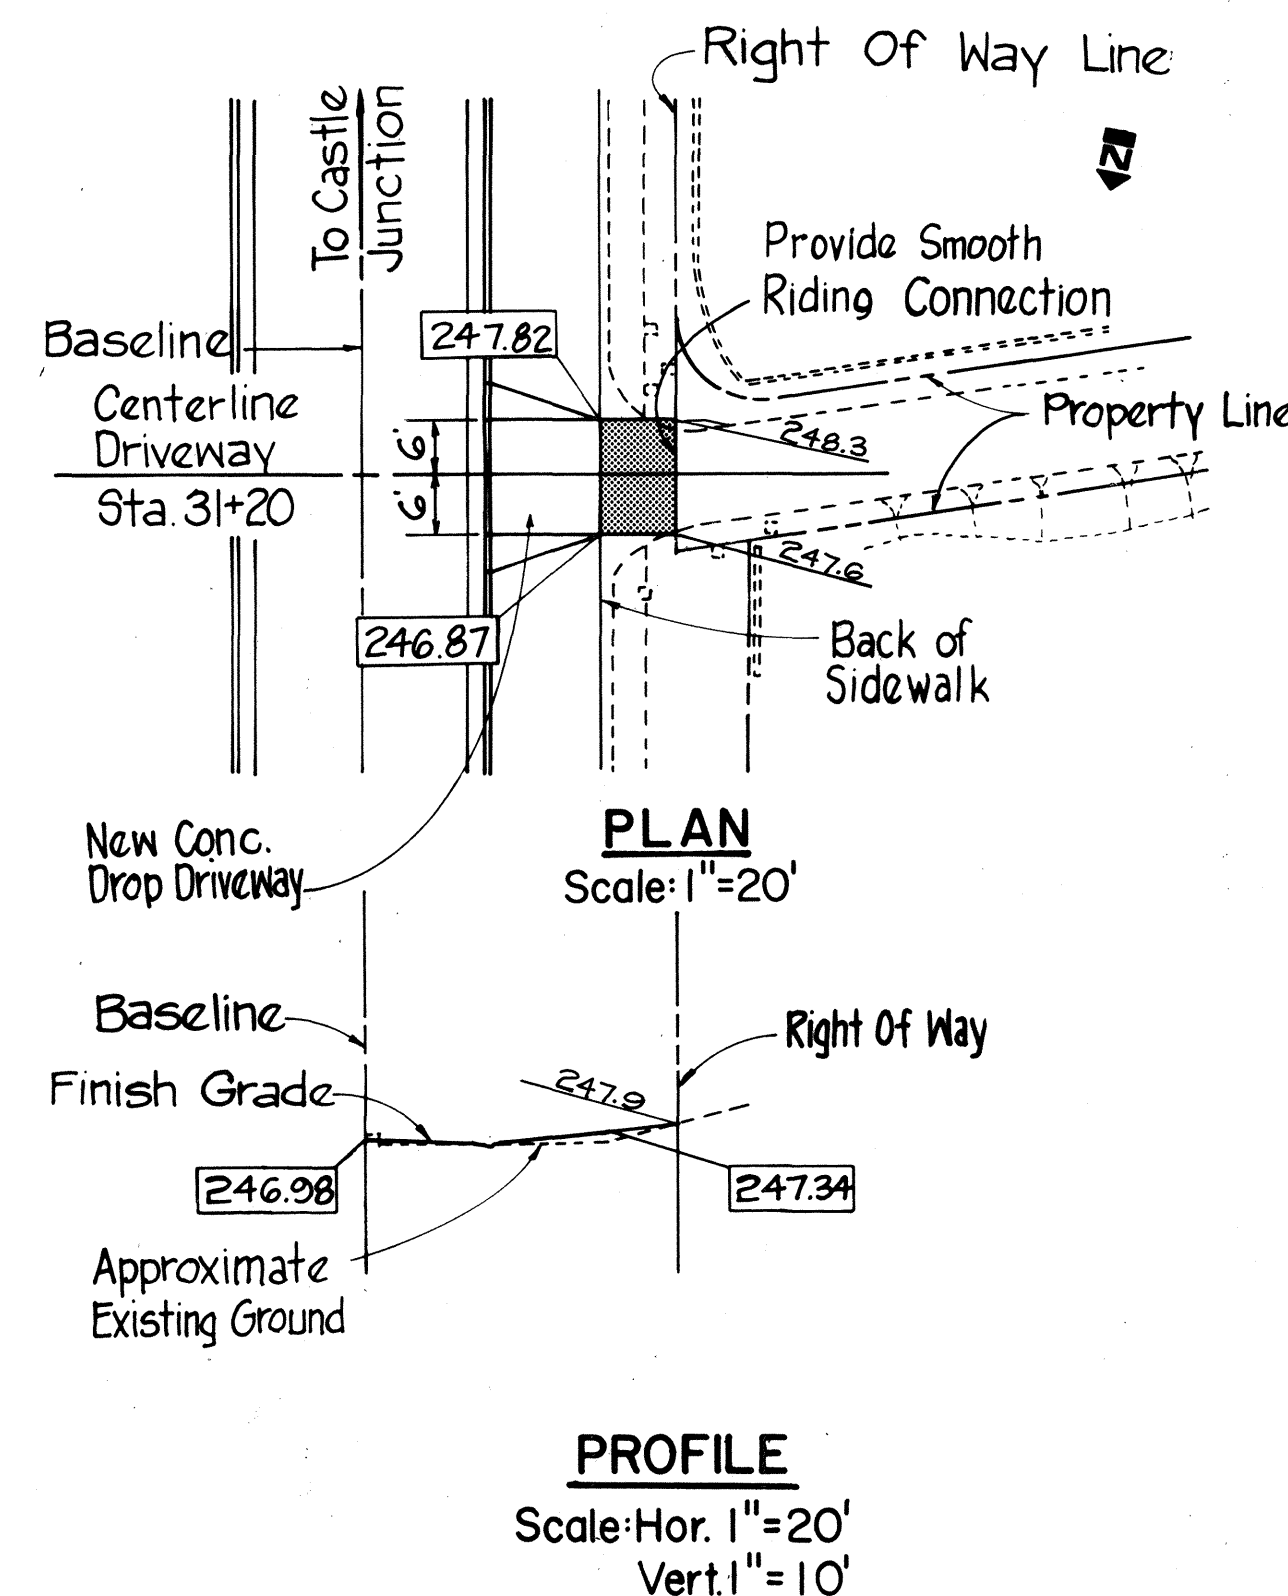


DRIVEWAY AT STA. 31 + 20

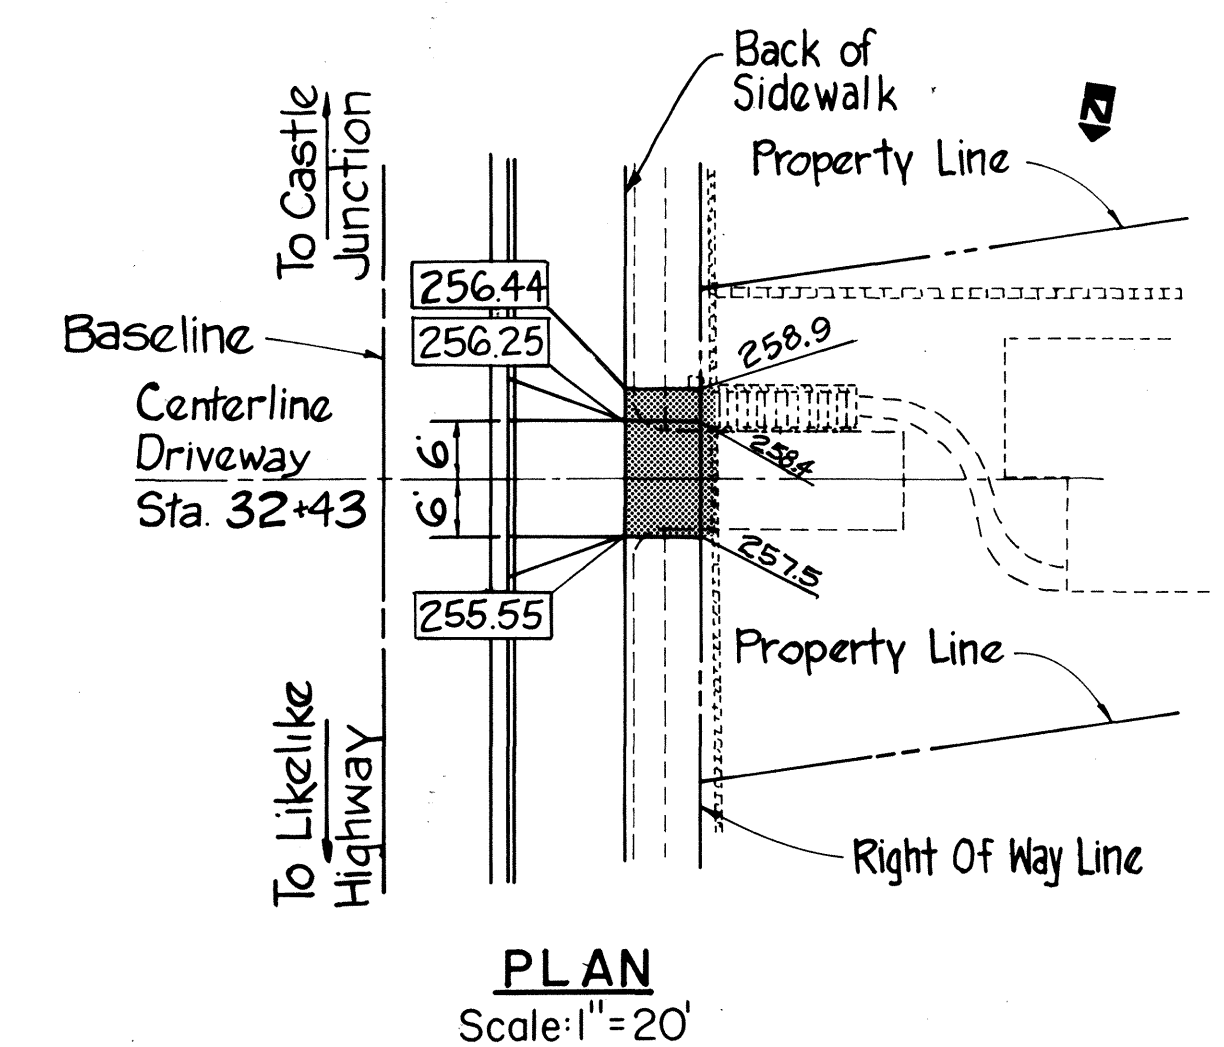


DRIVEWAY AT STA. 32 + 43

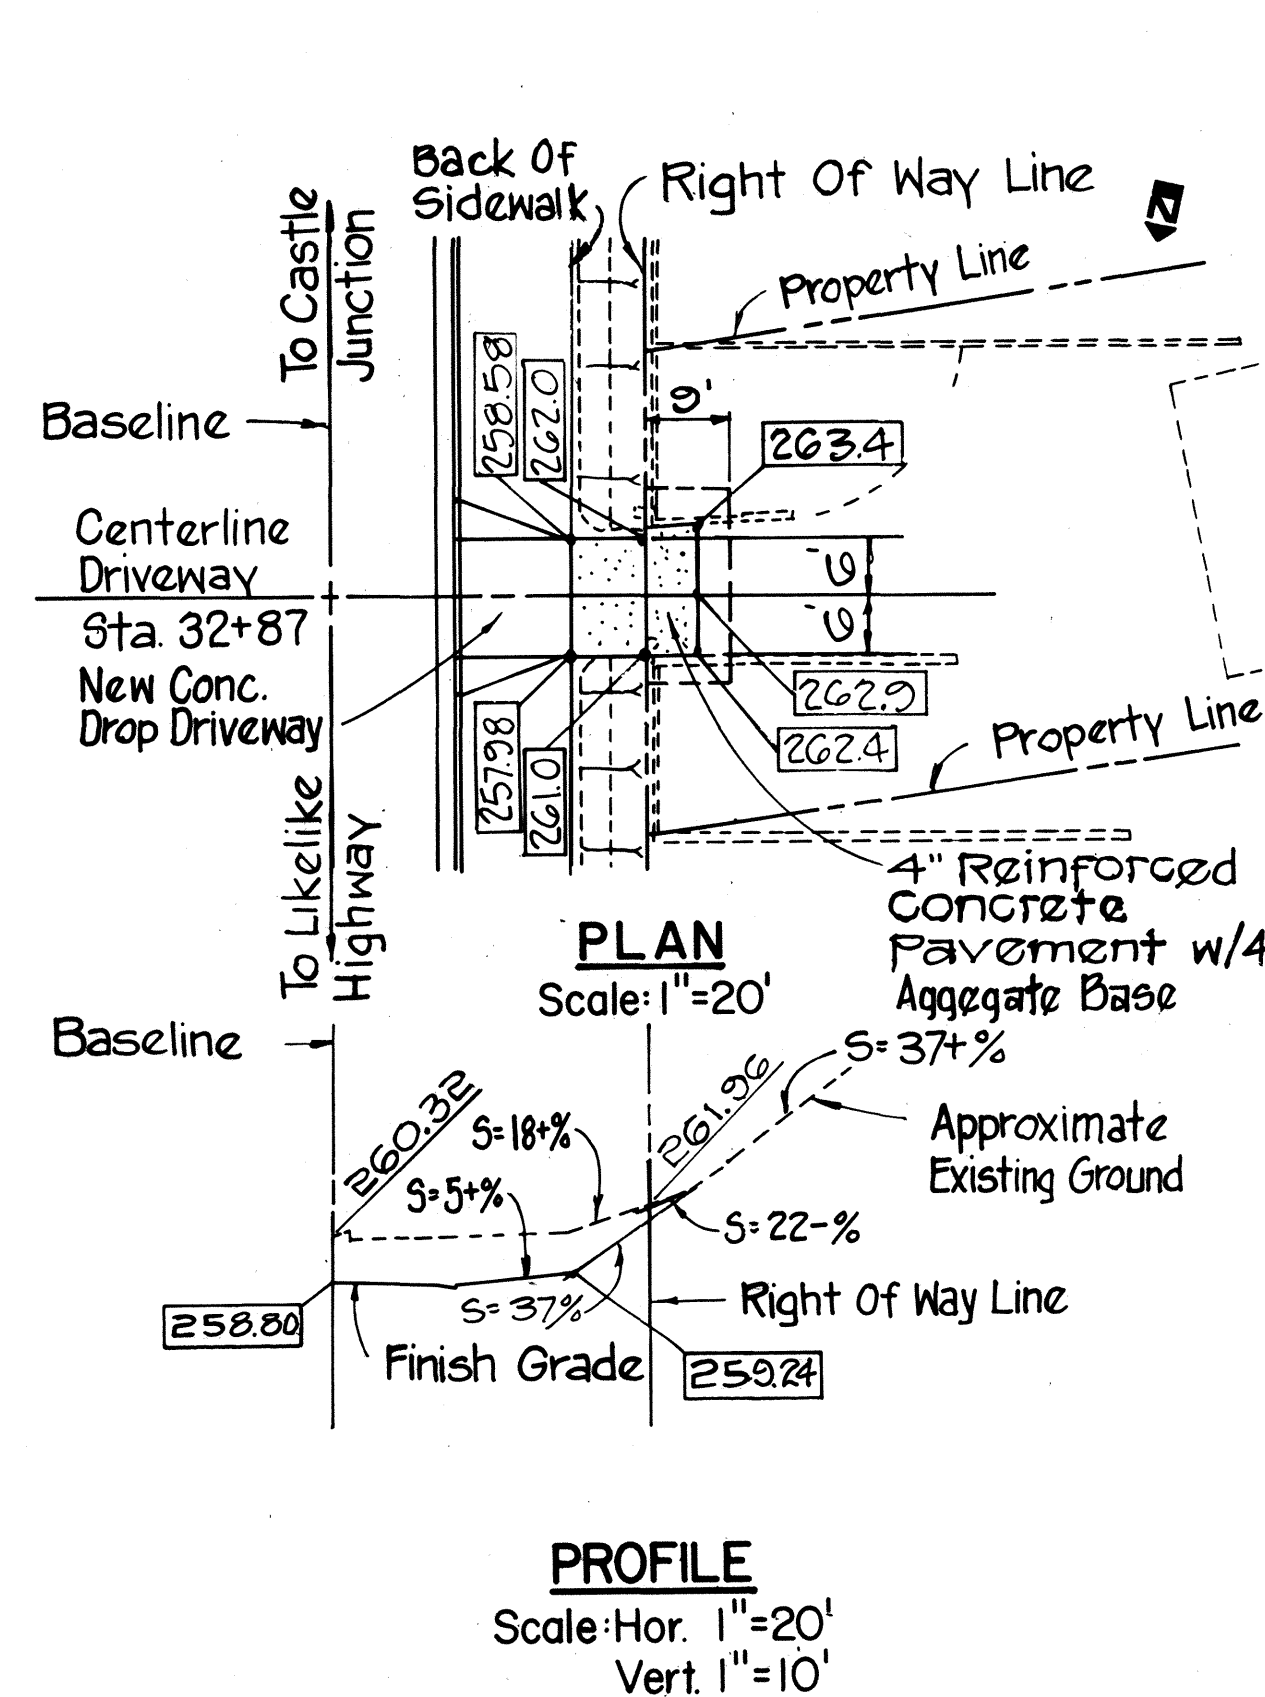

DRIVEWAY AT STA. 32 + 87

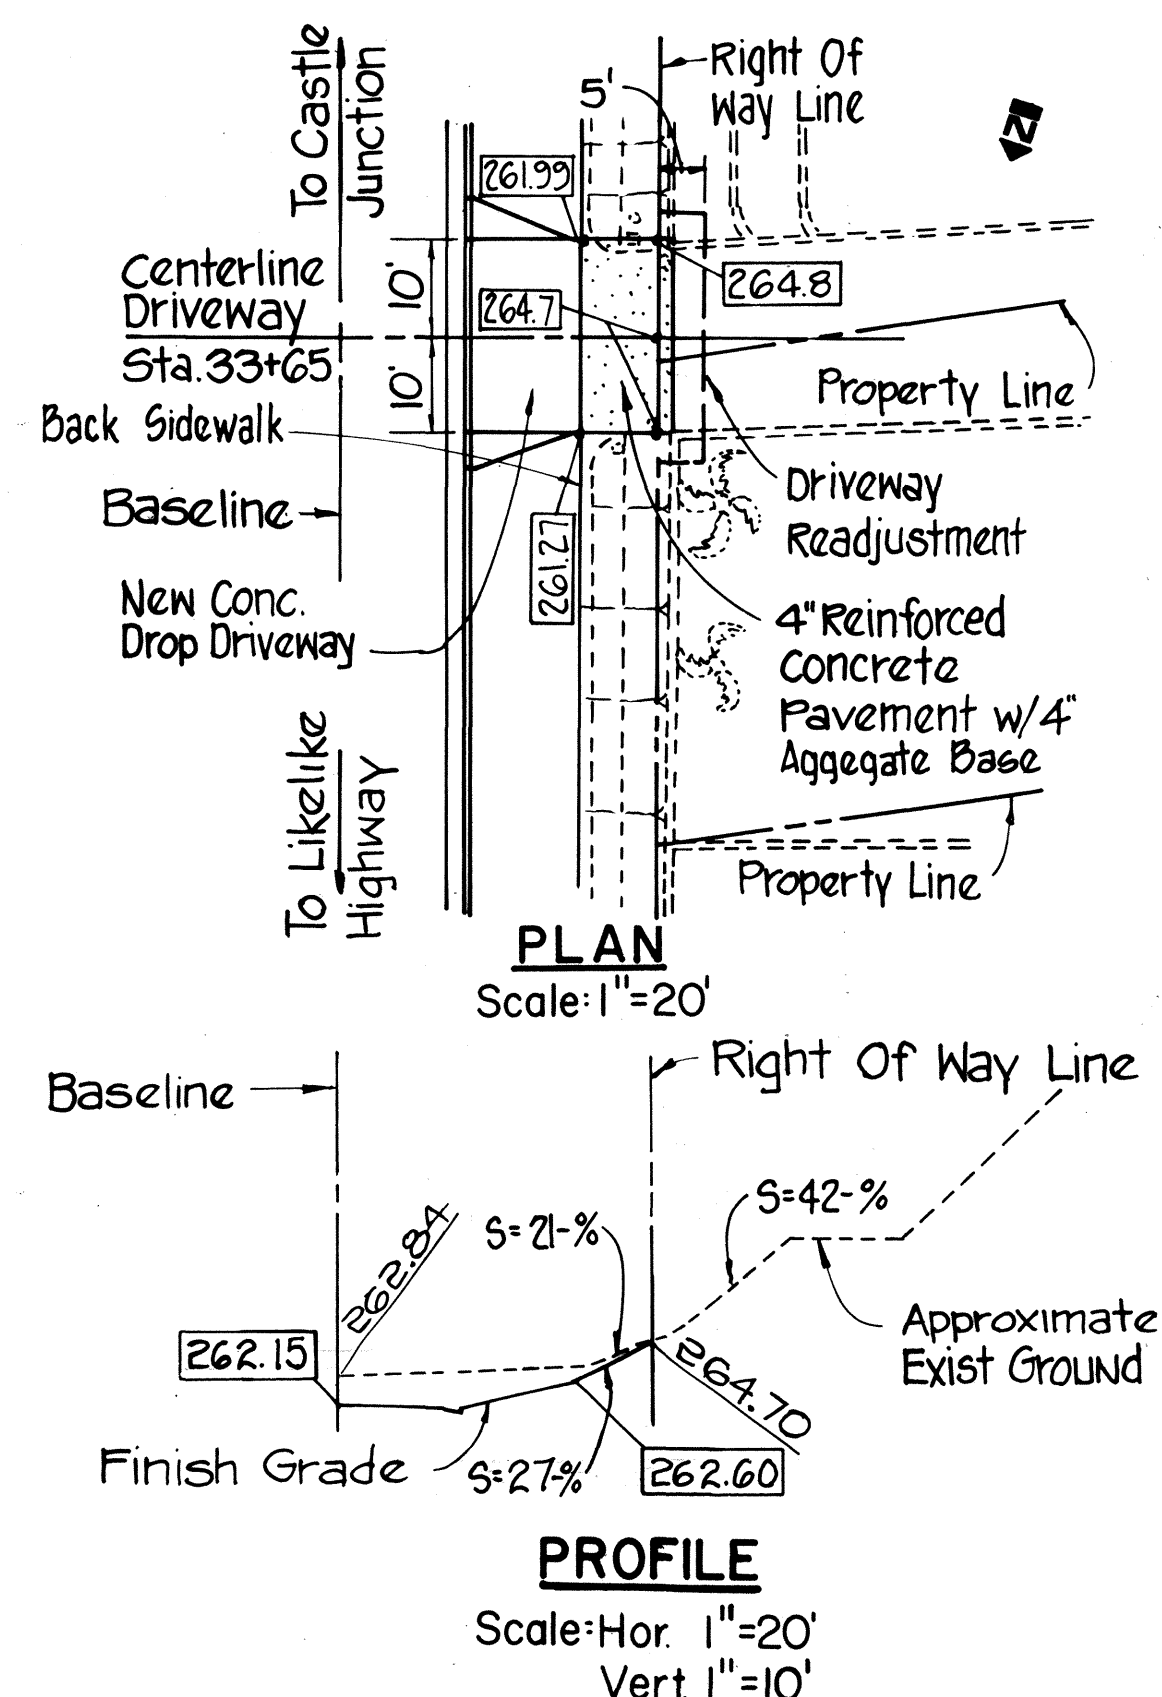


DRIVEWAY AT STA. 33 + 65

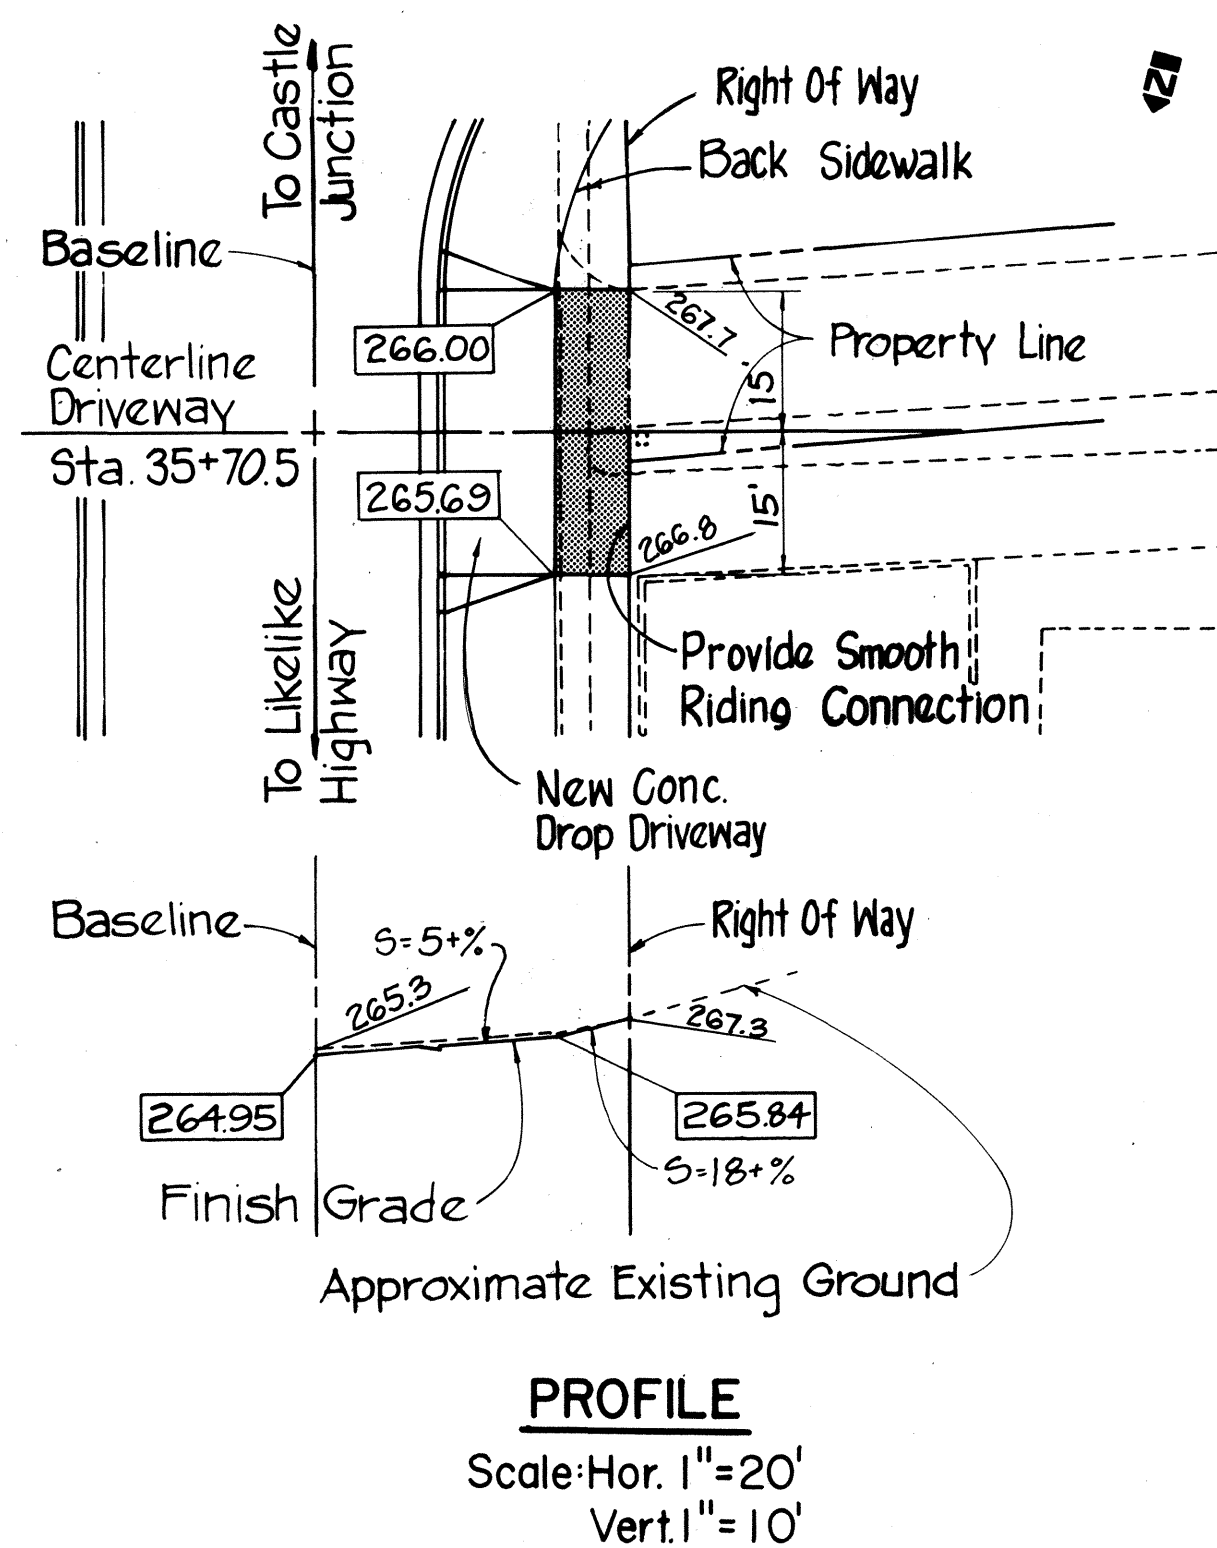

DRIVEWAY AT STA. 35 + 70.5

1/9/79	Changed Grades
DATE	REVISION

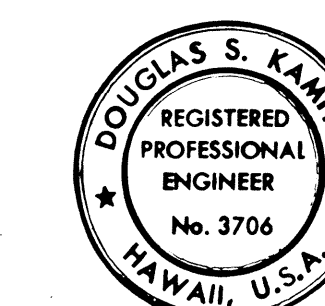


STATE OF HAWAII
DEPARTMENT OF TRANSPORTATION
LAND TRANSPORTATION FACILITIES DIVISION

DRIVEWAY AND PROPERTY ADJUSTMENTS


KAMEHAMEHA HIGHWAY IMPROVEMENT
(LIKELIKE HIGHWAY TO KOOLAU VIEW DRIVE)
PROJECT NO. F-083-1(10)

SCALE: AS SHOWN DATE AUG 1978
SHEET No. 5 OF 8 SHEETS


FED. ROAD DIST. NO.	STATE	FED. AID PROJ. NO.	FISCAL YEAR	SHEET NO.	TOTAL SHEETS
HAWAII	HAW.	F-083-1(10)	1978	27	160

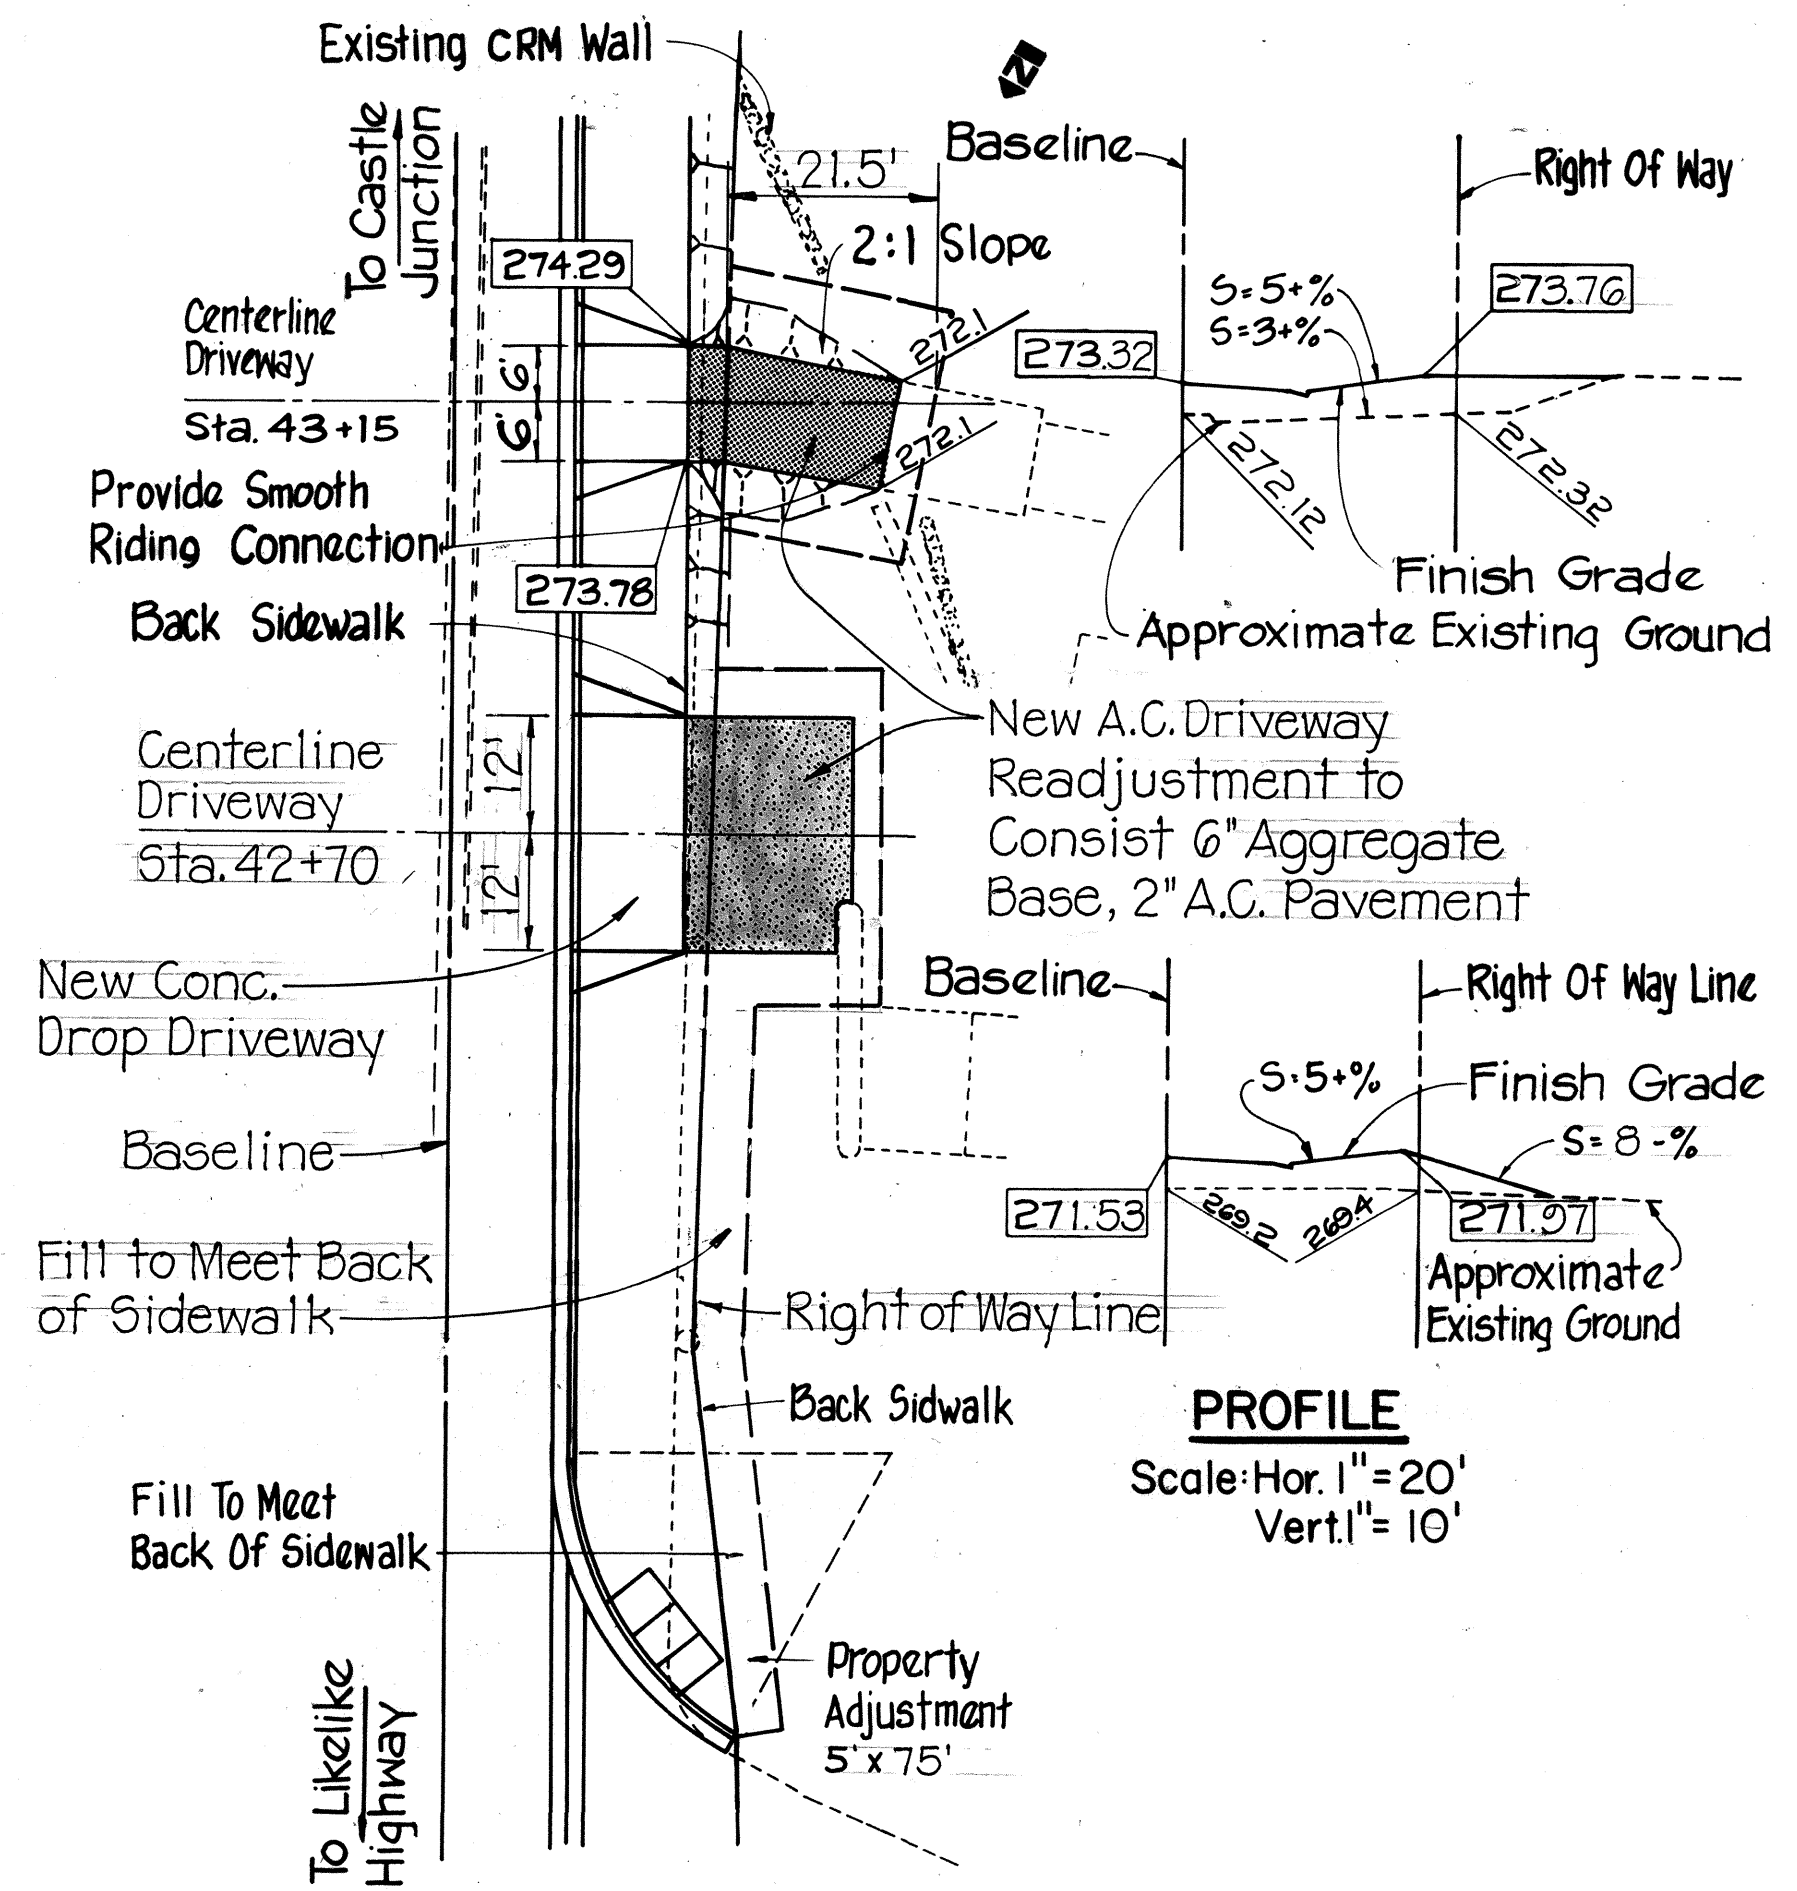


DRIVEWAY AT STA. 42+70 & 43+15

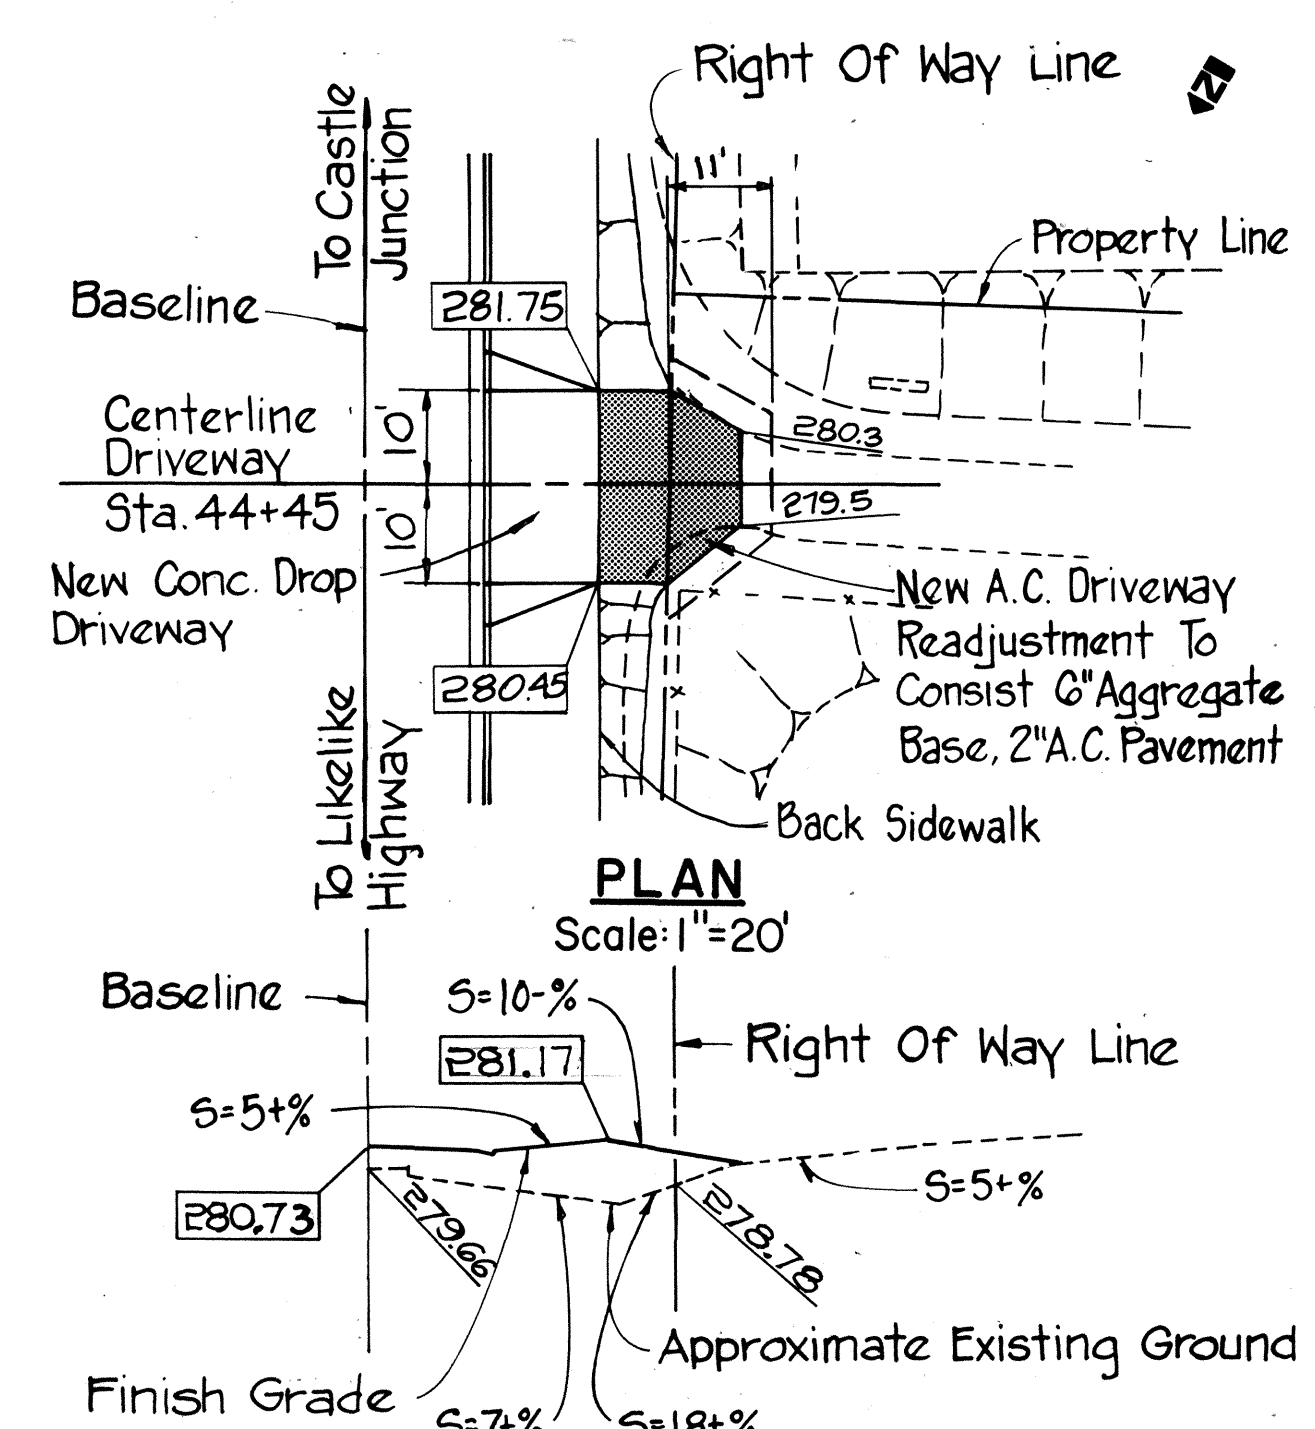


DRIVEWAY AT STA. 44+45

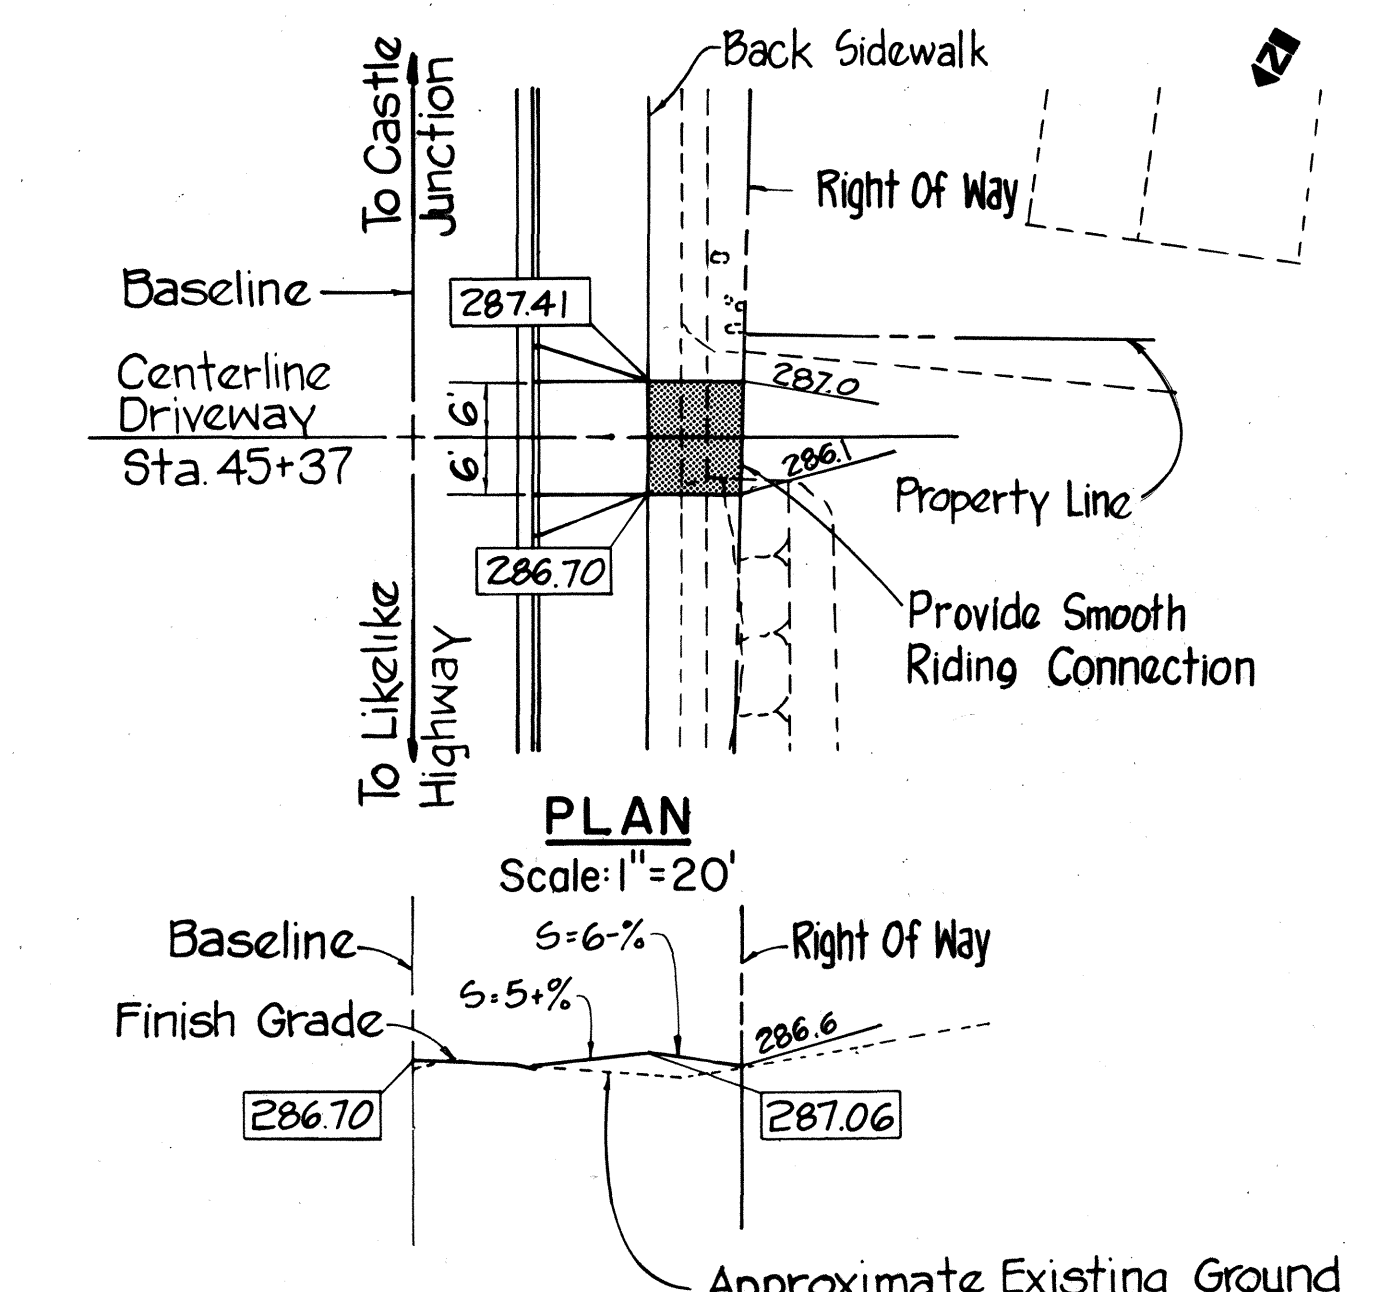


DRIVEWAY AT STA. 45+37

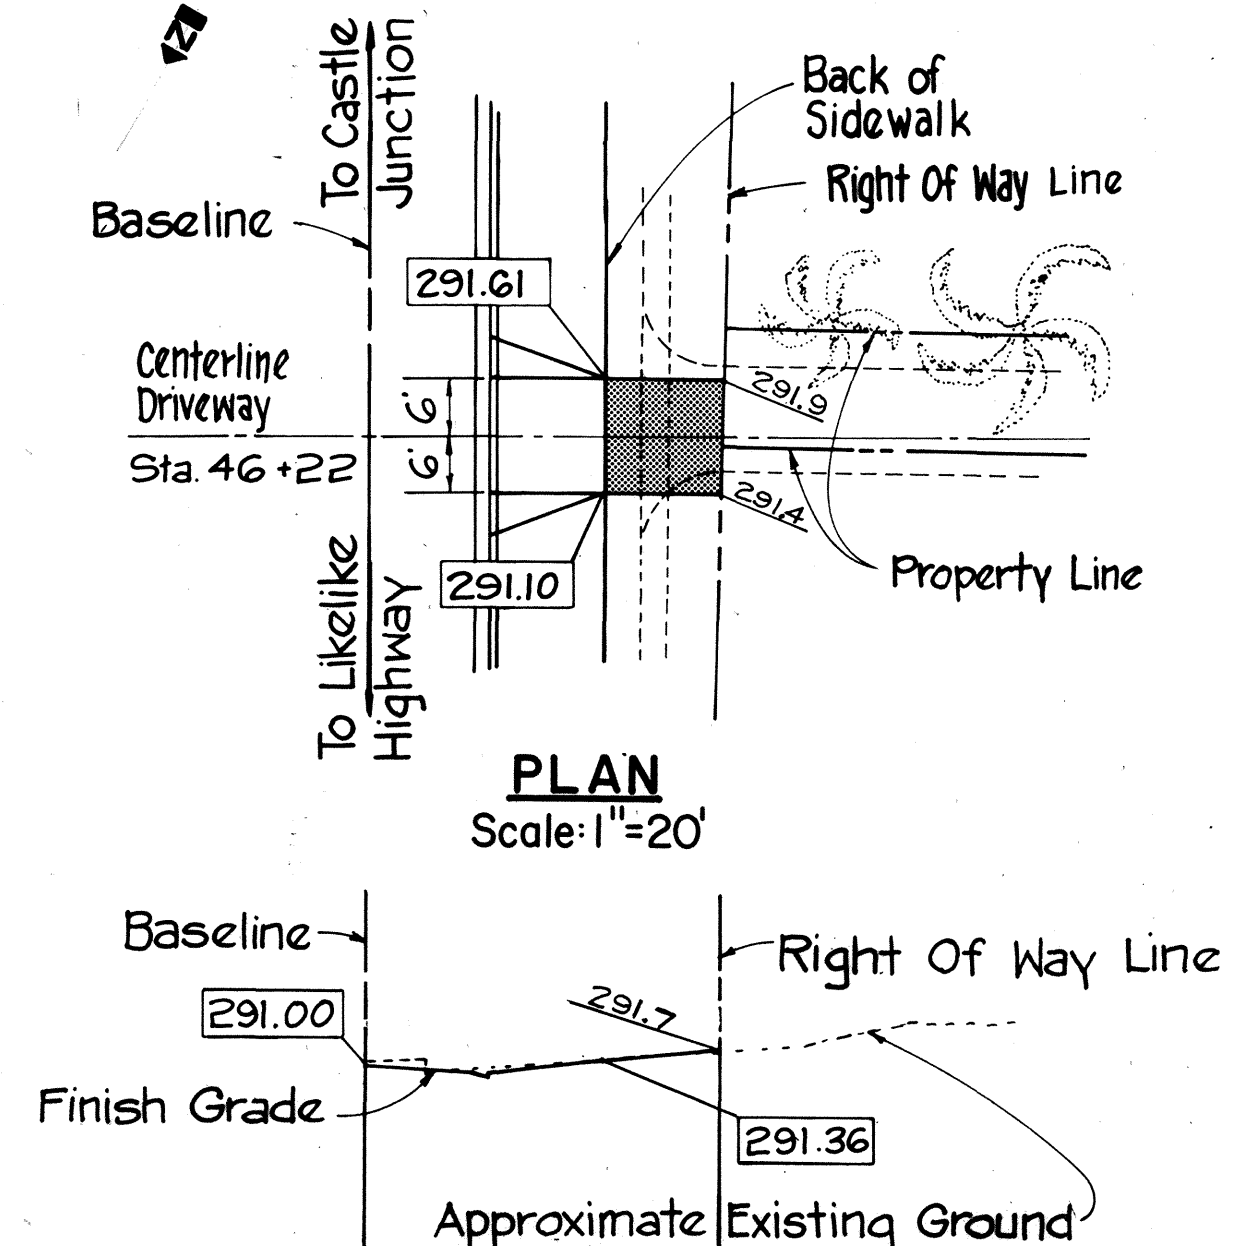


DRIVEWAY AT STA. 46+22

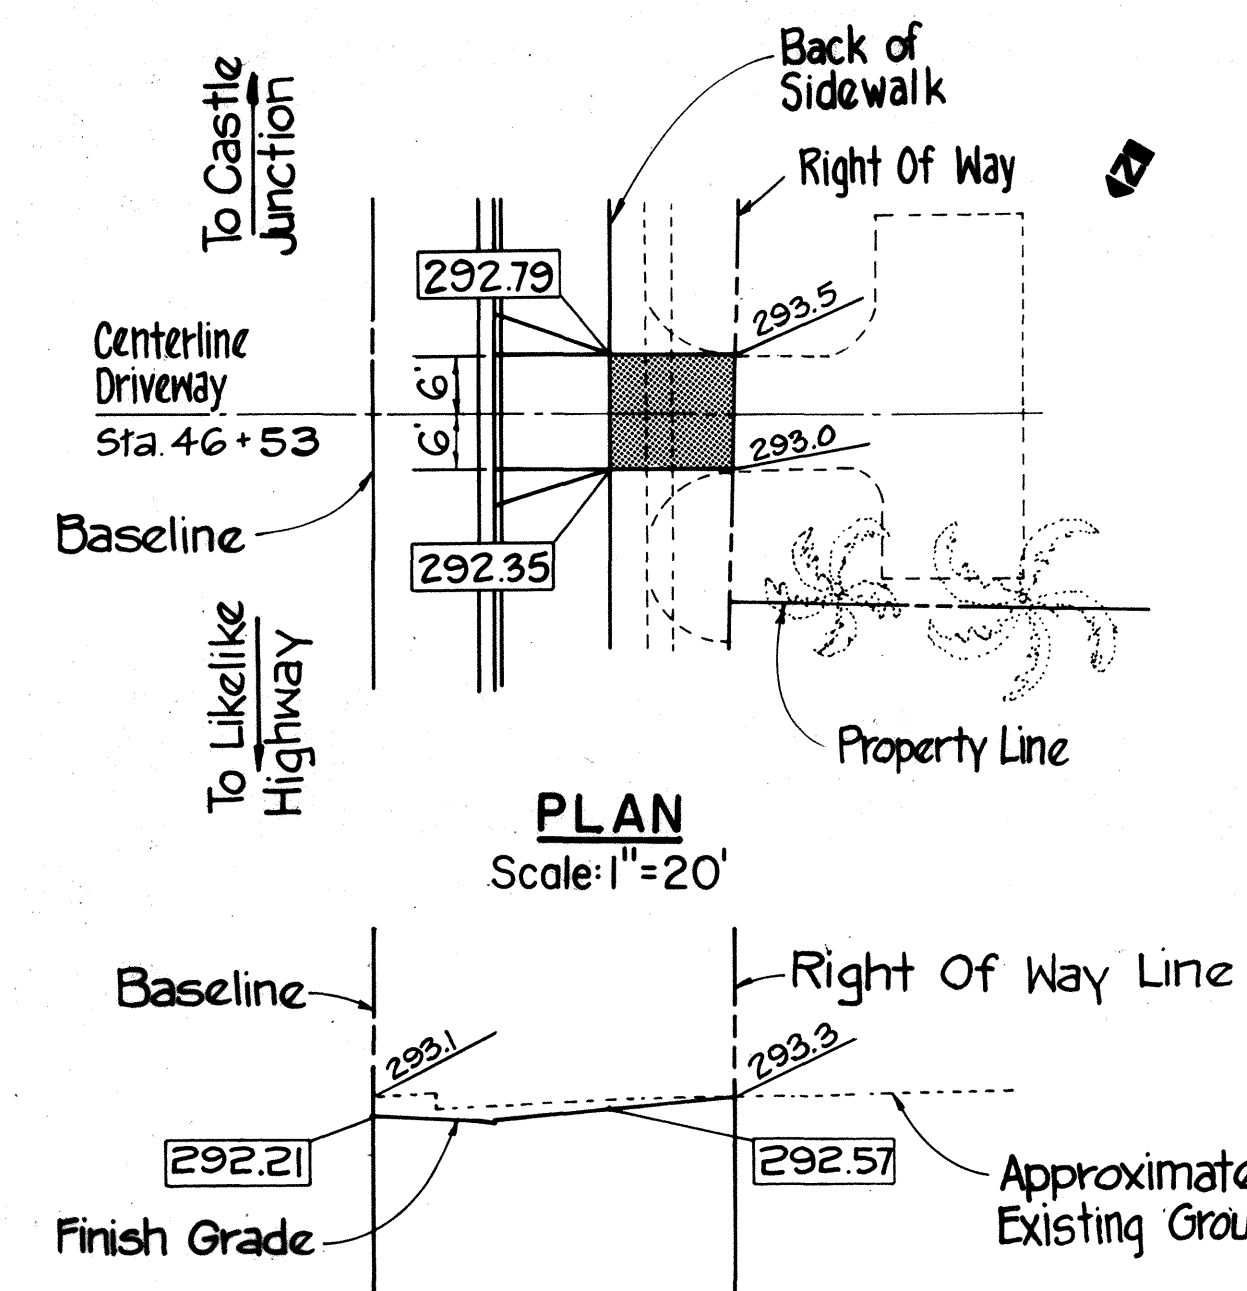


DRIVEWAY AT STA. 46+53

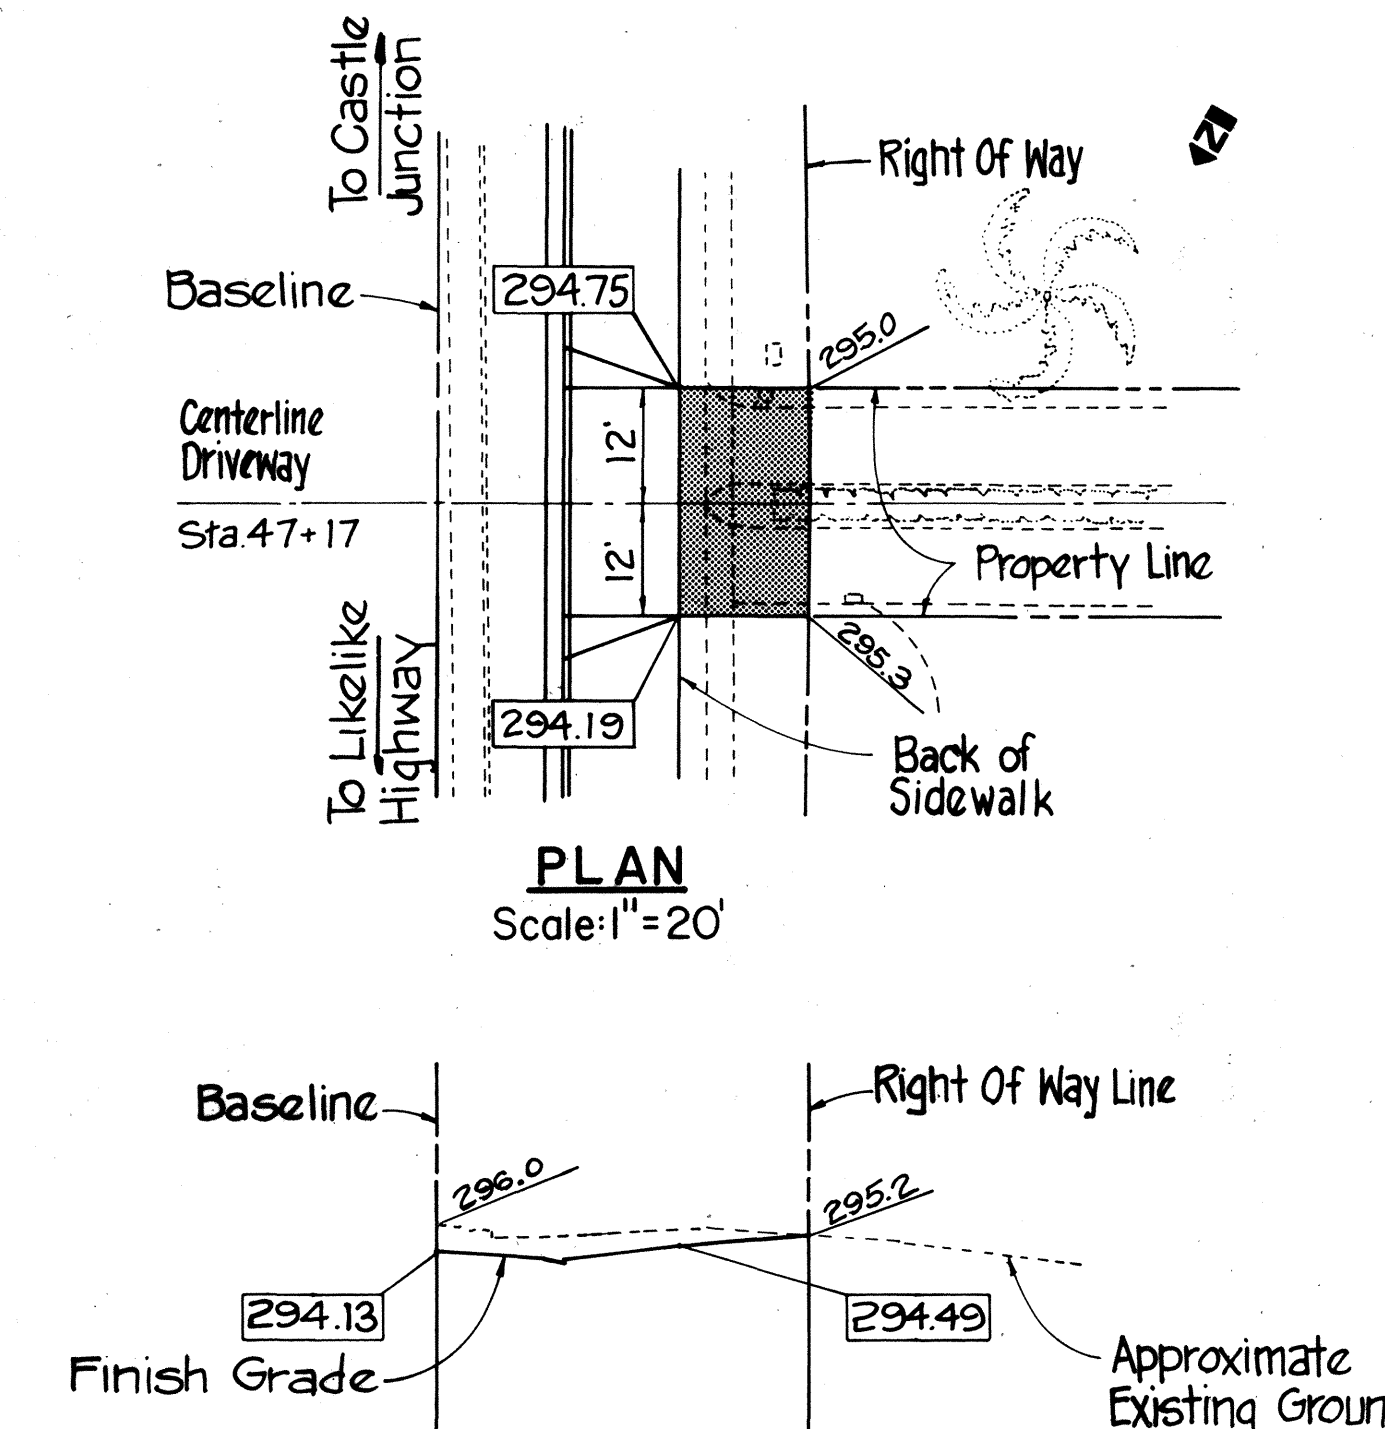

DRIVEWAY AT STA. 47+17

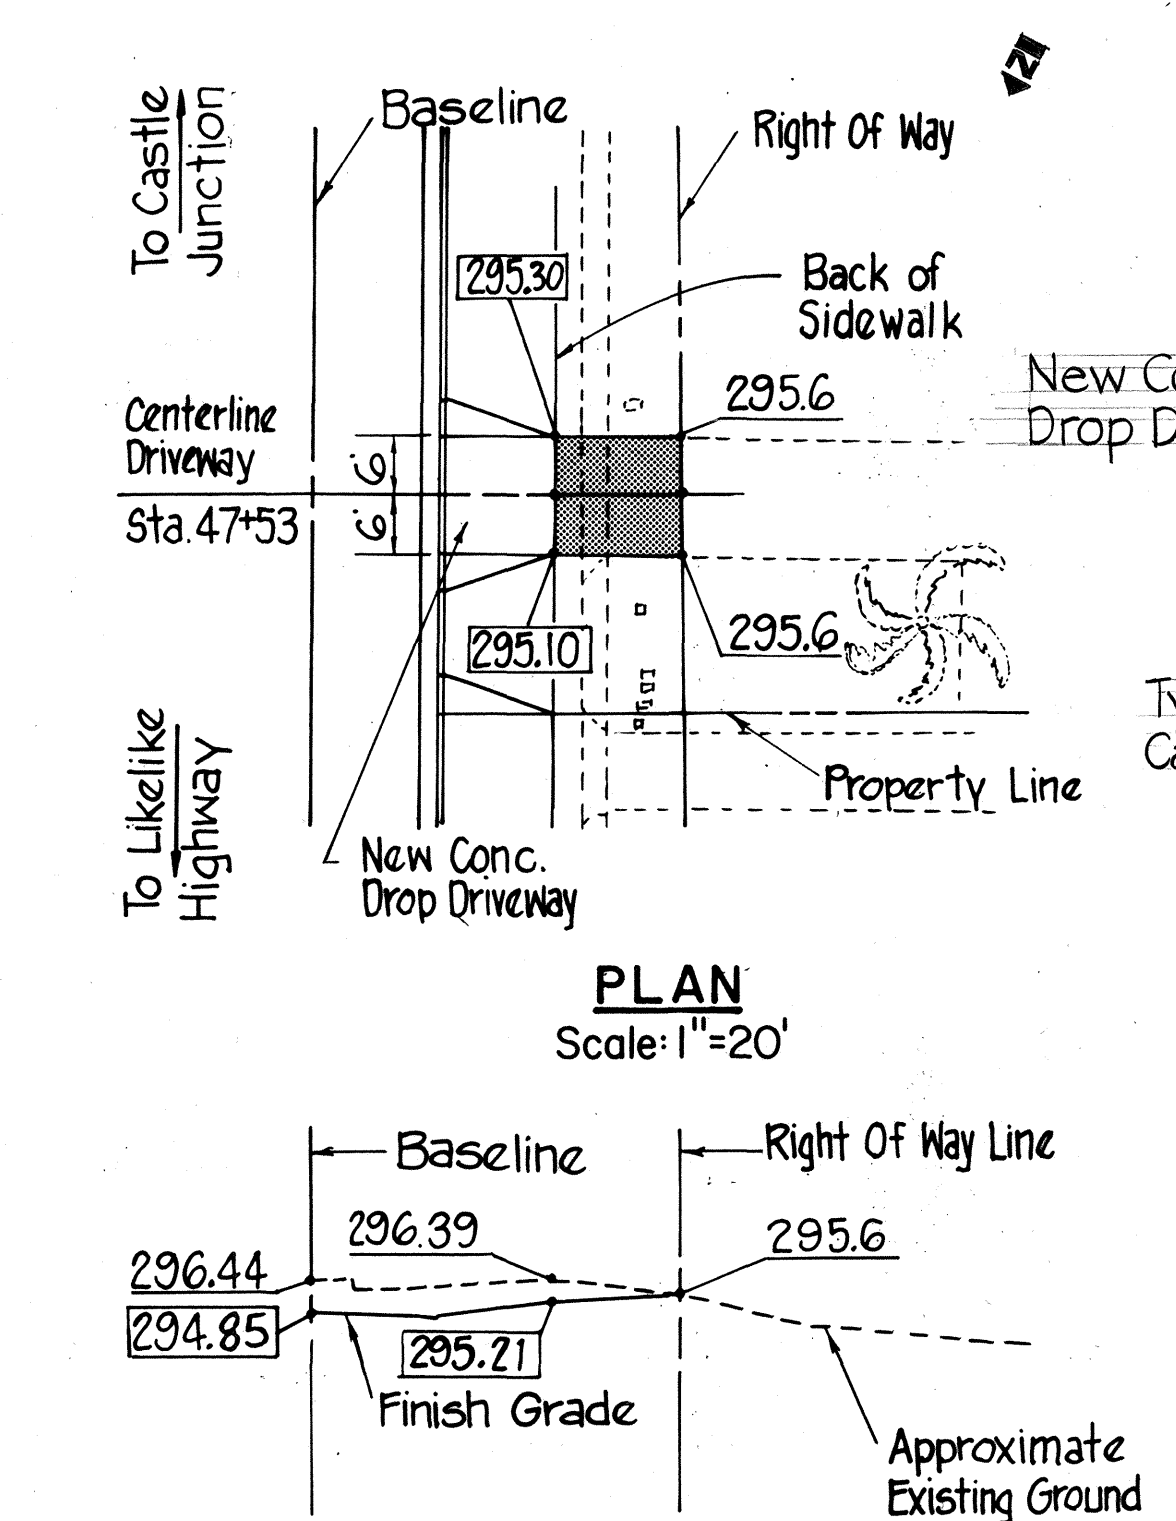


DRIVEWAY AT STA. 47+53

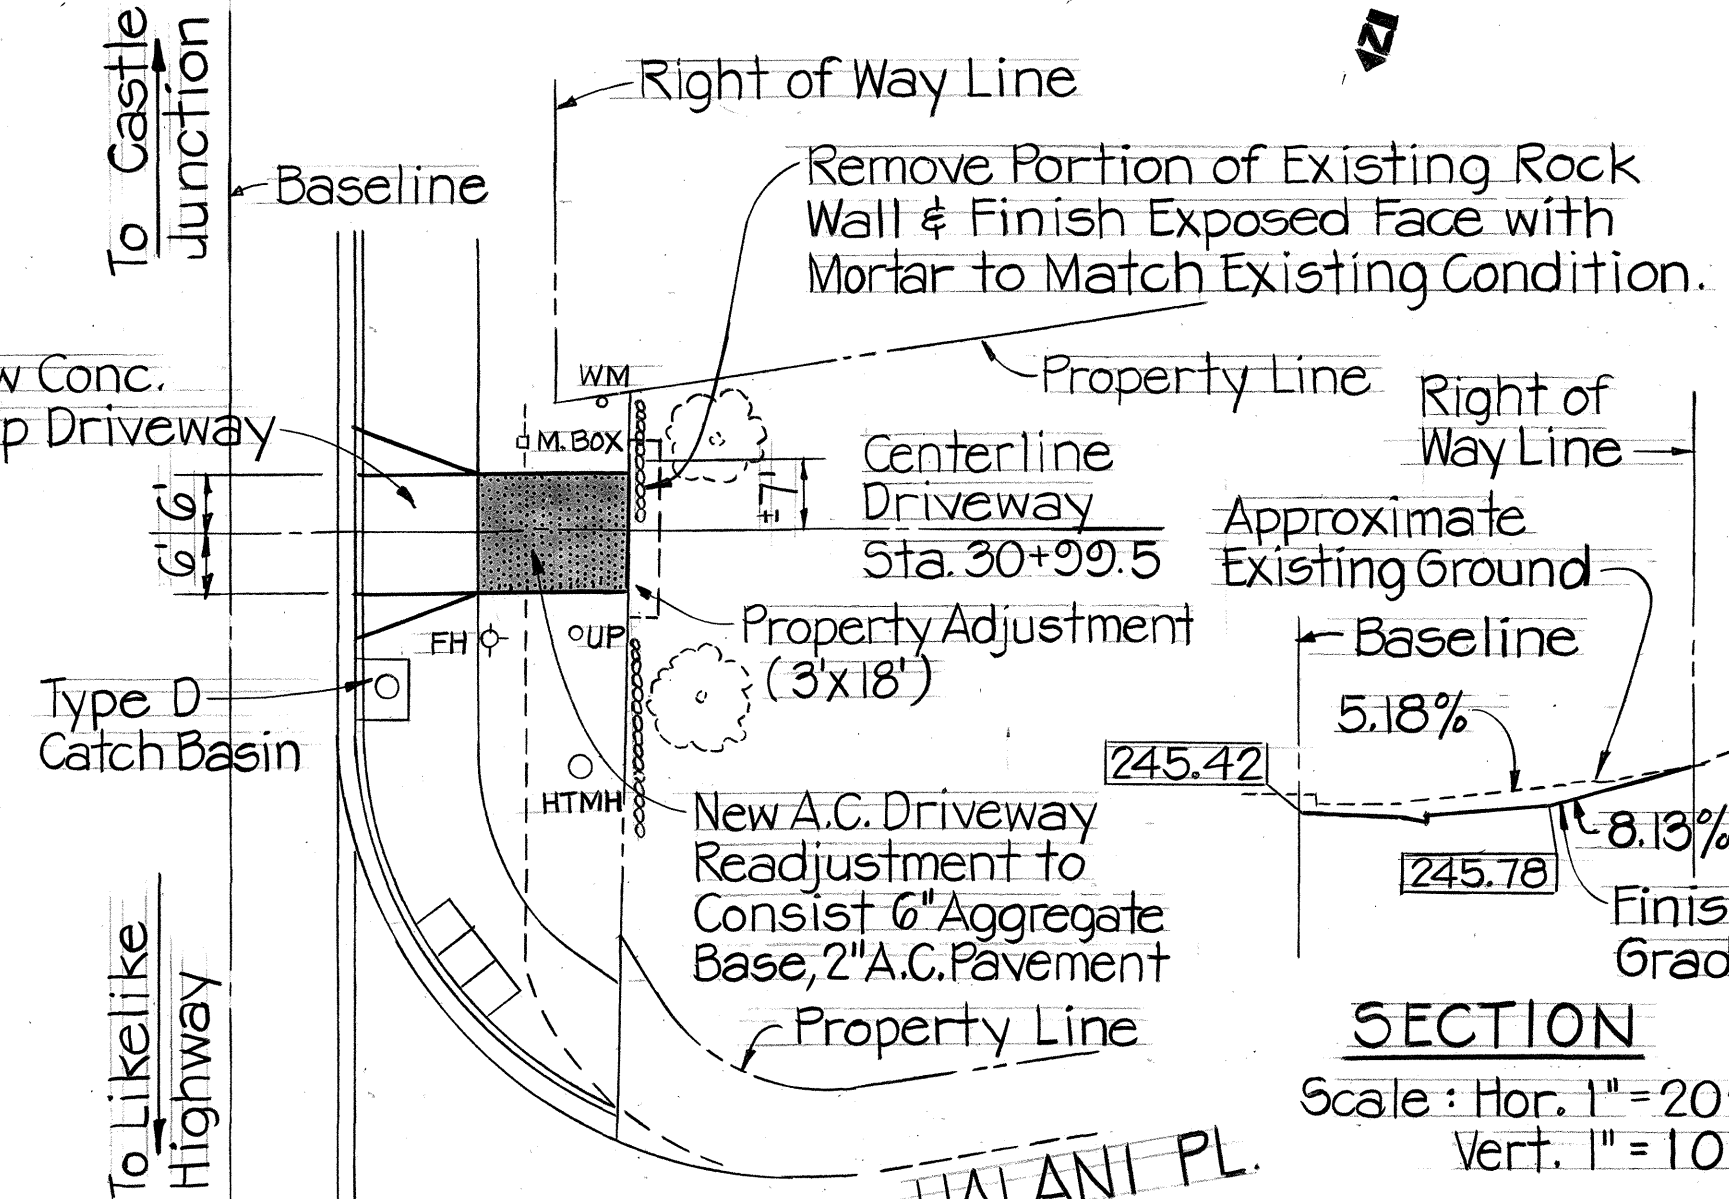

PROPERTY ADJUSTMENT

DATE	
DESIGNED BY	
CHECKED BY	
NOTED BY	
ORIGINAL PLAN	
NOTE BOOK	
No.	

1/9/79	Relocated Driveway from Sta. 42+35 to Sta. 42+70. Added Plan & Section for Driveway @ Sta. 30+00.5 Changed Grades.
DATE	REVISION

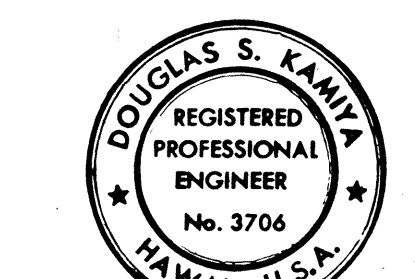

STATE OF HAWAII
DEPARTMENT OF TRANSPORTATION
LAND TRANSPORTATION FACILITIES DIVISION


DRIVEWAY AND PROPERTY ADJUSTMENTS

KAMEHAMEHA HIGHWAY IMPROVEMENT
(LIKELIKE HIGHWAY TO KOOLAU VIEW DRIVE)
PROJECT NO. F-083-1(10)


SCALE: AS SHOWN DATE AUG 1978

SHEET No. 6 OF 8 SHEETS


FED. ROAD DIST. NO.	STATE	FED. AID PROJ. NO.	FISCAL YEAR	SHEET NO.	TOTAL SHEETS
HAWAII	HAW.	F-083-1(10)	1978	28	160

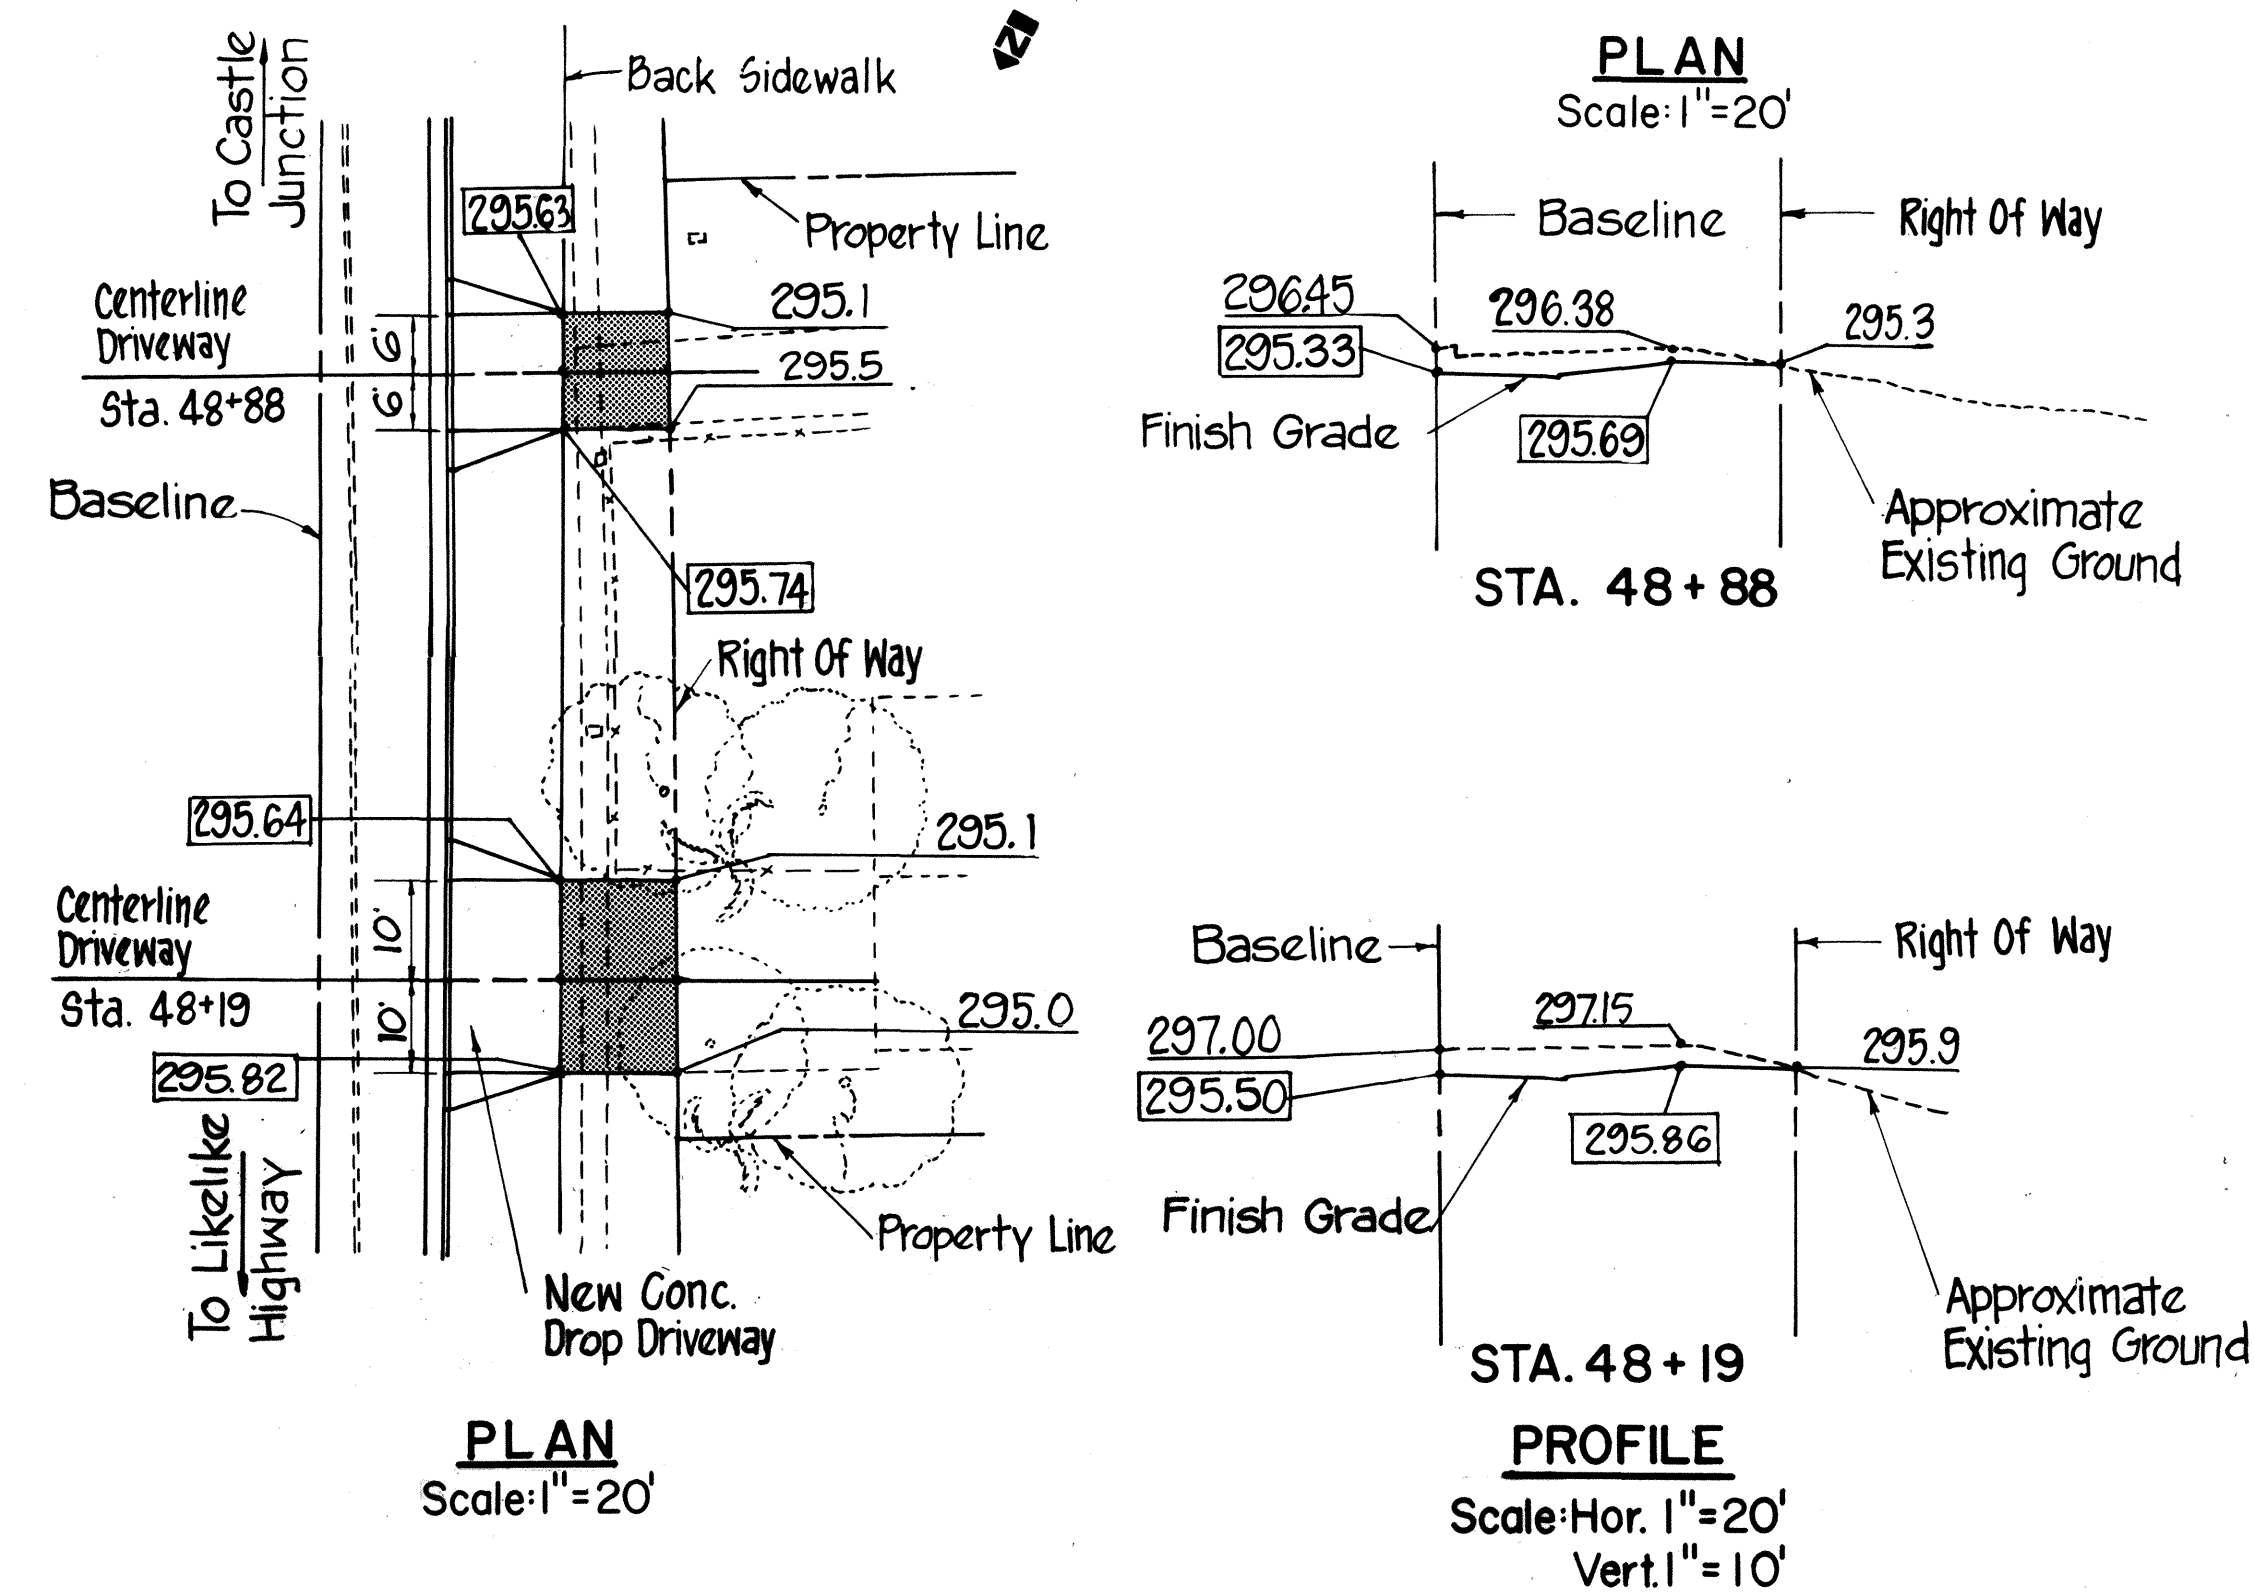


DRIVEWAY AT STA. 48 + 19 & 48 + 88

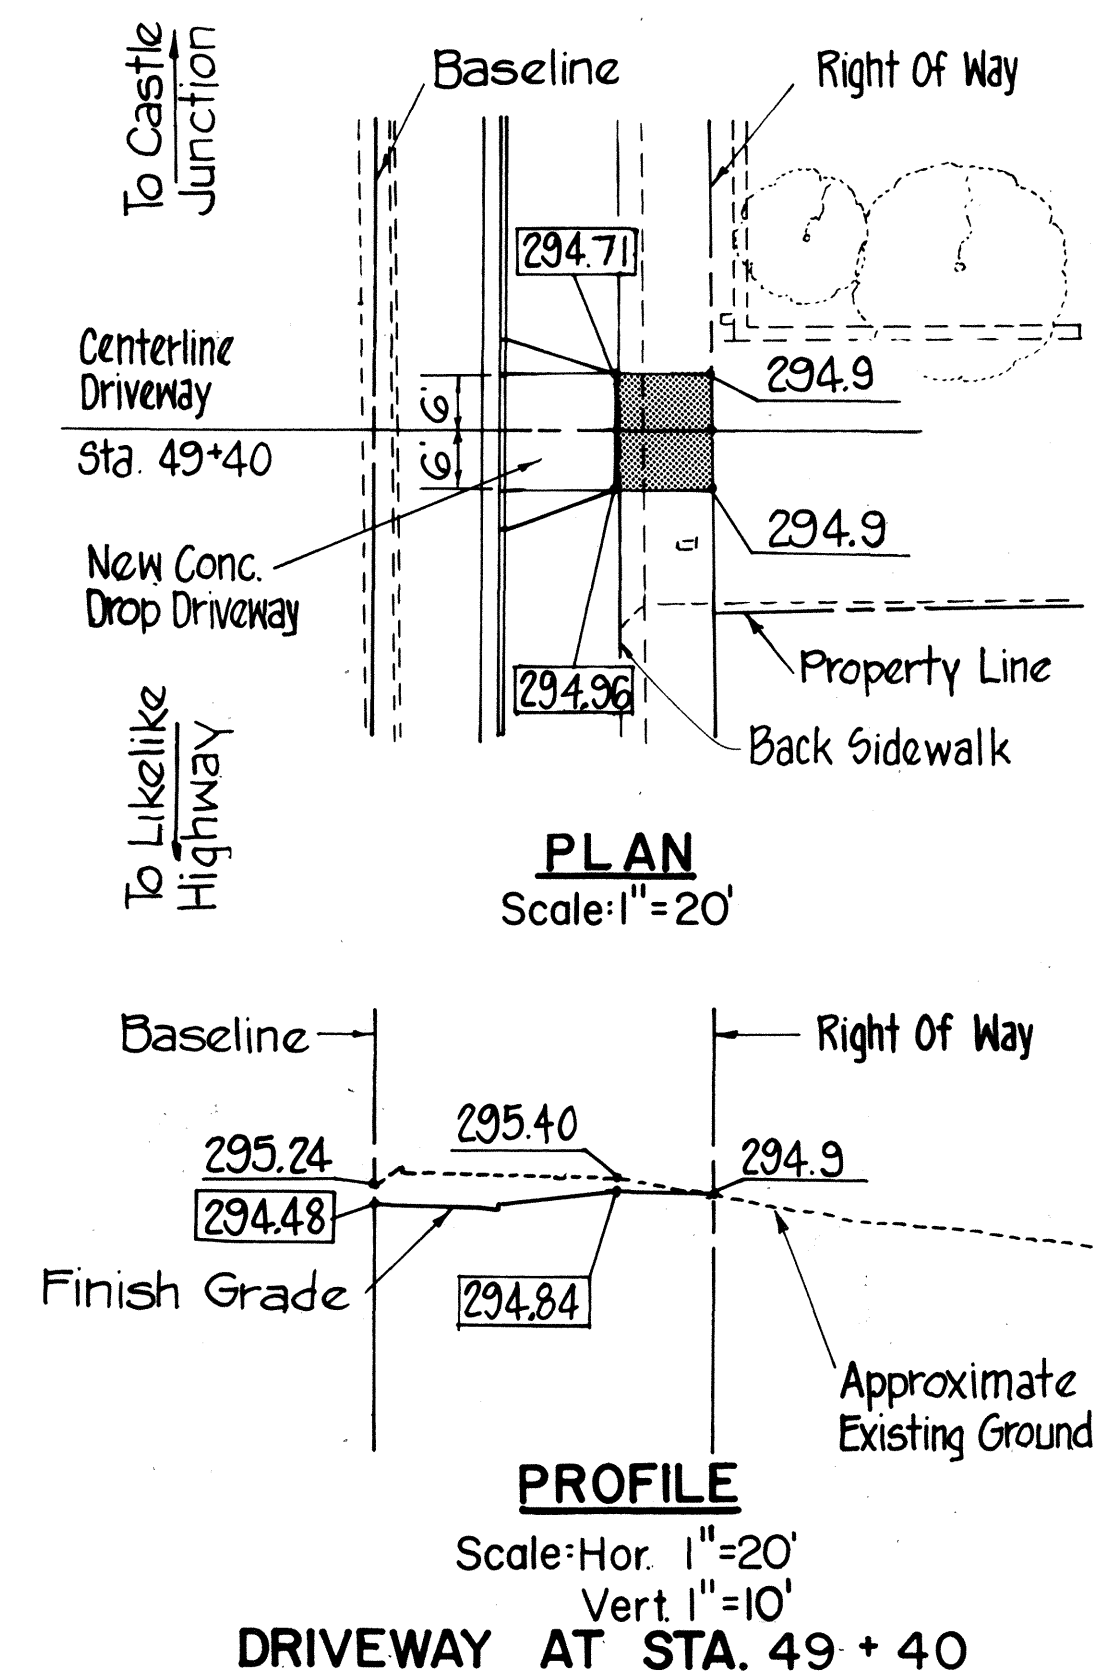


DRIVEWAY AT STA. 49 + 40

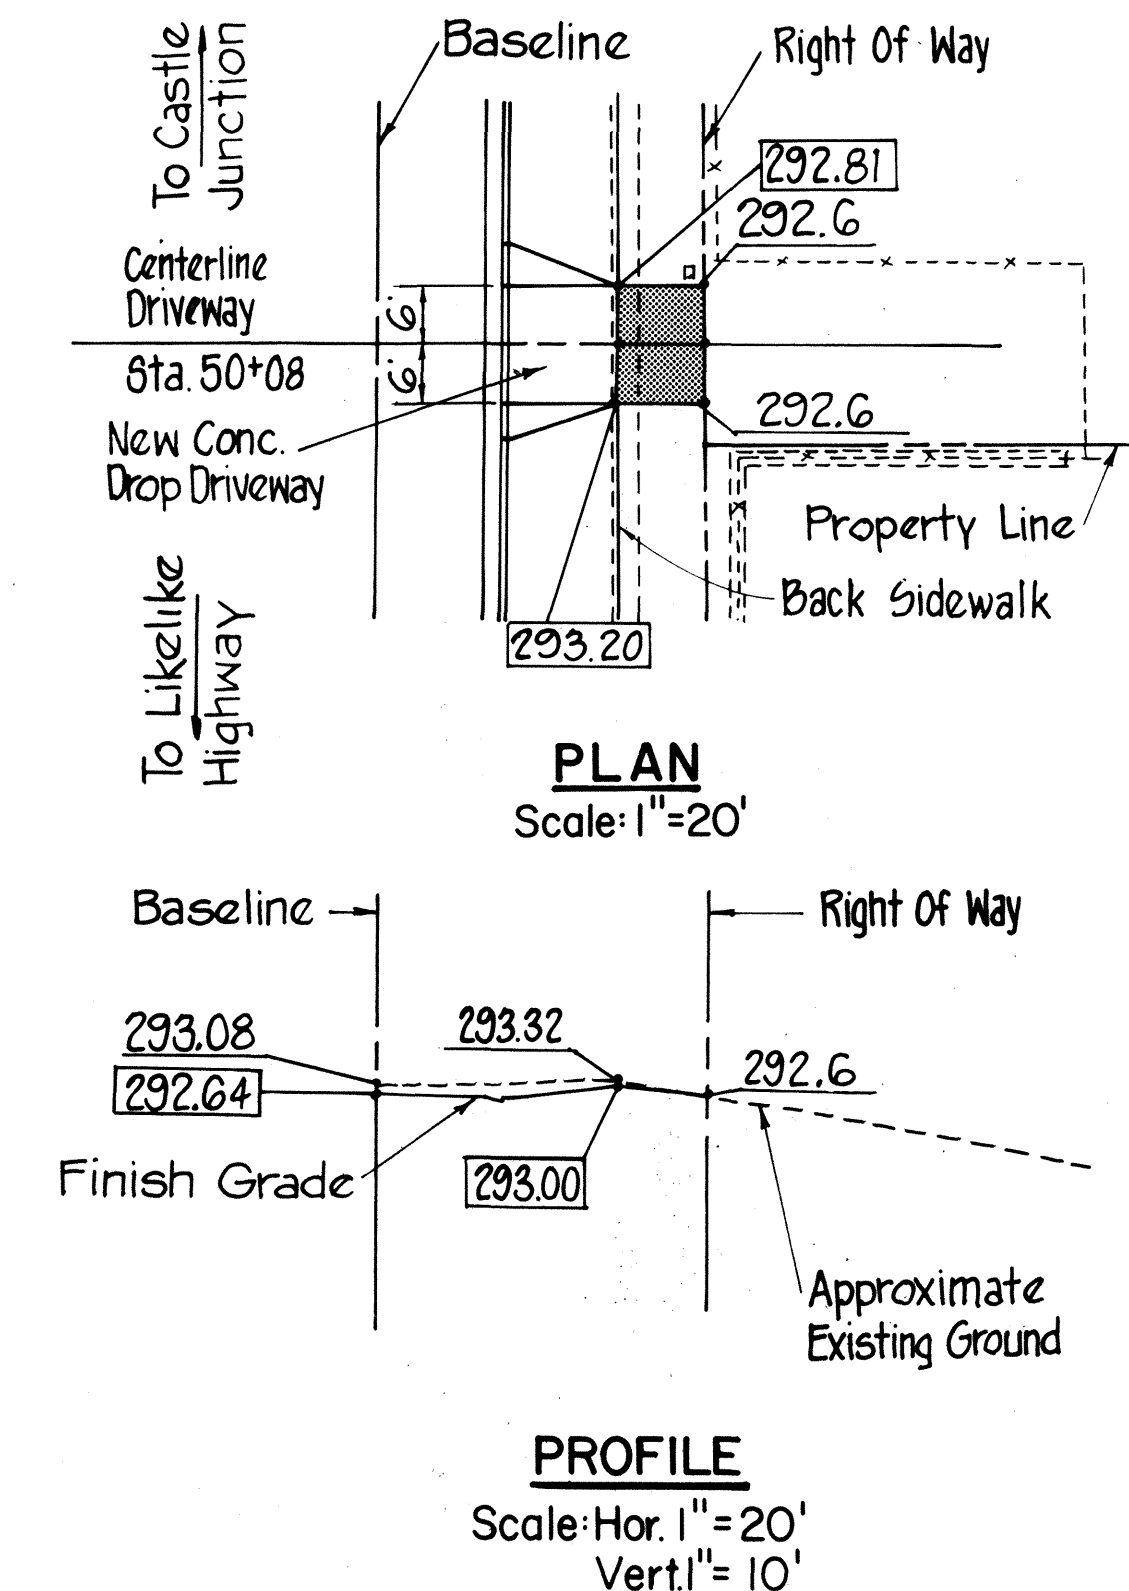


DRIVEWAY AT STA. 50 + 08

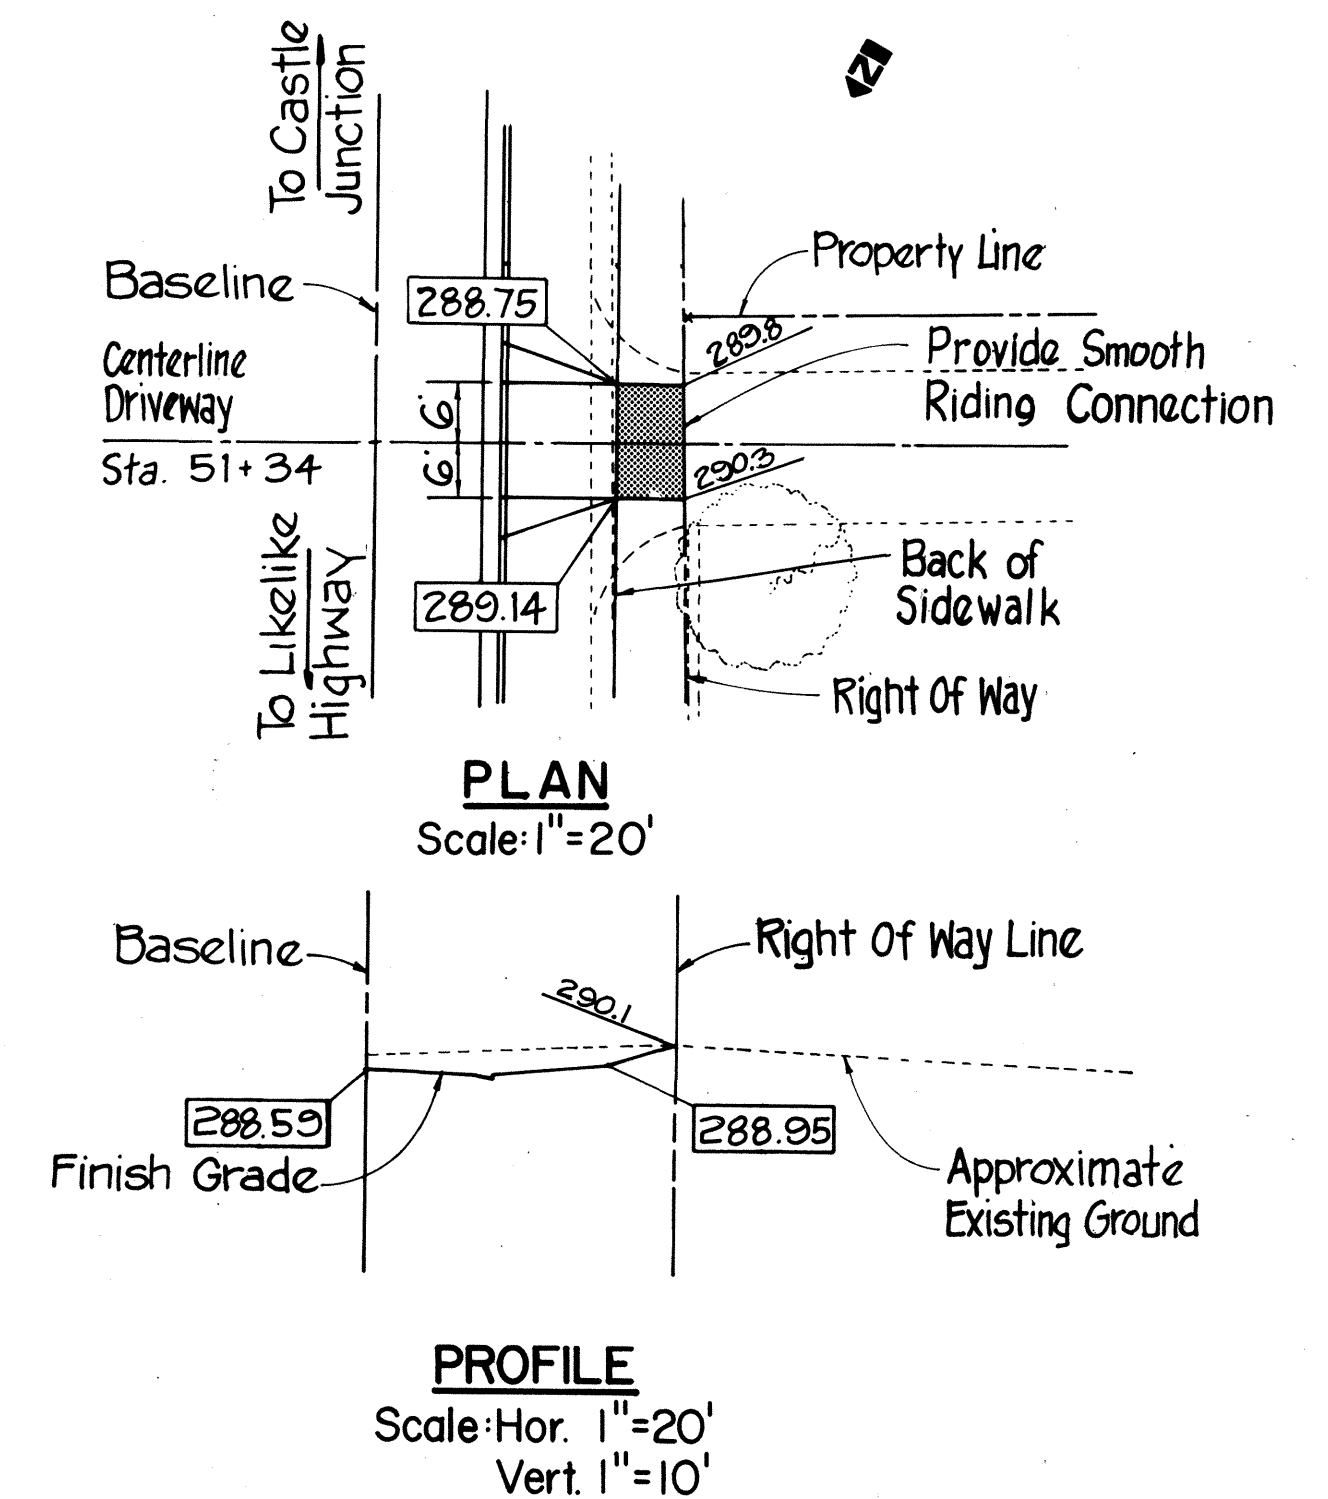


DRIVEWAY AT STA. 51 + 34

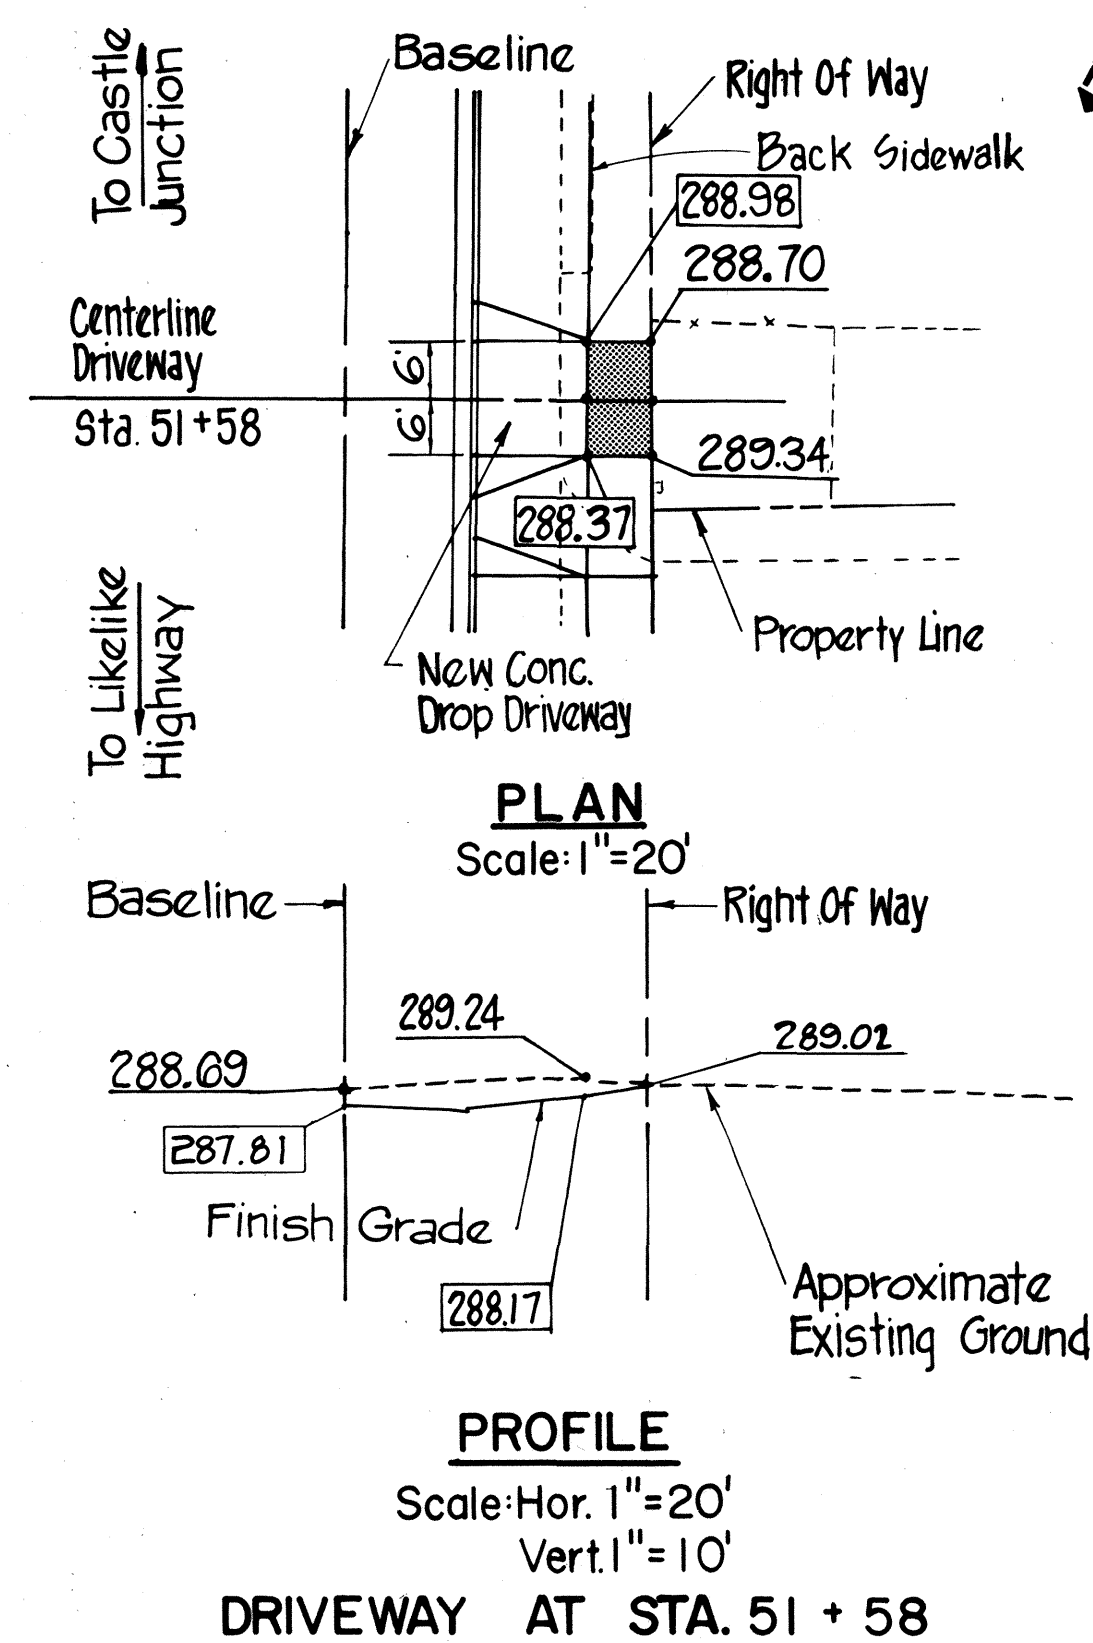

DRIVEWAY AT STA. 51 + 58

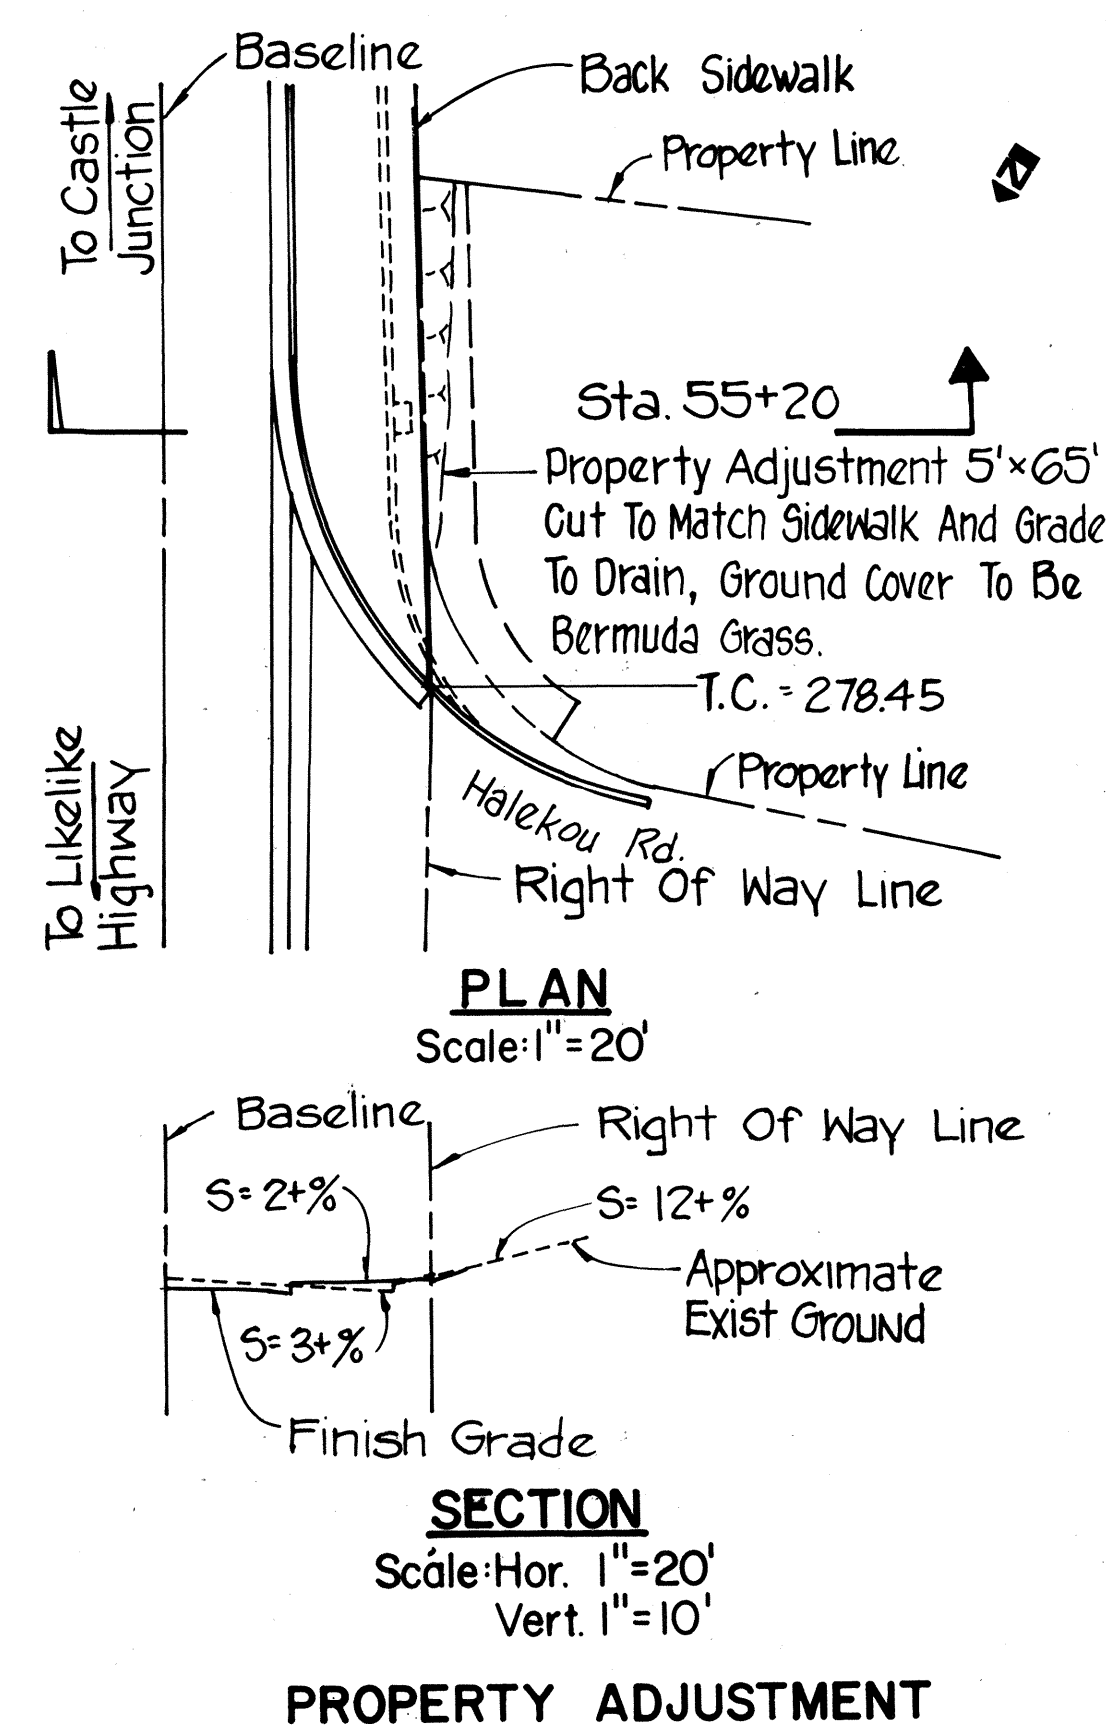


PROPERTY ADJUSTMENT

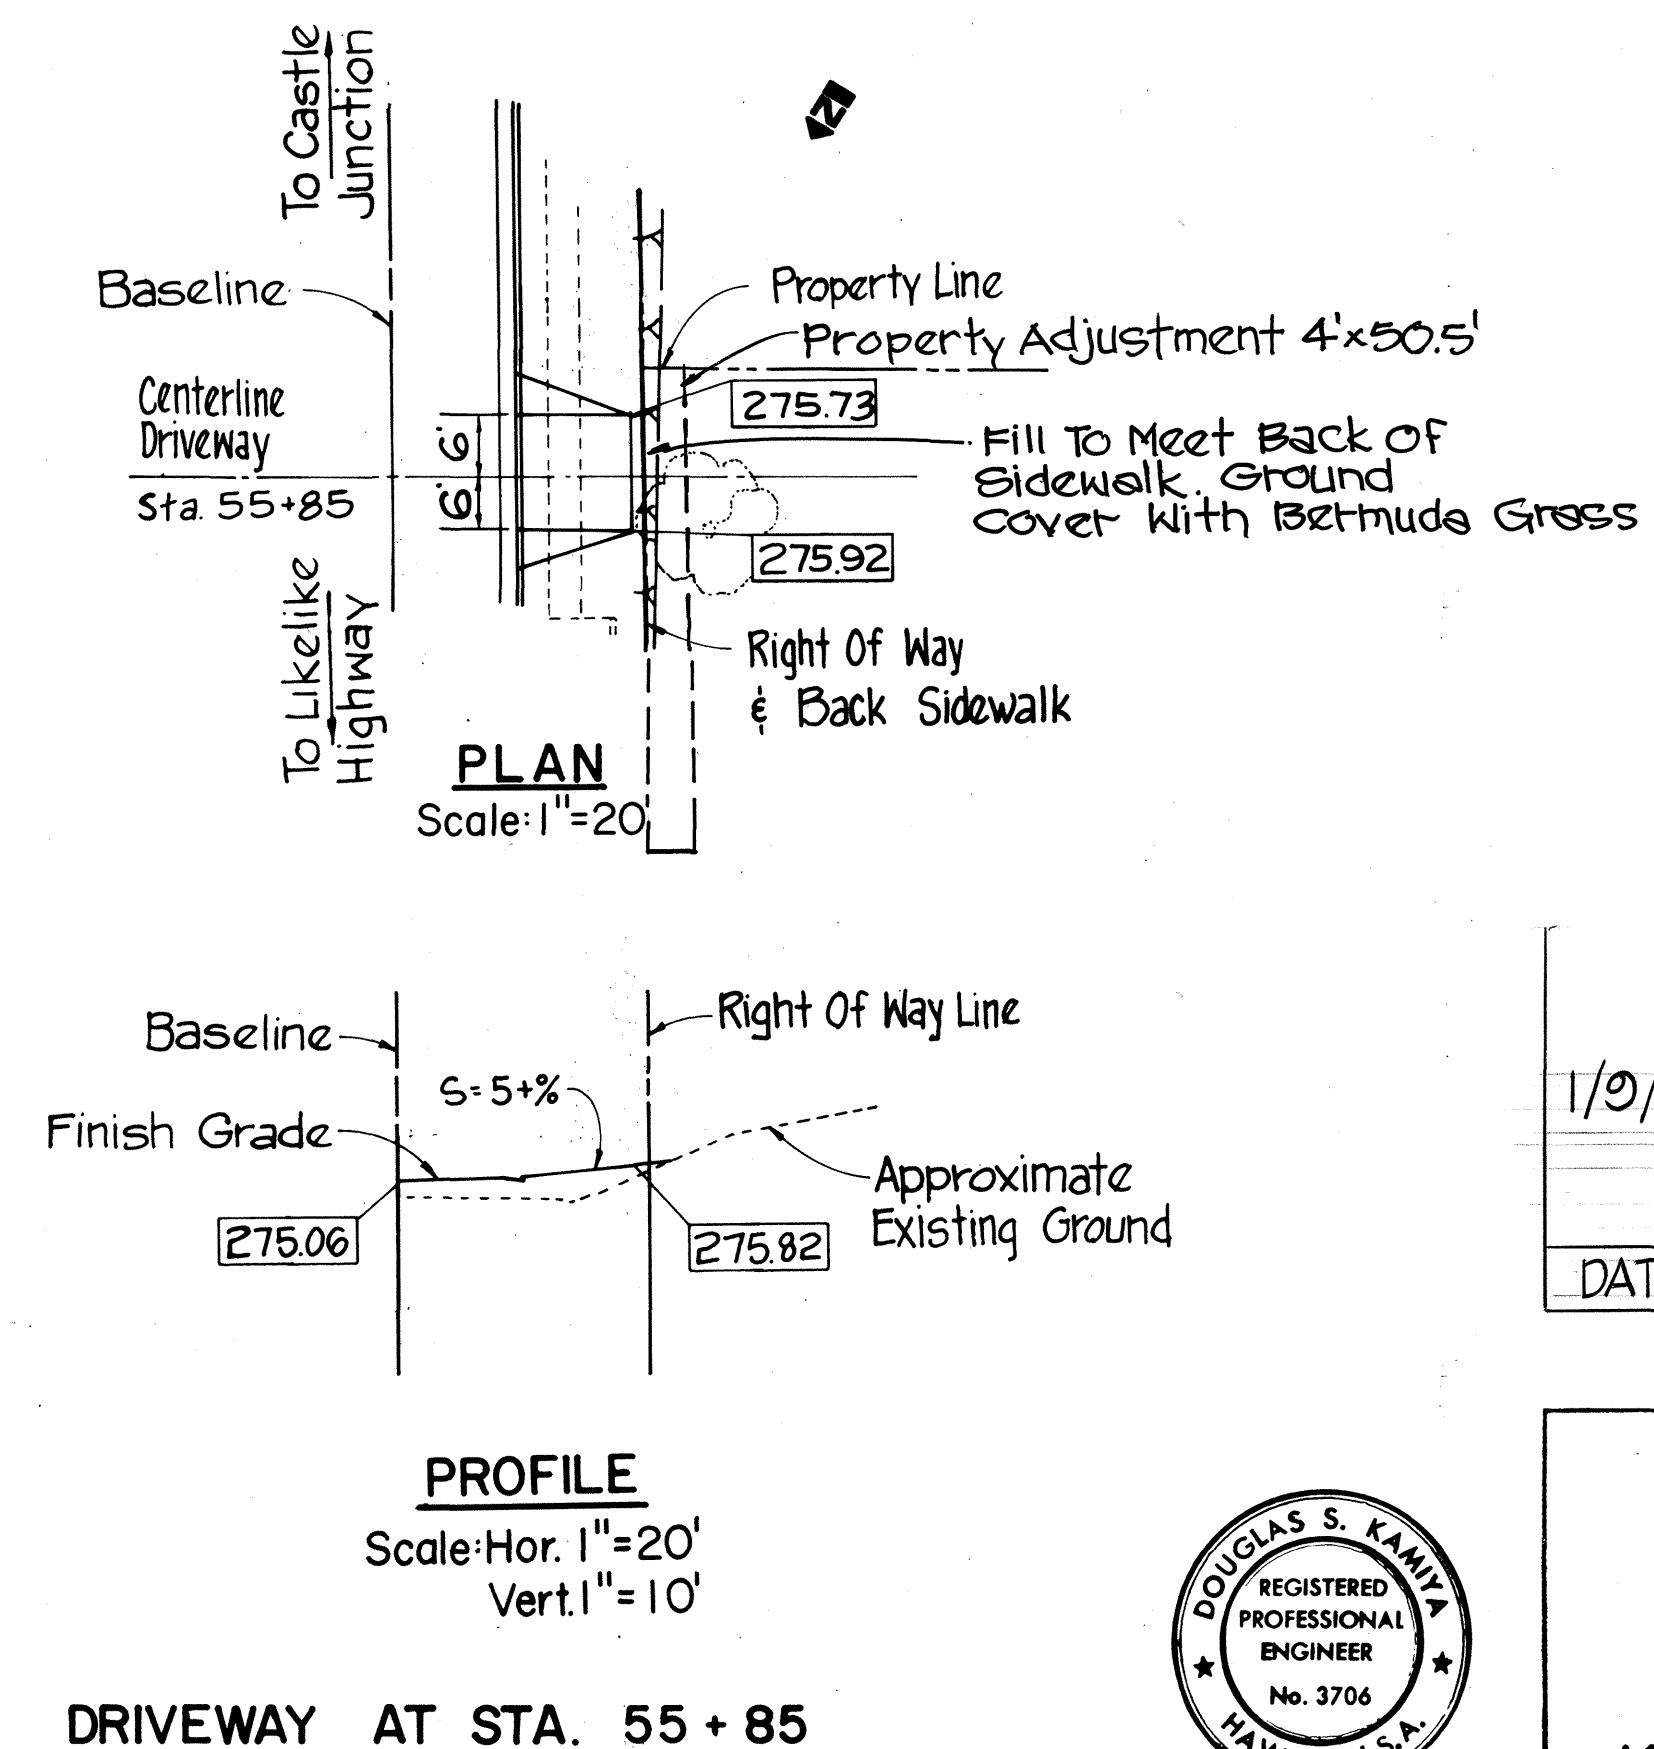

DRIVEWAY AT STA. 55 + 85

1/3/79	Completed Drawing of Property Adjustment Limits on Plan portion of Driveway @ Sta. 55+85
DATE	REVISION

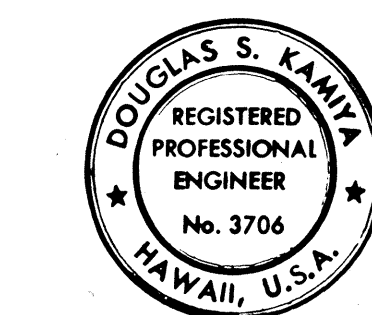

THIS WORK WAS PREPARED BY ME OR UNDER MY SUPERVISION.

Douglas S. Kemmige

STATE OF HAWAII
DEPARTMENT OF TRANSPORTATION
LAND TRANSPORTATION FACILITIES DIVISION

DRIVEWAY AND PROPERTY
ADJUSTMENTS



KAMEHAMEHA HIGHWAY
IMPROVEMENT
(LIKELIKE HIGHWAY TO KOOLAU VIEW DRIVE)
PROJECT NO. F - 083 - I (10)

SCALE: AS SHOWN DATE AUG - 1978



SHEET No. 7 OF 8 SHEETS

ORIGINAL PLAN	SURVEY PLOTTED BY _____ DATE _____
NOTE BOOK	DRAWN BY _____
	TRACED BY _____
	DESIGNED BY _____
	QUANTITIES BY _____
No. _____	CHECKED BY _____



FED. ROAD DIST. NO.	STATE	FED. AID PROJ. NO.	FISCAL YEAR	SHEET NO.	TOTAL SHEETS
HAWAII	HAW.	F-083-1(10)	1978	29	160

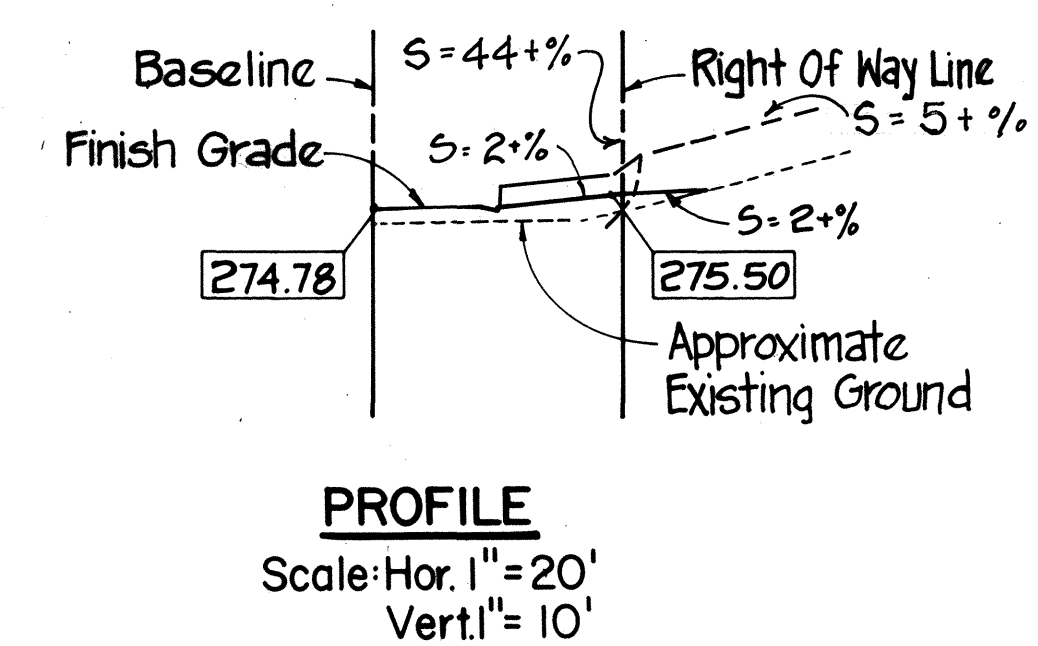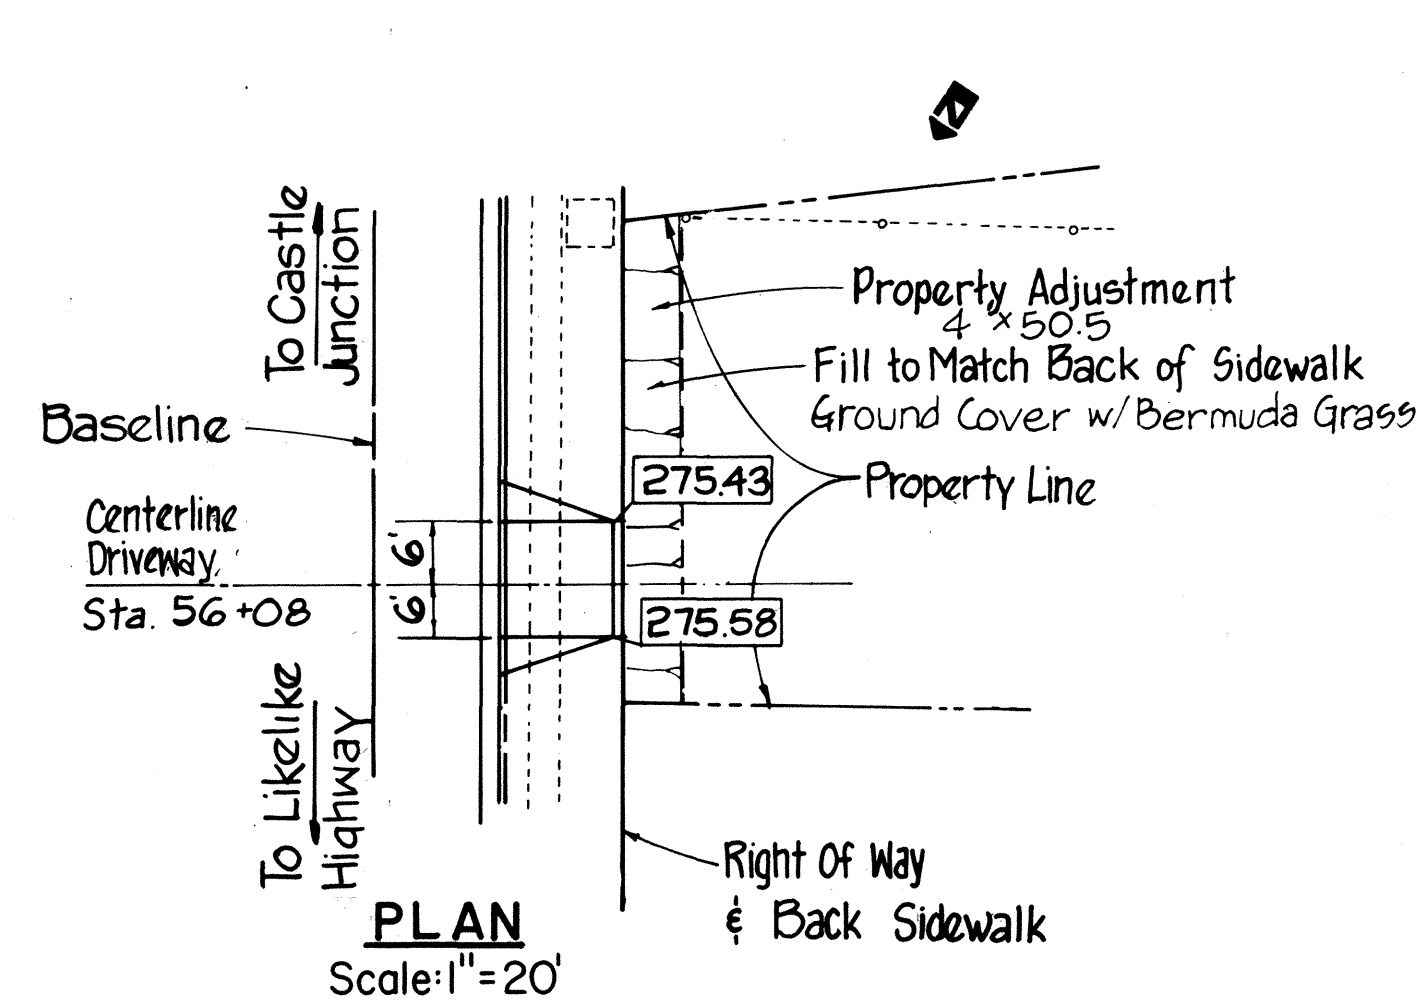

DRIVEWAY AT STA. 56 + 08

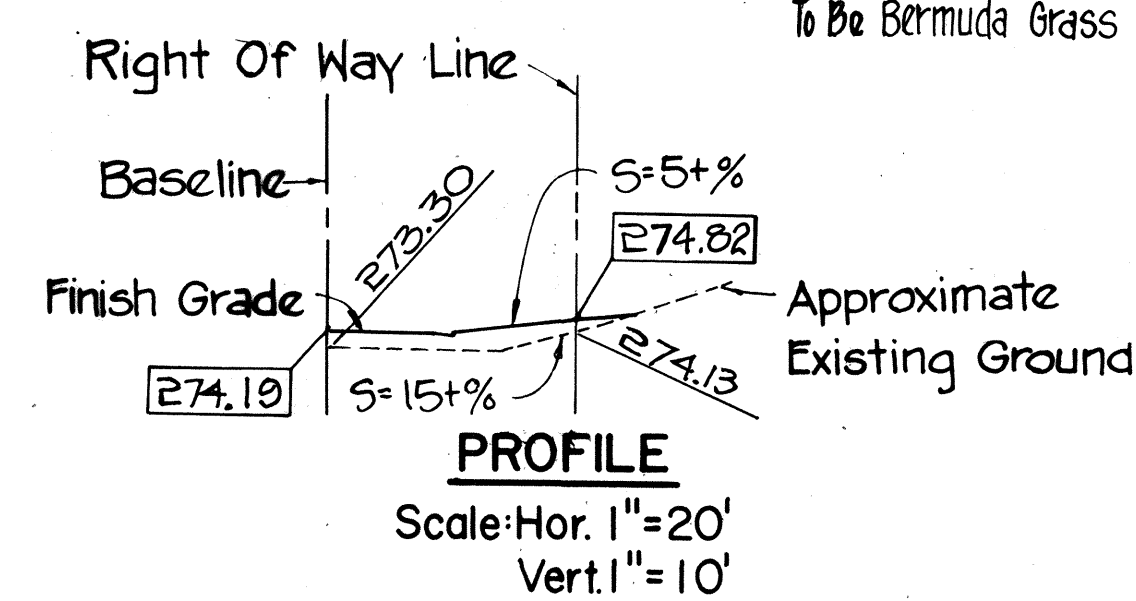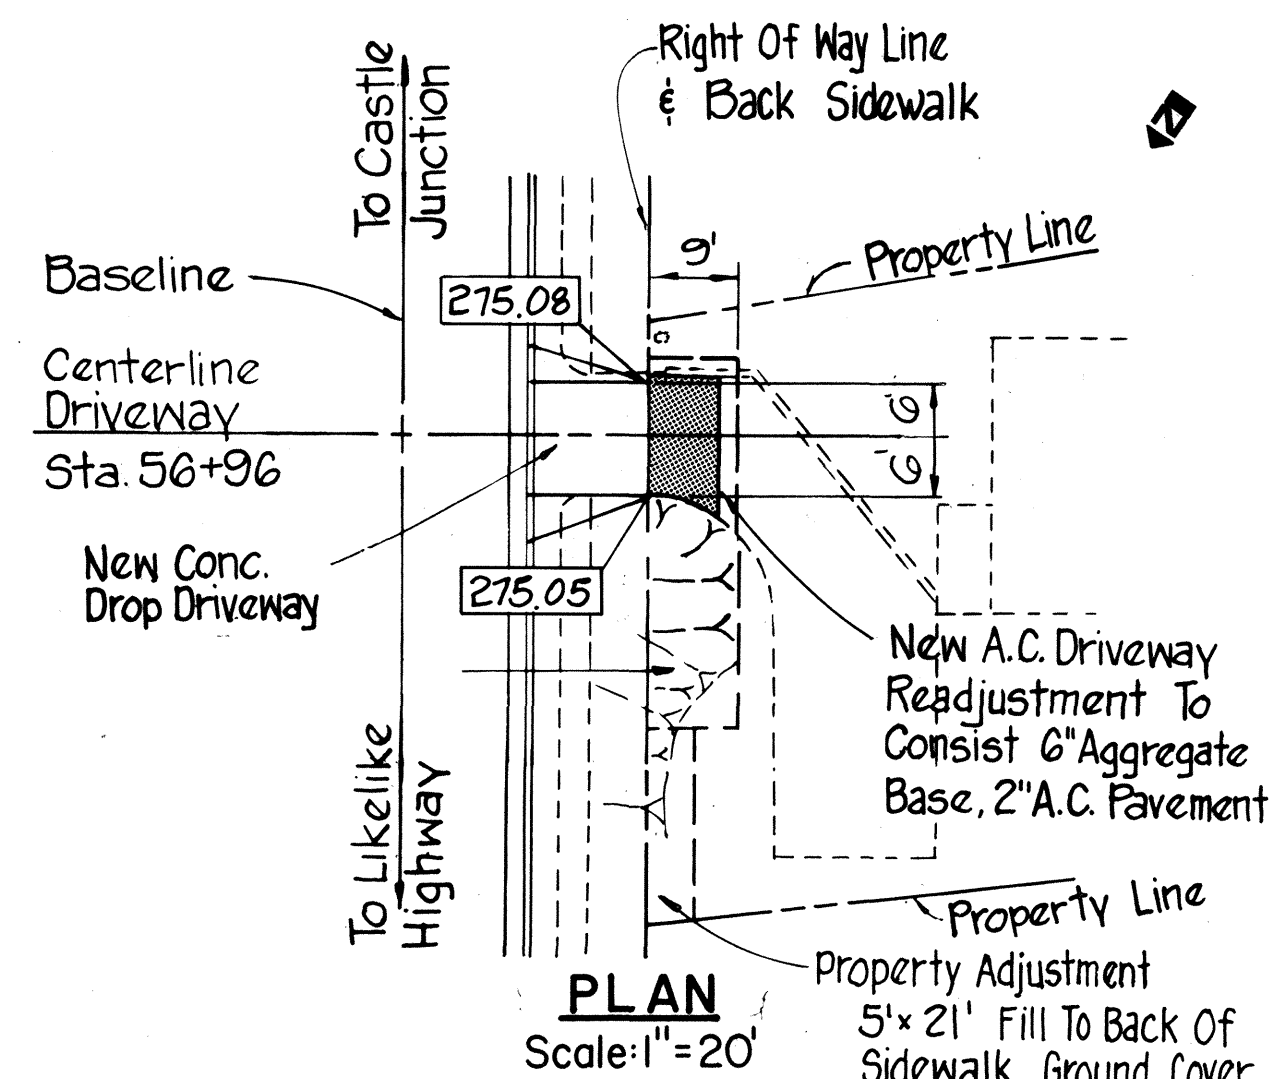


DRIVEWAY AT STA. 56 + 96

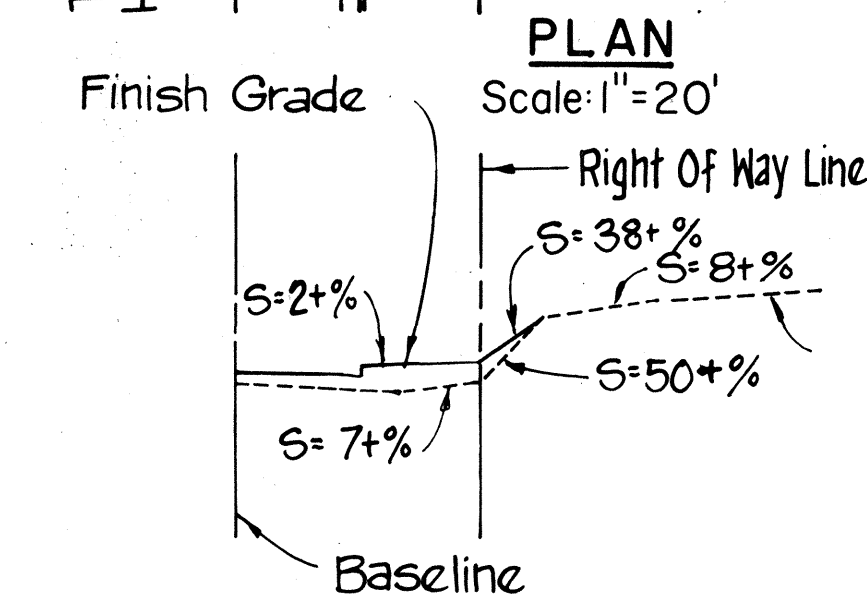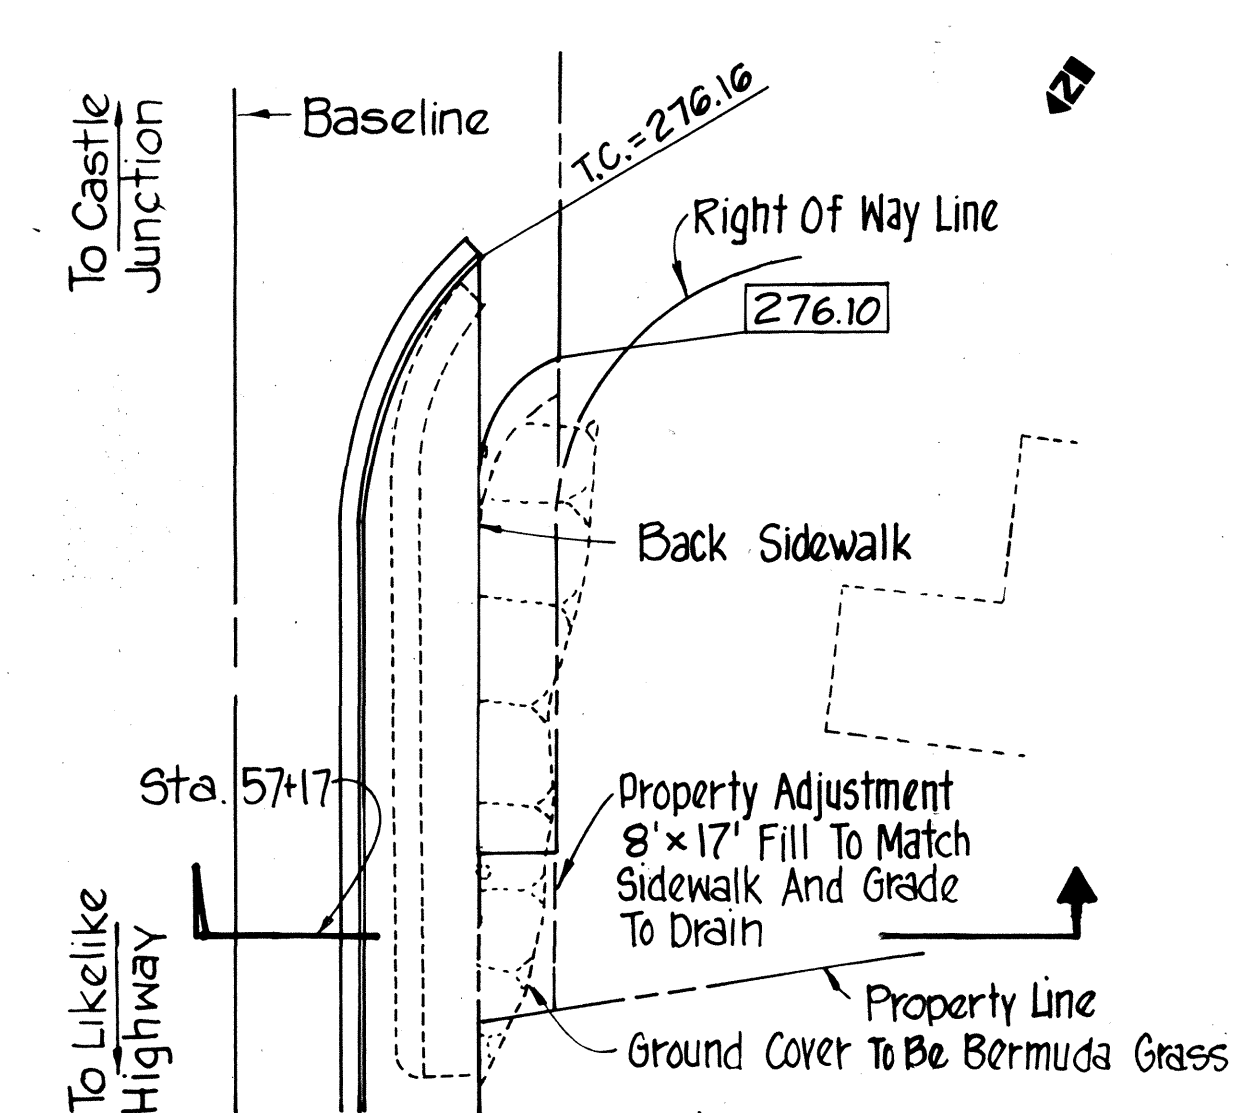

PROPERTY ADJUSTMENT

1/9/79	Changed Grades & Property Adjustment Width.
DATE	REVISION

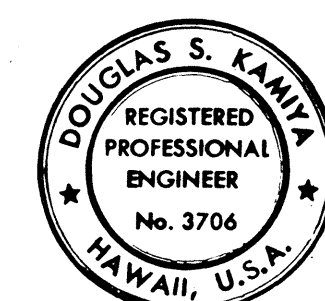

THIS WORK WAS PREPARED BY ME OR UNDER MY SUPERVISION.
Douglas S. Kania

STATE OF HAWAII
DEPARTMENT OF TRANSPORTATION
LAND TRANSPORTATION FACILITIES DIVISION
DRIVEWAY AND PROPERTY ADJUSTMENTS
KAMEHAMEHA HIGHWAY IMPROVEMENT
(LIKELIKE HIGHWAY TO KOOLAU VIEW DRIVE)
PROJECT NO. F - 083 - 1(10)

SCALE: AS SHOWN
DATE: AUG 1978
SHEET No. 8 OF 8 SHEETS

DATE	
SURVEY PLOTTED BY	
DRAWN BY	
TRACED BY	
DESIGNED BY	
CHECKED BY	
NOTE BOOK	
No.	