

WATER NOTES:

1. UNLESS OTHERWISE SPECIFIED, ALL MATERIALS AND CONSTRUCTION OF WATER SYSTEM FACILITIES AND APPURTENANCES SHALL BE IN ACCORDANCE WITH THE HONOLULU BOARD OF WATER SUPPLY'S WATER SYSTEM STANDARDS, DATED MARCH 1977, AND ALL SUBSEQUENT AMMENDMENTS AND ADDITIONS.
2. ALL PLANS APPROVED BY THE BOARD OF WATER SUPPLY ARE BASED SOLELY ON THE ADEQUACY OF THE WATER SUPPLY. ALL OTHER FEATURES OF THE WATER SYSTEM SUCH AS LINES, GRADES FITTINGS, ETC., SHALL BE THE RESPONSIBILITY OF THE ENGINEER WHO PREPARED THE PLANS. DRAINAGE AND OTHER FEATURES OF THE IMPROVEMENT SHALL NOT BE THE RESPONSIBILITY OF THE BOARD OF WATER SUPPLY.
3. PRIOR TO EXCAVATING FOR NEW UTILITY LINES, THE CONTRACTOR SHALL VERIFY IN THE FIELD THE LOCATION OF EXISTING WATER MAINS AND APPURTENANCES. WHERE THE INSTALLATION OF NEW UTILITY LINES ARE TO CROSS OVER OR UNDER EXISTING WATER MAINS THE CONTRACTOR SHALL EXPOSE THE EXISTING WATER MAINS PRIOR TO TRENCHING. EXCAVATION AROUND WATER MAINS SHALL BE DONE BY HAND.
4. THE CONTRACTOR SHALL NOTIFY THE BOARD OF WATER SUPPLY IN WRITING ONE WEEK PRIOR TO COMMENCING WORK BY THE MAINS.
5. WATER MAINS SHALL BE MAINTAINED IN SERVICE DURING THE CONSTRUCTION PERIOD UNTIL SUCH TIME THE ADJUSTMENTS ARE MADE.
6. THE EXISTENCE AND LOCATION OF UNDERGROUND UTILITIES AND STRUCTURES AS SHOWN ON THE PLANS ARE FROM THE LATEST AVAILABLE DATA BUT IS NOT GUARANTEED AS TO THE ACCURACY OR THE ENCOUNTERING OF OTHER OBSTACLES DURING THE COURSE OF THE WORK. THE CONTRACTOR SHALL BE RESPONSIBLE AND SHALL PAY FOR ALL DAMAGES TO EXISTING UTILITIES.
7. UNLESS OTHERWISE SPECIFIED, CONNECTIONS TO EXISTING WATER MAINS AND CHLORINATION OF NEW MAINS SHALL BE DONE BY THE CONTRACTOR, WITH THE B.W.S. INSPECTOR COORDINATING THE WORK. FOR DETAILS, CONTACT B.W.S. ENGINEERING DIVISION, CONSTRUCTION SECTION.
8. ALL METER BOXES INCLUDING FRAMES AND COVERS SHALL BE FURNISHED, INSTALLED AND PAID FOR BY THE CONTRACTOR.
9. TEST PRESSURE SHALL BE 250 PSI.
10. IN THE EVENT THAT MAINS OTHER THAN DUCTILE IRON ARE TO BE USED, THE PLANS SHALL BE RESUBMITTED FOR APPROVAL.
11. ALL CAST IRON (DUCTILE OR GRAY) PIPES, FITTINGS AND VALVES SHALL BE ENCLOSED IN PLASTIC MATERIAL IN ACCORDANCE WITH ANSI SPECIFICATIONS A21.5-1972 OR AWWA SPECIFICATIONS C105-72 POLYETHYLENE ENCASEMENT FOR GRAY AND DUCTILE CAST IRON PIPING FOR WATER AND OTHER LIQUIDS.
12. VALVE ID TAGS SHALL BE AFFIXED ON THE UNDERSIDE OF ALL NEW MANHOLE AND VALVE BOX COVERS. SEE DETAIL.
13. REAPPROVAL SHALL BE REQUIRED IF THIS PROJECT IS NOT UNDER CONSTRUCTION WITHIN A PERIOD OF ONE YEAR (SEE RULES AND REGULATIONS OF THE BOARD OF WATER SUPPLY).
14. FIRE HYDRANTS SHALL BE EAST BAY MODEL 5 AS SPECIFIED IN THE WATER SYSTEM STANDARDS, JAMES-JONES MODEL J-3740, OR APPROVED EQUAL. BREAKAWAY BOLTS SHALL BE DRILLED 11/32" X 1-3/8".
15. MAINTENANCE OF WATER LINES BEYOND THE WATER METER SHALL BE THE RESPONSIBILITY OF THE OWNERS.
16. WATER PIPELINE EASEMENTS SHALL BE GRANTED TO THE BOARD OF WATER SUPPLY FOR ALL LINES TO BE CONVEYED TO THE BWS. WHICH ARE LOCATED WITHIN PRIVATE PROPERTY AND ROADWAYS THAT WILL NOT BE DEDICATED TO THE CITY.


ELECTRIC & TELEPHONE NOTES:

1. THE CONTRACTOR SHALL NOTIFY EACH UTILITY IN WRITING TEN WORKING DAYS PRIOR TO COMMENCING WORK ON THEIR RESPECTIVE UTILITY SYSTEM.
2. EXISTING ELECTRIC AND TELEPHONE SYSTEMS SHOWN ON THESE PLANS ARE LOCATED FROM THE BEST SOURCES AVAILABLE. THE CONTRACTOR SHALL CHECK AND VERIFY IN THE FIELD THE EXACT LOCATION AND DEPTH OF SAME.
3. CONTRACTOR TO STAKE OUT PROPOSED DUCTLINES, MANHOLES, HANDHOLES, POLE AND ANCHOR LOCATIONS. HECO TO CHECK LOCATIONS BEFORE CONTRACTOR UNDERTAKES EXCAVATION. CONTRACTOR TO REQUEST TONING OUT OF EXISTING HECO'S UNDERGROUND FACILITIES PRIOR TO STAKING OUT PROPOSED MANHOLES AND HANDHOLES. THE CONTRACTOR IS TO CALL HECO'S UNDERGROUND DIVISION AT 548-7395, 72 HOURS IN ADVANCE.
4. THE CONTRACTOR SHALL NOTIFY THE AFFECTED PROPERTY OWNERS AT LEAST ONE WEEK IN ADVANCE AS TO THE TIME AND DURATION THE TRENCHING AND INSTALLING OF UNDERGROUND ELECTRIC AND TELEPHONE SERVICE WILL BE PERFORMED IN THEIR PROPERTY.
5. UNLESS OTHERWISE SHOWN ON THE PLANS, THE MINIMUM DEPTH OF DUCT LINE FROM FINISHED GRADE:
 - A. TOP OF CONCRETE JACKET IN PAVEMENT AREAS WITHIN HWY RIGHT-OF-WAY WHERE DUCTS ARE CONCRETE ENCASED=3.0 FT
 - B. TOP OF CONCRETE JACKET IN SIDEWALK AREAS WITHIN HWY RIGHT-OF-WAY WHERE DUCTS ARE CONCRETE ENCASED=1.5 FT
 - C. TOP OF DUCTS, COMMERCIAL AREA.(DIRECT BURIAL) UP TO 3 DUCTS.
IN PROPERTY = 2.0 FT
IN SIDEWALK = 2.0 FT
NOTE: 4 OR MORE DUCTS WILL BE CONCRETE ENCASED WITH A MIN. OF 1.5 FT CONCRETE COVER.
 - D. TOP OF CONCRETE JACKET, COMMERCIAL AREA, WHERE DUCTS ARE CONCRETE ENCASED
IN PROPERTY = 2.0 FT
IN SIDEWALK = 1.5 FT
 - E. TOP OF DUCTS, RESIDENTIAL AREA (DIRECT BURIAL)
IN PROPERTY = 1.5 FT
IN SIDEWALK = 2.0 FT
 - F. TOP OF CONCRETE JACKET, RESIDENTIAL AREA, WHERE DUCTS ARE CONCRETE ENCASED
IN PROPERTY = 1.5 FT
IN SIDEWALK = 1.5 FT
6. DUCTS ENCASED IN CONCRETE JACKET:
 - A. NORMAL DISTANCE FROM FACE OF JACKET TO ALL DUCTS TO BE 3 INCHES MINIMUM.
 - B. CLEAR DISTANCE OF 1.5 INCHES MINIMUM BETWEEN DUCTS OF SAME UTILITY.
 - C. CLEAR DISTANCE OF 3.0 INCHES MINIMUM BETWEEN HECO AND HTCO DUCT LINES.
7. ALL DUCTS AND CONDUITS CALLED FOR INSTALLATION IN CONCRETE JACKETS SHALL BE INSPECTED AND APPROVED BY THE RESPECTIVE REPRESENTATIVE OF HECO OR HTCO BEFORE CONCRETE PLACING. 24 HOUR MINIMUM NOTICE SHALL BE GIVEN BEFORE PLACING CONCRETE.
8. FINAL DEPTH OF ALL PULL BOXES, SERVICE BOXES, HANDHOLES AND MANHOLES SHALL BE DETERMINED IN THE FIELD BY THE ENGINEER.
9. ANCHOR HOLES SHALL BE BACKFILLED BY HECO OR ITS CONTRACTOR.

10. THE EXISTING CABLES, WHICH ARE IN DUCT LINES AND IN EXISTING HANDHOLES ARE ENERGIZED. THESE ENERGIZED INSULATED CABLES ARE TO REMAIN IN PLACE DURING CONSTRUCTION. ONLY HECO PERSONNEL ARE TO HANDLE THESE CABLES AND TO ERECT TEMPORARY GUARDS TO PROTECT THESE CABLES FROM DAMAGE. THE CONTRACTOR MUST EXERCISE DUE CARE AND TAKE PRECAUTIONS TO AVOID DISTURBANCE OF ENERGIZED CABLES, TEMPORARY GUARDS, ETC. AND SHALL WORK CAUTIOUSLY TO AVOID ACCIDENTS.
11. HTCO CONDUIT BENDS, THAT CONNECT DIRECTLY FROM PULLBOX OR HANDHOLE TO POLE SHALL BE DIRECT BURIAL, THE PAYMENT OF WHICH SHALL BE INCIDENTAL TO THE INSTALLATION OF THE PULLBOX, HANDHOLE, OR TO POLE EXCAVATION.
12. WHERE THE PLANS SHOW A TAP OR AN INTERCEPTION INTO AN EXISTING DUCTLINE, THE CONTRACTOR SHALL FIRST EXPOSE THE DUCTLINE. THE UTILITY COMPANY WILL BREAK INTO THE ENCASEMENT. THE CONTRACTOR SHALL THEN FINISH THE WORK UNDER HECO'S SUPERVISION. ALL WORK AND MATERIALS SHALL BE INCIDENTAL TO THE DUCTLINE, SERVICE BOX OR HANDHOLE FOR WHICH THE WORK IS BEING DONE.
13. WHERE POSSIBLE, SLOPE DUCTLINE TO DRAIN TOWARDS PULLBOX SERVICE BOX, HANDHOLE OR MANHOLE.
14. THE CONTRACTOR SHALL FURNISH AND INSTALL ALL MATERIALS TO COMPLETE CONSTRUCTION OF THE UNDERGROUND DUCTLINE SYSTEM INCLUDING RISER CONDUITS. ALL ELECTRIC DUCTS SHALL BE ENCASED IN CONCRETE, UNLESS OTHERWISE NOTED.
15. THE CONTRACTOR IS TO MANDREL TEST ALL DUCTLINES IN THE PRESENCE OF HECO'S INSPECTOR PRIOR TO ACCEPTANCE.
16. ELECTRIC DUCT BANKS SHALL ENTER AND LEAVE MANHOLES AND HANDHOLES AT ZERO PERCENT SLOPE FOR A MINIMUM DISTANCE OF TEN FEET.
17. HECO SHALL FURNISH AND THE STATE'S CONTRACTOR SHALL INSTALL A 1/8 INCH POLYOLEFIN PULL LINE (VETLINE CAT NO. 232) IN ALL DUCTS WHICH EXCEED 140 FEET IN LENGTH BETWEEN PULL POINTS.
18. THE STATE'S CONTRACTOR SHALL REMOVE, CLEAN AND DELIVER TO THE HECO'S WARD AVENUE WAREHOUSE THOSE EXISTING 2X4 HECO PRECAST HANDHOLES, FRAMES AND COVERS WHICH ARE DESIGNATED ON THE PLANS TO BE REMOVED. THE STATE'S CONTRACTOR SHALL CALL THE HECO WAREHOUSE AT LEAST 24 HOURS BEFORE DELIVERY (PHONE 548-3554). THIS WORK SHALL BE INCIDENTAL TO THE ELECTRICAL WORK.

C.C.O. 14
Note No. 18 Deleted

APPROVED
[Signature] 9/3/78
CHIEF, PLANNING AND ENGINEERING, B.W.S. CITY AND COUNTY OF HONOLULU
[Signature] 9/14/78
HAWAIIAN ELECTRIC COMPANY
[Signature] 9/8/78
HAWAIIAN TELEPHONE COMPANY

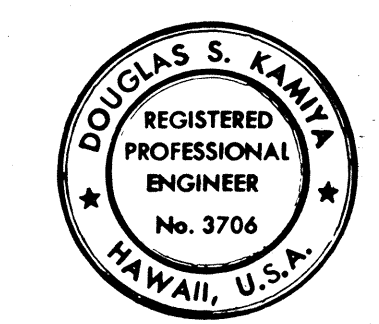


THIS WORK WAS PREPARED BY ME OR UNDER MY SUPERVISION.
[Signature]

STATE OF HAWAII	
DEPARTMENT OF TRANSPORTATION	
LAND TRANSPORTATION FACILITIES DIVISION	
UTILITY NOTES	
KAMEHAMEHA HIGHWAY	
IMPROVEMENT	
(LIKELIKE HIGHWAY TO KOOLAU VIEW DRIVE)	
PROJECT NO. F-083-1(10)	
SCALE	DATE 9/18/78
SHEET No. 1 OF 38 SHEETS	

DATE	_____
SURVEY PLOTTED BY	_____
DESIGNED BY	_____
NOTED BY	_____
QUANTITIES BY	_____
CHECKED BY	_____
ORIGINAL PLAN	_____
NOTE BOOK	_____
No.	_____


FED. ROAD DIST. NO.	STATE	FED. AID PROJ. NO.	FISCAL YEAR	SHEET NO.	TOTAL SHEETS
HAWAII	HAW.	F-083-1(10)	1978	50	160

DATE	10/10/78
SURVEY PLOTTED BY	W. S. K.
DRAWN BY	W. S. K.
CHECKED BY	W. S. K.
NOTE BOOK	
CHECKED BY	

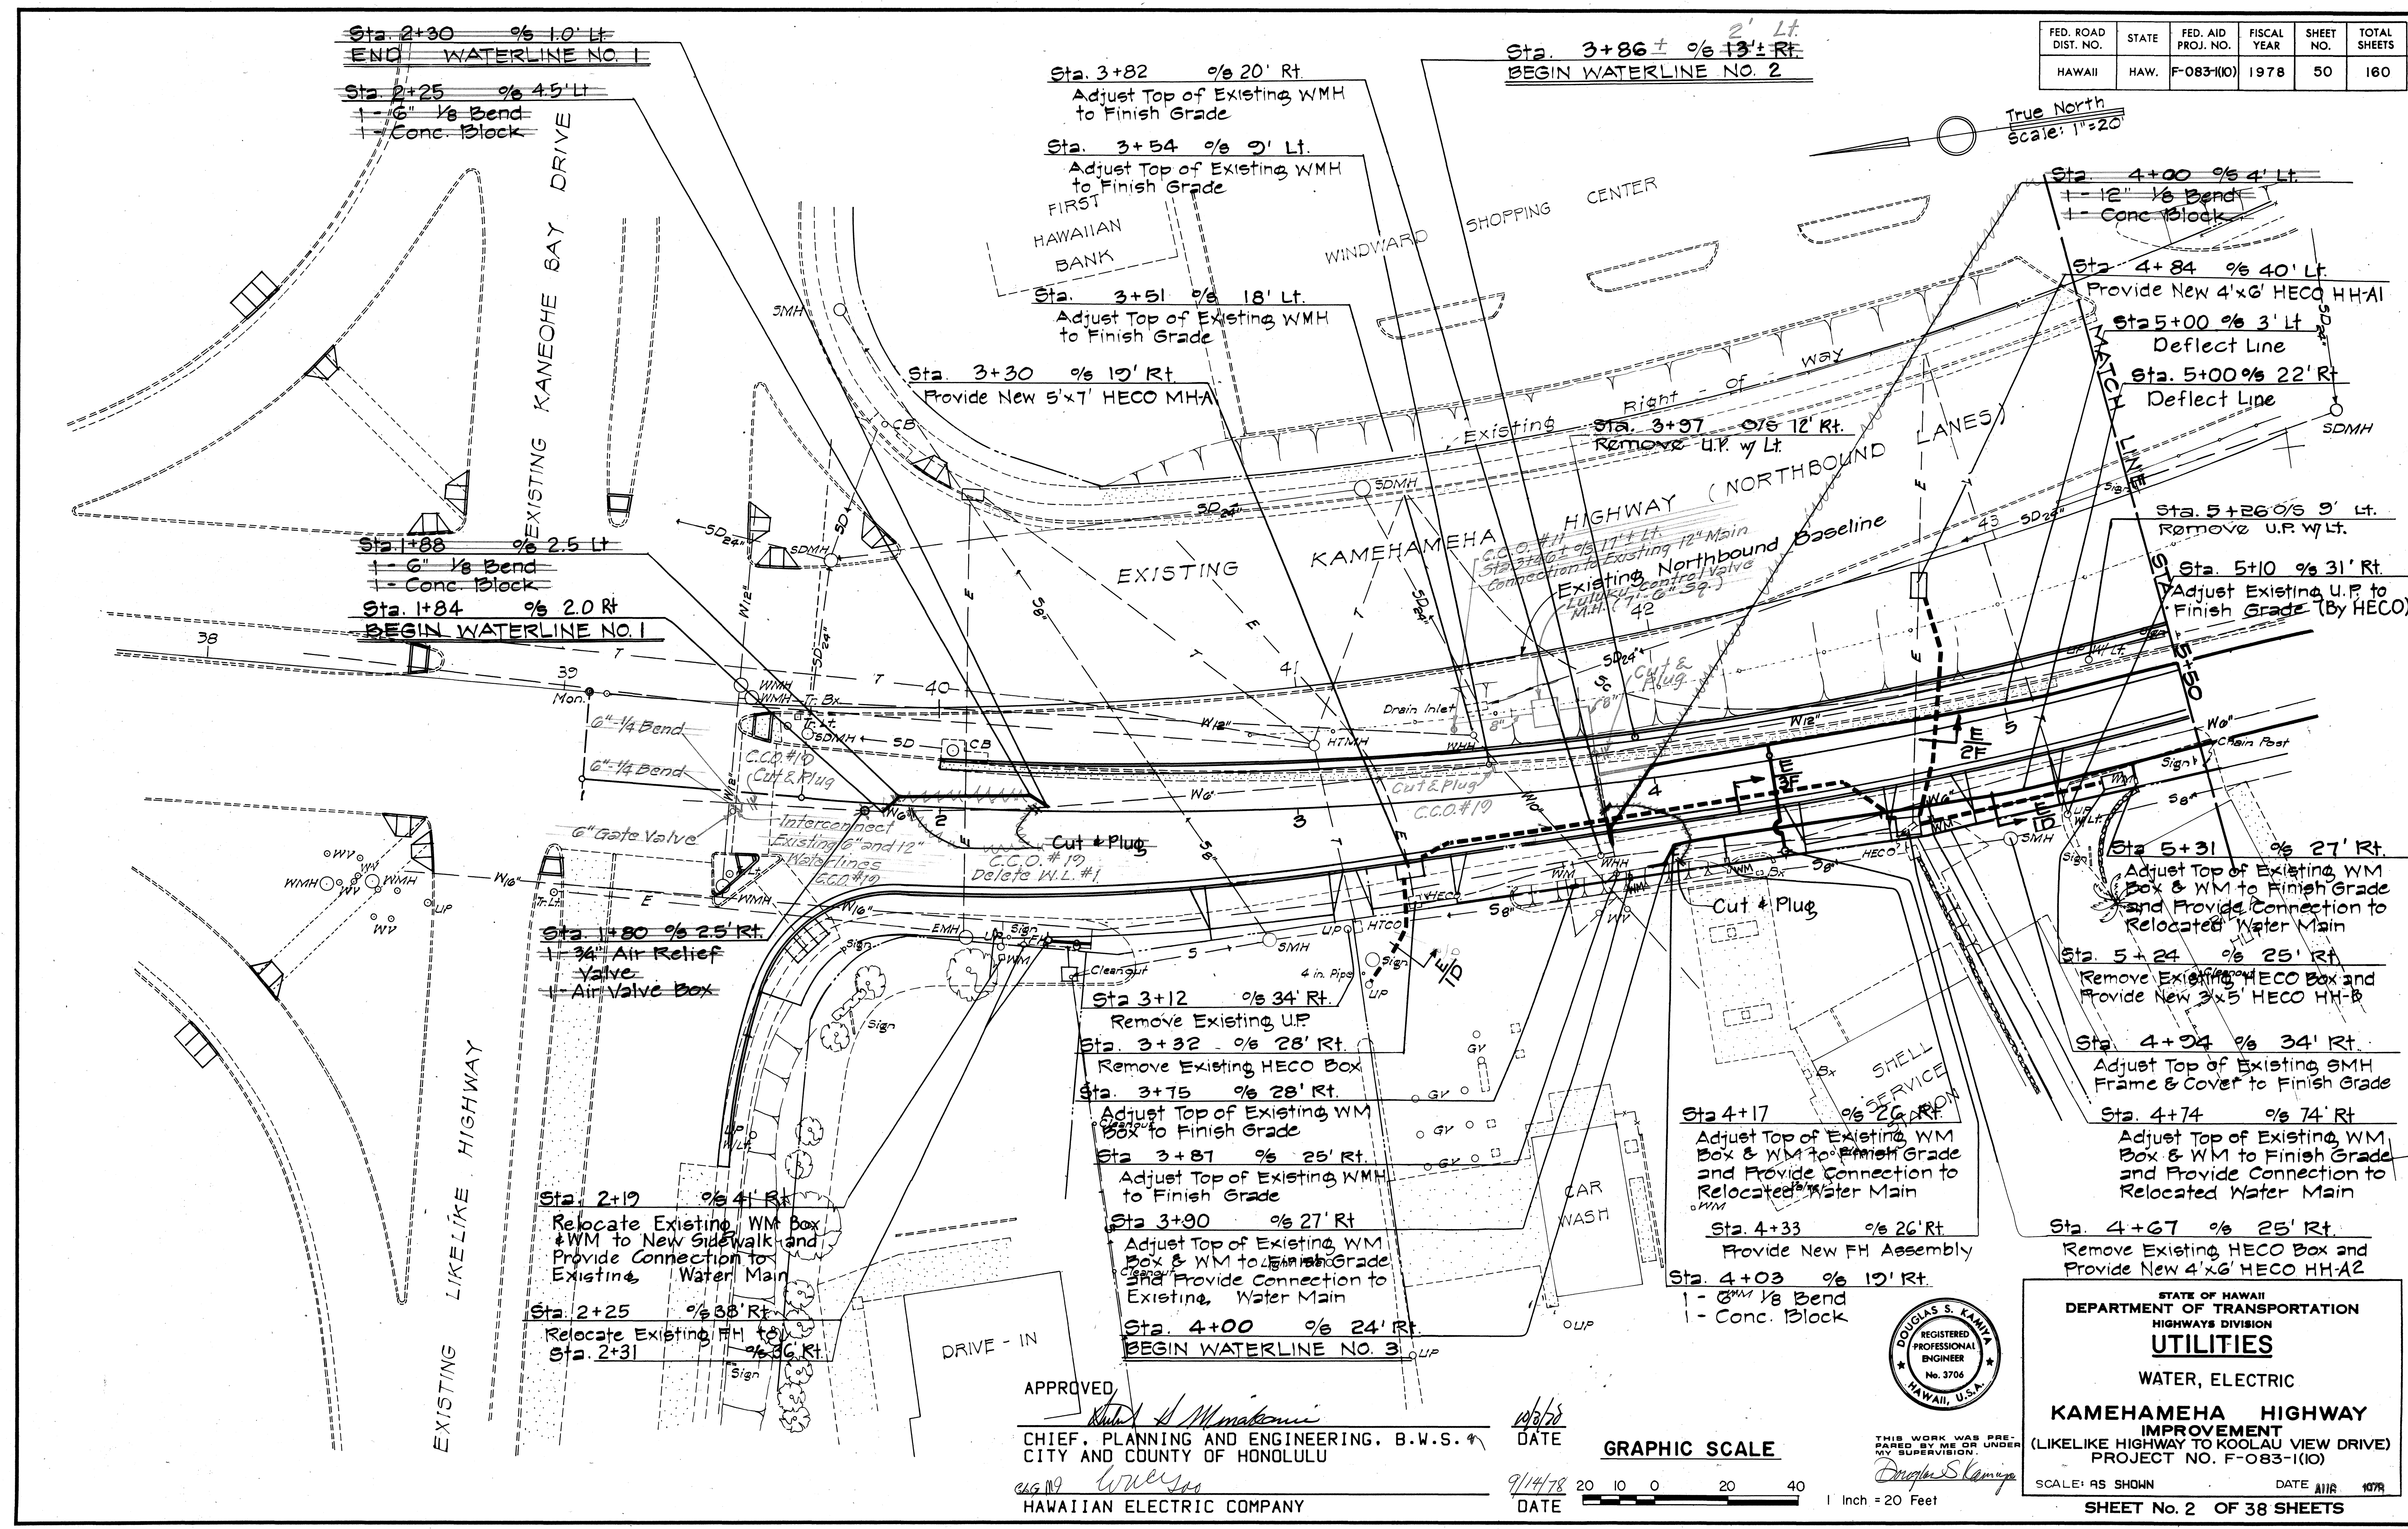


APPROVED
[Signature]
 CHIEF, PLANNING AND ENGINEERING, B.W.S. &
 CITY AND COUNTY OF HONOLULU
 HAWAIIAN ELECTRIC COMPANY

DATE 10/10/78
 DATE 9/14/78
 GRAPHIC SCALE
 20 10 0 20 40
 1 inch = 20 Feet

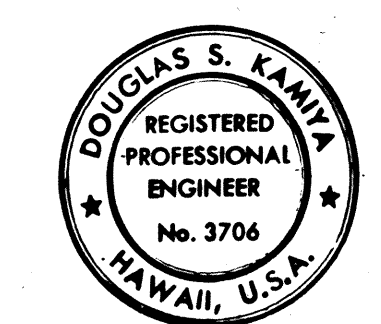

STATE OF HAWAII
 DEPARTMENT OF TRANSPORTATION
 HIGHWAYS DIVISION
UTILITIES
 WATER, ELECTRIC
KAMEHAMEHA HIGHWAY IMPROVEMENT
 (LIKELIKE HIGHWAY TO KOOLAU VIEW DRIVE)
 PROJECT NO. F-083-1(10)
 SCALE: AS SHOWN DATE 10/10/78
 SHEET No. 2 OF 38 SHEETS


FED. ROAD DIST. NO.	STATE	FED. AID PROJ. NO.	FISCAL YEAR	SHEET NO.	TOTAL SHEETS
HAWAII	HAW.	F-083-1(10)	1978	52	160

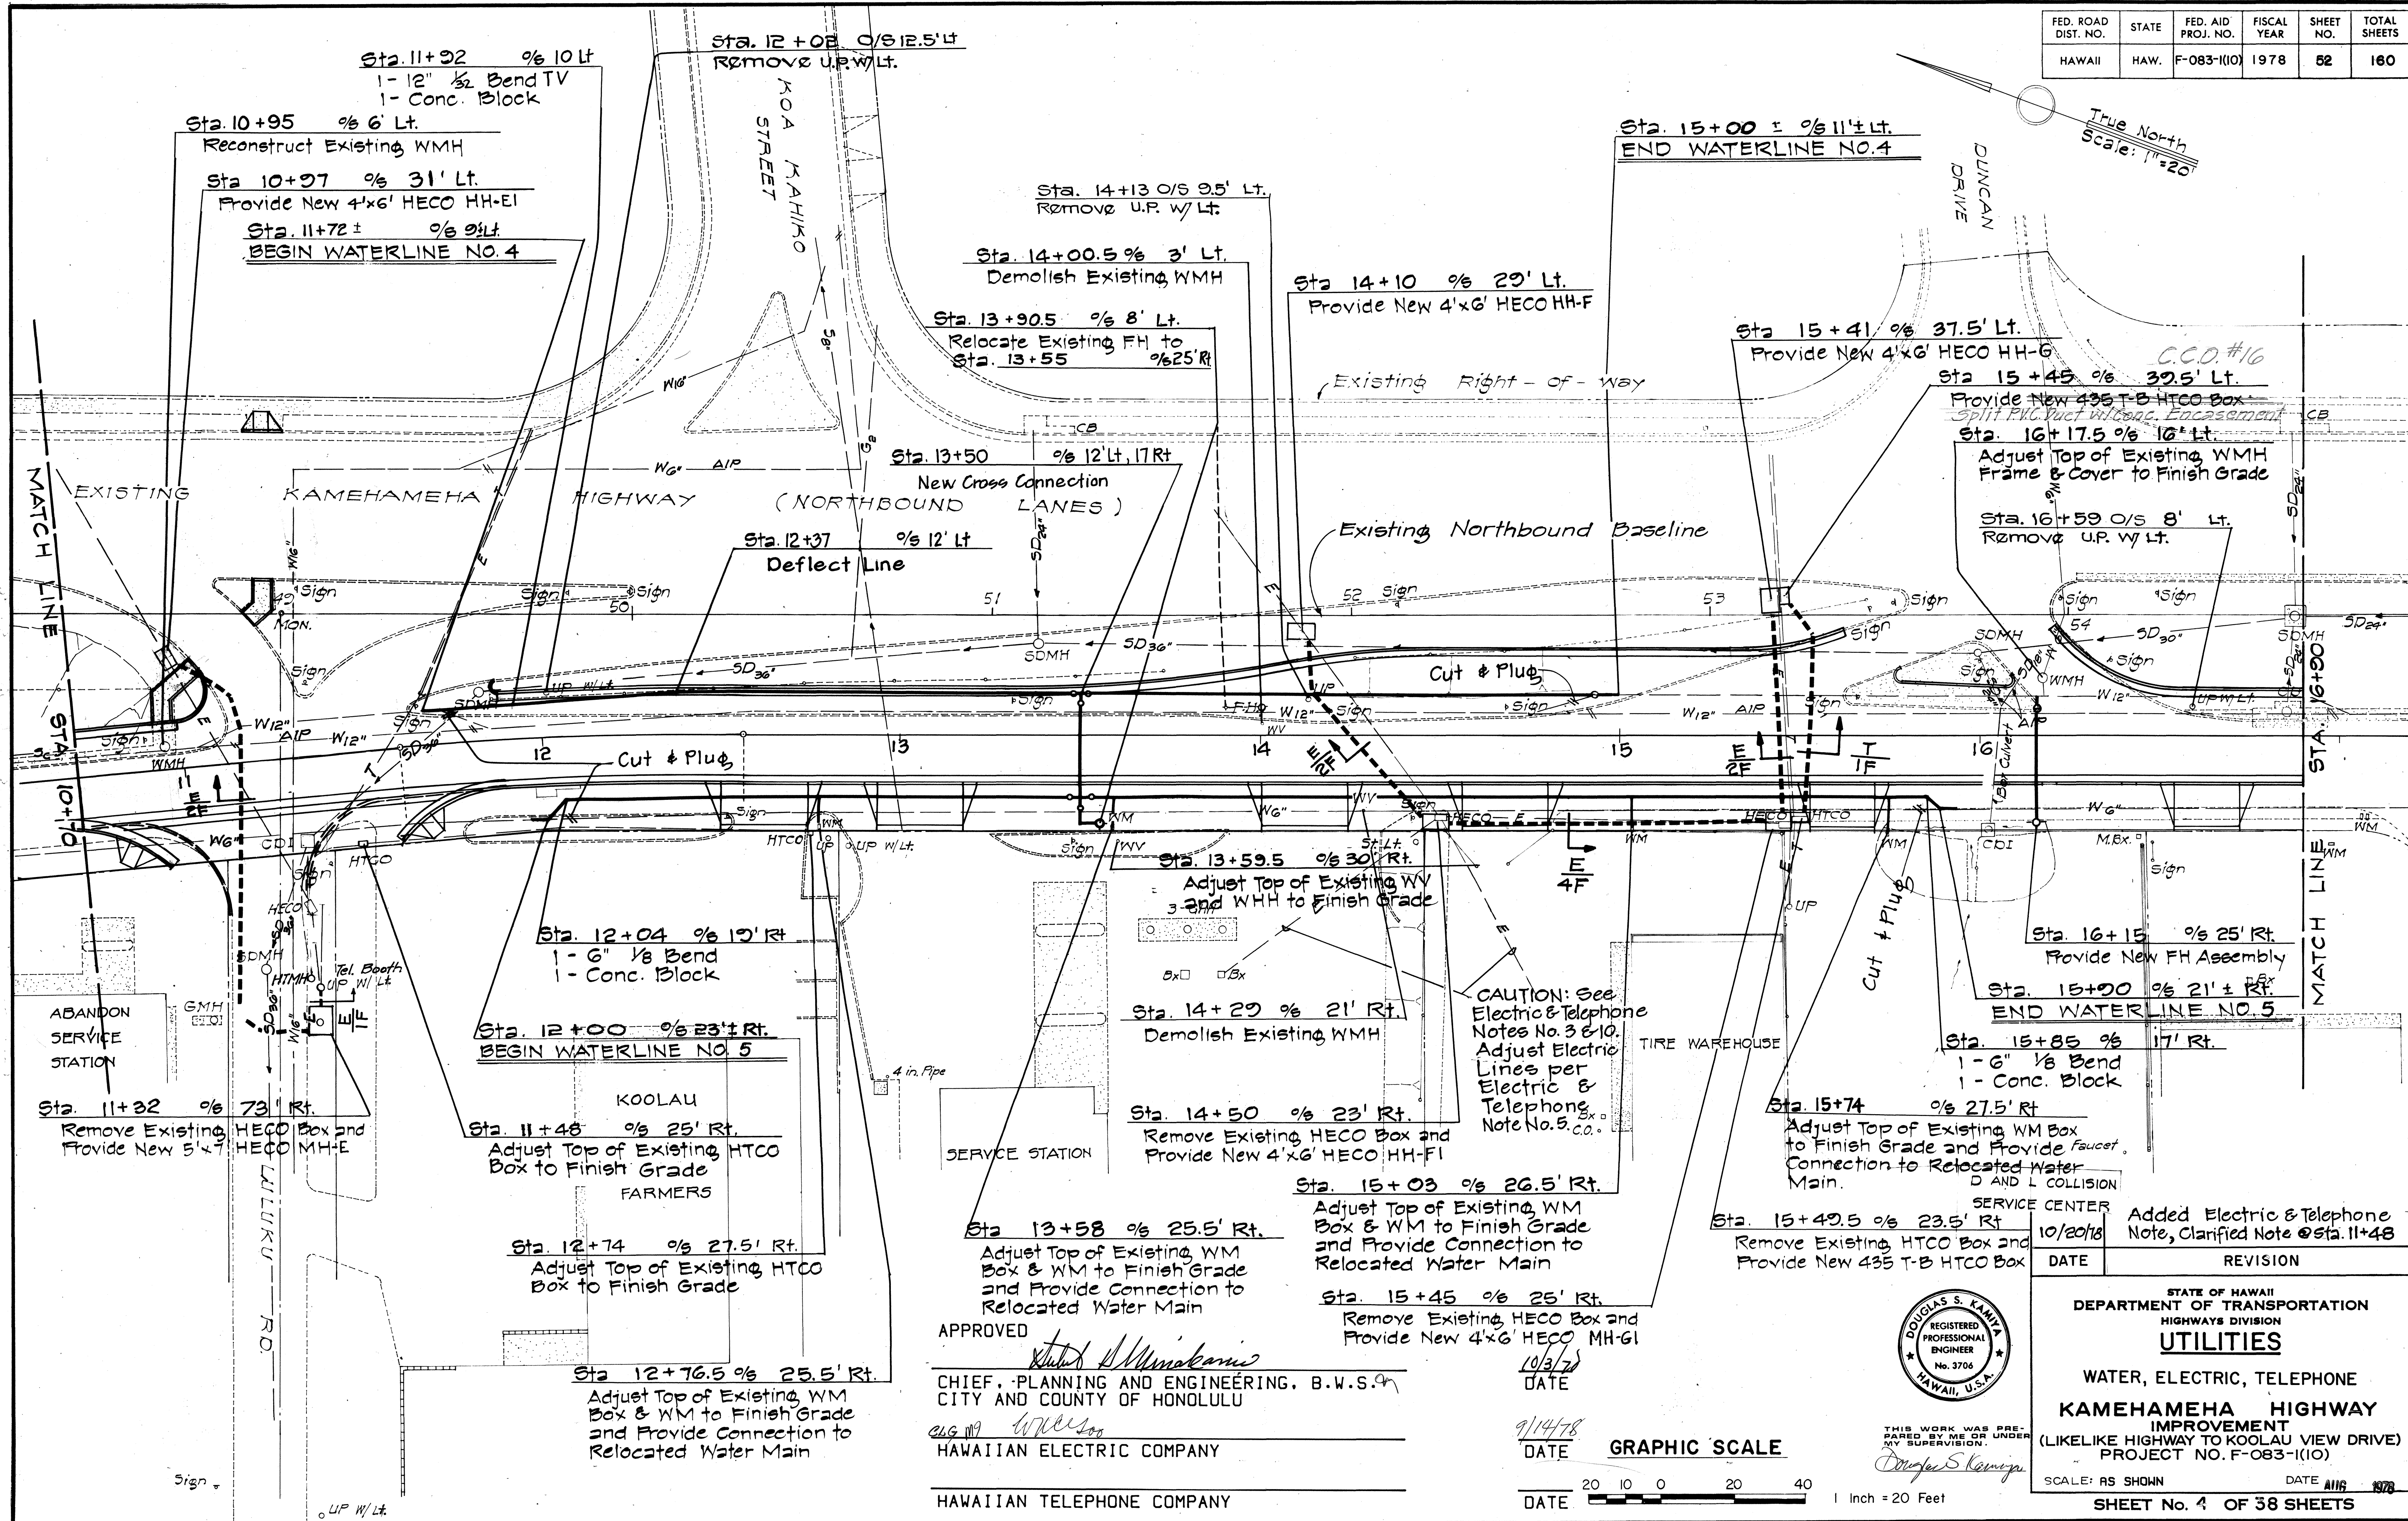

DATE	
SURVEY PLOTTED BY	
DRAWN BY	
DESIGNED BY	
QUANTITIES BY	
CHECKED BY	
ORIGINAL PLAN	
NOTE BOOK	

APPROVED
[Signature]
 CHIEF, PLANNING AND ENGINEERING, B.W.S.
 CITY AND COUNTY OF HONOLULU
 HAWAIIAN ELECTRIC COMPANY
 HAWAIIAN TELEPHONE COMPANY

DATE 9/14/78
 DATE 10/3/78
 DATE 10/20/78
 GRAPHIC SCALE
 20 10 0 20 40
 1 Inch = 20 Feet

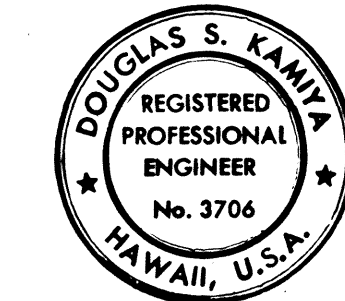

DATE	10/20/78
REVISION	Added Electric & Telephone Note, Clarified Note @ Sta. 11+48
STATE OF HAWAII DEPARTMENT OF TRANSPORTATION HIGHWAYS DIVISION UTILITIES WATER, ELECTRIC, TELEPHONE KAMEHAMEHA HIGHWAY IMPROVEMENT (LIKELIKE HIGHWAY TO KOOLAU VIEW DRIVE) PROJECT NO. F-083-1(10) SCALE: AS SHOWN SHEET No. 4 OF 38 SHEETS	

ADD. 52R

Sta. 19+00 % 7' Lt.
BEGIN WATERLINE NO. 6

Sta. 19+04 % 3' Lt.
1- 12" 1/8 Bend
1- Conc. Block

Sta. 20+48 % 17' Rt.
1- 6" 1/8 Bend
1- Conc. Block

Sta. 21+60 % 5' Lt.
BEGIN WATERLINE NO. 6-A

Sta. 21+50 % 32' Lt.
END WATERLINE NO. 6-A

FED. ROAD DIST. NO.	STATE	FED. AID PROJ. NO.	FISCAL YEAR	SHEET NO.	TOTAL SHEETS
HAWAII	HAW.	F-083-100	1978	53	160

Sta. 22+65 % 30' Lt.
Provide New 435 T-B HECO Box

Split PVC Duct w/ Conc. Encasement

True North
Scale: 1" = 20'

Sta. 22+46 % 16' Rt.
BEGIN WATERLINE NO. 7B

Sta. 18+91 % 26' Rt.
Relocate Existing FH to Sta. 18+06 % 24' Rt.

Sta. 18+86 O/S 9' Lt.
Remove U.P. w/ Lt.

Sta. 20+65 % 10' Rt.
1- 6" 1/8 Bend
1- Conc. Block

Sta. 21+53 % 8' Lt.
Demolish Existing WMH

Sta. 21+50 % 12.5' Lt.
Demolish Existing WMH

EXISTING KAMEHAMEHA HIGHWAY (NORTHBOUND LANES)
Sta. 21+47.5 % 7' Lt.
Demolish Existing WMH

Sta. 21+45 % 10' Rt.
1- 6" 1/8 Bend
1- Conc. Block

Sta. 21+62 % 17' Rt.
1- 6" 1/8 Bend
1- Conc. Block

Sta. 21+91 % 23.5' Rt.
Remove Existing U.P. w/ Light

Sta. 20+85 % 10' Lt.
Remove Existing U.P.

Sta. 20+32 % 25' Rt.
Remove Existing HECO Box and Provide New 2'x4' HECO HH-SB2/PH

Sta. 20+70 % 25' Rt.
Remove Existing HECO Box and Provide New 2'x4' HECO HH-SB1/PH

YAMASHIRO BUILDING SUPPLY

Sta. 20+92 % 21' Rt.
Demolish Existing WMH

Sta. 20+84 % 58' Rt.
Remove Existing HECO Box and Provide New 435 T-B HECO Box

Sta. 20+84 % 64' Rt.
Adjust Existing U.P. to Finish Grade (By HECO)

Sta. 20+96.5 % 18' Rt.
Demolish Existing WMH

Sta. 20+92 % 79' ± Rt.
END WATERLINE NO. 7A

Sta. 20+98 % 74' Rt.
1- 8" 1/8 Bend
1- Conc. Block

Sta. 21+41 % 30' Rt.
Relocate Existing WMH Box & WM to New Sidewalk and Provide Connection to Relocated Water Main

Sta. 21+89 % 23.5' Rt.
Adjust Top of Existing WMH Box & WM to Finish Grade and Provide Connection to Relocated Water Main

Sta. 22+20 % 24' Rt.
Provide New FH Assembly

Sta. 20+98 % 10' Lt.
BEGIN WATERLINE NO. 7A

Sta. 22+43 % 23' Rt.
Demolish Existing WMH

Sta. 22+42 % 75' ± Rt.
END WATERLINE NO. 7B

Sta. 22+46 % 71' Rt.
1- 6" 1/8 Bend
1- Conc. Block

Sta. 22+67 % 44' Rt.
Remove Existing HECO Box and Provide New 435 T-B HECO Box

Sta. 18+97 % 20' Rt.
Adjust Top of Existing WMH to Finish Grade

Sta. 19+00 % 19' ± Rt.
BEGIN WATERLINE NO. 7

LARRY HO'S SERVICE STATION
Sta. 19+02 % 17' Rt.
1- 6" 1/8 Bend
1- Conc. Block

Sta. 20+20 % 24.5' Rt.
Adjust Top of Existing WMH Box & WM to Finish Grade and Provide Connection to Relocated Water Main

Sta. 17+07 ± % 23' ± Rt.
Adjust Top of Existing WMH Box to Finish Grade (8 WMH)

Sta. 17+46 % 25.5' Rt.
Adjust Top of Existing WMH to Finish Grade

Sta. 17+58.5 % 24.5' Rt.
Adjust Top of Existing WMH Box to Finish Grade

Sta. 17+77.5 % 24' Rt.
Adjust Top of Existing WMH Box to Finish Grade

Sta. 18+77 % 26' Rt.
Adjust Top of Existing WMH Box & WM to Finish Grade (Double Service Lateral)

Sta. 18+83 % 25' Rt.
Adjust Top of Existing WMH Box & WM to Finish Grade (Double Service Lateral)

Sta. 18+85.5 % 25' Rt.
Adjust Top of Existing HECO Box to Finish Grade

APPROVED


CHIEF, PLANNING AND ENGINEERING, B.W.S. & CITY AND COUNTY OF HONOLULU

HAWAIIAN ELECTRIC COMPANY

HAWAIIAN TELEPHONE COMPANY

GRAPHIC SCALE


20 10 0 20 40
1 Inch = 20 Feet

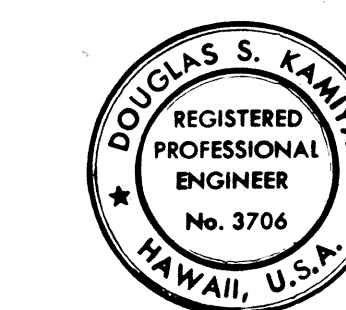

THIS WORK WAS PREPARED BY ME OR UNDER MY SUPERVISION.

STATE OF HAWAII
DEPARTMENT OF TRANSPORTATION
HIGHWAYS DIVISION
UTILITIES
WATER, ELECTRIC, TELEPHONE
KAMEHAMEHA HIGHWAY IMPROVEMENT
(LIKELIKE HIGHWAY TO KOOLAU VIEW DRIVE)
PROJECT NO. F-083-1(10)
SCALE: AS SHOWN
DATE AUG 1978
SHEET No. 5 OF 38 SHEETS

FED. ROAD DIST. NO.	STATE	FED. AID PROJ. NO.	FISCAL YEAR	SHEET NO.	TOTAL SHEETS
HAWAII	HAW.	F-083-1(10)	1978	54	160

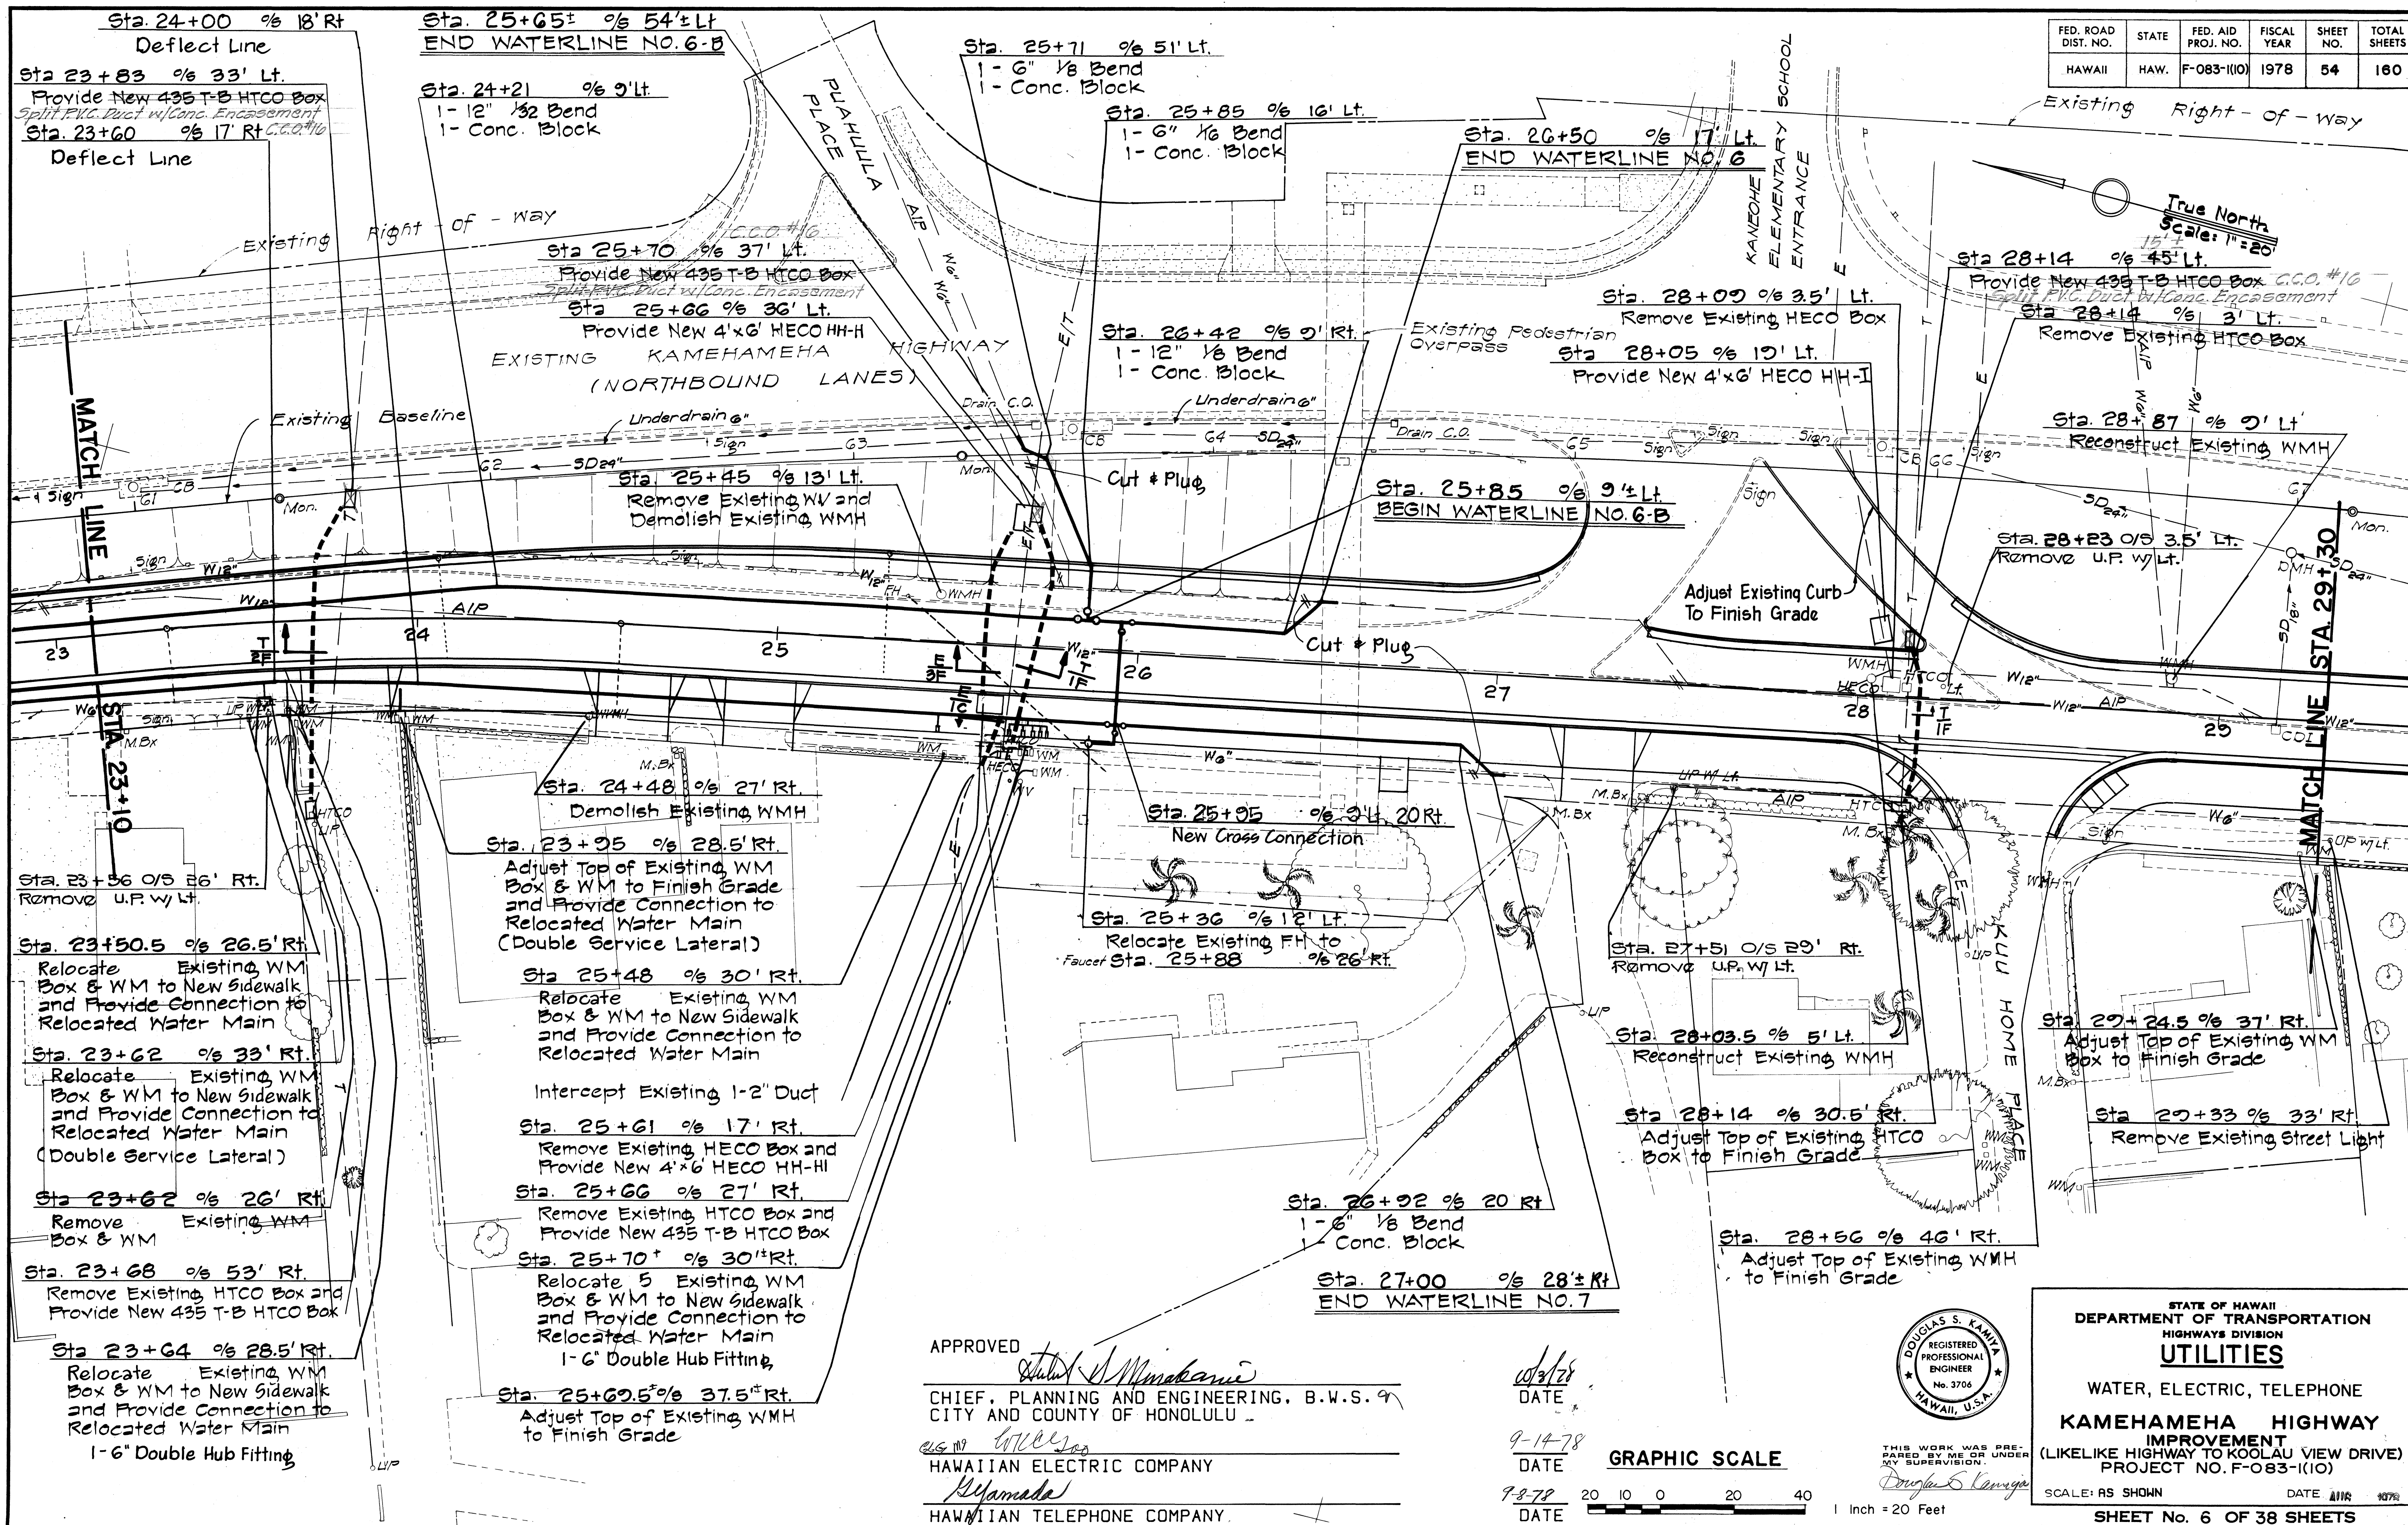

DATE	
SURVEY PLOTTED BY	
DRAWN BY	
DESIGNED BY	
QUANTITIES BY	
CHECKED BY	
ORIGINAL PLAN	
NOTE BOOK	
NO.	


APPROVED *[Signature]*
 CHIEF, PLANNING AND ENGINEERING, B.W.S. &
 CITY AND COUNTY OF HONOLULU
[Signature]
 HAWAIIAN ELECTRIC COMPANY
[Signature]
 HAWAIIAN TELEPHONE COMPANY

[Signature]
 DATE 9-14-78
 DATE 9-8-78
 DATE

GRAPHIC SCALE



1 Inch = 20 Feet

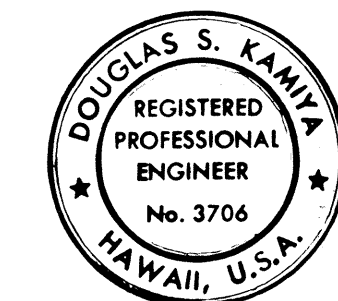


THIS WORK WAS PREPARED BY ME OR UNDER MY SUPERVISION.

[Signature]

STATE OF HAWAII
 DEPARTMENT OF TRANSPORTATION
 HIGHWAYS DIVISION
UTILITIES
 WATER, ELECTRIC, TELEPHONE
KAMEHAMEHA HIGHWAY IMPROVEMENT
 (LIKELIKE HIGHWAY TO KOOLAU VIEW DRIVE)
 PROJECT NO. F-083-1(10)
 SCALE: AS SHOWN
 DATE: 11/18/78
 SHEET No. 6 OF 38 SHEETS

FED. ROAD DIST. NO.	STATE	FED. AID PROJ. NO.	FISCAL YEAR	SHEET NO.	TOTAL SHEETS
HAWAII	HAW.	F-083-1(10)	1978	55	160

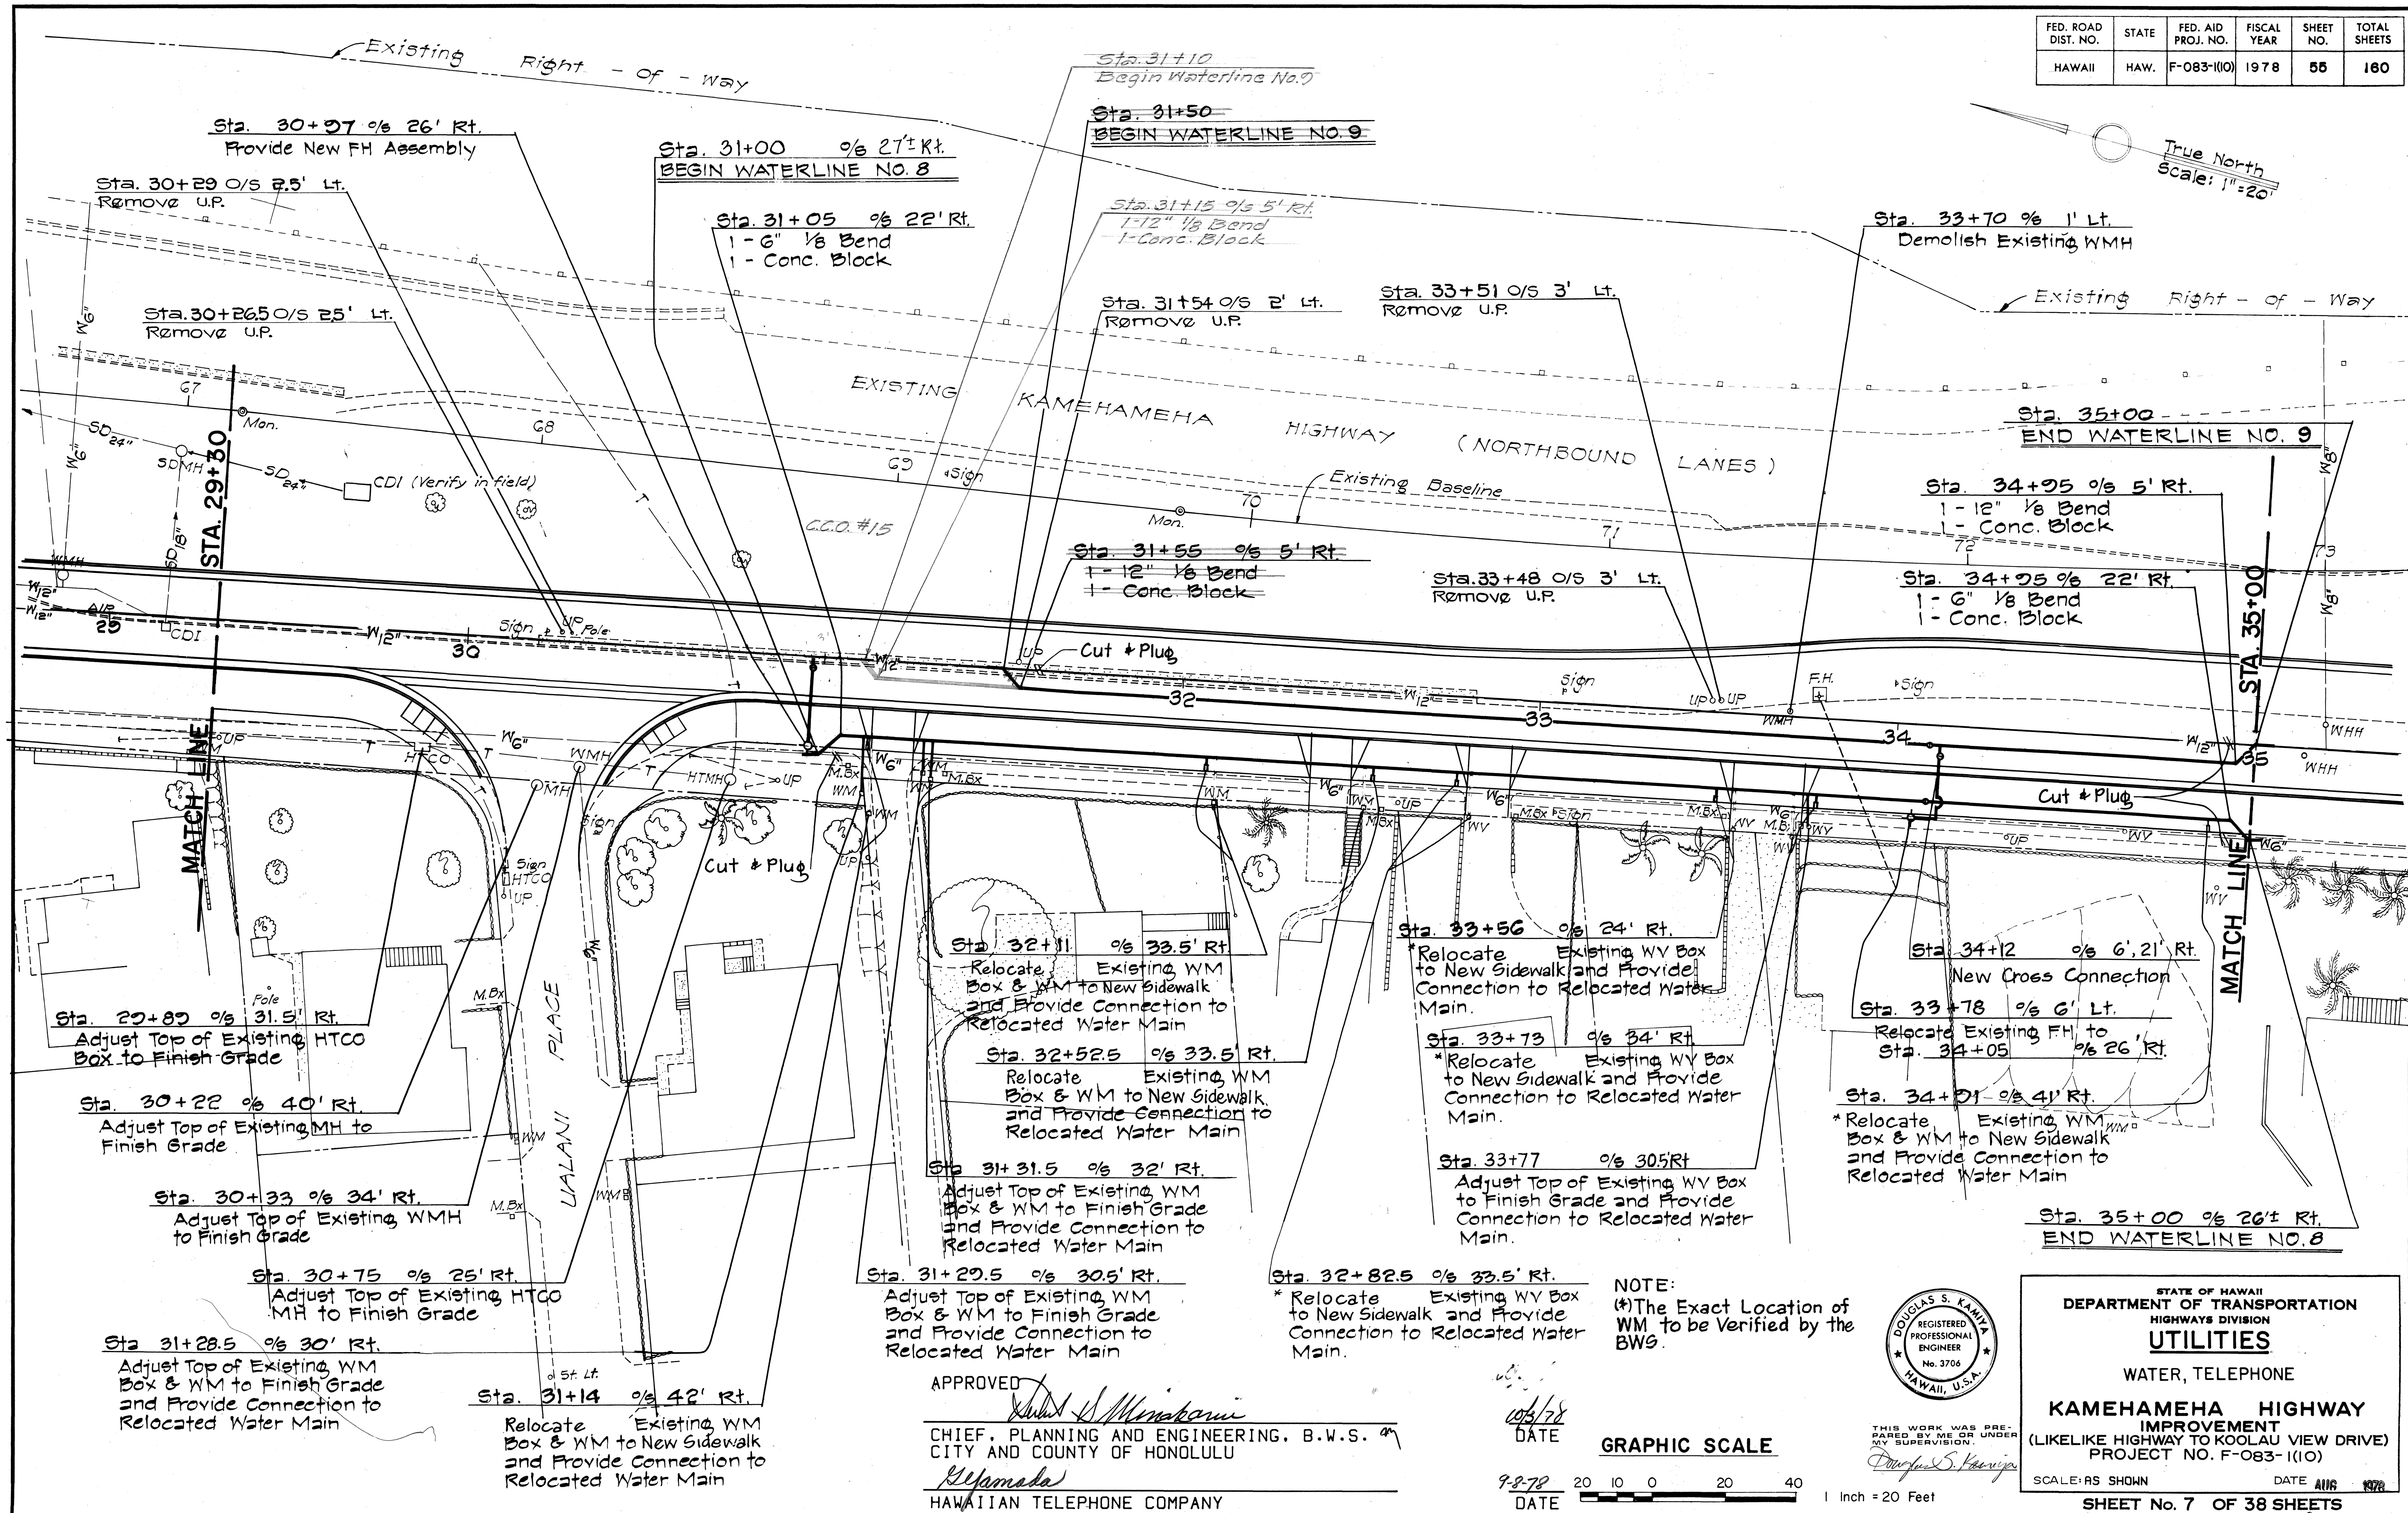


DATE	
DESIGNED BY	
CHECKED BY	
NOTED BY	
ORIGINAL PLAN	
NOTE BOOK	

APPROVED *[Signature]*
 CHIEF, PLANNING AND ENGINEERING, B.W.S.
 CITY AND COUNTY OF HONOLULU
[Signature]
 HAWAIIAN TELEPHONE COMPANY

DATE 10/28/78
 DATE 9-8-78

GRAPHIC SCALE


1 Inch = 20 Feet

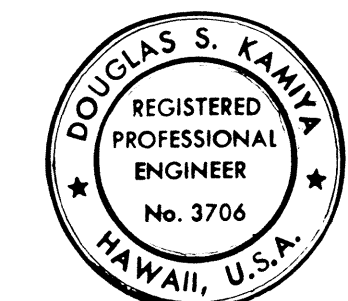

THIS WORK WAS PREPARED BY ME OR UNDER MY SUPERVISION.
[Signature]

STATE OF HAWAII
 DEPARTMENT OF TRANSPORTATION
 HIGHWAYS DIVISION
UTILITIES
 WATER, TELEPHONE
KAMEHAMEHA HIGHWAY IMPROVEMENT
 (LIKELIKE HIGHWAY TO KOOLAU VIEW DRIVE)
 PROJECT NO. F-083-1(10)
 SCALE: AS SHOWN DATE AUG 1978
SHEET No. 7 OF 38 SHEETS

FED. ROAD DIST. NO.	STATE	FED. AID PROJ. NO.	FISCAL YEAR	SHEET NO.	TOTAL SHEETS
HAWAII	HAW.	F-083-1(10)	1978	56	160

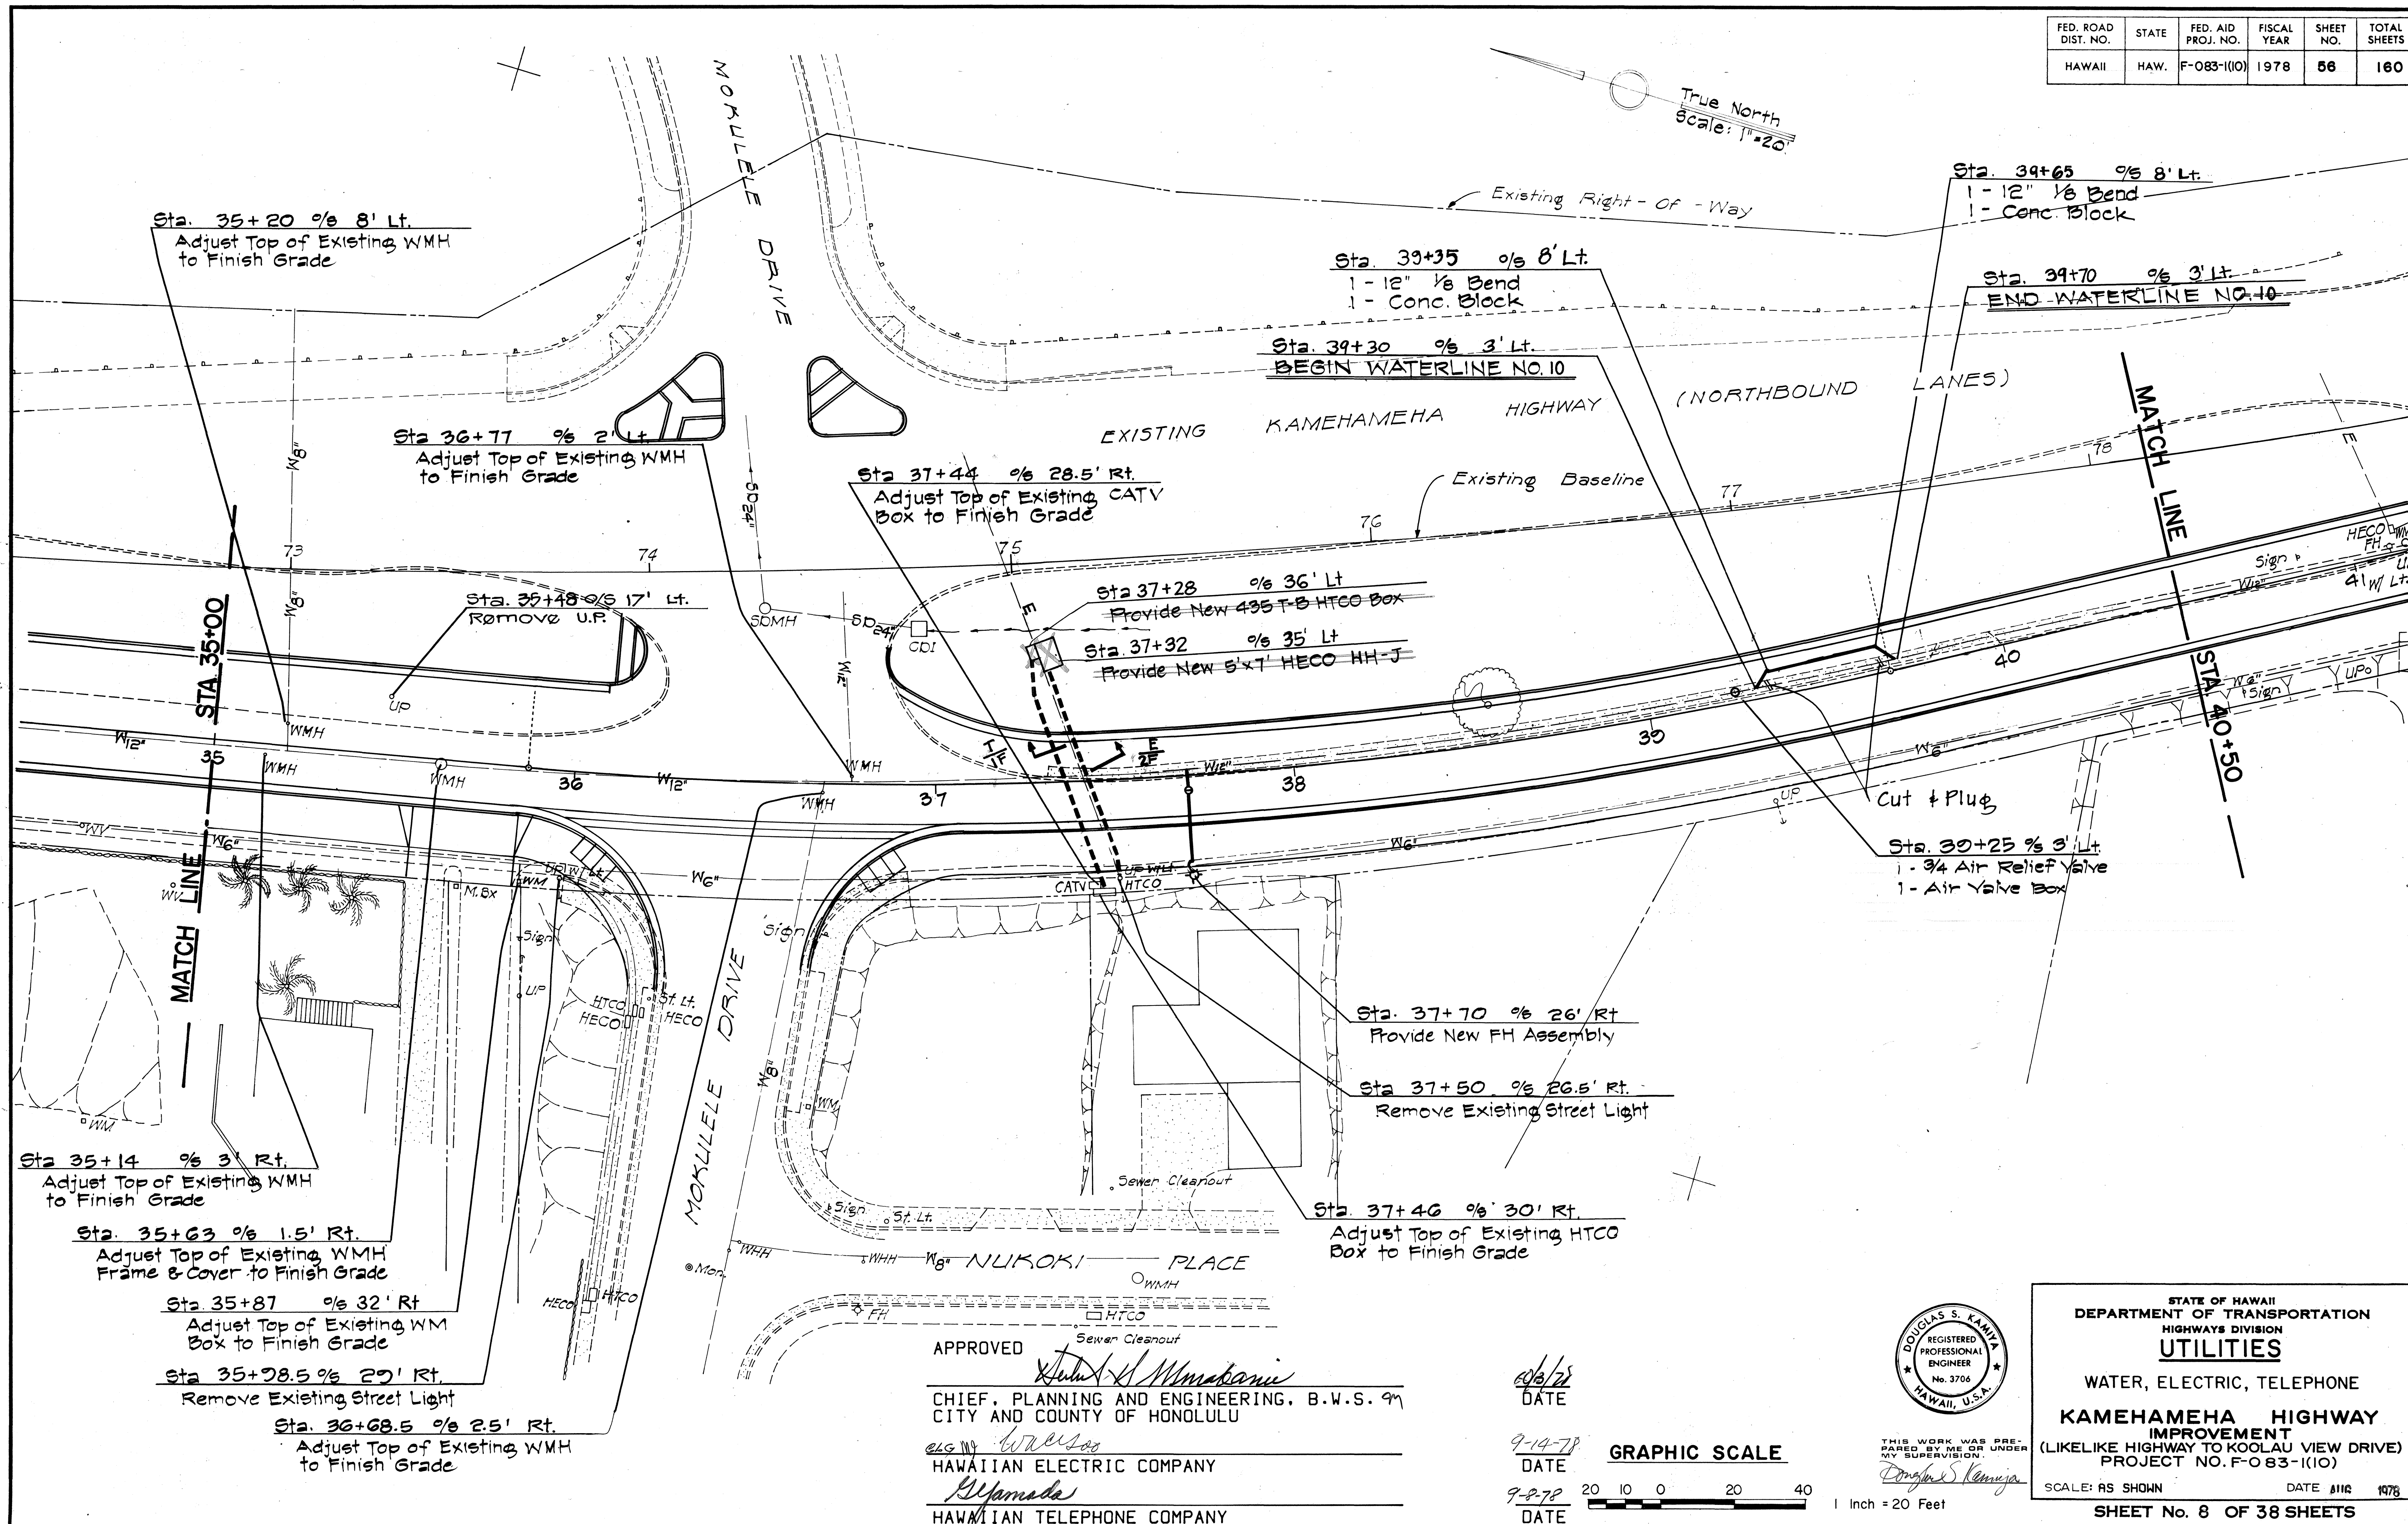

DATE	
SURVEY PLOTTED BY	
DRAWN BY	
TRACED BY	
QUANTITIES BY	
NOTES BY	
CHECKED BY	


APPROVED
[Signature]
 CHIEF, PLANNING AND ENGINEERING, B.W.S. 99
 CITY AND COUNTY OF HONOLULU
 HAWAIIAN ELECTRIC COMPANY
 HAWAIIAN TELEPHONE COMPANY

9/14/78
 DATE
 9-8-78
 DATE

GRAPHIC SCALE



1 Inch = 20 Feet

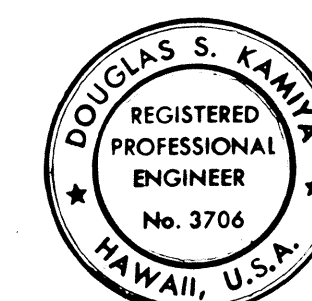


THIS WORK WAS PREPARED BY ME OR UNDER MY SUPERVISION.
[Signature]

STATE OF HAWAII
 DEPARTMENT OF TRANSPORTATION
 HIGHWAYS DIVISION
UTILITIES
 WATER, ELECTRIC, TELEPHONE
KAMEHAMEHA HIGHWAY IMPROVEMENT
 (LIKELIKE HIGHWAY TO KOOLAU VIEW DRIVE)
 PROJECT NO. F-083-1(10)
 SCALE: AS SHOWN
 DATE: 11/16/1978
 SHEET No. 8 OF 38 SHEETS

FED. ROAD DIST. NO.	STATE	FED. AID PROJ. NO.	FISCAL YEAR	SHEET NO.	TOTAL SHEETS
HAWAII	HAW.	F-083-1(10)	1978	57	160


True North
Scale: 1"=20'

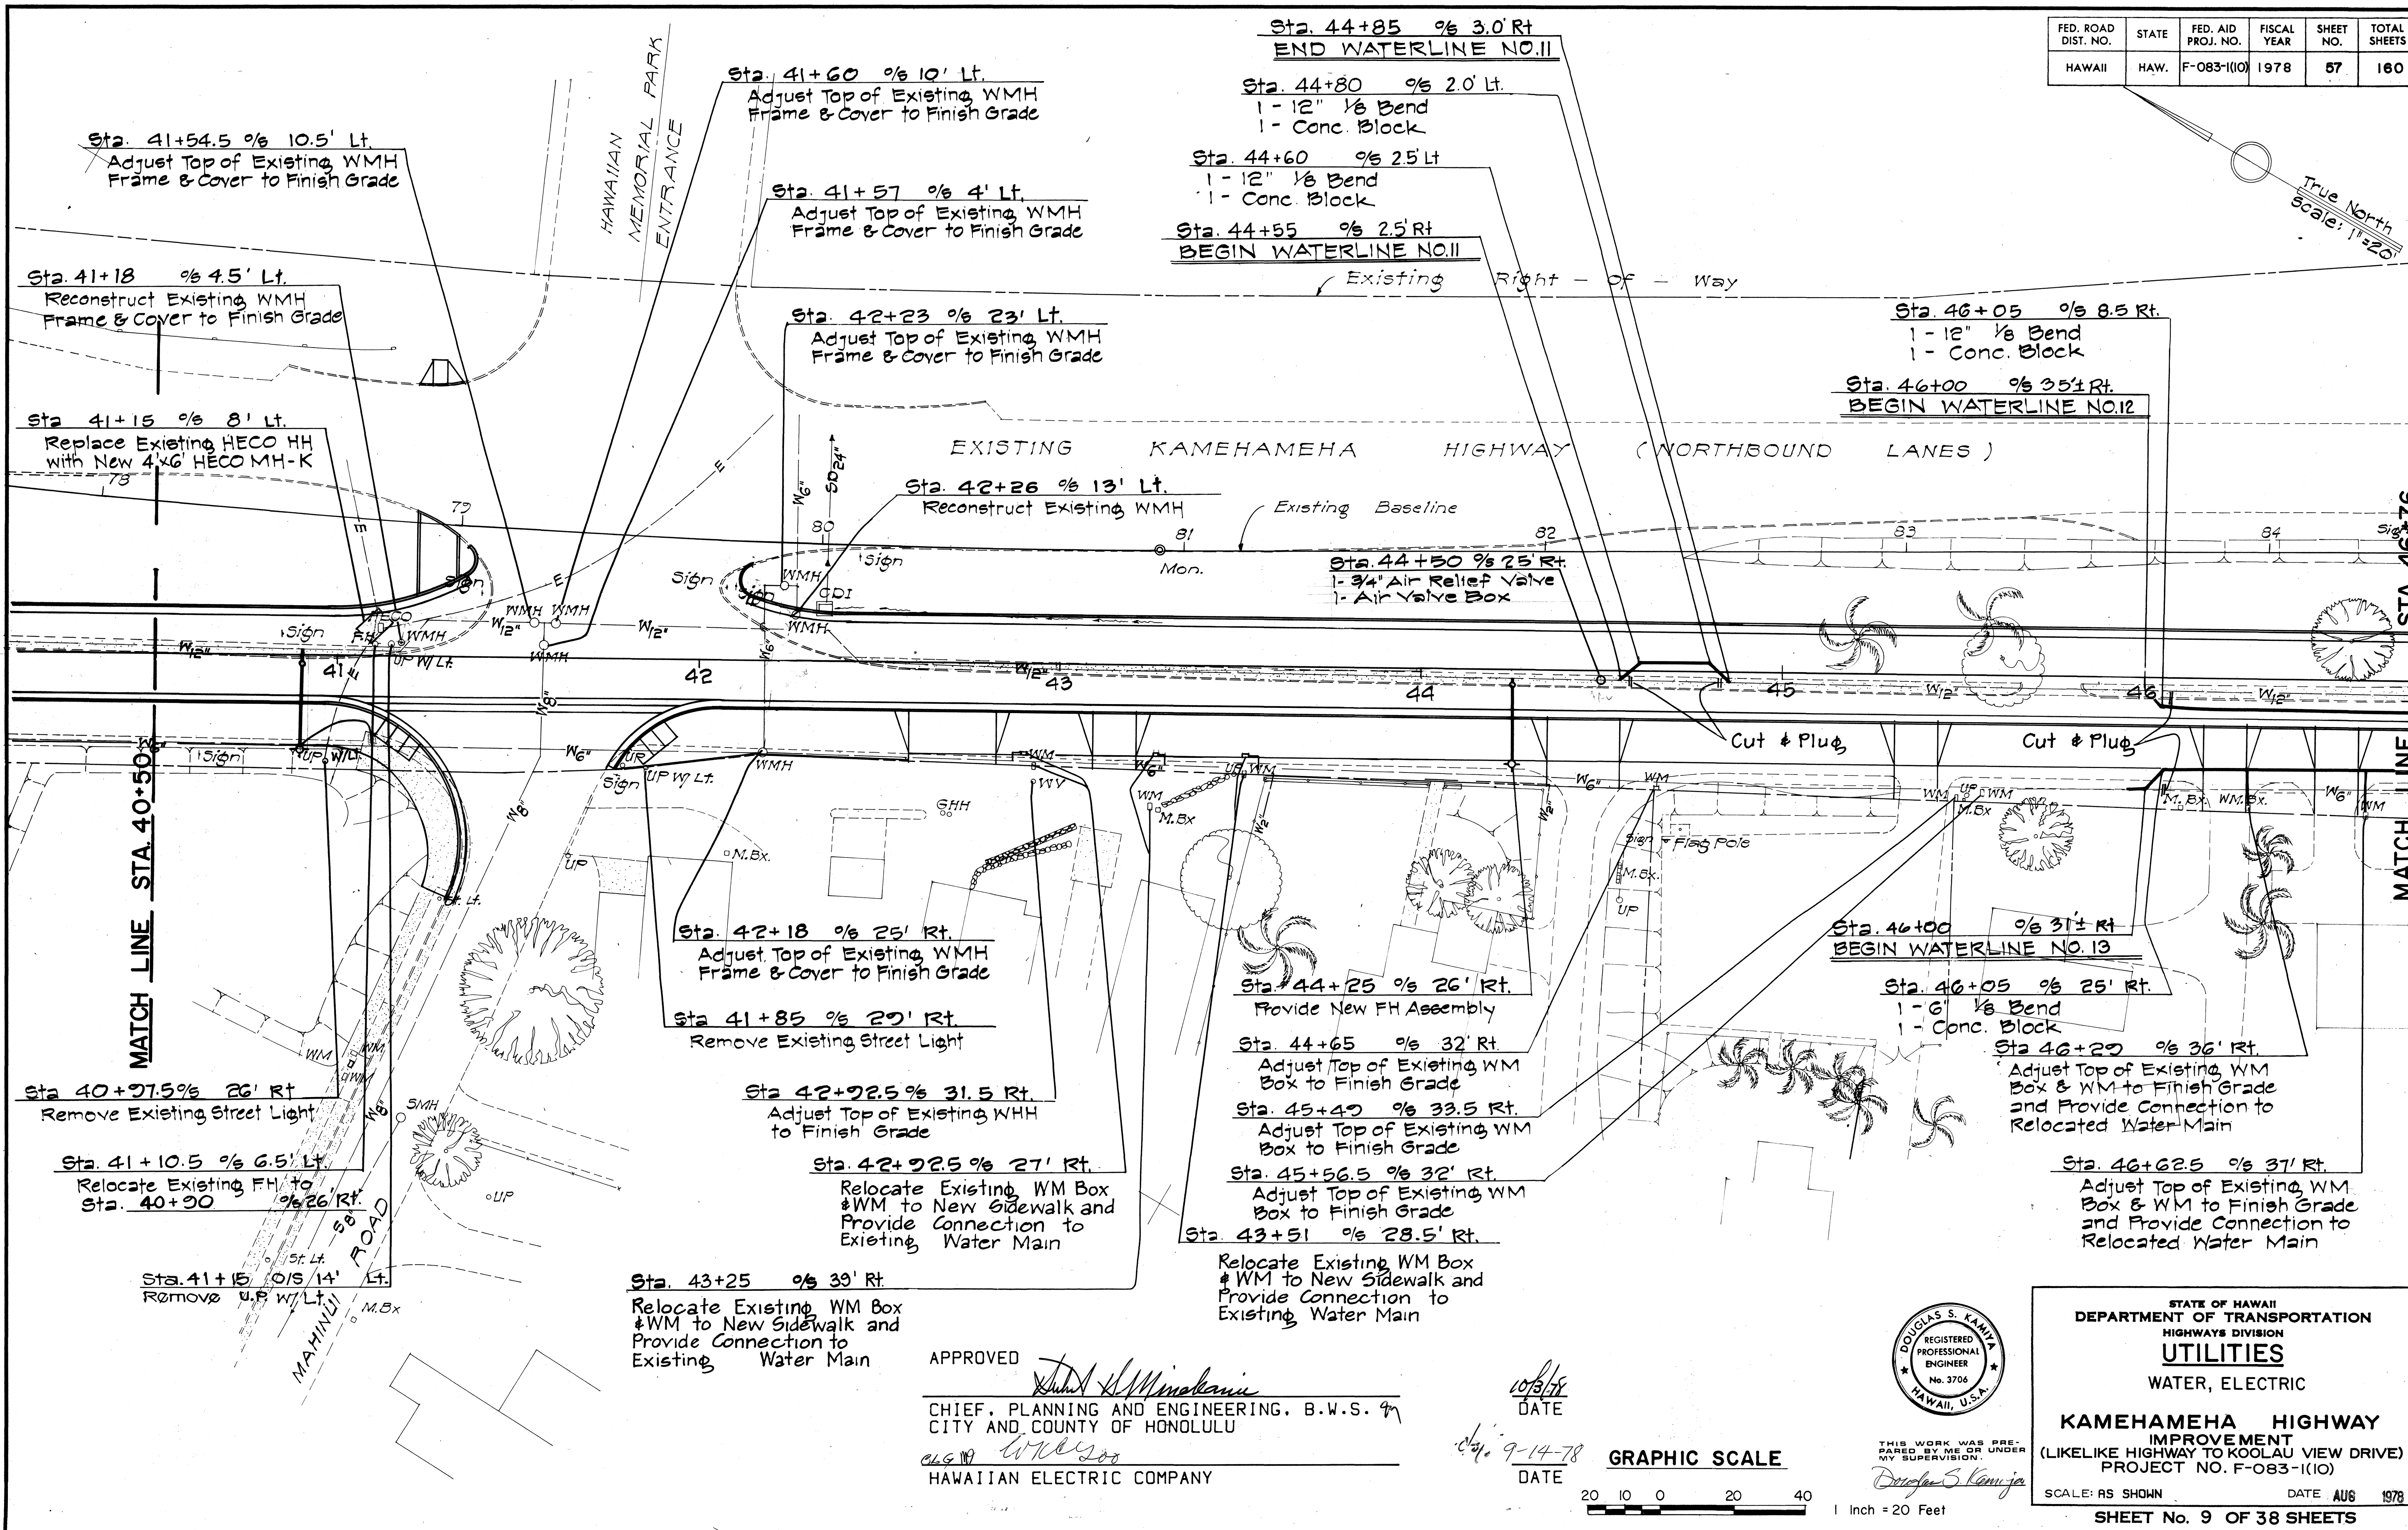

SURVEY PLOTTED BY	DATE
DRAWN BY	DATE
DESIGNED BY	DATE
CHECKED BY	DATE
NOTE BOOK	
NO.	

APPROVED
[Signature]
CHIEF, PLANNING AND ENGINEERING, B.W.S. &
CITY AND COUNTY OF HONOLULU
HAWAIIAN ELECTRIC COMPANY


10/3/78
DATE
9-14-78
DATE

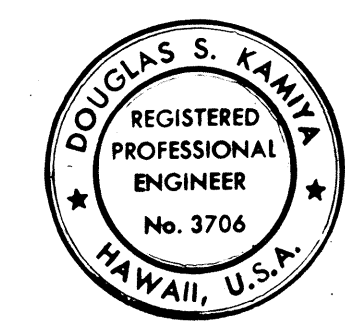

STATE OF HAWAII
DEPARTMENT OF TRANSPORTATION
HIGHWAYS DIVISION
UTILITIES
WATER, ELECTRIC
KAMEHAMEHA HIGHWAY
IMPROVEMENT
(LIKELIKE HIGHWAY TO KOOLAU VIEW DRIVE)
PROJECT NO. F-083-1(10)
SCALE: AS SHOWN
DATE AUG 1978
SHEET No. 9 OF 38 SHEETS

FED. ROAD DIST. NO.	STATE	FED. AID PROJ. NO.	FISCAL YEAR	SHEET NO.	TOTAL SHEETS
HAWAII	HAW.	F-083-1(10)	1978	58	160

True North
Scale: 1" = 20'

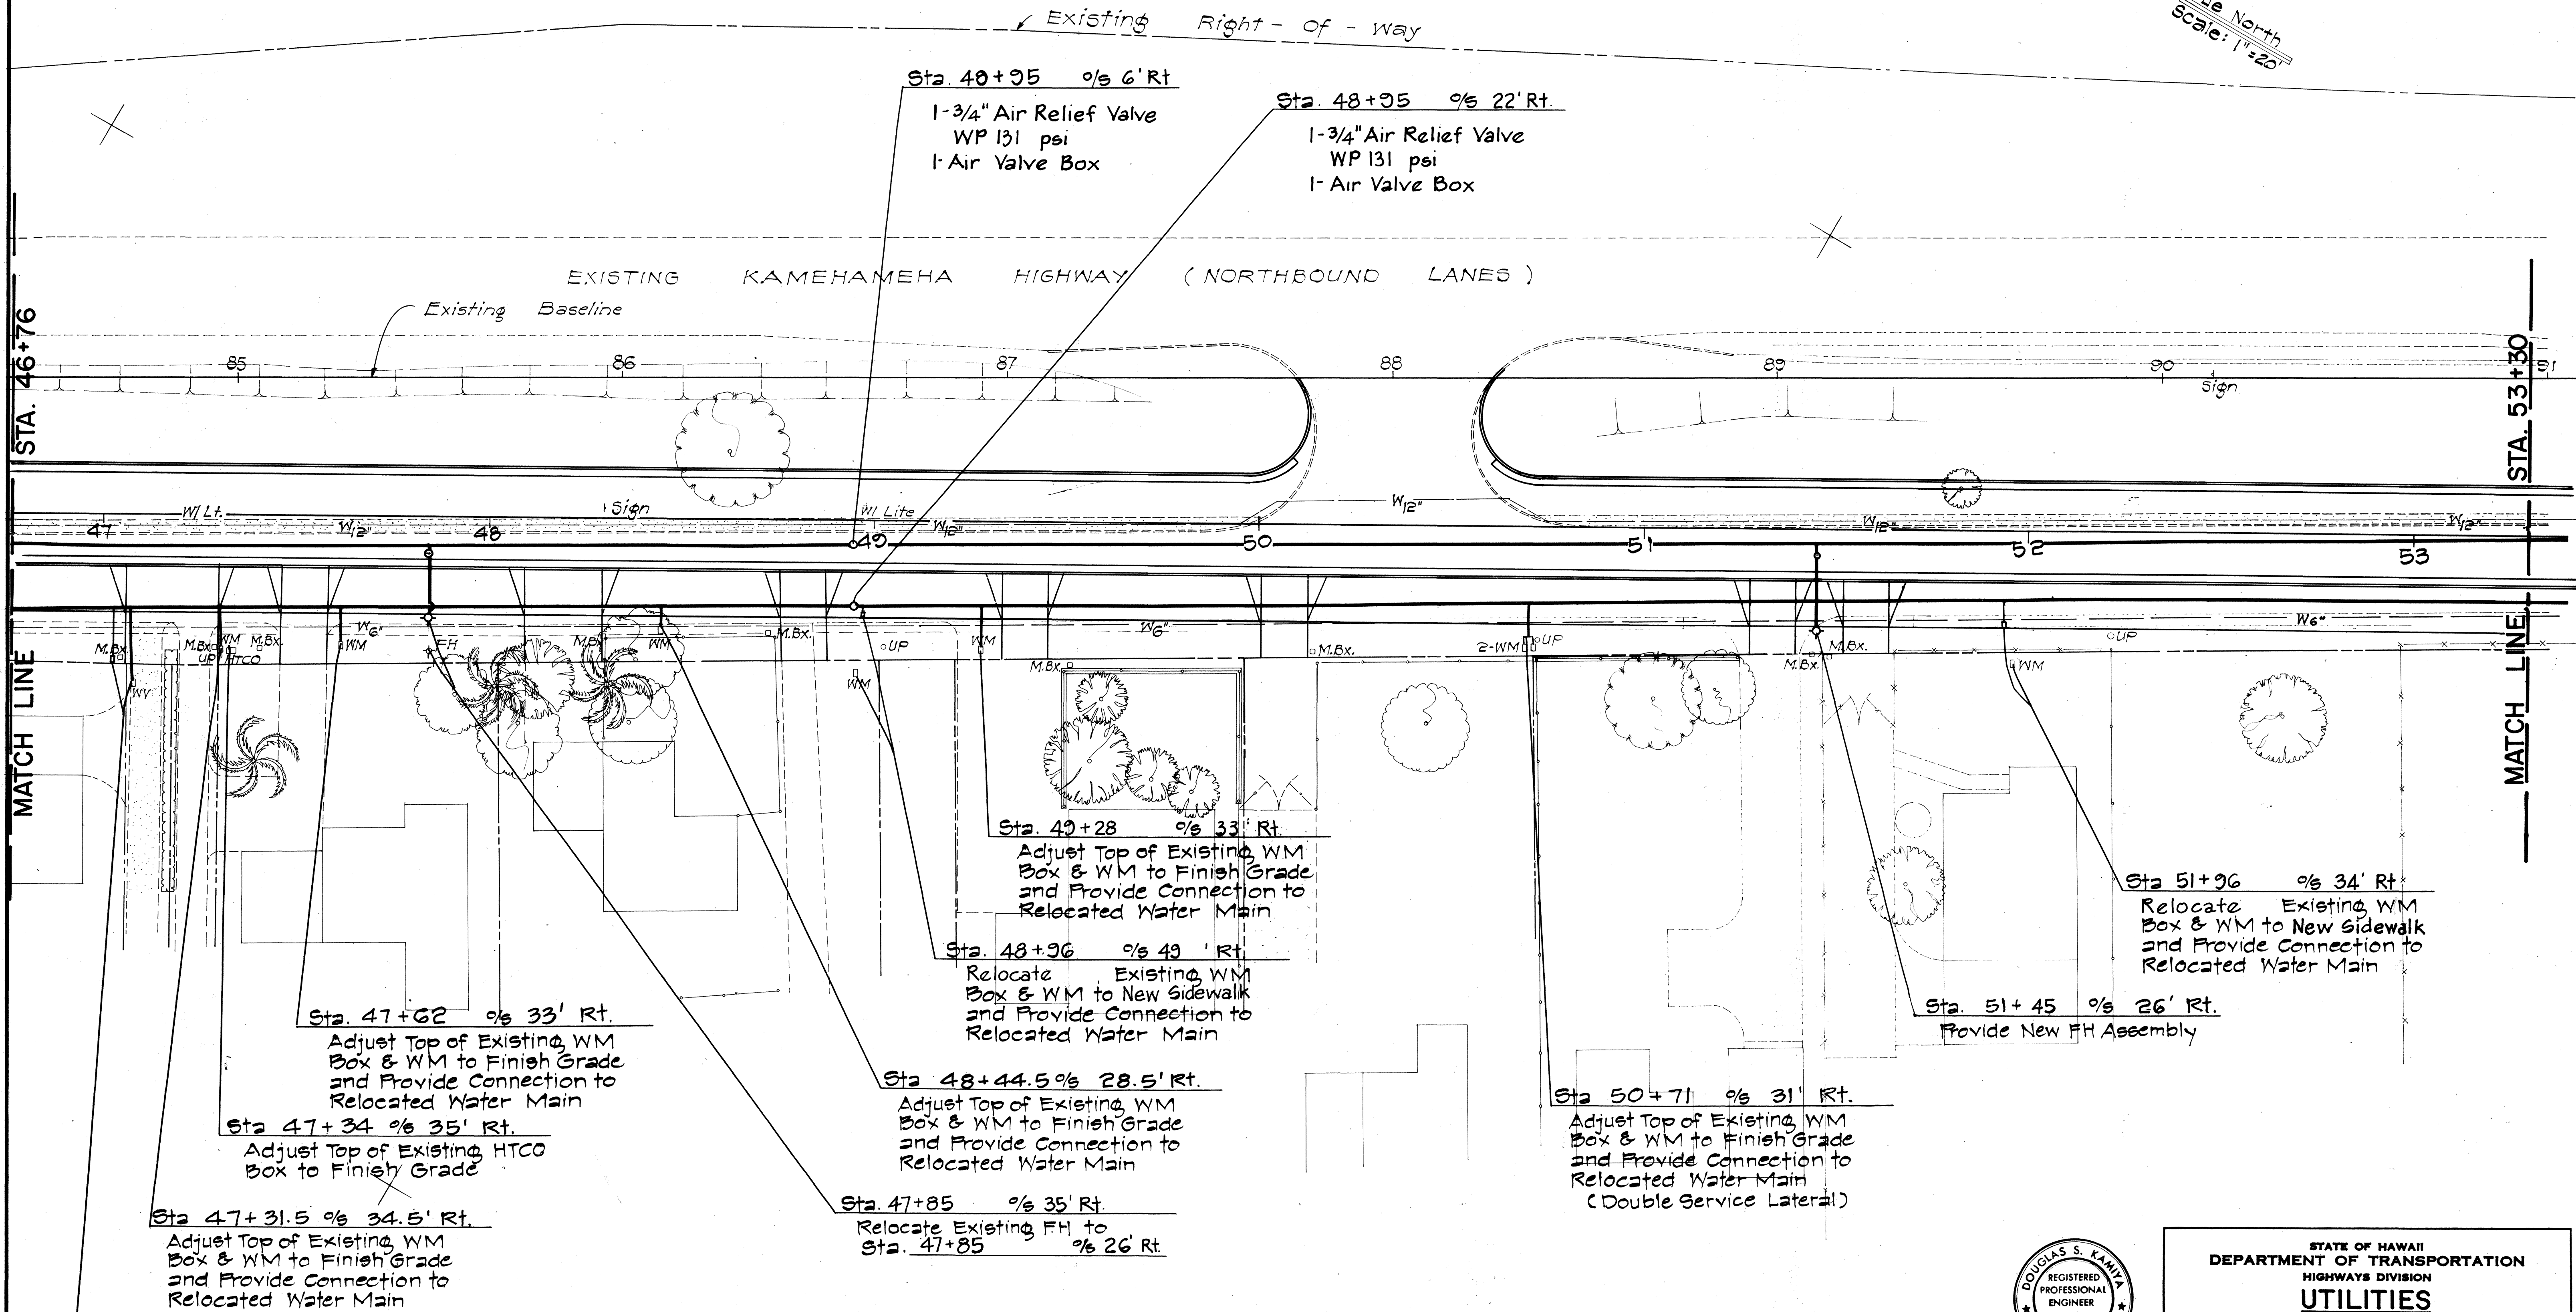



ORIGINAL PLAN	DATE
SURVEY PLOTTED BY	
DRAWN BY	
TRACED BY	
NOTED BY	
CHECKED BY	

APPROVED

 CHIEF, PLANNING AND ENGINEERING, B.W.S.
 CITY AND COUNTY OF HONOLULU

 HAWAIIAN TELEPHONE COMPANY


DATE 9/8/78
 DATE 9-8-78

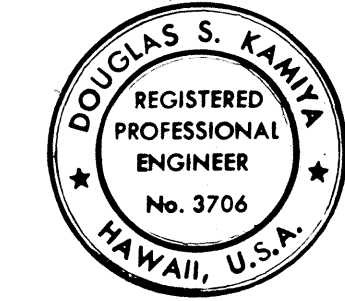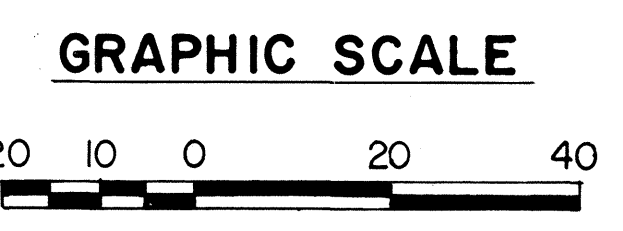


THIS WORK WAS PREPARED BY ME OR UNDER MY SUPERVISION.

STATE OF HAWAII
 DEPARTMENT OF TRANSPORTATION
 HIGHWAYS DIVISION
UTILITIES
 WATER, TELEPHONE
KAMEHAMEHA HIGHWAY IMPROVEMENT
 (LIKELIKE HIGHWAY TO KOOLAU VIEW DRIVE)
 PROJECT NO. F-083-1(10)
 SCALE: AS SHOWN DATE AUG 1978
SHEET No. 10 OF 38 SHEETS


FED. ROAD DIST. NO.	STATE	FED. AID PROJ. NO.	FISCAL YEAR	SHEET NO.	TOTAL SHEETS
HAWAII	HAW.	F-083-1(10)	1978	60	160

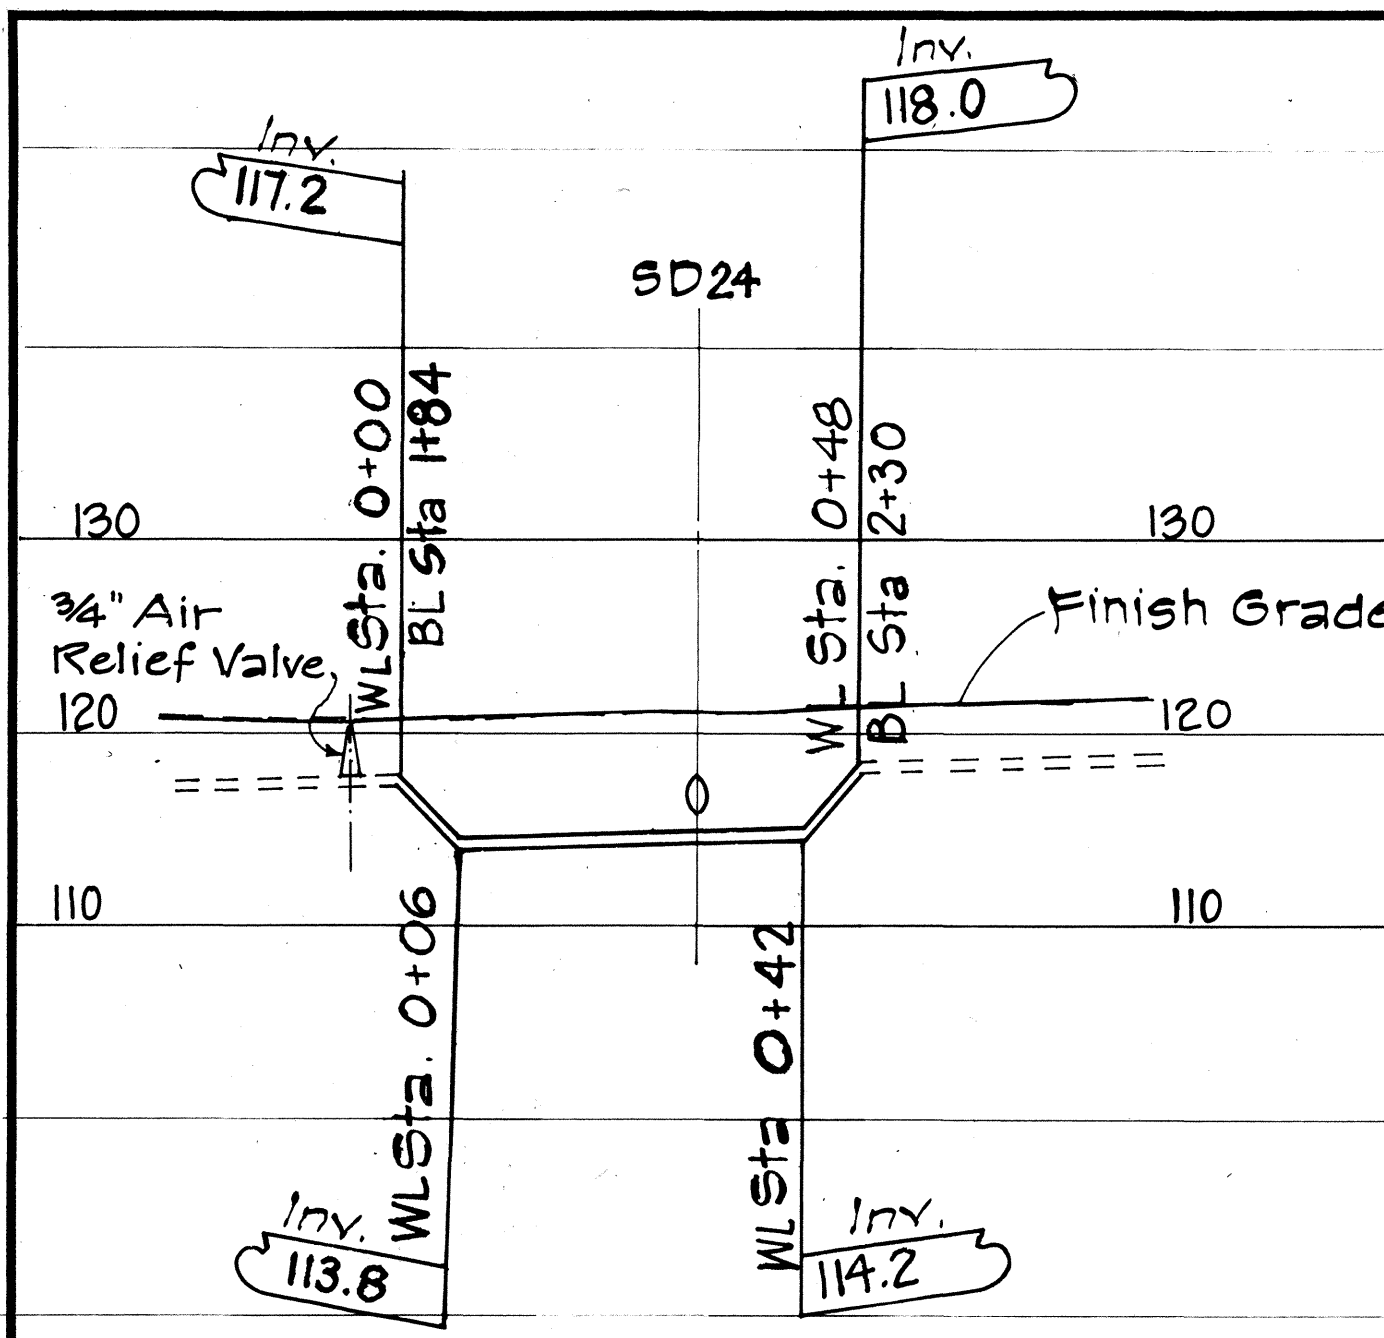


PROFILE - WATERLINE NO. 1

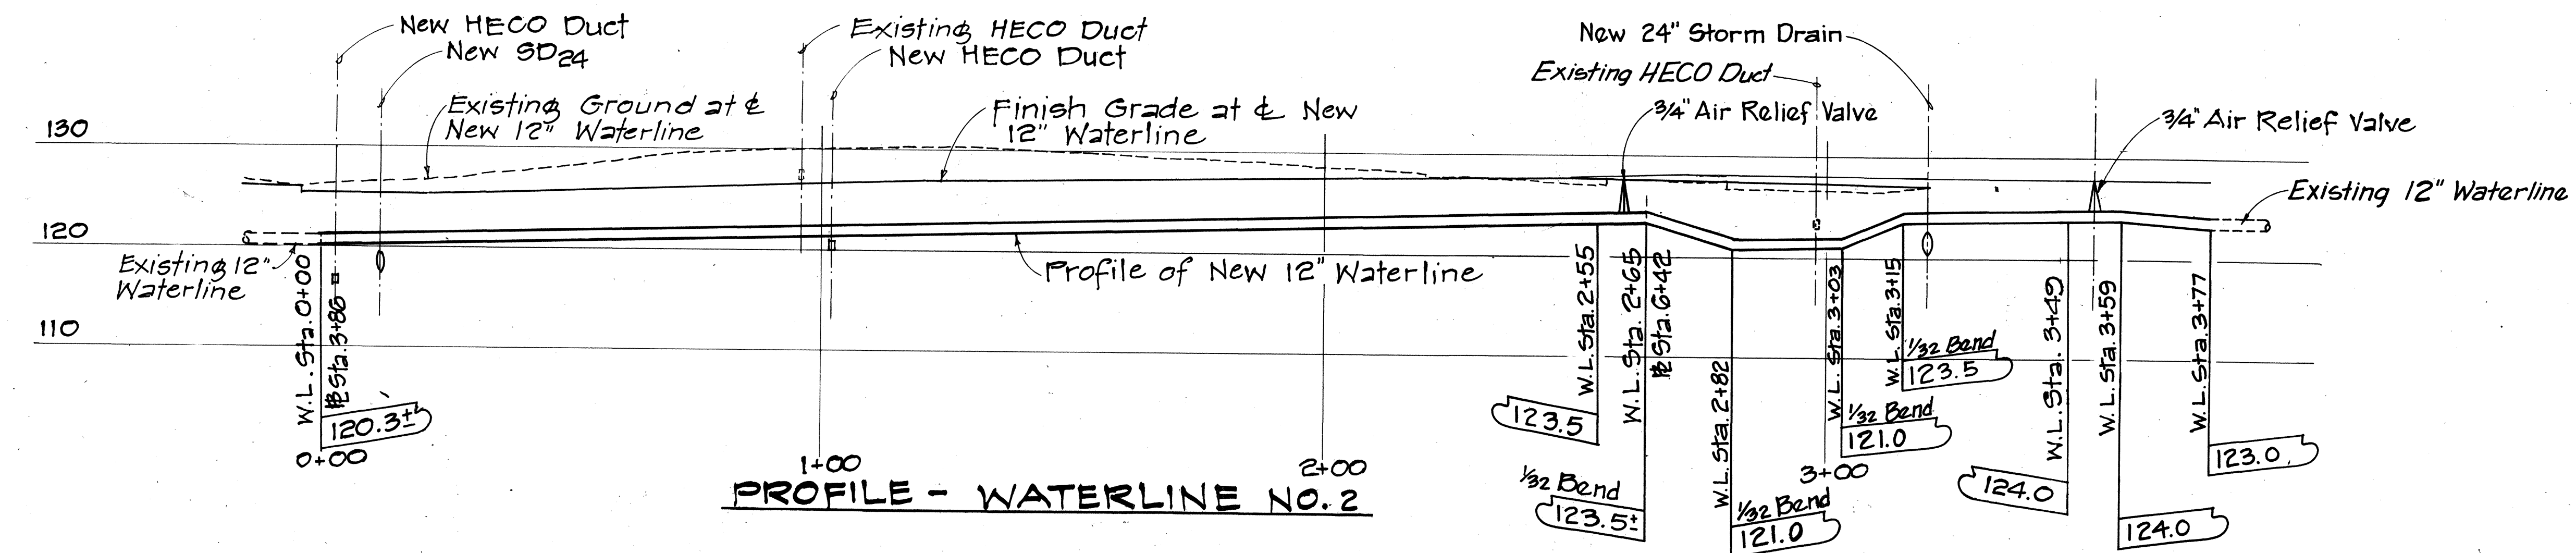

PROFILE - WATERLINE NO. 2

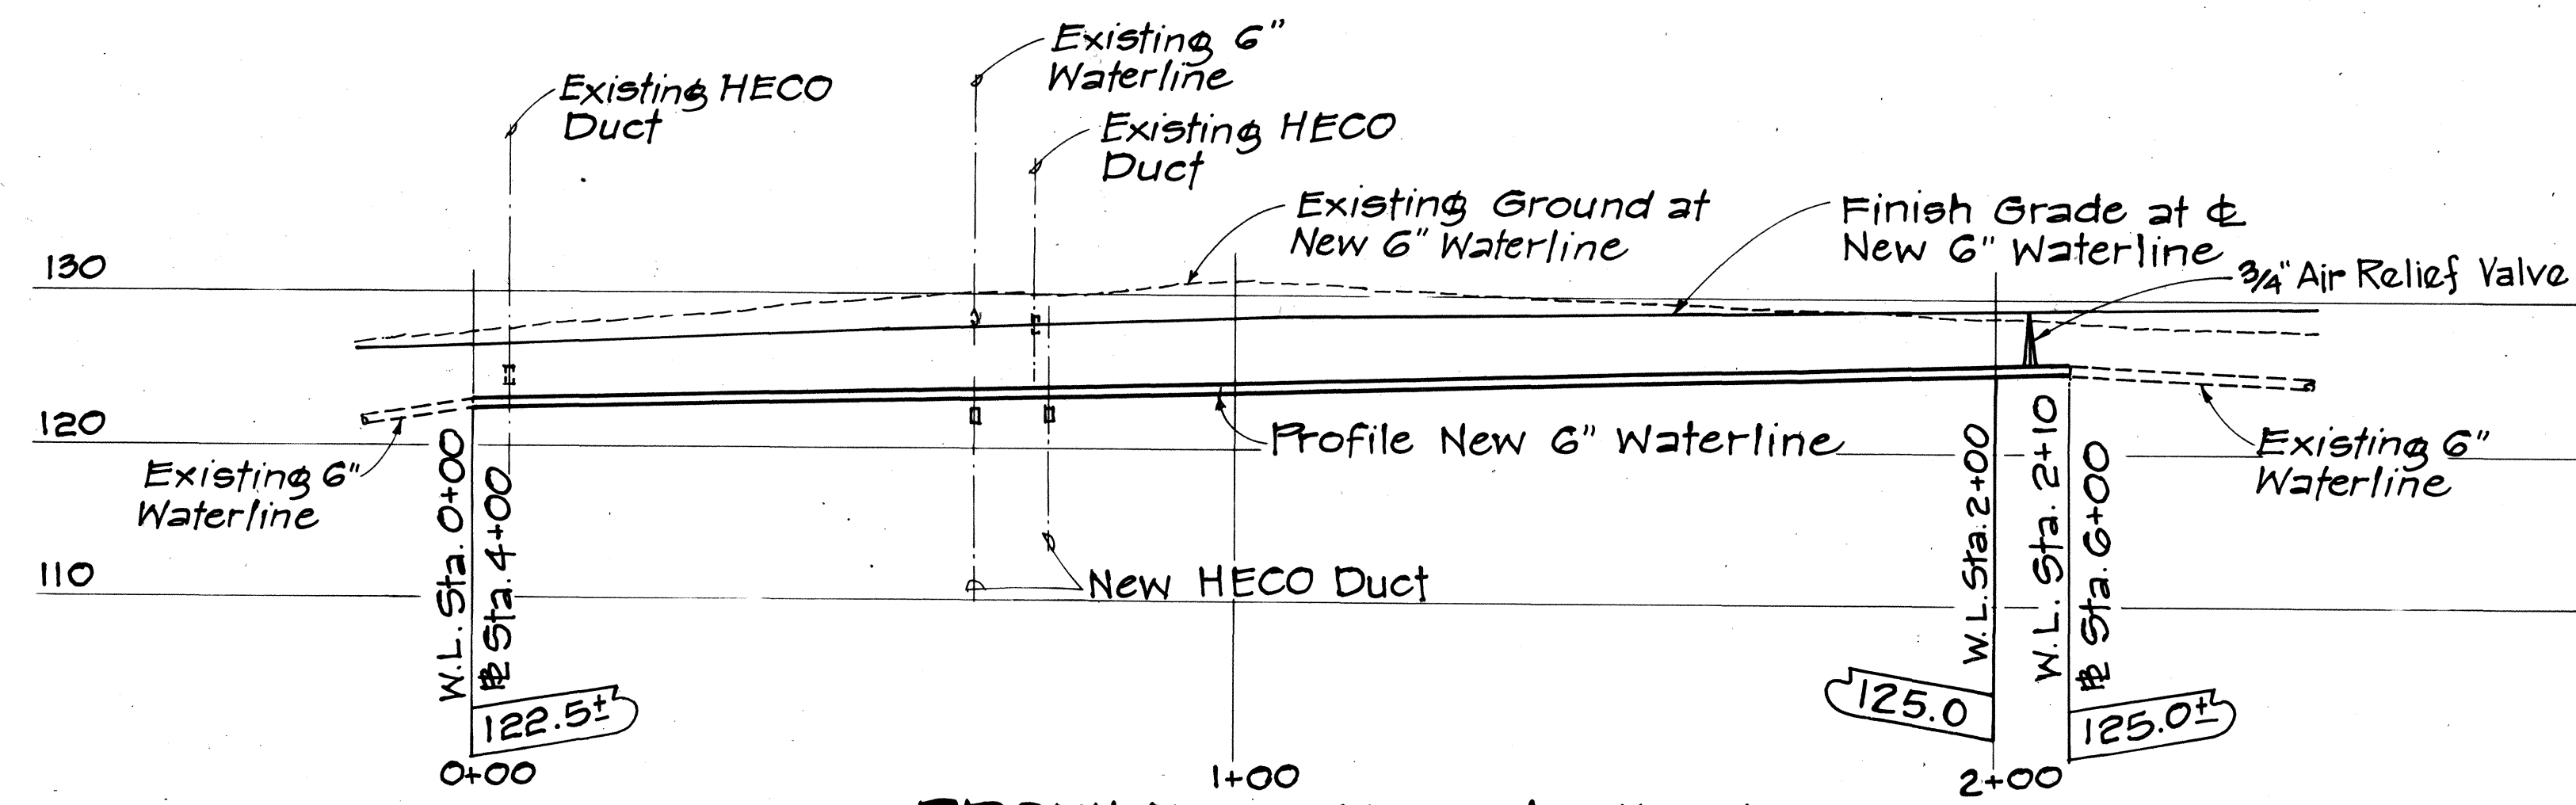


PROFILE - WATERLINE NO. 3

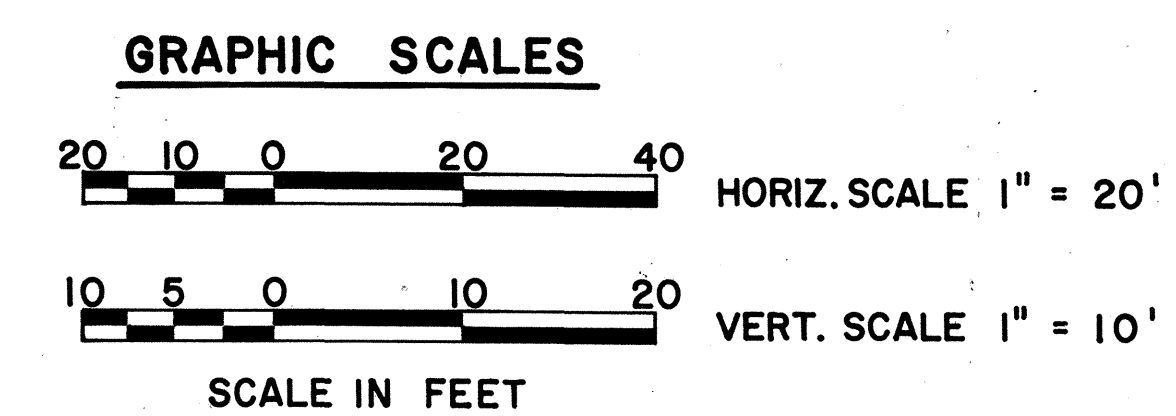

SURVEY PLOTTED BY	DATE
DRAWN BY	
TRACED BY	
QUANTITIES BY	
CHECKED BY	
ORIGINAL PLAN	
NOTE BOOK	
No.	

APPROVED
[Signature]
 CHIEF, PLANNING AND ENGINEERING, B.W.S. 9
 CITY AND COUNTY OF HONOLULU
 DATE 8/2/78

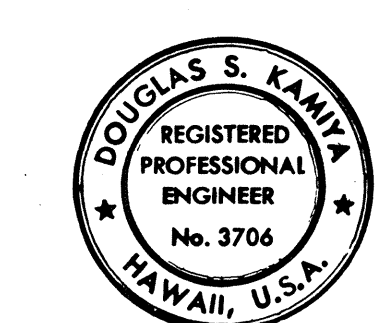

THIS WORK WAS PREPARED BY ME OR UNDER MY SUPERVISION.
[Signature]


STATE OF HAWAII
 DEPARTMENT OF TRANSPORTATION
 LAND TRANSPORTATION FACILITIES DIVISION

UTILITY PROFILES
 WATER
 KAMEHAMEHA HIGHWAY IMPROVEMENT
 (LIKELIKE HIGHWAY TO KOOLAU VIEW DRIVE)
 PROJECT NO. F-083-1(10)


SCALE: AS SHOWN DATE AUG 1978

SHEET No. 12 OF 38 SHEETS

FED. ROAD DIST. NO.	STATE	FED. AID PROJ. NO.	FISCAL YEAR	SHEET NO.	TOTAL SHEETS
HAWAII	HAW.	F-083-1(10)	1978	61	160


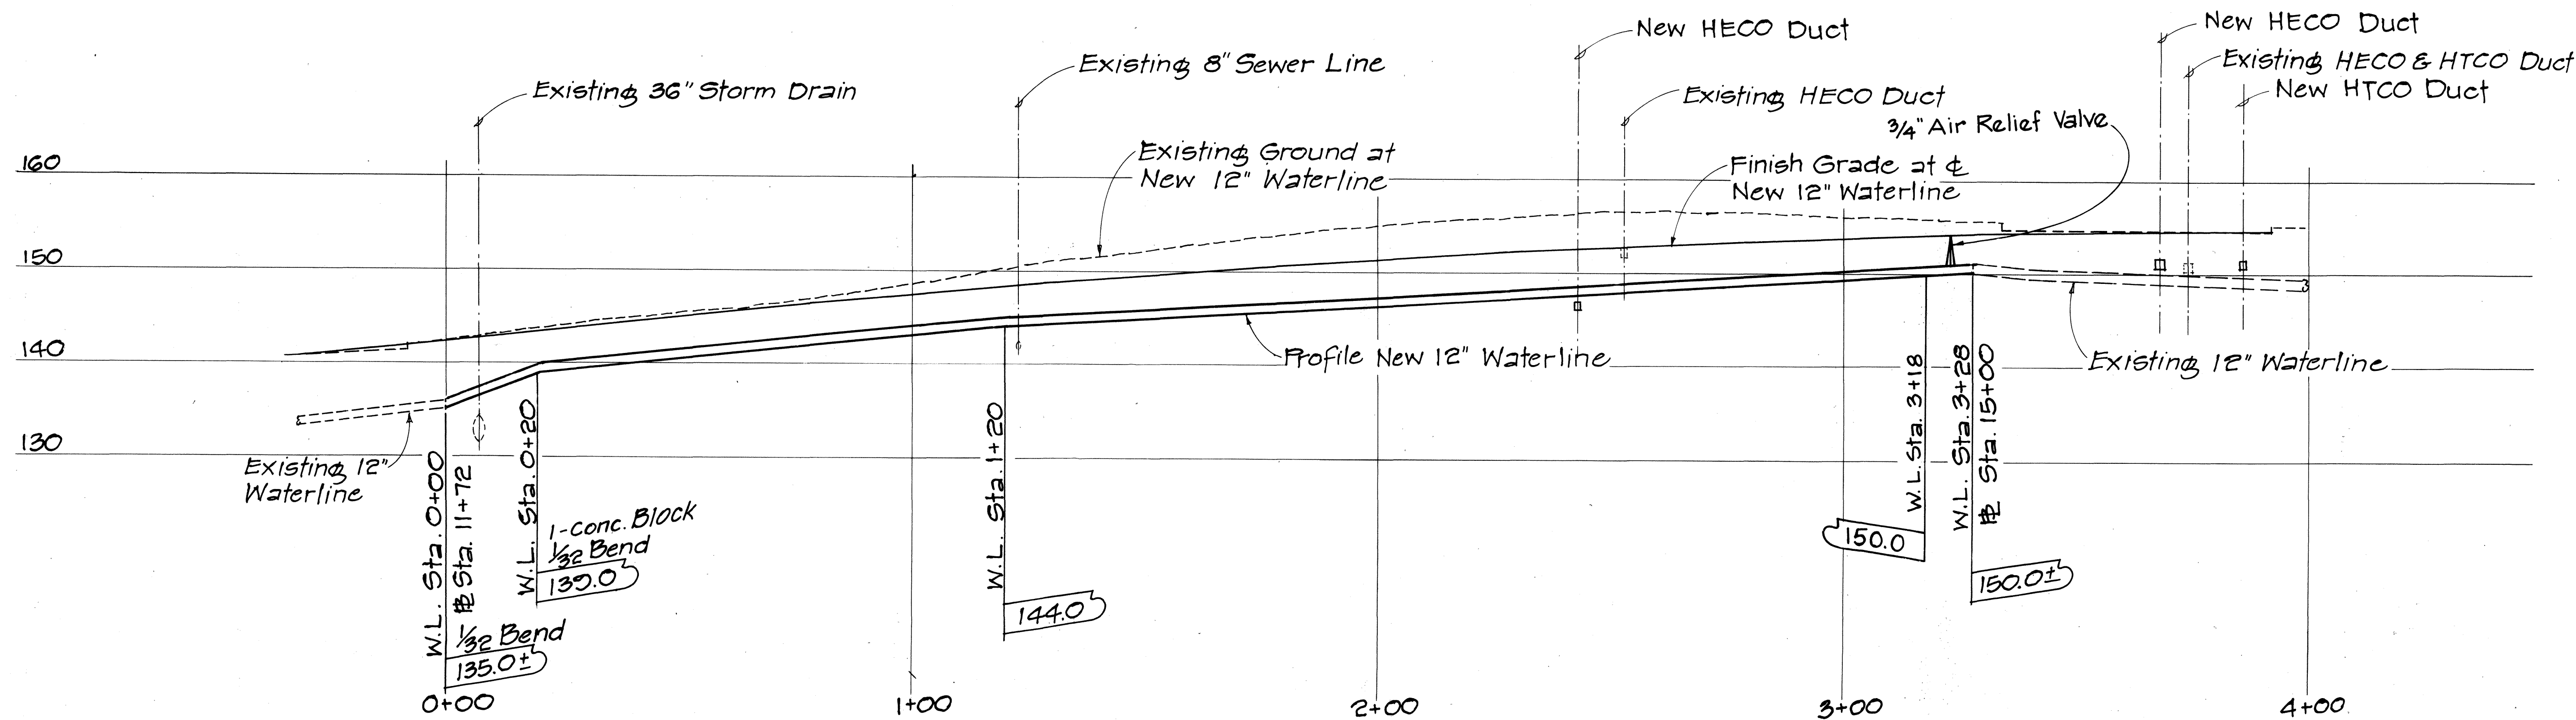


PROFILE - WATERLINE NO. 4

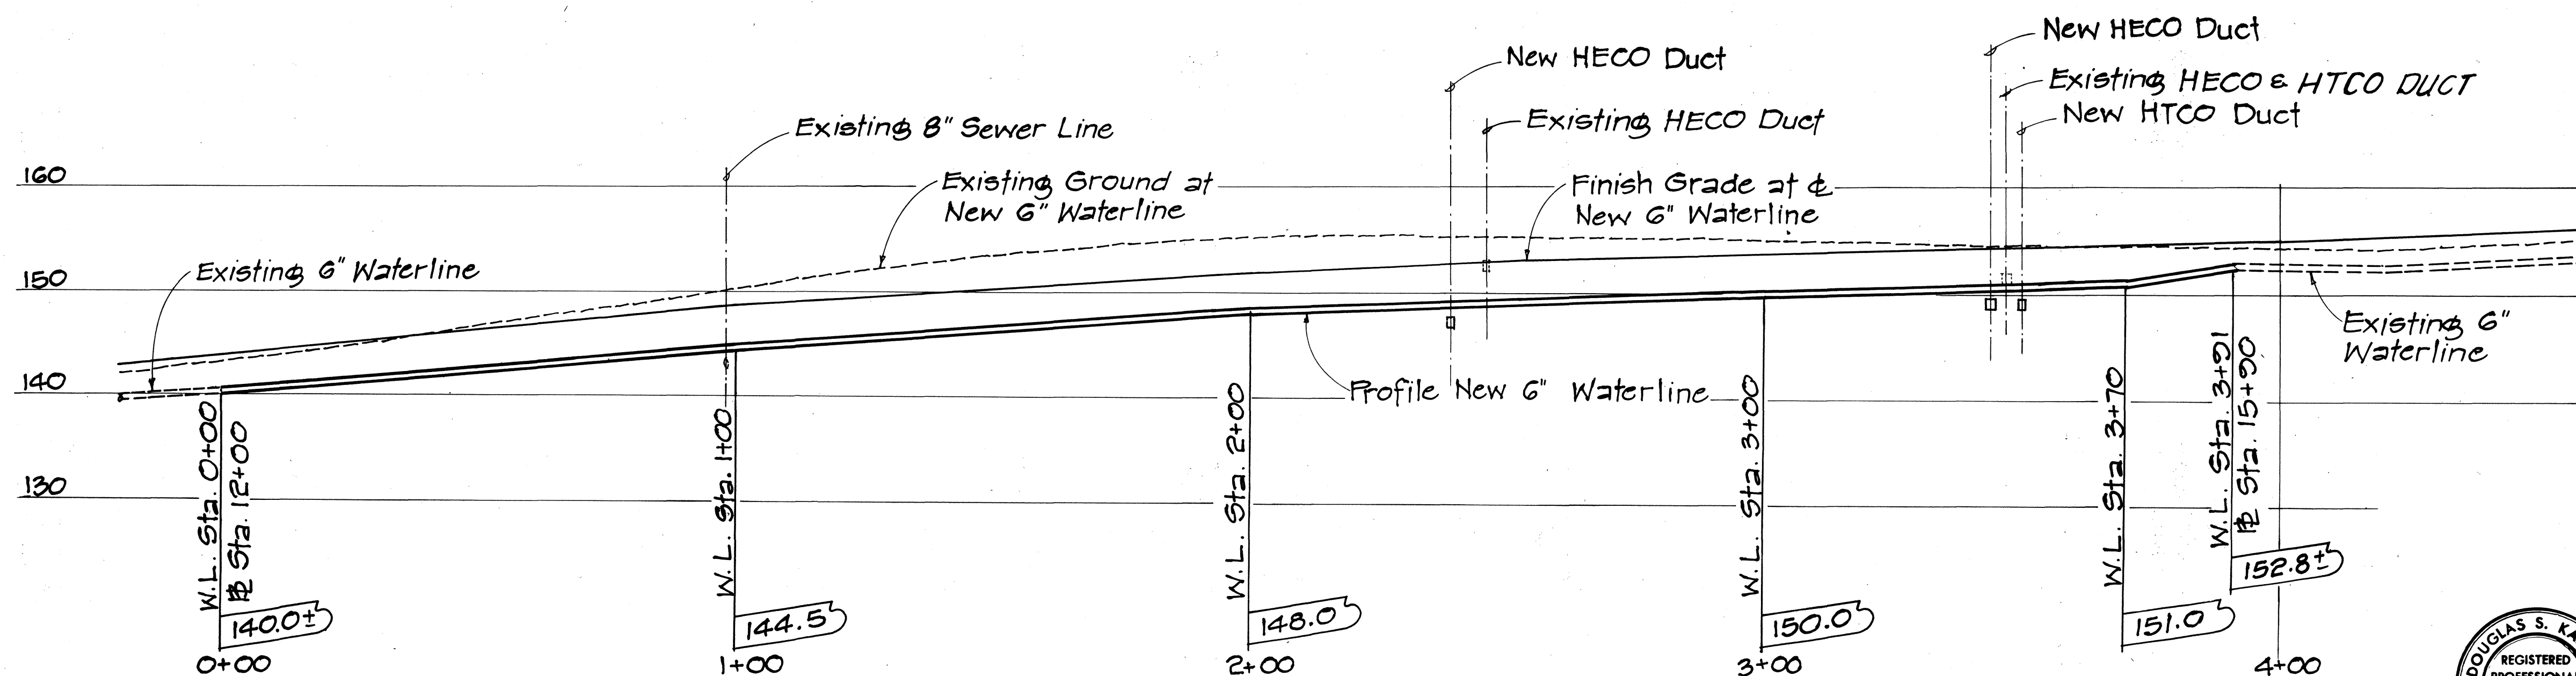

PROFILE - WATERLINE NO. 5

GRAPHIC SCALES

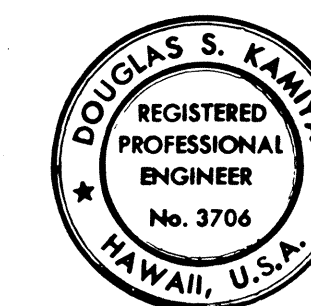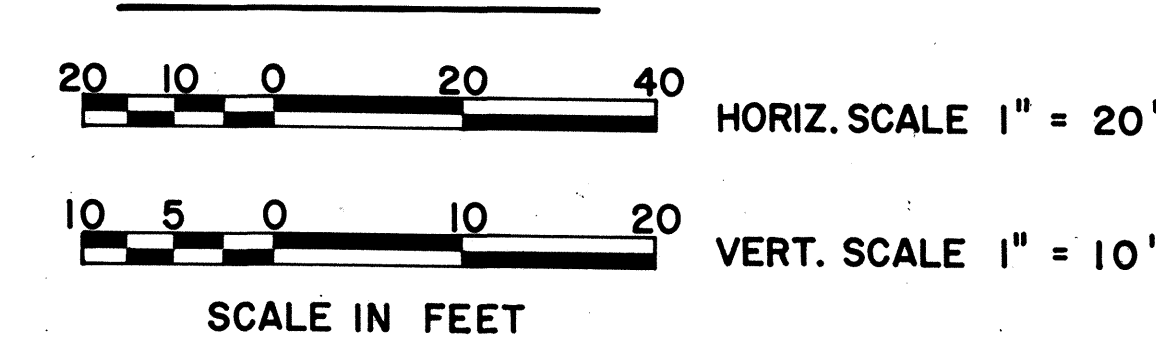

THIS WORK WAS PREPARED BY ME OR UNDER MY SUPERVISION.
Douglas S. Kanaka

APPROVED:
Kurt H. Minakawa
 CHIEF, PLANNING AND ENGINEERING, B.W.S. 9
 CITY AND COUNTY OF HONOLULU

10/3/78
 DATE


STATE OF HAWAII
 DEPARTMENT OF TRANSPORTATION
 LAND TRANSPORTATION FACILITIES DIVISION

UTILITY PROFILES
 WATER
 KAMEHAMEHA HIGHWAY
 IMPROVEMENT
 (LIKELIKE HIGHWAY TO KOOLAU VIEW DRIVE)
 PROJECT NO. F-083-1(10)


SCALE: AS SHOWN DATE AUG 1978
 SHEET No. 13 OF 38 SHEETS

ORIGINAL PLAN	DATE
DESIGNED BY	
CHECKED BY	
NO. 1	


FED. ROAD DIST. NO.	STATE	FED. AID PROJ. NO.	FISCAL YEAR	SHEET NO.	TOTAL SHEETS
HAWAII	HAW.	F-083-1(10)	1978	62	160

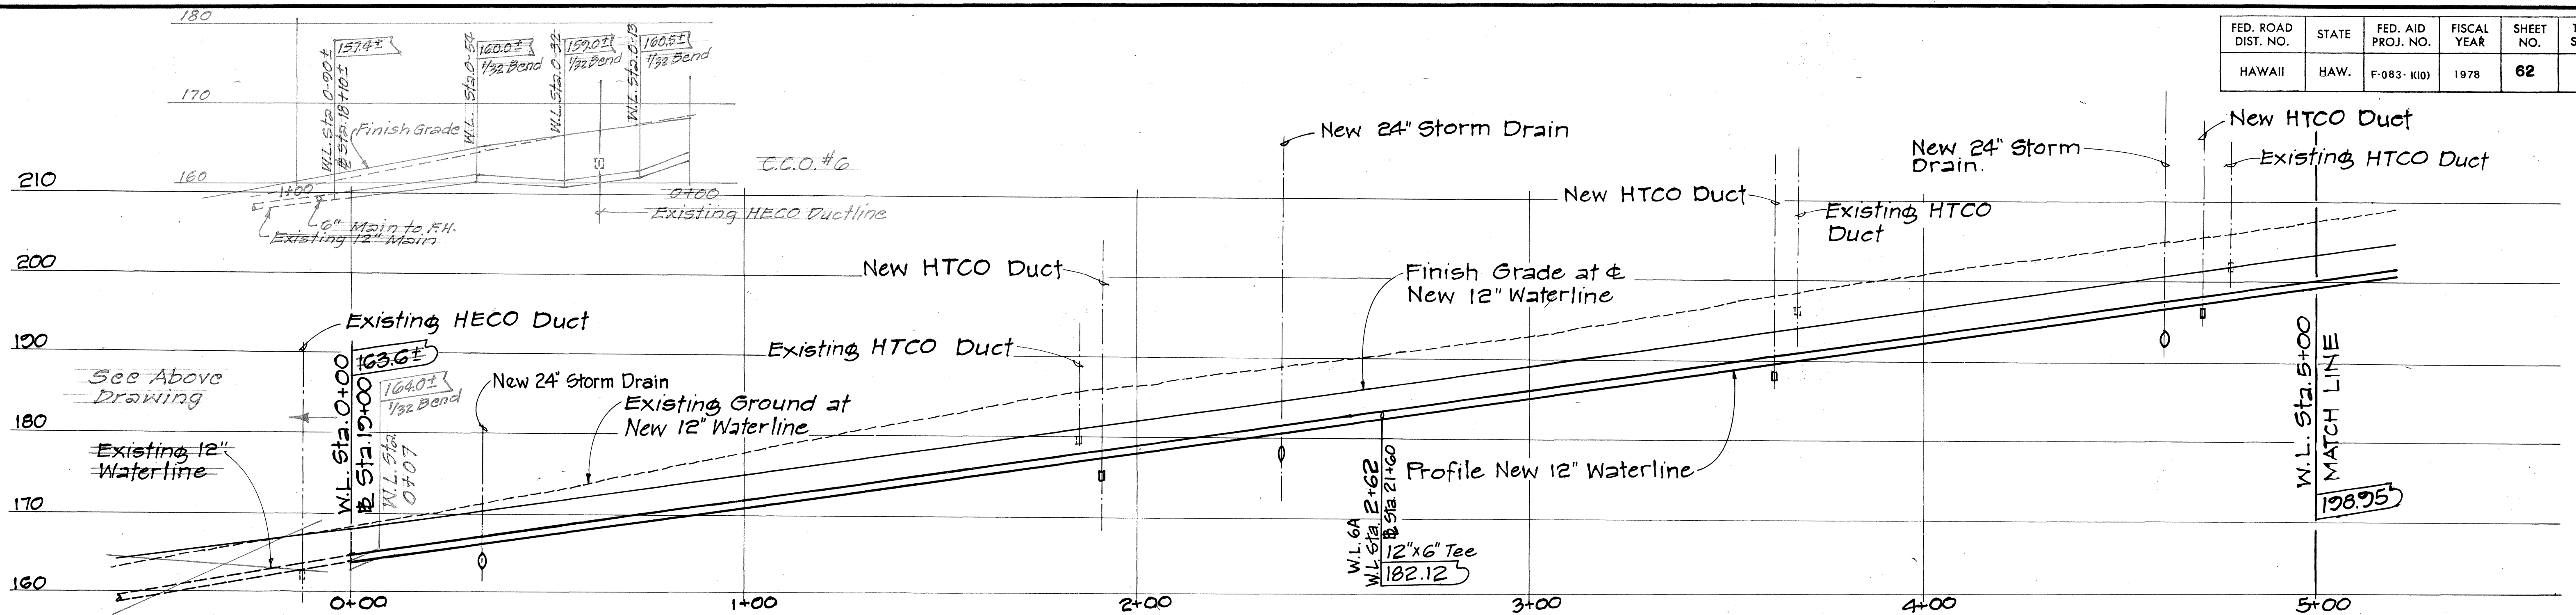


PROFILE - WATERLINE NO. 6

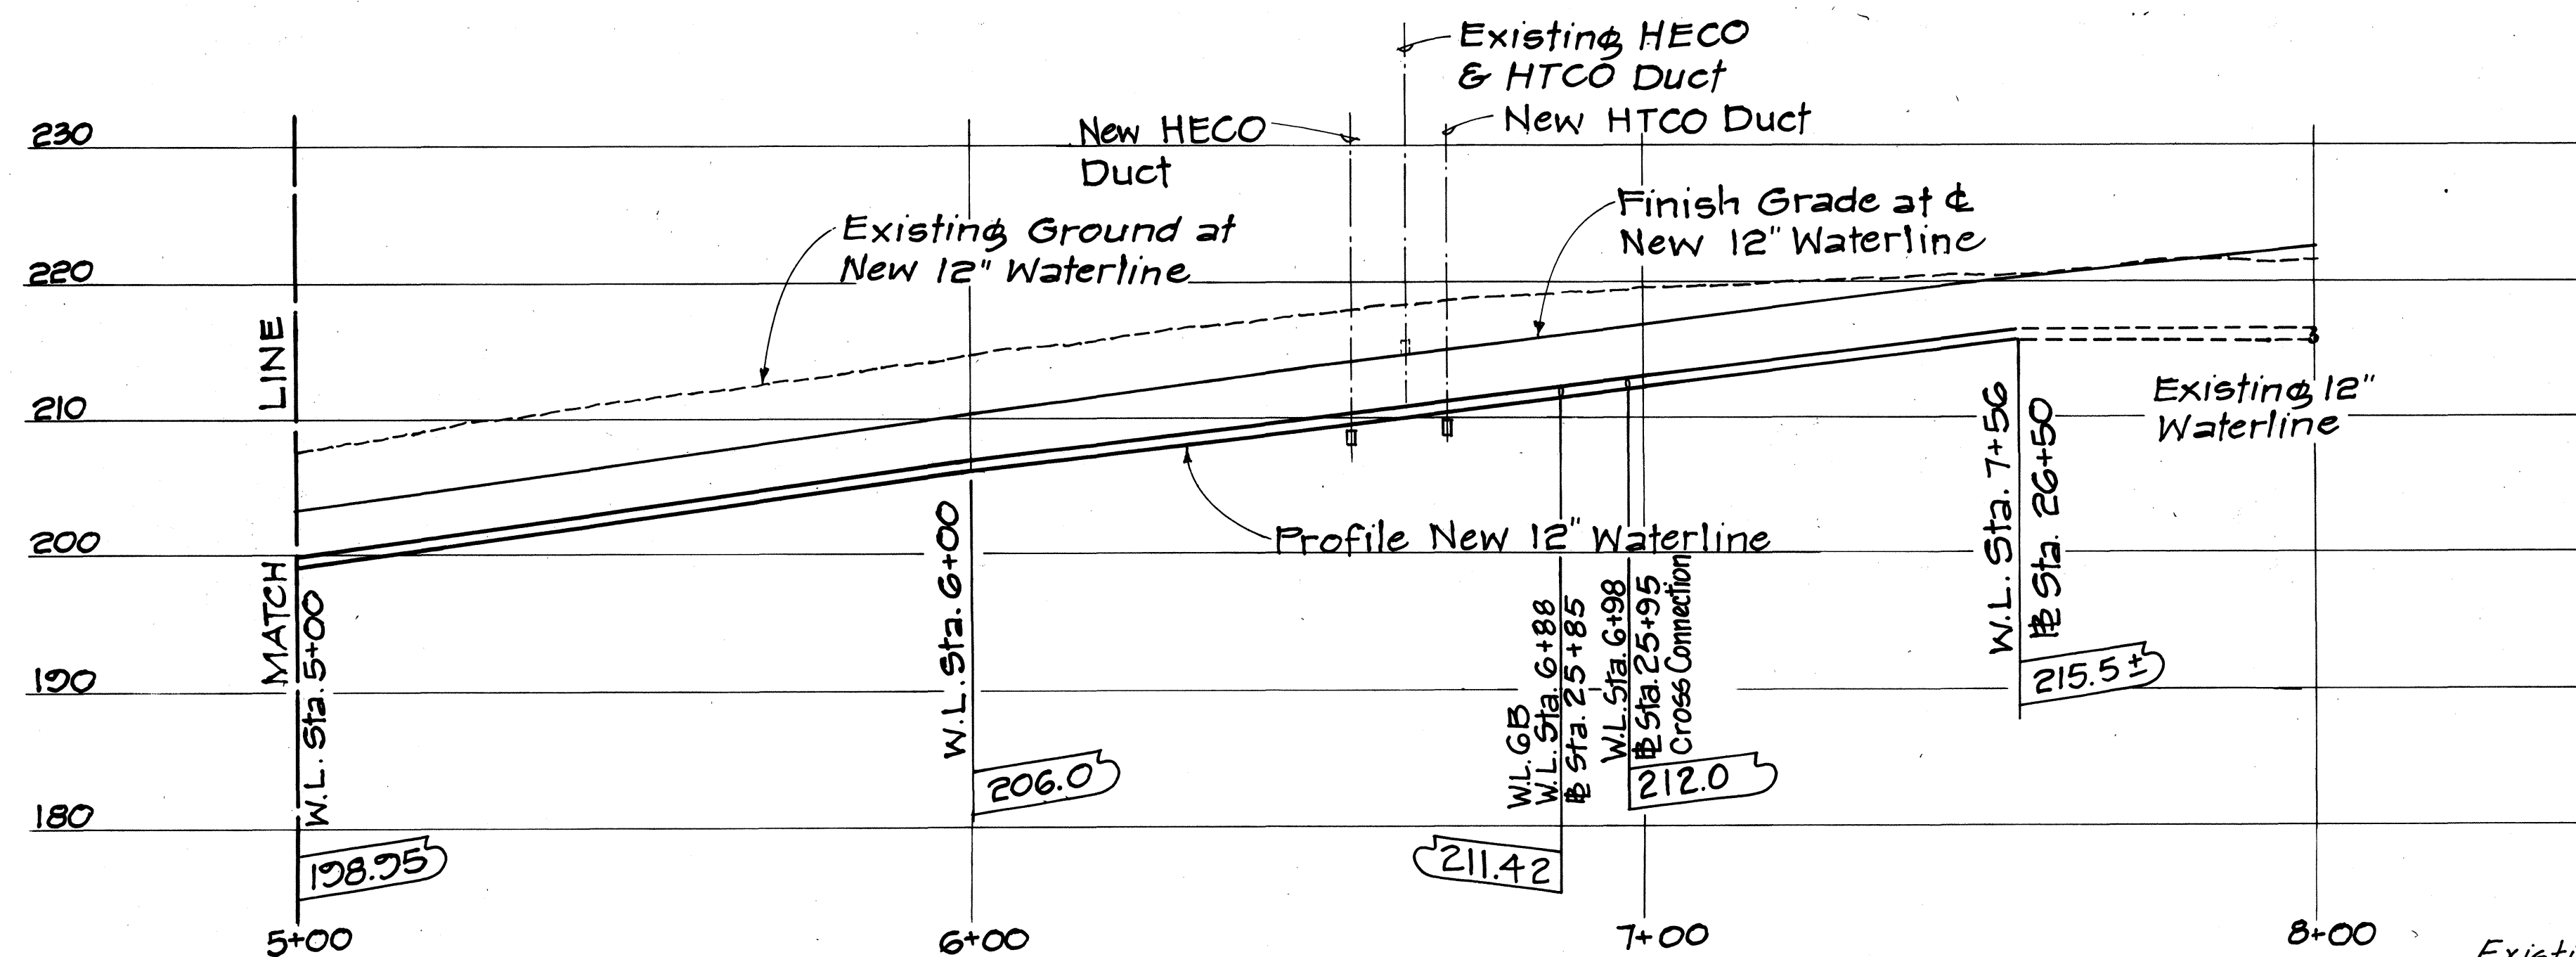

PROFILE - WATERLINE NO. 6

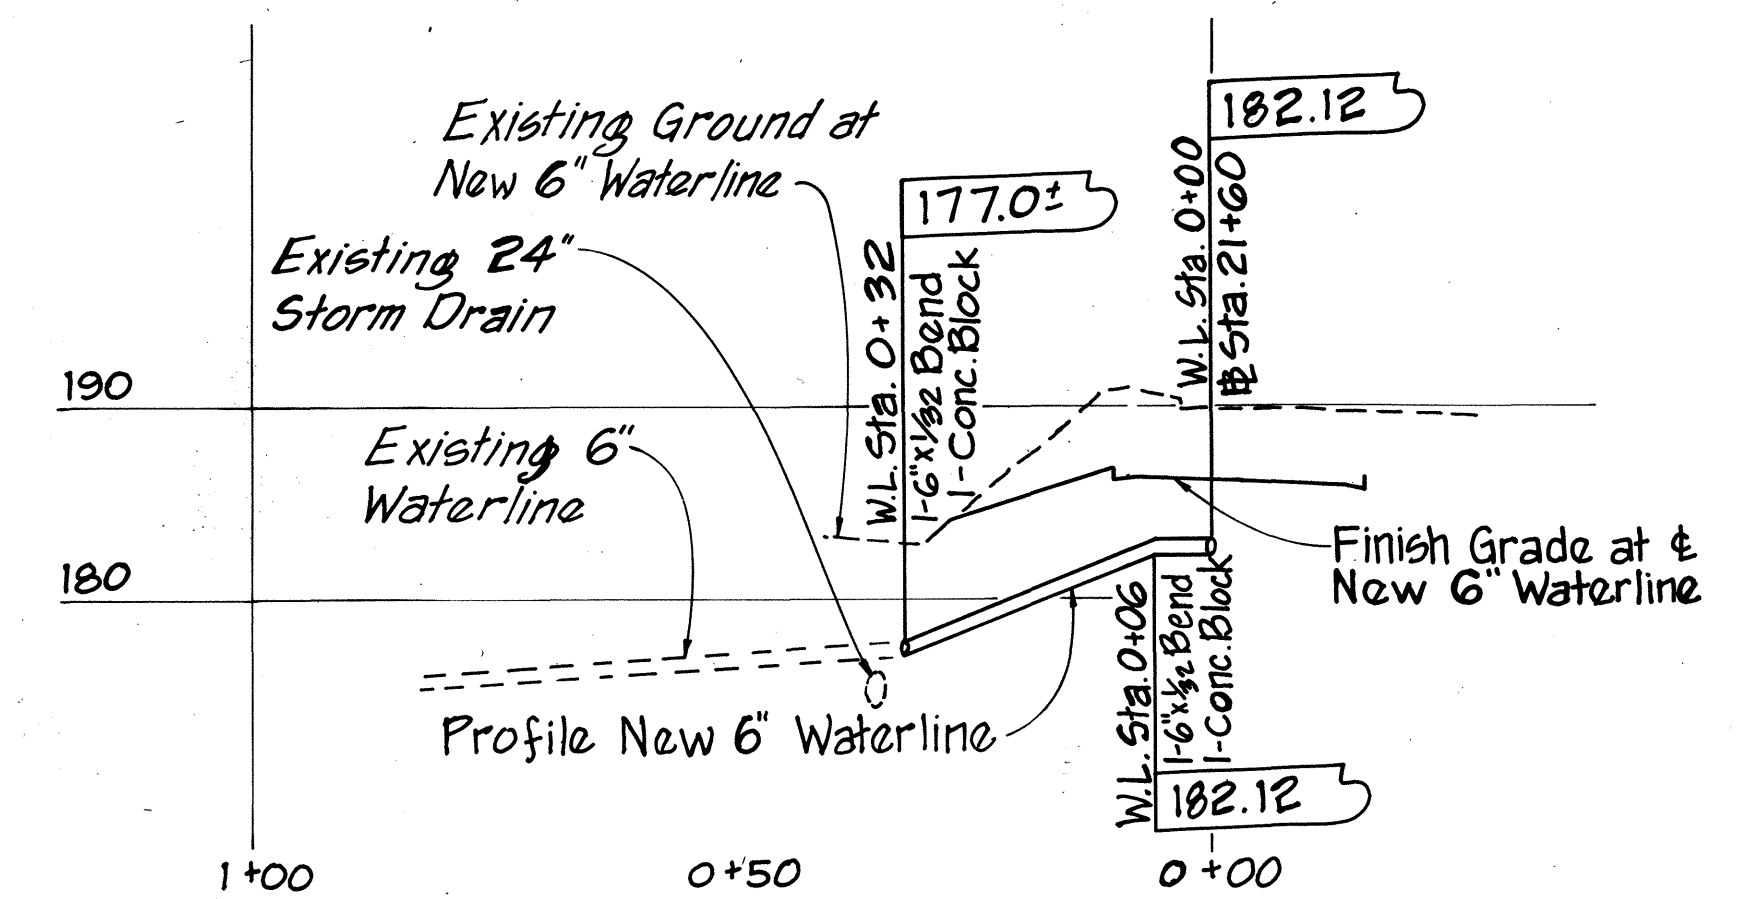

PROFILE - WATERLINE NO. 6A

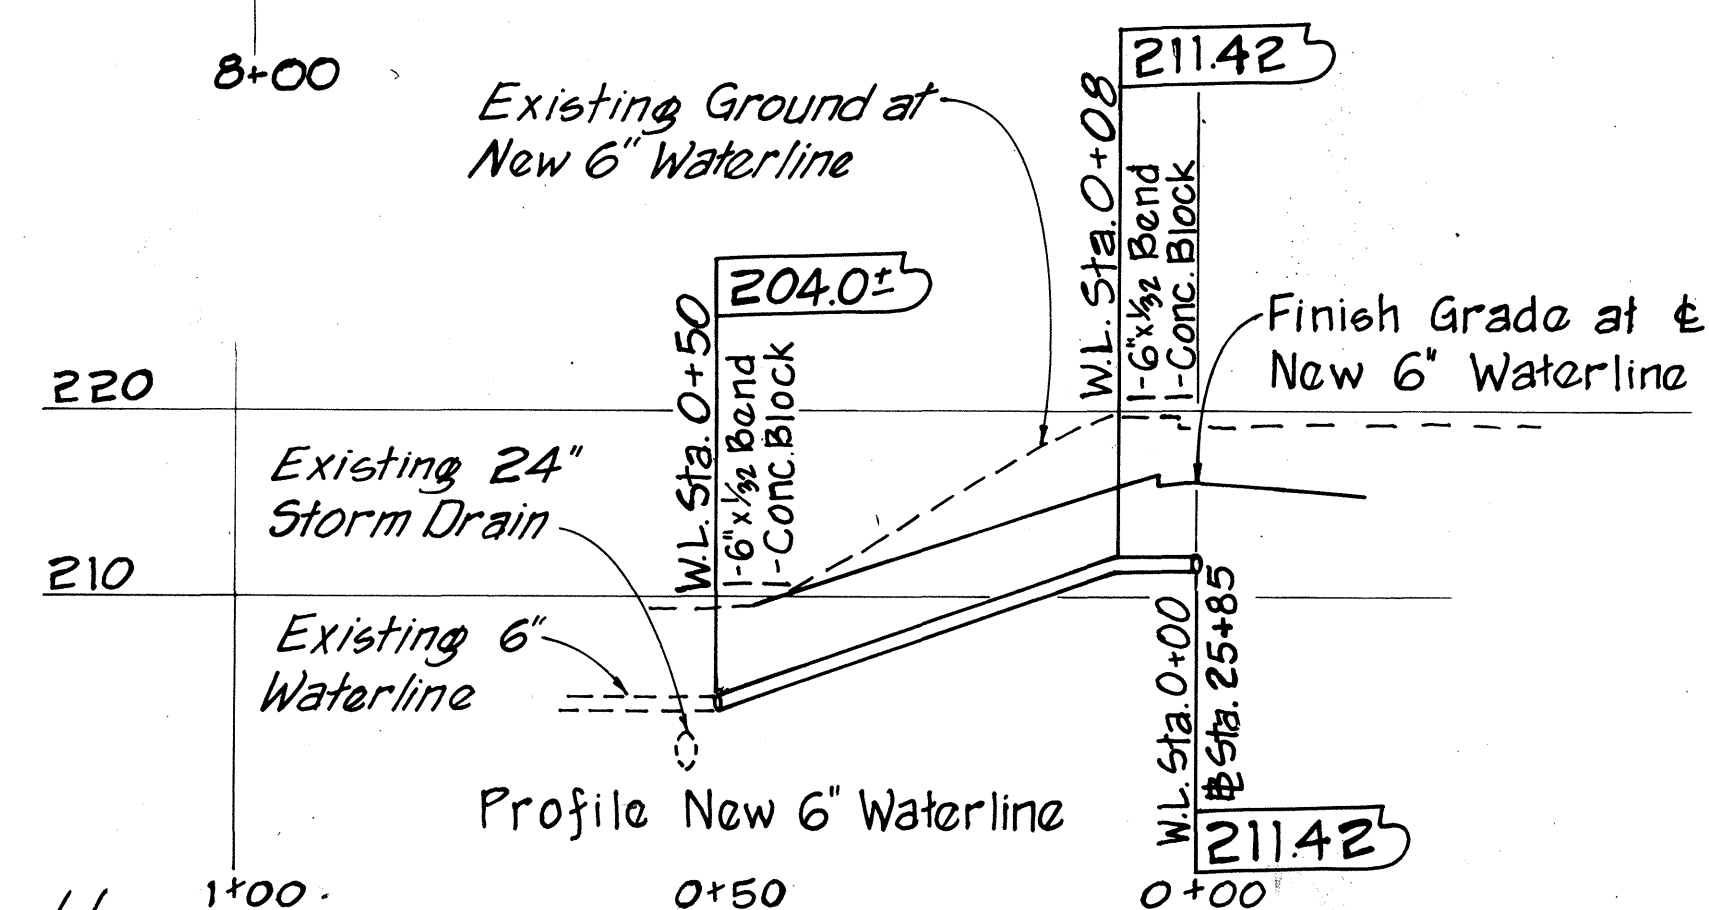


PROFILE - WATERLINE NO. 6B

GRAPHIC SCALES

20 10 0 20 40 HORIZ. SCALE 1" = 20'

10 5 0 10 20 VERT. SCALE 1" = 10'

SCALE IN FEET

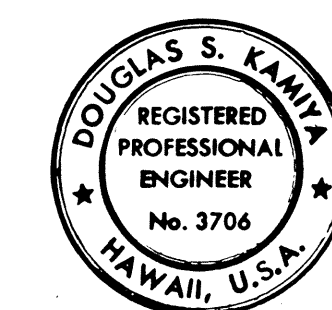

THIS WORK WAS PREPARED BY ME OR UNDER MY SUPERVISION.
Douglas S. Kamia

STATE OF HAWAII
DEPARTMENT OF TRANSPORTATION
LAND TRANSPORTATION FACILITIES DIVISION

UTILITY PROFILES
WATER
KAMEHAMEHA HIGHWAY
IMPROVEMENT
(LIKELIKE HIGHWAY TO KOOLAU VIEW DRIVE)
PROJECT NO. F-083-1(10)
SCALE: AS SHOWN DATE AUG 1978

SHEET No. 14 OF 38 SHEETS


DATE	
SURVEY PLOTTED BY	
DESIGNED BY	
NOTED BY	
CHECKED BY	
ORIGINAL PLAN	
NOTE BOOK	
QUANTITIES BY	
CHECKED BY	

APPROVED
[Signature]
CHIEF, PLANNING AND ENGINEERING,
CITY AND COUNTY OF HONOLULU


B. W. S.

DATE
10/3/78


FED. ROAD DIST. NO.	STATE	FED. AID PROJ. NO.	FISCAL YEAR	SHEET NO.	TOTAL SHEETS
HAWAII	HAW.	F-083-1(10)	1978	63	160

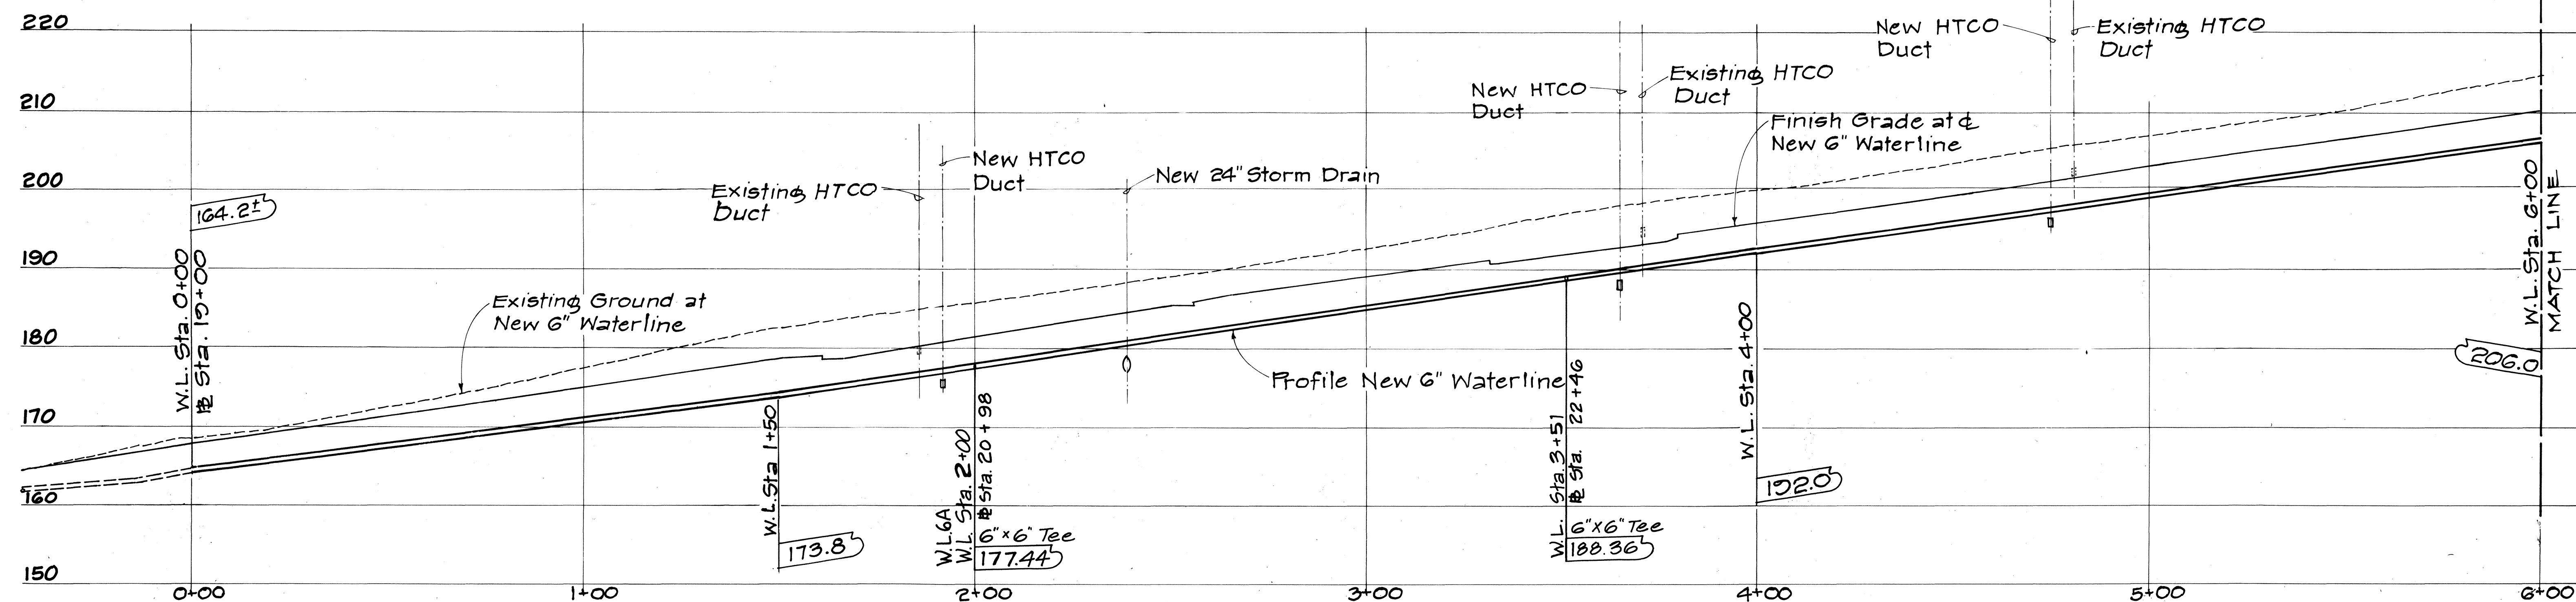


PROFILE - WATERLINE NO. 7

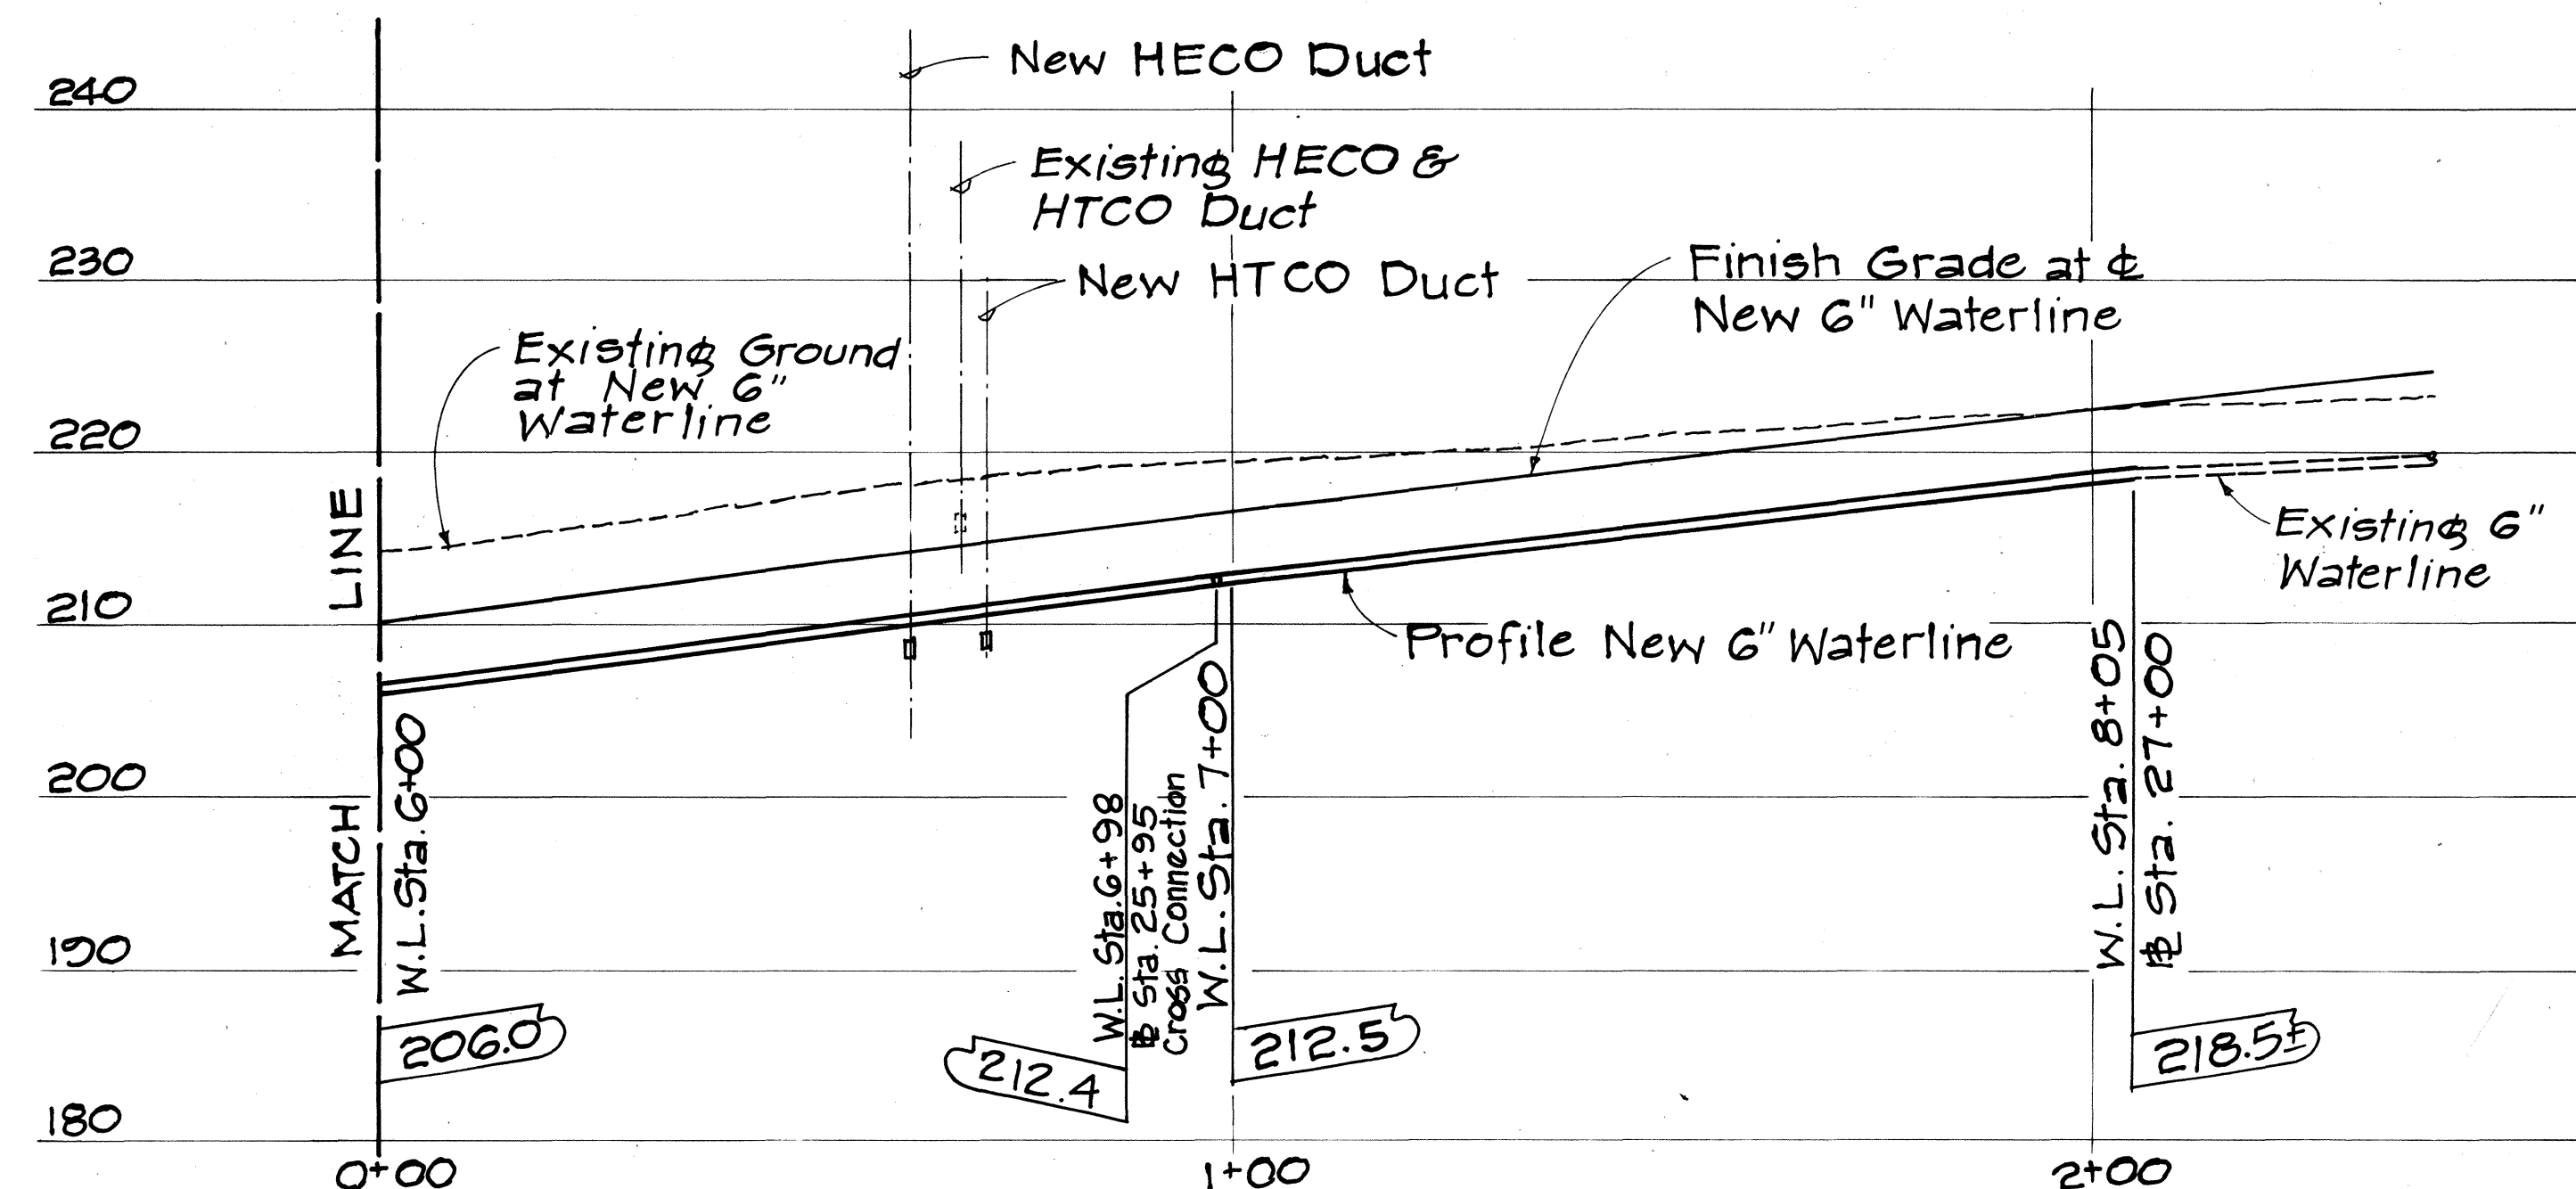

PROFILE - WATERLINE NO. 7

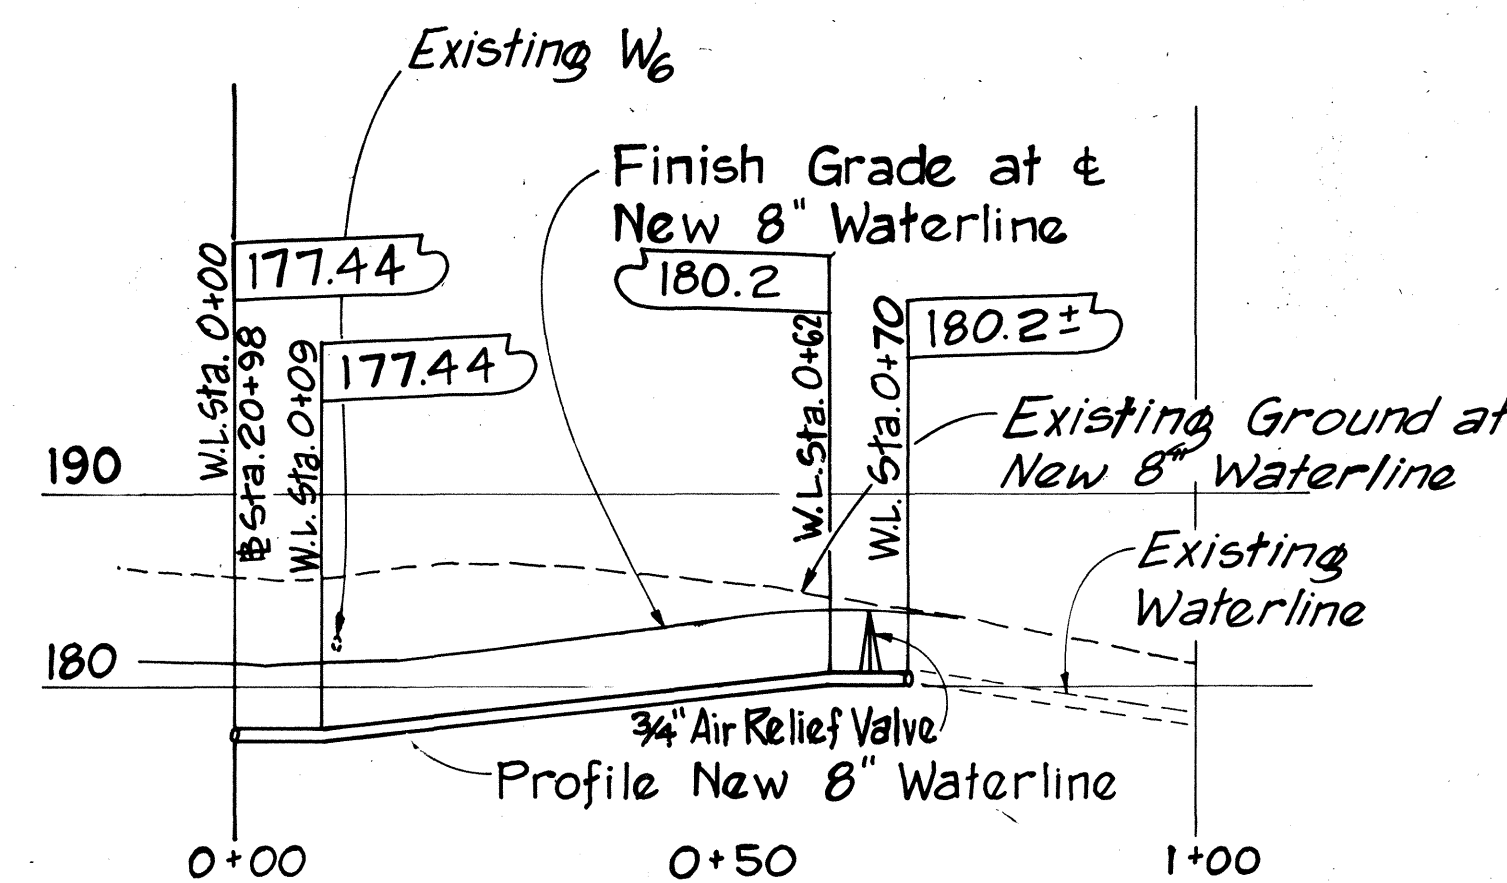


PROFILE - WATERLINE NO. 7A

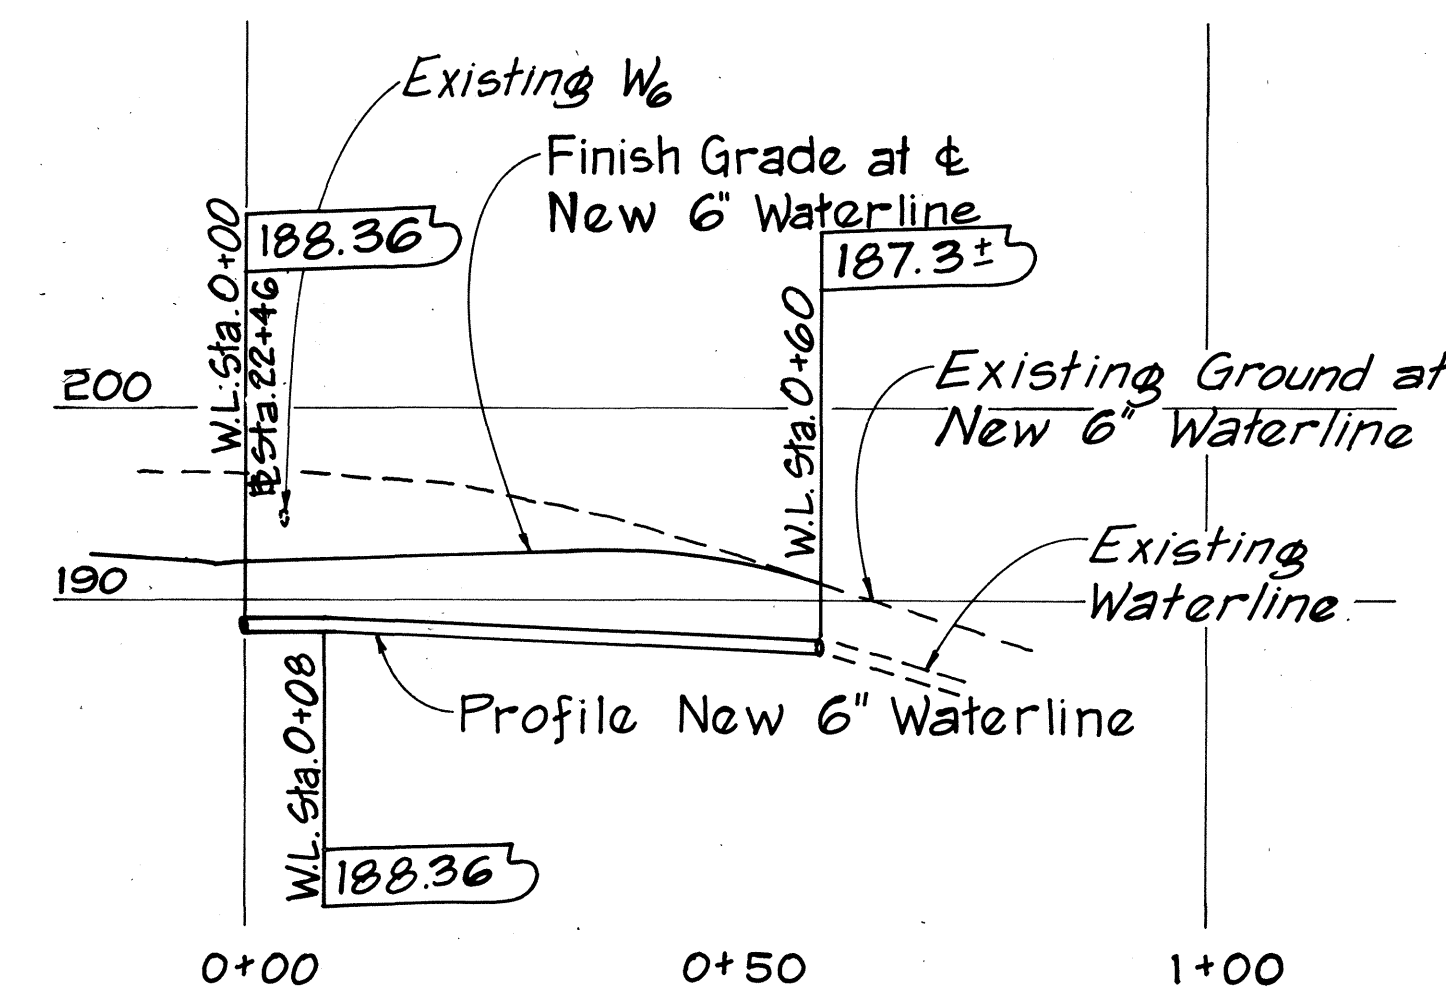


PROFILE - WATERLINE NO. 7B

GRAPHIC SCALES

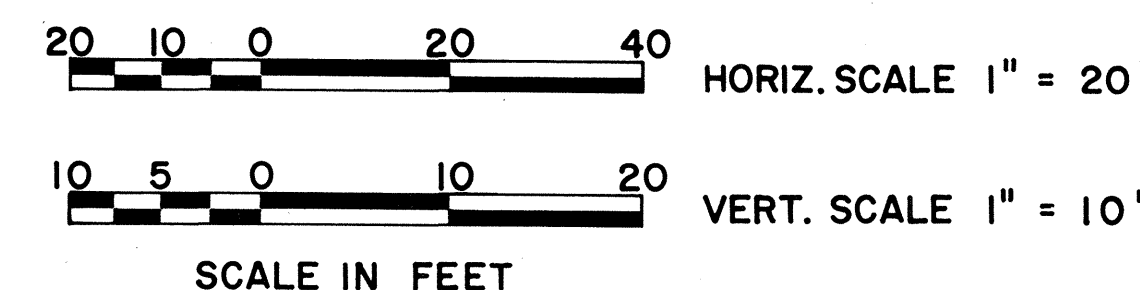

APPROVED: *[Signature]*
CHIEF, PLANNING AND ENGINEERING, B.W.S. &
CITY AND COUNTY OF HONOLULU

DATE: 10/15/78

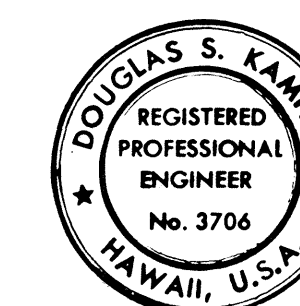


THIS WORK WAS PREPARED BY ME OR UNDER MY SUPERVISION.
[Signature]

STATE OF HAWAII
DEPARTMENT OF TRANSPORTATION
LAND TRANSPORTATION FACILITIES DIVISION


UTILITY PROFILES
WATER
KAMEHAMEHA HIGHWAY
IMPROVEMENT
(LIKELIKE HIGHWAY TO KOOLAU VIEW DRIVE)
PROJECT NO. F-083-1(10)

SCALE: AS SHOWN DATE: AUG 1978
SHEET No. 15 OF 38 SHEETS

FED. ROAD DIST. NO.	STATE	FED. AID PROJ. NO.	FISCAL YEAR	SHEET NO.	TOTAL SHEETS
HAWAII	HAW.	F-083-1(10)	1978	64	160

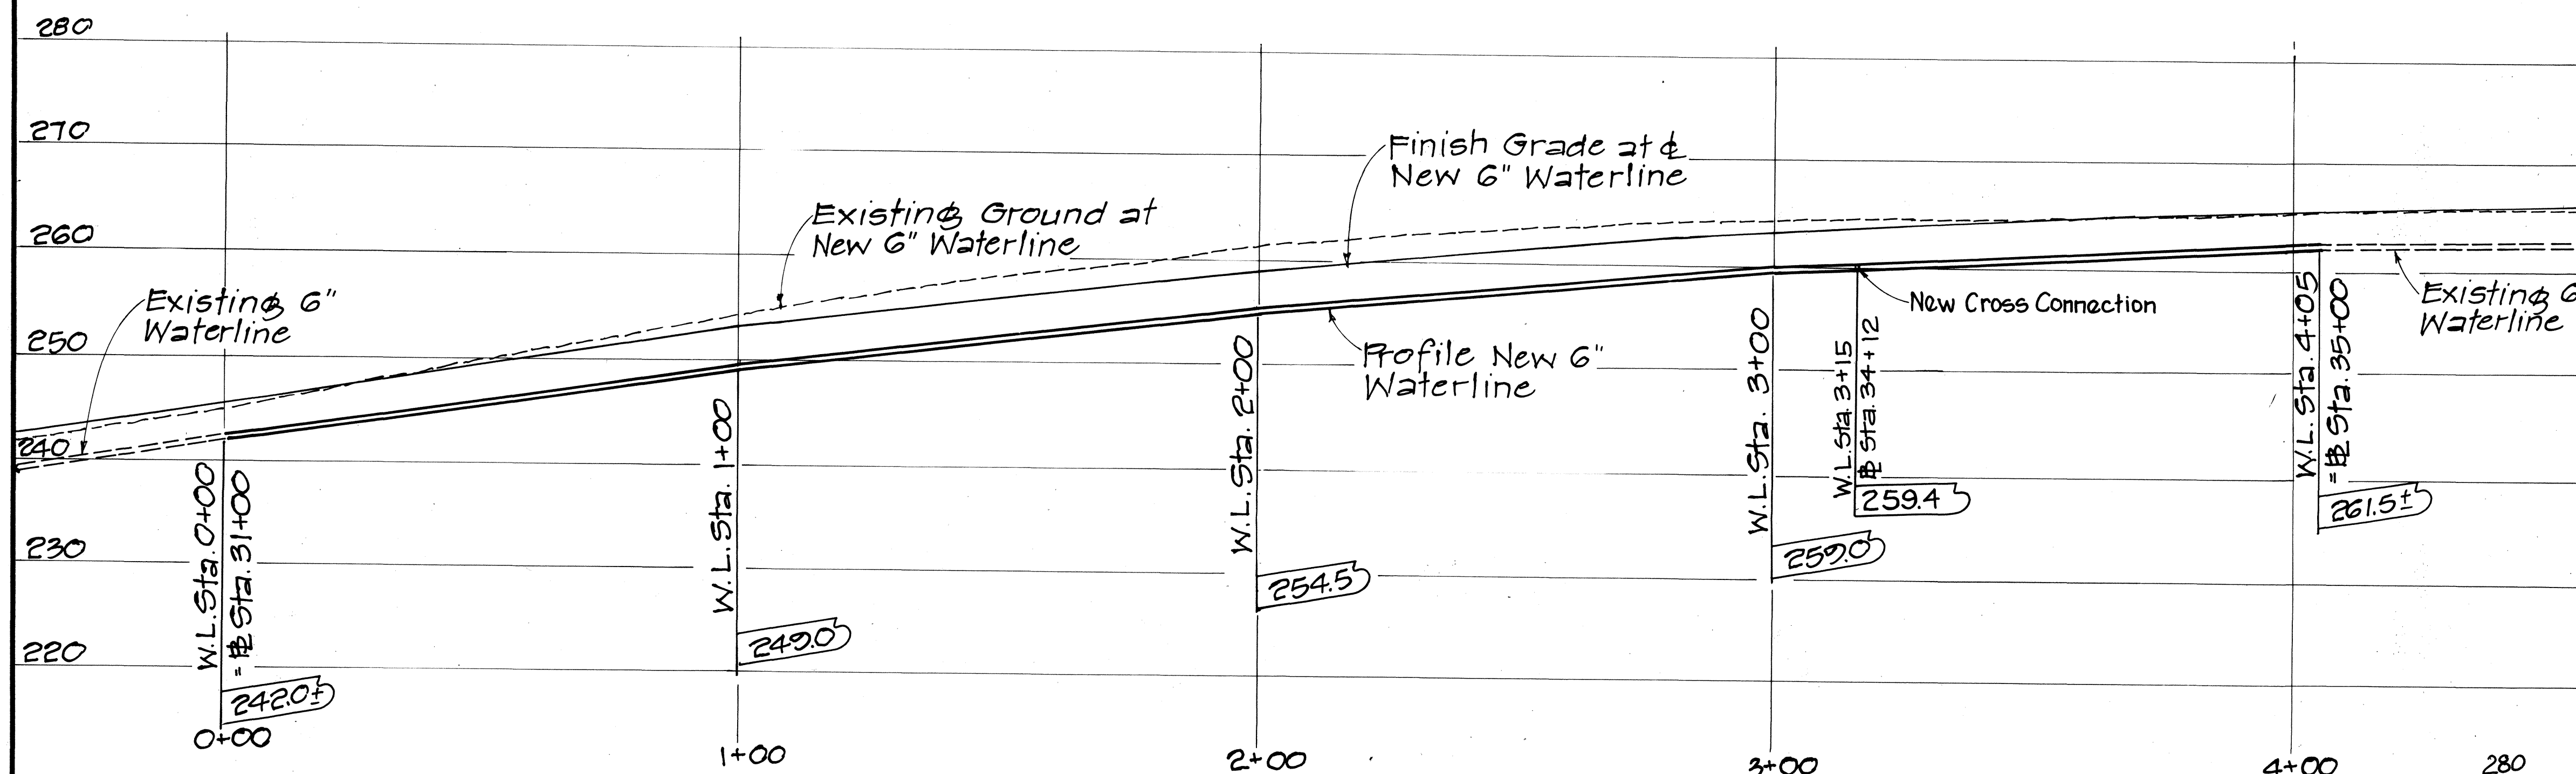

PROFILE - WATERLINE NO. 8

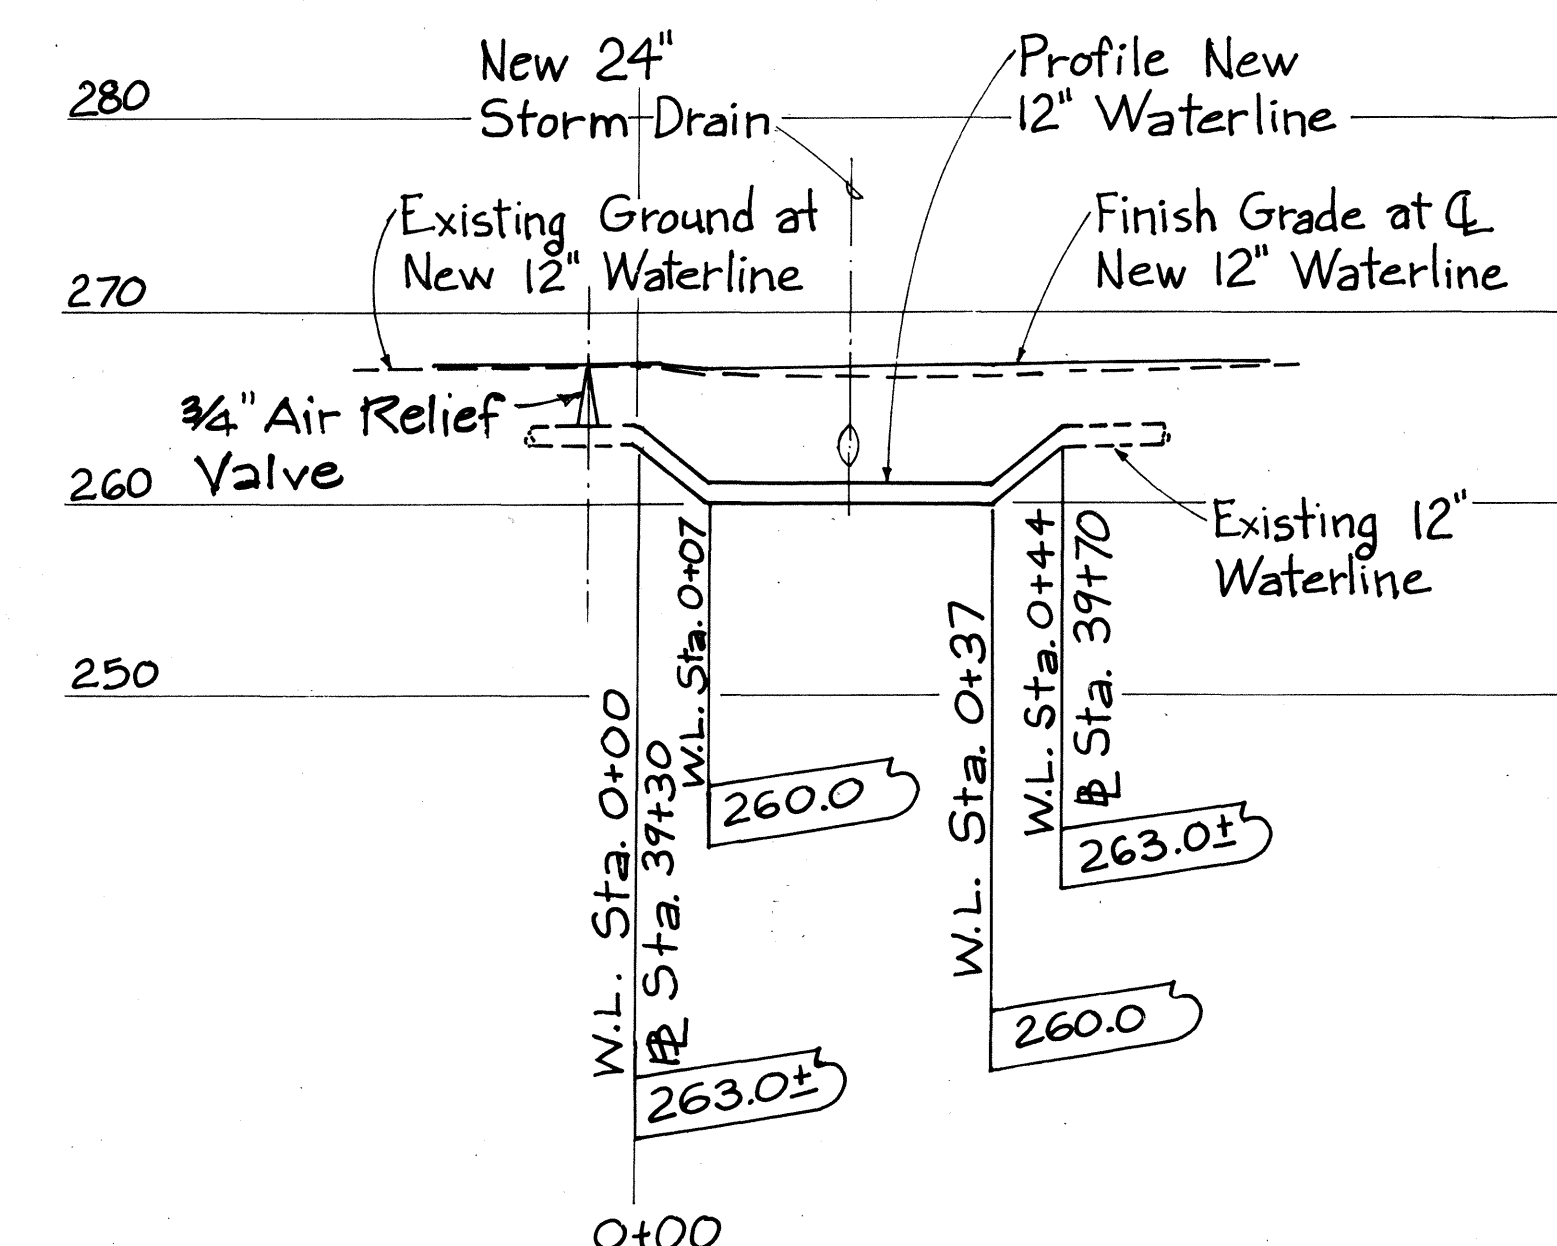


PROFILE - WATERLINE NO. 10

GRAPHIC SCALES

20 10 0 20 40 HORIZ. SCALE 1" = 20'

10 5 0 10 20 VERT. SCALE 1" = 10'

SCALE IN FEET

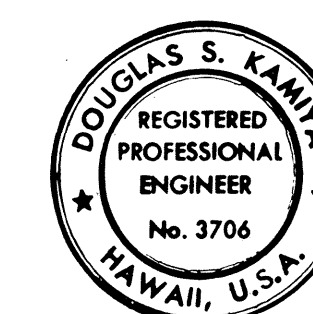


THIS WORK WAS PREPARED BY ME OR UNDER MY SUPERVISION.
Douglas S. Kama

STATE OF HAWAII
DEPARTMENT OF TRANSPORTATION
LAND TRANSPORTATION FACILITIES DIVISION

UTILITY PROFILES
WATER
KAMEHAMEHA HIGHWAY
IMPROVEMENT
(LIKELIKE HIGHWAY TO KOOLAU VIEW DRIVE)
PROJECT NO. F-083-1(10)

SCALE: AS SHOWN DATE AUG 1978
SHEET No. 16 OF 38 SHEETS

APPROVED
Arthur D. Munakami
CHIEF, PLANNING AND ENGINEERING, B.W.S. DATE 10/3/78
CITY AND COUNTY OF HONOLULU

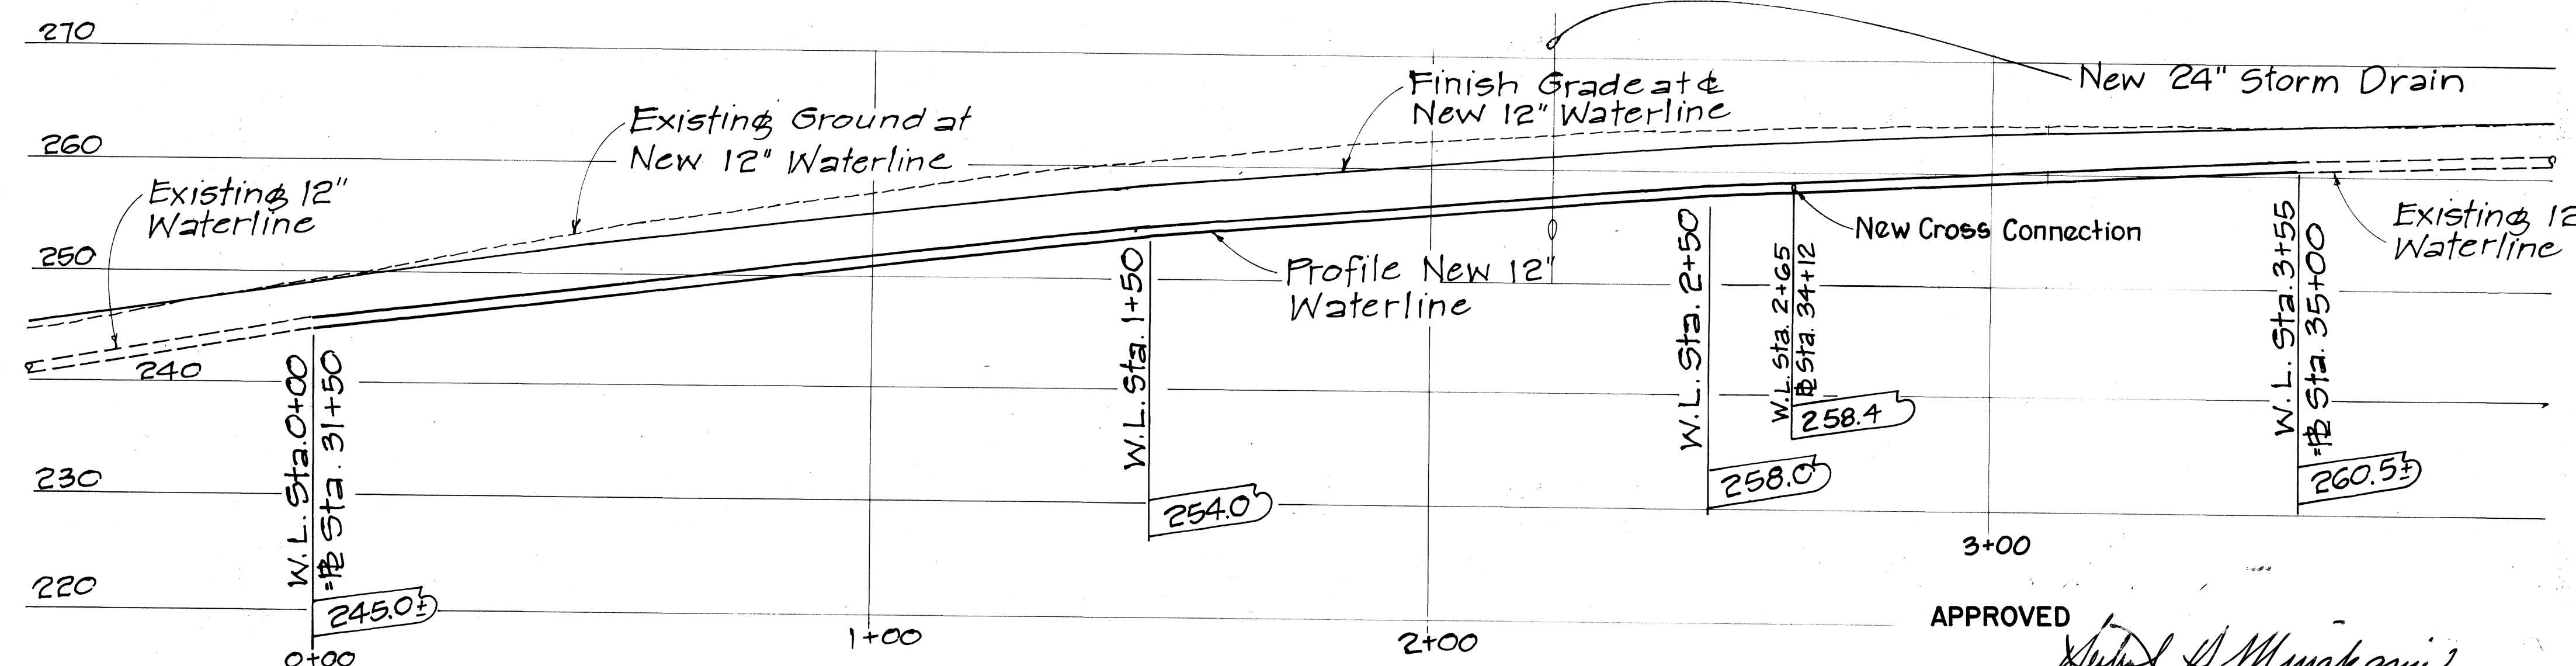


PROFILE - WATERLINE NO. 9


Connection Point moved
to Sta. 31+10 C.C.D. #15

SURVEY PLOTTED BY	DATE
DRAWN BY	
TRACED BY	
NOTED BY	
CHECKED BY	
NO.	


FED. ROAD DIST. NO.	STATE	FED. AID PROJ. NO.	FISCAL YEAR	SHEET NO.	TOTAL SHEETS
HAWAII	HAW.	F-083-1(10)	1978	65	160

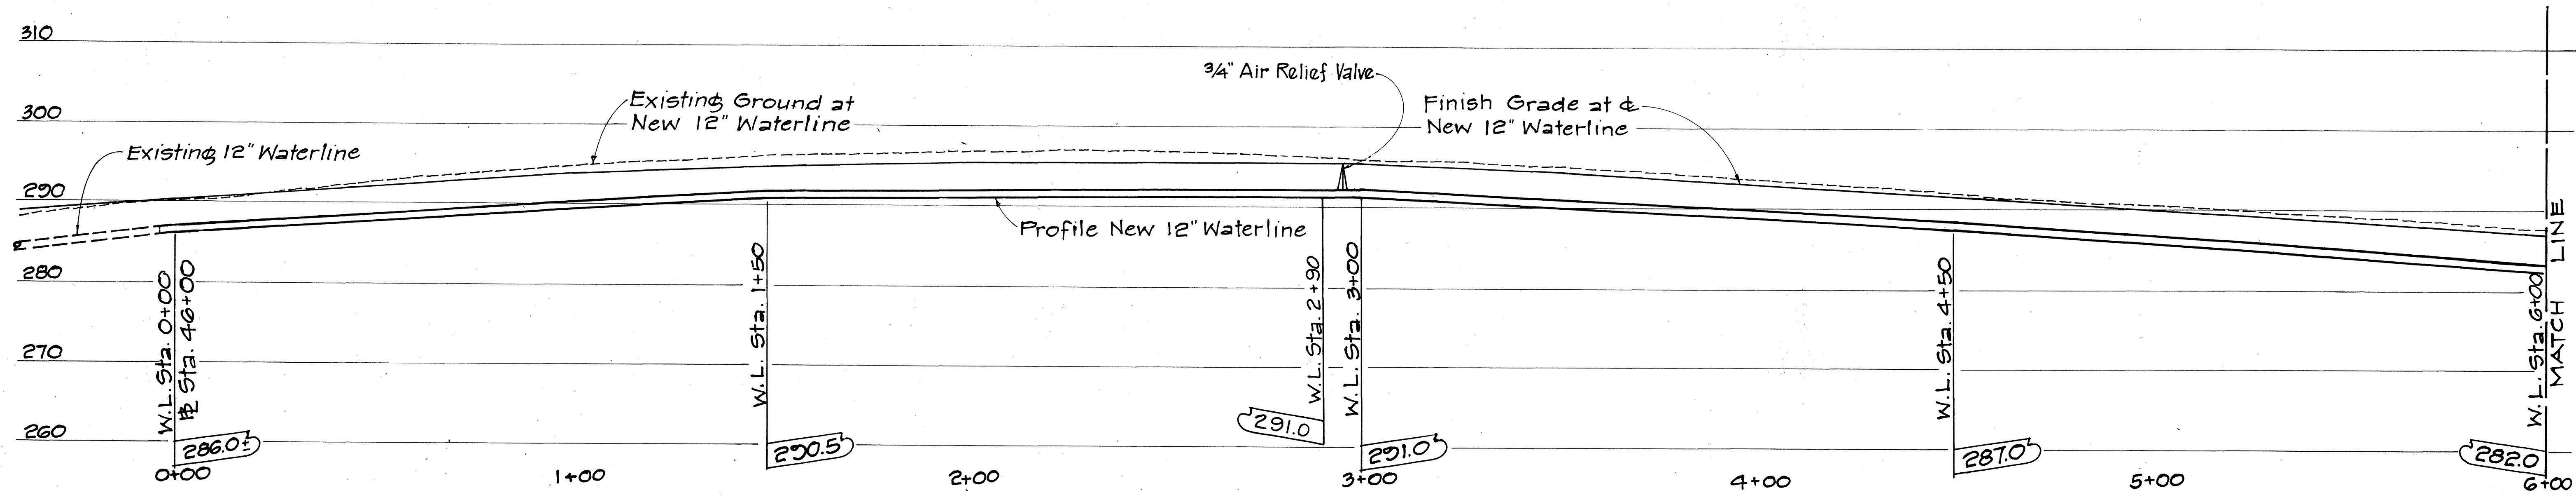



PROFILE - WATERLINE NO. 12

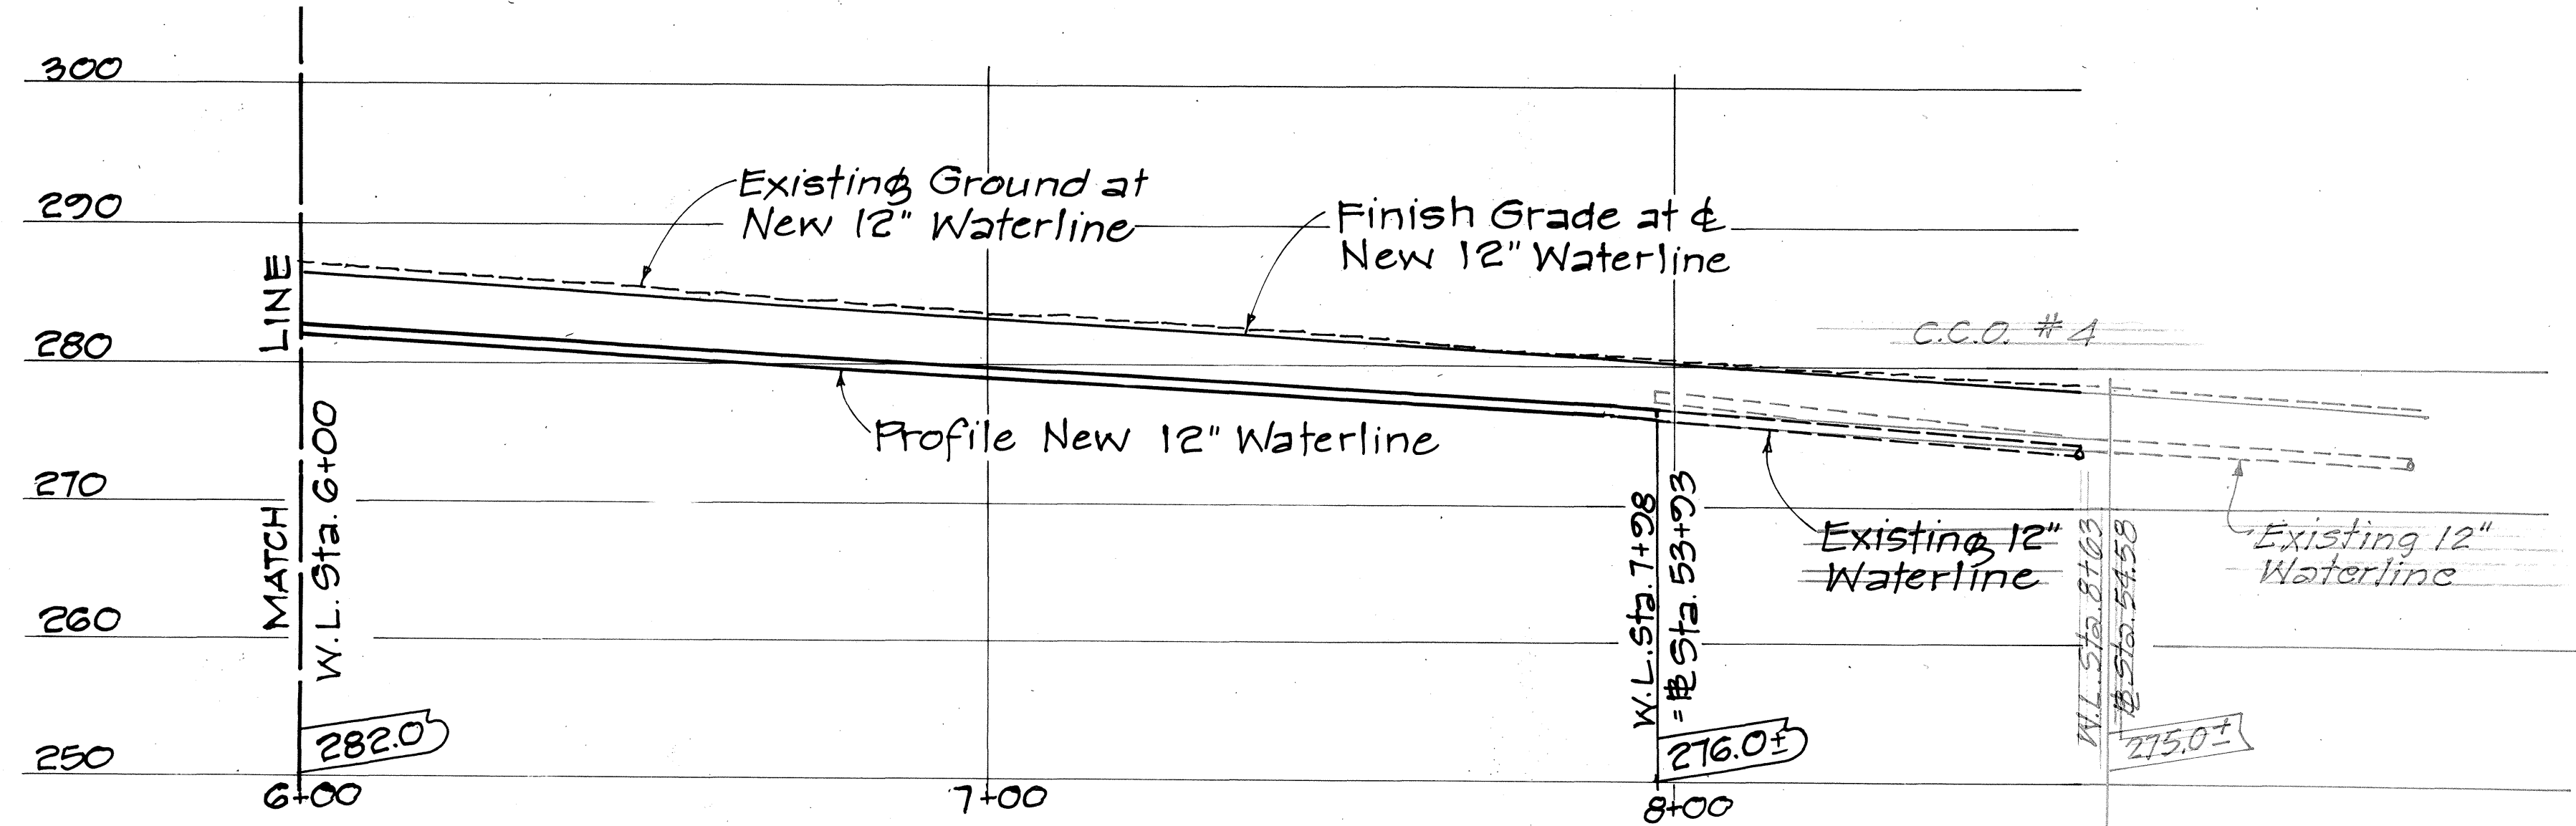

PROFILE - WATERLINE NO. 12

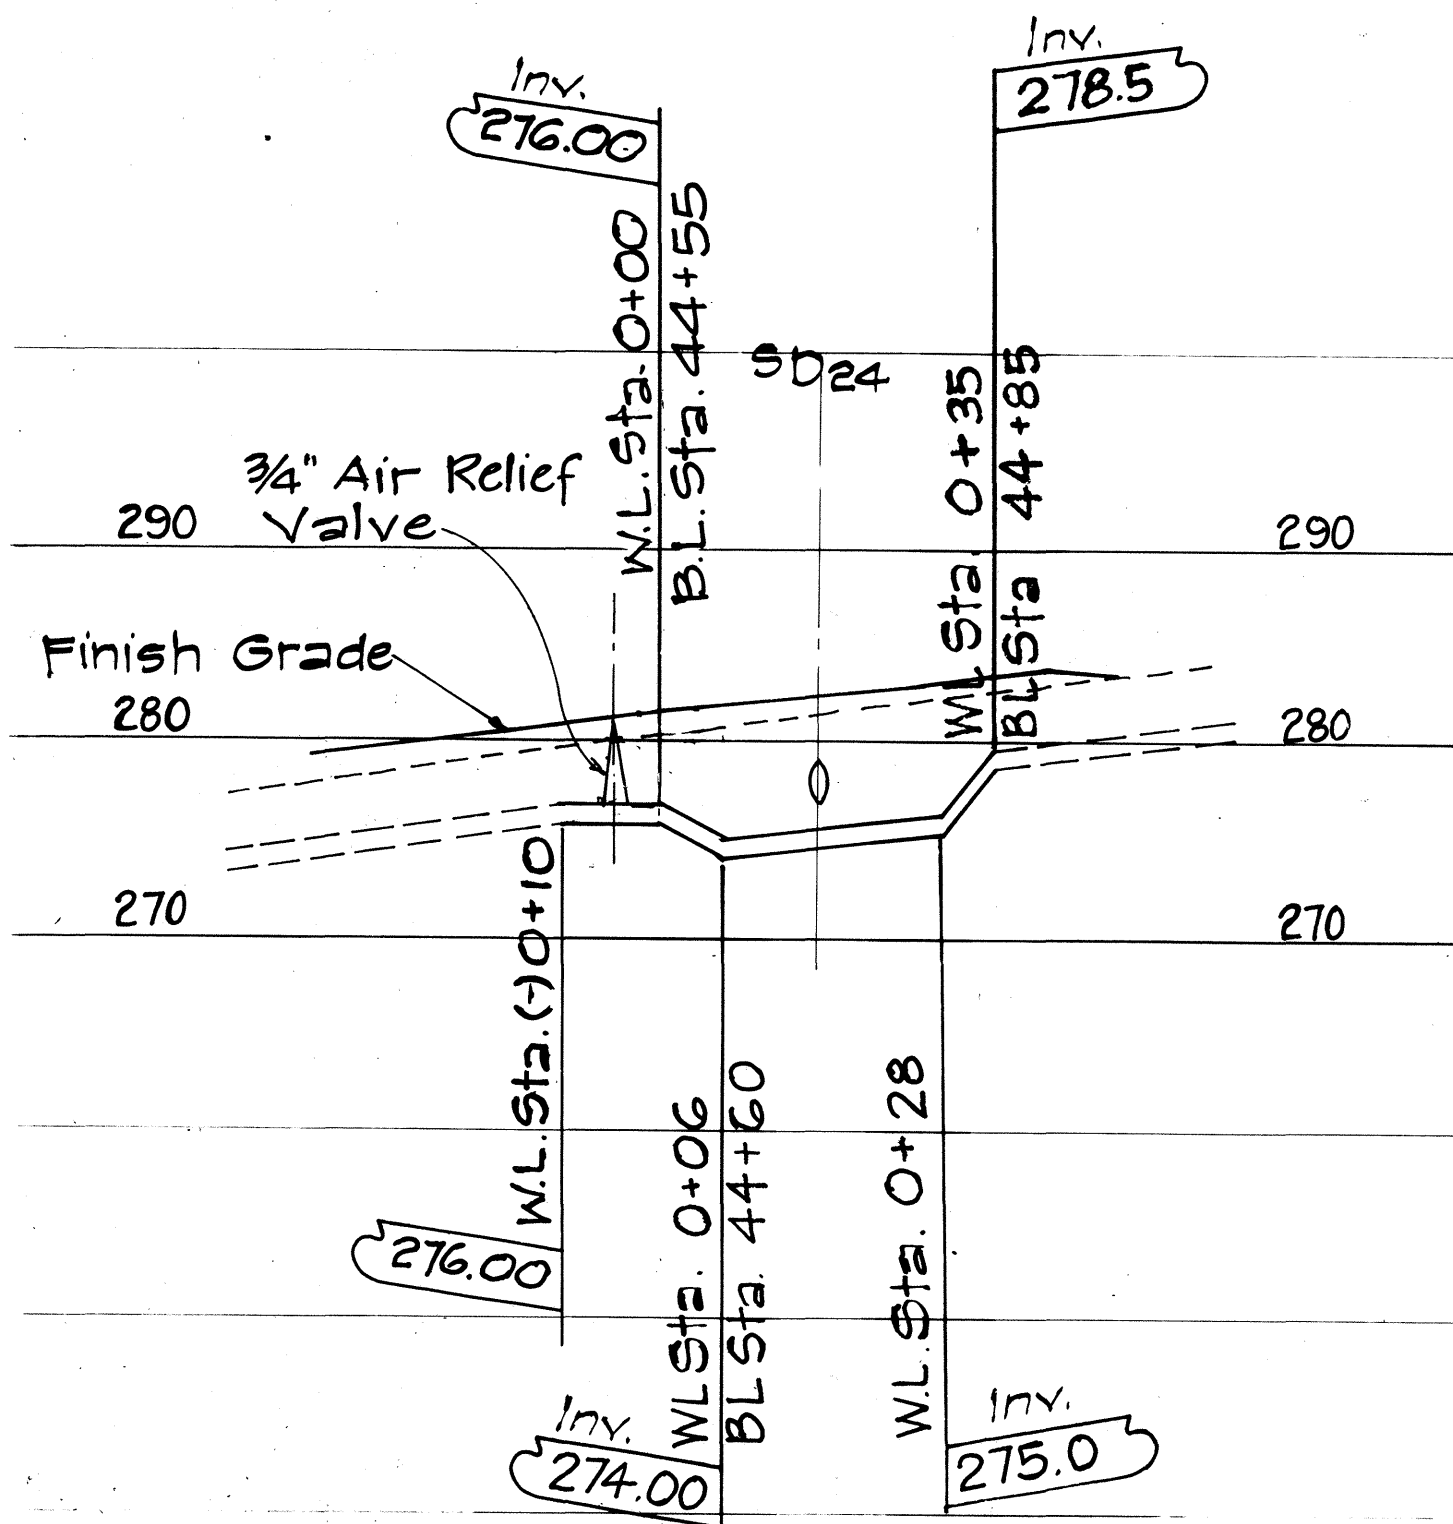

PROFILE - WATERLINE NO. 11

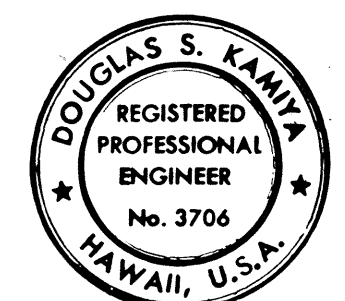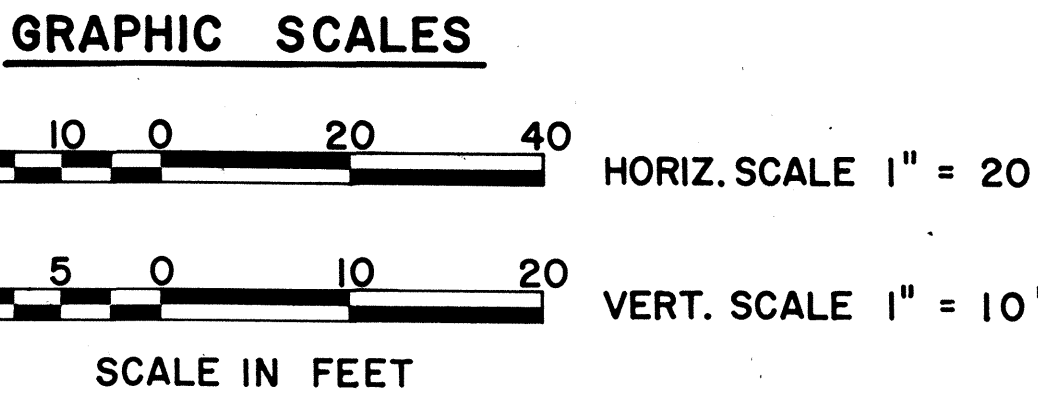

APPROVED *[Signature]* DATE 09/28/78
CHIEF, PLANNING AND ENGINEERING, B.W.S. CITY AND COUNTY OF HONOLULU

THIS WORK WAS PREPARED BY ME OR UNDER MY SUPERVISION.
[Signature]

STATE OF HAWAII
DEPARTMENT OF TRANSPORTATION
LAND TRANSPORTATION FACILITIES DIVISION


UTILITY PROFILES
WATER
KAMEHAMEHA HIGHWAY IMPROVEMENT
(LIKELIKE HIGHWAY TO KOOLAU VIEW DRIVE)
PROJECT NO. F - 083 - 1(10)

SCALE: AS SHOWN DATE AUG 1978


SHEET No. 17 OF 38 SHEETS

ORIGINAL PLAN	DATE
SURVEY PLOTTED BY	
DRAWN BY	
DESIGNED BY	
QUANTITIES BY	
CHECKED BY	
No.	


FED. ROAD DIST. NO.	STATE	FED. AID PROJ. NO.	FISCAL YEAR	SHEET NO.	TOTAL SHEETS
HAWAII	HAW.	F-083-K(10)	1978	66	160

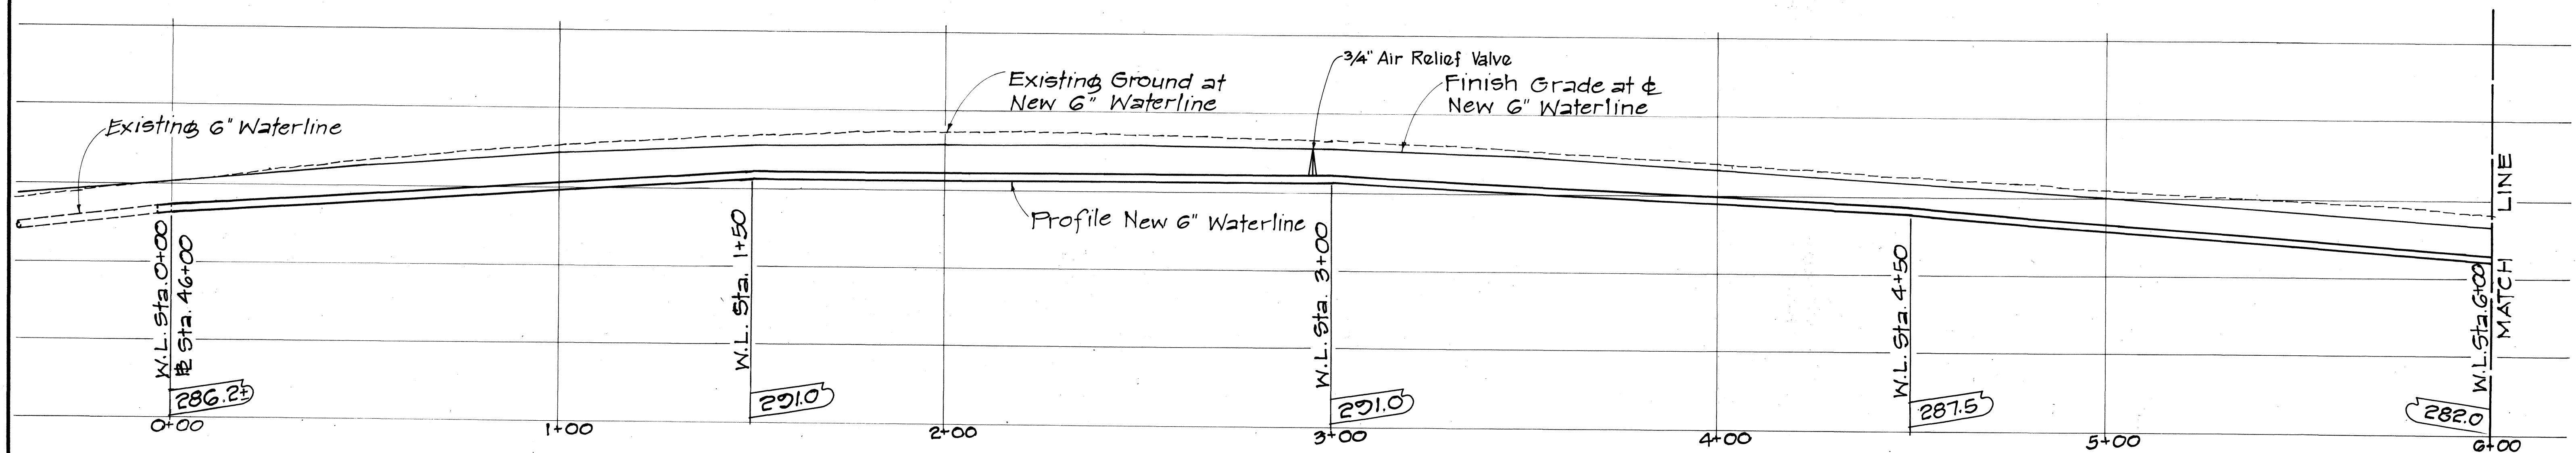

PROFILE - WATERLINE NO.13


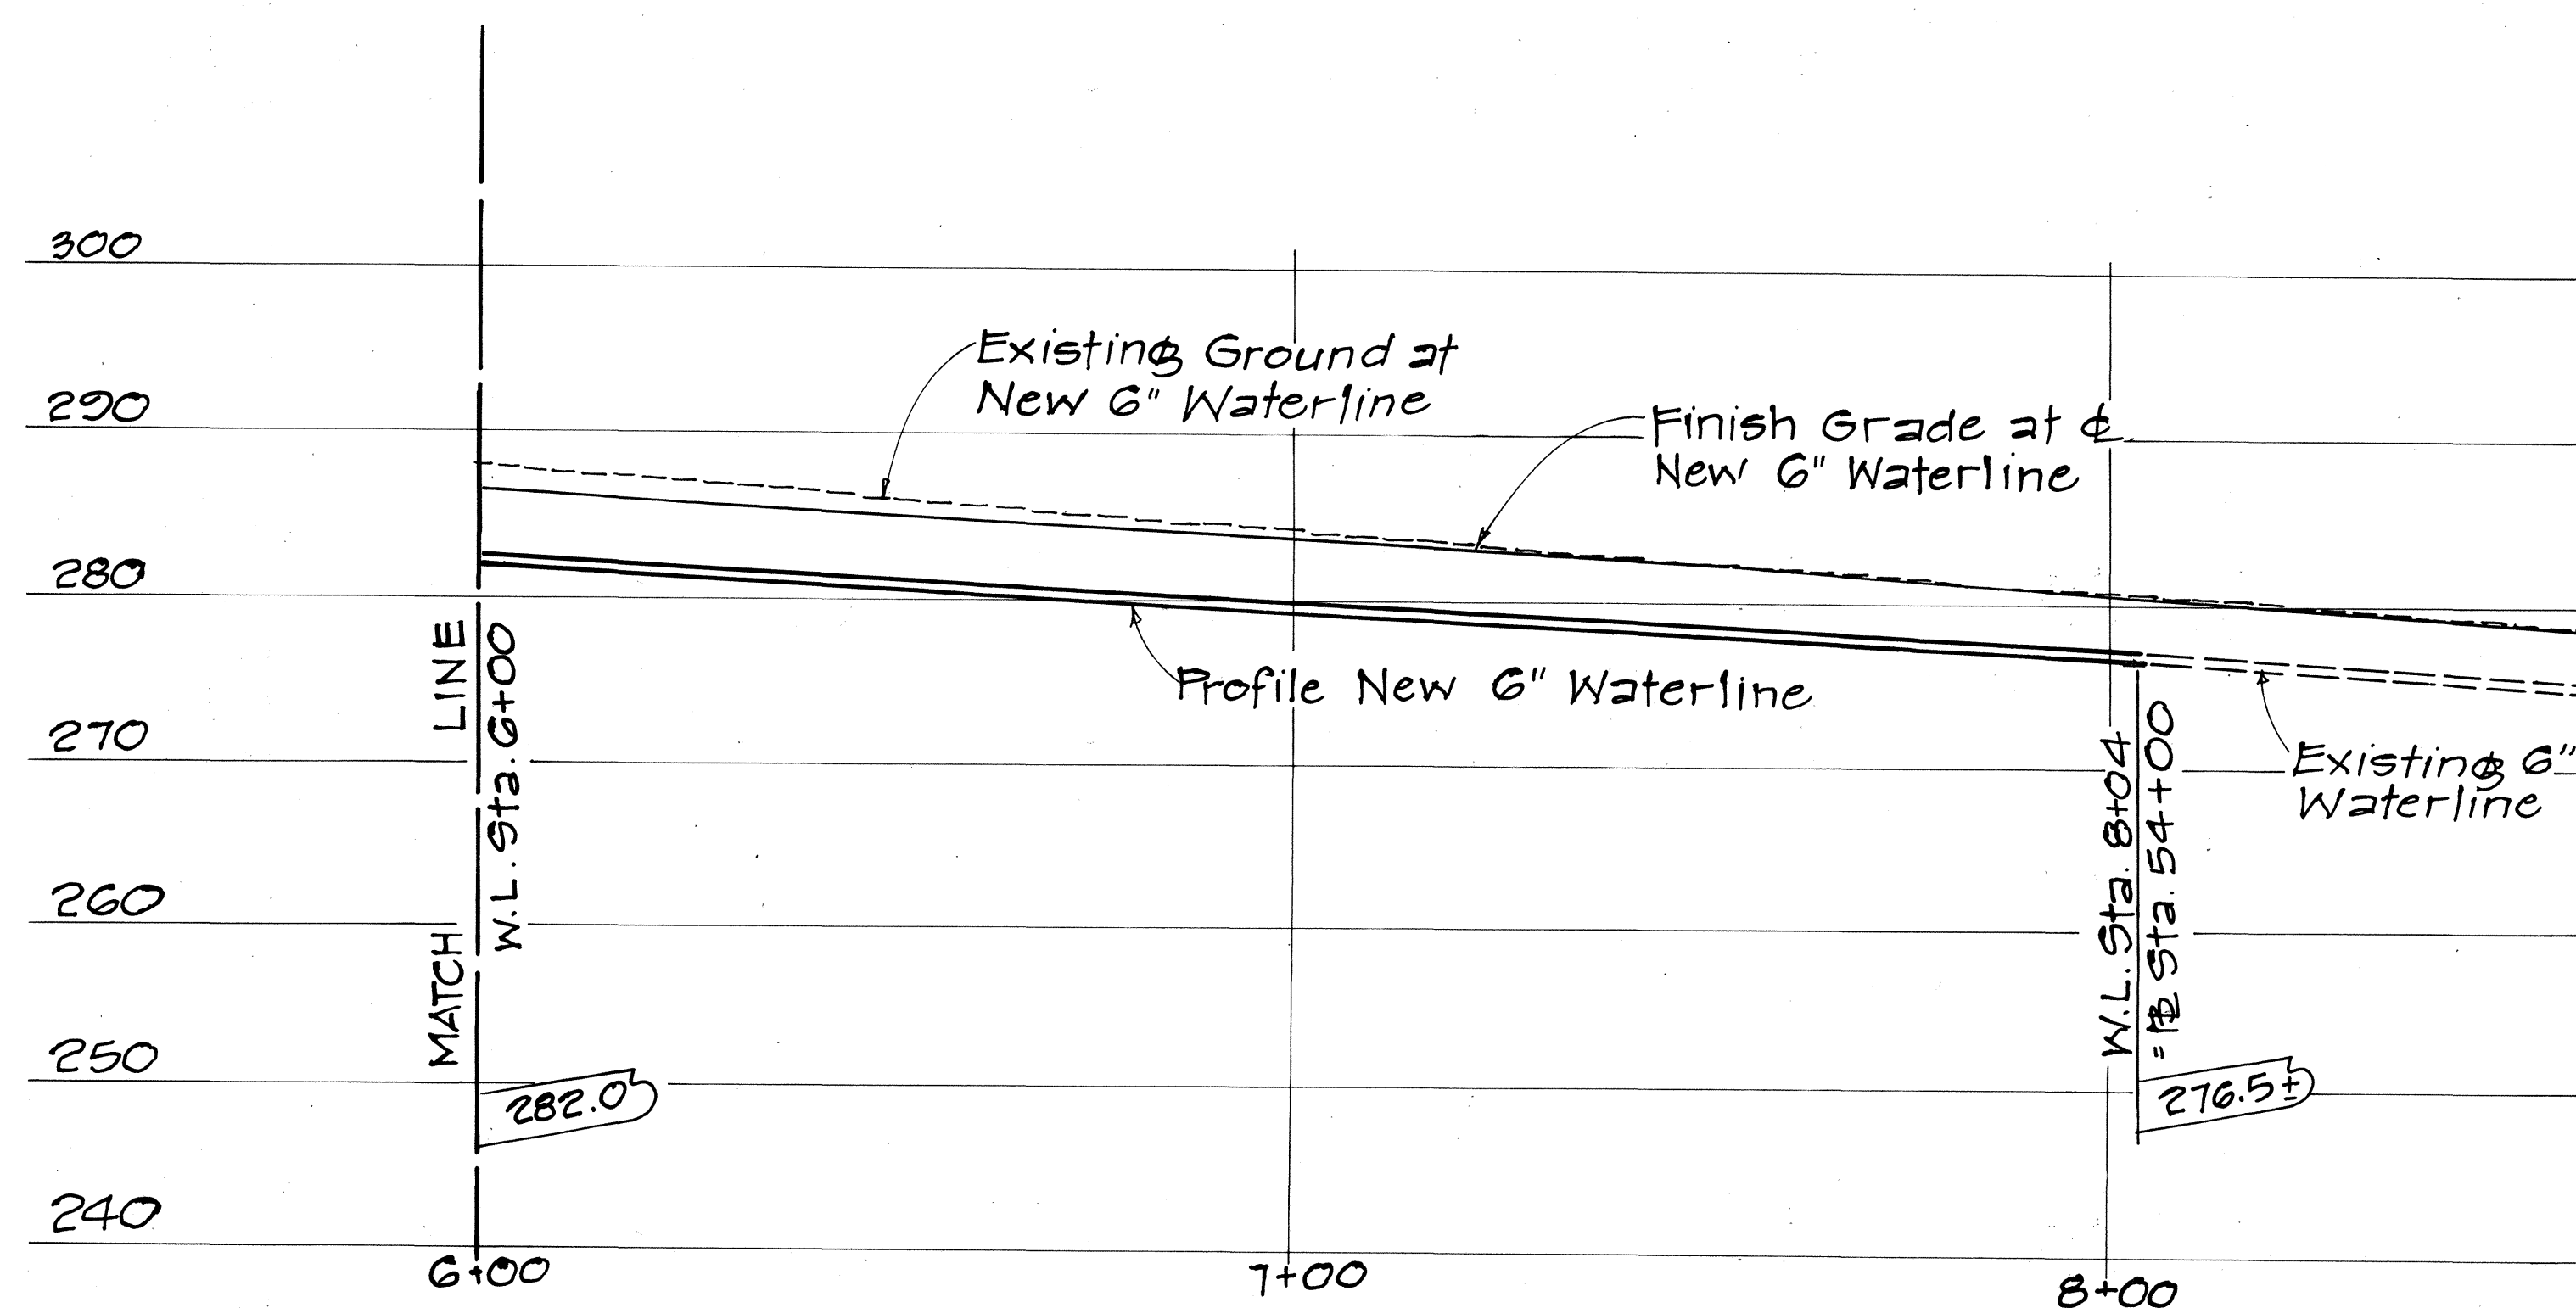


PROFILE - WATERLINE NO. 13

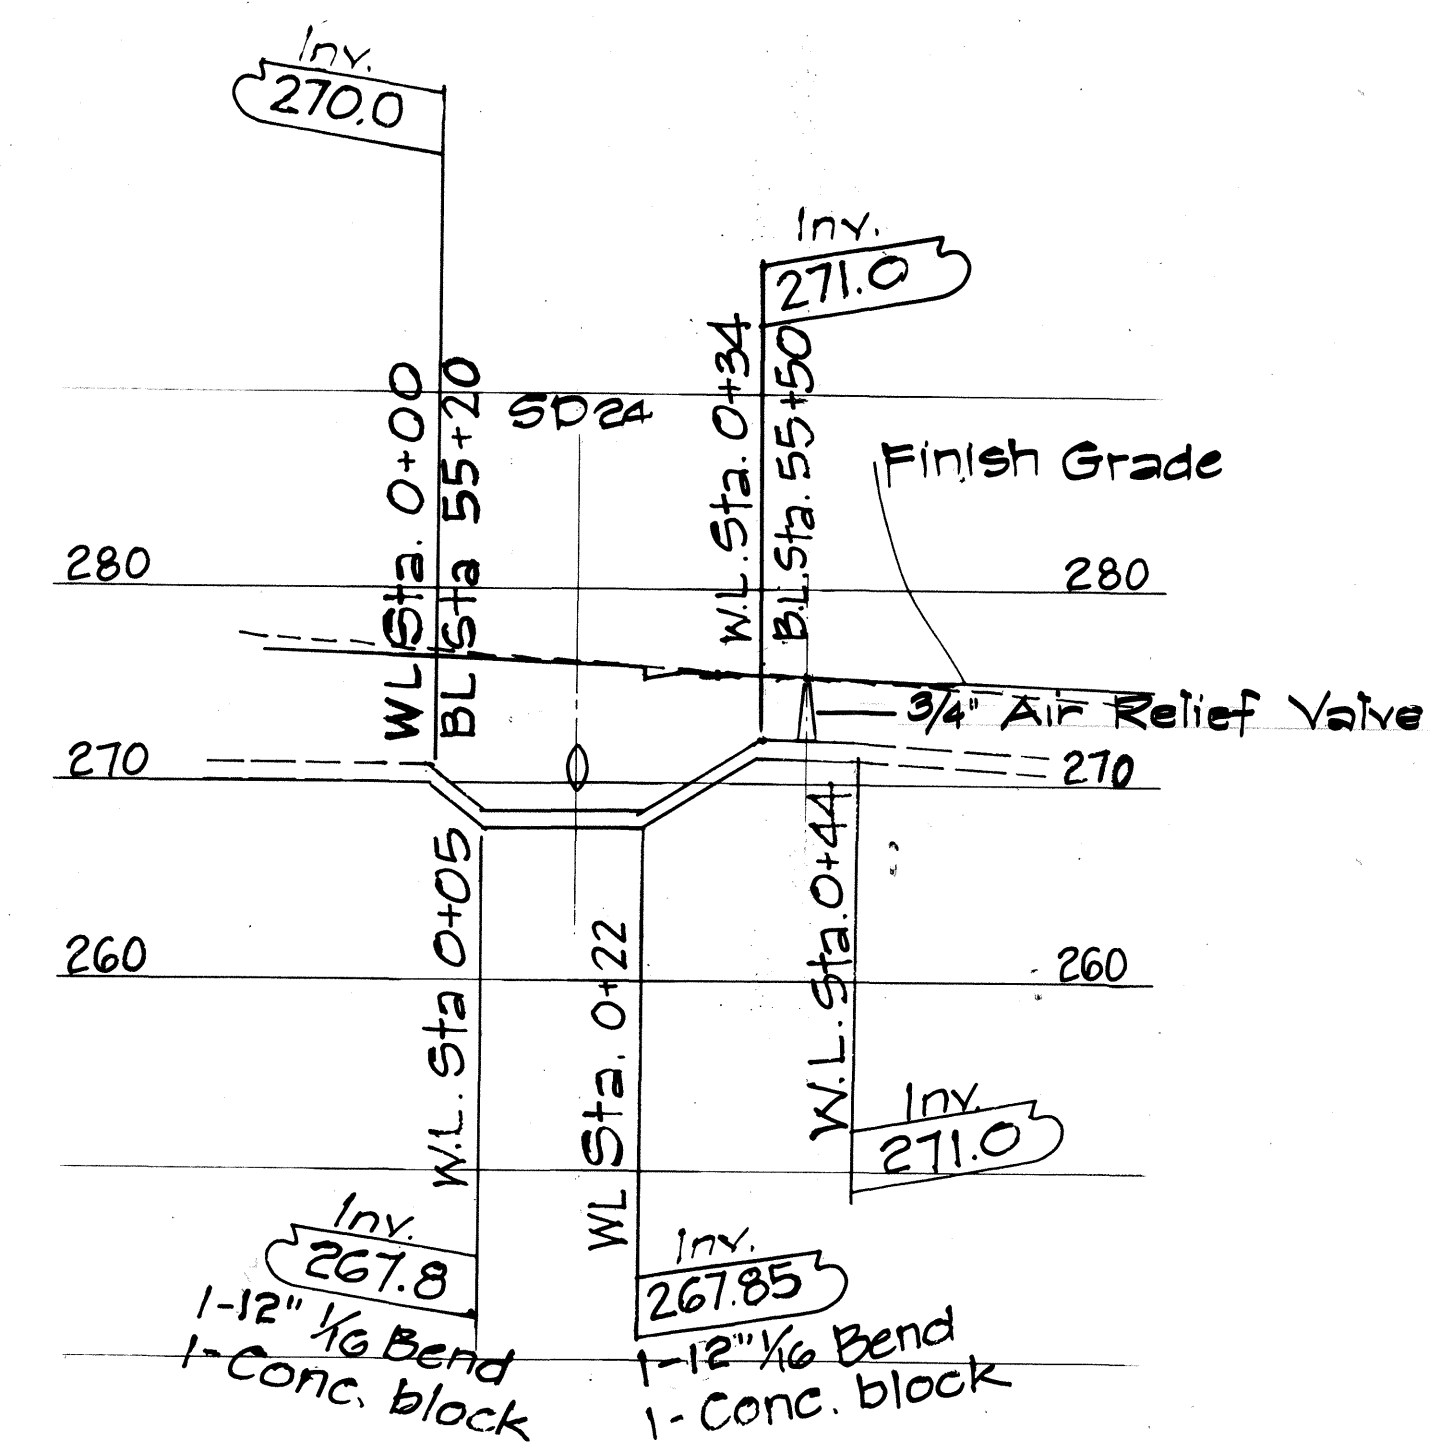


PROFILE - WATERLINE NO.14

GRAPHIC SCALES

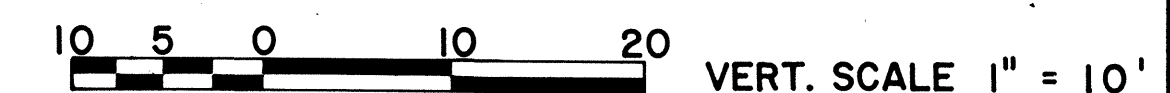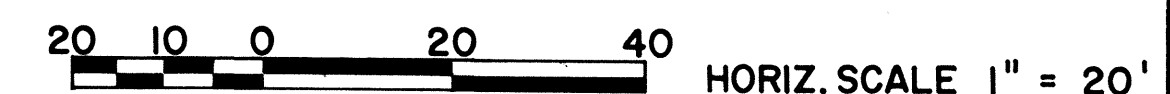

SCALE IN FEET

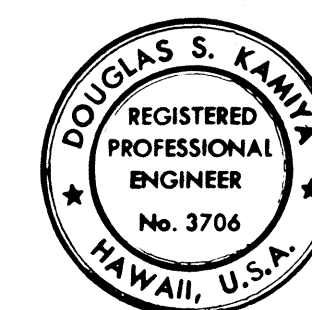

THIS WORK WAS PREPARED BY ME OR UNDER MY SUPERVISION.

Douglas S. Kamaya

STATE OF HAWAII
DEPARTMENT OF TRANSPORTATION
LAND TRANSPORTATION FACILITIES DIVISION

UTILITY PROFILES
WATER
KAMEHAMEHA HIGHWAY
IMPROVEMENT
(LIKELIKE HIGHWAY TO KOOLAU VIEW DRIVE)
PROJECT NO. F - 083 - 1(10)


SCALE : AS SHOWN DATE AUG 1978

SHEET No. 16 OF 38 SHEETS


APPROVED *Terrell S. Minabami* 10/3/11
CHIEF, PLANNING AND ENGINEERING, B.W.S. *gn* DATE
CITY AND COUNTY OF HONOLULU

ORIGINAL PLAN	SURVEY PLOTTED BY _____ DATE _____
NOTE BOOK	DRAWN BY _____
	TRACED BY _____
	DESIGNED BY _____
	QUANTITIES BY _____
No. _____	CHECKED BY _____


FED. ROAD DIST. NO.	STATE	FED. AID PROJ. NO.	FISCAL YEAR	SHEET NO.	TOTAL SHEETS
HAWAII	HAW.	F-083-1(10)	1978	67	160

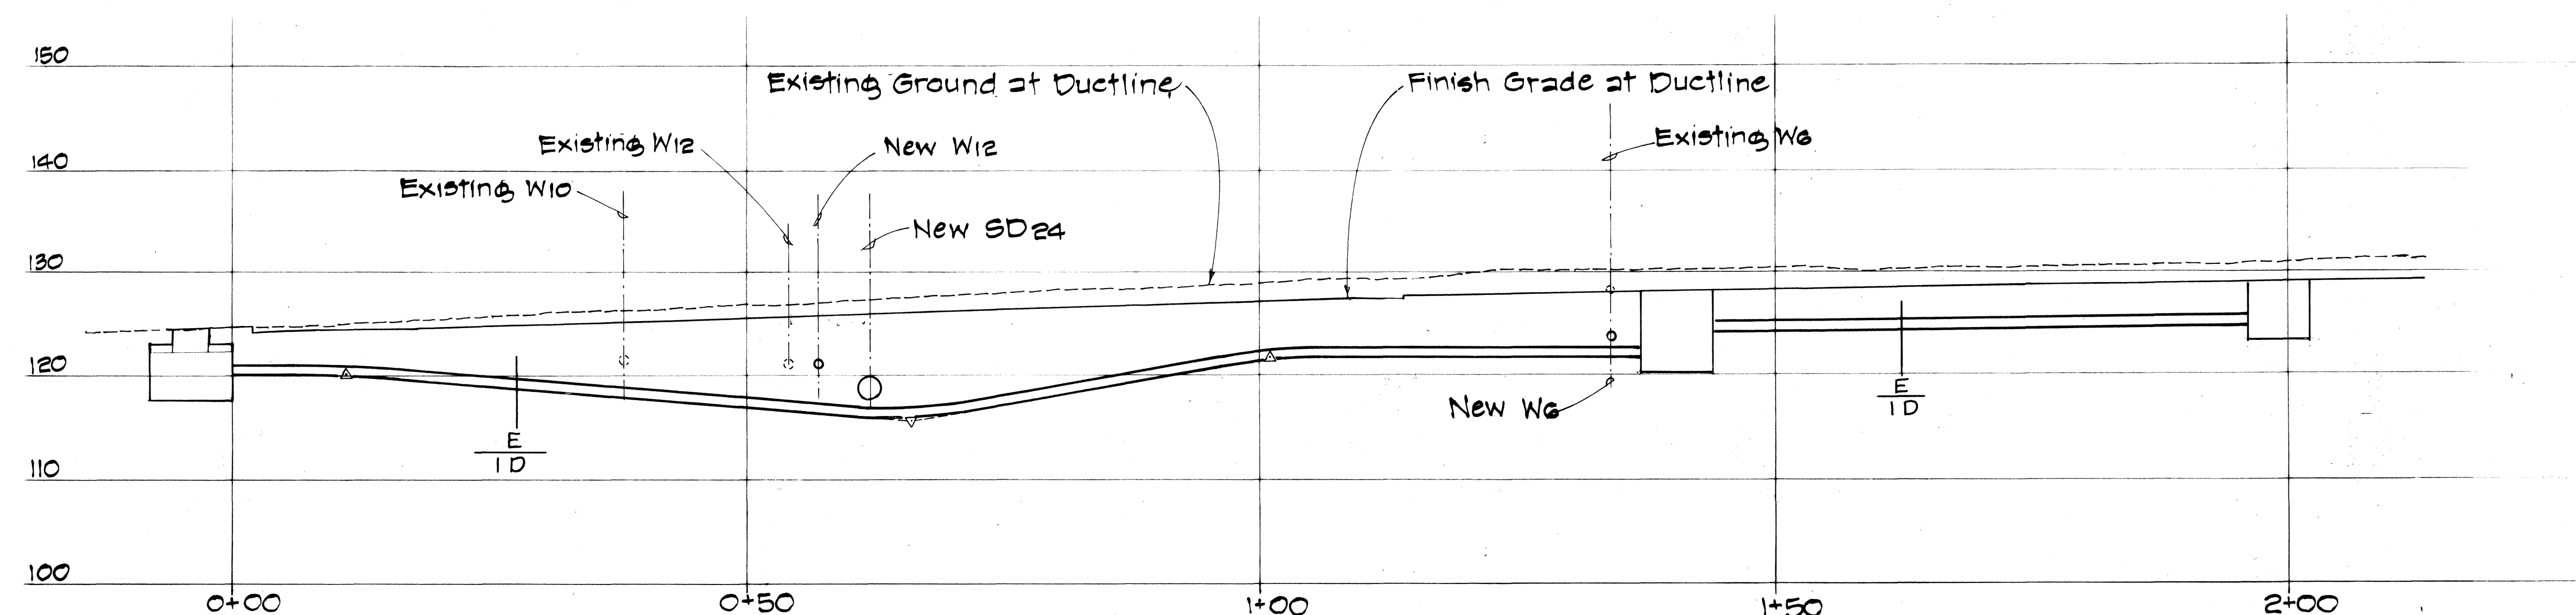

HECO DUCTLINE AT STA. 3+30 TO STA. 5+24

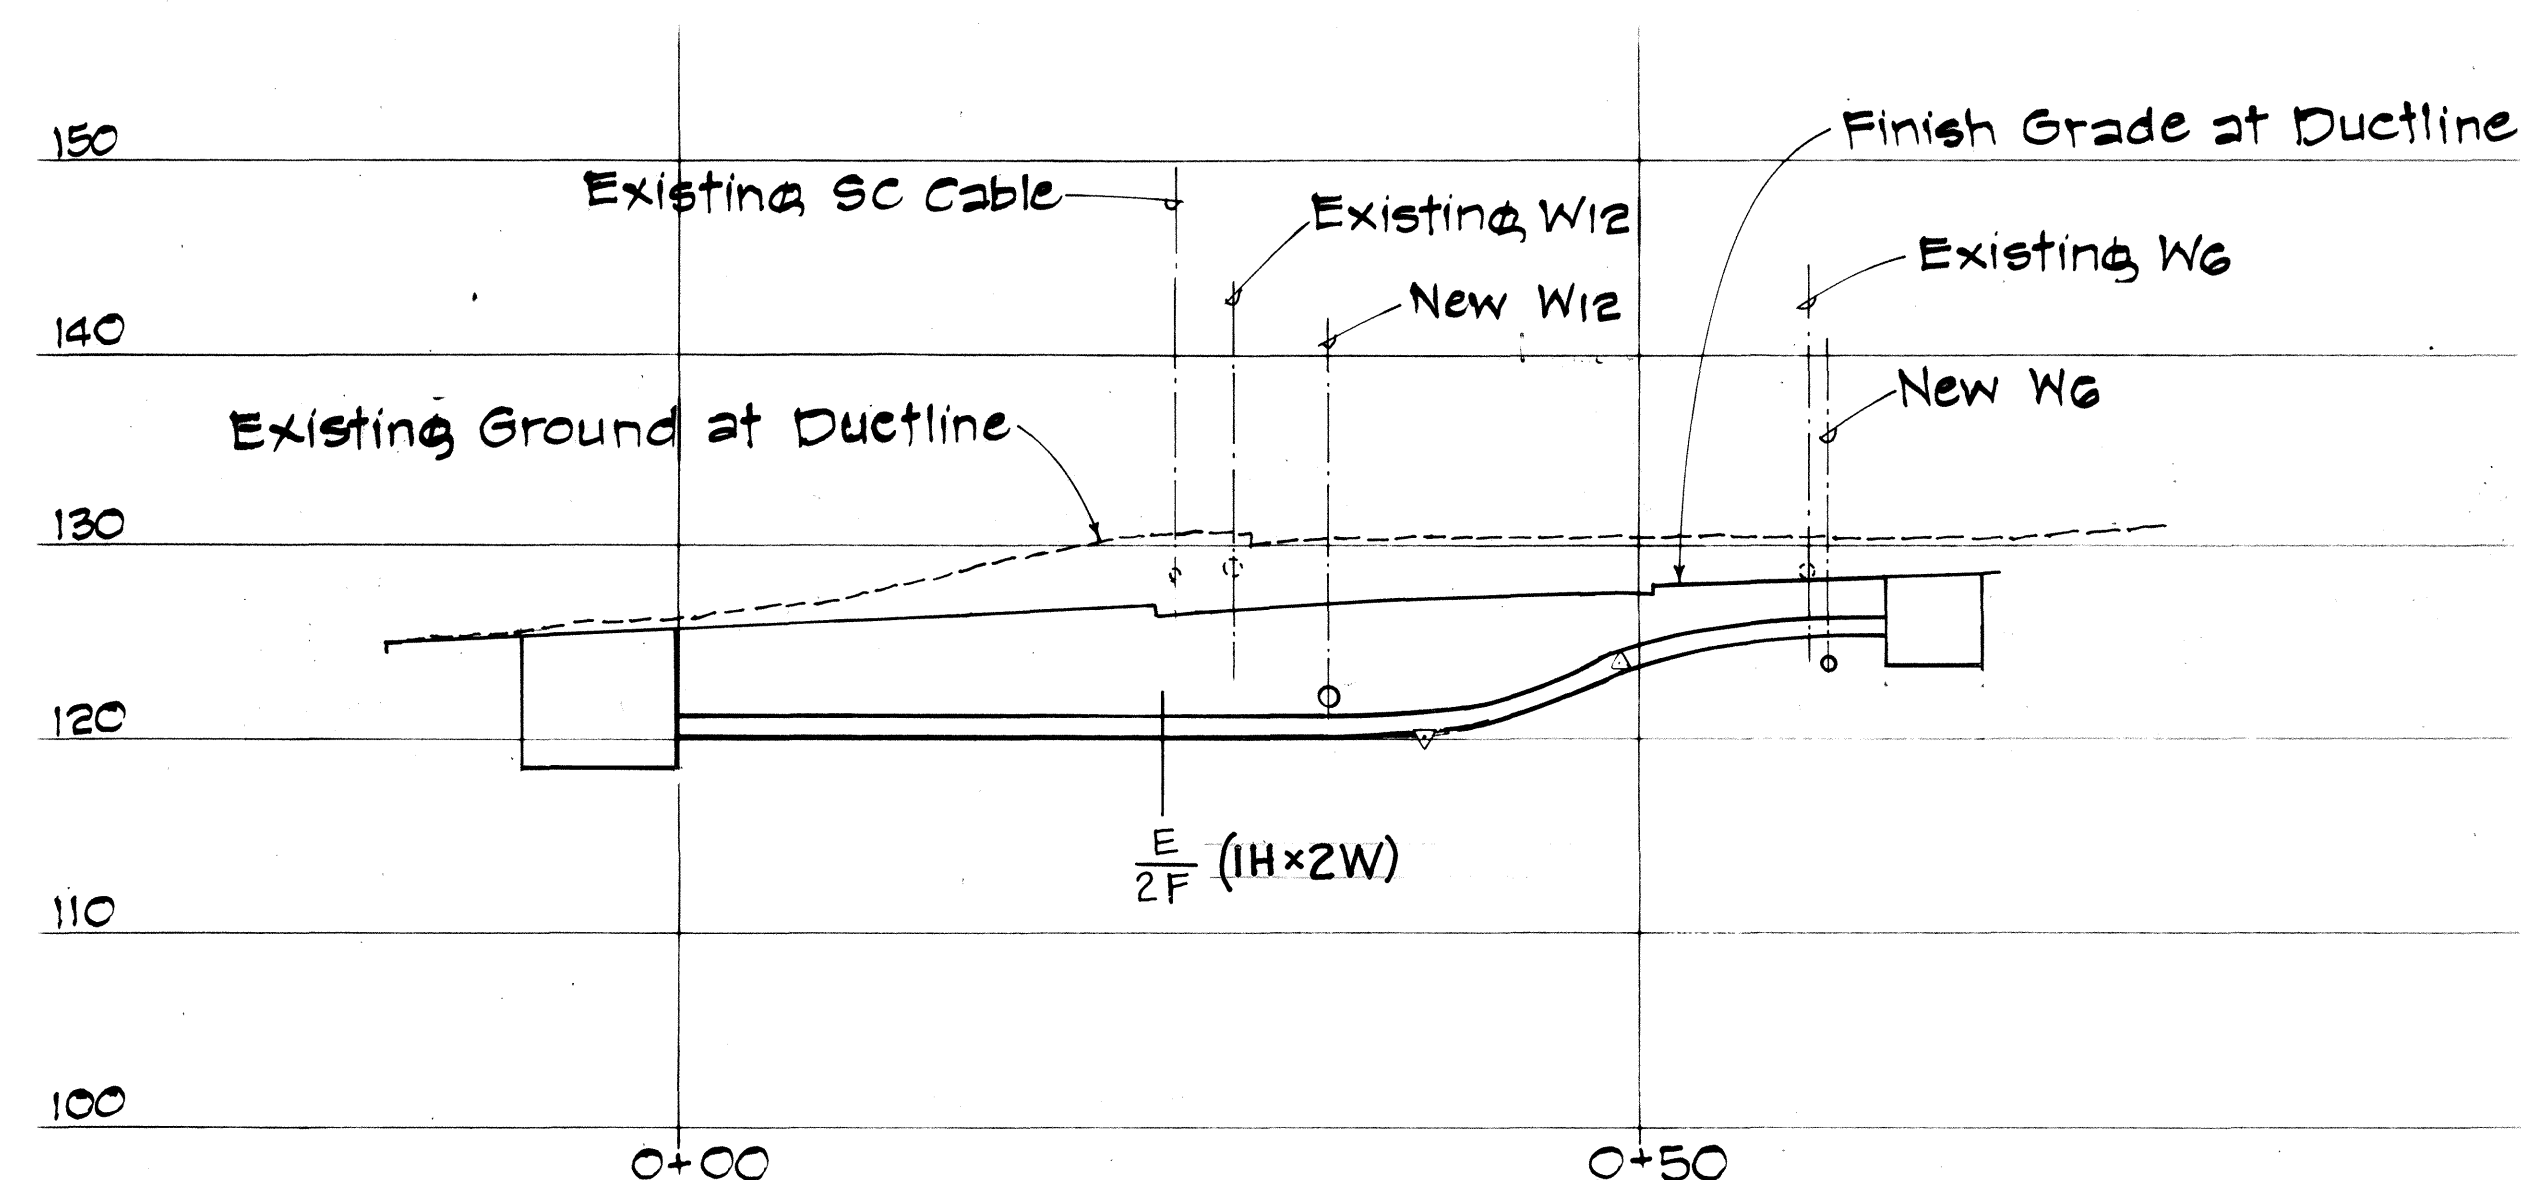

HECO DUCTLINE AT STA. 4+84 TO STA. 4+67

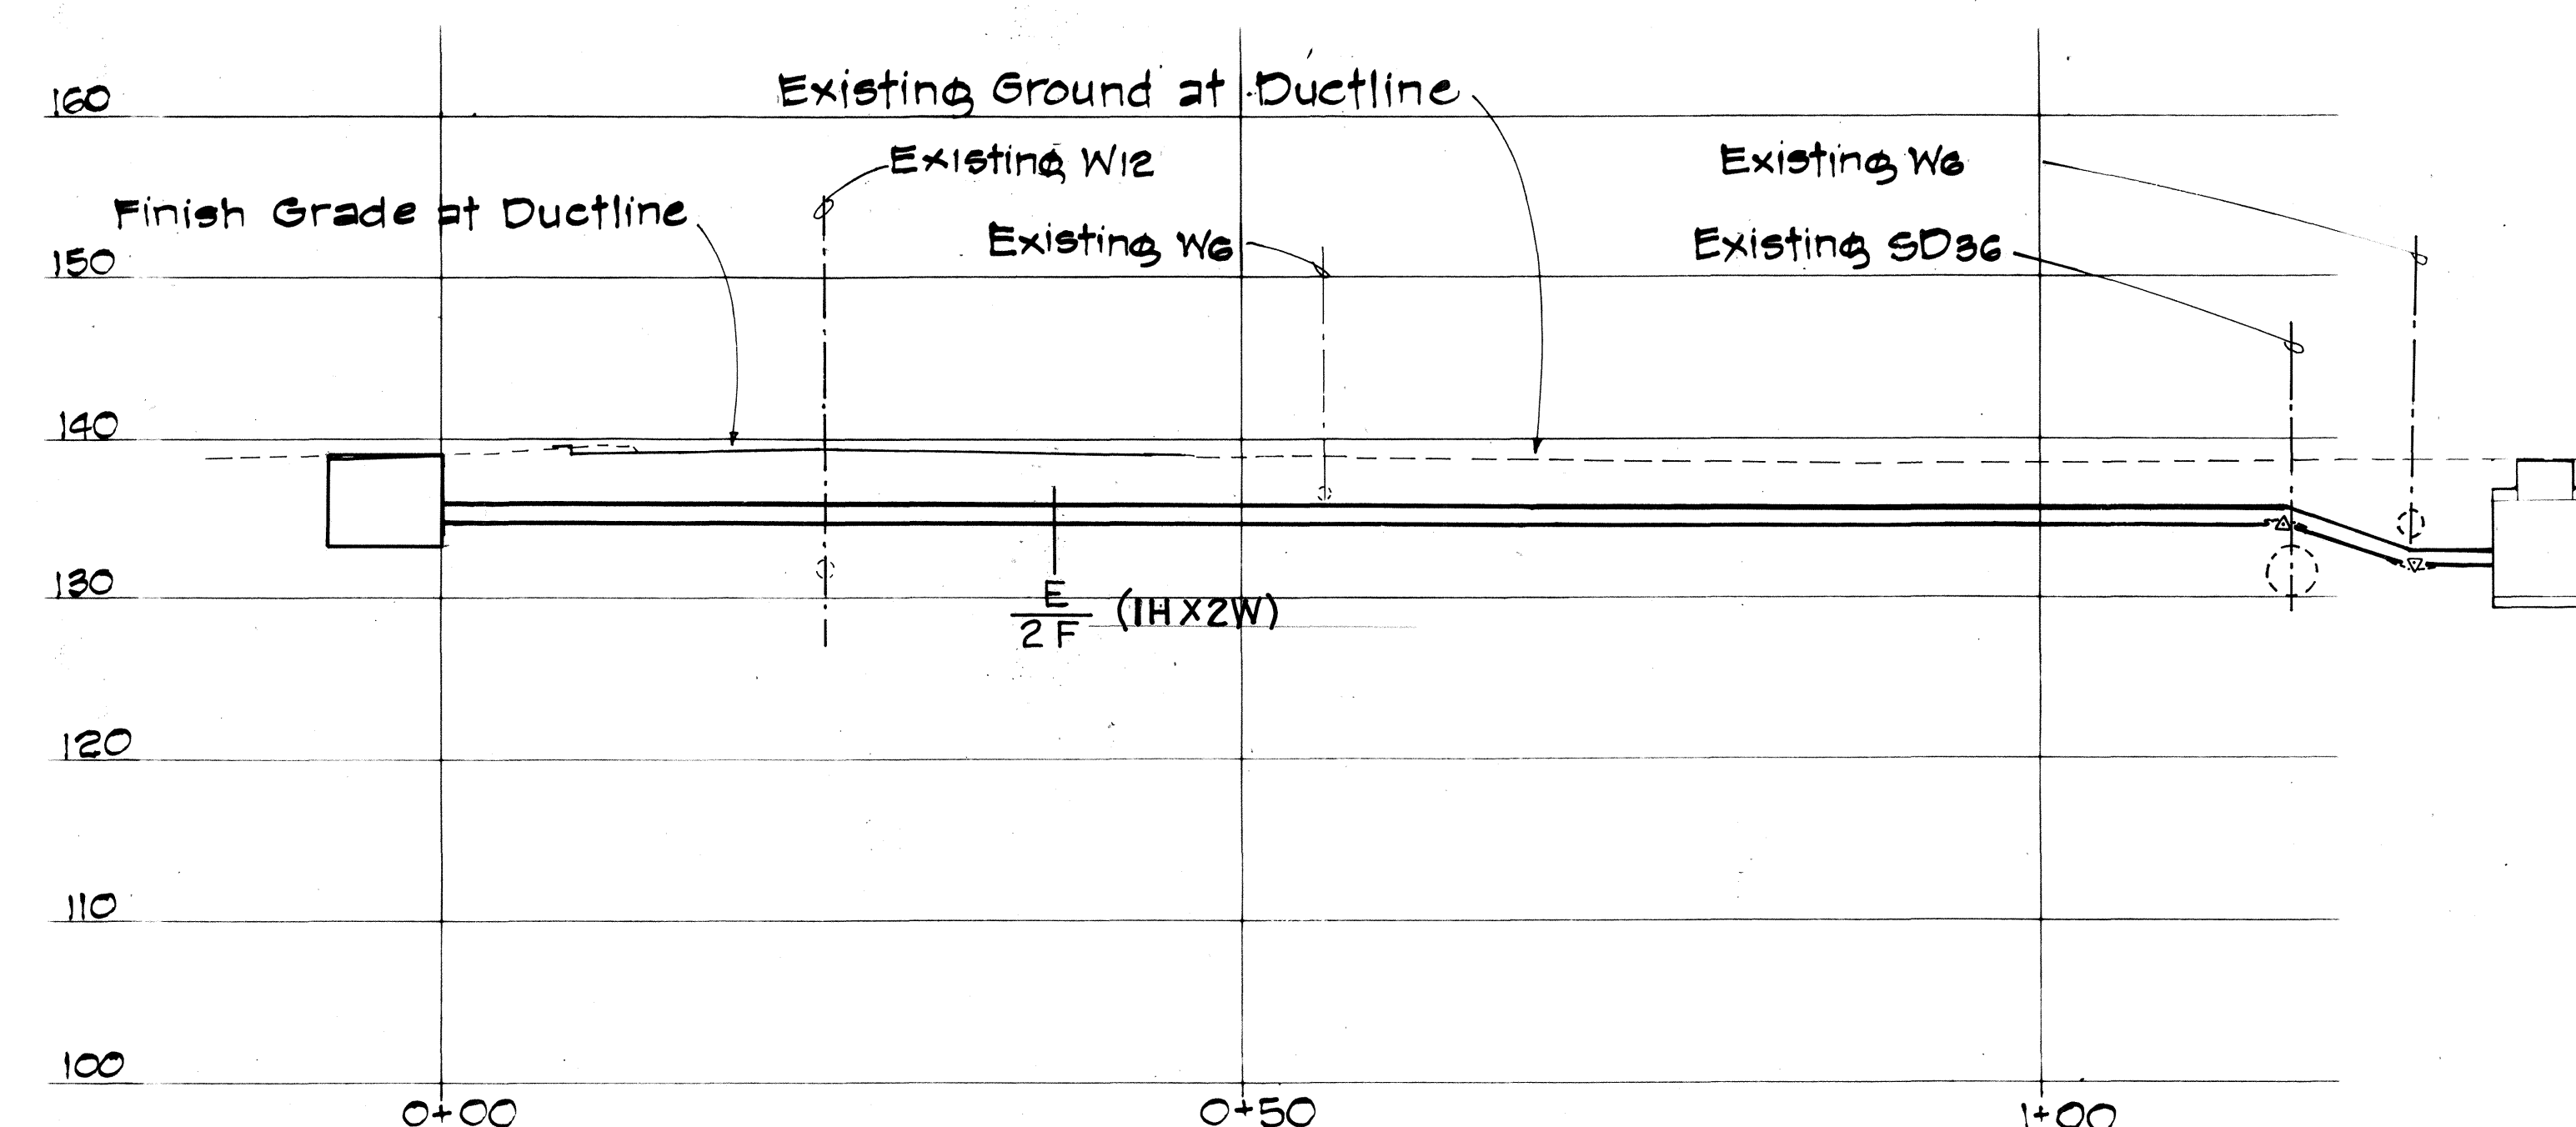


HECO DUCTLINE AT LULUKU ROAD

LEGEND FOR CONDUIT


CONDUIT SIZE	SYMBOL
3"	D
4"	F
5"	H

GRAPHIC SCALES

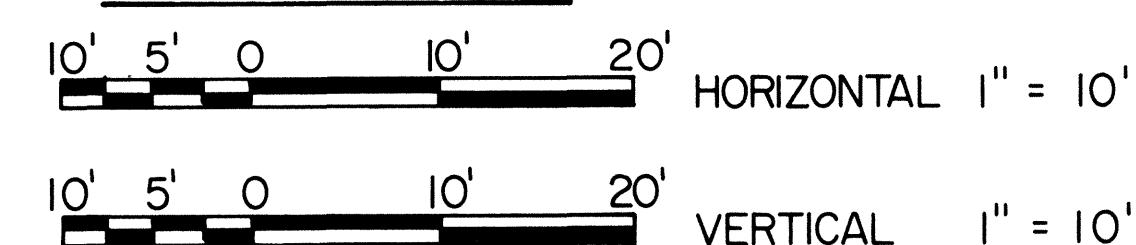

APPROVED
[Signature]
 HAWAIIAN ELECTRIC COMPANY


9/14/78
 DATE

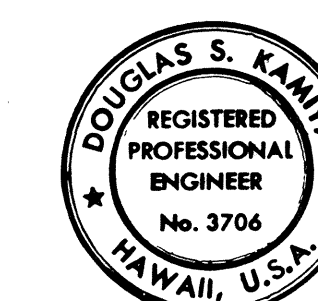


THIS WORK WAS PREPARED BY ME OR UNDER MY SUPERVISION.
[Signature]

STATE OF HAWAII
 DEPARTMENT OF TRANSPORTATION
 LAND TRANSPORTATION FACILITIES DIVISION
ELECTRICAL & TELEPHONE PROFILES
KAMEHAMEHA HIGHWAY IMPROVEMENT
 (LIKELIKE HIGHWAY TO KOOLAU VIEW DRIVE)
 PROJECT NO. F-083-1(10)
 SCALE: AS SHOWN DATE AUG 1978
 SHEET No. 19 OF 38 SHEETS


FED. ROAD DIST. NO.	STATE	FED. AID PROJ. NO.	FISCAL YEAR	SHEET NO.	TOTAL SHEETS
HAWAII	HAW.	F-083- (10)	1978	68	160

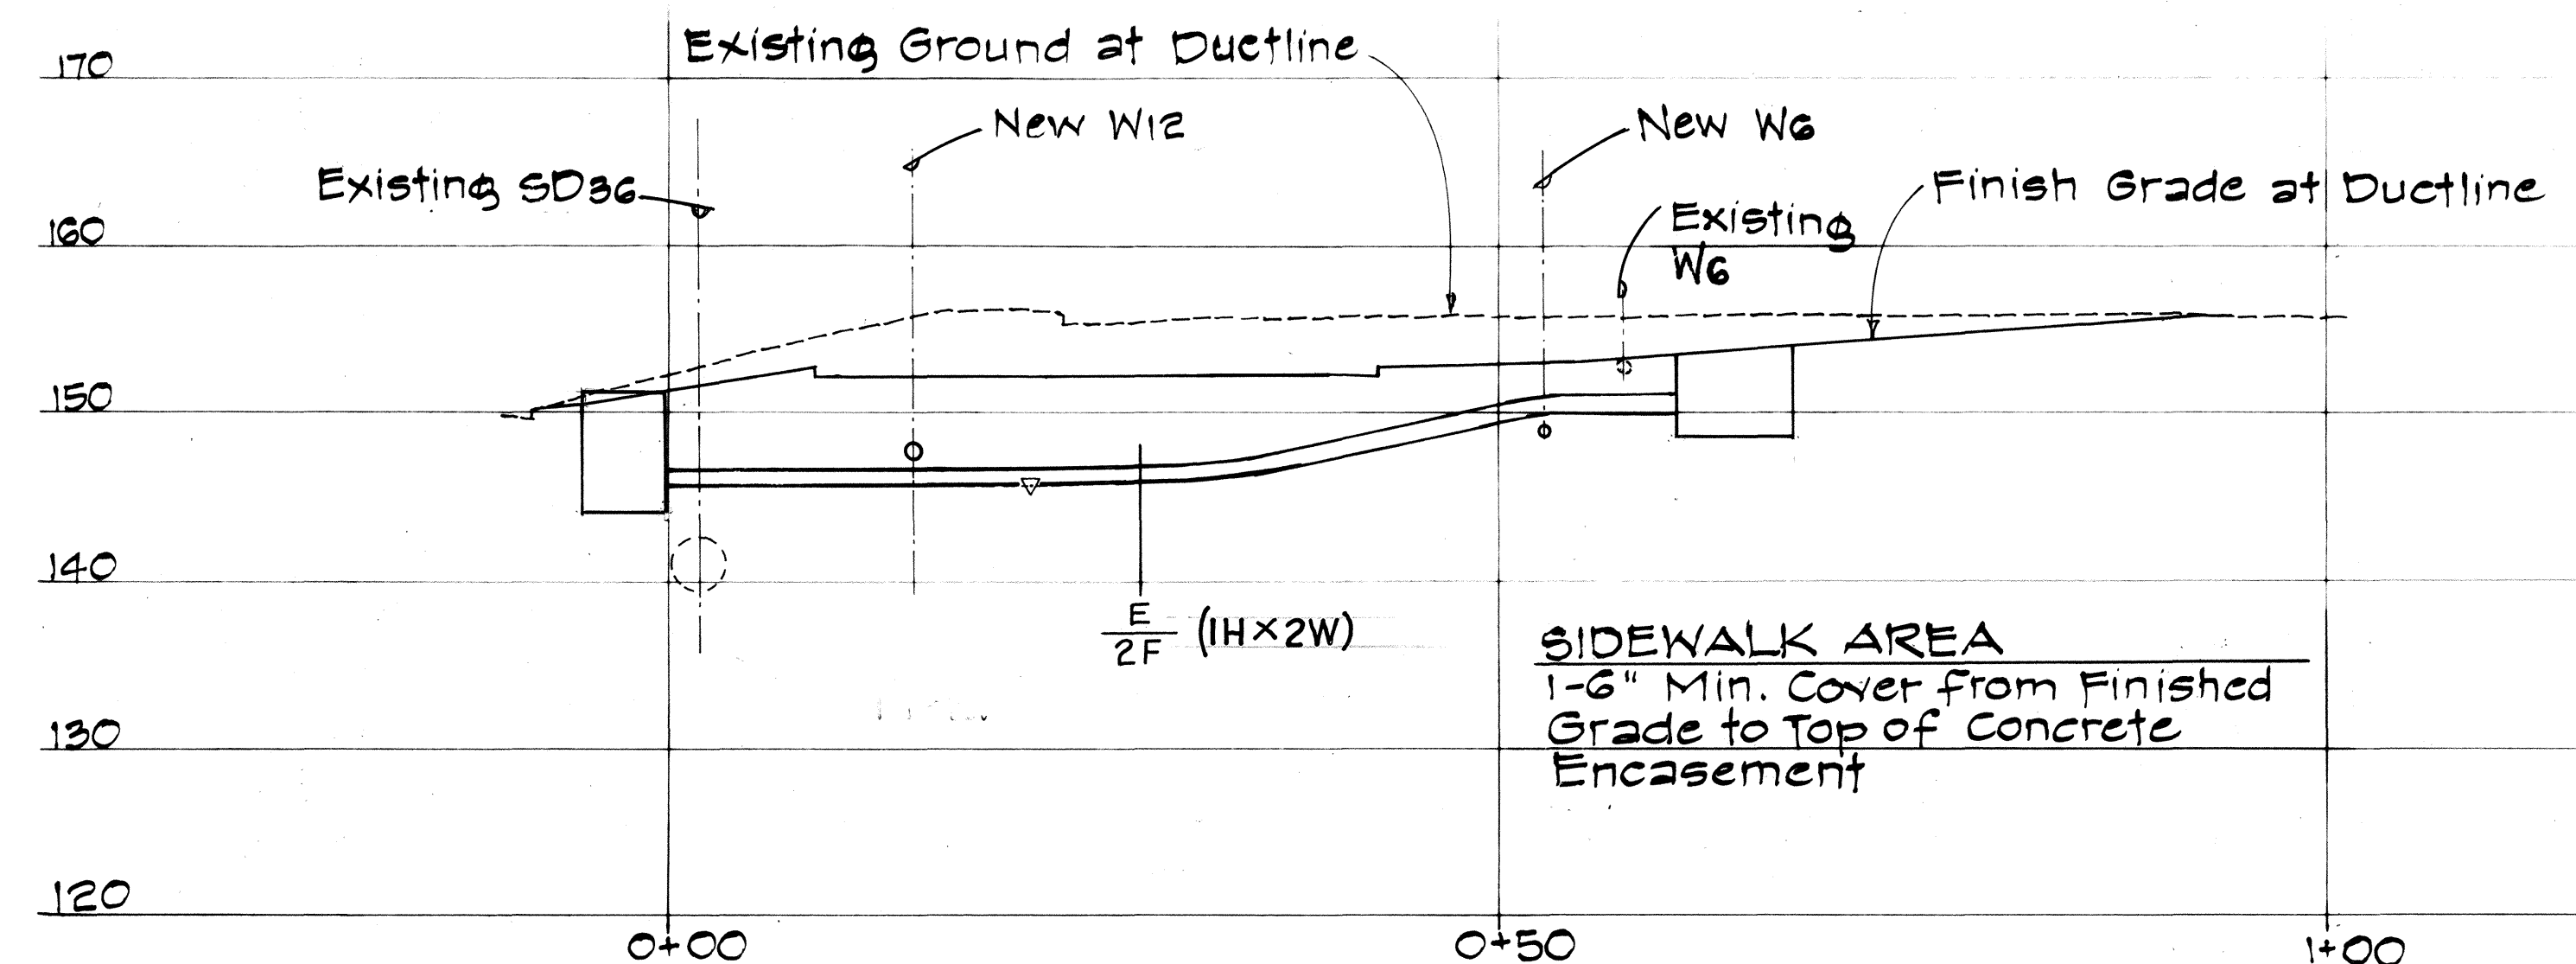


HECO DUCTLINE AT STA. 14+10 TO STA. 14+50

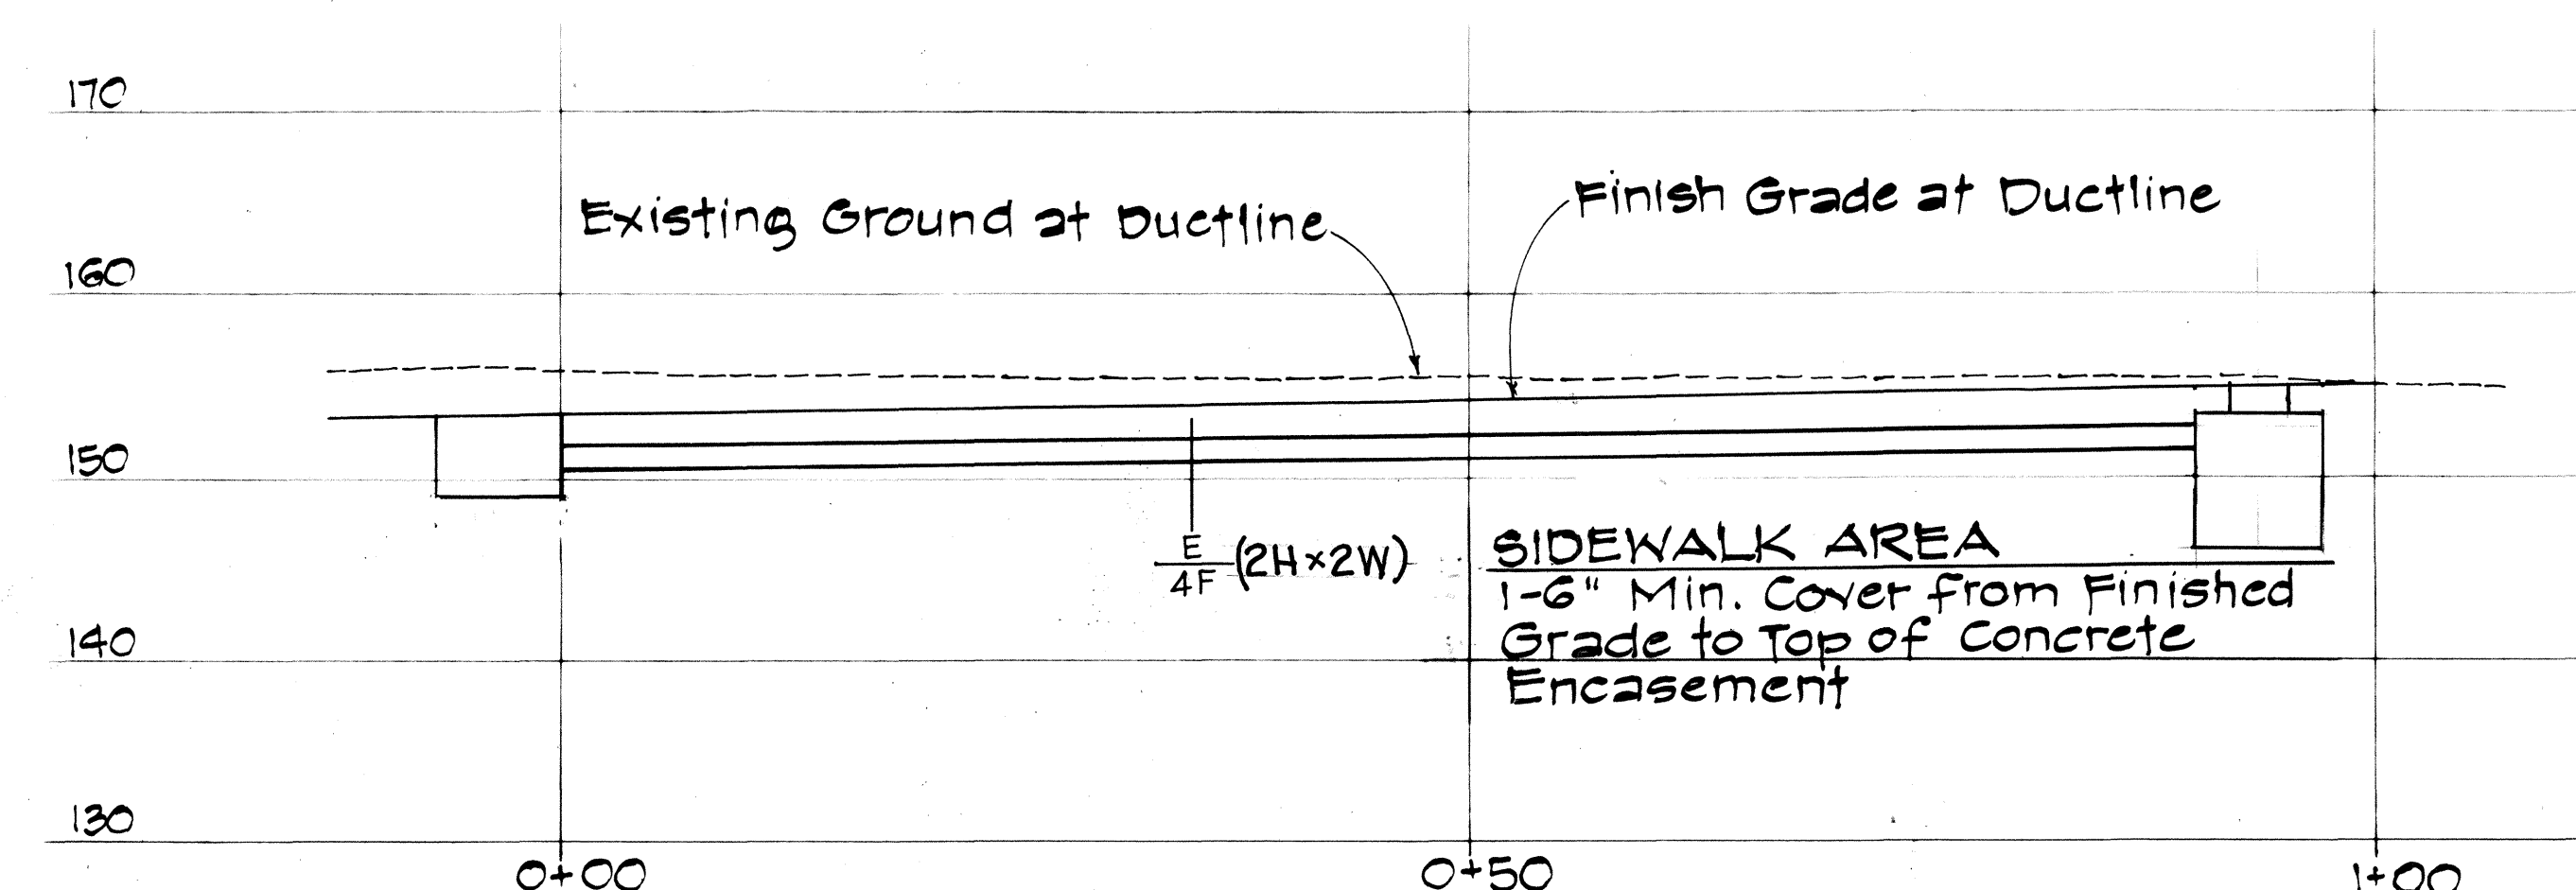


HECO DUCTLINE AT STA. 14+50 TO STA. 15+45

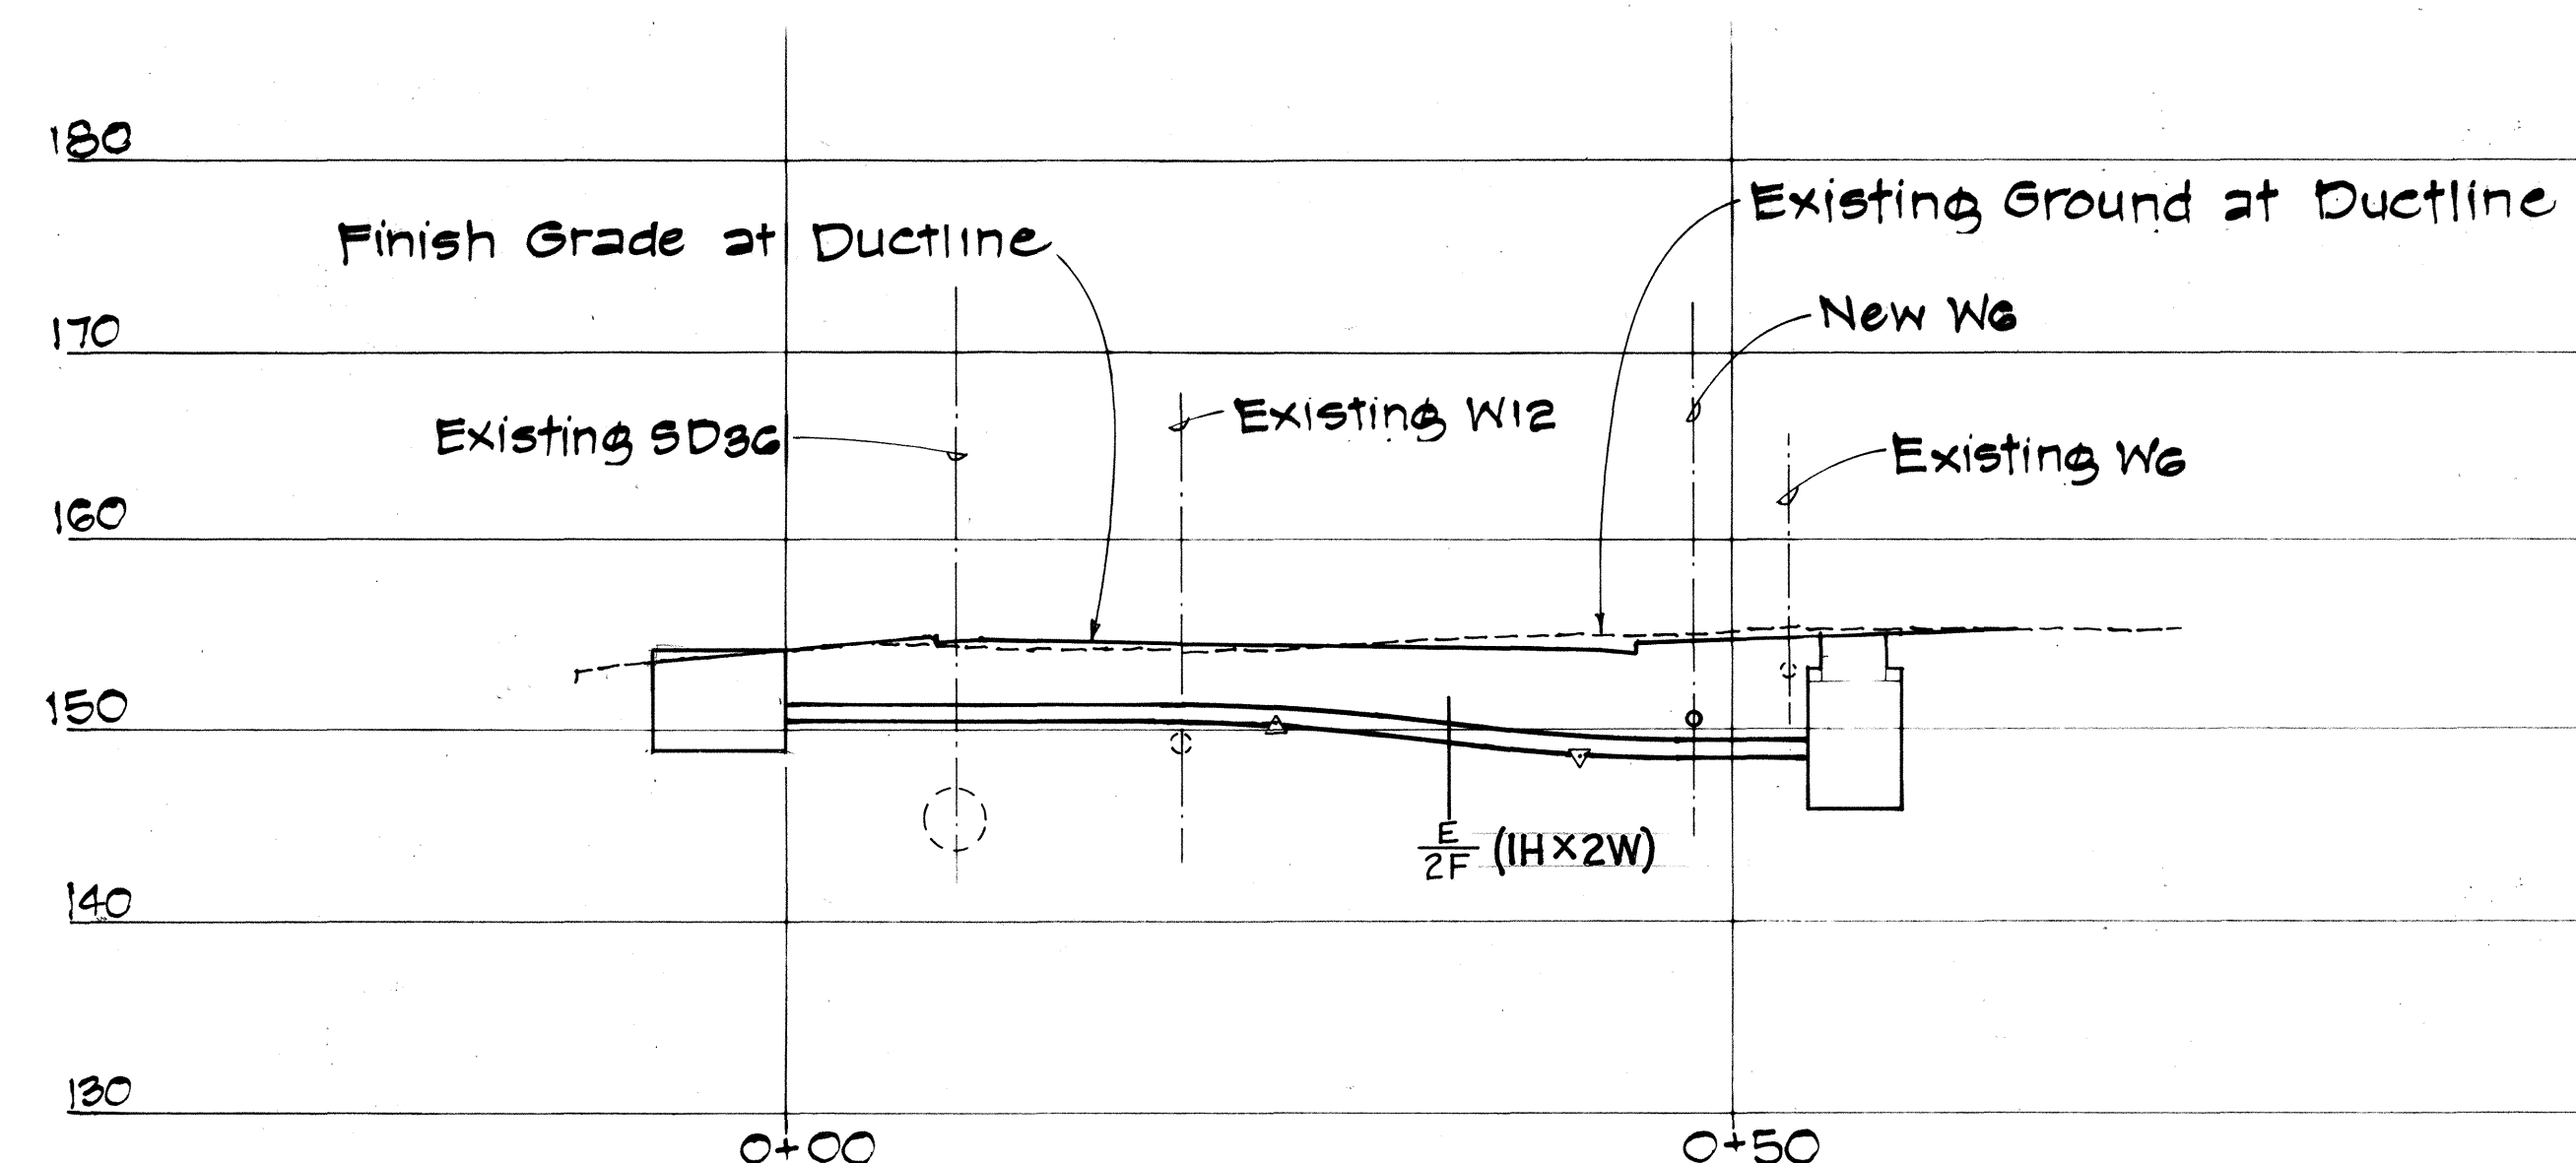

HECO DUCTLINE AT STA. 15+41 TO STA. 15+45

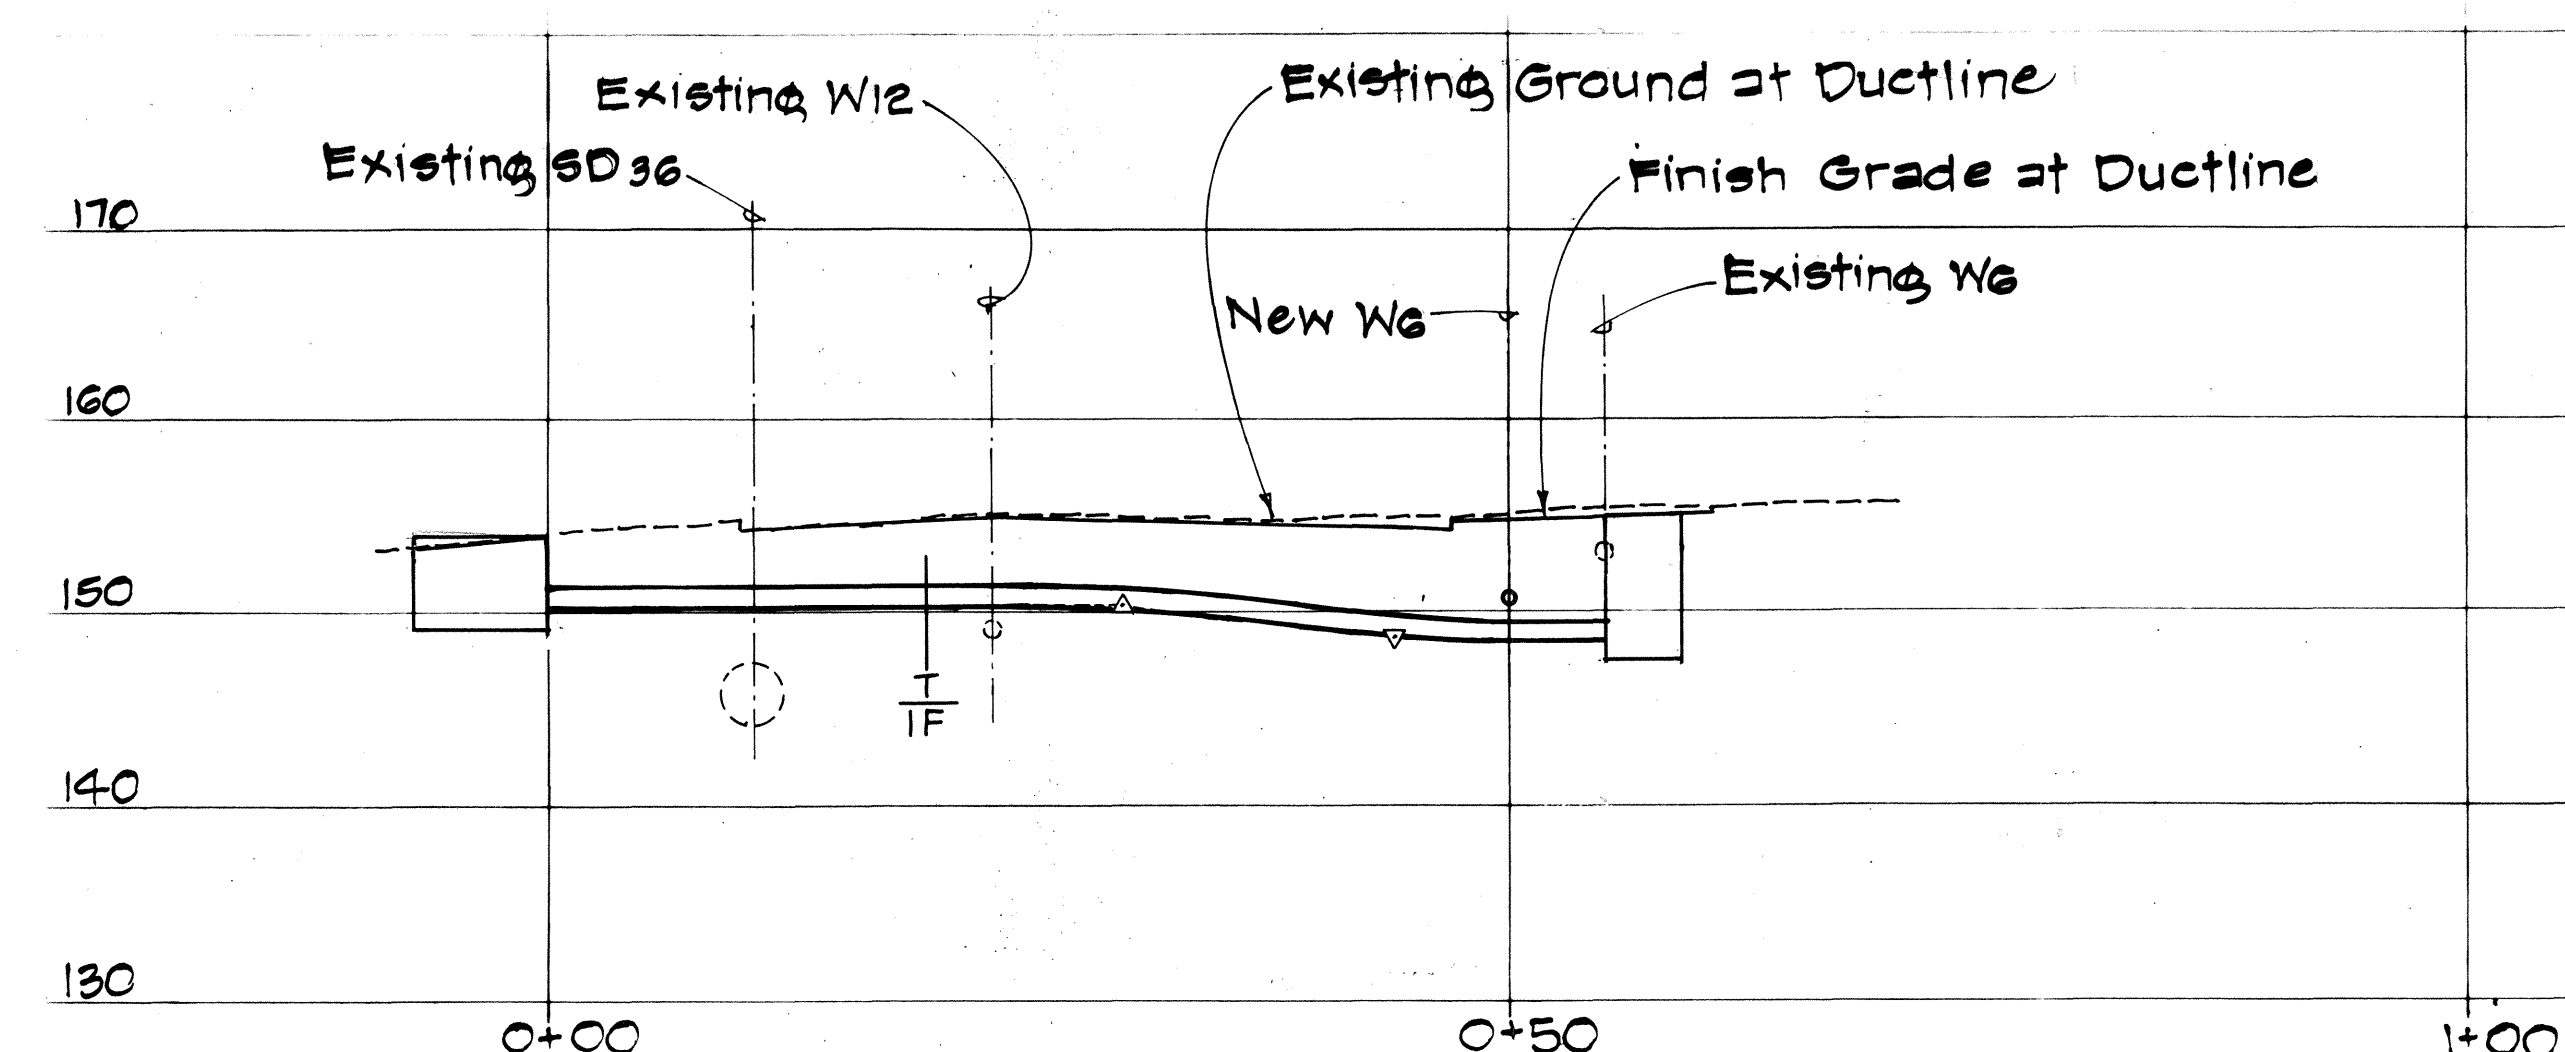

HECO DUCTLINE AT STA. 15+45 TO STA. 15+49.5

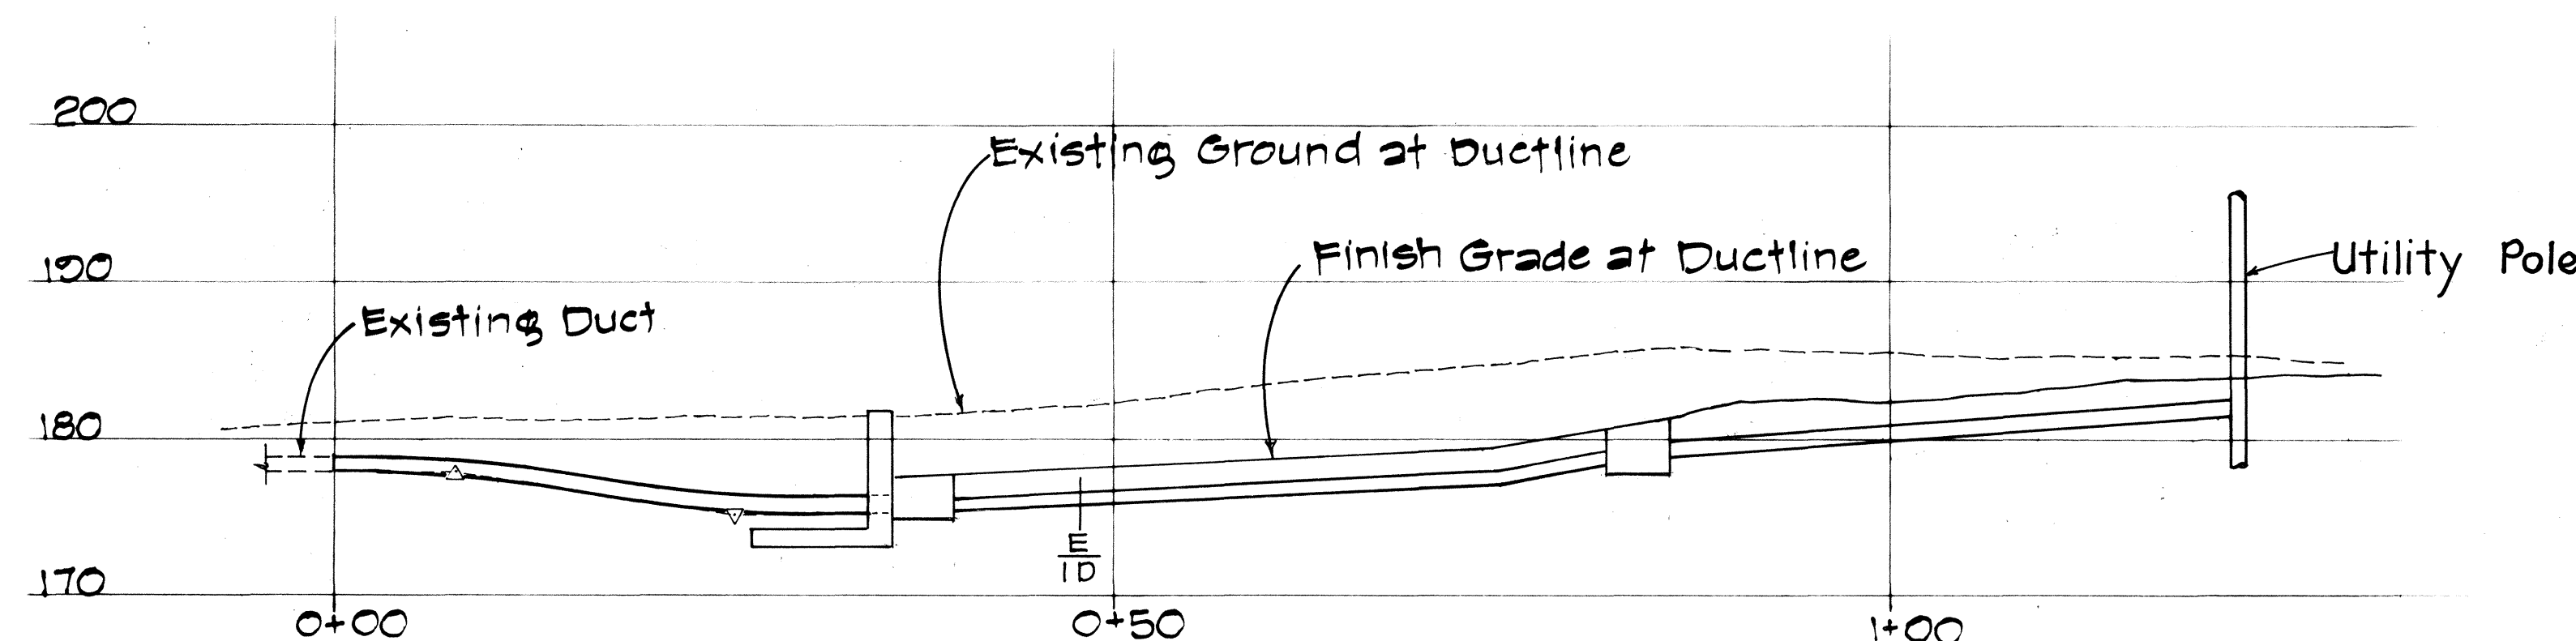


HECO DUCTLINE AT STA. 20+32 TO STA. 20+84

LEGEND FOR CONDUIT


CONDUIT SIZE	SYMBOL
3"	D
4"	F
5"	H

GRAPHIC SCALES

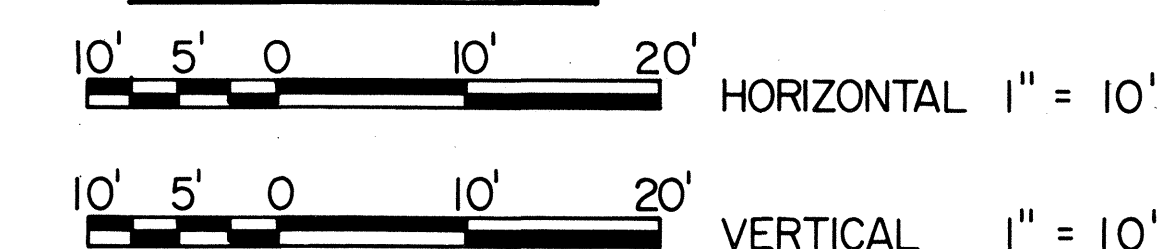

APPROVED
W. H. H. H.
 HAWAIIAN ELECTRIC COMPANY
R. Yamada
 HAWAIIAN TELEPHONE COMPANY


9-14-78
 DATE
 7-8-78
 DATE

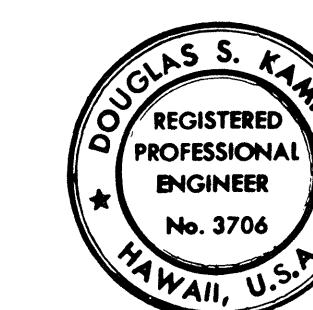


THIS WORK WAS PREPARED BY ME OR UNDER MY SUPERVISION.
Douglas S. Kama

STATE OF HAWAII
 DEPARTMENT OF TRANSPORTATION
 LAND TRANSPORTATION FACILITIES DIVISION
ELECTRICAL & TELEPHONE PROFILES
KAMEHAMEHA HIGHWAY IMPROVEMENT
 (LIKELIKE HIGHWAY TO KOOLAU VIEW DRIVE)
 PROJECT NO. F-083-1 (10)
 SCALE: AS SHOWN
 DATE AUG 1978
 SHEET No. 20 OF 38 SHEETS


FED. ROAD DIST. NO.	STATE	FED. AID PROJ. NO.	FISCAL YEAR	SHEET NO.	TOTAL SHEETS
HAWAII	HAW.	F-083-1(10)	1978	69	160

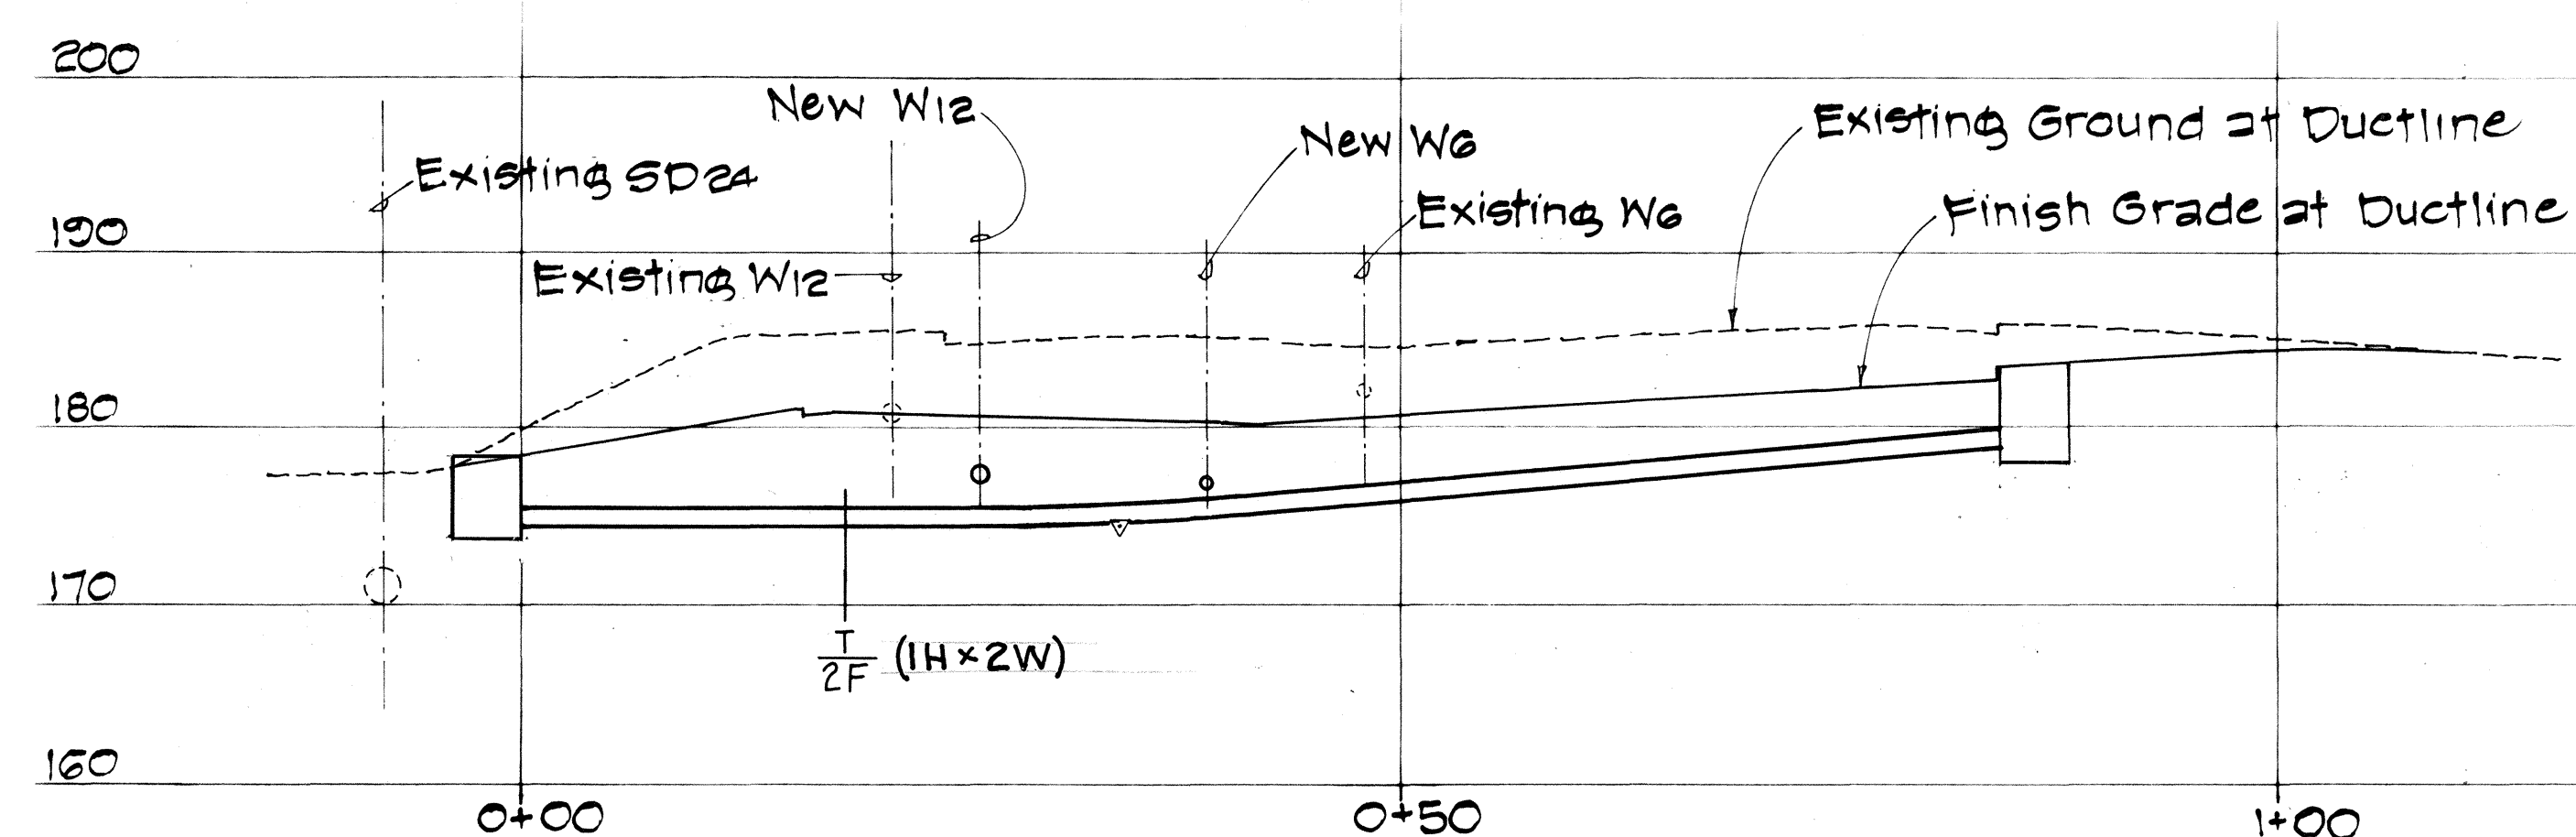


HTCO DUCTLINE AT KUUIPO PLACE

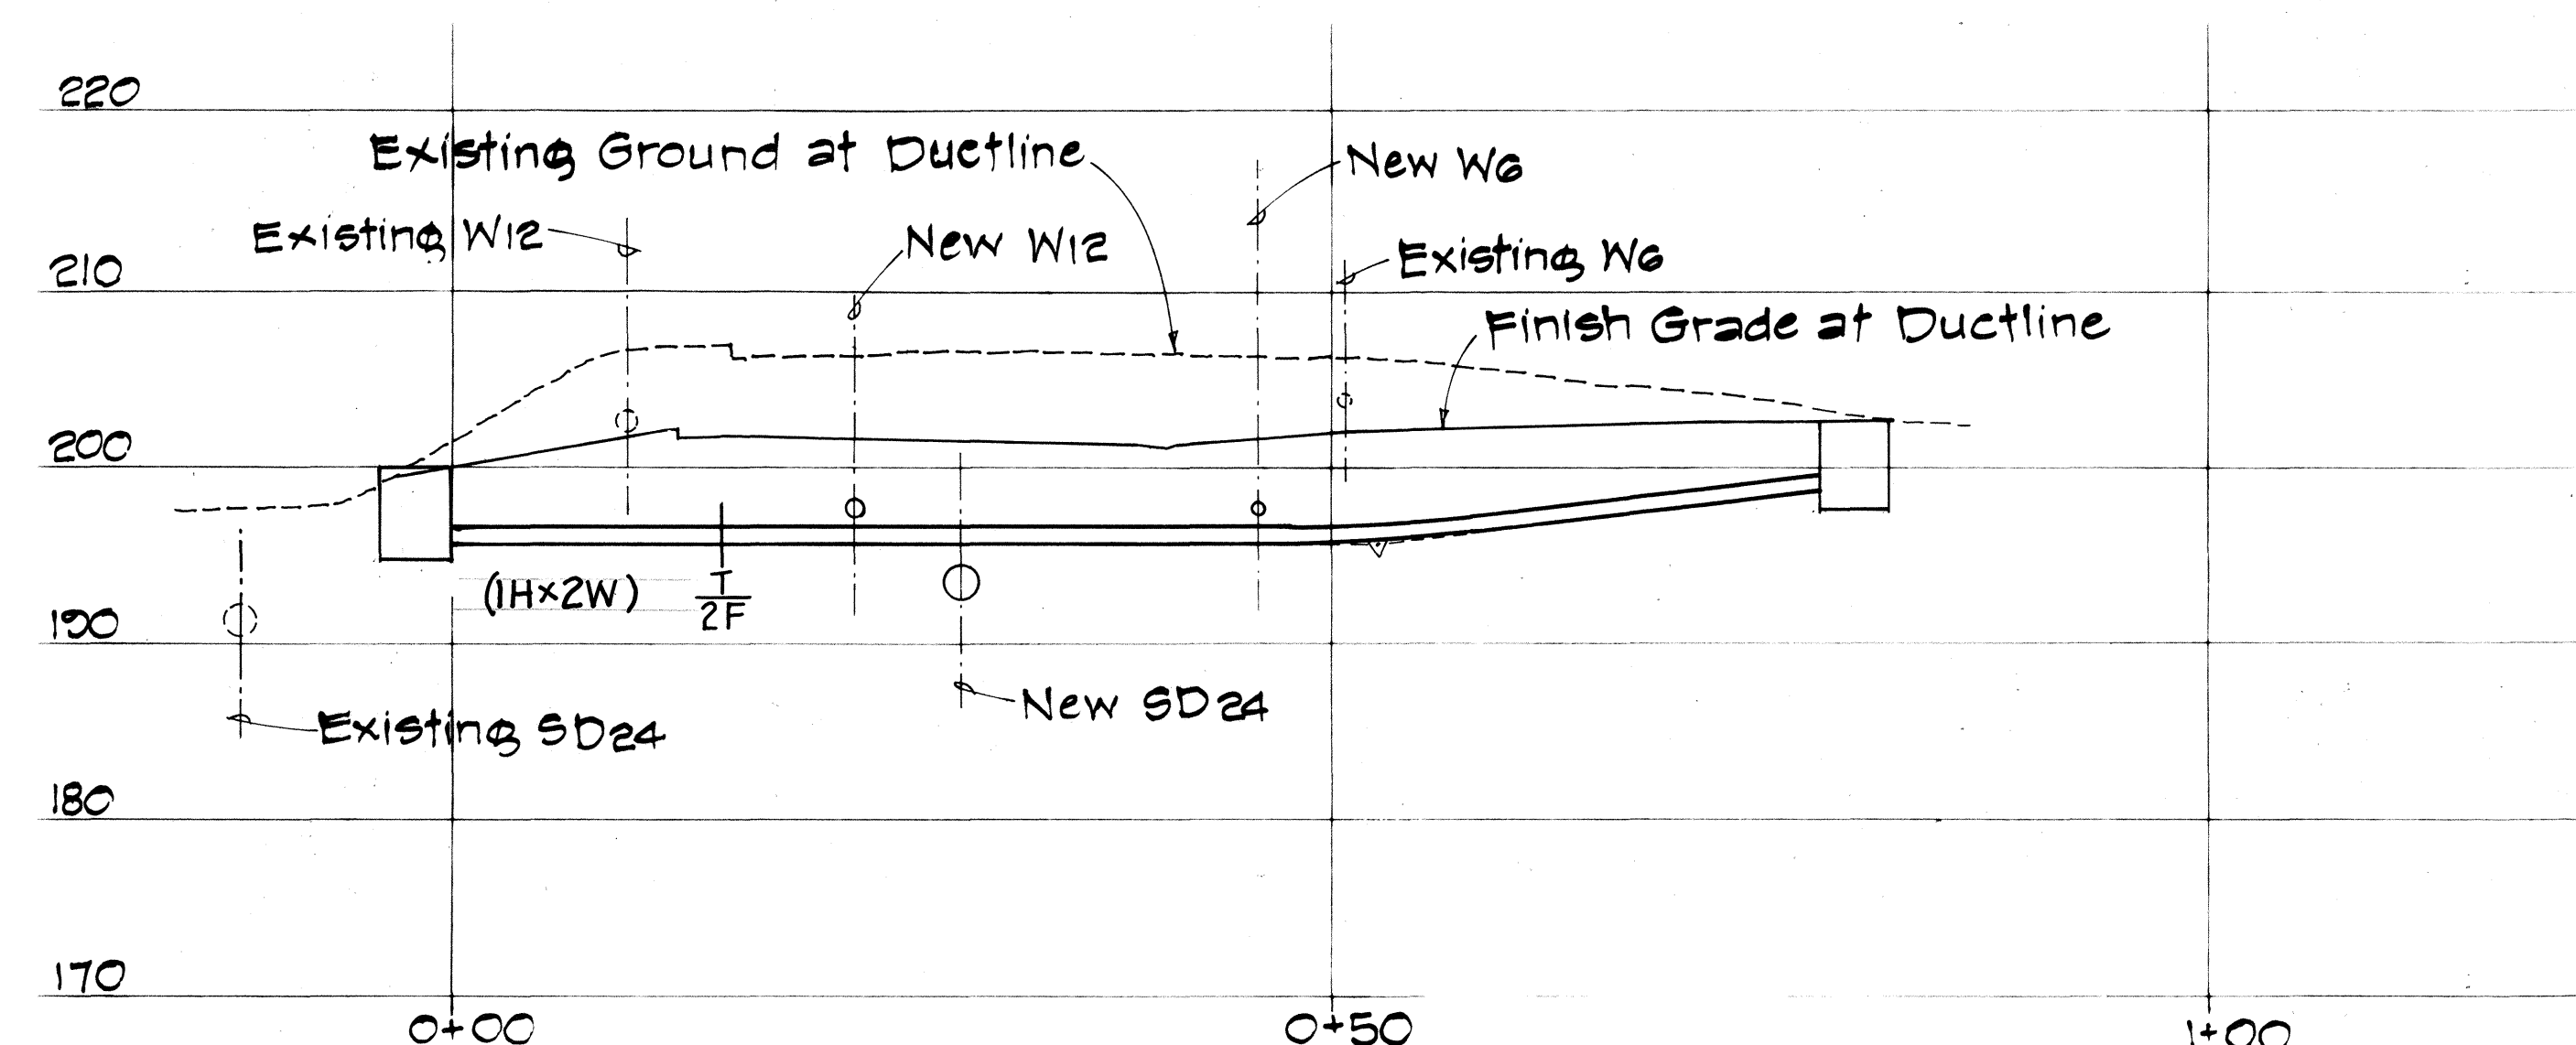

HTCO DUCTLINE AT STA. 23+83 TO STA. 23+68

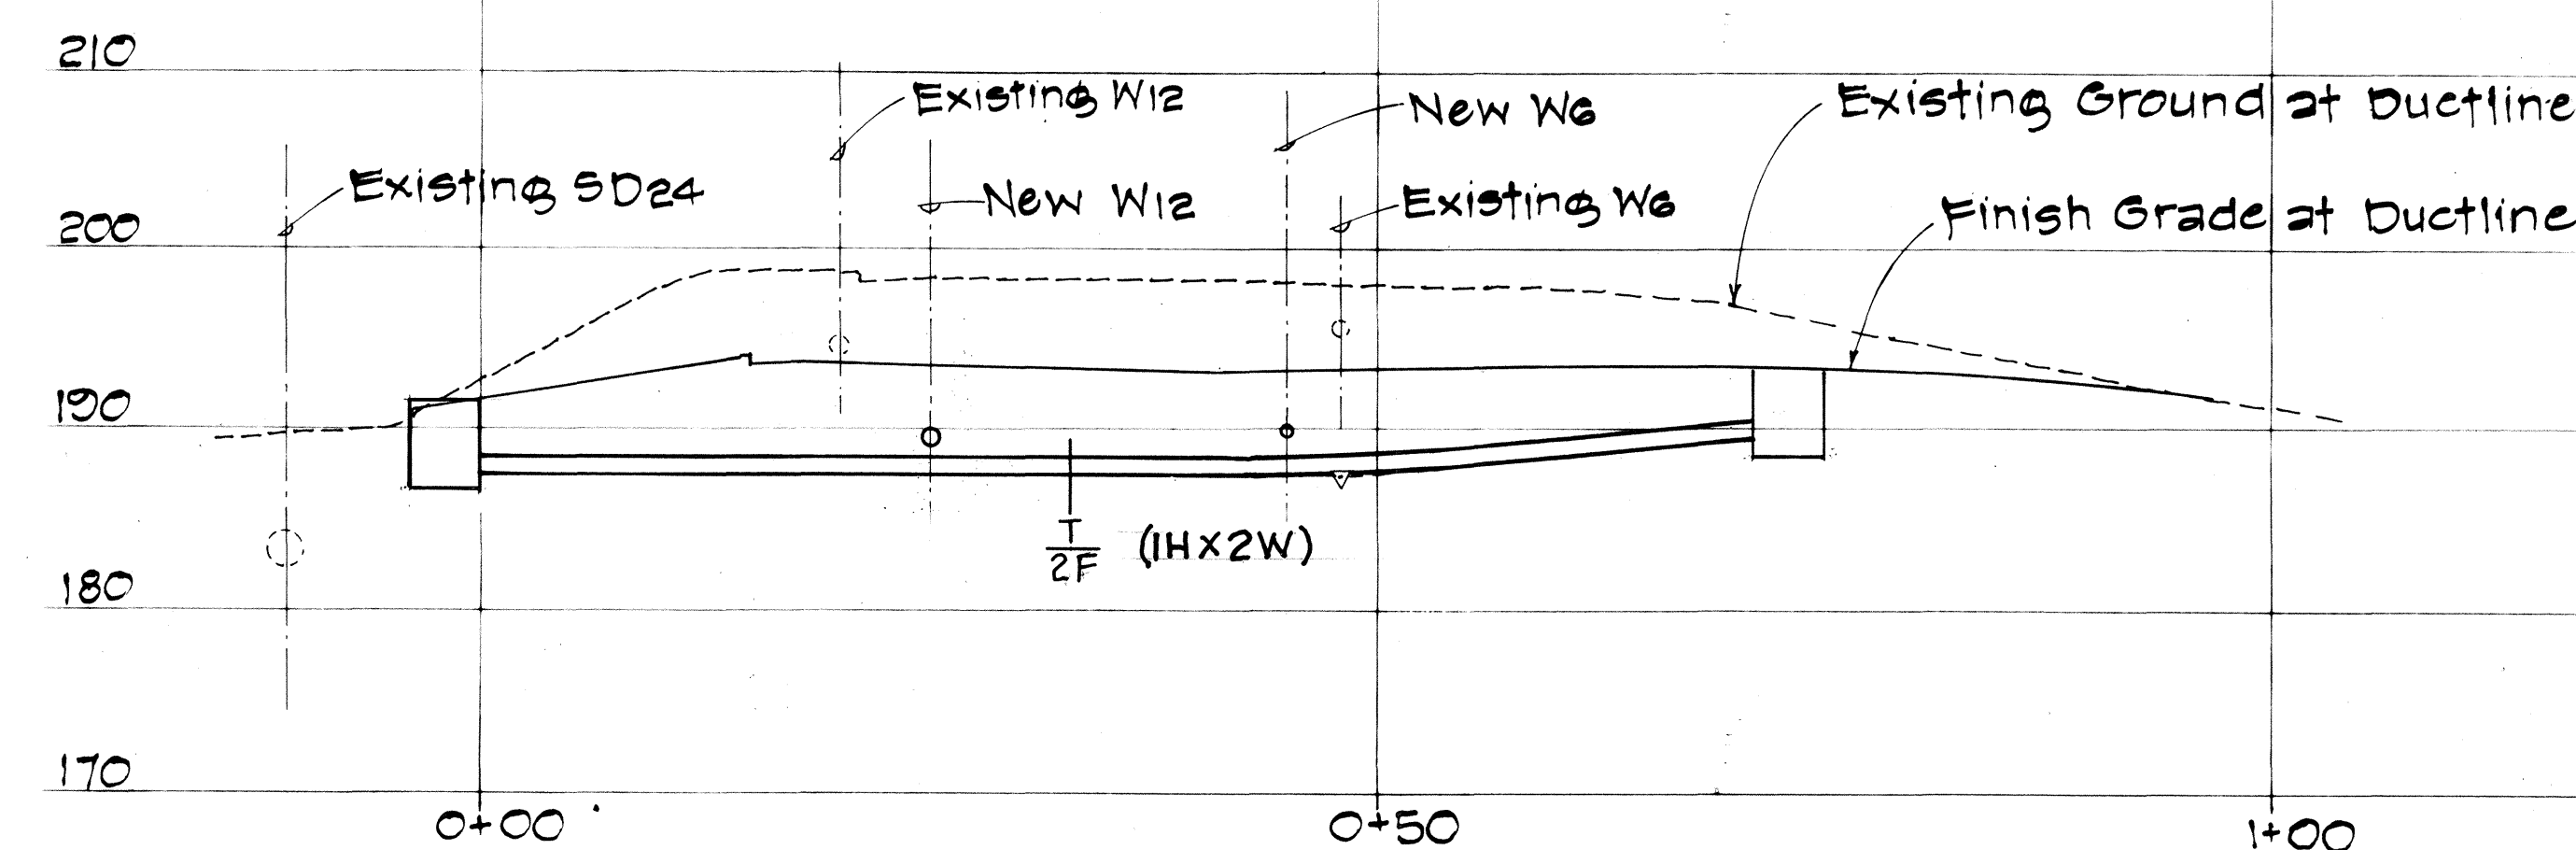

HTCO DUCTLINE AT HUAWAINA PLACE

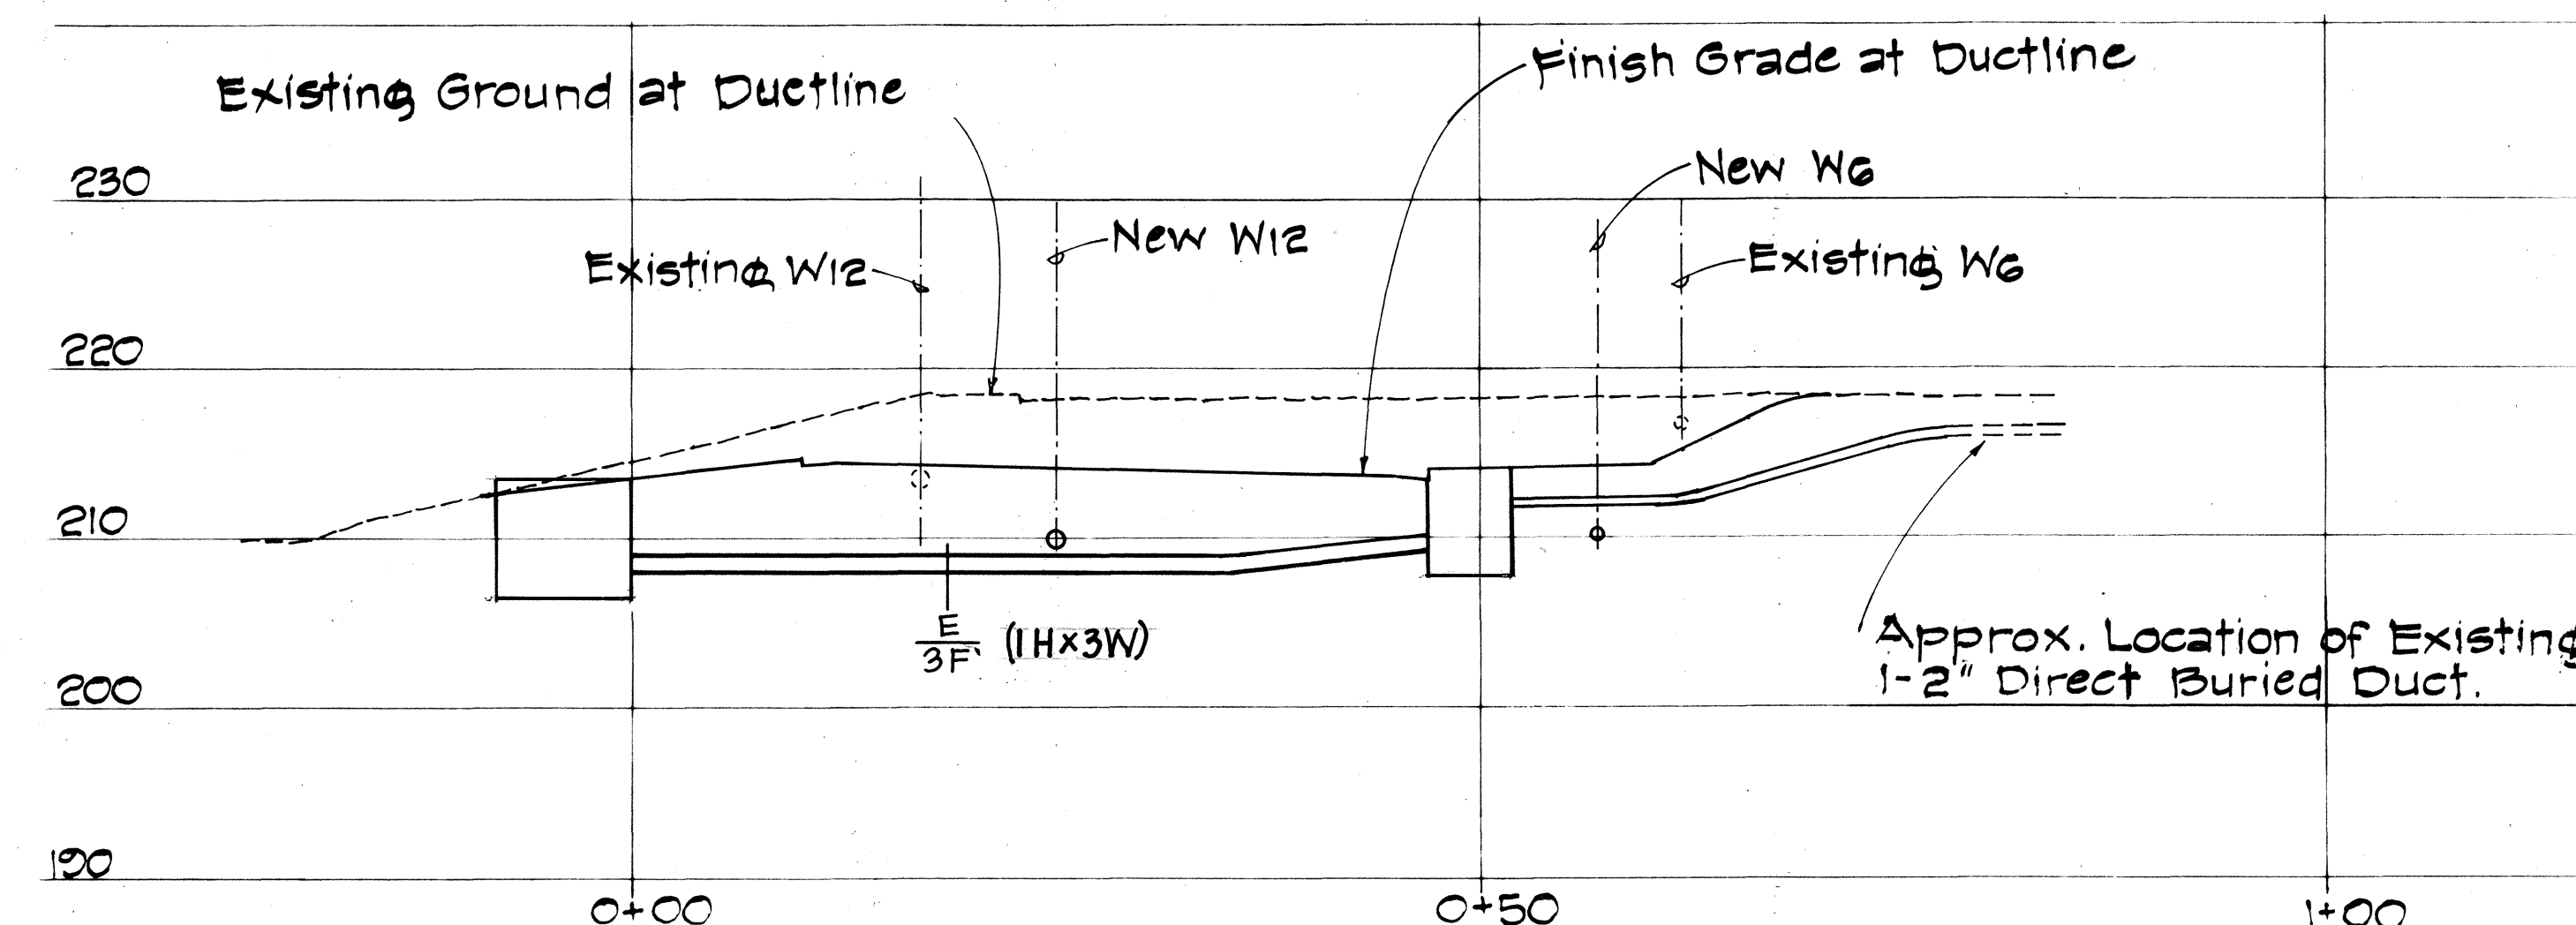


HECO DUCTLINE AT STA. 25+61 TO STA. 25+66

LEGEND FOR CONDUIT


CONDUIT SIZE	SYMBOL
3"	D
4"	F
5"	H

GRAPHIC SCALES

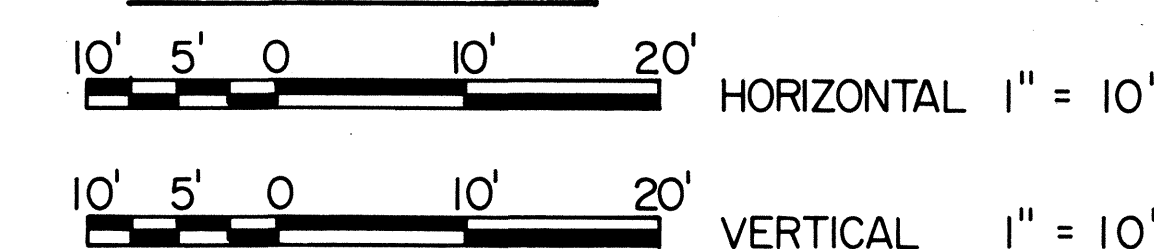

DATE	_____
DESIGNED BY	_____
CHECKED BY	_____
NOTED BY	_____
NO.	_____


APPROVED
[Signature] 9-14-78
HAWAIIAN ELECTRIC COMPANY DATE
[Signature] 9-8-78
HAWAIIAN TELEPHONE COMPANY DATE

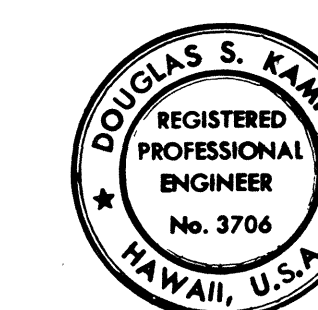


THIS WORK WAS PREPARED BY ME OR UNDER MY SUPERVISION.
Douglas S. Kameha

STATE OF HAWAII
DEPARTMENT OF TRANSPORTATION
LAND TRANSPORTATION FACILITIES DIVISION
ELECTRICAL & TELEPHONE PROFILES
KAMEHAMEHA HIGHWAY IMPROVEMENT
(LIKELIKE HIGHWAY TO KOOLAU VIEW DRIVE)
PROJECT NO. F-083-1(10)
SCALE: AS SHOWN DATE AUG 1978
SHEET No. 21 OF 38 SHEETS


FED. ROAD DIST. NO.	STATE	FED. AID PROJ. NO.	FISCAL YEAR	SHEET NO.	TOTAL SHEETS
HAWAII	HAW.	F-083-1(10)	1978	70	160

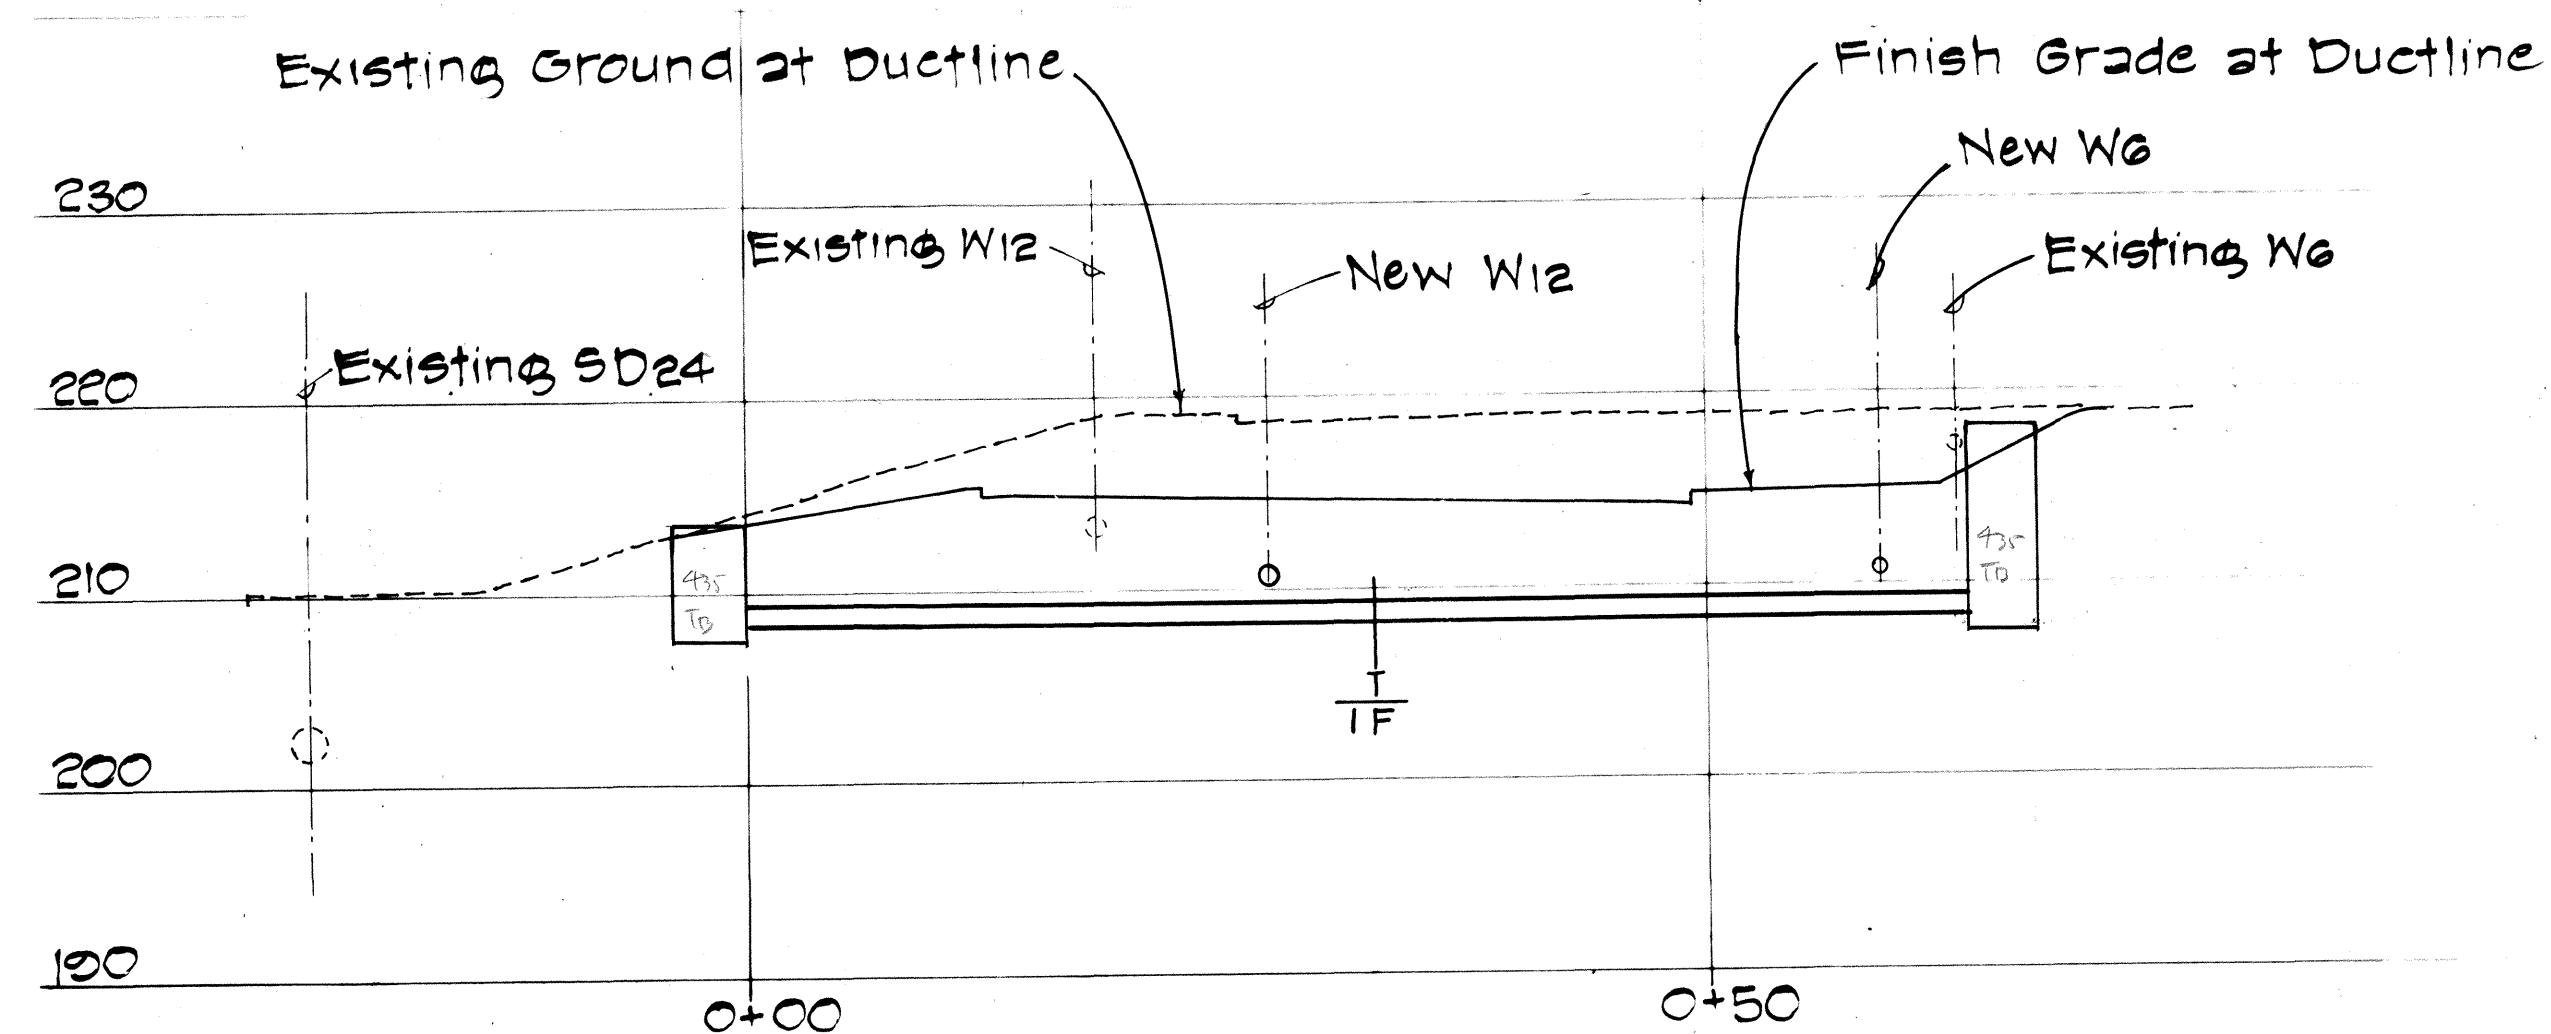


HTCO DUCTLINE AT STA. 25+70 TO STA. 25+66

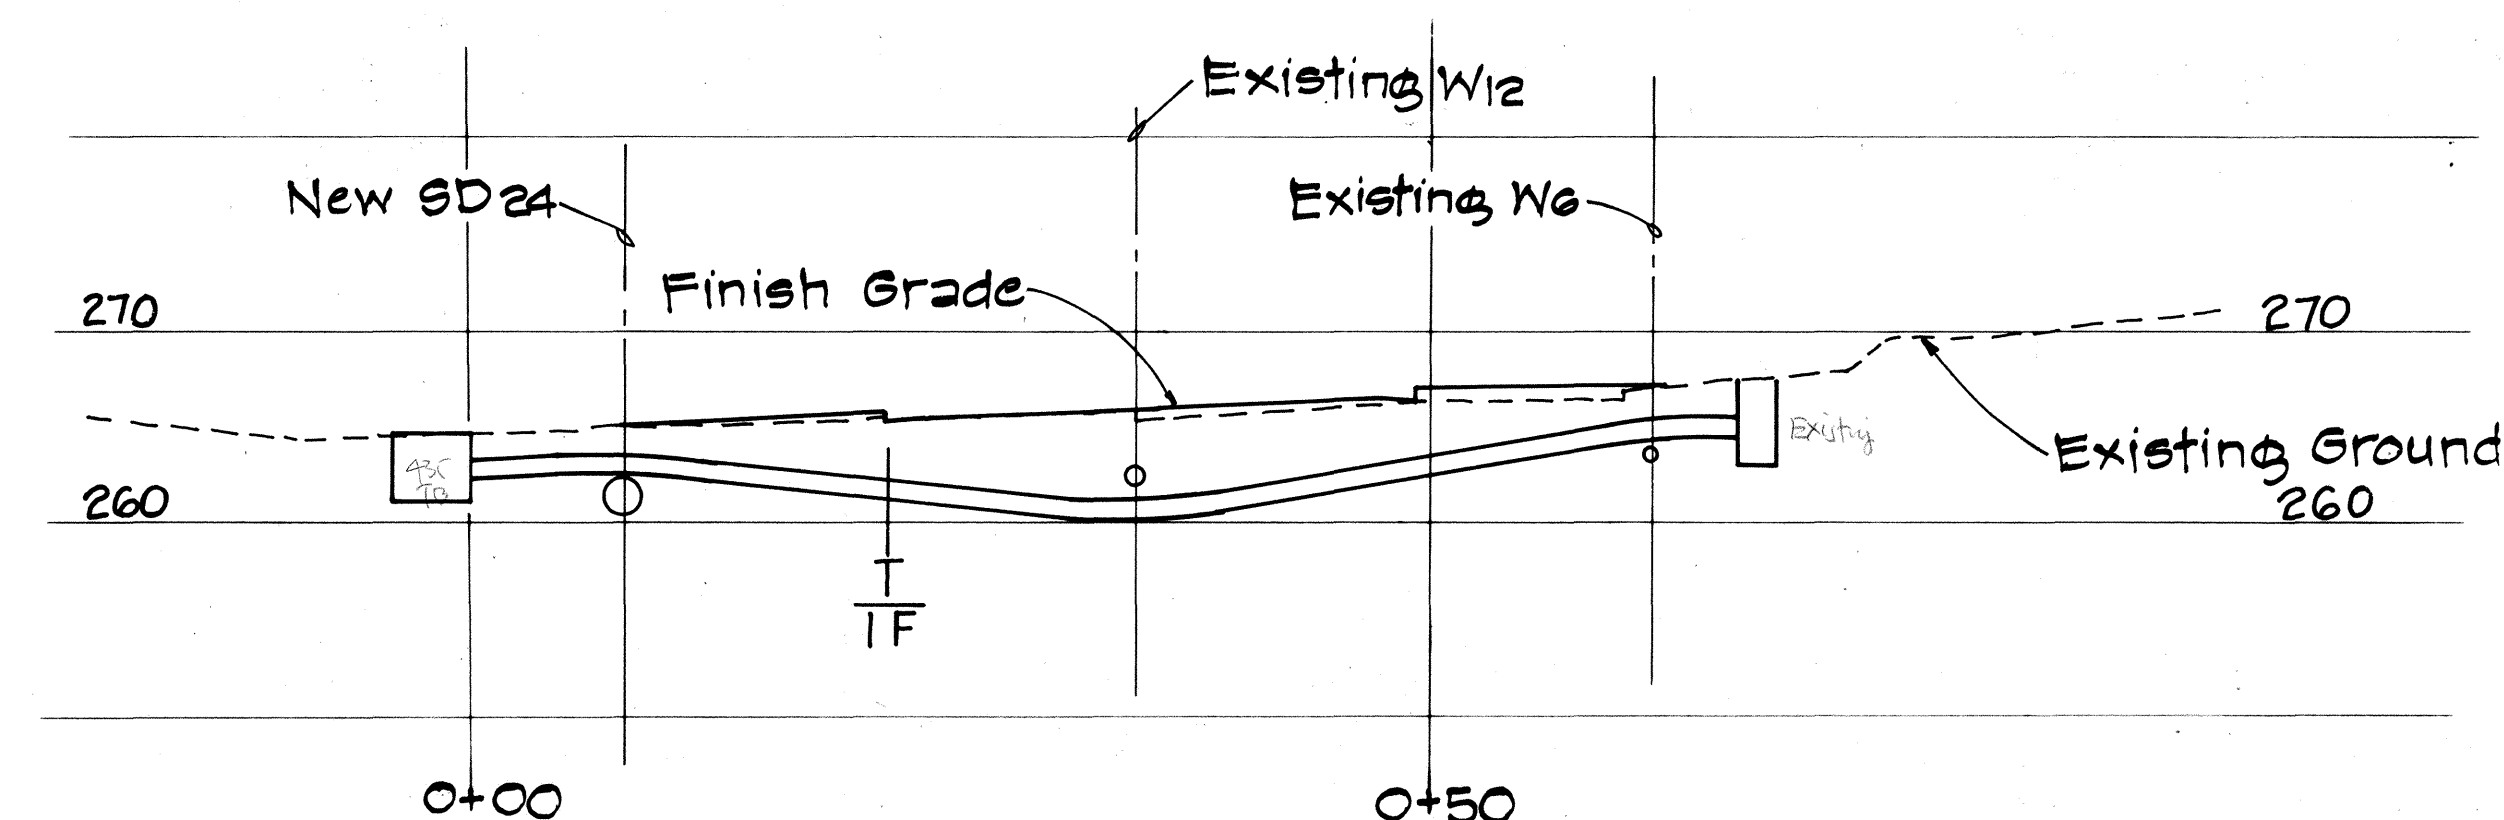


HTCO DUCTLINE AT STA. 37+28 TO STA. 37+46

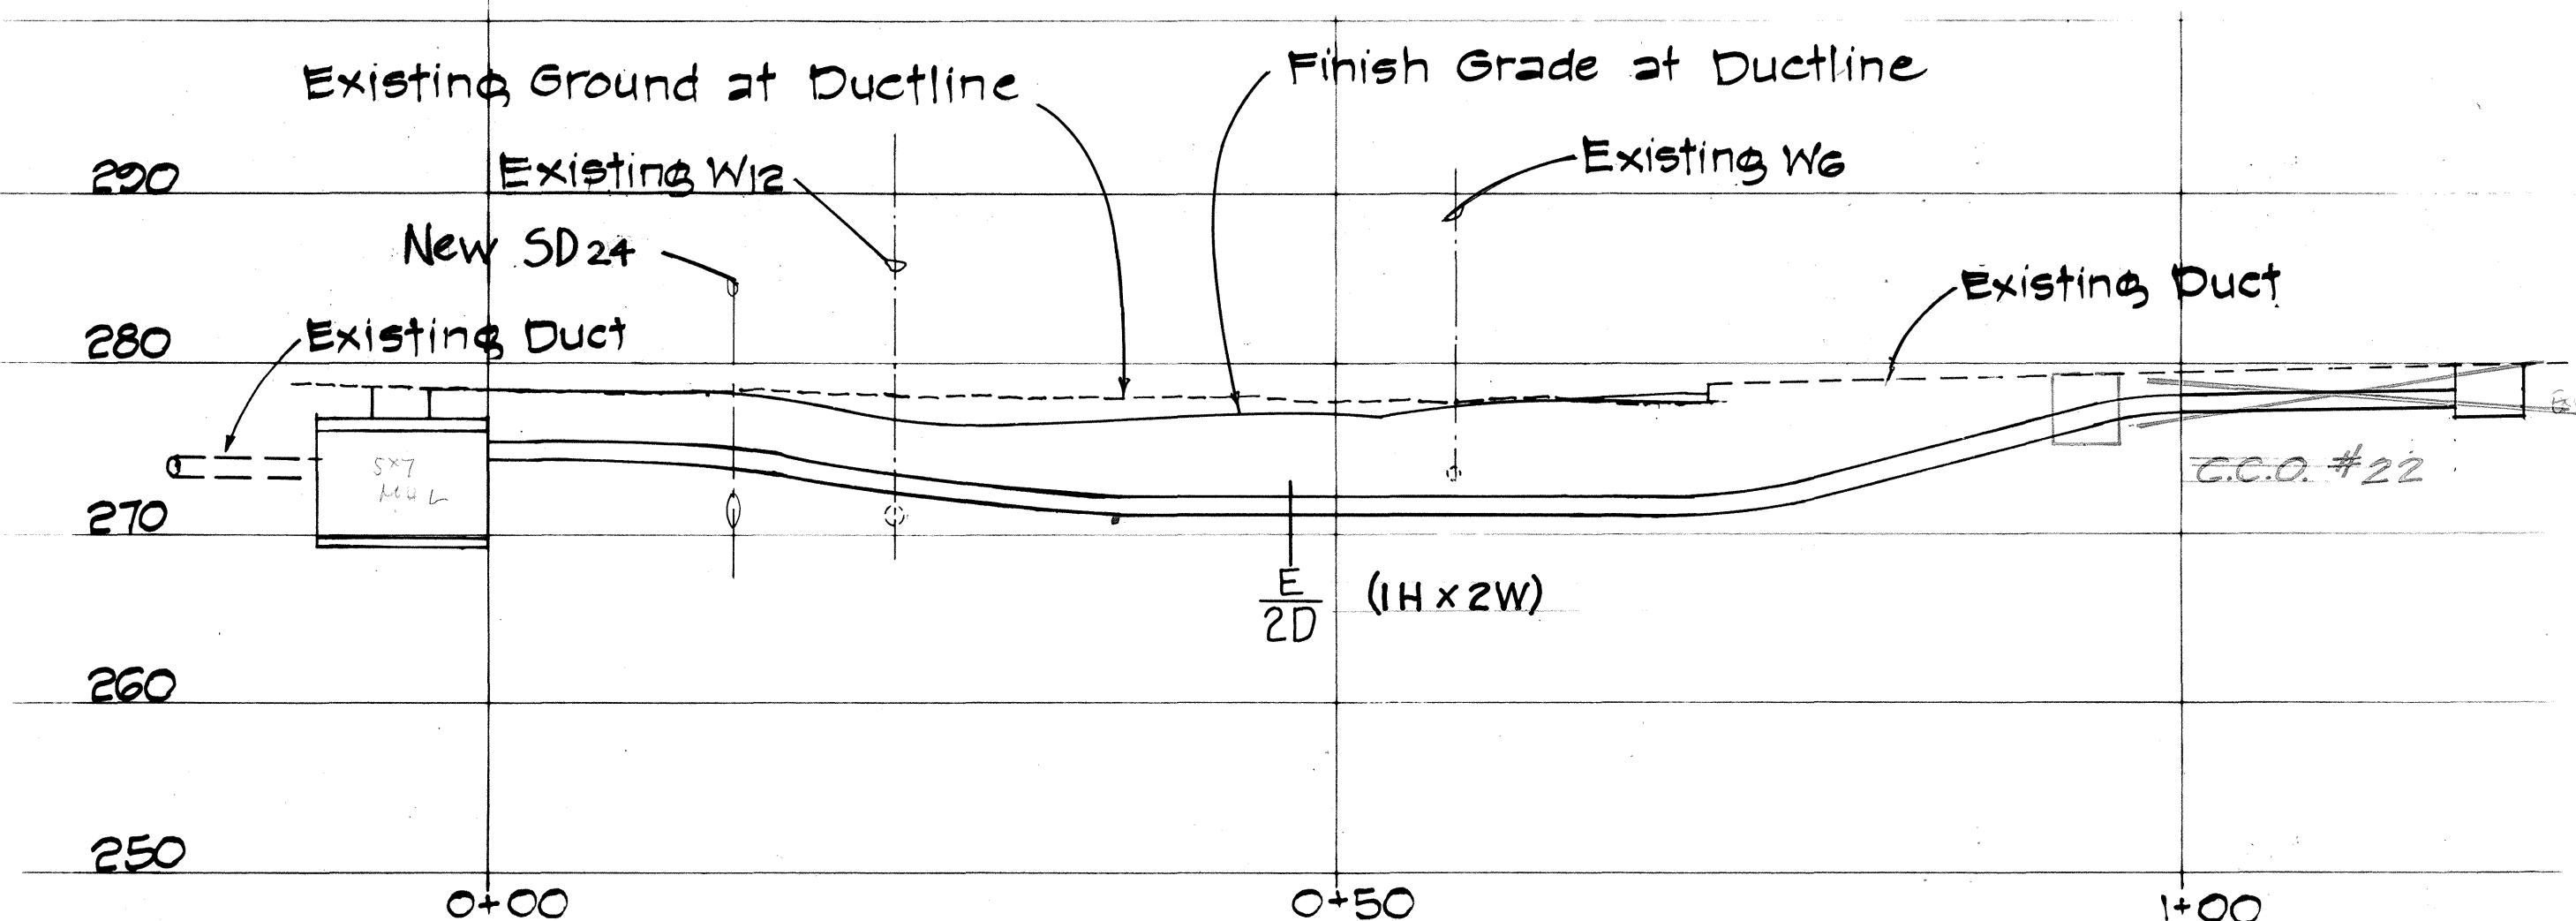

HECO DUCTLINE AT HALEKOU ROAD

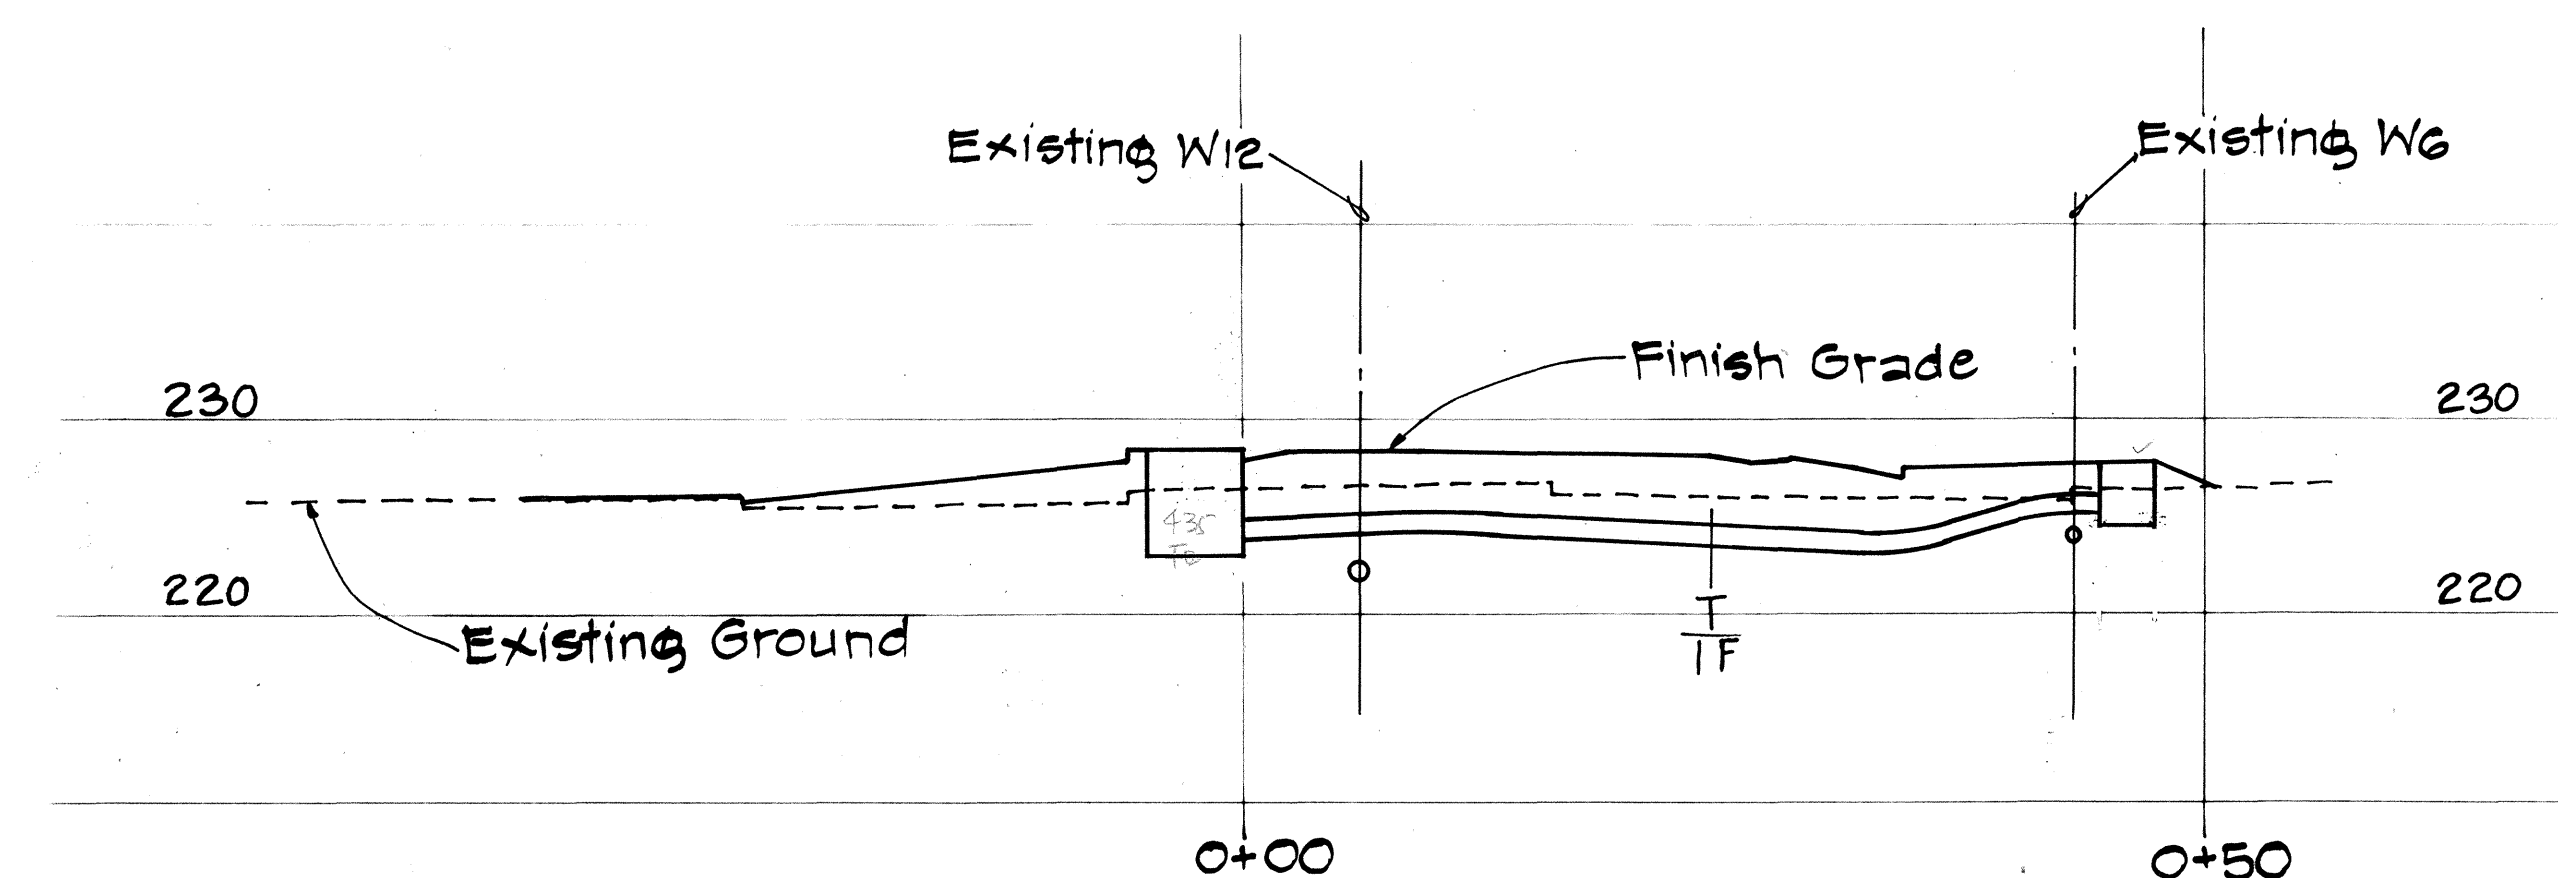

HTCO DUCTLINE AT STA. 28+14

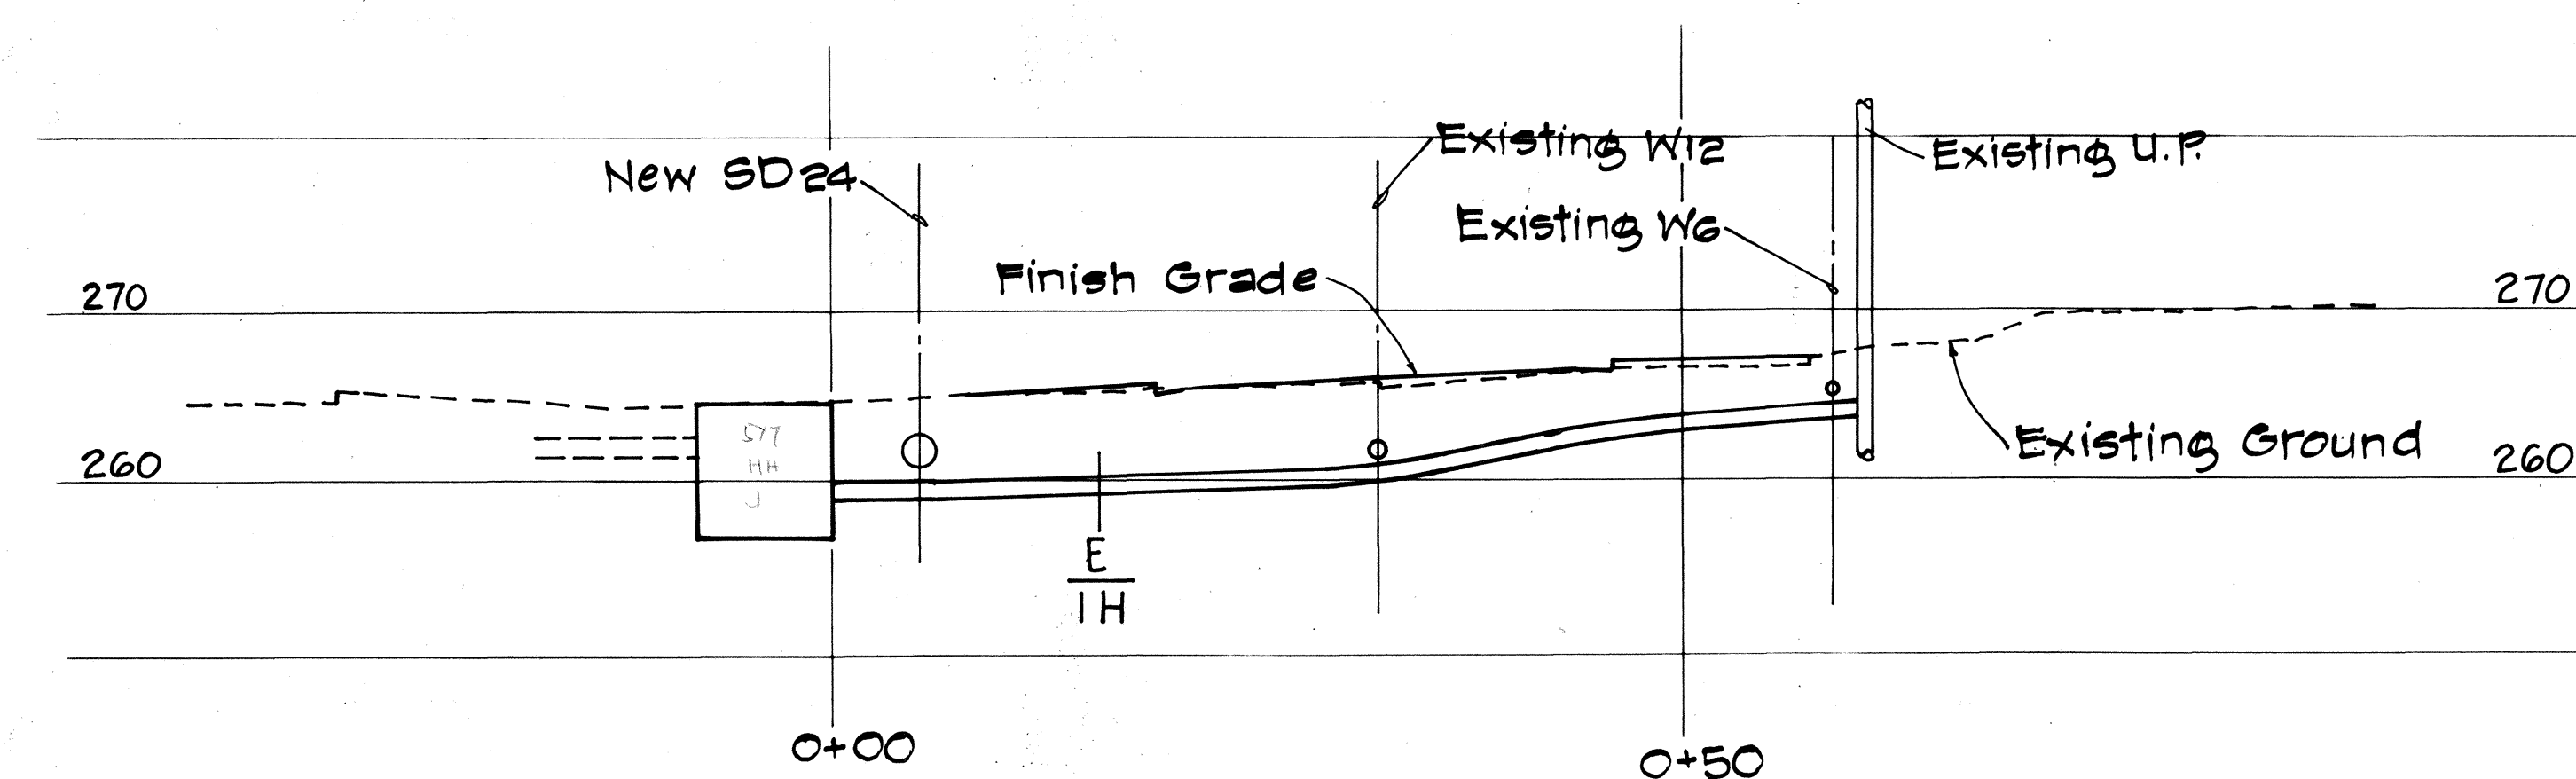


HECO DUCTLINE AT STA. 37+32 TO STA. 37+50

LEGEND FOR CONDUIT


CONDUIT SIZE	SYMBOL
3"	D
4"	F
5"	H

GRAPHIC SCALES

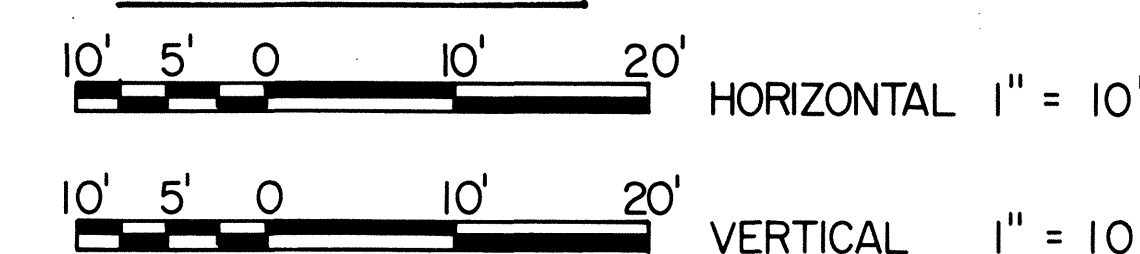

APPROVED
 HAWAIIAN ELECTRIC COMPANY
 HAWAIIAN TELEPHONE COMPANY


9-14-78
 DATE
 9-8-78
 DATE

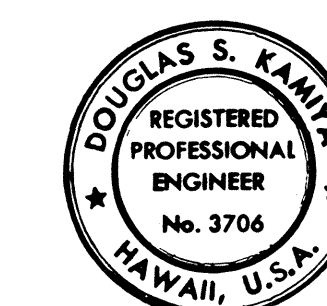


THIS WORK WAS PREPARED BY ME OR UNDER MY SUPERVISION.
 Douglas S. Kamehameha

STATE OF HAWAII
 DEPARTMENT OF TRANSPORTATION
 LAND TRANSPORTATION FACILITIES DIVISION
ELECTRICAL & TELEPHONE PROFILES
KAMEHAMEHA HIGHWAY IMPROVEMENT
 (LIKELIKE HIGHWAY TO KOOLAU VIEW DRIVE)
 PROJECT NO. F-083-1(10)
 SCALE: AS SHOWN
 DATE AUG 1978
 SHEET No. 22 OF 38 SHEETS


FED. ROAD DIST. NO.	STATE	FED. AID PROJ. NO.	FISCAL YEAR	SHEET NO.	TOTAL SHEETS
HAWAII	HAW.	F-083-1(10)	1978	71	160

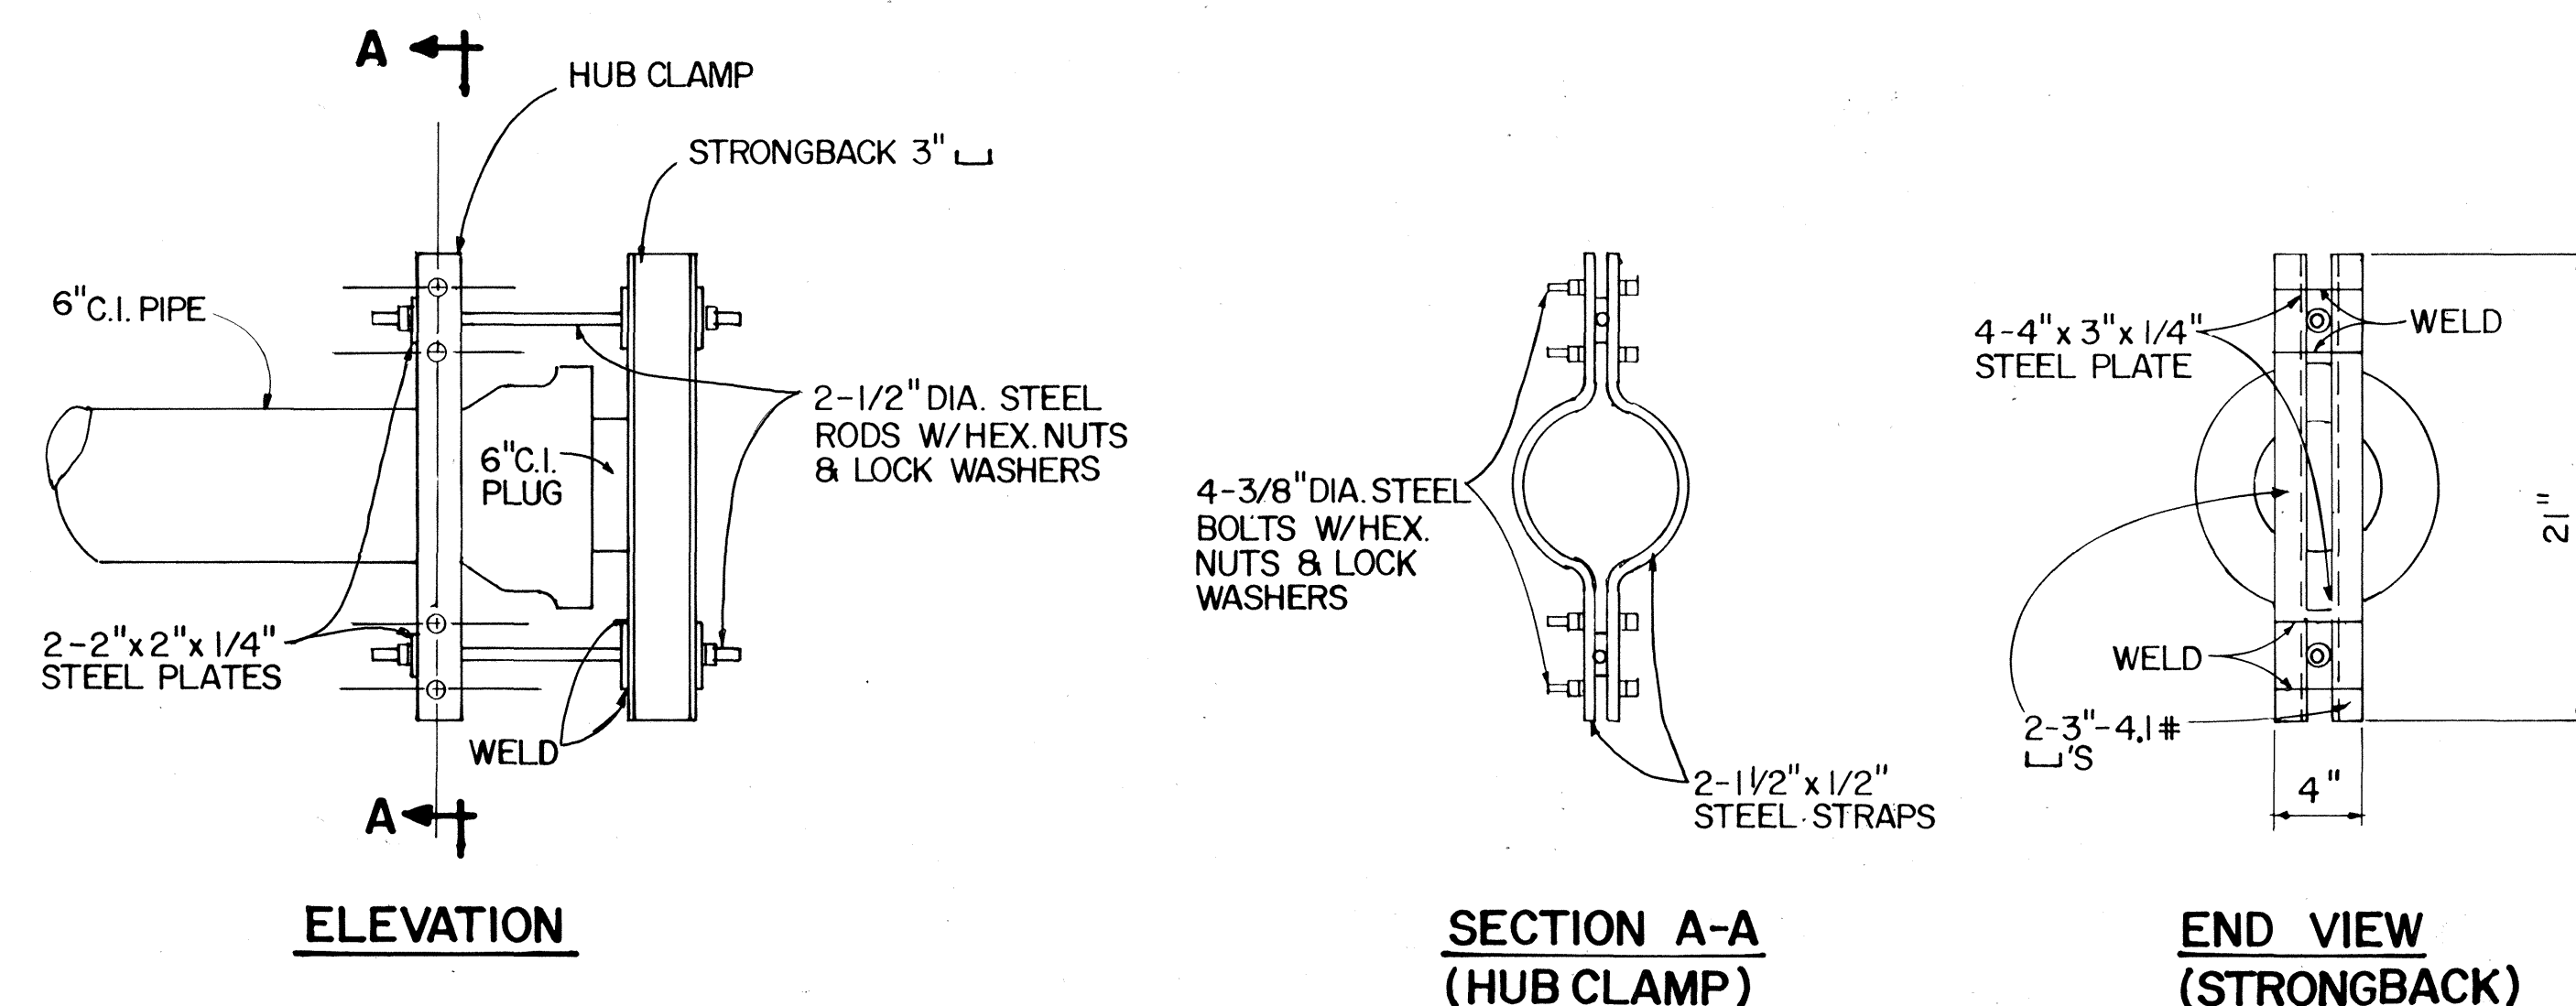

6" - HUB CLAMP & STRONGBACK ASSEMBLY
NOT TO SCALE

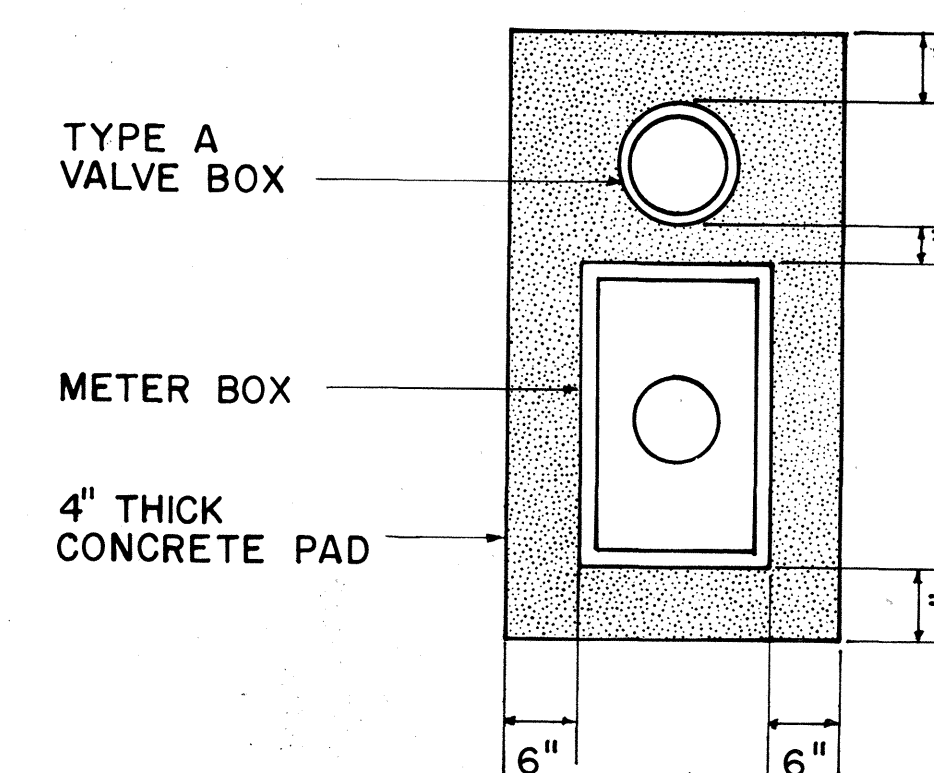


PLAN OF CONCRETE PAD FOR WATER METER IN DIRT AREAS
NOT TO SCALE

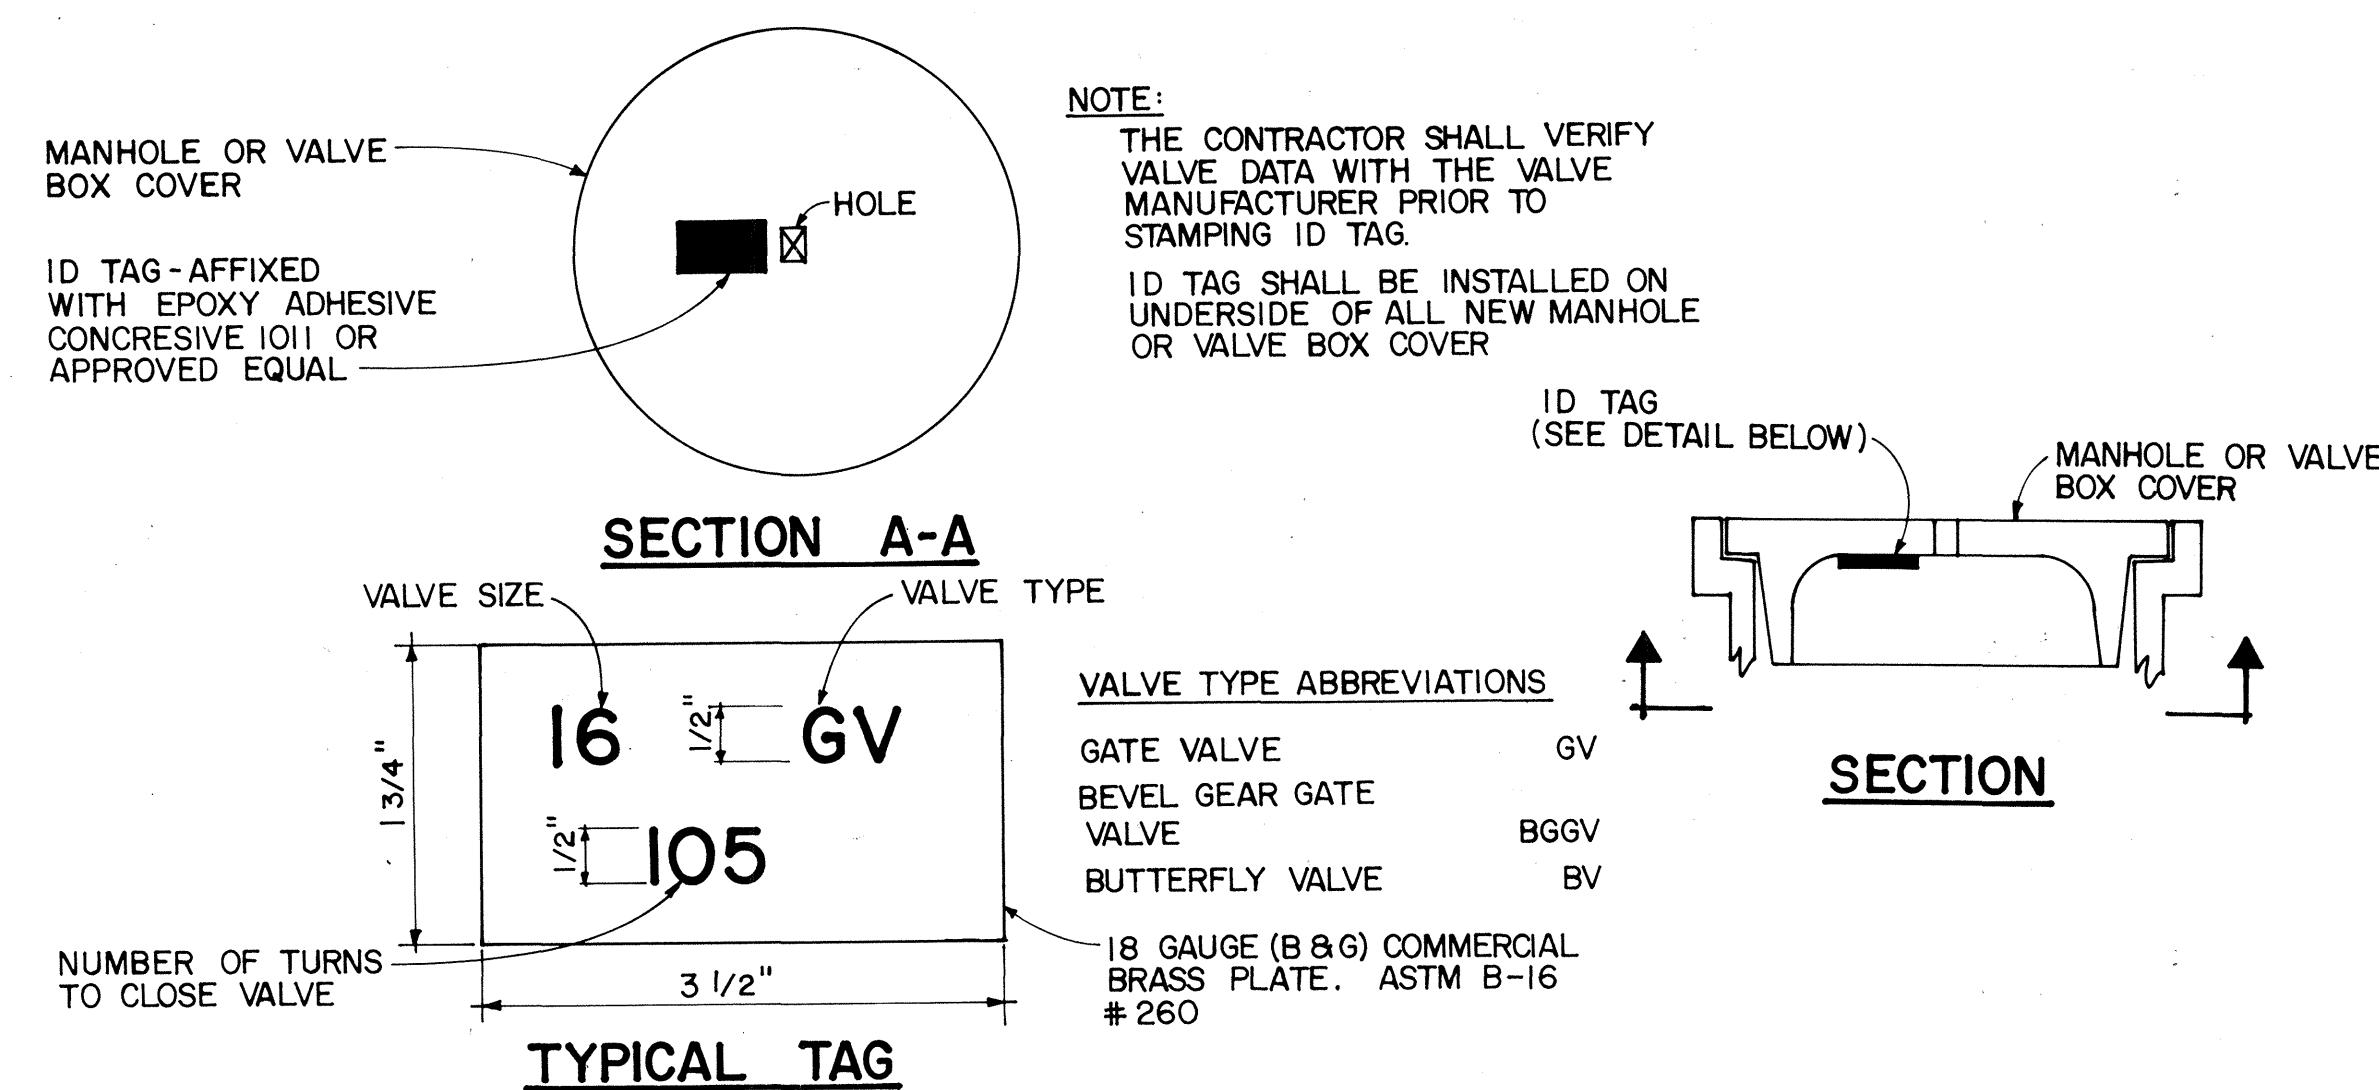

IDENTIFICATION TAG FOR MANHOLE OR VALVE BOX COVER
NOT TO SCALE

APPROVED *Arthur A. M. Makani* 10/3/78
CHIEF, PLANNING AND ENGINEERING, B.W.S. 4
CITY AND COUNTY OF HONOLULU DATE

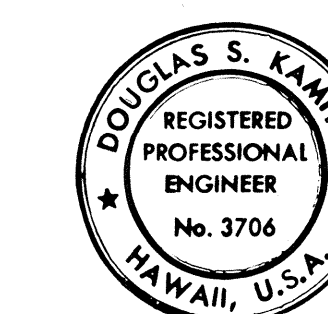

THIS WORK WAS PREPARED BY ME OR UNDER MY SUPERVISION.
Douglas S. Kanaka

STATE OF HAWAII
DEPARTMENT OF TRANSPORTATION
LAND TRANSPORTATION FACILITIES DIVISION
WATERLINE DETAILS
KAMEHAMEHA HIGHWAY IMPROVEMENT
(LIKELIKE HIGHWAY TO KOOLAU VIEW DRIVE)
PROJECT NO. F-083-1(10)
SCALE AS SHOWN DATE AUG 1978
SHEET No. 23 OF 38 SHEETS

**PROVIDE FOLLOWING WATER LINE AND FIRE
HYDRANT FITTINGS AND APPURTENANCES AT
THE STATIONS SHOWN IN THE SCHEDULE BELOW:**

FED. ROAD DIST. NO.	STATE	FED. AID PROJ. NO.	FISCAL YEAR	SHEET NO.	TOTAL SHEETS
HAWAII	HAW.	F-083- K(10)	1978	72	160

[illegible]

THIS WORK WAS PREPARED BY ME OR UNDER MY SUPERVISION.

Douglas S. Kammer

STATE OF HAWAII
DEPARTMENT OF TRANSPORTATION
LAND TRANSPORTATION FACILITIES DIVISION

**FITTINGS AND
APPURTENANCES SCHEDULE**

**KAMEHAMEHA HIGHWAY
IMPROVEMENT**
(LIKELIKE HIGHWAY TO KOOLAU VIEW DRIVE)
PROJECT NO. F - 083 - 1 (10)

SCALE _____ DATE **AUG 1978**

SHEET No. 24 OF 38 SHEETS

Pulling Iron (See Detail & Note of Typical Detail at Duct Window.)

Fin. Grade

Depth "D" Varies
Measured from lowest point of top of sidewalk refer to plan of project concerned.
(2'-6" max. depth)

6"

5'-0" ± Conc. Opening, See Note "5"

3/16" max. cl.

3/16" max. cl.

6"

3/8" Rounded edges all around

Sidewalk

#4 at 10" L

#4 at 8" W

End Entrance (See Detail Dwg. 16688)

3" cl.

Construction Joint as required. Water Stop required if joint occurs less than 6" above highest high water level.

Knockout for Future Ducts (See Detail)

5/8" φ x 8'-0" Copper-weld Ground Rod furnished and installed by Contractor

← Slope Fl. dn. 1/2" to sump

6" typ.

4"

4" - #4 x 2'-0" Diag. Reinf.

4"

1'-0"

6"

6"

8"



2'-10"

6"

12" sq. x 12" deep closed sump (If open sump is used, See Open Sump Detail)

SECTION "A-A"

Scale : 1" = 1'-0"

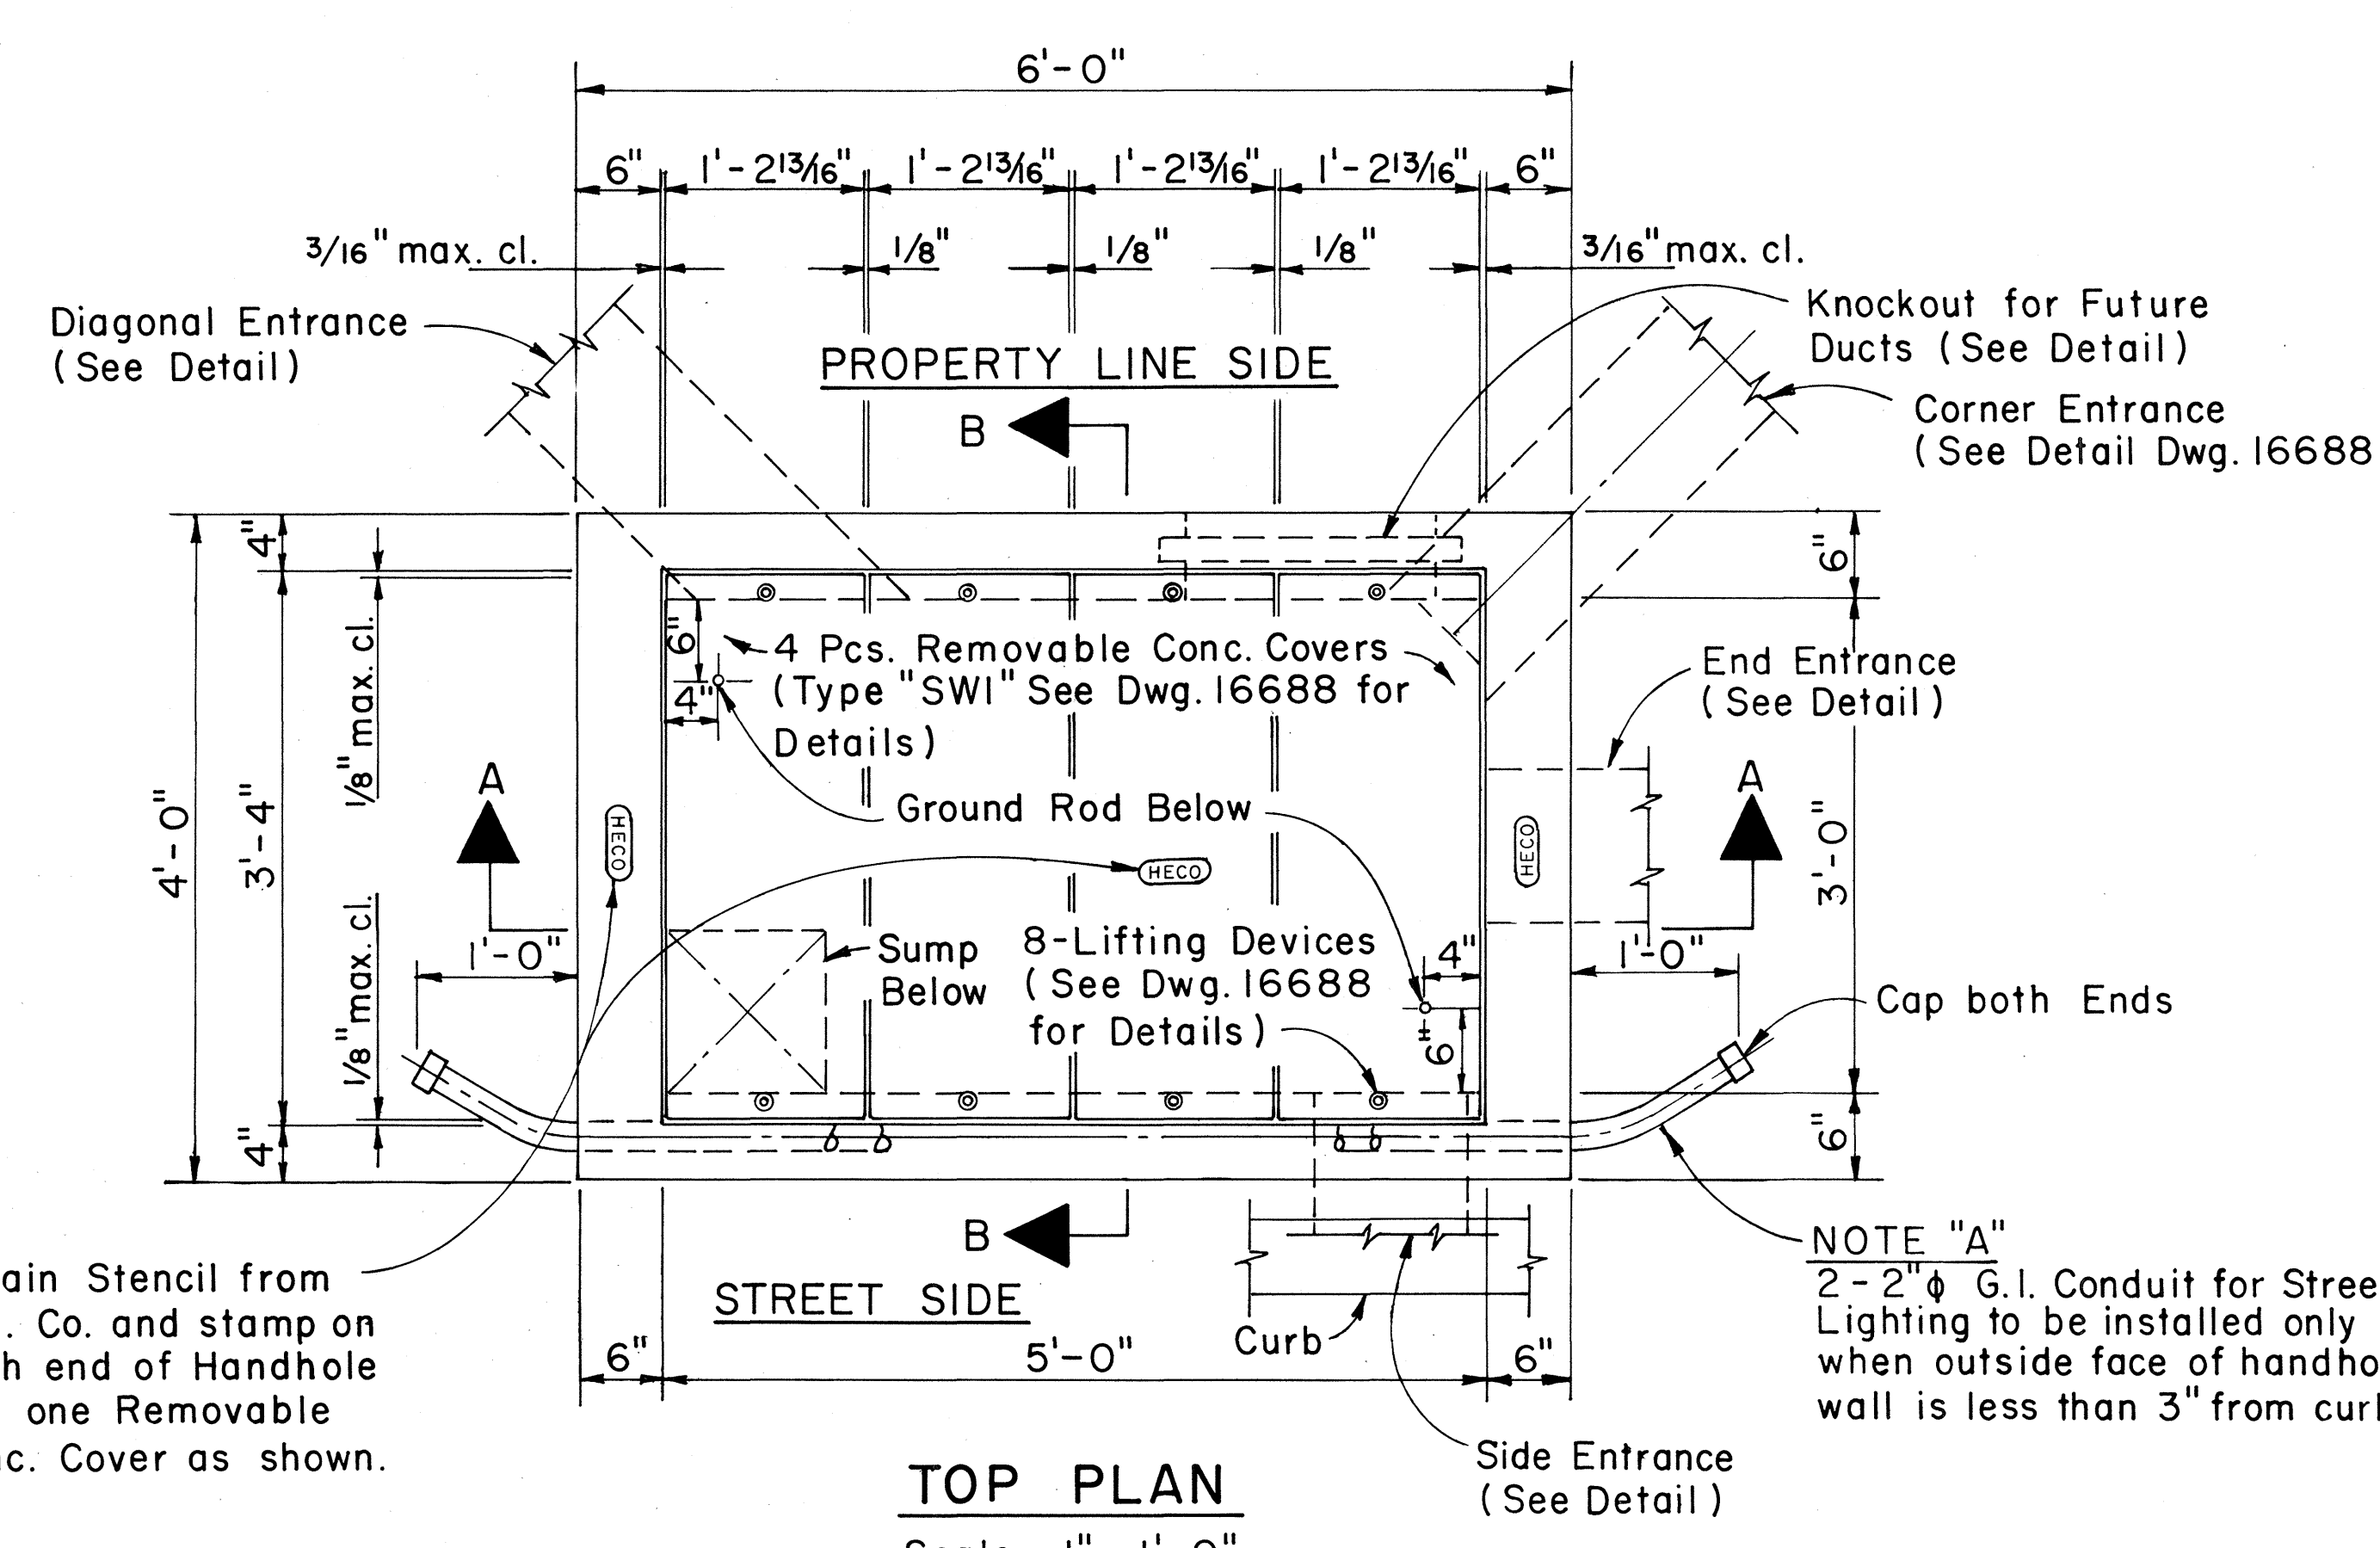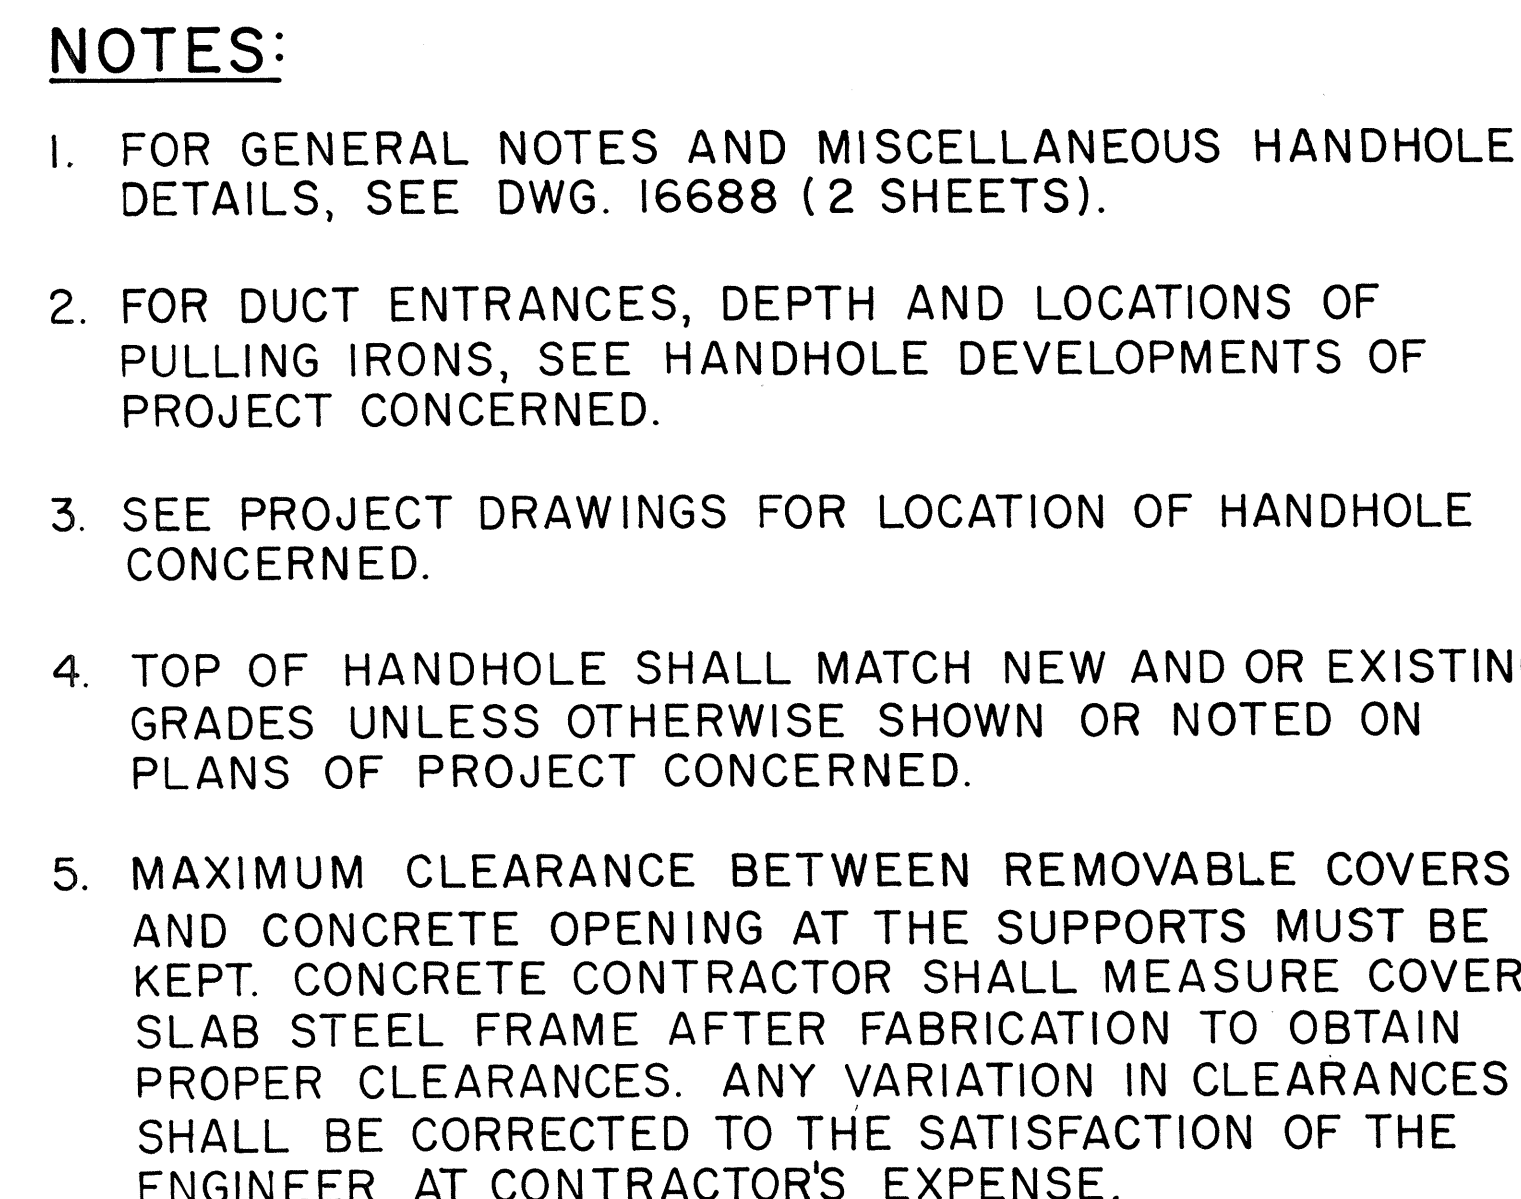

MATERIAL QUANTITIES

QUANTITY OF MATERIALS REQUIRED FOR DEPTH "D" = 2'-6" max.

Total concrete	= 2.05 cu. yds.
Total reinf. steel	= 300 lbs.
Total misc. steel	= 157 lbs.

WEIGHT PER REMOVABLE CONCRETE COVER

Concrete	= 118 lbs.
Reinf. steel	= 4 lbs.
Misc. steel	= <u>37 lbs.</u>
Total	159 lbs.

MATERIALS FOR 6" DEPTH OF 6" THICK WALL,


Concrete	= 0.17 cu. yds.
Reinf. steel	= 19 lbs.

FOR USE IN AREAS NOT SUBJECT
TO VEHICULAR TRAFFIC.

APPROVED :
WLS WKS 9-14-78
HAWAIIAN ELECTRIC Co., Inc. DATE


HECo., Inc.	Drawing	Number
18841	SHEET No. 1 OF 1 SHEET	
STATE OF HAWAII DEPARTMENT OF TRANSPORTATION LAND TRANSPORTATION FACILITIES DIVISION		
<u>STANDARD DETAILS</u>		
<u>HANDHOLE TYPE 35</u> <u>(3'-0" x 5'-0")</u>		
<u>UNDERGROUND STANDARDS</u>		
SCALE : AS NOTED		AUG 1978
SHEET NO. 25 OF 38 SHEETS		

FED. ROAD DIST. NO.	STATE	FED. AID PROJ. NO.	FISCAL YEAR	SHEET NO.	TOTAL SHEETS
HAWAII	HAW.	F-083-110	1978	74	160

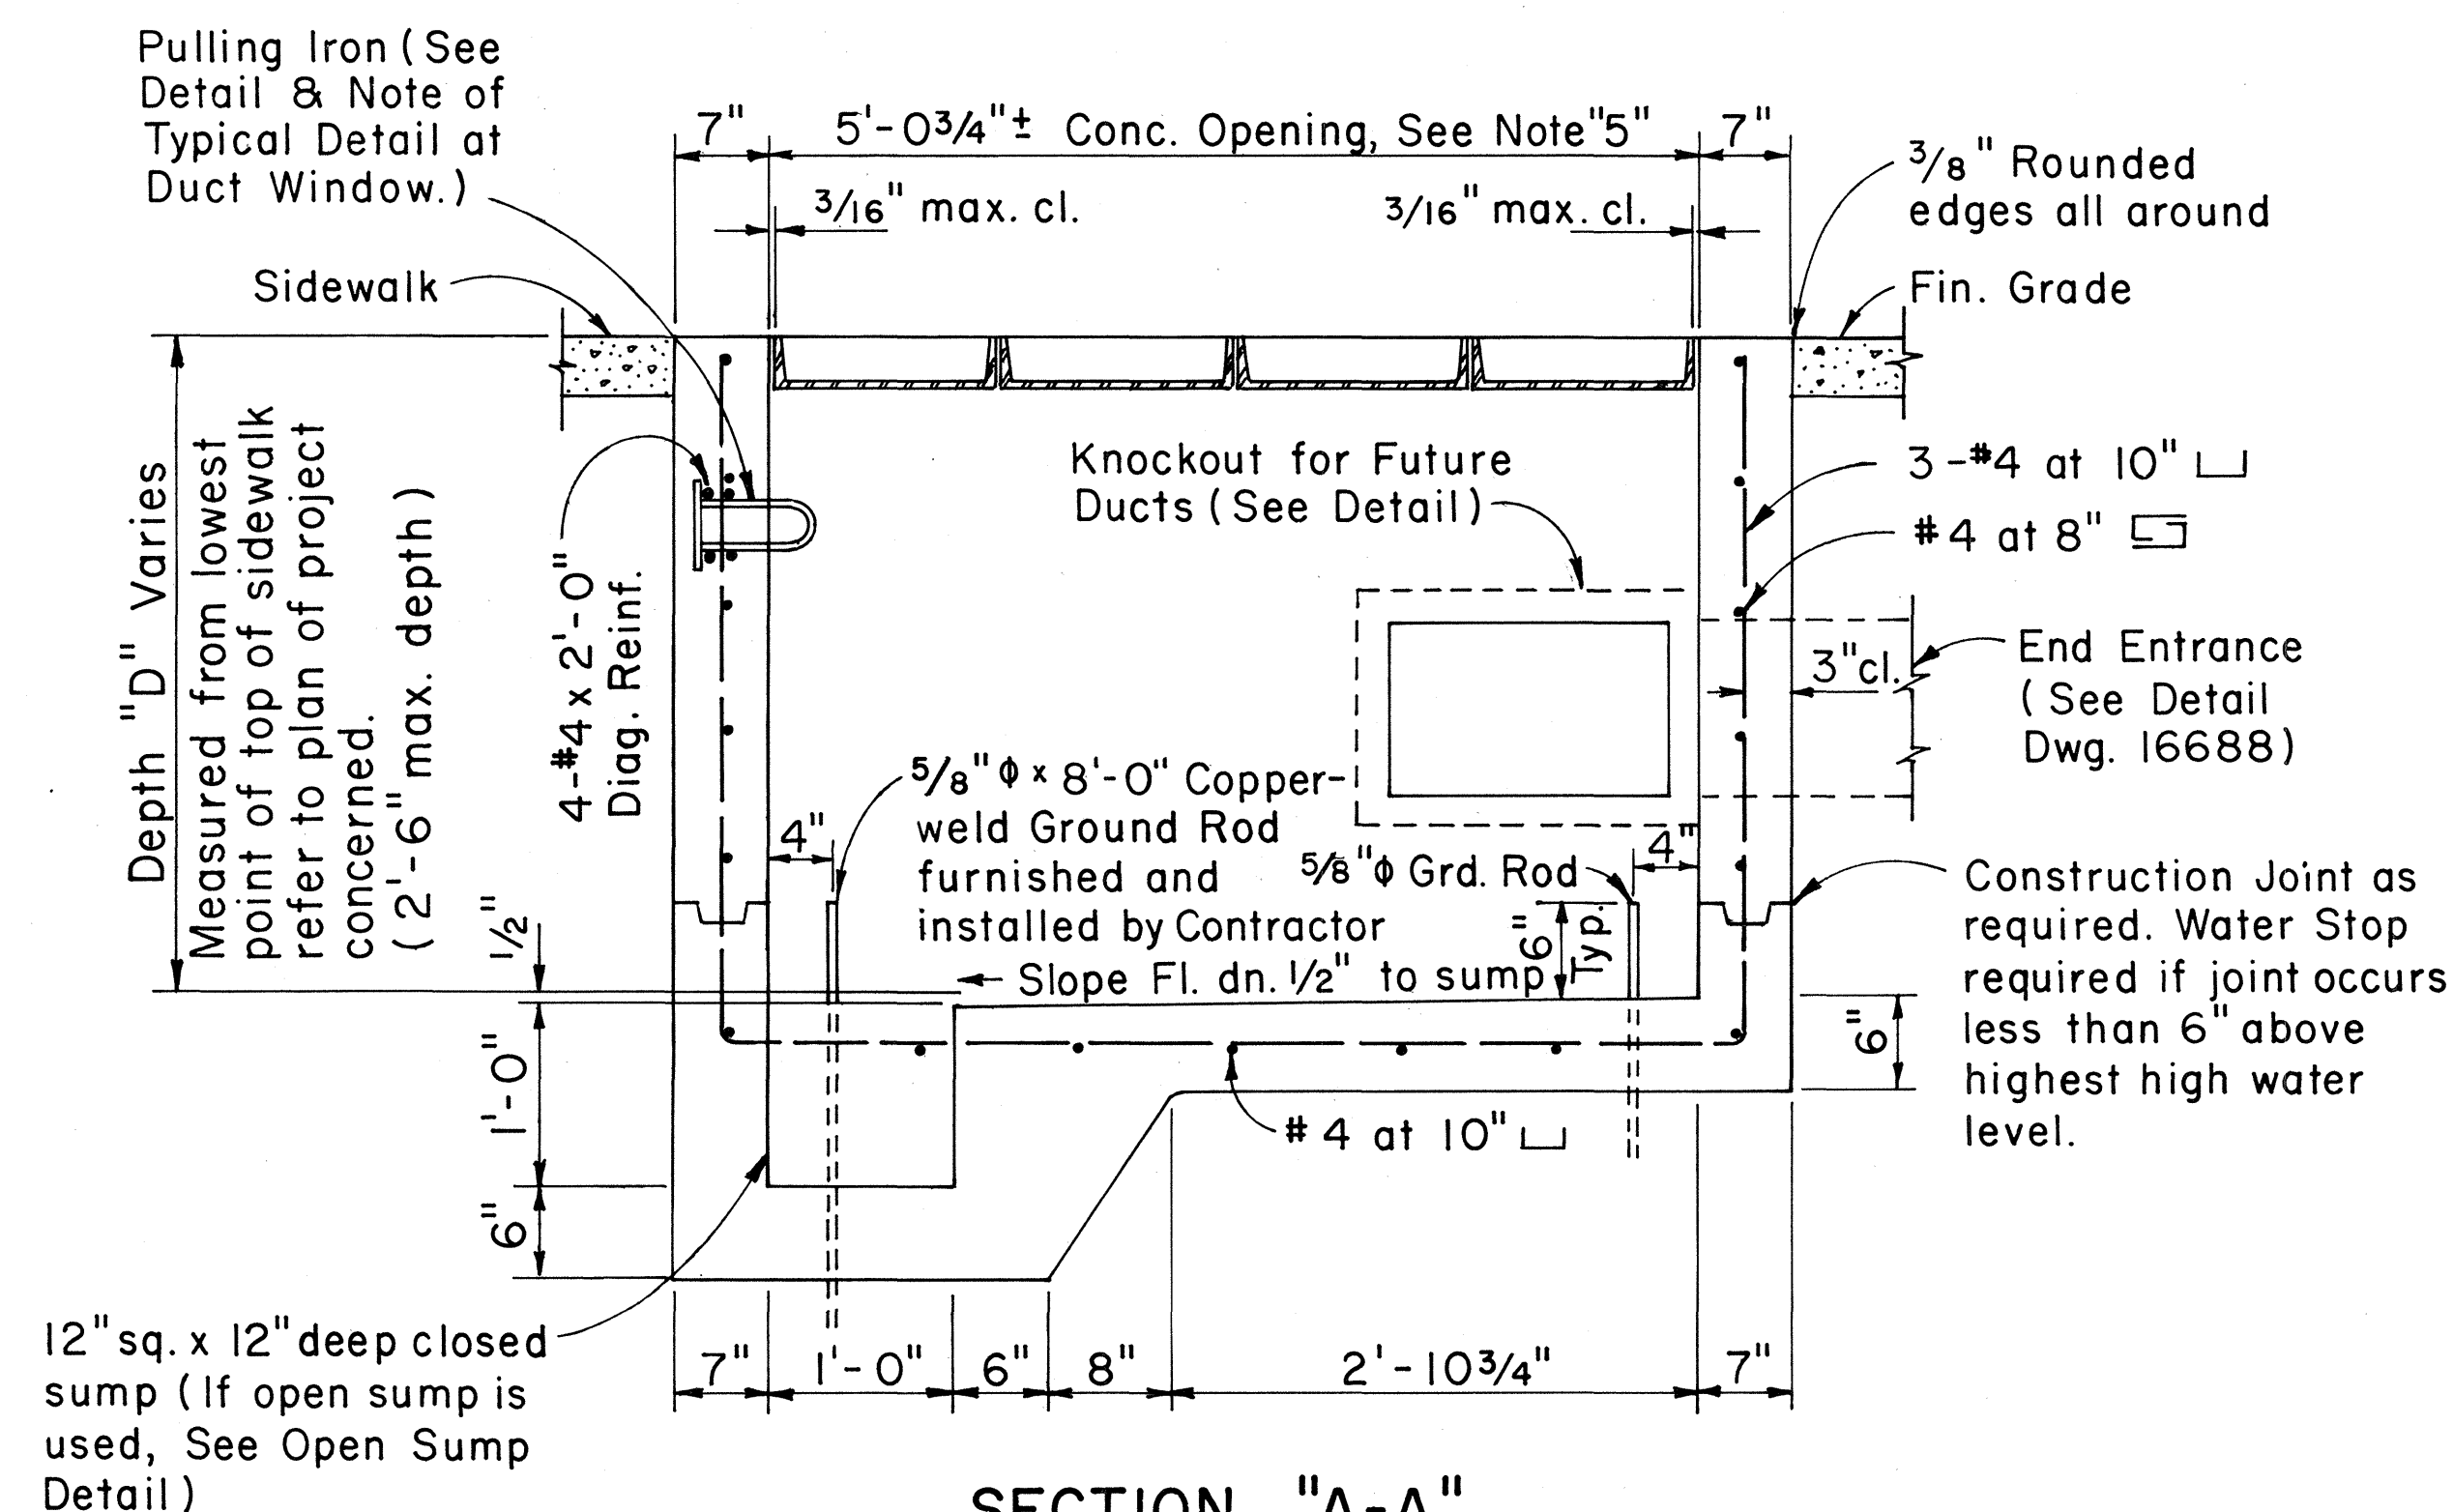

SECTION "A-A"

Scale: 1" = 1'-0"

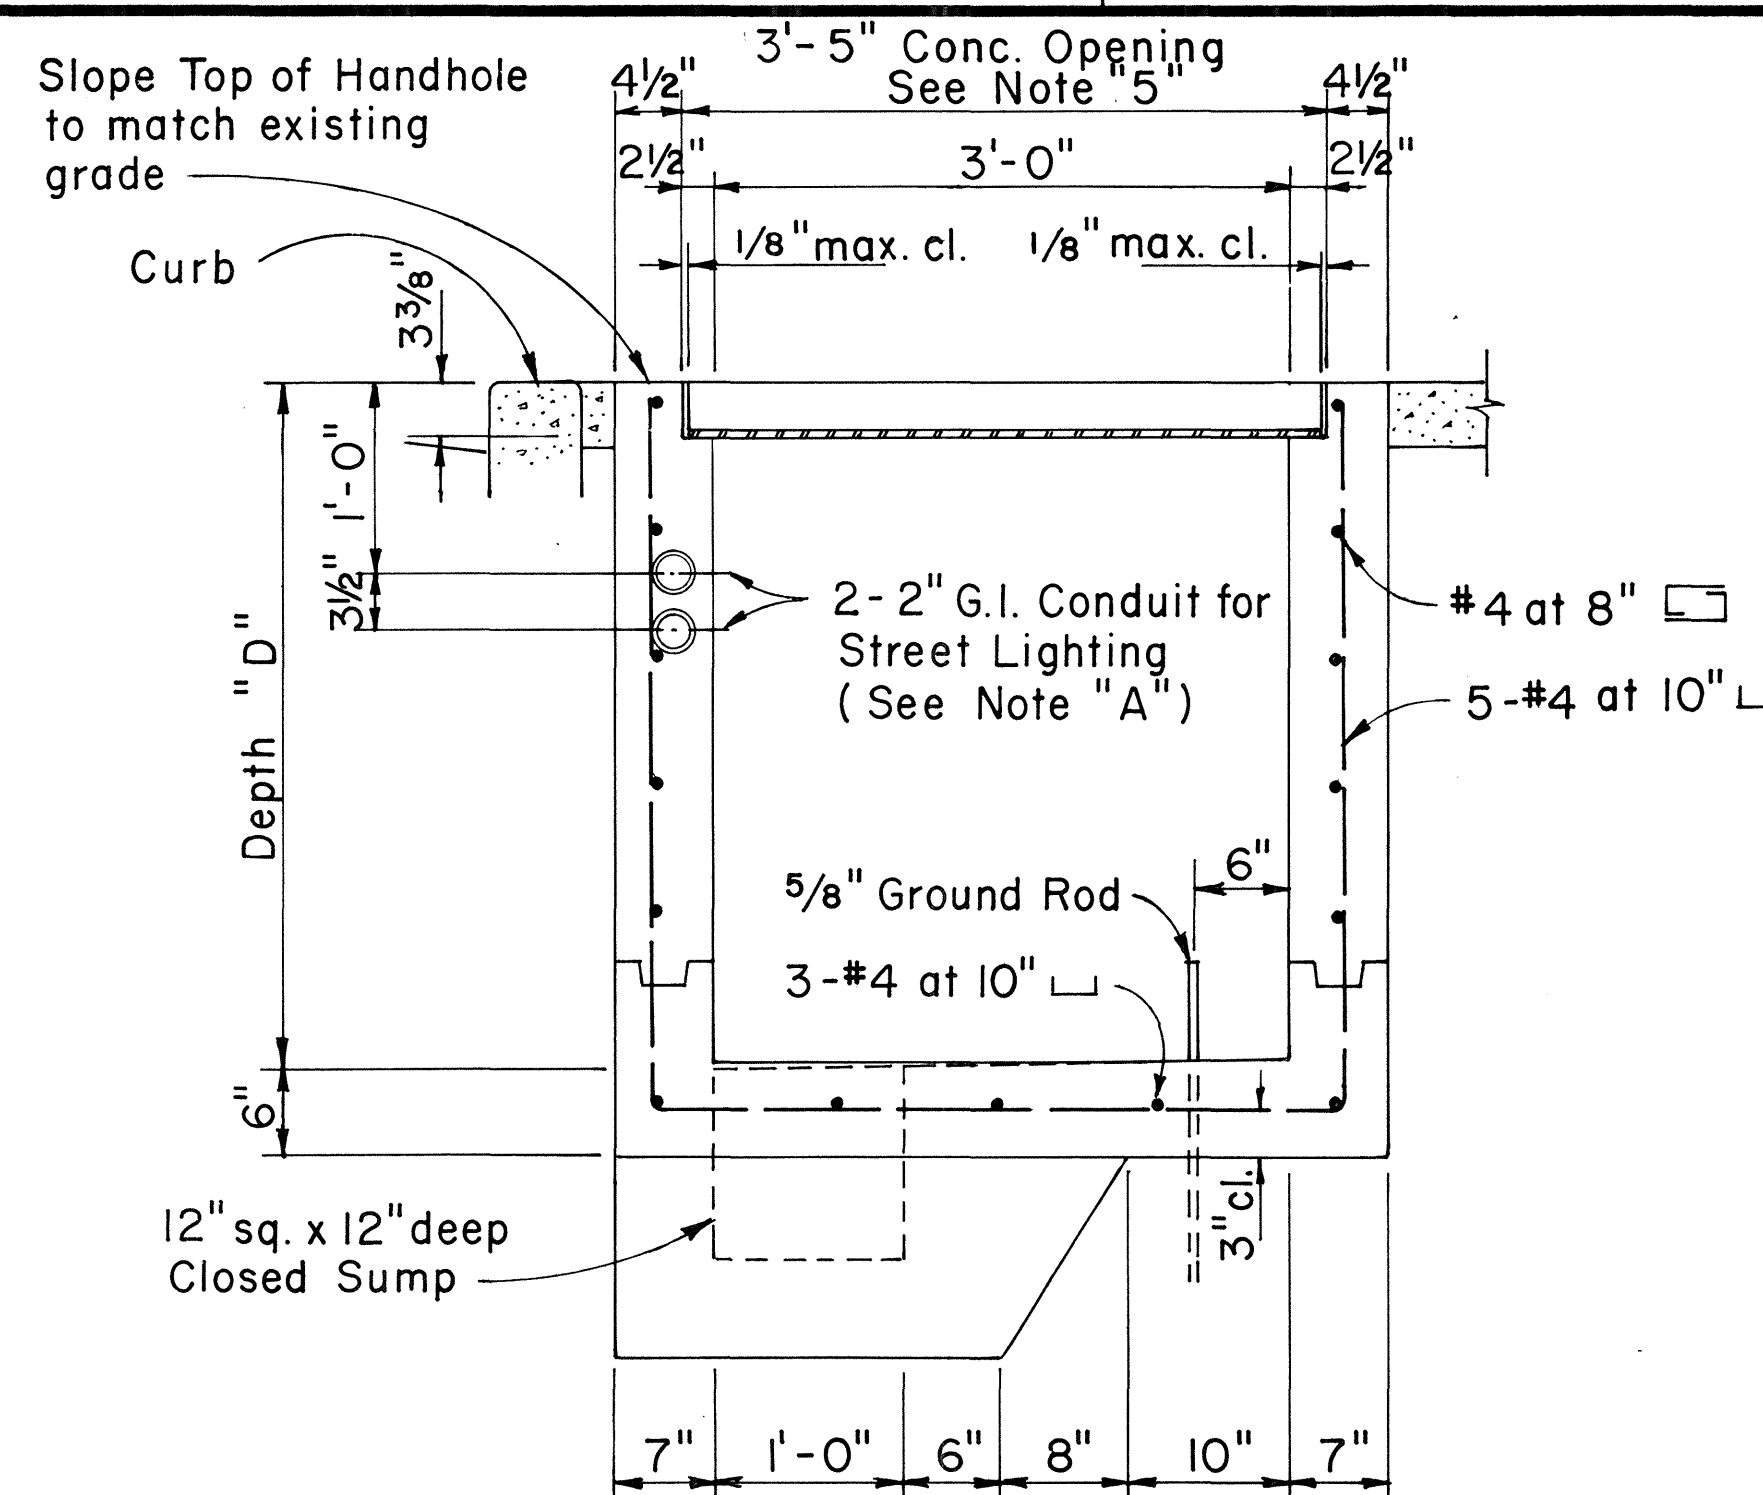


SECTION "B-B"

Scale: 1" = 1'-0"

NOTES:

- FOR GENERAL NOTES AND MISCELLANEOUS HANDHOLE DETAILS, SEE DWG. 16688 (2 SHEETS).
- FOR DUCT ENTRANCES, DEPTH AND LOCATIONS OF PULLING IRONS, SEE HANDHOLE DEVELOPMENTS OF PROJECT CONCERNED.
- SEE PROJECT DRAWINGS FOR LOCATION OF HANDHOLE CONCERNED.
- TOP OF HANDHOLE SHALL MATCH NEW AND OR EXISTING GRADES UNLESS OTHERWISE SHOWN OR NOTED ON PLANS OF PROJECT CONCERNED.
- MAXIMUM CLEARANCE BETWEEN REMOVABLE COVERS AND CONCRETE OPENING AT THE SUPPORTS MUST BE KEPT. CONCRETE CONTRACTOR SHALL MEASURE COVER SLAB STEEL FRAME AFTER FABRICATION TO OBTAIN PROPER CLEARANCES. ANY VARIATION IN CLEARANCES SHALL BE CORRECTED TO THE SATISFACTION OF THE ENGINEER AT CONTRACTOR'S EXPENSE.

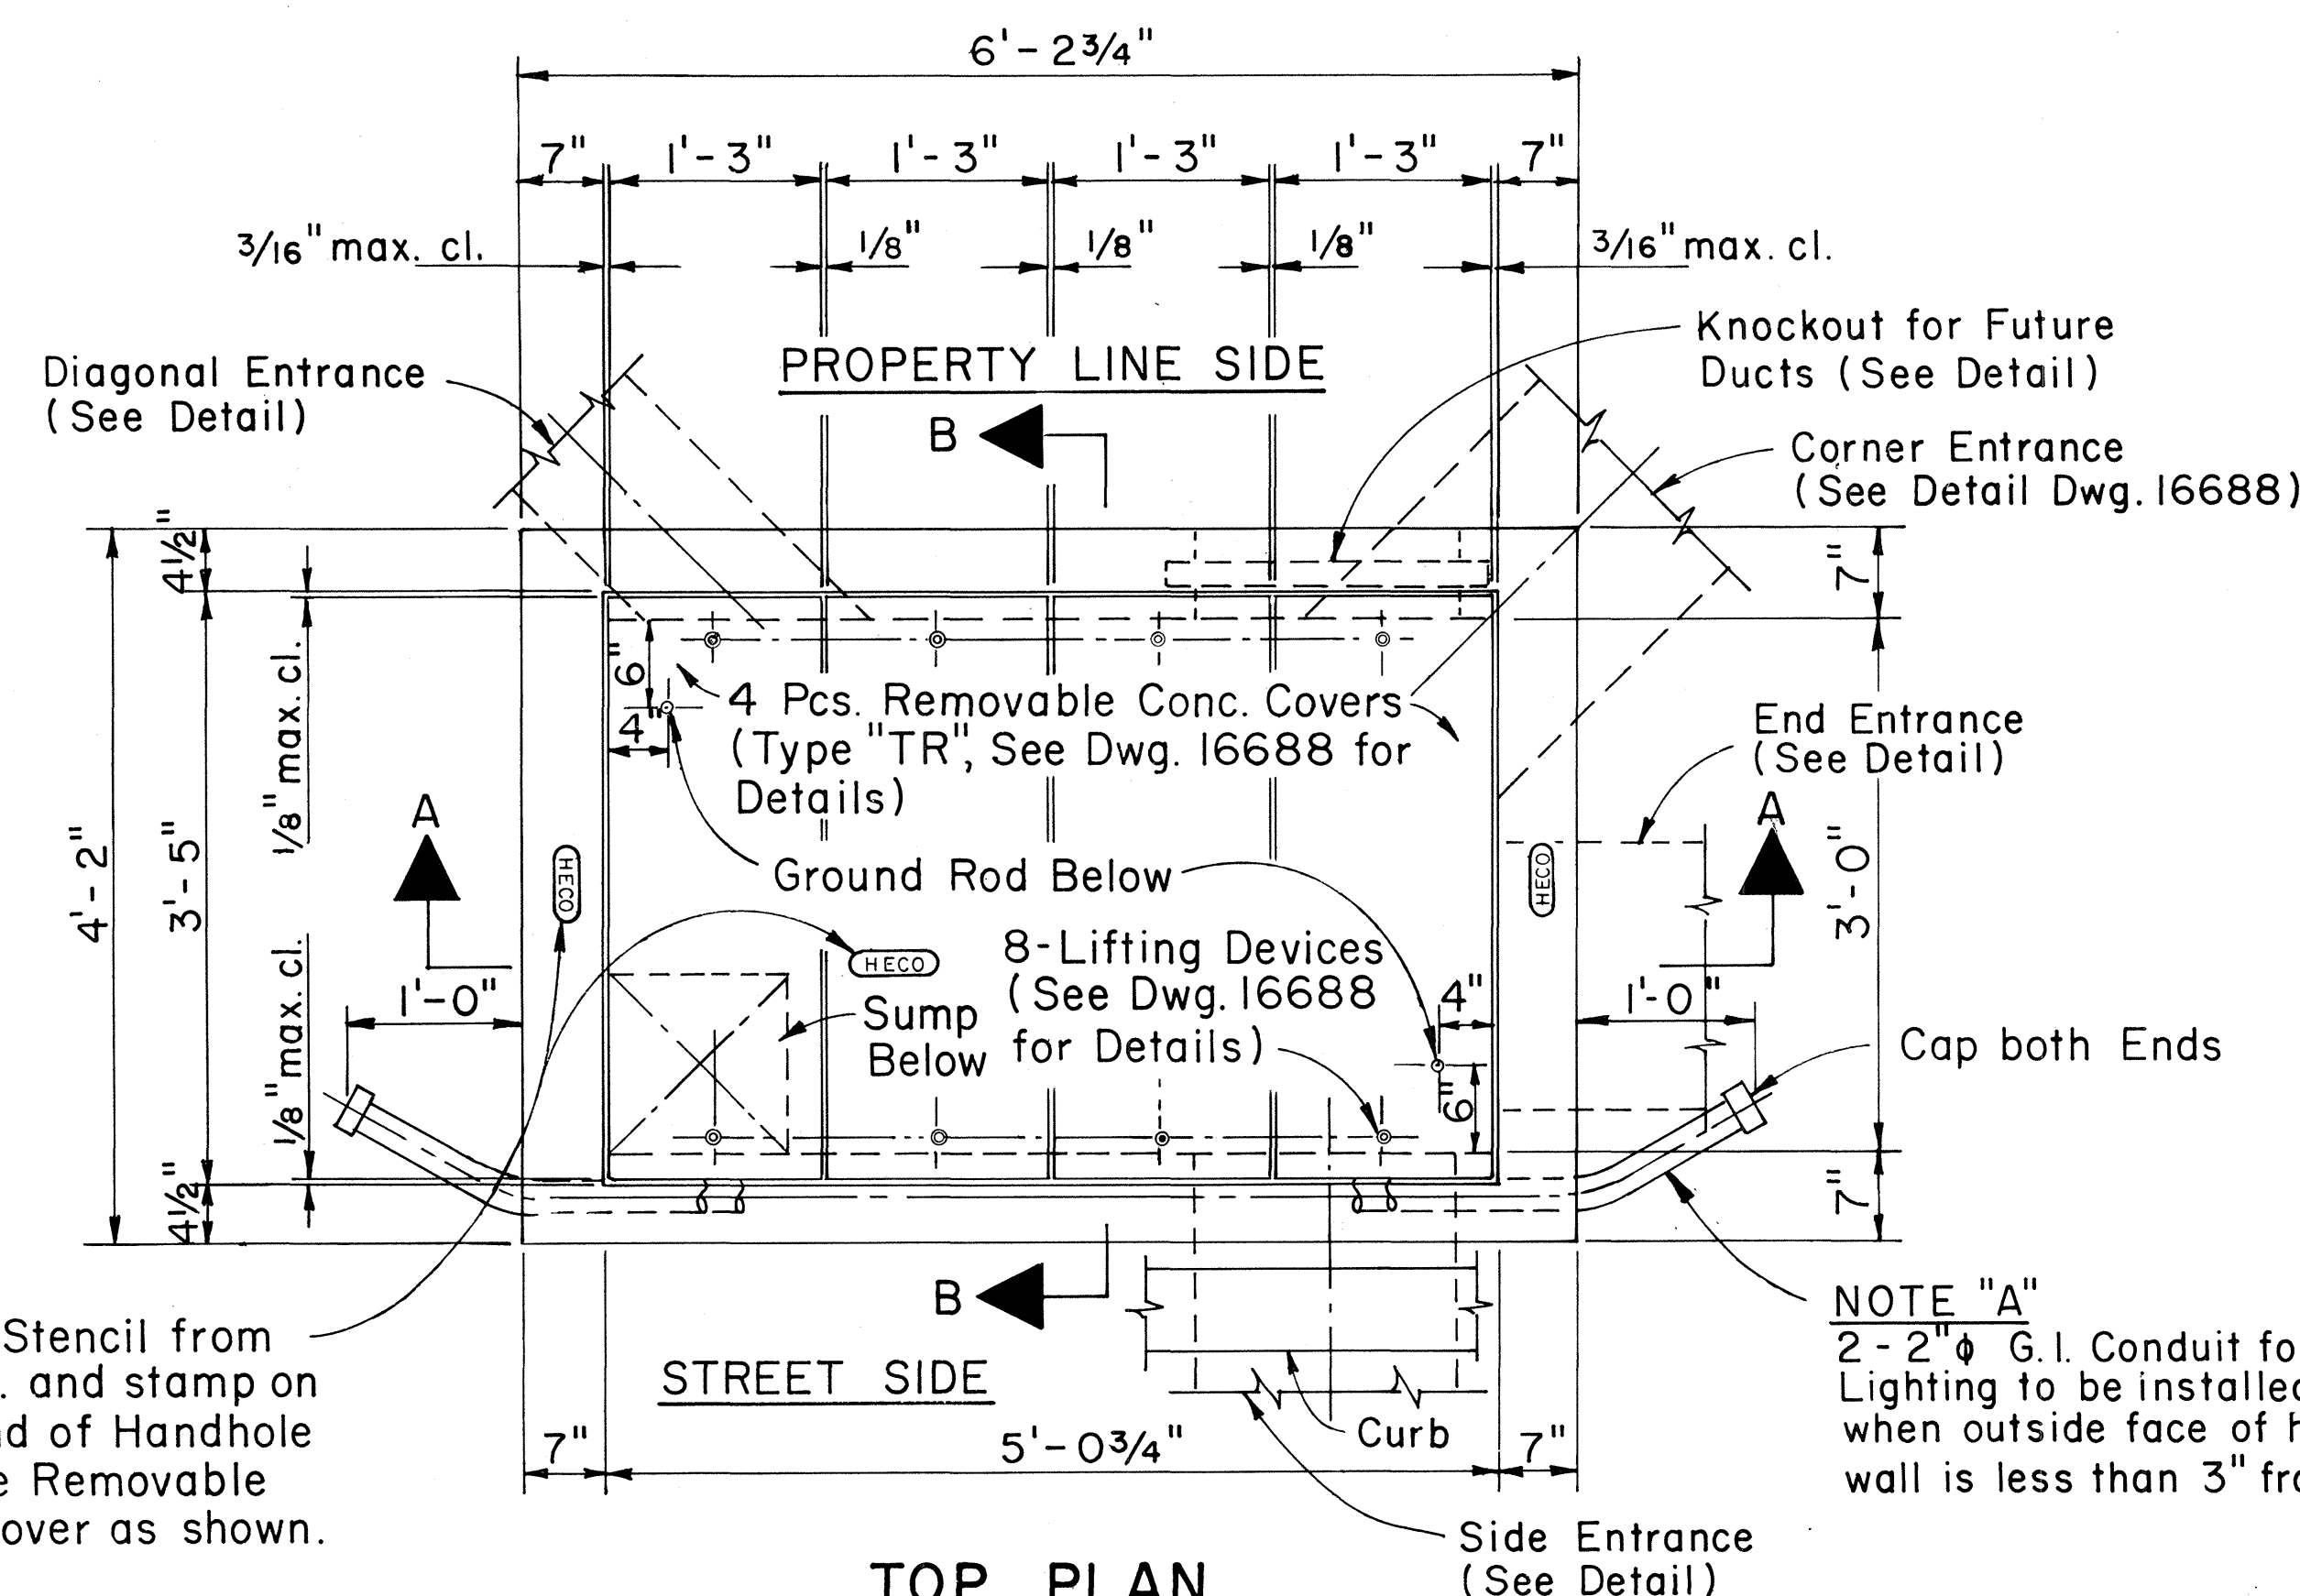

TOP PLAN

Scale: 1" = 1'-0"

MATERIAL QUANTITIES

QUANTITY OF MATERIALS FOR DEPTH "D" = 2'-6" max.	
Total concrete	= 2.42 cu. yds.
Total reinf. steel	= 305 lbs.
Total misc. steel	= 471 lbs.
WEIGHT PER REMOVABLE CONCRETE COVER	
Concrete	= 141 lbs.
Reinf. steel	= 6 lbs.
Misc. steel	= 115 lbs.
Total	262 lbs.
MATERIALS FOR 6" DEPTH OF 7" THICK WALL,	
Concrete	= 20 cu. yds.
Reinf. steel	= 20 lbs.

FOR USE IN AREAS SUBJECT TO LIGHT VEHICULAR TRAFFIC.

APPROVED:

mg *W. H. H. H.*
HAWAIIAN ELECTRIC Co., Inc.


9-14-78
DATE

HECo., Inc.	Drawing	Number
18841		
SHEET No. 1 OF 1 SHEET		
STATE OF HAWAII DEPARTMENT OF TRANSPORTATION LAND TRANSPORTATION FACILITIES DIVISION		
STANDARD DETAILS HANDHOLE TYPE 35V (3'-0" x 5'-0") UNDERGROUND STANDARDS		
SCALE: AS NOTED	AUG	1978
SHEET No. 26 OF 38 SHEETS		


FED. ROAD DIST. NO.	STATE	FED. AID PROJ. NO.	FISCAL YEAR	SHEET NO.	TOTAL SHEETS
HAWAII	HAWAII	F-083-100	1978	75	160

NOTES:

- FOR GENERAL NOTES AND MISCELLANEOUS DETAILS, REFER TO DWY. 16688 (2 SHEETS).
- MAXIMUM CLEARANCES BETWEEN REMOVABLE CONCRETE COVERS AND CONCRETE OPENING AT THE SUPPORTS MUST BE KEPT. CONCRETE CONTRACTOR SHALL MEASURE COVER SLAB STEEL FRAME AFTER FABRICATION TO OBTAIN PROPER CLEARANCES. ANY VARIATION IN CLEARANCES SHALL BE CORRECTED TO THE SATISFACTION OF THE ENGINEER AT CONTRACTOR'S EXPENSE.
- TWO-2" Ø G.I. COND. FOR STREET LIGHTING TO BE INSTALLED ONLY WHEN OUTSIDE FACE OF HANDHOLE IS LESS THAN 3" FROM CURBING.
- TOP OF HANDHOLE SHALL MATCH NEW AND/OR EXISTING GRADES UNLESS OTHERWISE SHOWN OR NOTED ON PLANS OF PROJECT CONCERNED.
- FOR DUCT ENTRANCES, DEPTH AND LOCATIONS OF PULLING IRONS, SEE HANDHOLE DEVELOPMENTS OF PROJECT CONCERNED.
- SEE PROJECT DRAWING FOR LOCATION OF HANDHOLE CONCERNED.

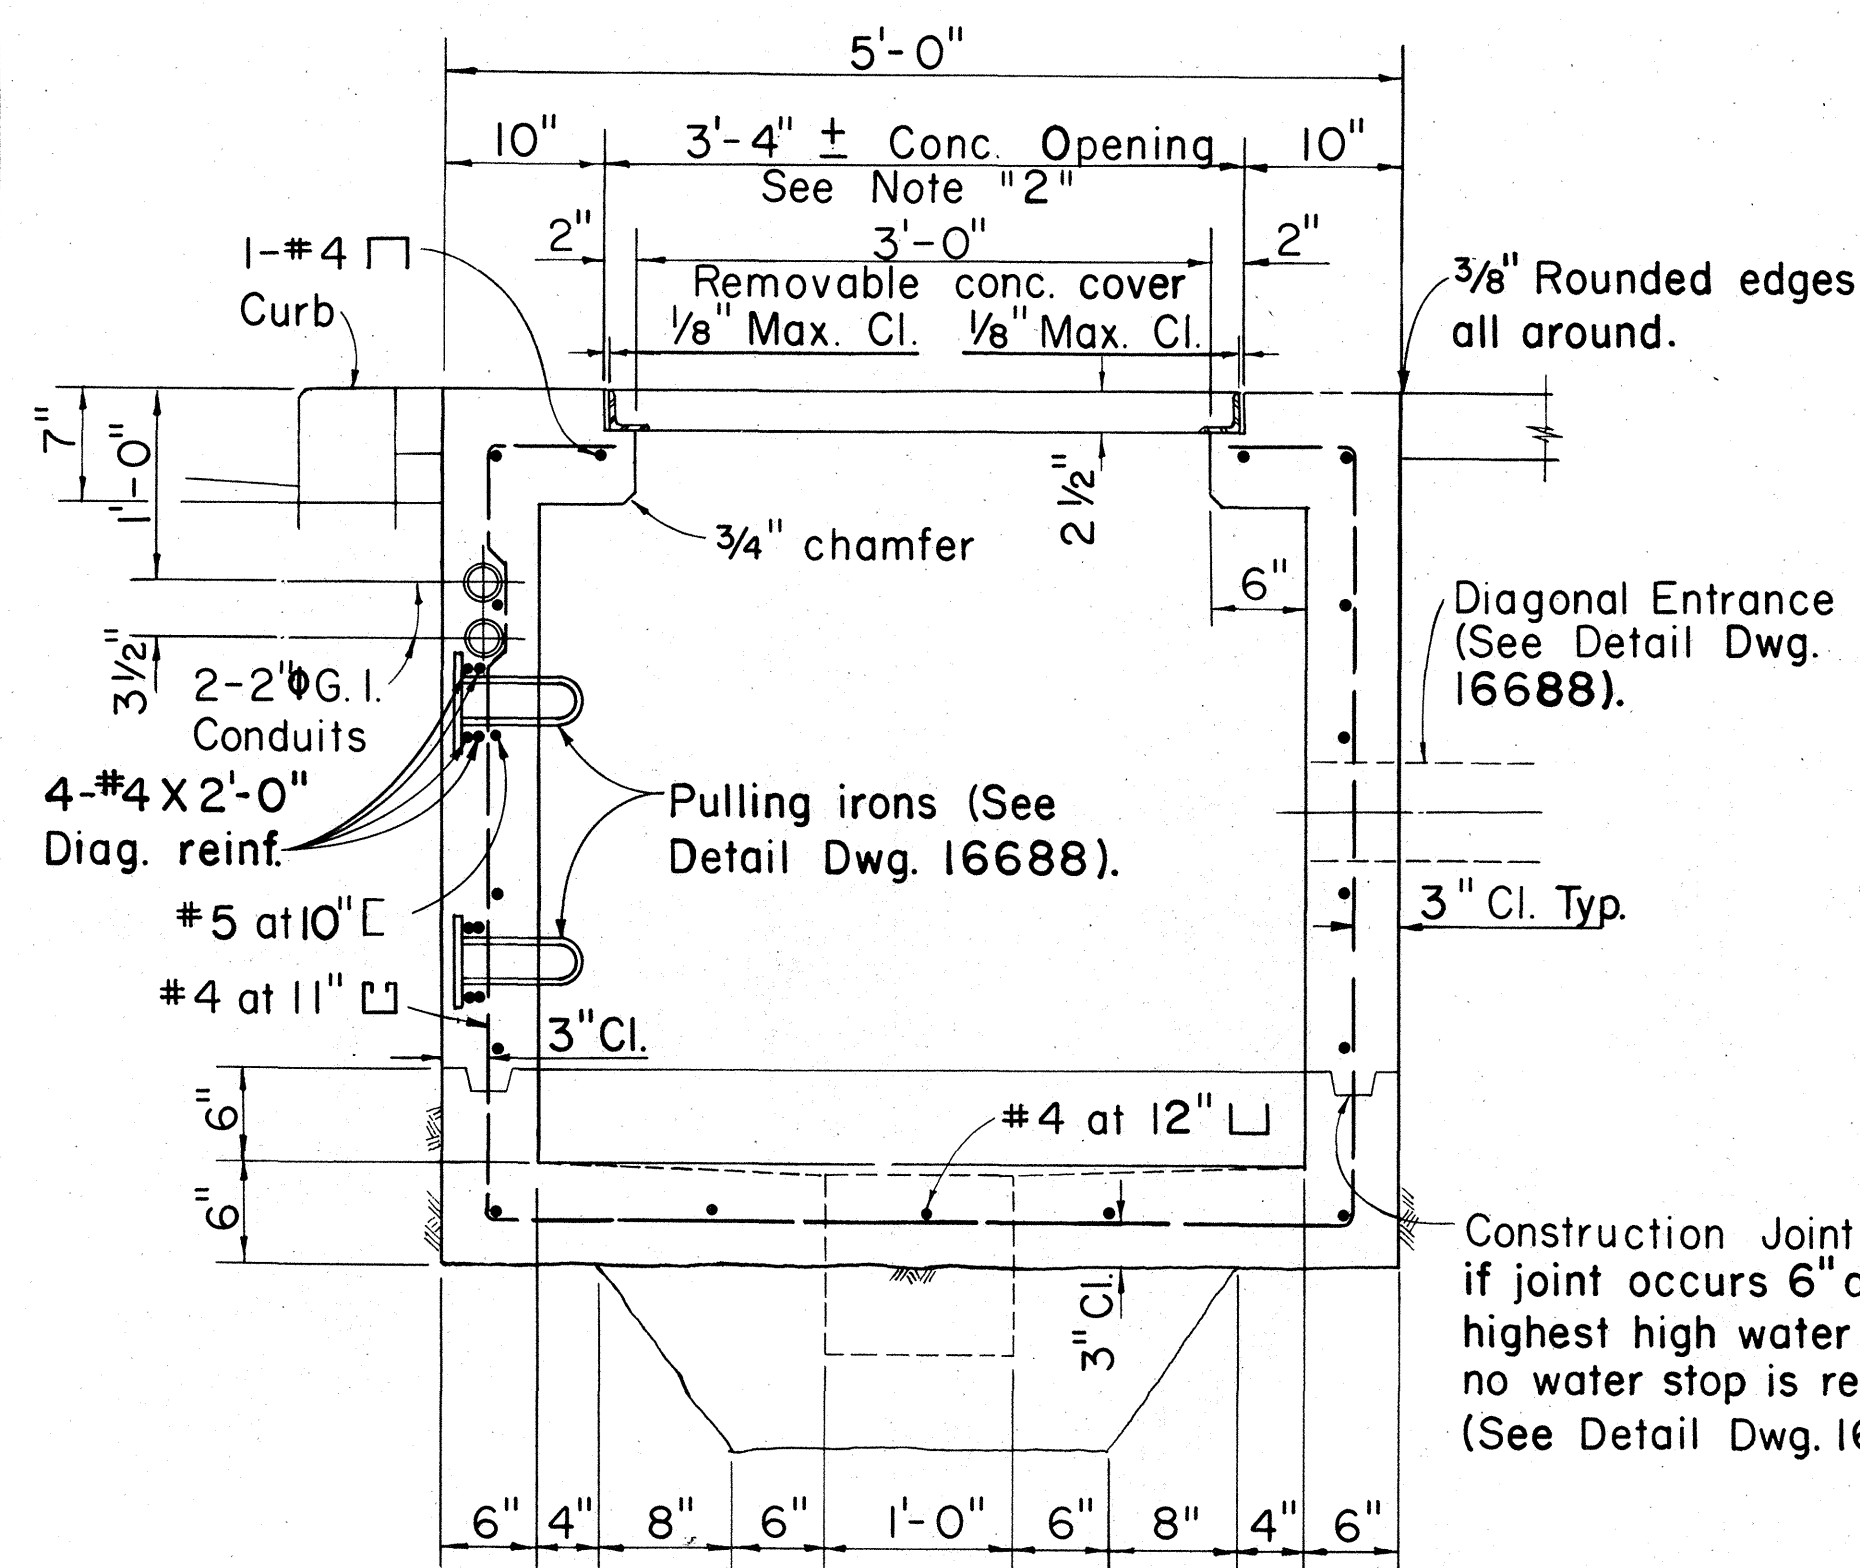

SECTION "B-B"
Scale: 1" = 1'-0"

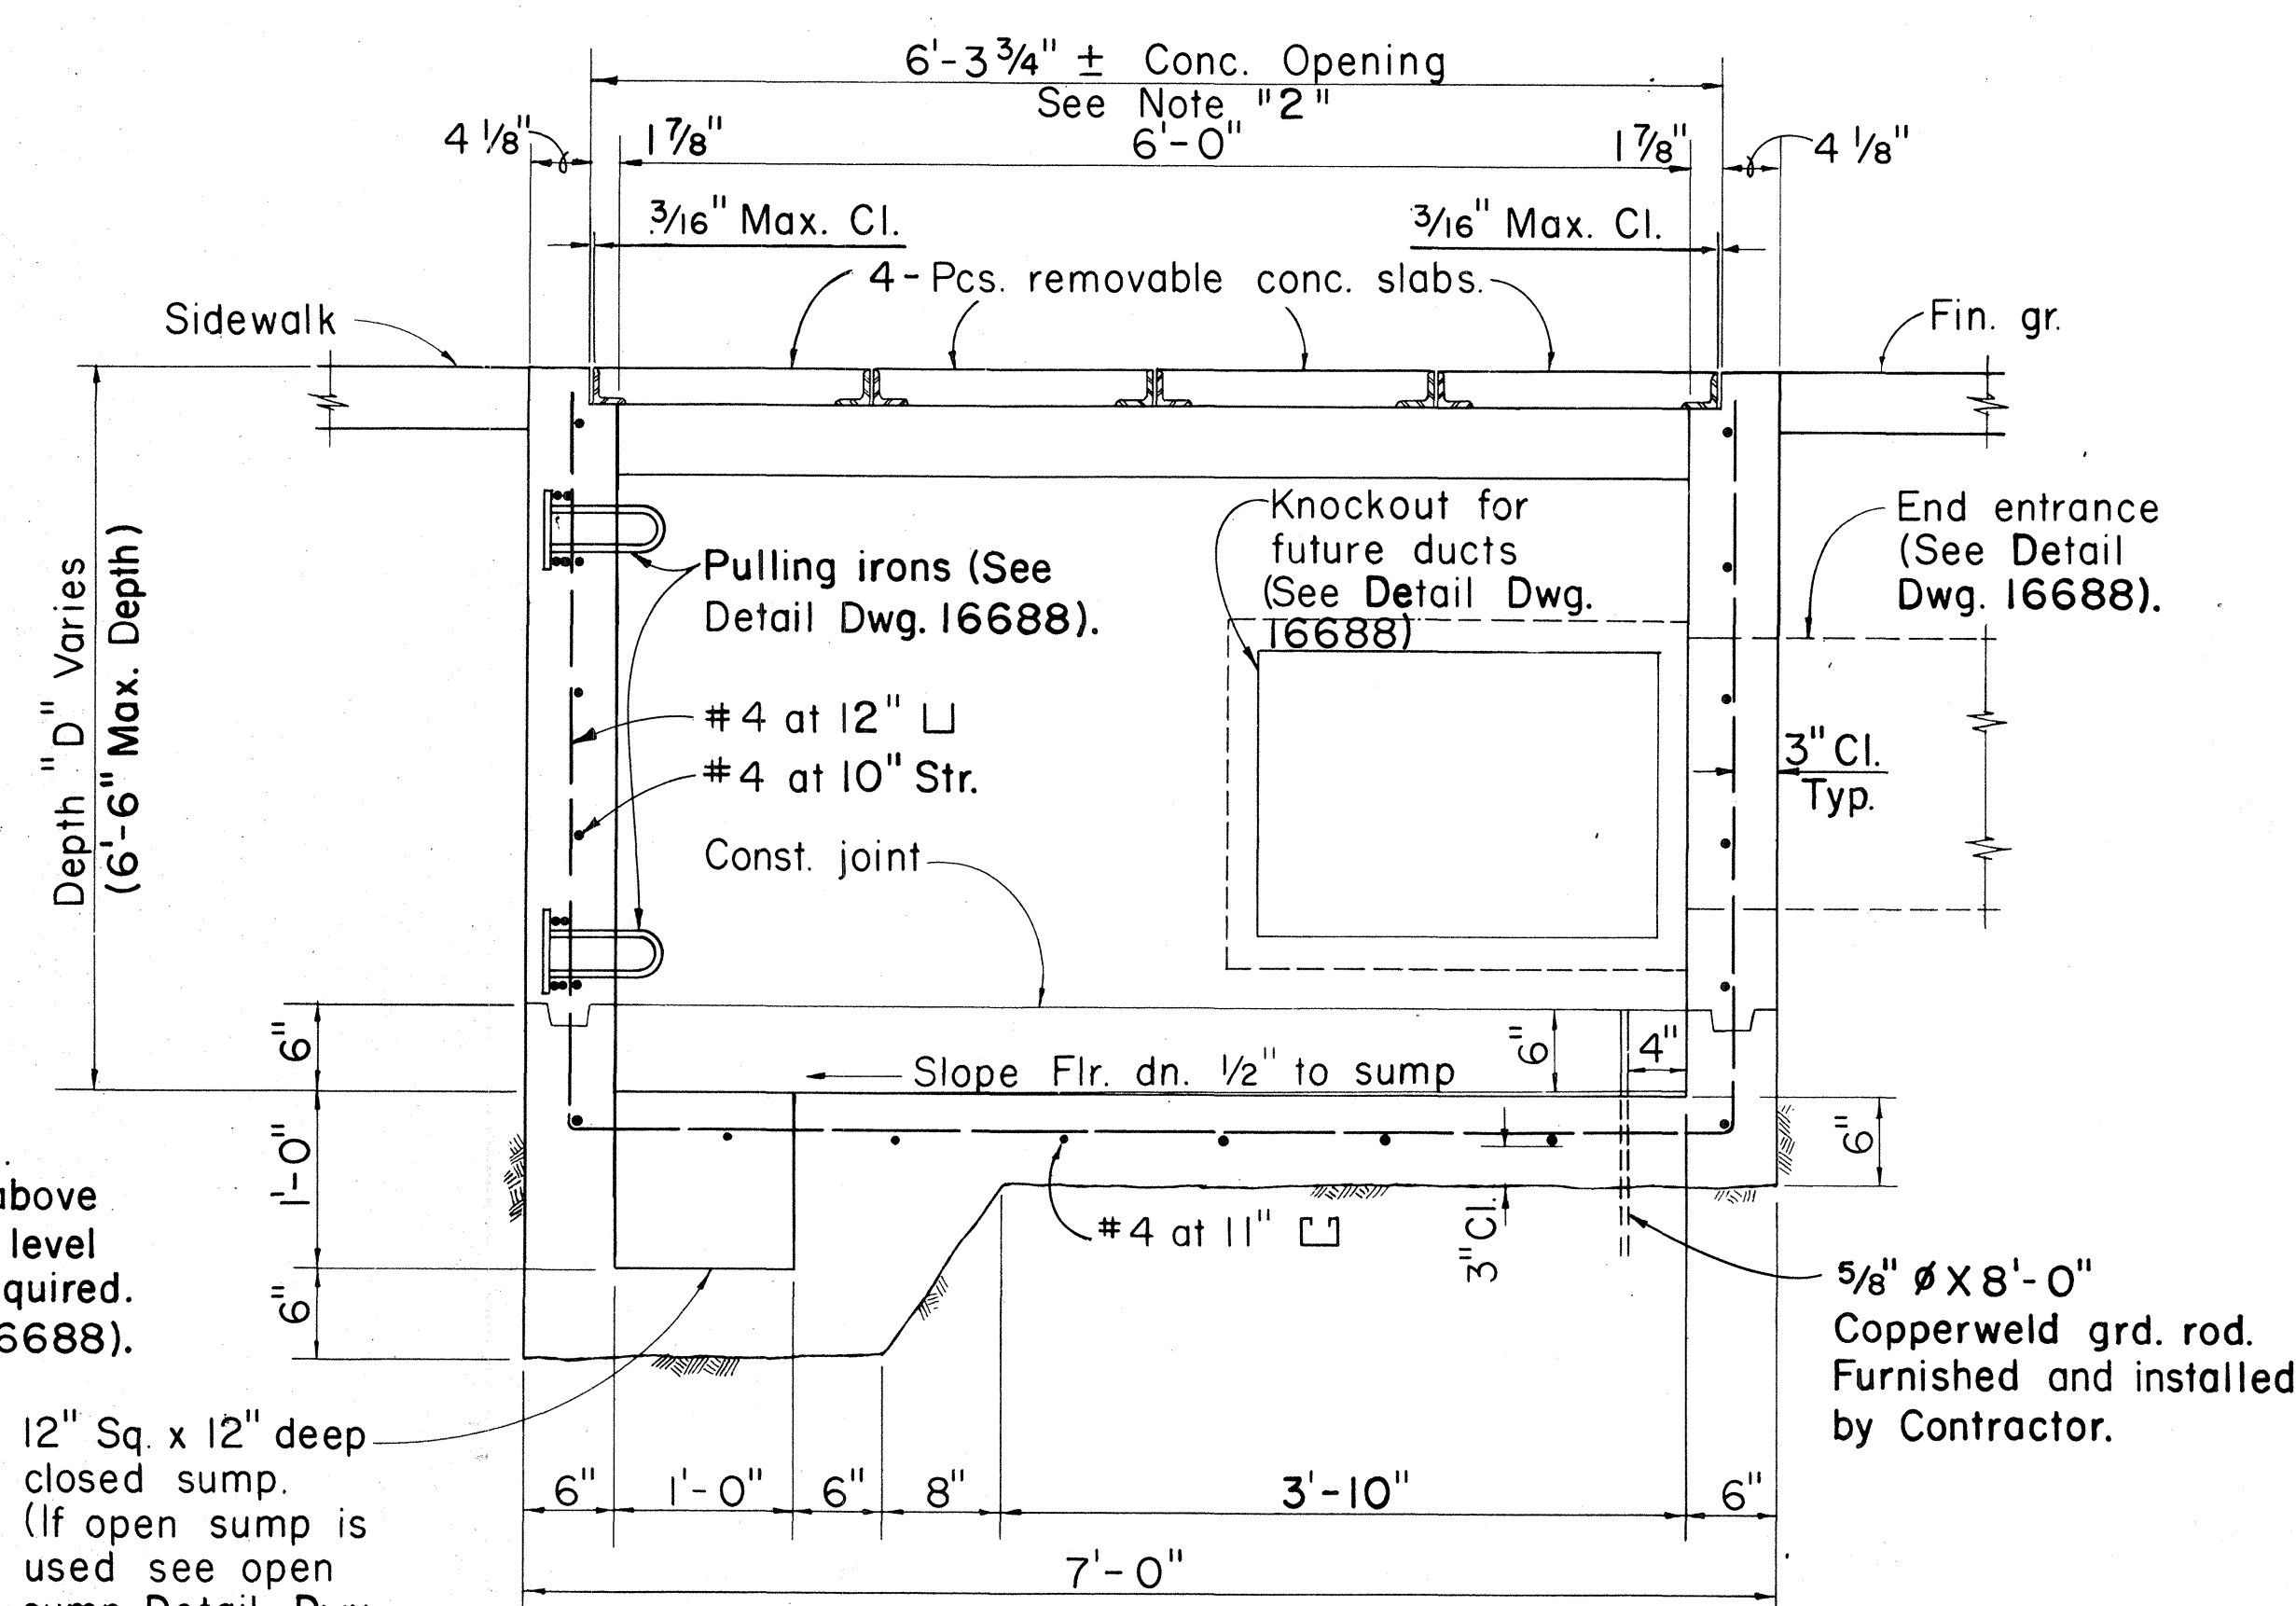


SECTION "A-A"
Scale: 1" = 1'-0"

Construction Joint if joint occurs 6" above highest high water level no water stop is required. (See Detail Dwg. 16688).

12" Sq. x 12" deep closed sump. (If open sump is used see open sump Detail. Dwy. 16688-No reinf. thru sump).

REINFORCED CONCRETE QUANTITIES	
QUANTITIES OF MATERIALS FOR DEPTH "D" = 5'-0"	
Total concrete	= 3.0 Cu. Yds.
Total reinf. steel	= 427 Lbs.
Total misc. steel	= 160 Lbs.
WEIGHT PER REMOVABLE CONCRETE COVER	
Concrete	= 150 Lbs.
Reinf. steel	= 7 Lbs.
Misc. steel	= 42 Lbs.
TOTAL	199 Lbs.
MATERIALS FOR 6" DEPTH OF 6" THICK WALL,	
Concrete	= 0.2 Cu. Yds.
Reinf. steel	= 25 Lbs.

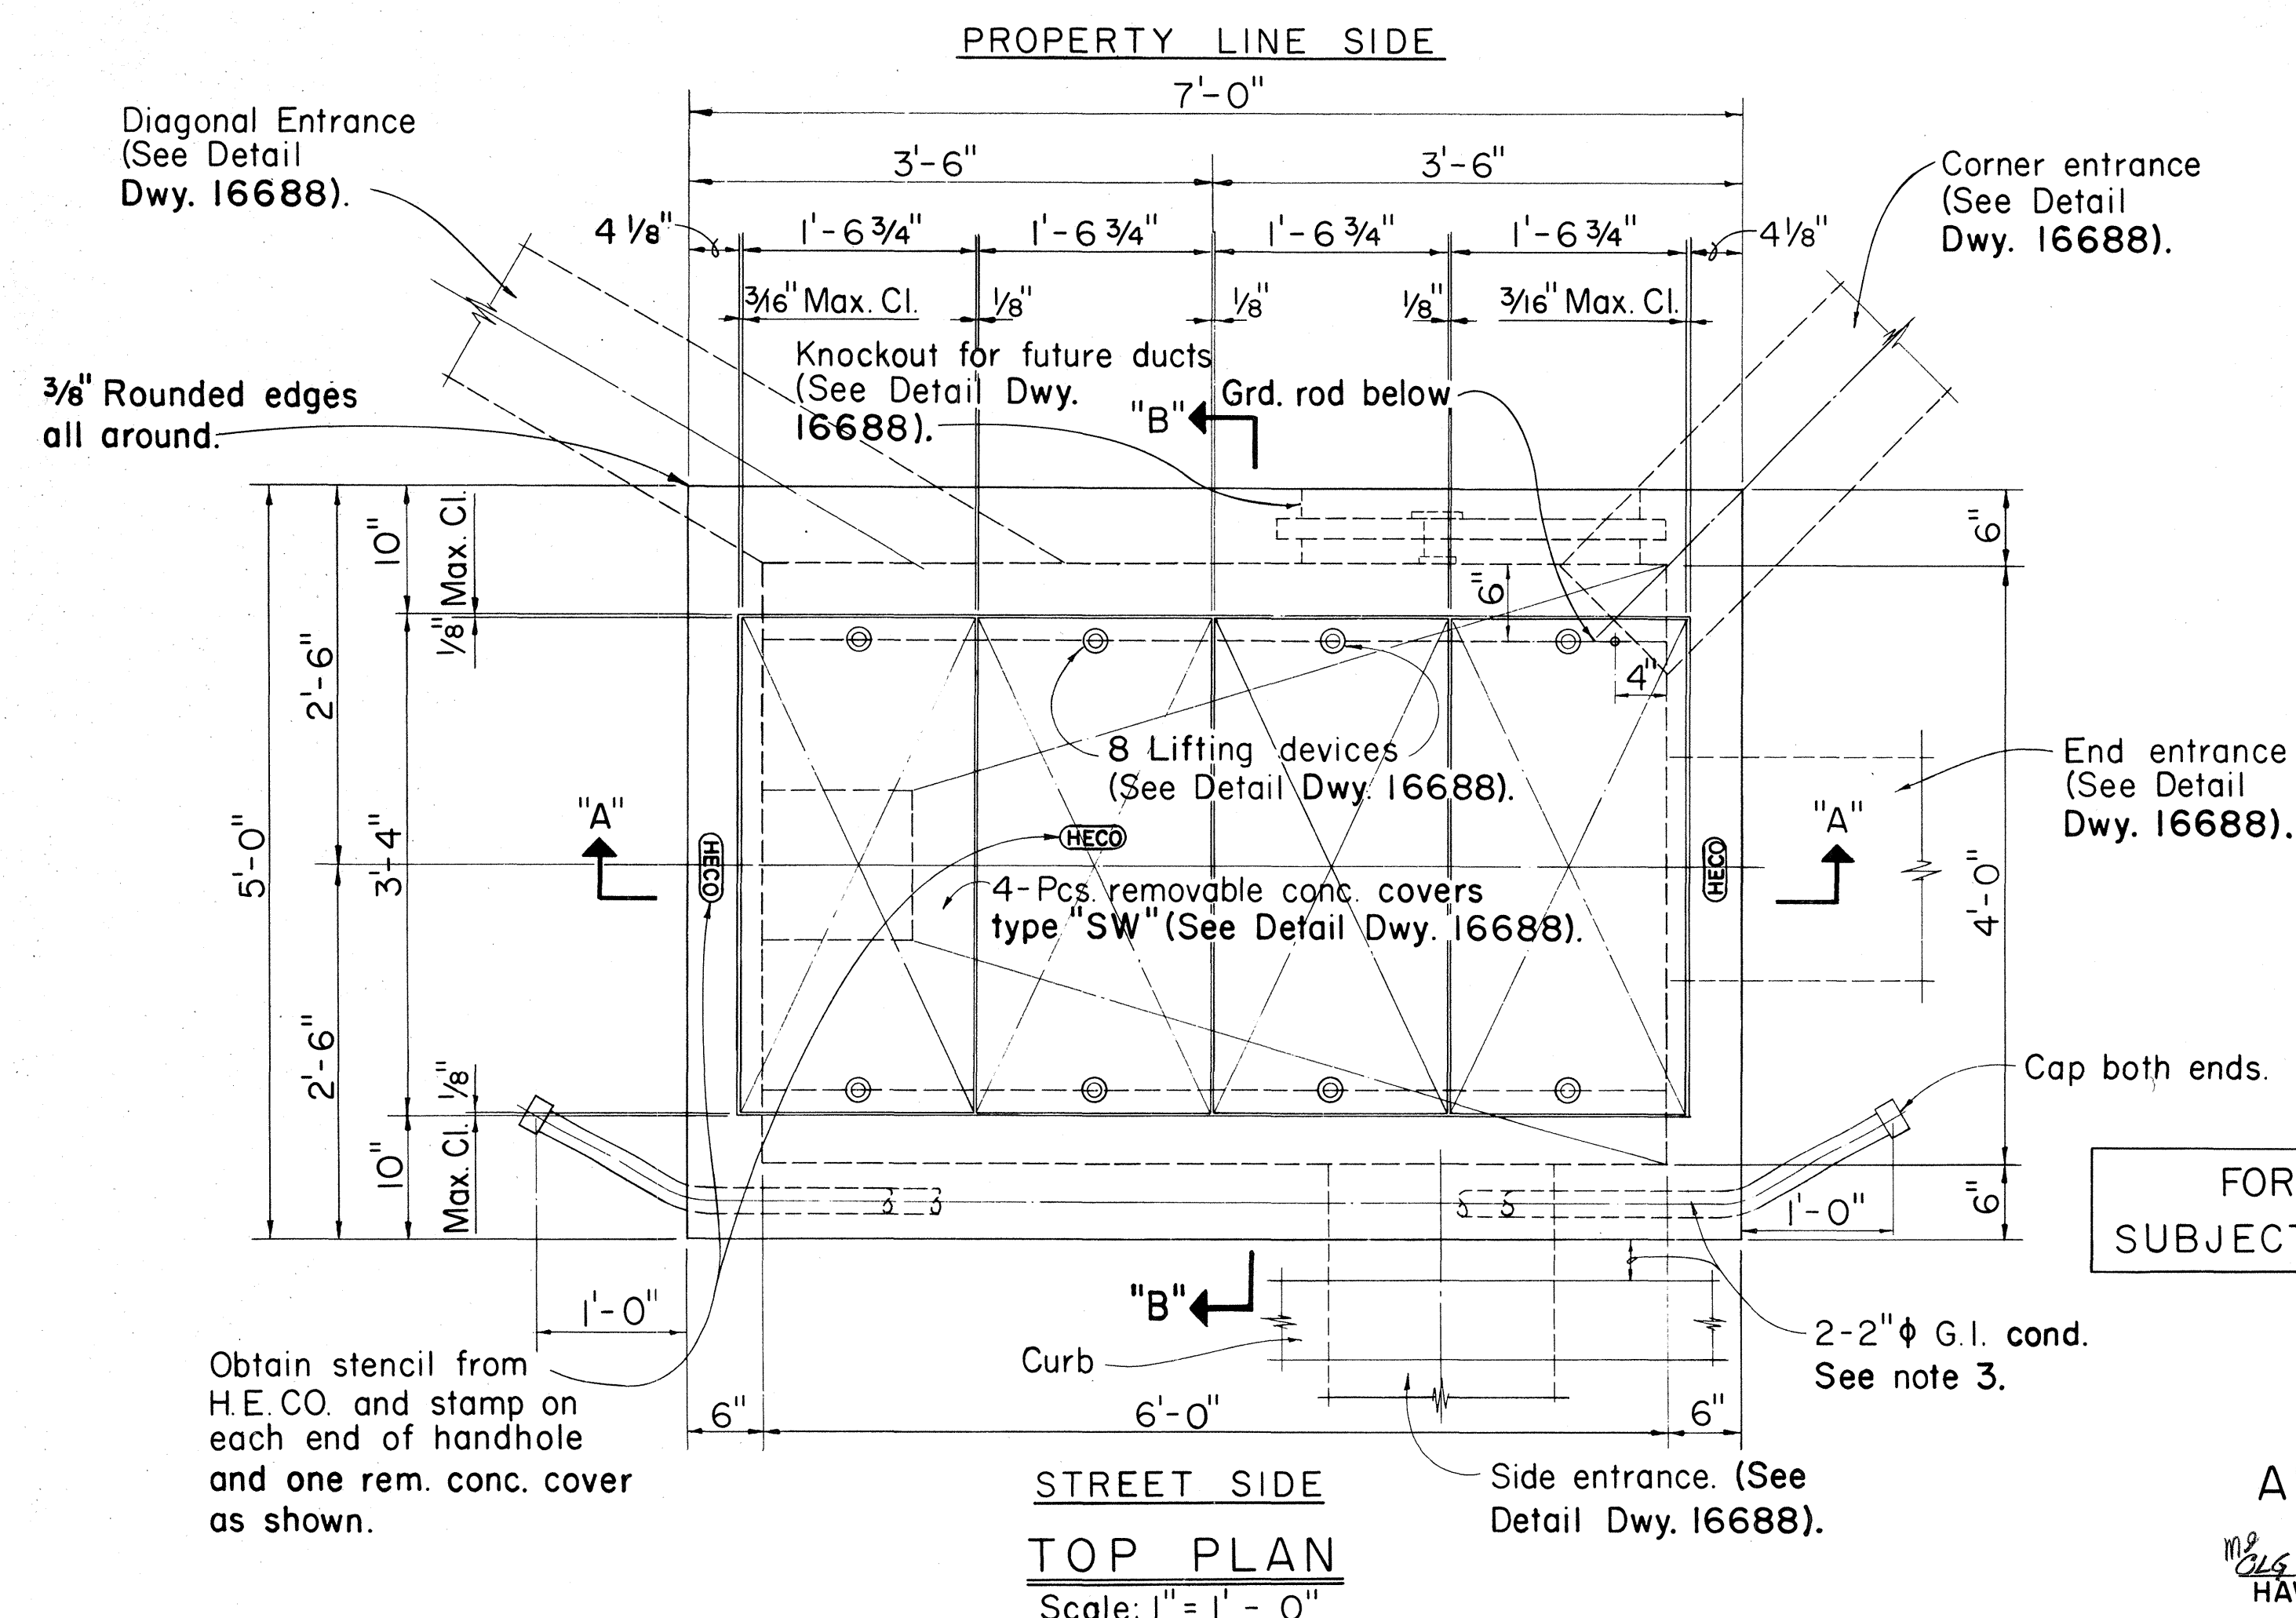

TOP PLAN
Scale: 1" = 1'-0"

FOR USE IN AREAS NOT
SUBJECT TO VEHICULAR TRAFFIC

APPROVED:


[Signature]
HAWAIIAN ELECTRIC CO., INC.

9-14-78
DATE


HECo., Inc. Drawing Number	18842
SHEET No. 1 OF 1 SHEET	
STATE OF HAWAII DEPARTMENT OF TRANSPORTATION LAND TRANSPORTATION FACILITIES DIVISION	
STANDARD DETAILS	
HANDHOLE TYPE	
46 (4'-0" x 6'-0")	
UNDERGROUND STANDARDS	
Scale: As Shown	AUG 1978
SHEET No. 27 OF 38 SHEETS	

GENERAL NOTES FOR MANHOLES & HANDHOLES STANDARD DETAILS

1. All work shall be subject to inspection by the Hawaiian Electric Co., Inc., Contracting & Inspection Division, City & County of Honolulu and/or Land Transportation Facilities Division, State of Hawaii, whichever Government has authority over the work.
2. Contractor shall notify the Hawaiian Electric Co., Inc., Contracting & Inspection Division, phone 548-4427 or 548-4428 24 hours before proceeding with any work on facilities owned by Hawaiian Electric Co., Inc..
3. Ducts: For number, size and exact location of Duct Entrances, refer to Project Drawings.
4. Pulling Irons: For number and locations, refer to Project Drawings.

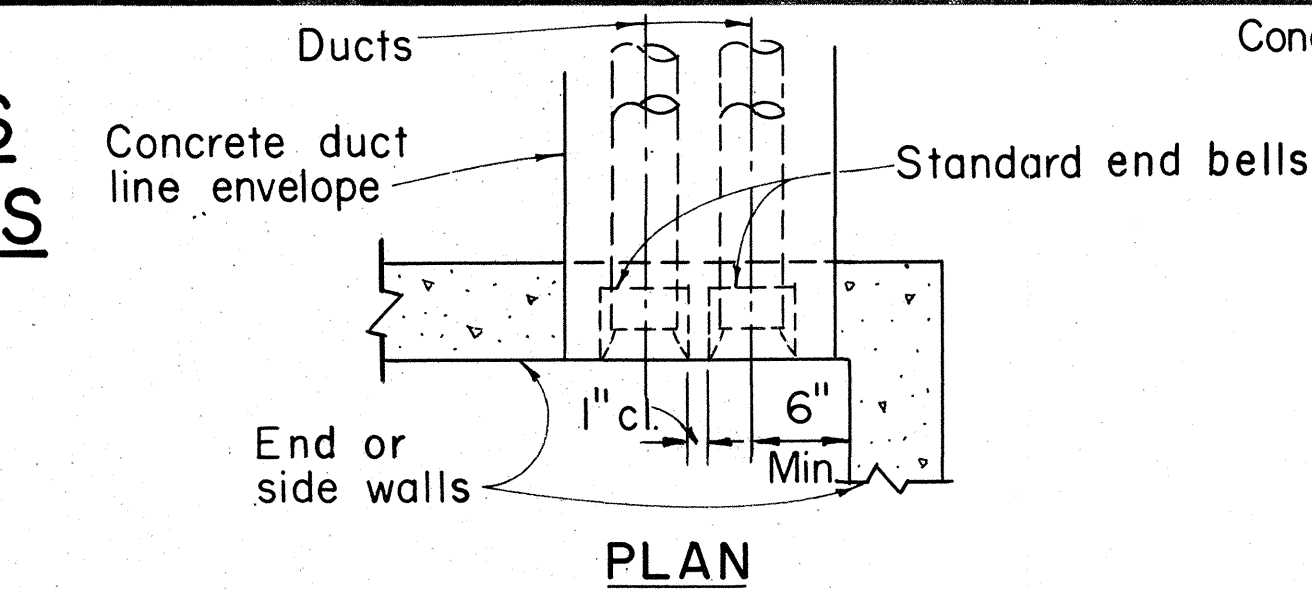


PLAN

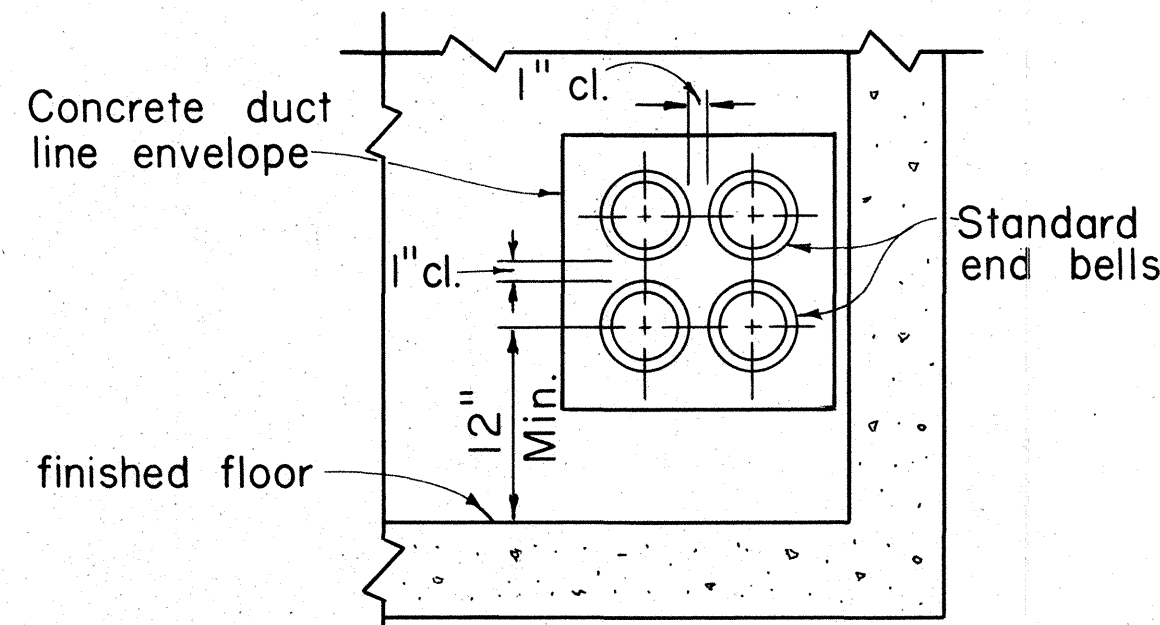


ELEVATION

END OR SIDE ENTRANCE

Scale: 1" = 1'-0"

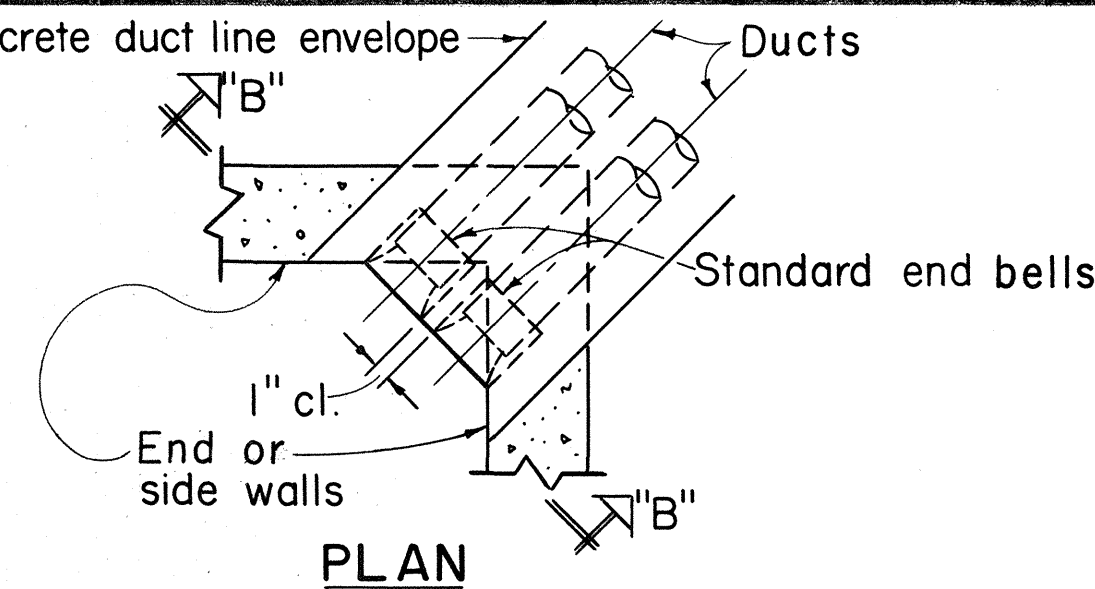


PLAN

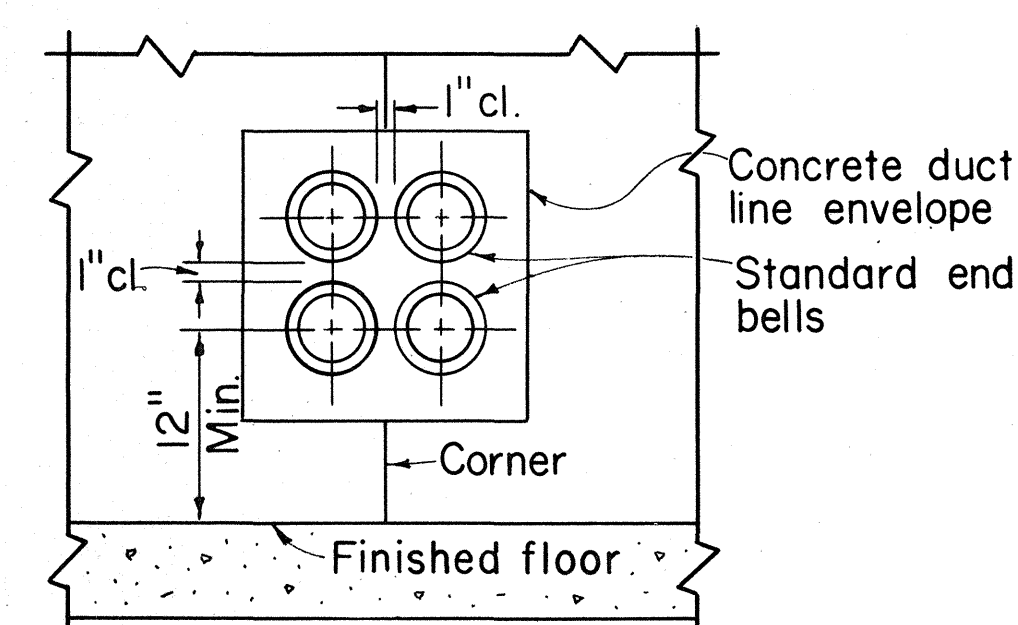


ELEVATION "B-B"

CORNER ENTRANCE

Scale: 1" = 1'-0"

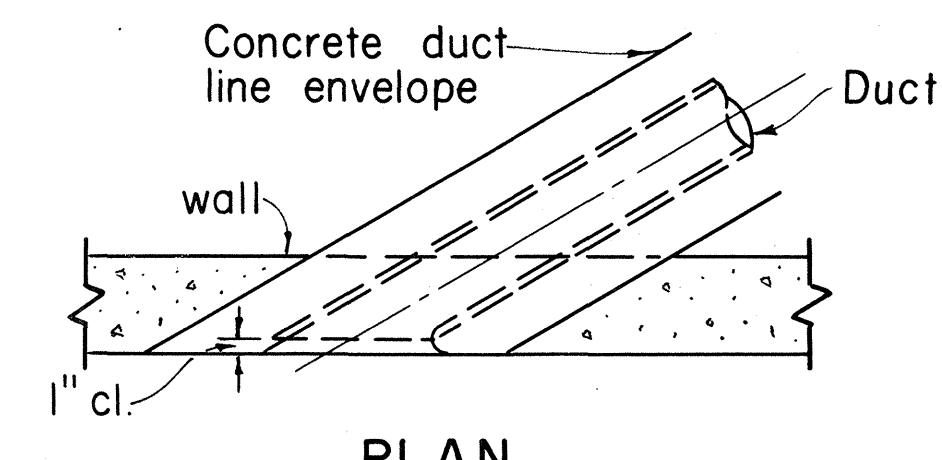


PLAN

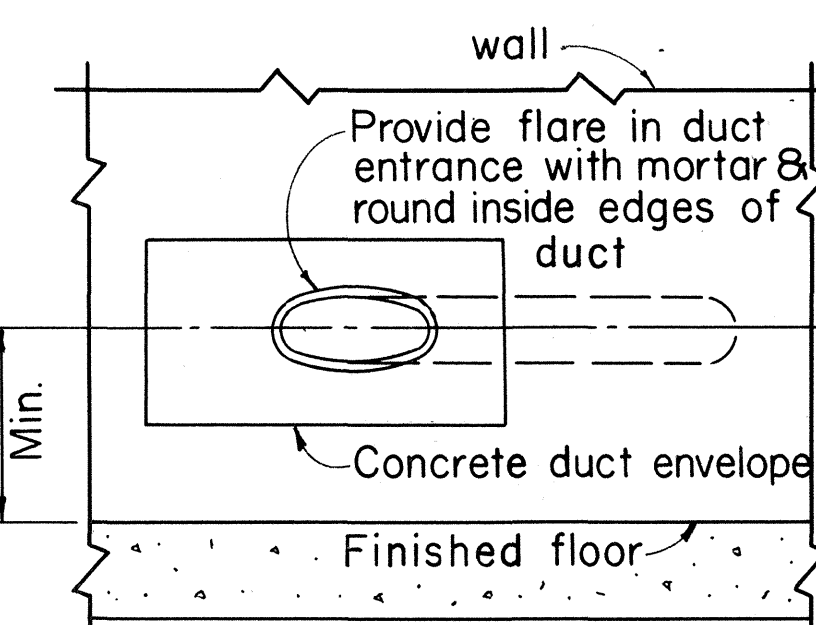

ELEVATION

DIAGONAL ENTRANCE

Scale: 1" = 1'-0"

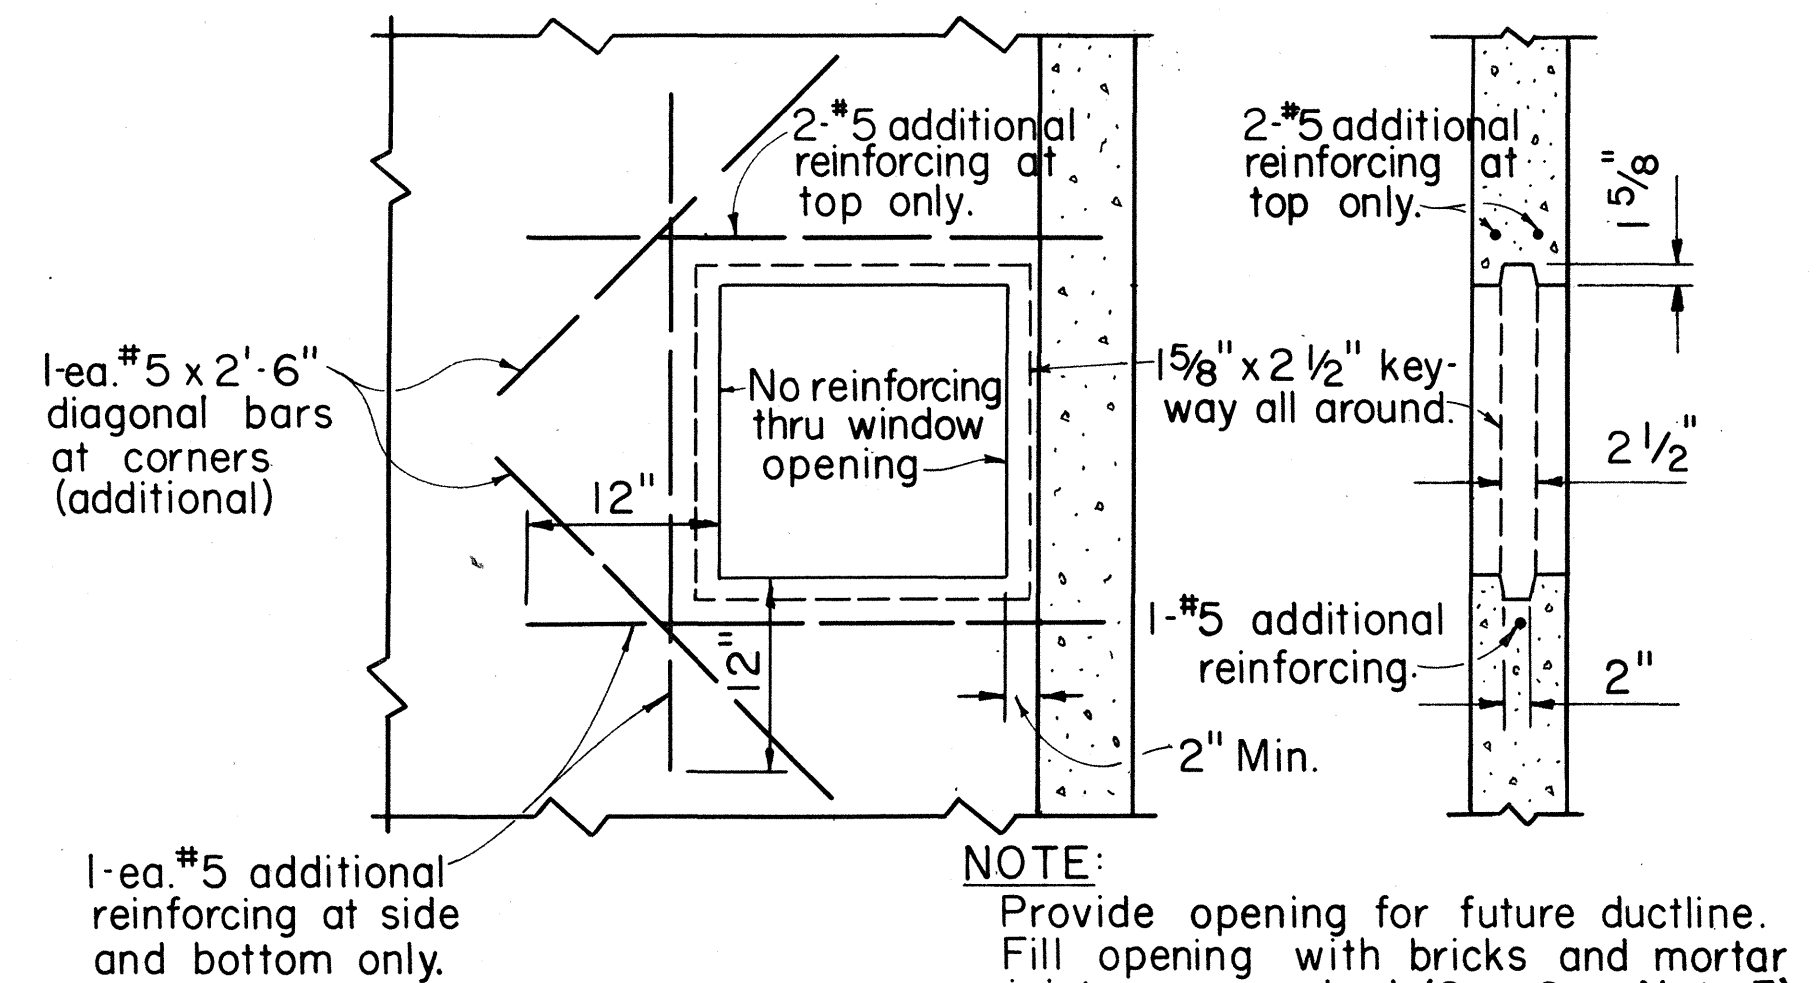

ELEVATION


SECTION

KNOCKOUT FOR FUTURE DUCT LINE

Scale: 1" = 1'-0"

NOTES:


1. Hot-dip galvanized after fabrication.
2. For additional reinf. see Proj Dwg.

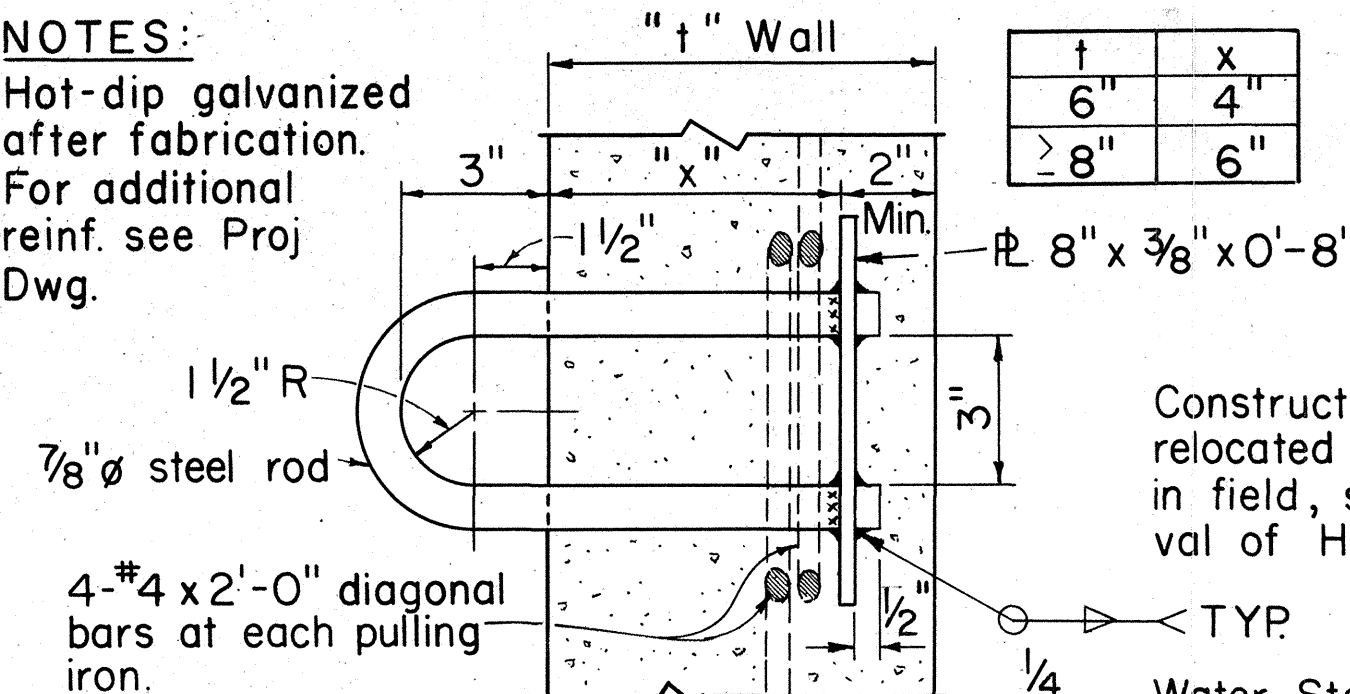

SECTION

PULLING IRON


Scale: 3" = 1'-0"

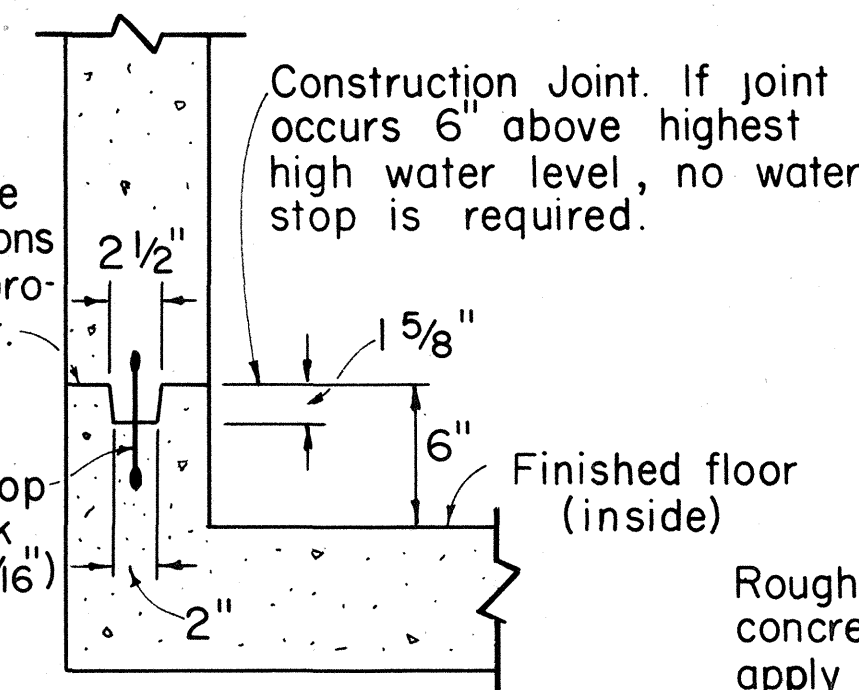

SECTION

TYPICAL CONSTRUCTION JOINT


Scale: 1 1/2" = 1'-0"

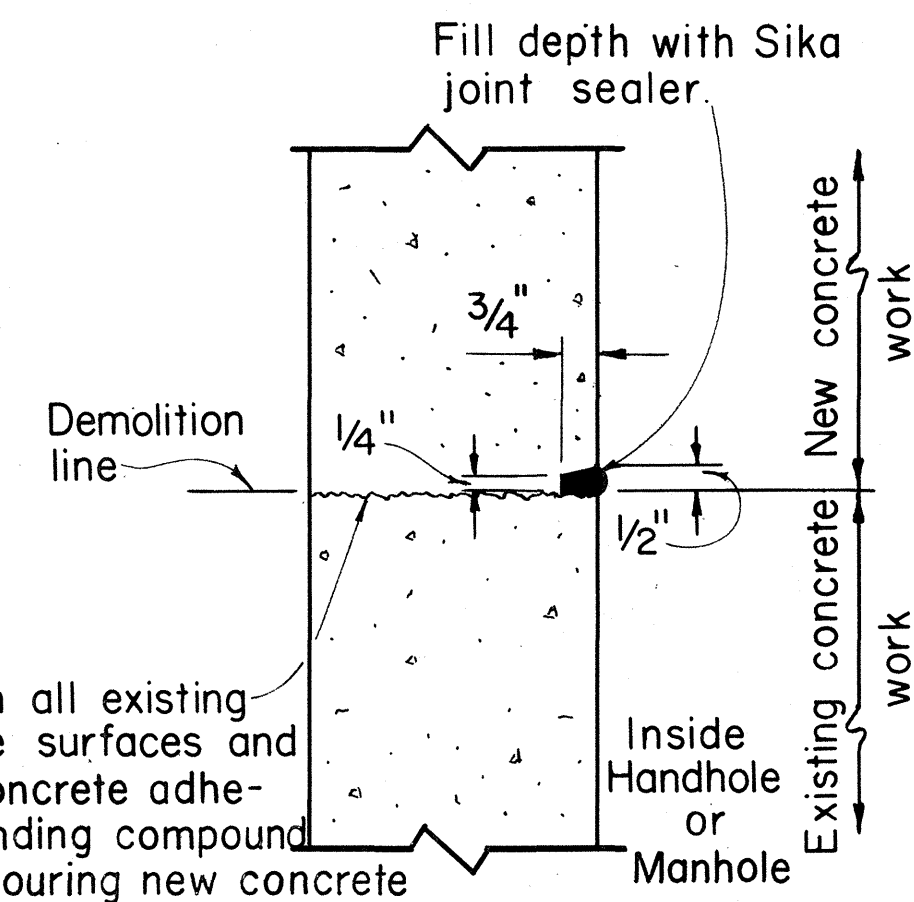

SECTION

TYPICAL COLD JOINT

Scale: 3" = 1'-0"

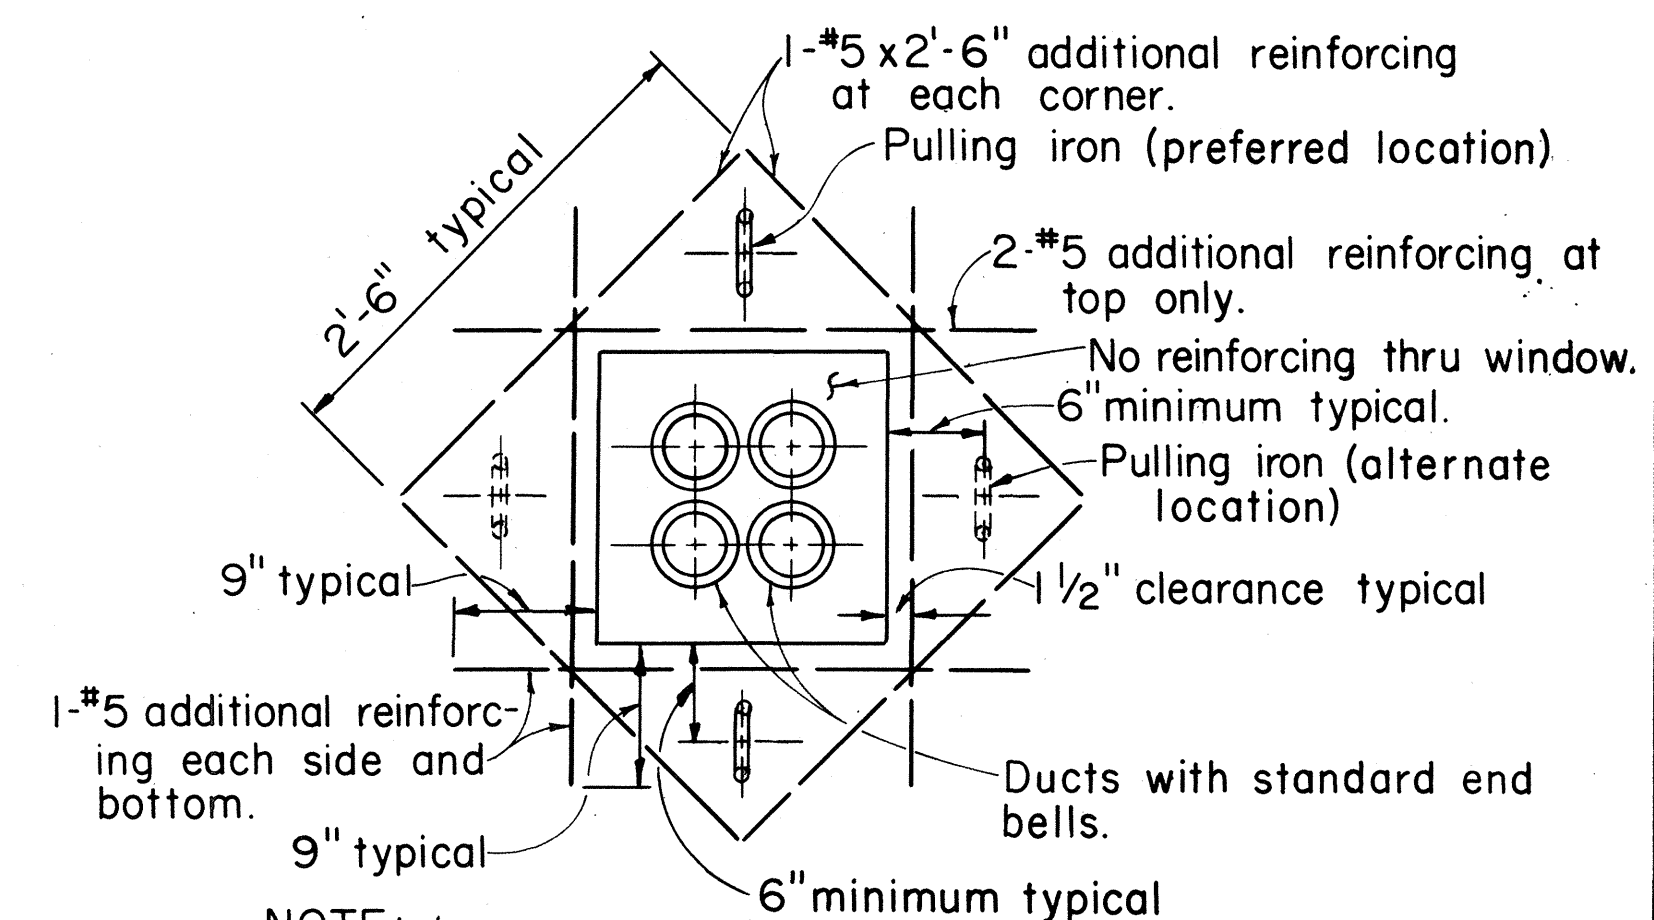


NOTE:

Generally 2 pulling irons are required and located on opposite wall of each duct window unless otherwise shown or noted. H.E.Co. Engineer shall determine number required.

ELEVATION

TYPICAL DUCT WINDOW


Scale: 1" = 1'-0"

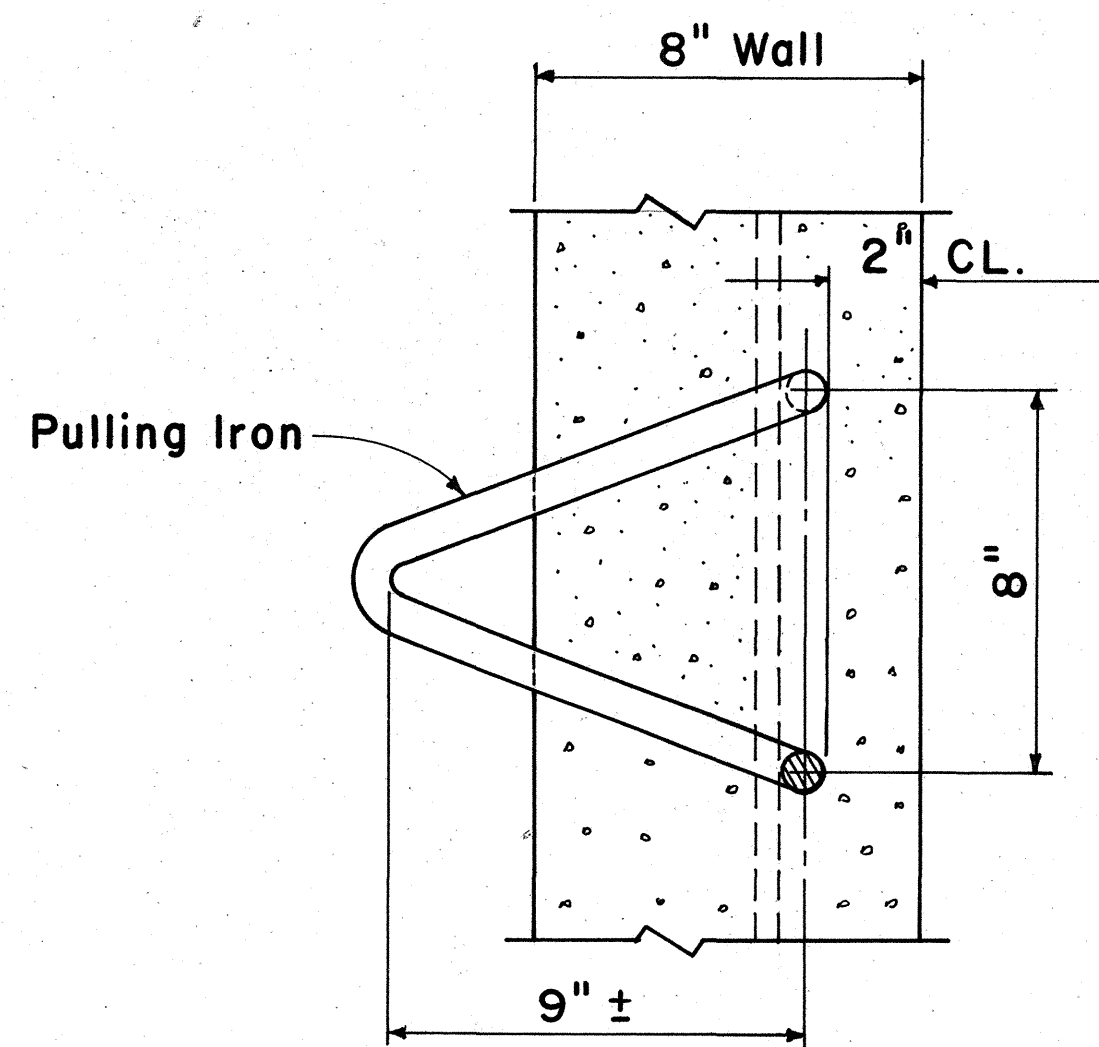


PLAN

PULLING IRON FOR 8" WALL

Scale: 3" = 1'-0"

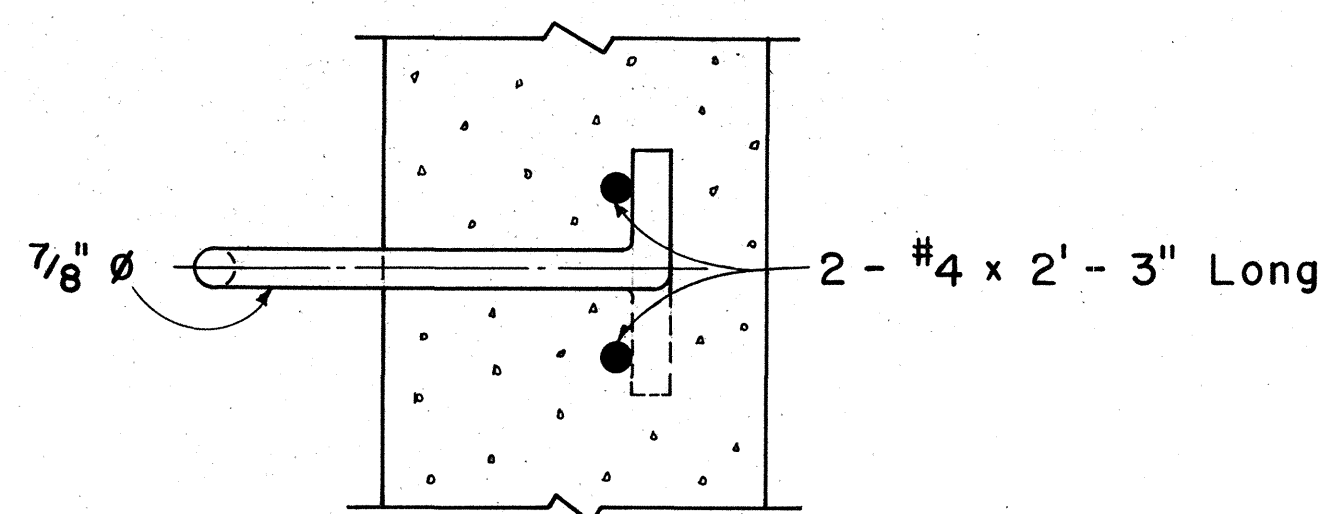


SECTION

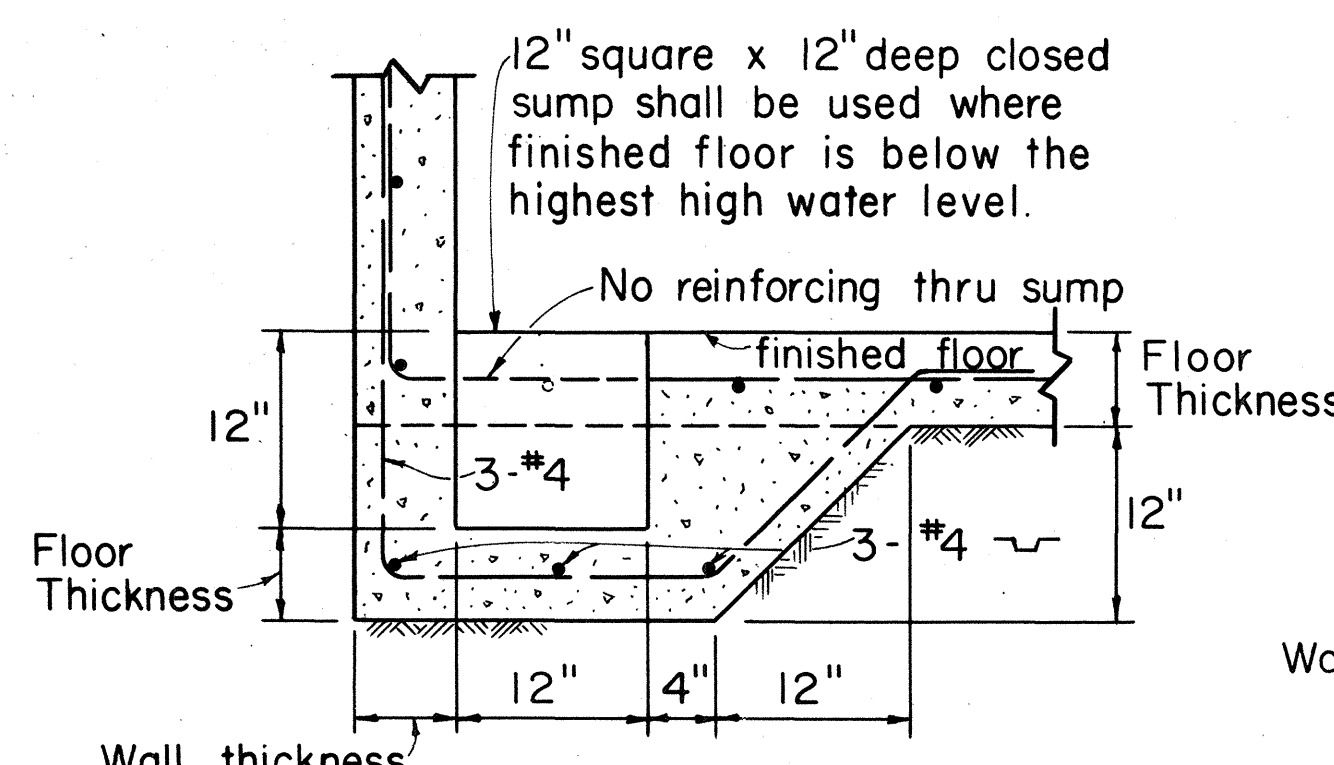

SECTION

CLOSED SUMP

Scale: 1" = 1'-0"

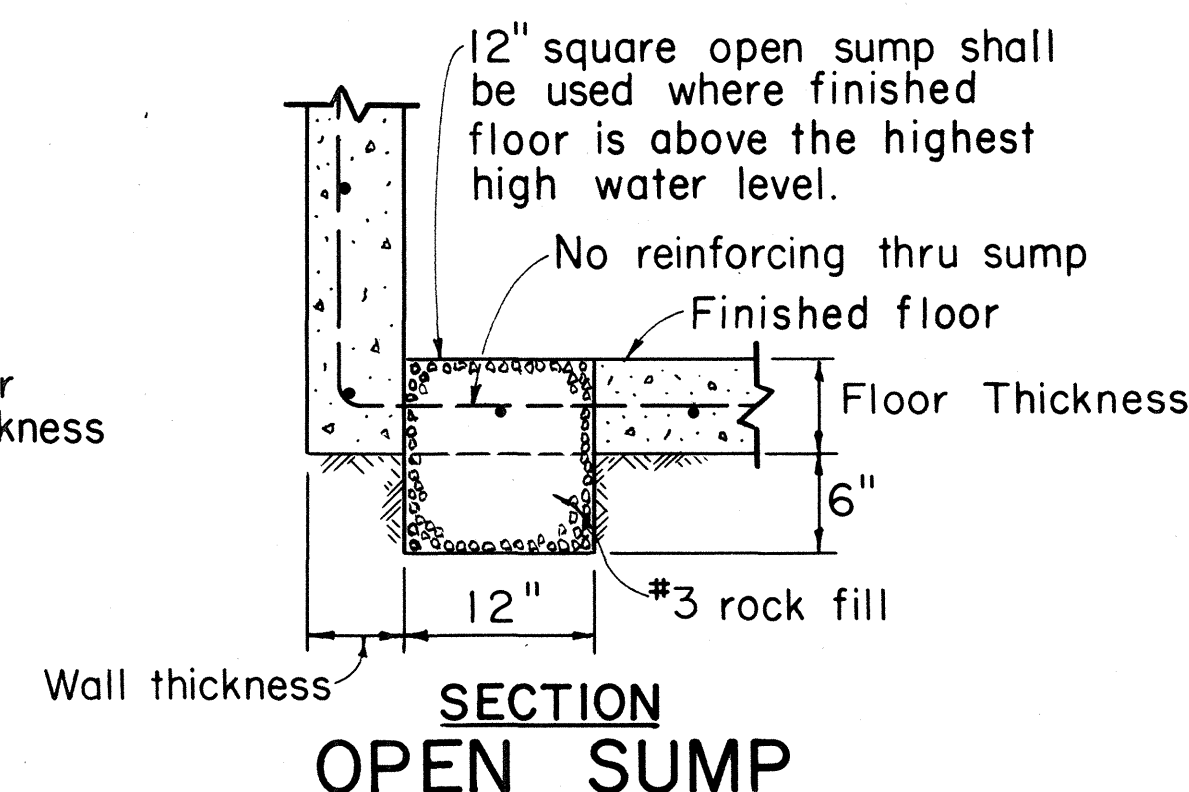

SECTION

OPEN SUMP

Scale: 1" = 1'-0"

APPROVED:

Hawaiian Electric Co., Inc. Date

HECo., Inc. Drawing Number

16688

SHEET NO. 1
OF 2 SHEETS

STATE OF HAWAII
DEPARTMENT OF TRANSPORTATION
LAND TRANSPORTATION FACILITIES DIVISION




MISCELLANEOUS DETAILS
HANDHOLES & MANHOLES
UNDERGROUND STANDARDS

Scale as noted

AUG 1978




SHEET No. 28 OF 38 SHEETS

FED. ROAD DIST. NO.	STATE	FED. AID PROJ. NO.	FISCAL YEAR	SHEET NO.	TOTAL SHEETS
HAWAII	HAW.	F-083-110	1978	77	160

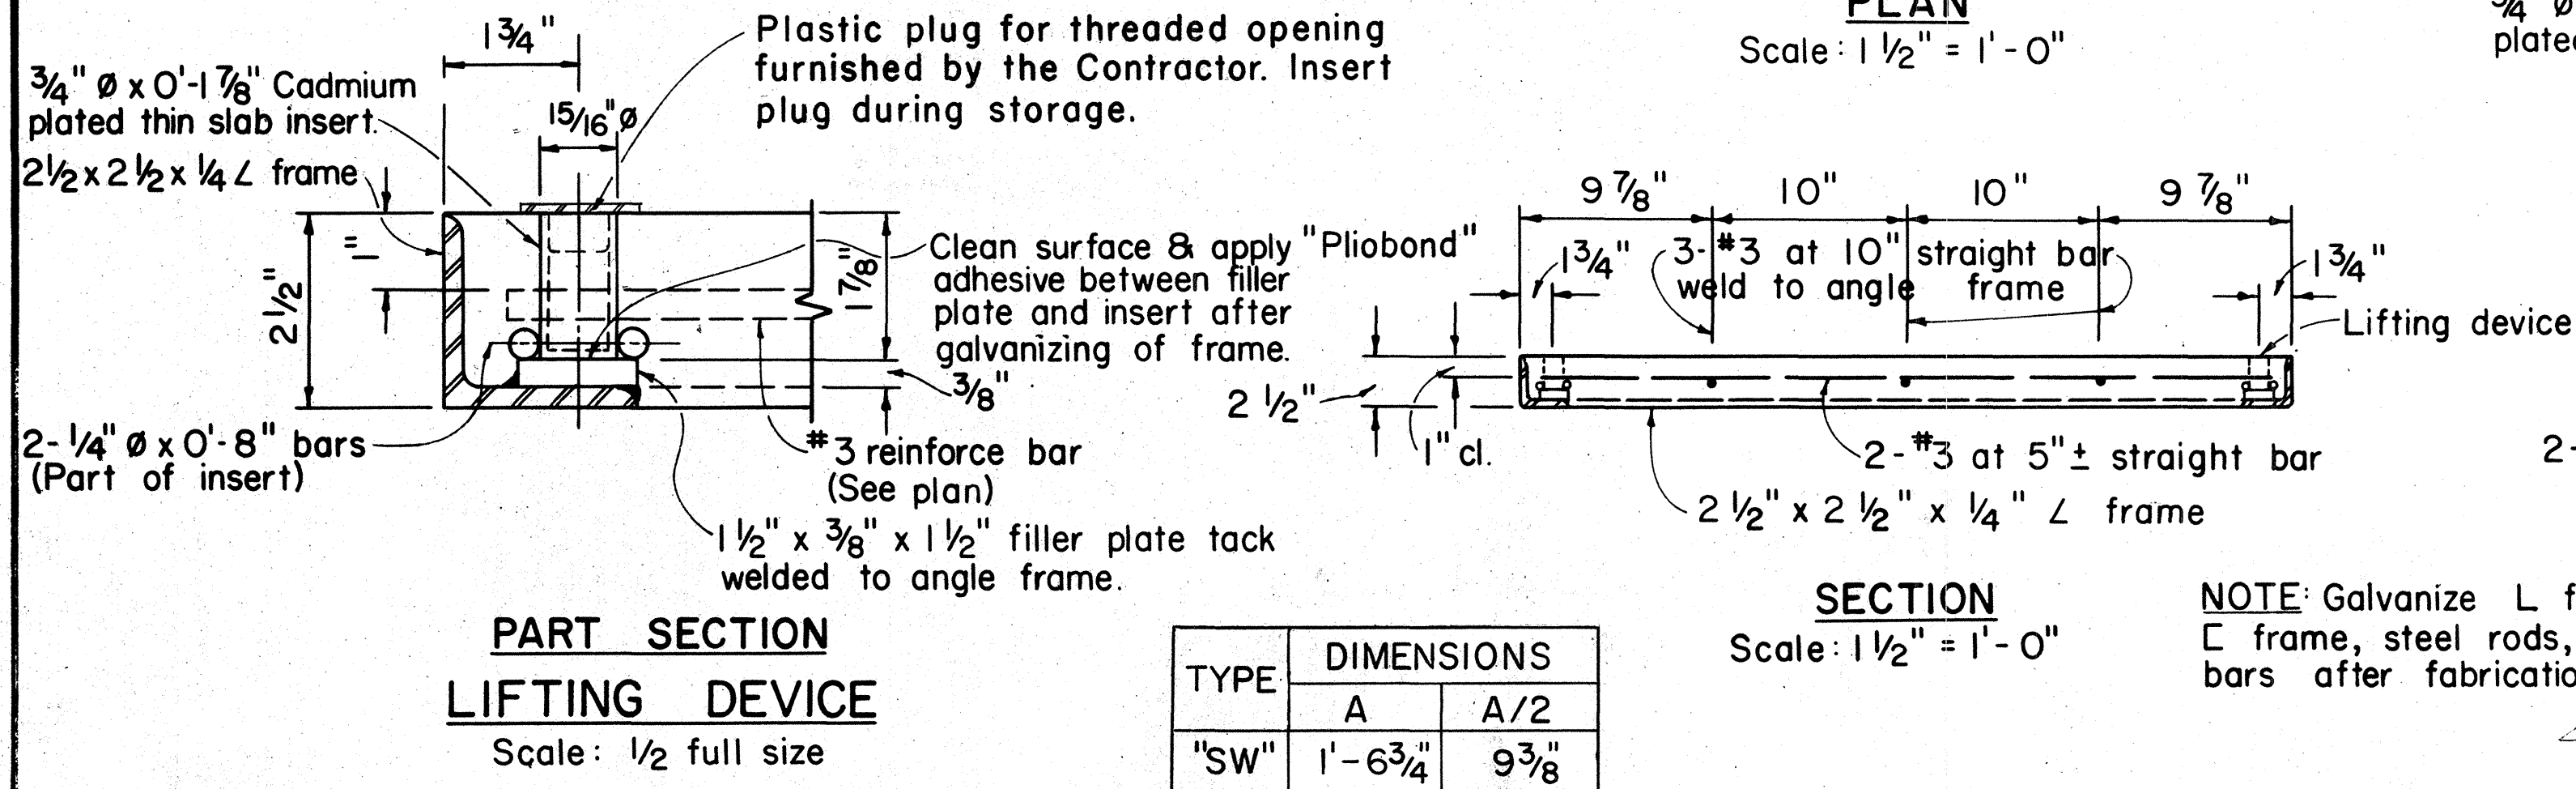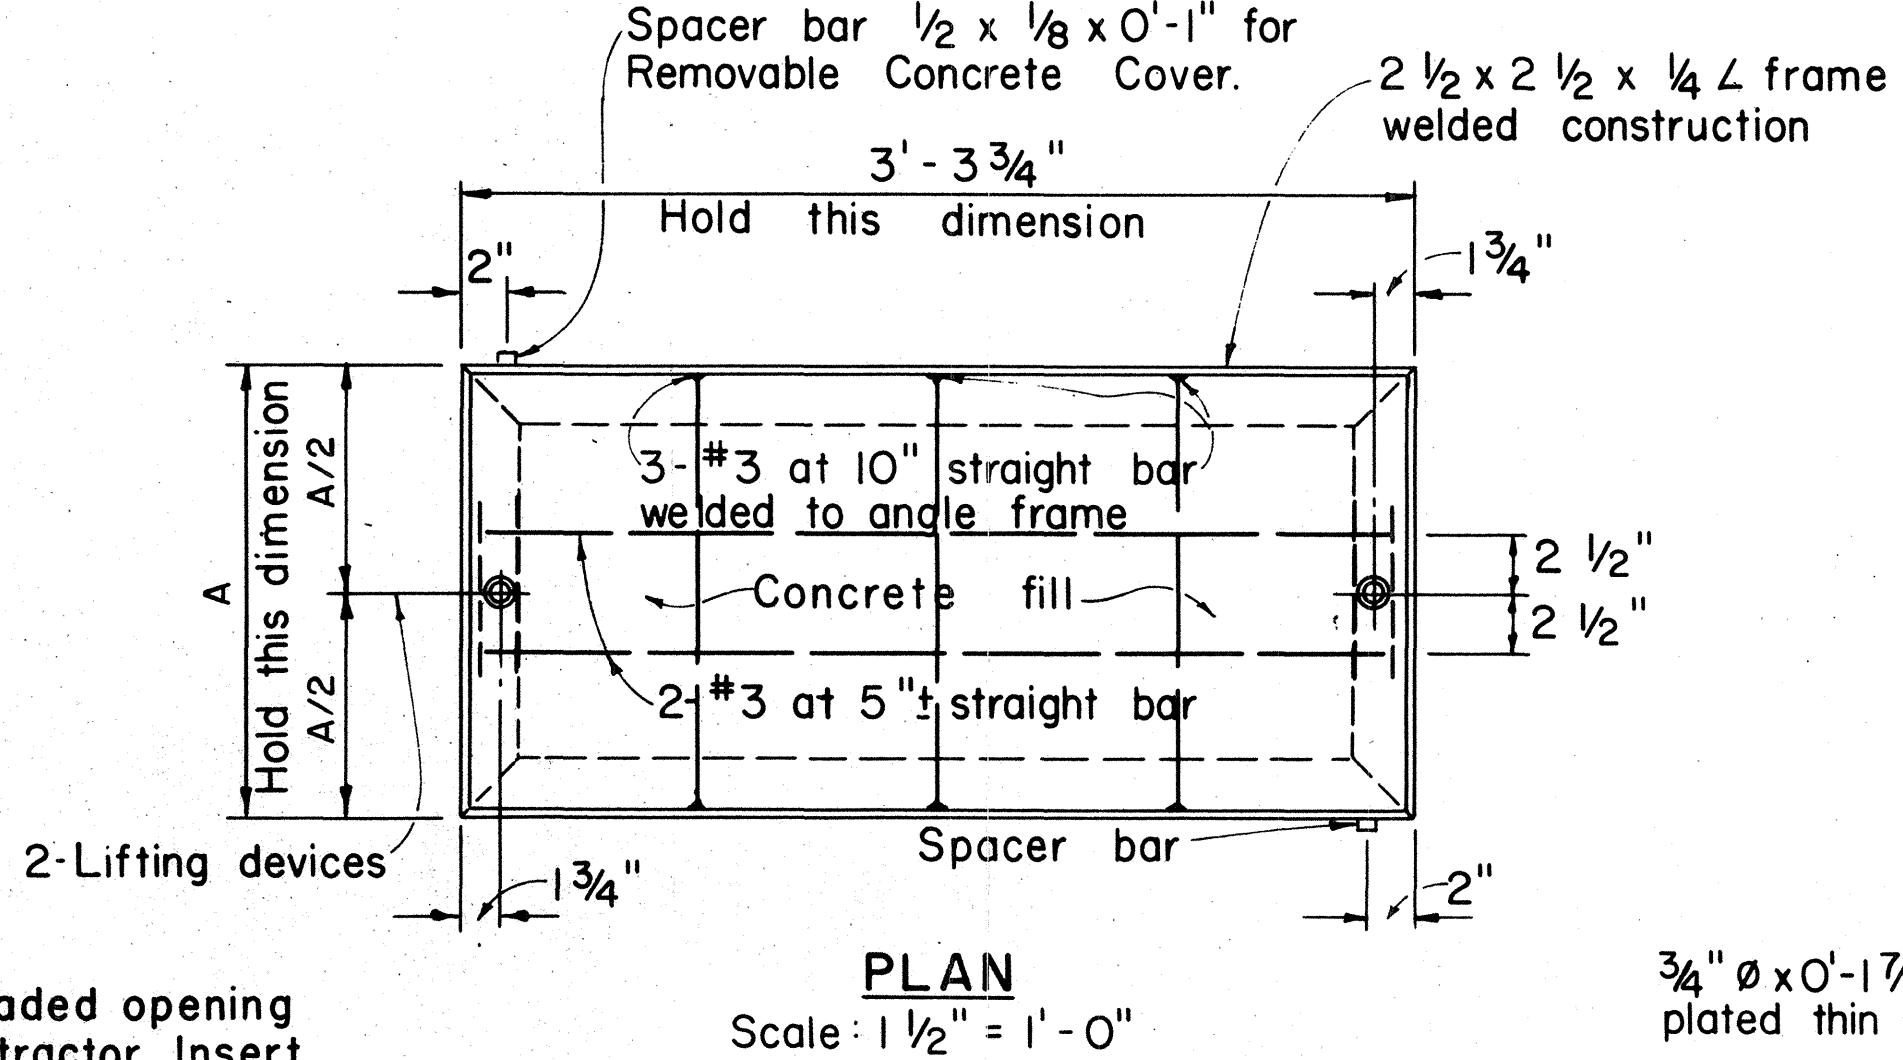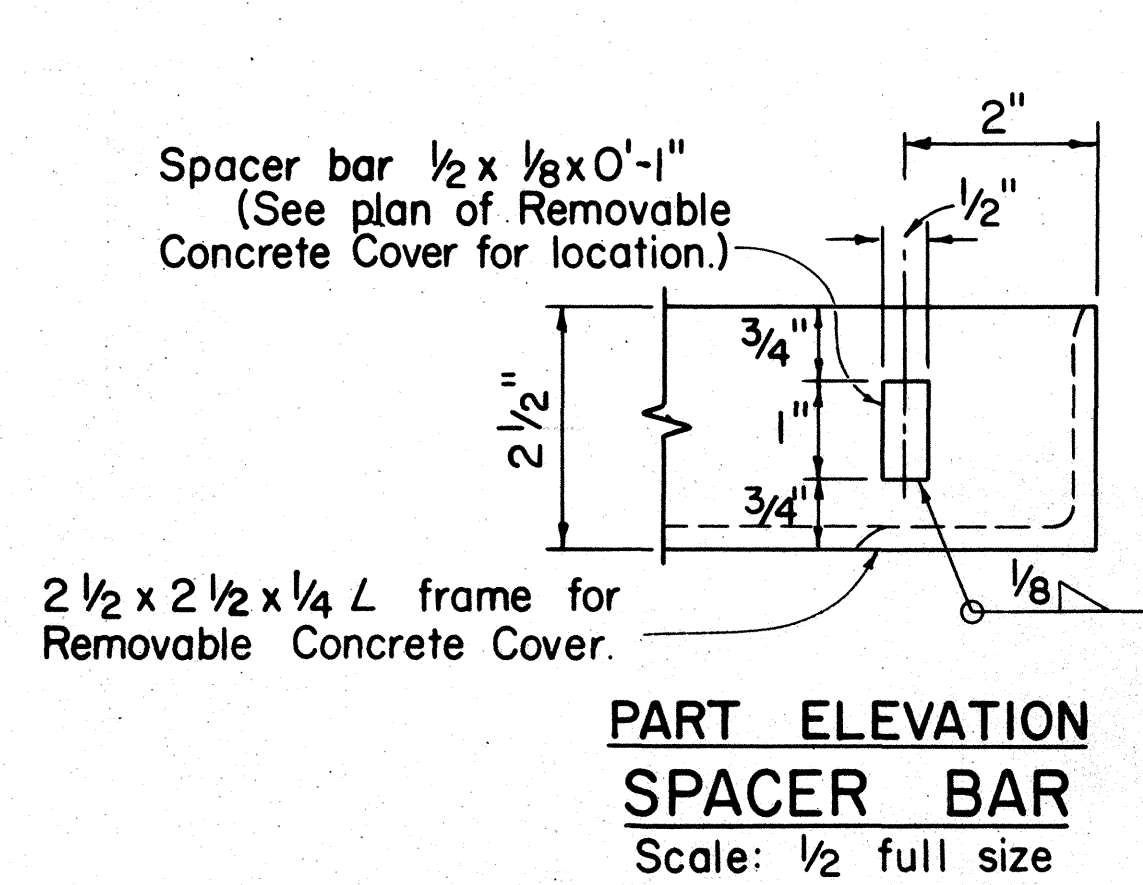



TYPE	DIMENSIONS	
	A	A/2
"SW"	1'-6 $\frac{3}{4}$ "	9 $\frac{3}{8}$ "
"SWI"	1'-2 $\frac{13}{16}$ "	7 $\frac{13}{32}$ "

NOTE: Galvanize L frame or C frame, steel rods, and spacer bars after fabrication.

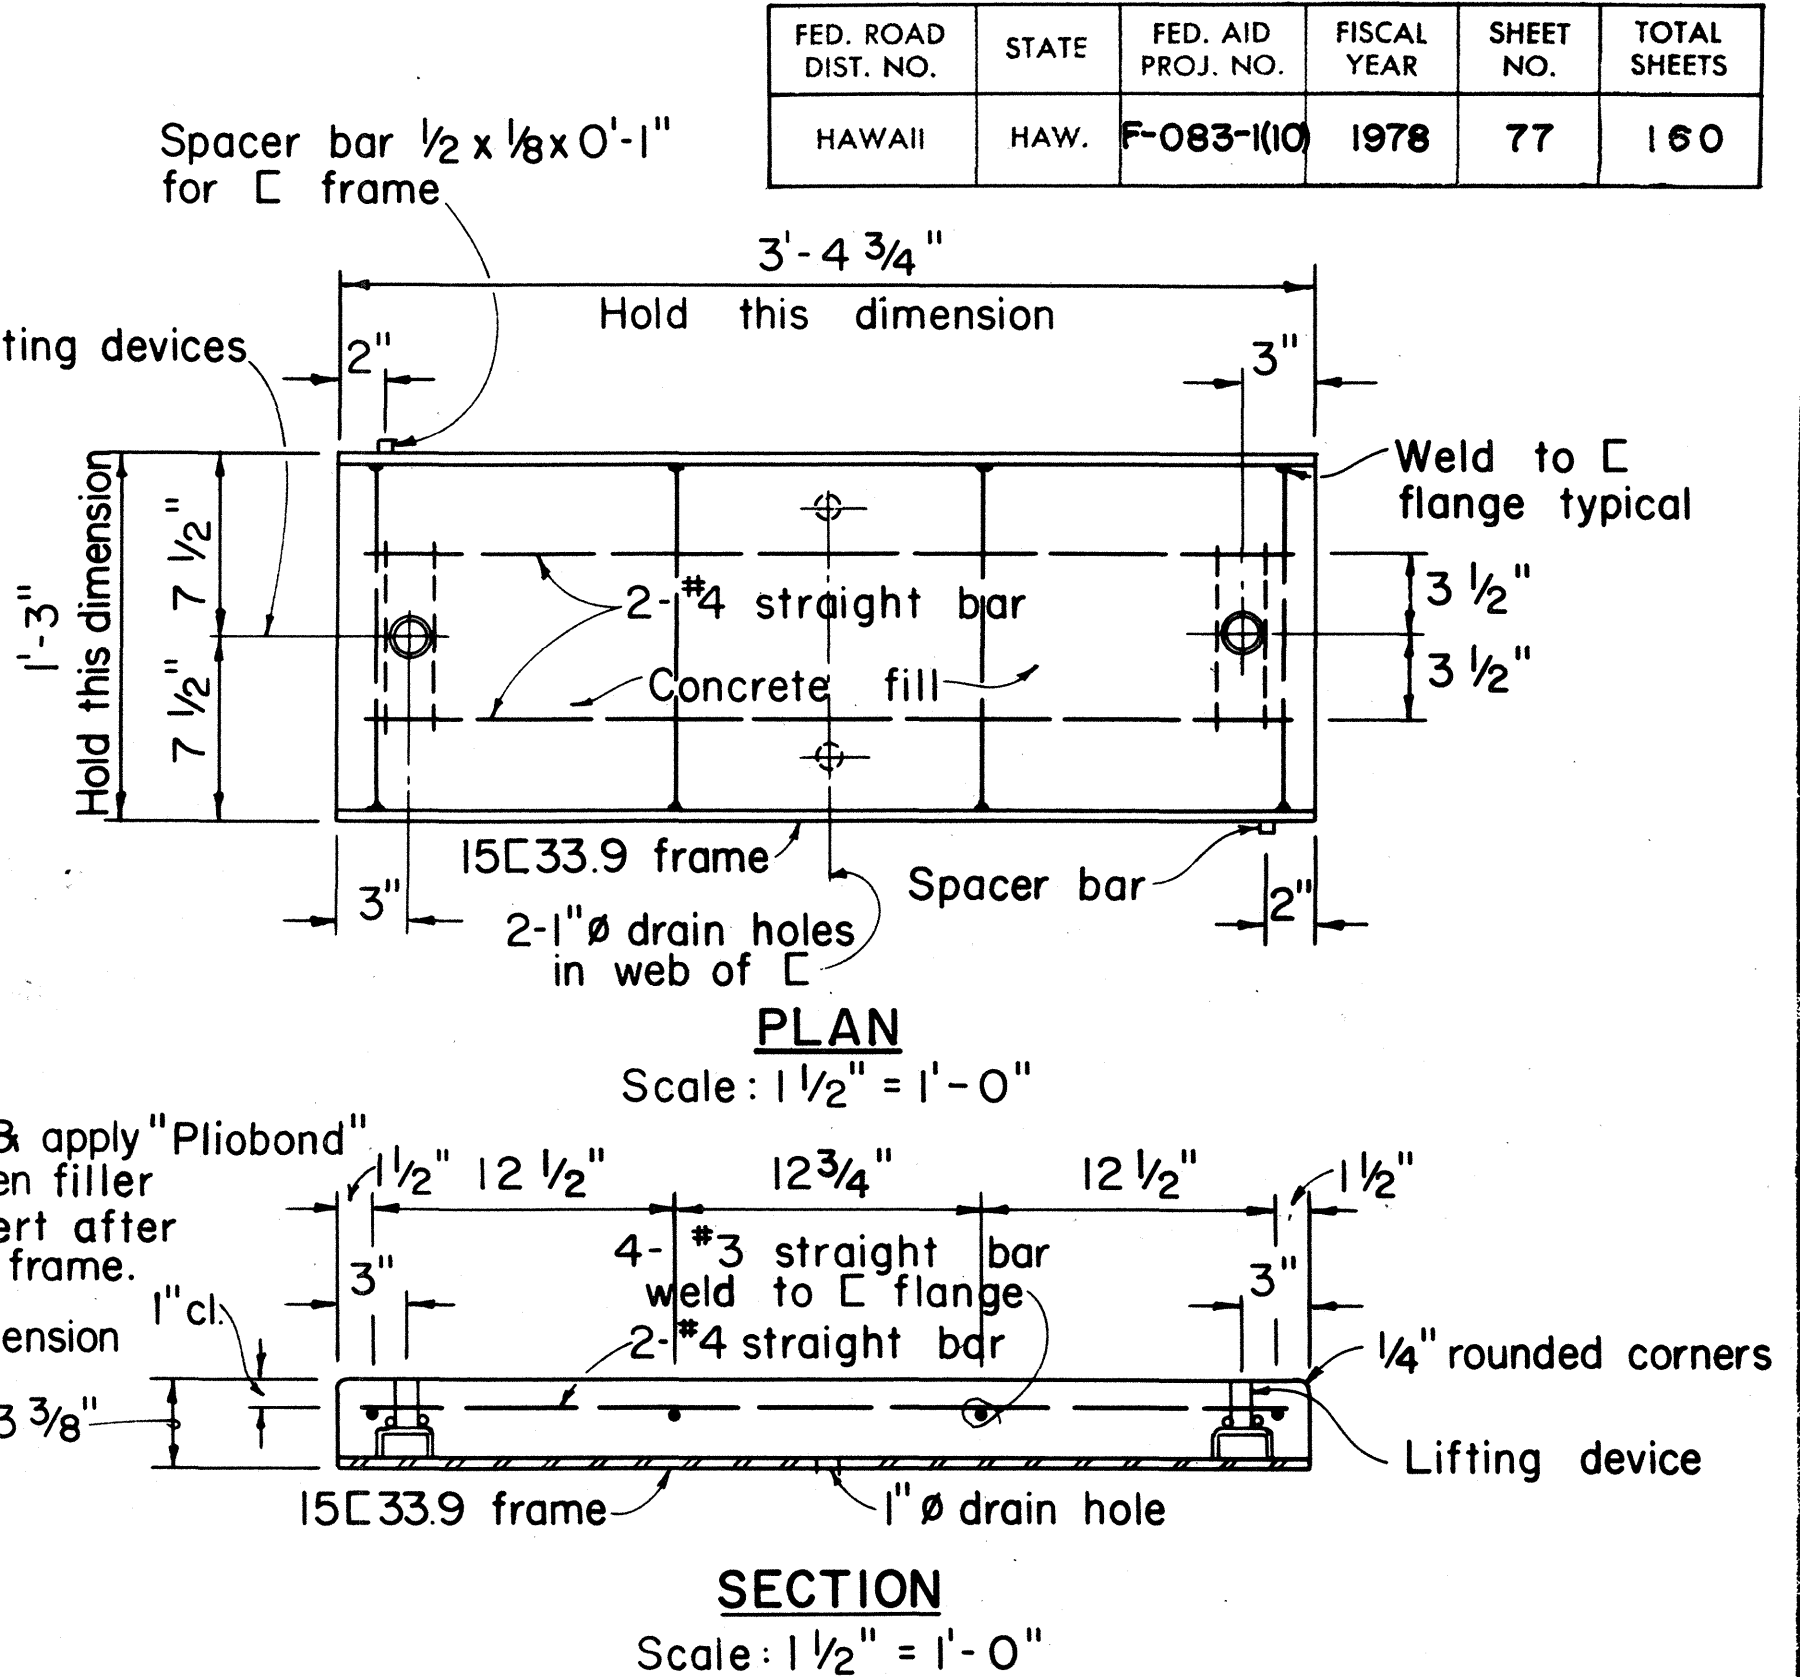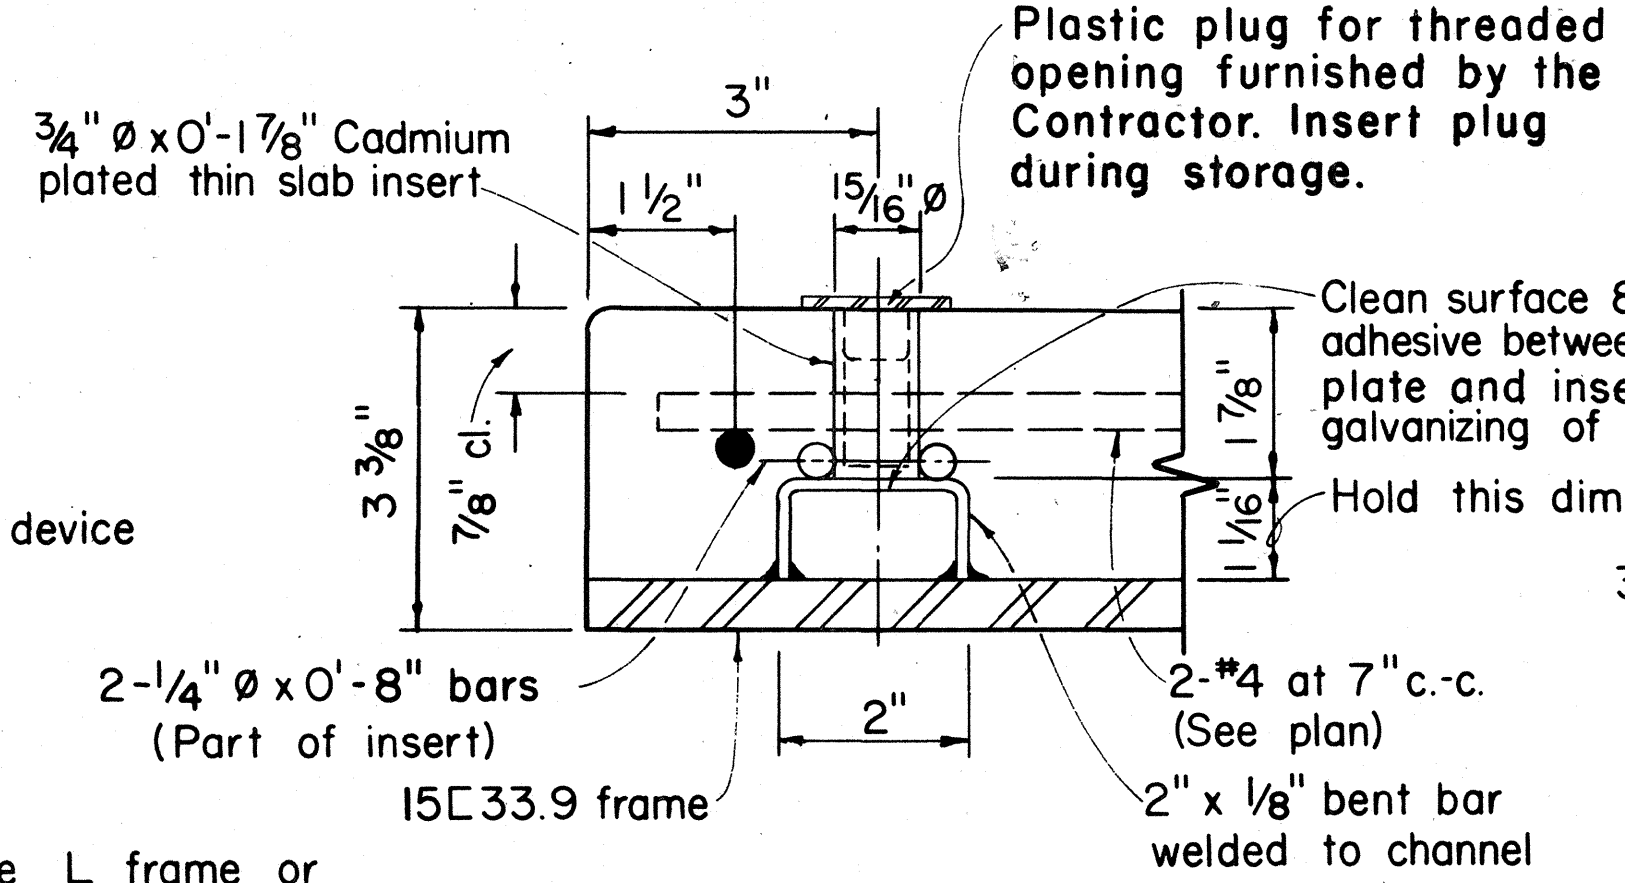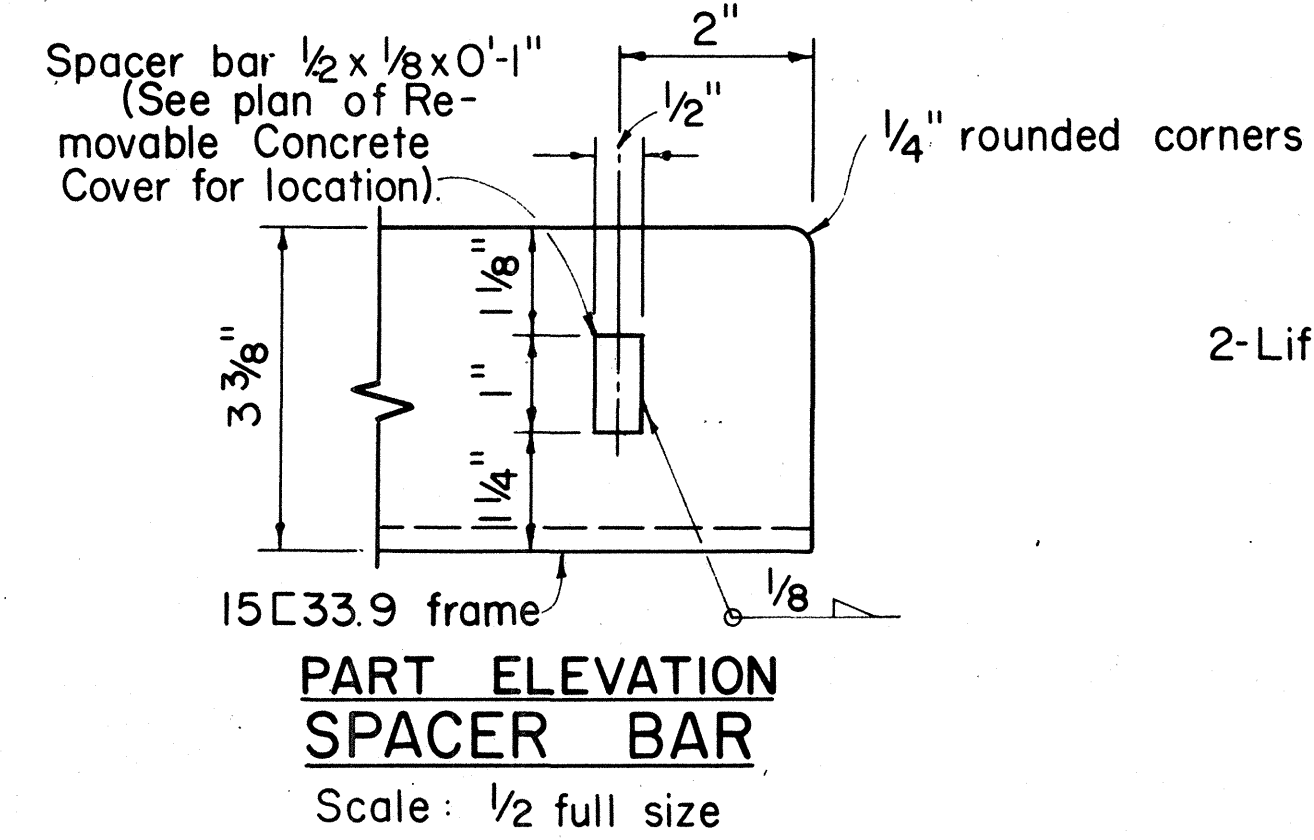

TYPE "TR" REMOVABLE CONCRETE COVER

TYPE "SW" & "SWI" REMOVABLE CONCRETE COVER

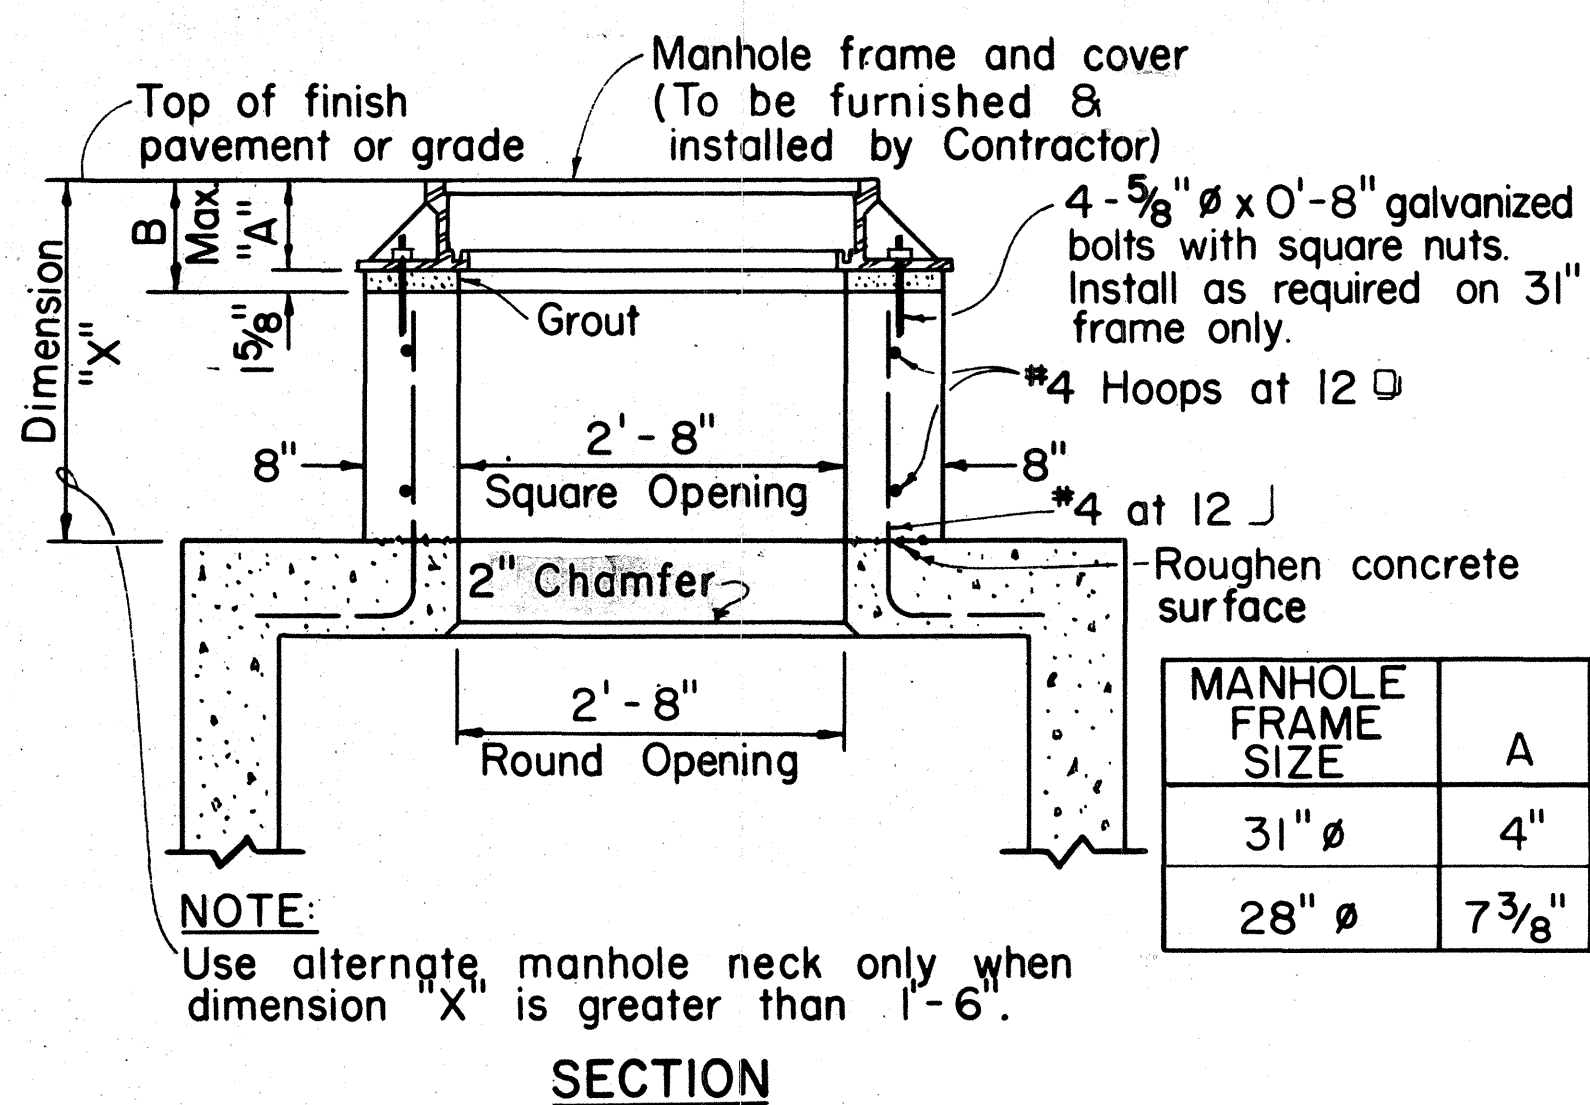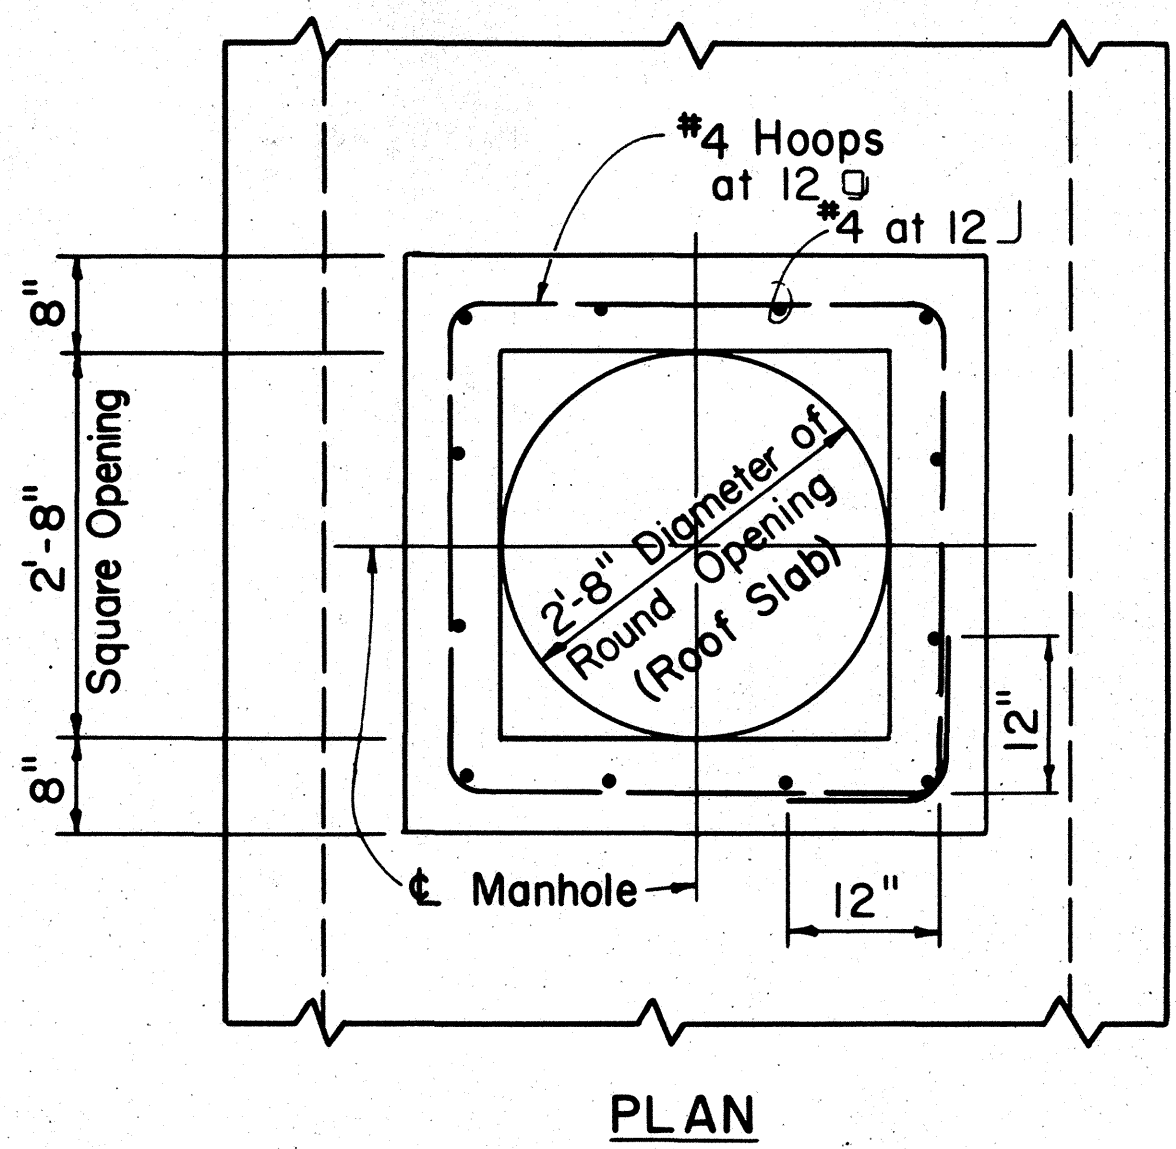


MANHOLE FRAME SIZE	A	B
31" ϕ	4"	5 $\frac{5}{8}"$
28" ϕ	7 $\frac{3}{8}"$	9"

NOTE: Use alternate manhole neck only when dimension "X" is greater than 1'-6".

ALTERNATE MANHOLE NECK

Scale: $\frac{3}{4}" = 1'-0"$

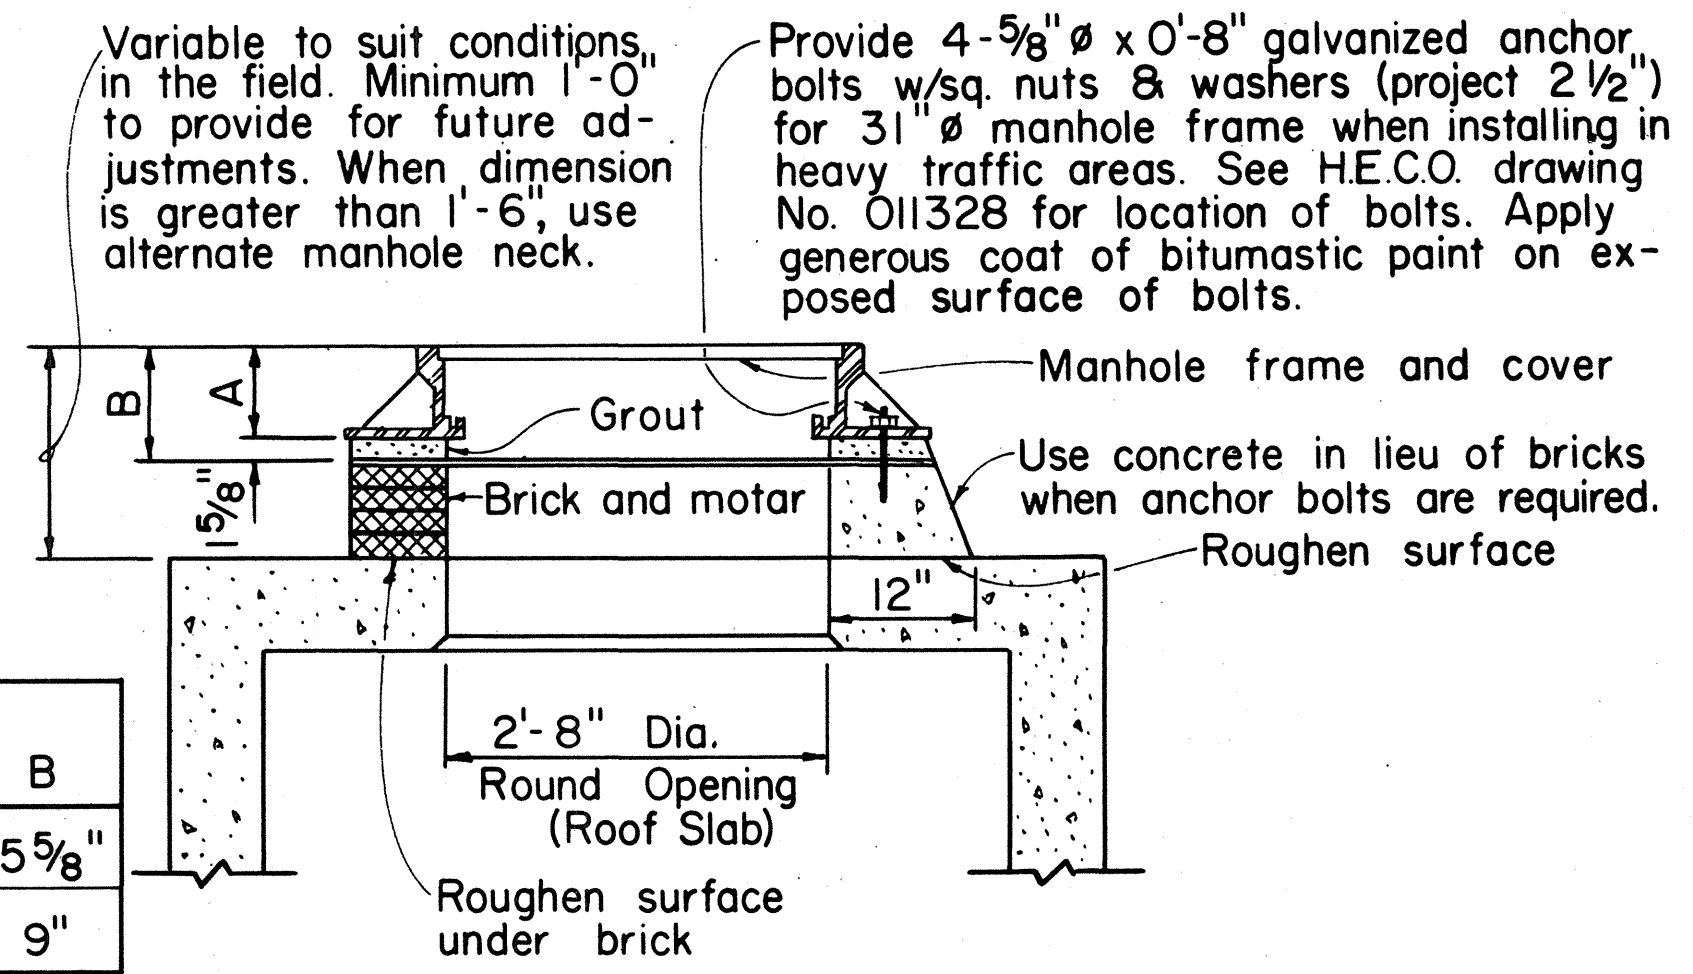

NOTE: See table alternate manhole neck detail for dimension A and B.

31" ϕ & 28" ϕ MANHOLE FRAME NECK DETAIL

Scale: $\frac{3}{4}" = 1'-0"$

APPROVED:
Hawaiian Electric Co., Inc. Date 9-14-78


HECo., Inc. Drawing Number
16688 SHEET NO. 2 OF 2 SHEETS

STATE OF HAWAII
DEPARTMENT OF TRANSPORTATION
LAND TRANSPORTATION FACILITIES DIVISION

**MISCELLANEOUS DETAILS
HANDHOLES & MANHOLES
UNDERGROUND STANDARDS**


Scale as noted AUG 1978
SHEET No. 29 OF 38 SHEETS

FED. ROAD DIST. NO.	STATE	FED. AID PROJ. NO.	FISCAL YEAR	SHEET NO.	TOTAL SHEETS
HAWAII	HAW.	F-083-1(10)	1978	78	160

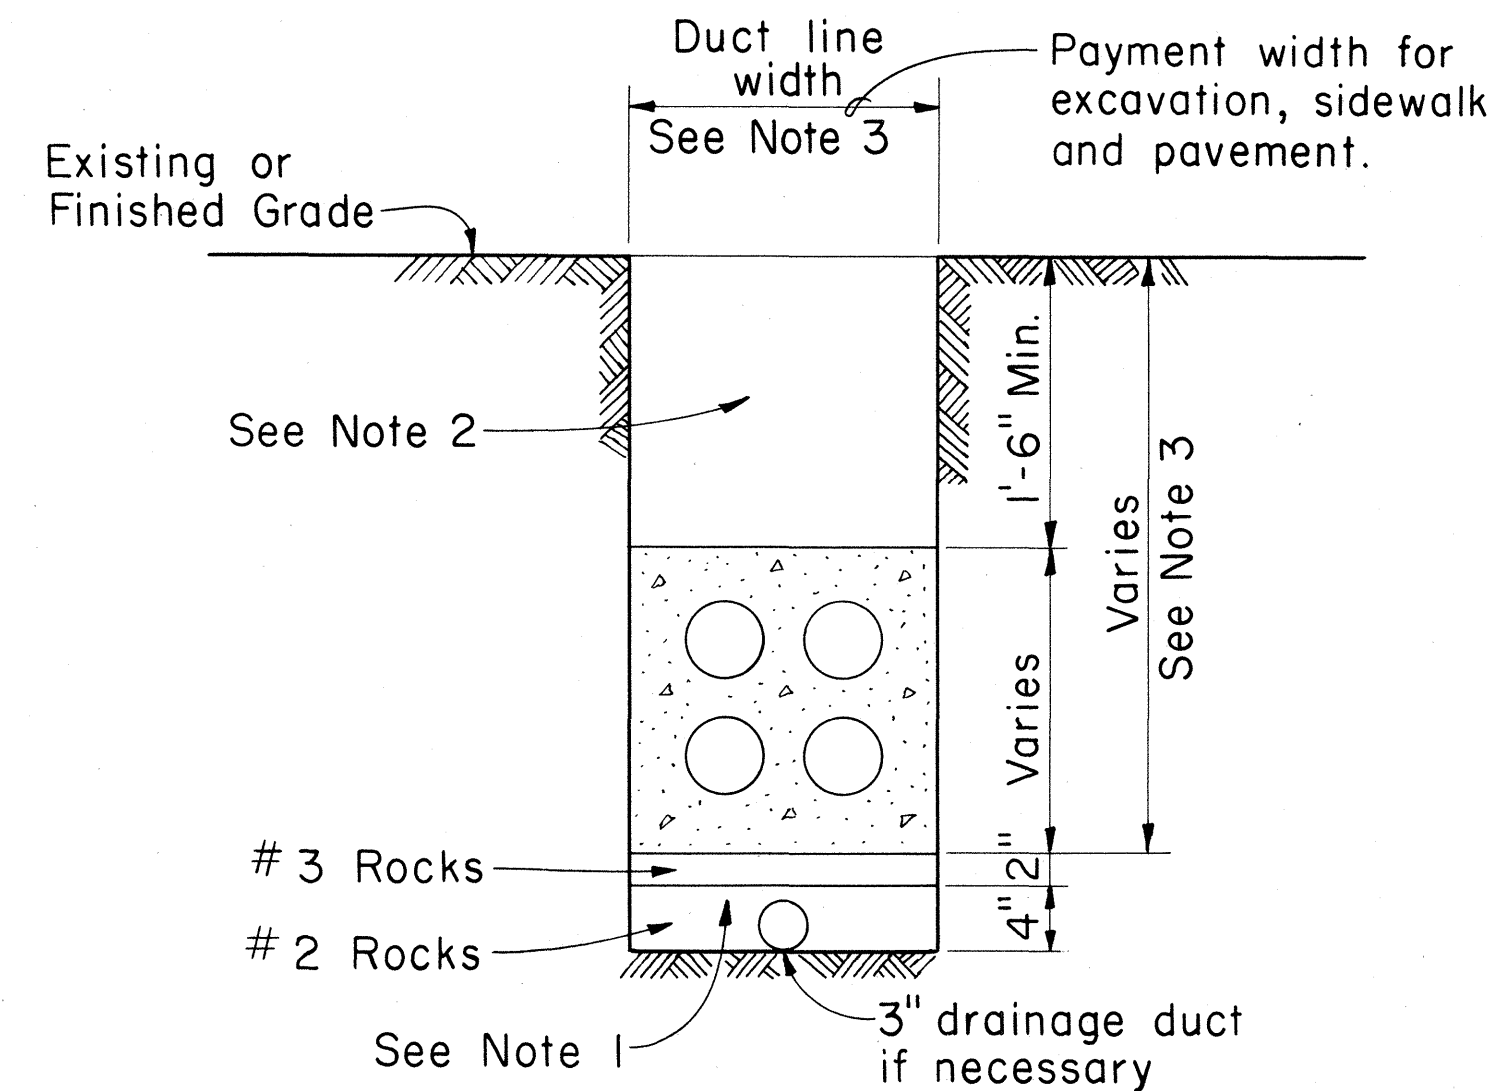

- NOTES:
1. If drainage is necessary, install 6" rockfill as shown. In extremely watery areas, install 3" drainage duct.
 2. Refer to H.E.Co. Specification CS7001-O (or equivalent) for backfill material requirements.
 3. Size of concrete envelope and depth of excavation to be determined by specific project.


EB EXCAVATION AND BACKFILL DETAILS
(TYPICAL)
Scale: 1 1/2" = 1' - 0"

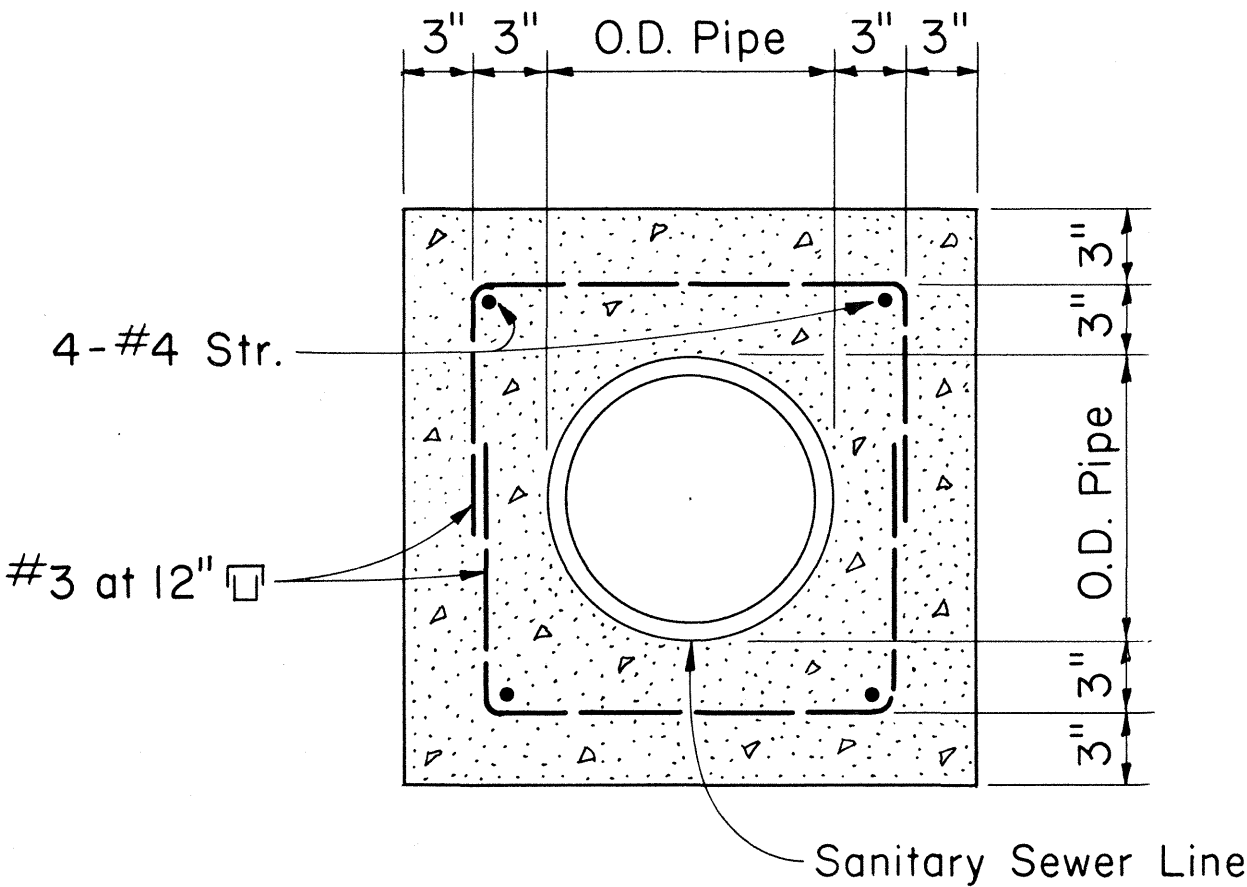


CROSS-SECTION OF SEWER LINE

- NOTE:
Where duct line crosses sewer line, cover sewer line with concrete jacket as indicated in specification.
- | DUCT LINE WIDTH | LENGTH OF SEWER LINE TO BE COVERED |
|------------------|------------------------------------|
| 24" or less | 5' |
| Greater than 24" | (Width of duct line) + (5') |


SANITARY SEWER LINE CROSSING DETAIL
Scale: 1 1/2" = 1' - 0"

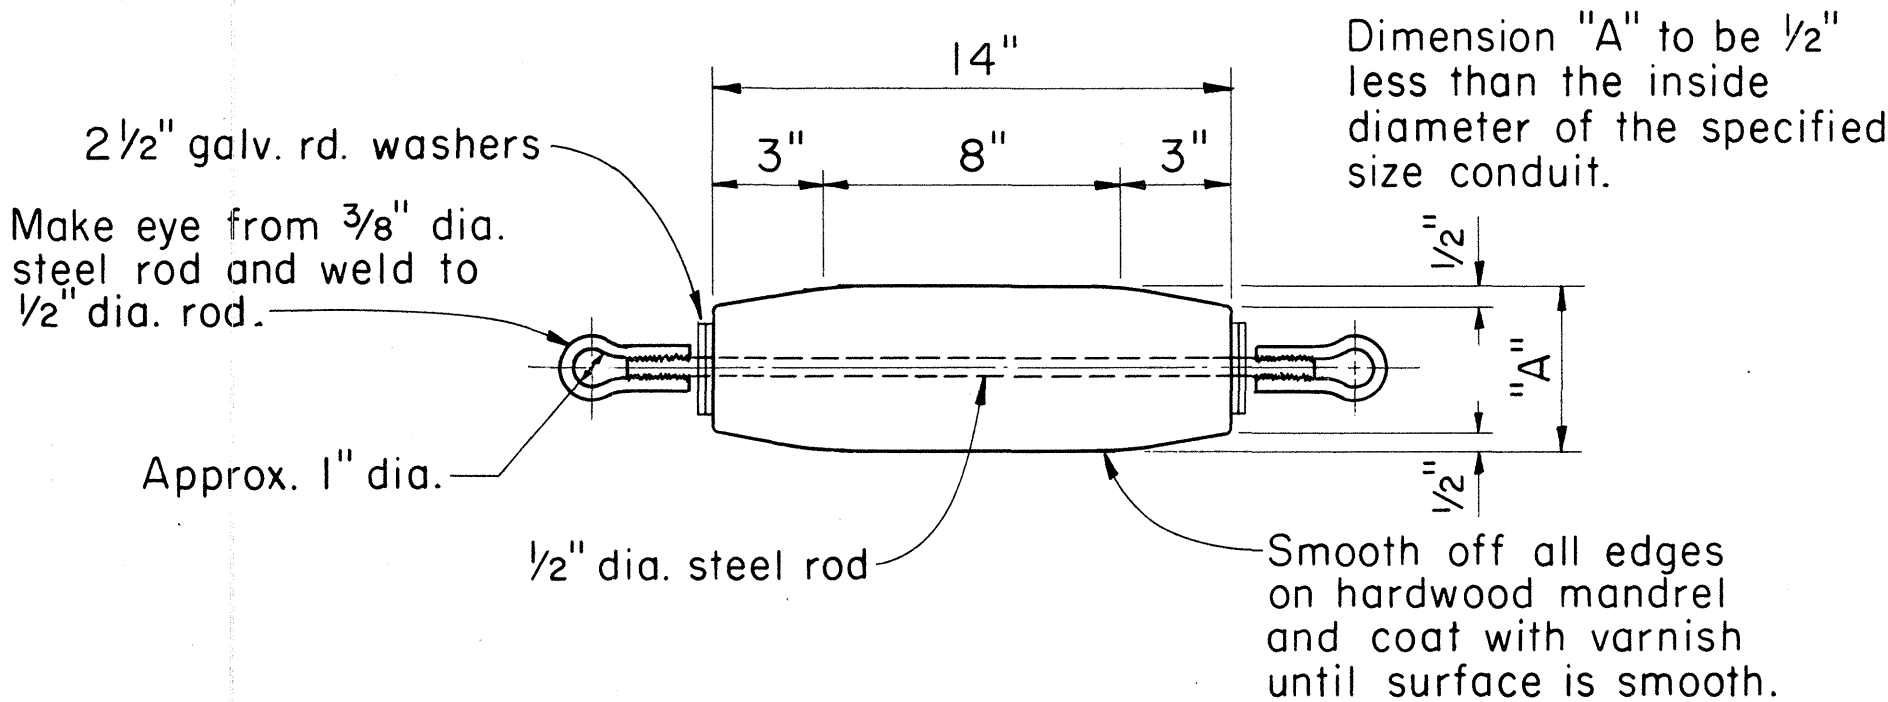


MANDREL DETAIL
Not To Scale

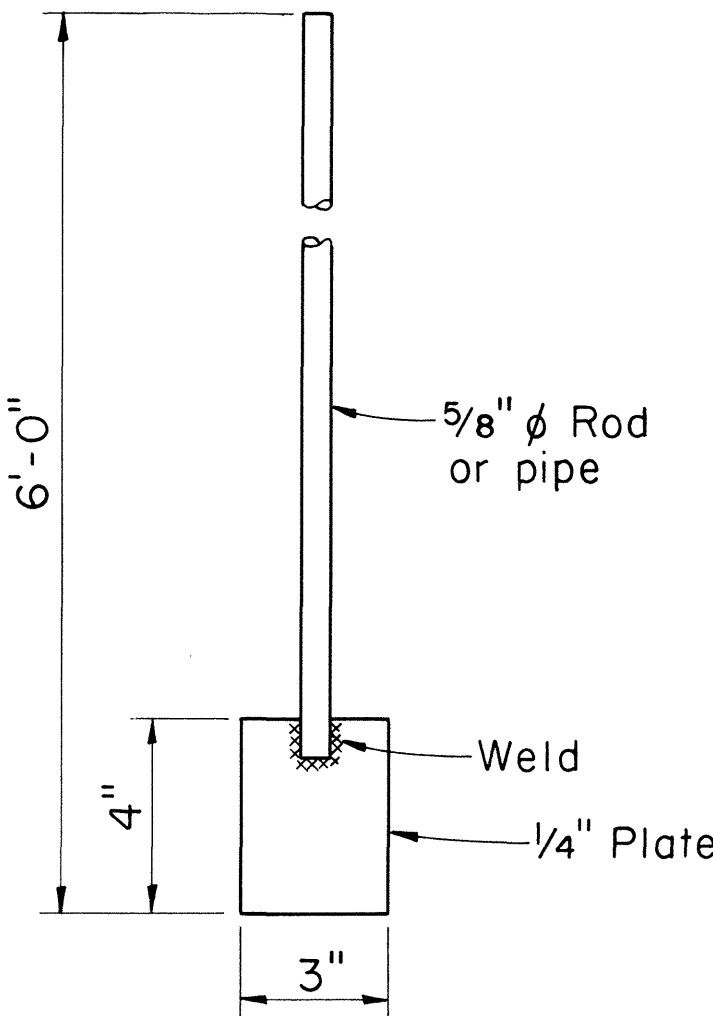

HAND SPADE
Scale: 3" = 1' - 0"

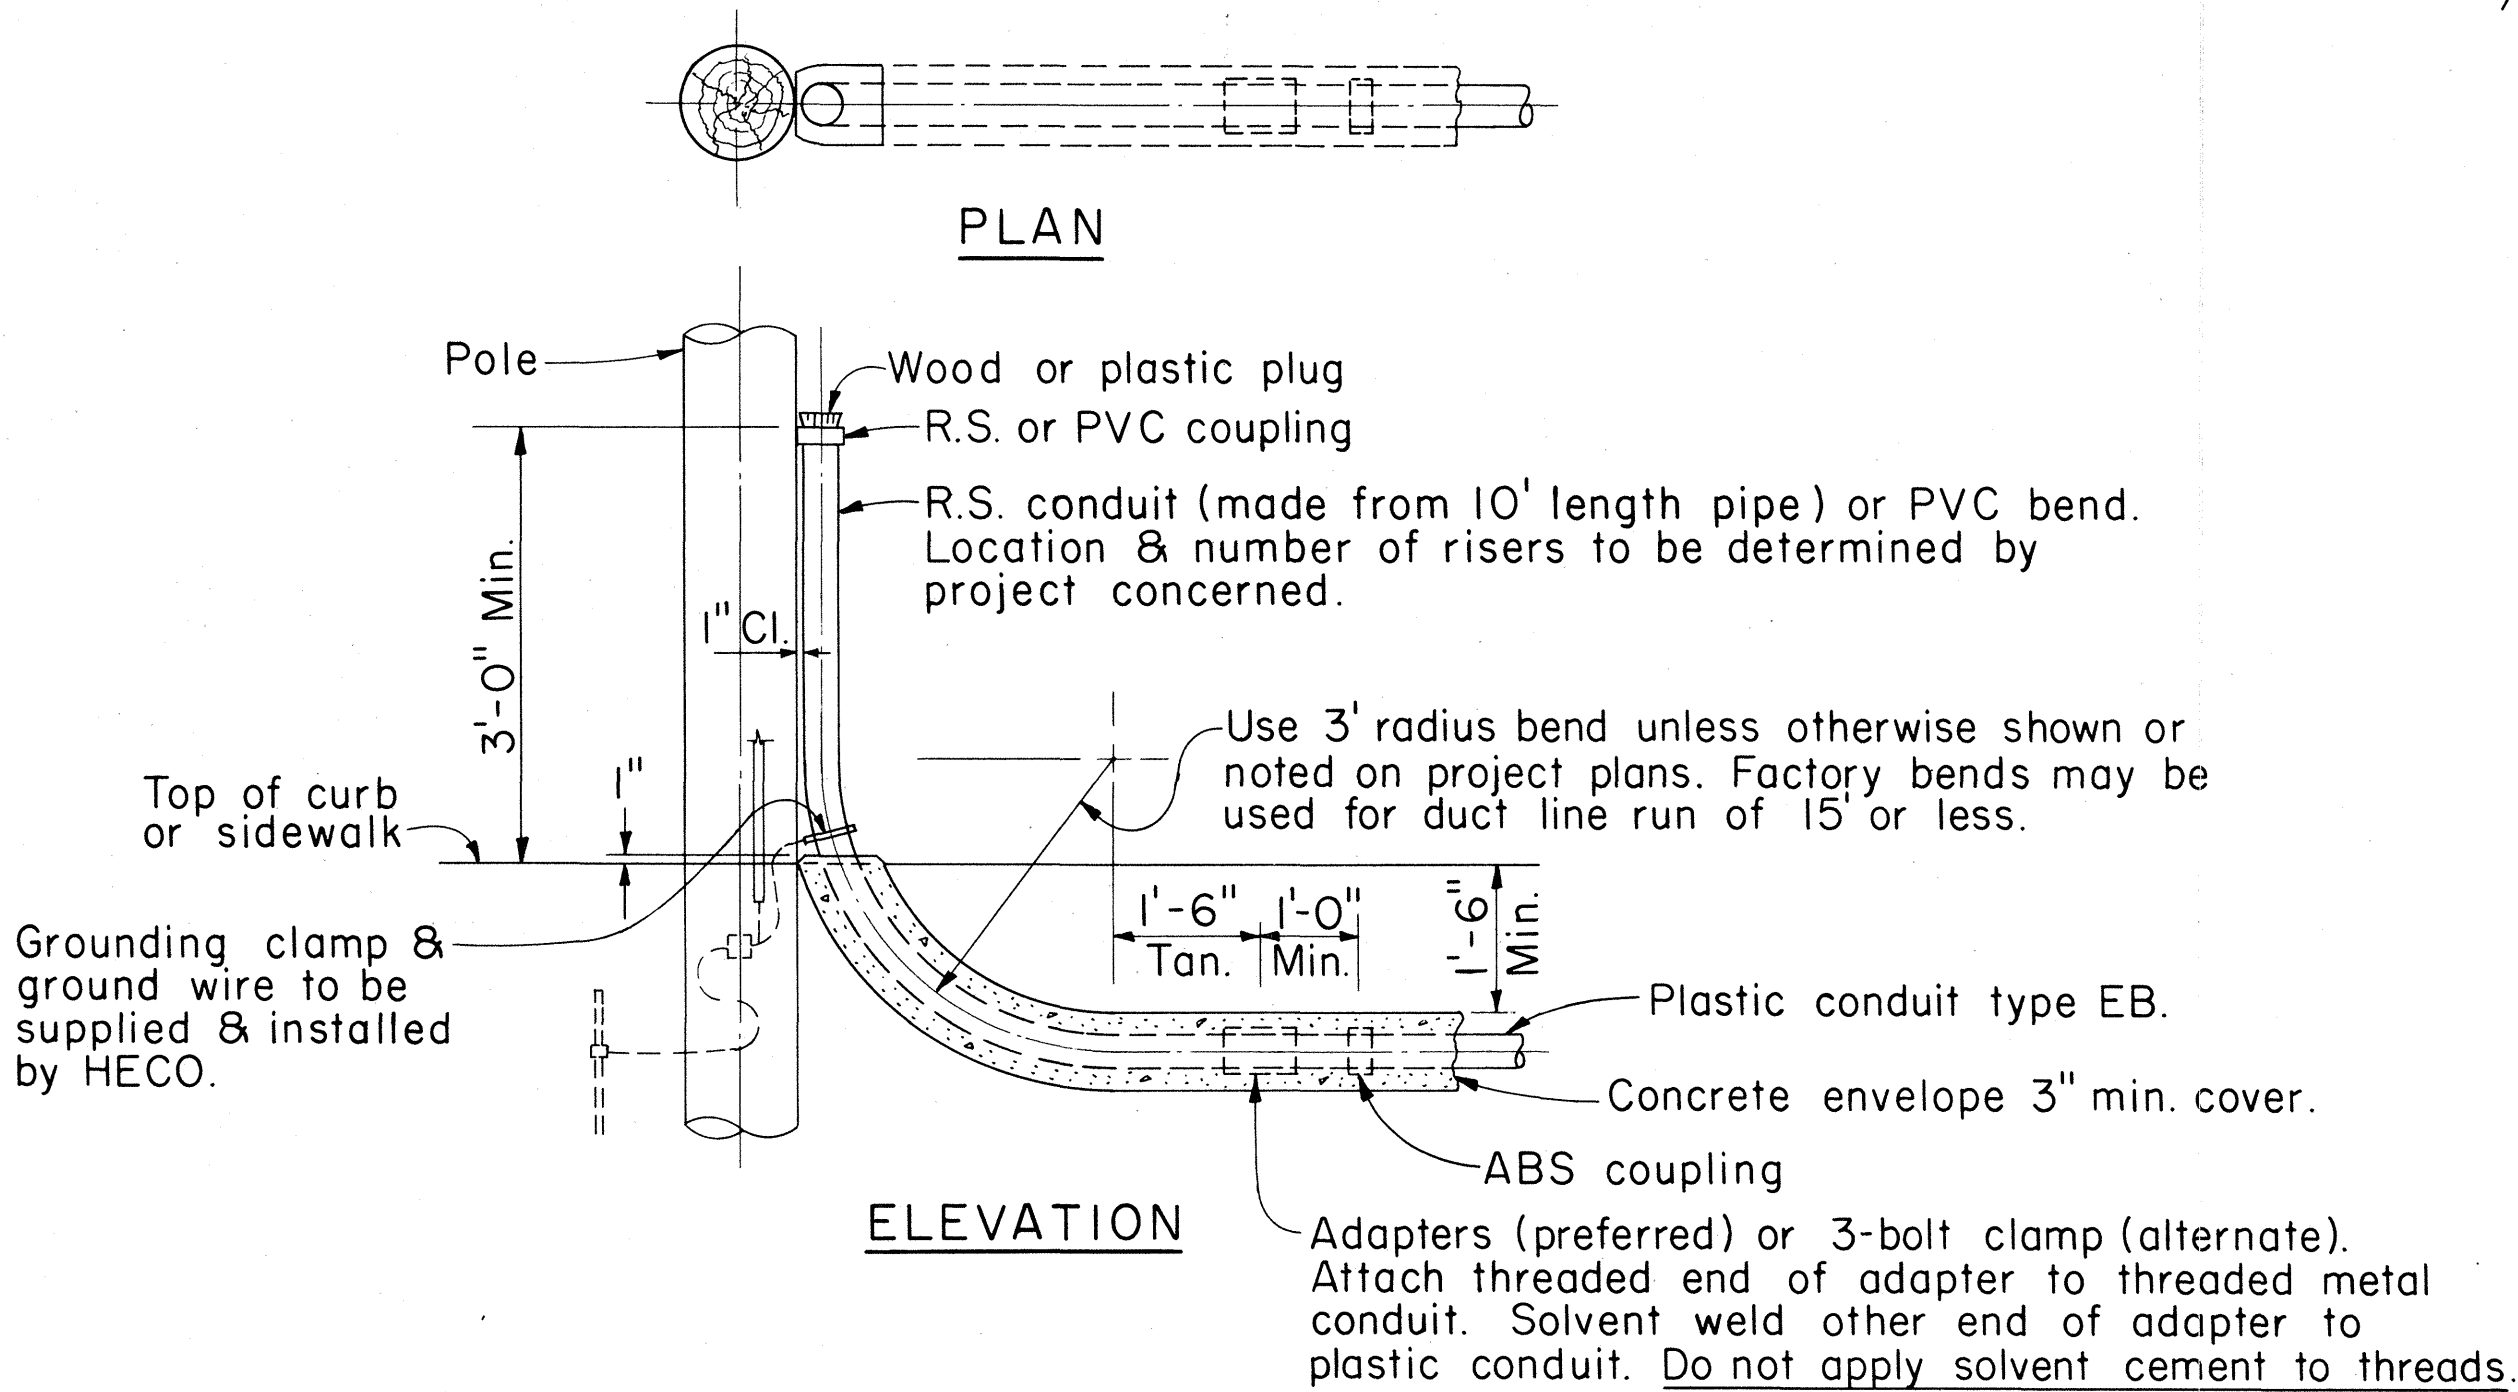

TYPICAL RISER DETAIL
(POLE RISER SHOWN)
Scale: 1/2" = 1' - 0"

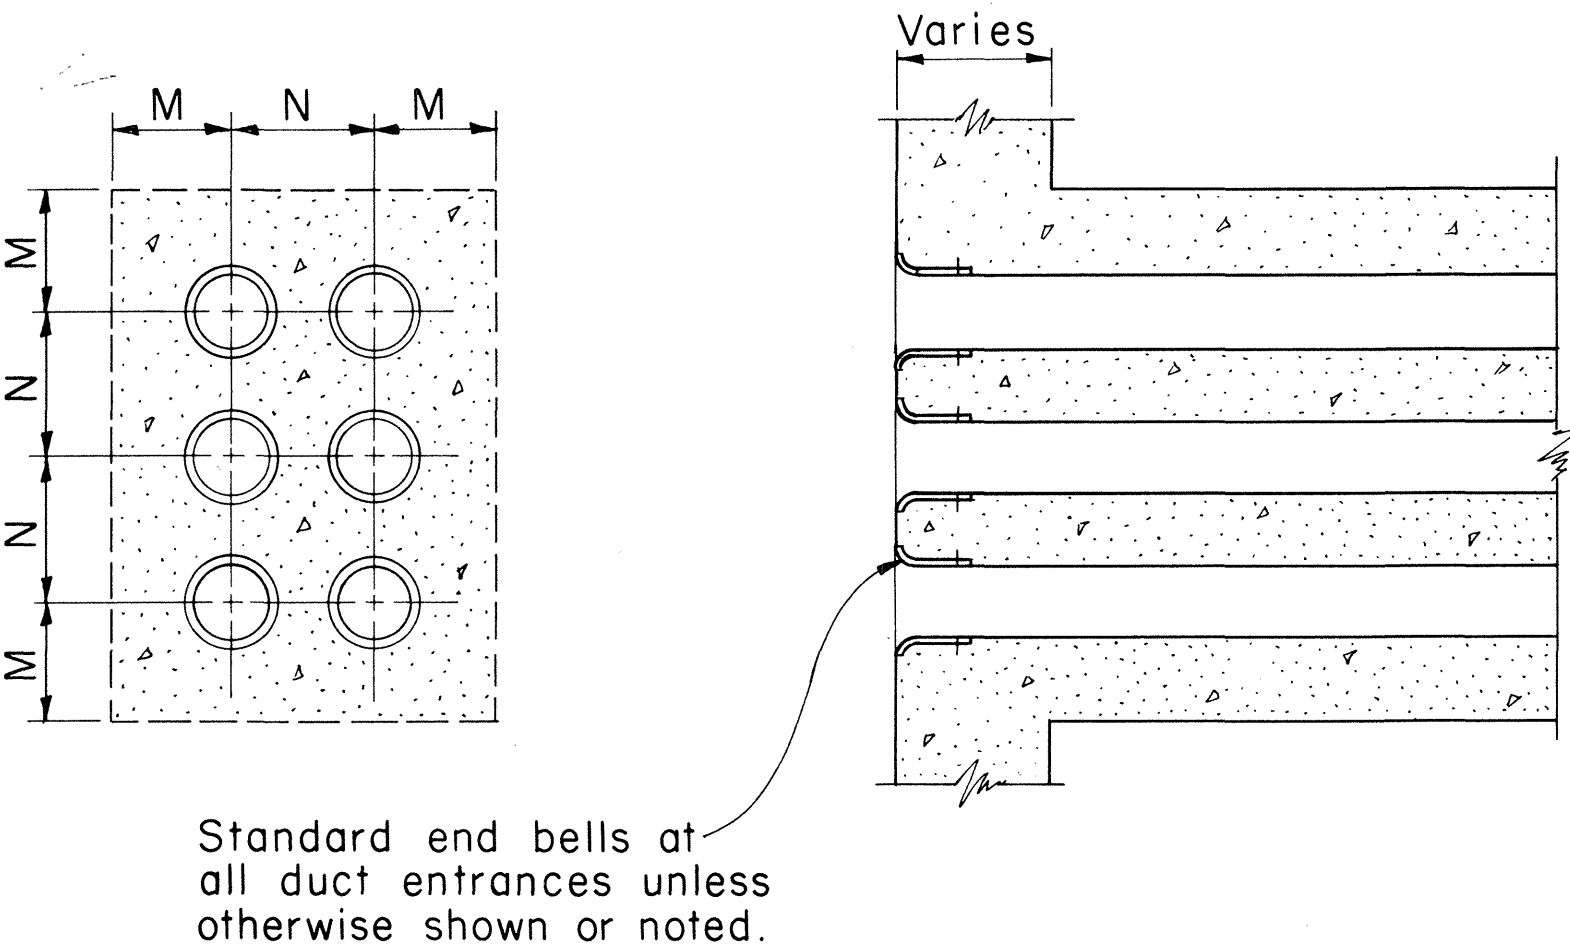

TYPICAL CONDUIT ENTRANCE INTO HANDHOLE, MANHOLE OR VAULT WALLS
(6 WAY DUCT LINE SHOWN)
Scale: 1 1/2" = 1' - 0"


DUCT SIZE	DIMENSIONS (INCHES)	
	M	N
2	4	5
3	5	6
4	5 1/2	7
5	6	8
6	6 5/16	9

APPROVED:
M. J. [Signature] 9-14-78
Hawaiian Electric Co., Inc. Date

HECo., Inc. Drawing Number
30-1030
STATE OF HAWAII
DEPARTMENT OF TRANSPORTATION
LAND TRANSPORTATION FACILITIES DIVISION
TYPICAL DUCT CONSTRUCTION INSTALLATION DETAILS UNDERGROUND DETAILS
Scale as noted AUG 1978
SHEET No. 30 OF 38 SHEETS

DESIGNED BY	DATE
NOTED BY	
CHECKED BY	
ORIGINAL PLAN	
NOTE BOOK	
NO.	

FED. ROAD DIST. NO.	STATE	FED. AID PROJ. NO.	FISCAL YEAR	SHEET NO.	TOTAL SHEETS
HAWAII	HAW.	F-083-100	1978	79	160

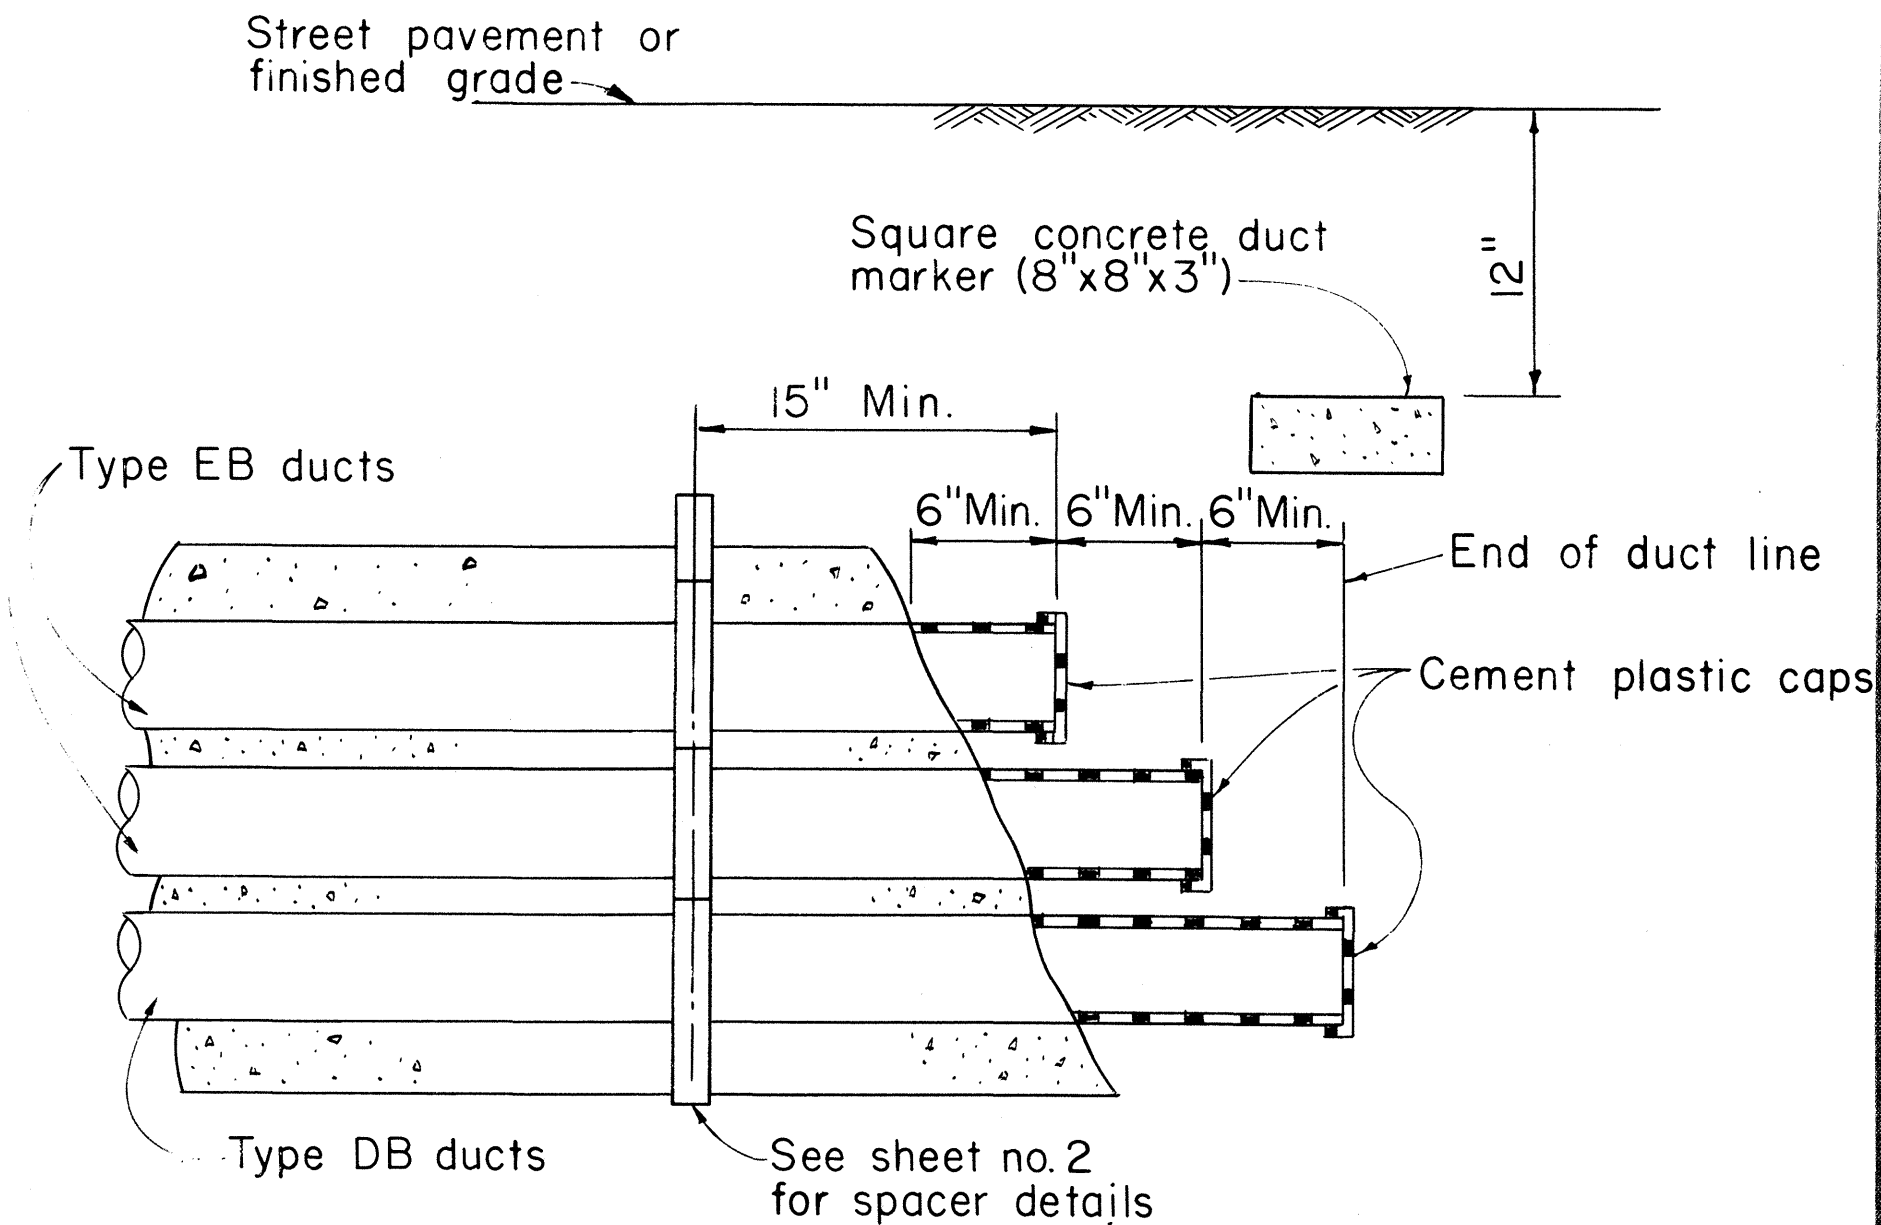

TYPICAL STUB OUT DETAIL
(6-WAY DUCT SHOWN)
Scale: 1 1/2" = 1' - 0"

GENERAL NOTES

- A. APPROVED CONDUIT MATERIALS**
- Encased Burial (EB) Conduit
 - Asbestos Cement, Type I ----- M7005
 - ABS (Acrylonitrile-Butadiene-Styrene) Plastic Conduit, Type EB ----- M7001
 - PVC (Polyvinyl Chloride) Plastic Conduit, Type EB ----- M7001
 - PVC Plastic Conduit, Schedule 40 ----- 116
 - See note 3 EB Typical Duct Section
 - Direct Burial (DB) Conduit
 - ABS Plastic Conduit, Type DB ----- M7001
 - PVC Plastic Conduit ----- M7001
 - PVC Plastic Conduit, Schedule 40 ----- 116
- B. This drawing provides details for installing Plastic Ducts (ABS & PVC) only. Refer to drawing 30-1030 & 30-1033 for installing Asbestos Cement Ducts Encased Burial.**

HECO PURCHASE SPECIFICATION NO.

Type EB ducts

Type DB ducts


See sheet no. 2 for spacer details

End of duct line

Cement plastic caps

Square concrete duct marker (8'x8'x3')


Street pavement or finished grade

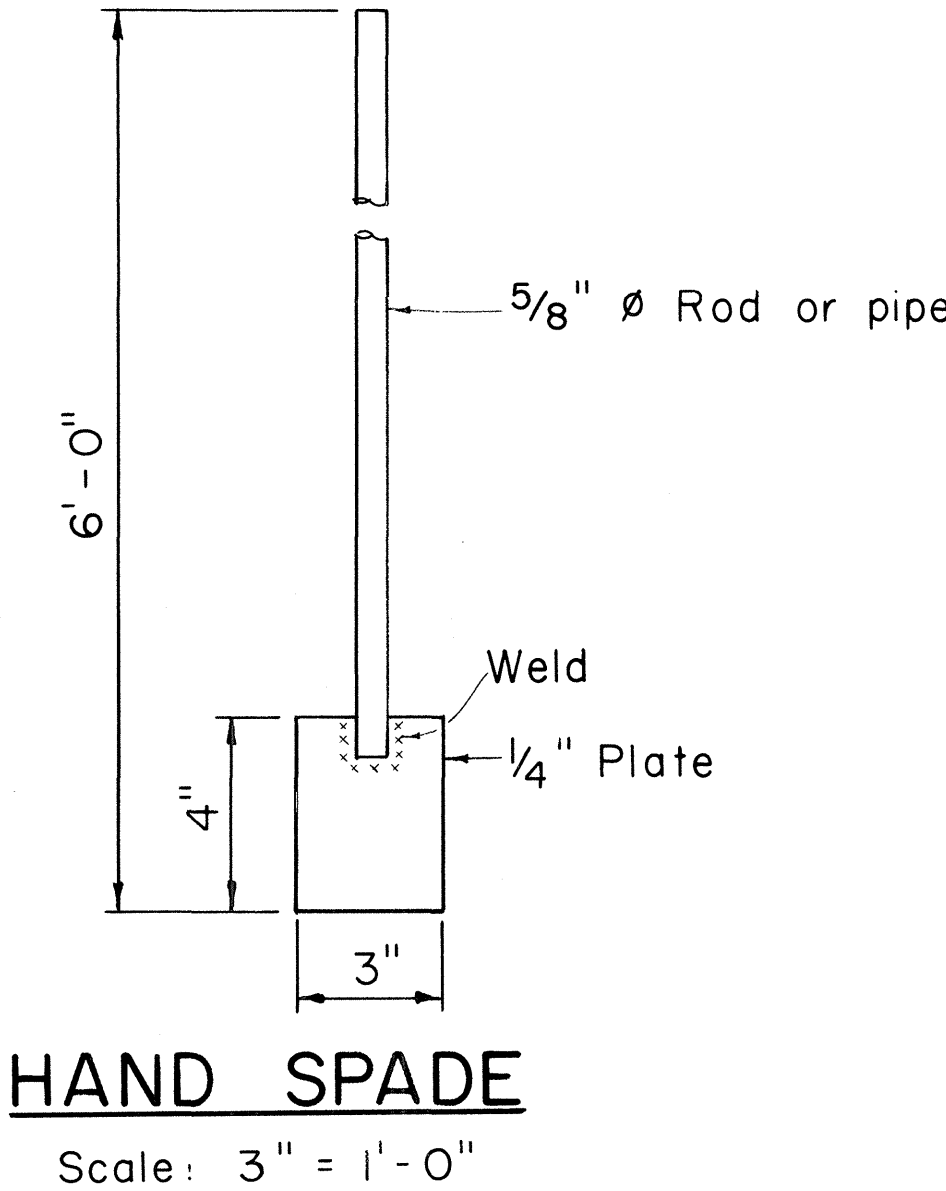

HAND SPADE
Scale: 3" = 1' - 0"

TABLE "A"	
APPROX. RADIUS OF BEND, R	LENGTH OF EA. CONDUIT-FT. USING 5° BEND AT COUPL.
11' - 6"	1
17' - 3"	1.5
23' - 0"	2
28' - 9"	2.5
34' - 6"	3
40' - 3"	3.5
46' - 0"	4
51' - 9"	4.5
57' - 6"	5
69' - 0"	6
80' - 6"	7
92' - 0"	8

TABLE "B"		
ANGLE OF BEND θ	NO. OF COUPLINGS	LENGTH OF CONDUIT
15°	3	2
30°	6	5
45°	9	8
60°	12	11
75°	15	14
90°	18	17

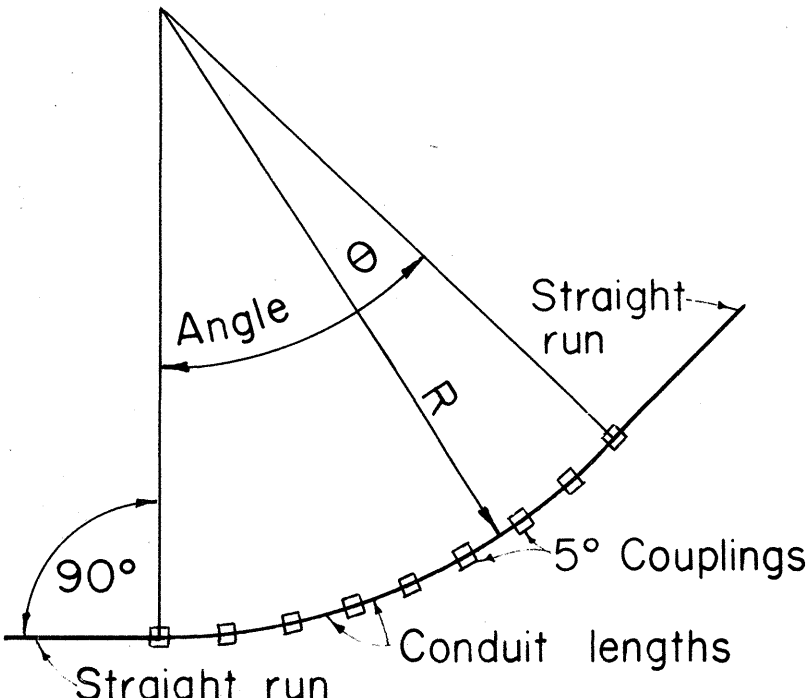

EXAMPLE:
Radius of bend (R) = 60'
Angle of bend (θ) = 45°
From Table A, the nearest value to 60' radius is 57'-6". Length of conduit = 5'.
From Table B, for 45° angle.
Number of couplings required = 9
Number of conduit lengths required = 8

METHOD OF FORMING CURVES:

- There are 4 methods of forming curves with plastic conduit.
- "Cold" bending: Limit trench formed radius sweeps to 25' minimum radius.
 - "Heat" bending: Do not heat bend conduit.
 - 5° angle couplings may be used as shown.
 - Factory made elbows and sweeps may be used only when specified by Engineer.


APPLICATION OF 5° COUPLING FOR LONG RADIUS BENDS

REFERENCE SPECIFICATION	
CS 7202	General Conditions
CS 7001	Construction of U.G. Facilities
CS 7003	Construction of Electrical Facilities

APPROVED:
m9 *W. W. W. W.* 7-14-78
Hawaiian Electric Co., Inc. Date


HECO, Inc. Drawing Number
30-1035
 SHEET No. 1 OF 2 SHEETS

STATE OF HAWAII
 DEPARTMENT OF TRANSPORTATION
 LAND TRANSPORTATION FACILITIES DIVISION
 STANDARD DETAILS
 PLASTIC DUCTS
 INSTALLATION DETAILS
 UNDERGROUND STRUCTURES
 Scale as noted AUG 1978
 SHEET No. 31 OF 38 SHEETS

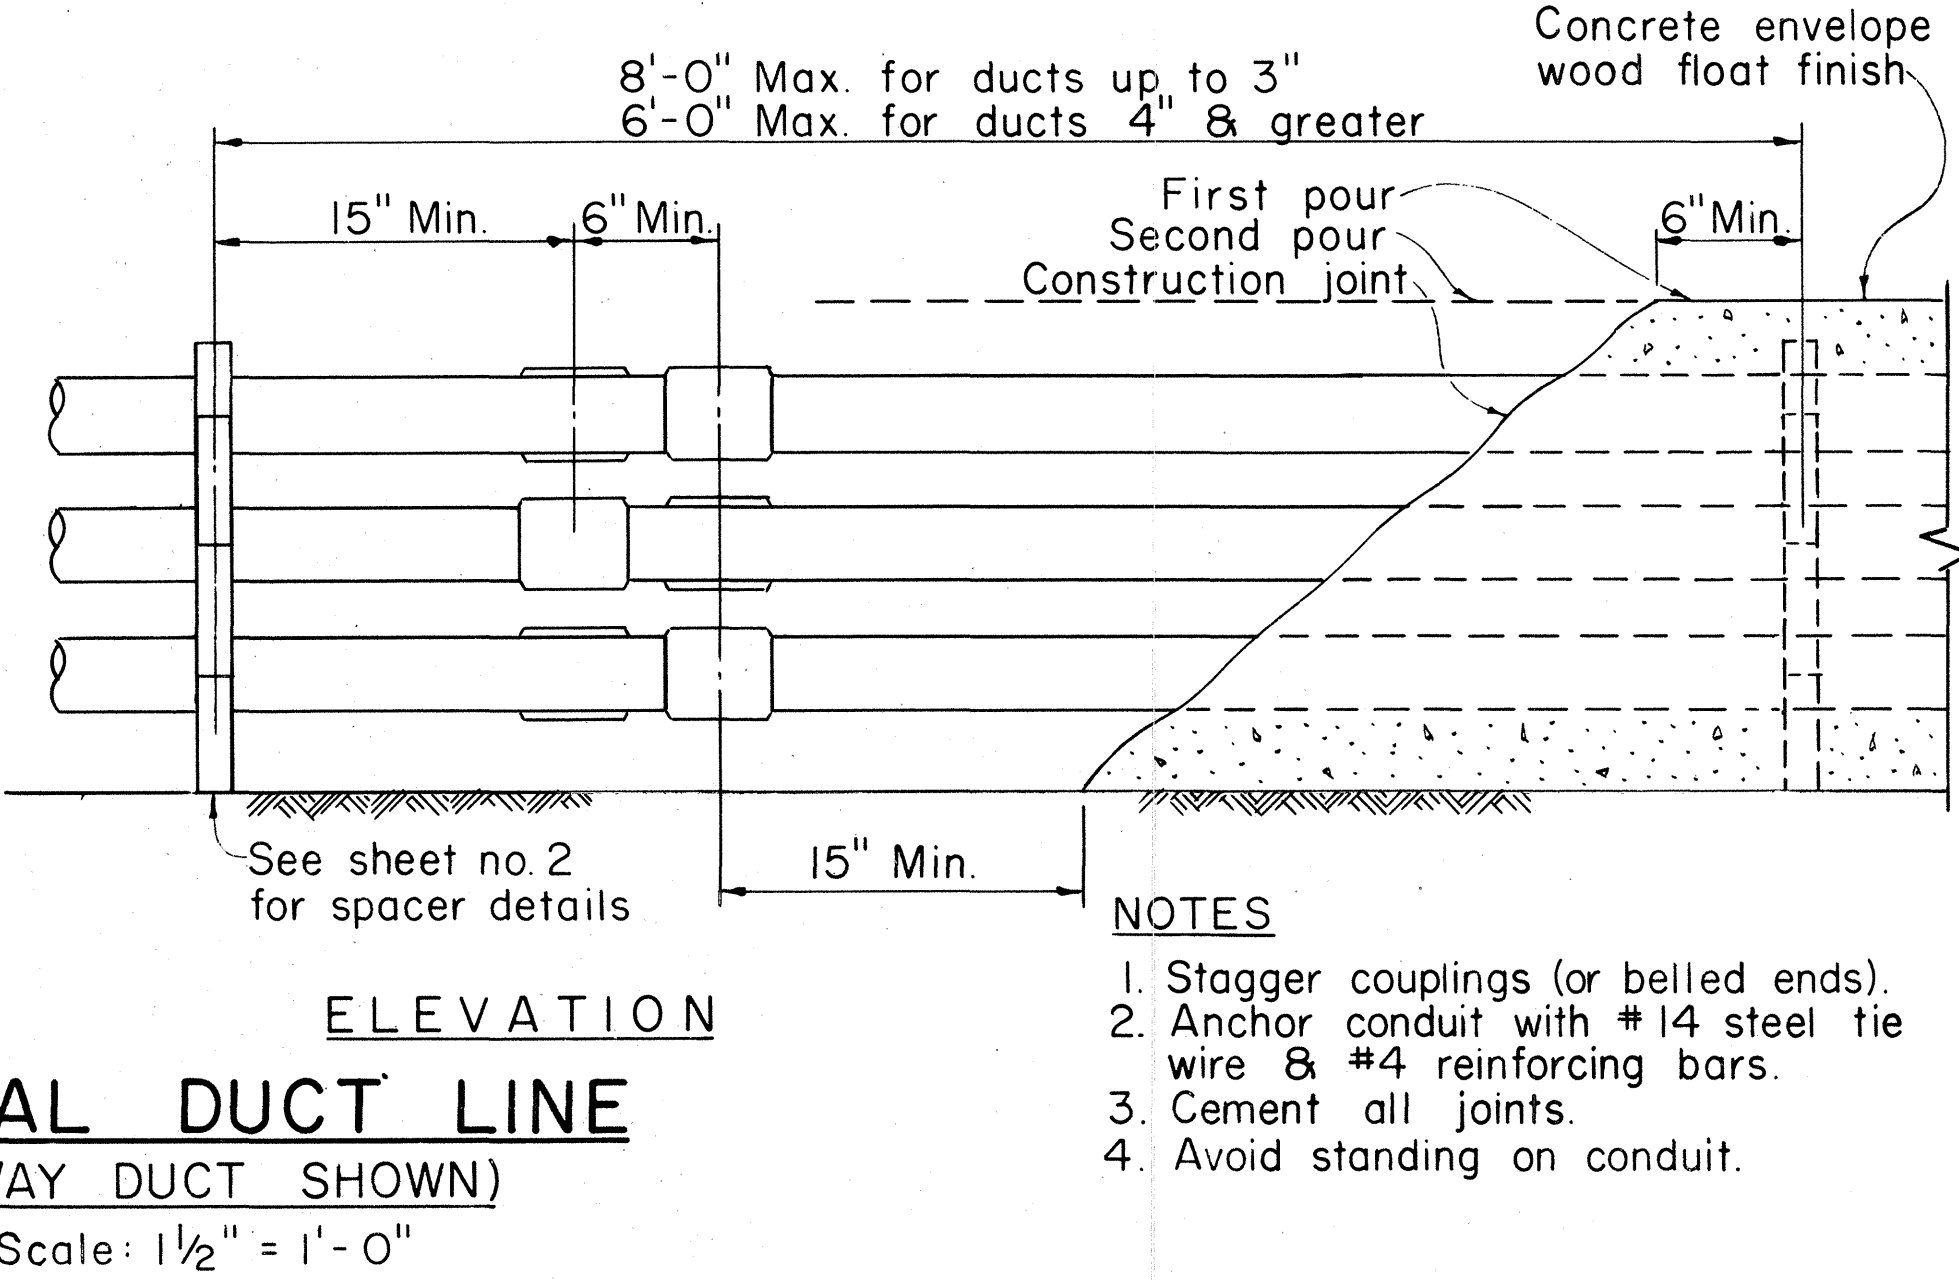

TYPICAL DUCT LINE
(6-WAY DUCT SHOWN)
Scale: 1 1/2" = 1' - 0"

- NOTES**
- Stagger couplings (or belled ends).
 - Anchor conduit with #14 steel tie wire & #4 reinforcing bars.
 - Cement all joints.
 - Avoid standing on conduit.

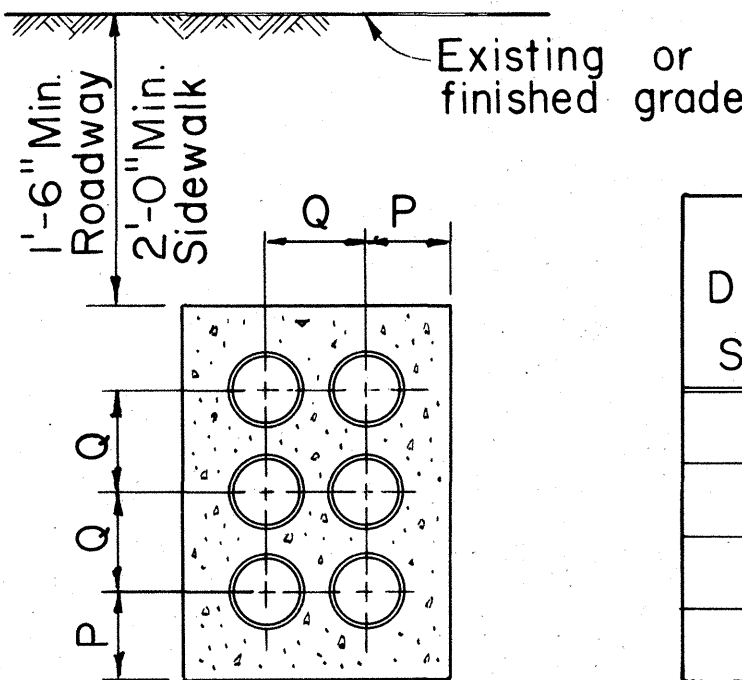


EB TYPICAL DUCT SECTION
(6-WAY DUCT SHOWN)
Scale: 1" = 1' - 0"

DUCT SIZE	DIMENSIONS (INCHES)	
	P	Q
2	4 1/4	4 1/8
3	4 3/4	5 1/8
4	5 1/4	6 1/4
5	5 7/8	7 5/8
6	6 5/16	8 5/8

NOTES:

- Type A: Beach sand, earth or earth and gravel. If earth and gravel, the max. rock size shall be 1" and the mixture shall contain not more than 50%, by volume, of rock particles.
- Type B: Beach sand, earth or earth and gravel. If earth and gravel, the mixture must pass a 1/2" mesh screen and contain not more than 20%, by volume, of rock particles.
- When trench bottom is coarser than Type B material, provide 3" duct cushion.
- Soil poison details: Use an aqueous solution of 2% chlordane, 1% dieldrin or 1% adrin, when specified by engineer. Apply soil poison (1 gal. per 3 square feet) to trench floor and to layer of backfill from trench floor to 3" above conduit.

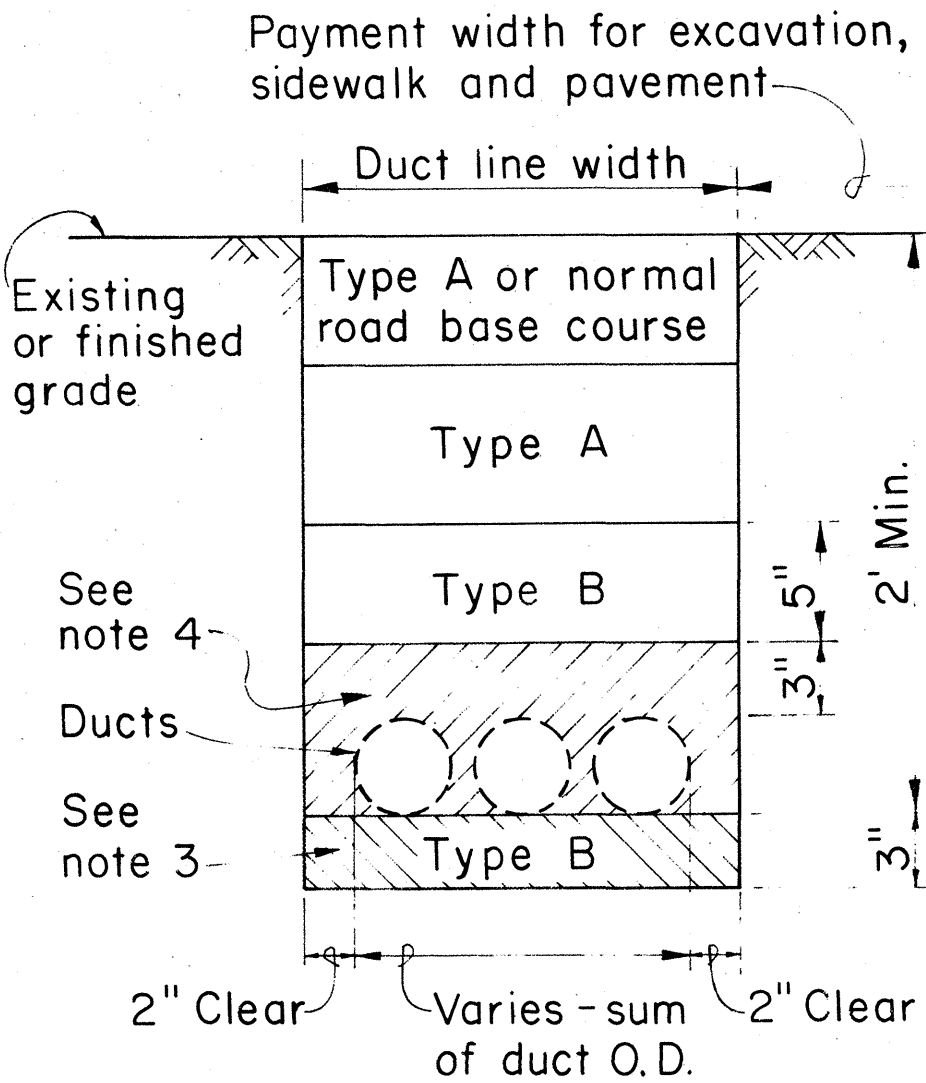


D.B. EXCAVATION & BACKFILL DETAILS (TYPICAL)
Scale: 1 1/2" = 1' - 0"

NOTE:


- Maintain 1 1/2" minimum spacing between conduit; 3" minimum concrete envelope around top, bottom & sides.
- Dimensions are minimum dimensions.
- The bottom row in an encased duct bank of three or more layers shall be Type DB ducts. The remaining ducts shall be Type EB.

SURVEY PLOTTED BY	DATE
DRAWN BY	
DESIGNED BY	
QUANTITIES BY	
CHECKED BY	
ORIGINAL PLAN	
NOTE BOOK	
No.	


FED. ROAD DIST. NO.	STATE	FED. AID PROJ. NO.	FISCAL YEAR	SHEET NO.	TOTAL SHEETS
HAWAII	HAW.	F-083-1(10)	1978	80	160

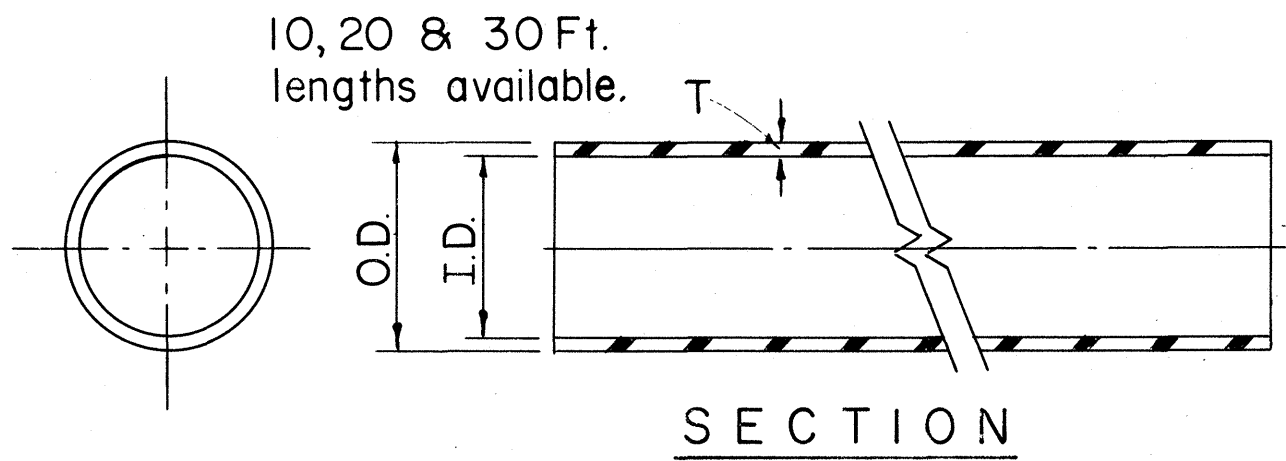


CONDUIT

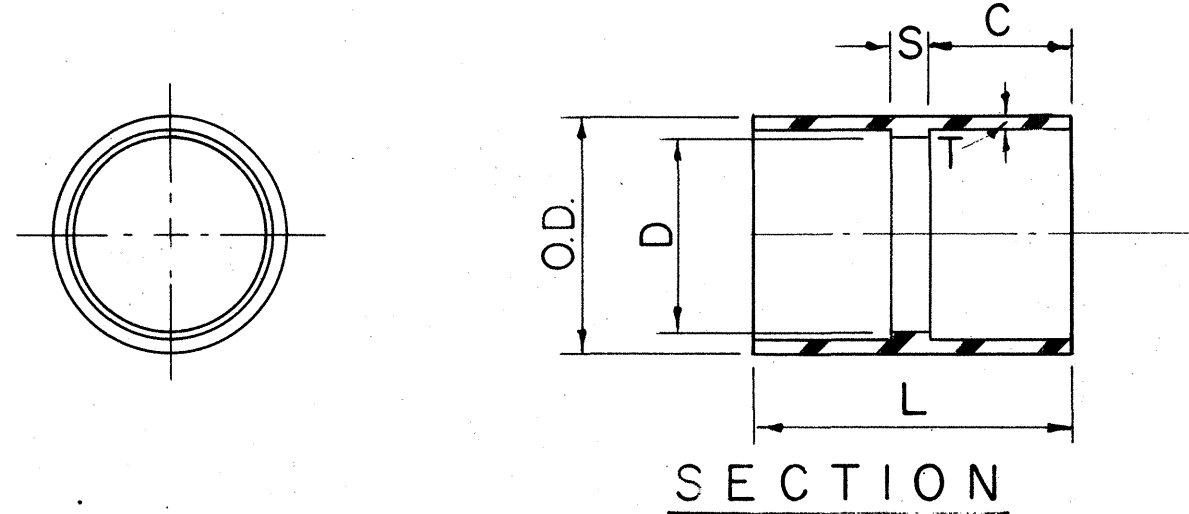


COUPLING (ASTM D-2750)

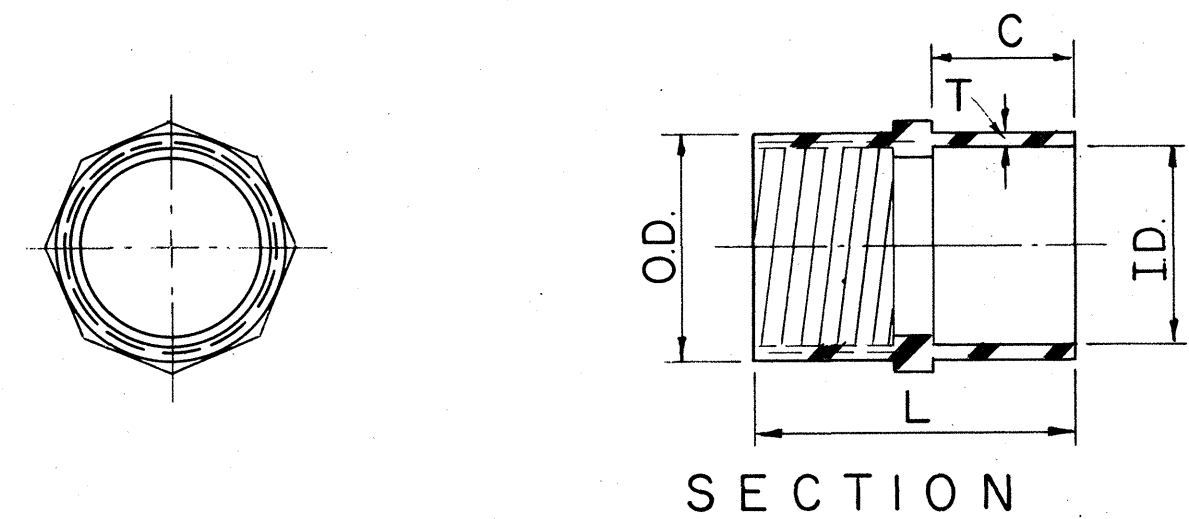


ADAPTER - PLASTIC TO STEEL

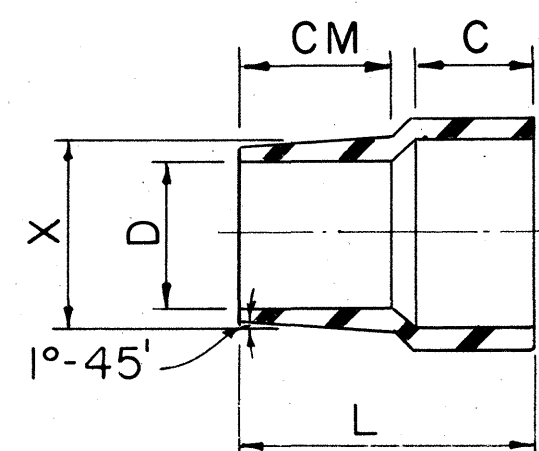

ADAPTER - PLASTIC TO ASBESTOS CEMENT

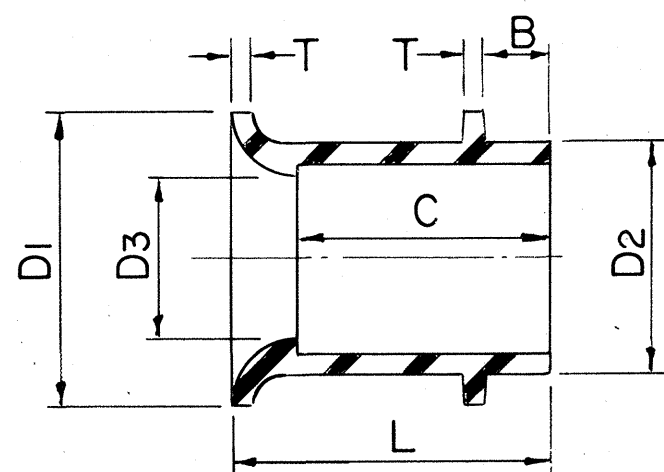


END BELL (ASTM D-2750)

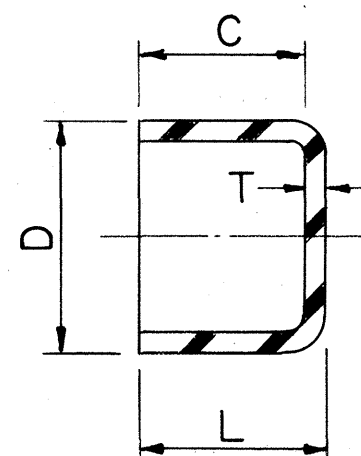

CAP (RIGID) - FOR SEMI-PERMANENT USE (ASTM D-2750)

SIZE	HECO CODE	D	C	L	T
2		2.52	.59	.65	.060
3		3.68	.81	.89	.075
4		4.725	.91	1.01	.095
5		5.805	1.00	1.10	.100
6		6.920	1.13	1.25	.125

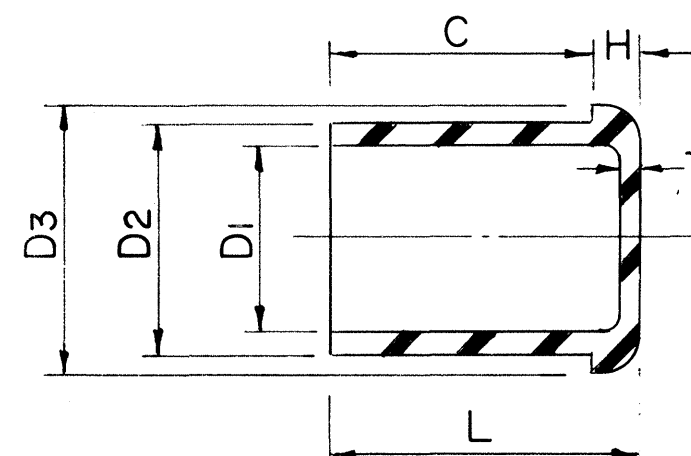


CAP (TEMPORARY) (ASTM D-2750)

CONDUIT SIZE	EB (ENCASED BURIAL)					DB (DIRECT BURIAL)				
	HECO CODE	O.D.	I.D.	T (MIN.)	WEIGHT #/10 ² FT.	HECO CODE	O.D.	I.D.	T (MIN.)	WEIGHT #/10 ² FT.
2		2.375	2.25	.060	21	29010	2.375	2.15	.110	38
3		3.500	3.35	.075	39	29012	3.500	3.25	.125	64
4		4.500	4.31	.095	63	29014	4.500	4.18	.160	104
5		5.563	5.36	.100	82	29016	5.563	5.20	.180	146
6		6.625	6.375	.125	121		6.625	6.25	.190	182


NOTE: Type EB & DB Conduits have same O.D. for a given size. All fittings which go over Conduits are DB type & fit both types of Conduits.

SIZE	HECO CODE	O.D.	D	L	C	S	T
2		2.620	2.255	2 7/16	1.16	.110	.110
3		3.780	3.350	3 3/8	1.63	.120	.125
4		4.855	4.310	3 11/16	1.78	.120	.160
5		5.965	5.363	4 3/32	1.97	.160	.180
6		7.050	6.375	4 15/32	2.16	.160	.190

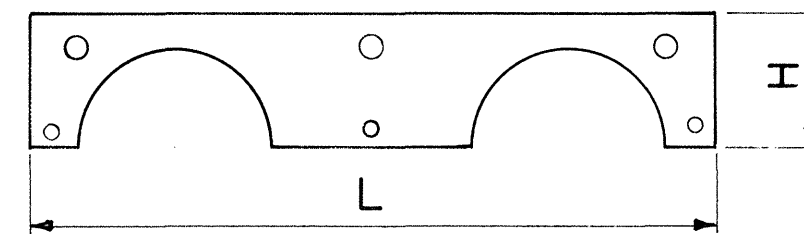


CAP SPACER

SIZE	HECO CODE	L	H
2		9.50	1.75
3		11.25	2.25
4		13.75	3.13
5		15.87	3.63
6		18.0	4.25

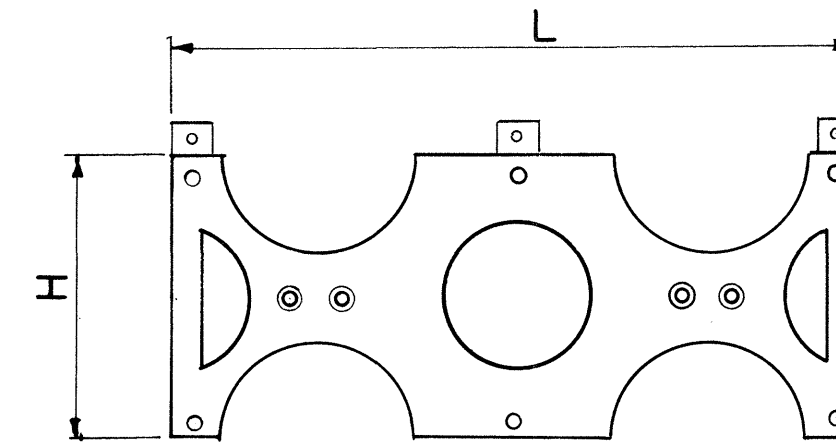


INTERMEDIATE SPACER

SIZE	HECO CODE	L	H	W
2		9.50	3.94	
3		11.25	5.06	
4		13.75	6.06	
5		15.97	7.06	
6		18.0	8.19	

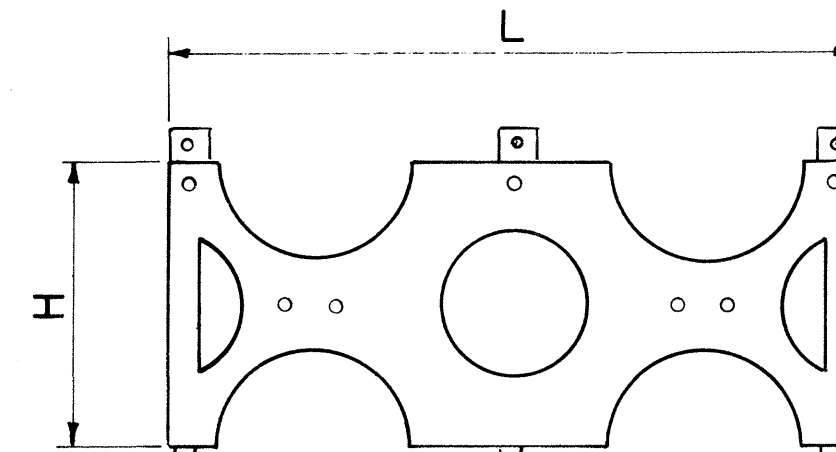

BASE SPACER

DUCT SPACER COMPONENTS (FORMEX SPACER OR EQUIVALENT)

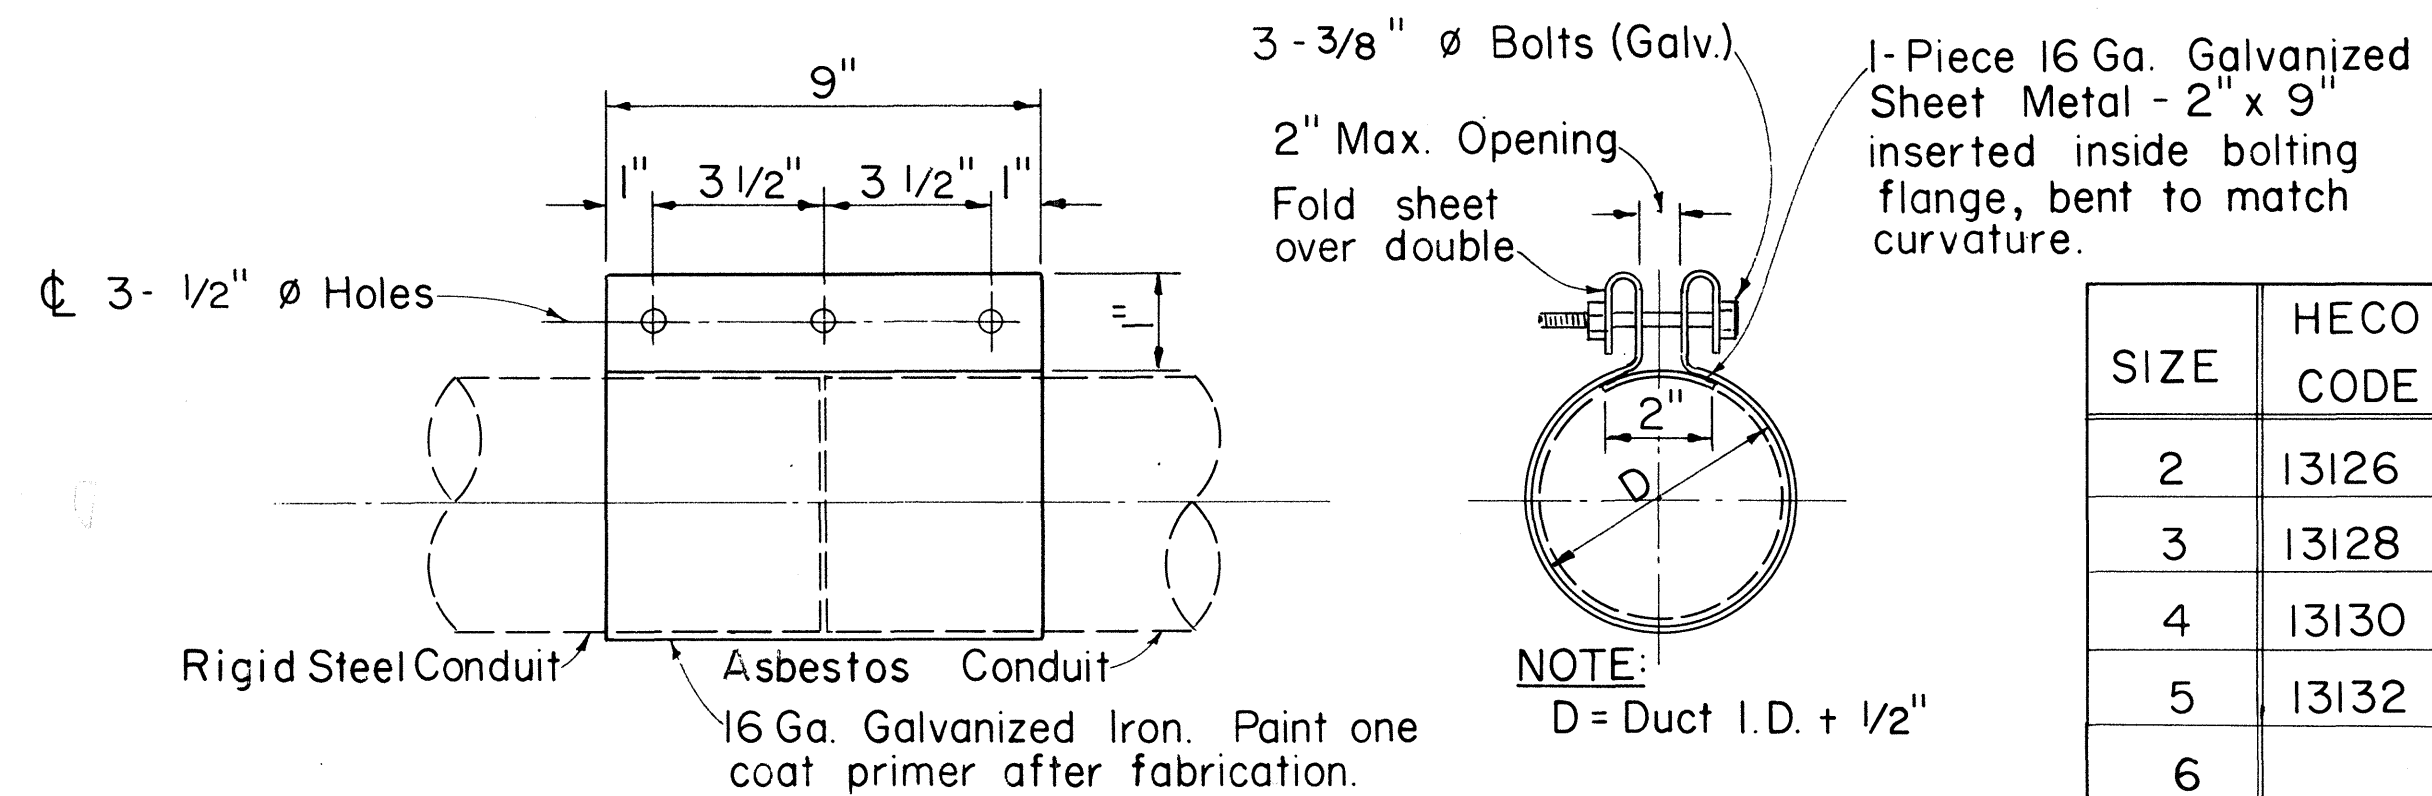

SIZE	HECO CODE
2	13126
3	13128
4	13130
5	13132
6	

3 - BOLT CLAMP

GENERAL NOTES:

- All dimensions in inches.
- Spacers shown are different than that used for Asbestos Cement Type.
- These accessories are to be used with ABS (Acrylonitrile-Butadiene-Styrene), or PVC (Poly-Vinyl Chloride) Plastic Conduit, per HECO purchase specification M7001-O.

APPROVED: *M. J. [Signature]* 9-14-78
Hawaiian Electric Co., Inc. Date

SIZE	HECO CODE	D1	D2	D3	C	H	L	T
2		2.260	2.375	2.500	.593	.125	.718	.060
3		3.360	3.500	3.656	.812	.156	.968	.075
4		4.320	4.500	4.687	.906	.187	1.092	.095
5		5.375	5.638	5.760	1.000	.218	1.218	.100
6		6.390	6.625	6.875	1.093	.250	1.343	.125


NOTE: Cap will go over conduit or "plug" the coupling.

HECO, Inc. Drawing Number
30-1035 SHEET NO. 2 OF 2 SHEETS


STATE OF HAWAII
DEPARTMENT OF TRANSPORTATION
LAND TRANSPORTATION FACILITIES DIVISION
STANDARD DETAILS
PLASTIC DUCTS
INSTALLATION DETAILS
UNDERGROUND STRUCTURES

Scales: Not to Scale AUG 1978
SHEET No. 32 OF 38 SHEETS

FED. ROAD DIST. NO.	STATE	FED. AID PROJ. NO.	FISCAL YEAR	SHEET NO.	TOTAL SHEETS
HAWAII	HAW.	F-083-1(10)	1978	81	160

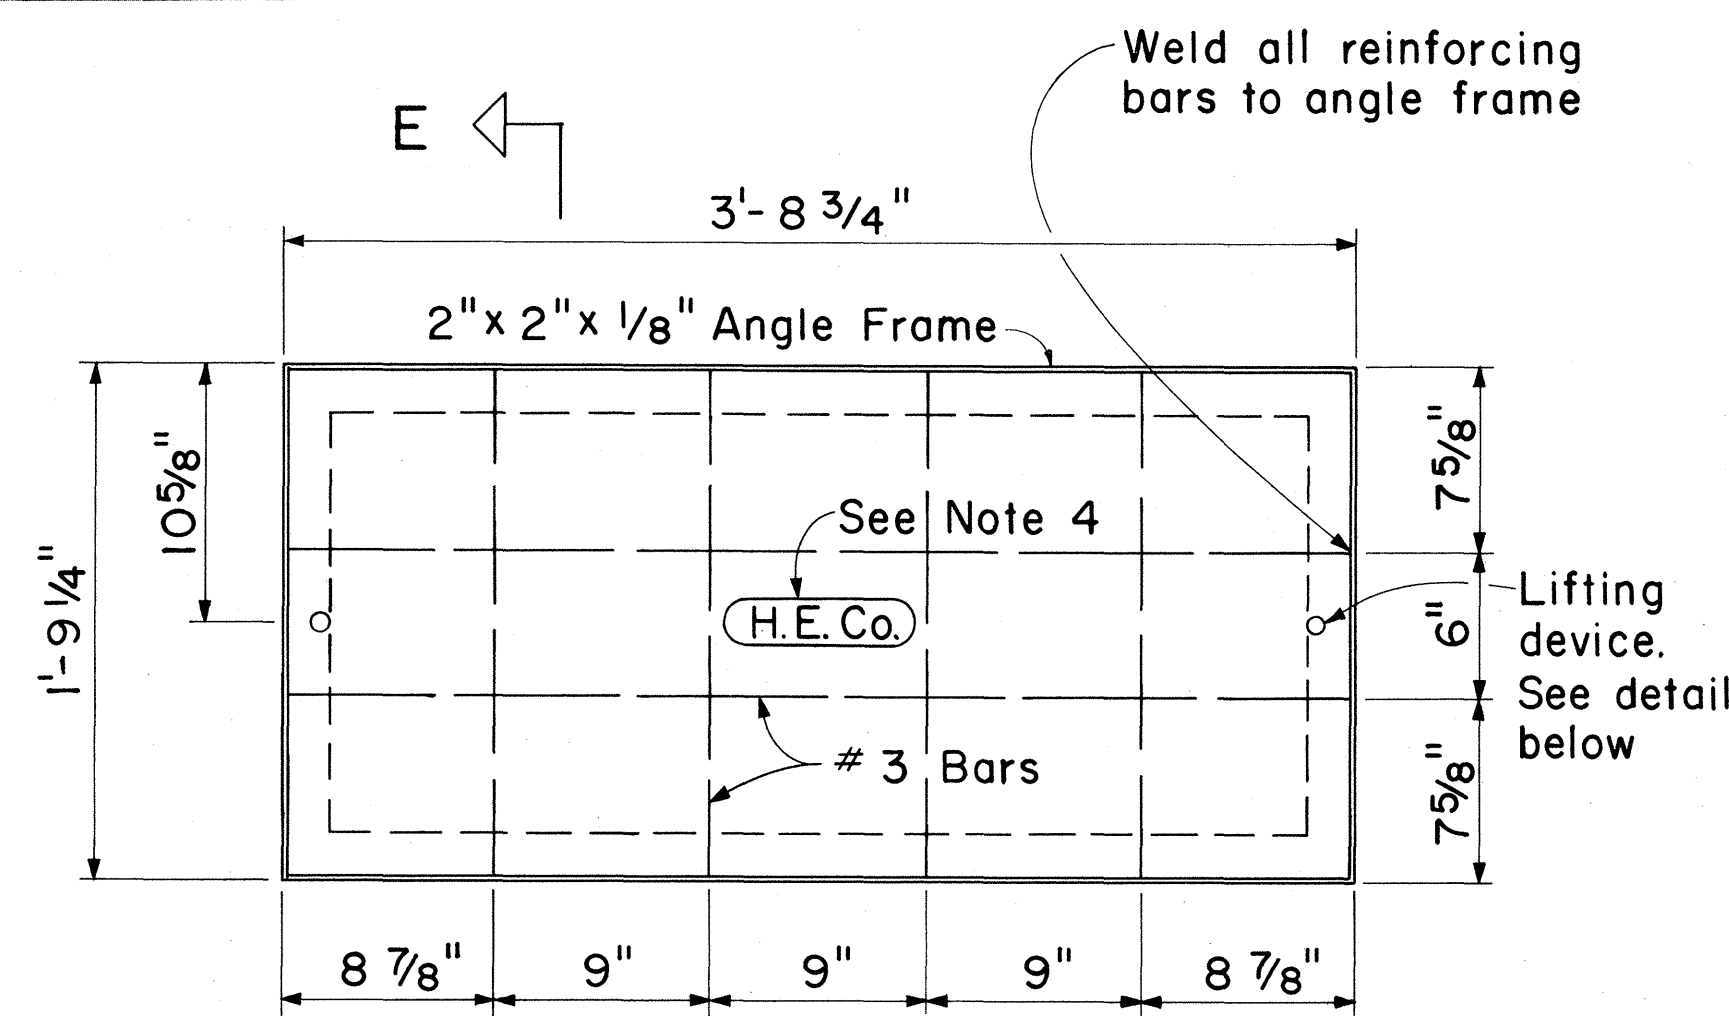

PLAN
Scale: 1 1/2" = 1'-0"

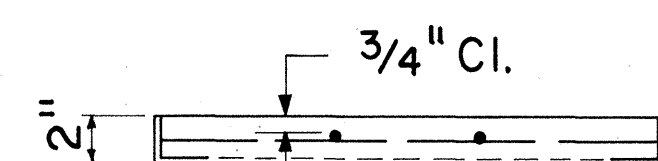


SECTION E-E
Scale: 1 1/2" = 1'-0"

Before installing nylon plug, H.E. Code 11554, apply corrosion resistant grease to the inserts on cover.

3/4" ϕ x 1 7/8" cadmium plated thin slab insert.

3/4" ϕ x 0'-1" threaded (10 thds. per in.) nylon plug furnished by H.E. Co. to Contractor. Fabricator shall adequately seal opening of insert to prevent water from entering during storage.

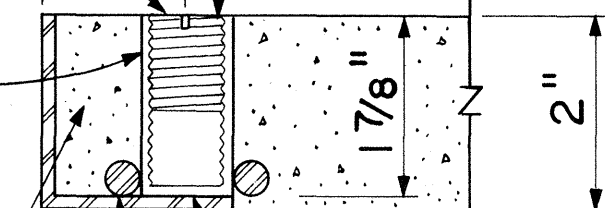

Concrete Fill

Clean surface and apply bonding adhesive between angle and insert after galvanizing of frame.

2" x 2" x 1/8" Angle Frame

1/4" ϕ x 0'-8 1/2" Bar (Part of insert)


LIFTING DEVICE DETAIL
Scale: 1/2" Actual Size

CONCRETE COVER FOR 1'-6" x 3'-5 1/2" SERVICE BOX


NOTES:

- Galvanize Angle Frame per ASTM 153 (as amended to date) after fabrication.
- Concrete compressive strength = 3,000 psi in 28 days.
- Finished surface shall be broomed or roughened per City & County or State Standards for sidewalks.
- Company identification marking stamped on Cover.
- "Contractor Furnished" item.


H.E. Co. DWG. NO.
011312

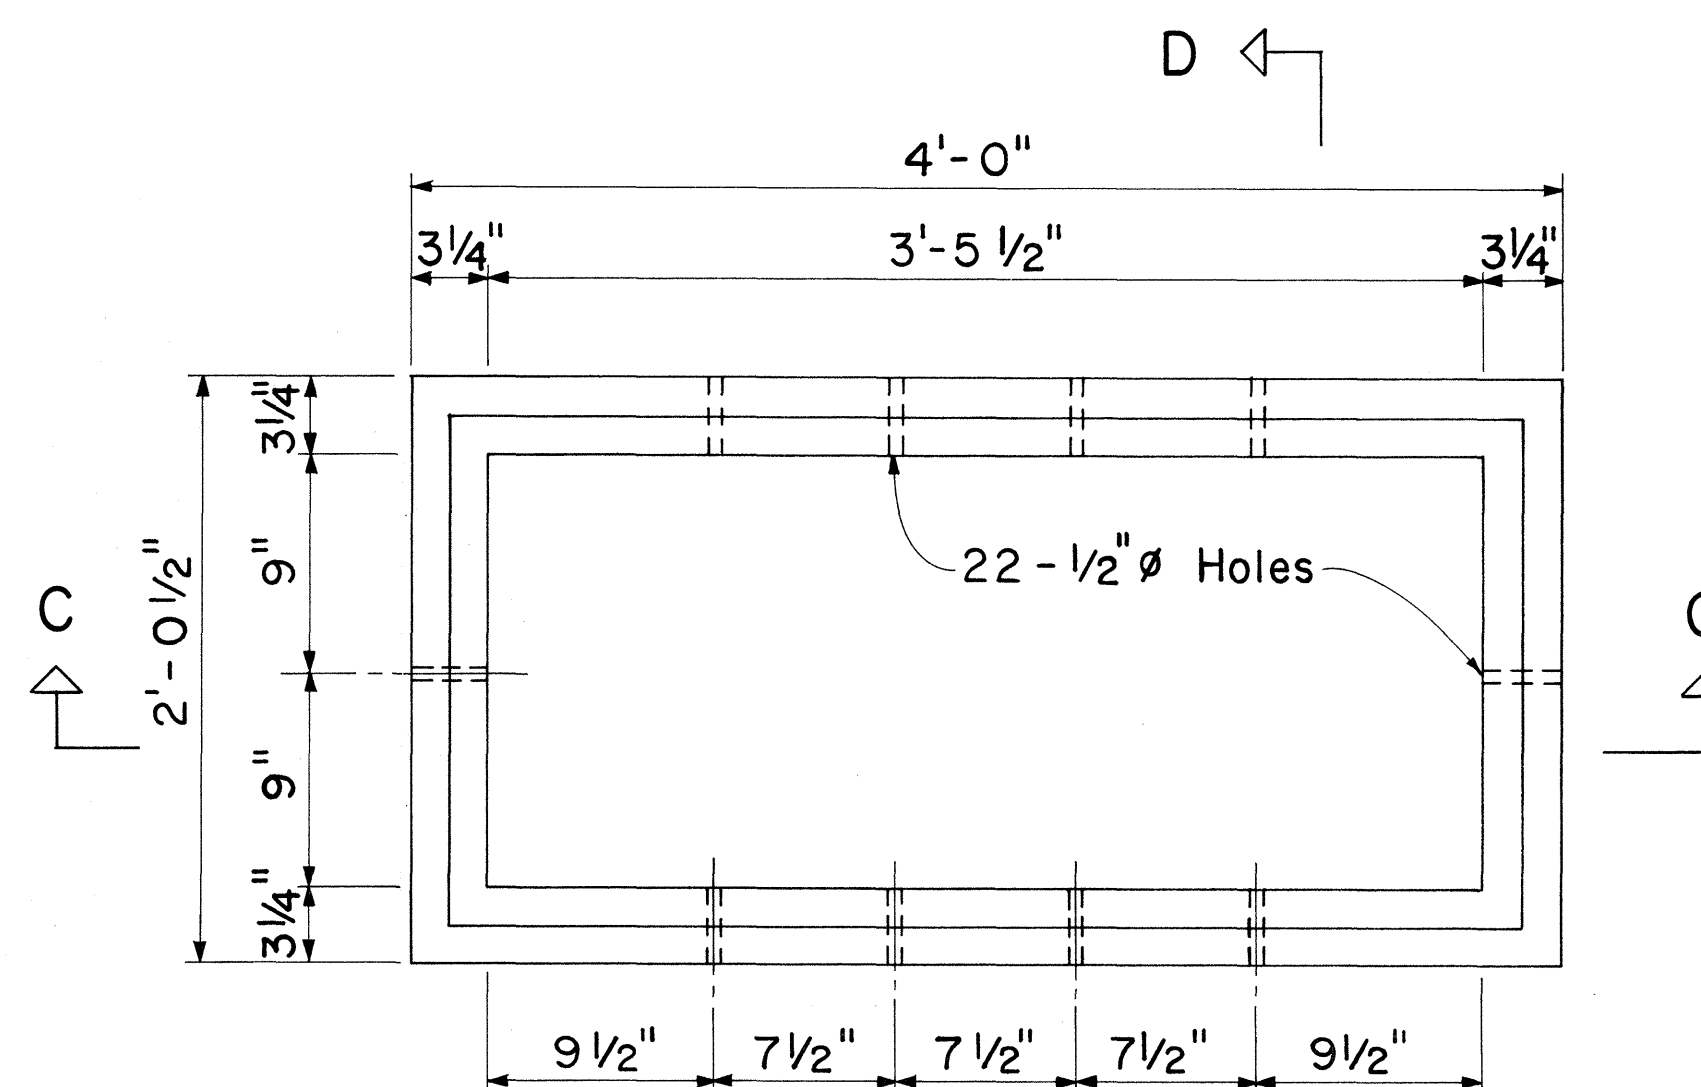

PLAN D

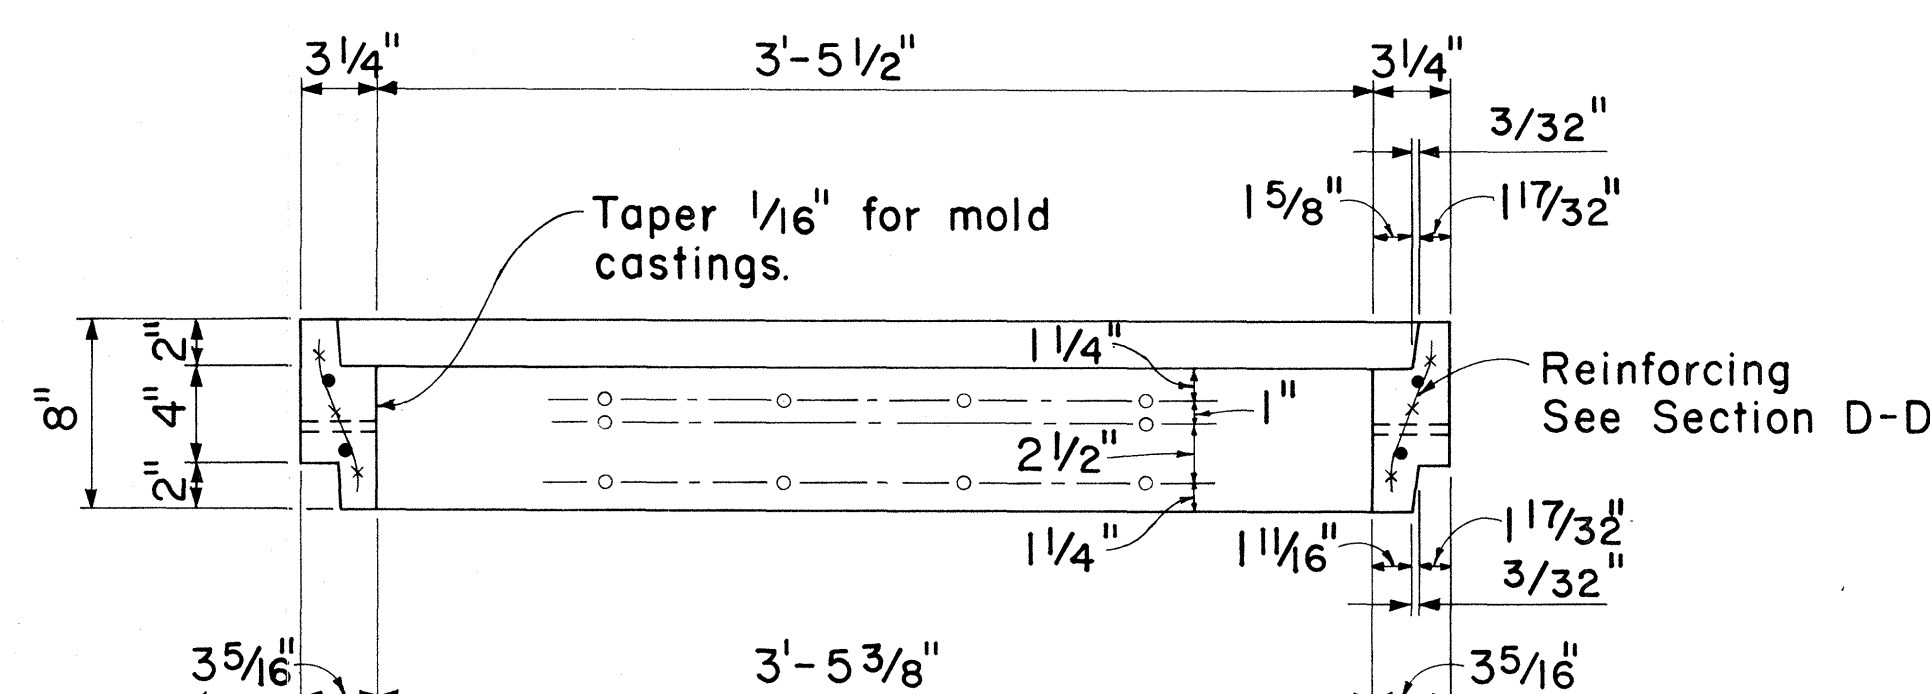

SECTION C-C

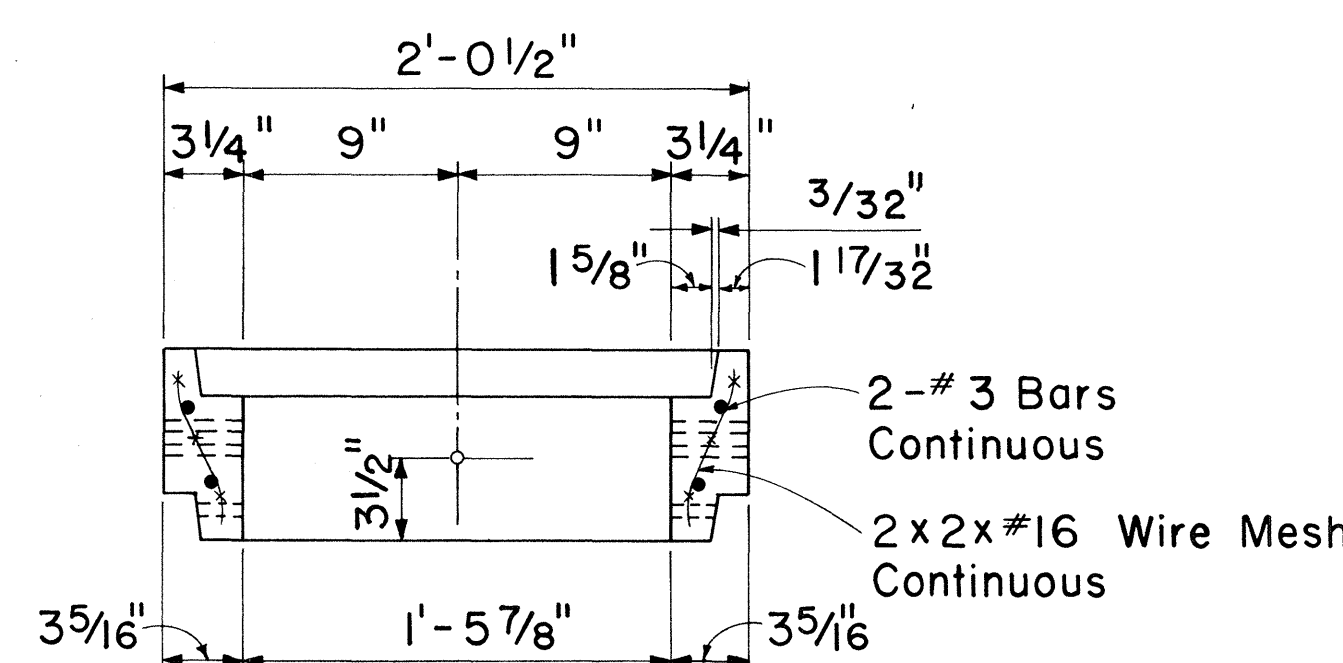

SECTION D-D


CONCRETE SERVICE BOX EXTENSION 1'-6" x 3'-5 1/2" x 0'-8" DEPTH

Scale: 1 1/2" = 1'-0"


NOTES:

- Concrete compressive strength = 3,000 psi in 28 days.
- Weight per section = 200 lbs. $\pm$.
- See Drawing 011312 for Concrete Cover.
- "Contractor Furnished" item.


H.E. Co. DWG. NO.
011311

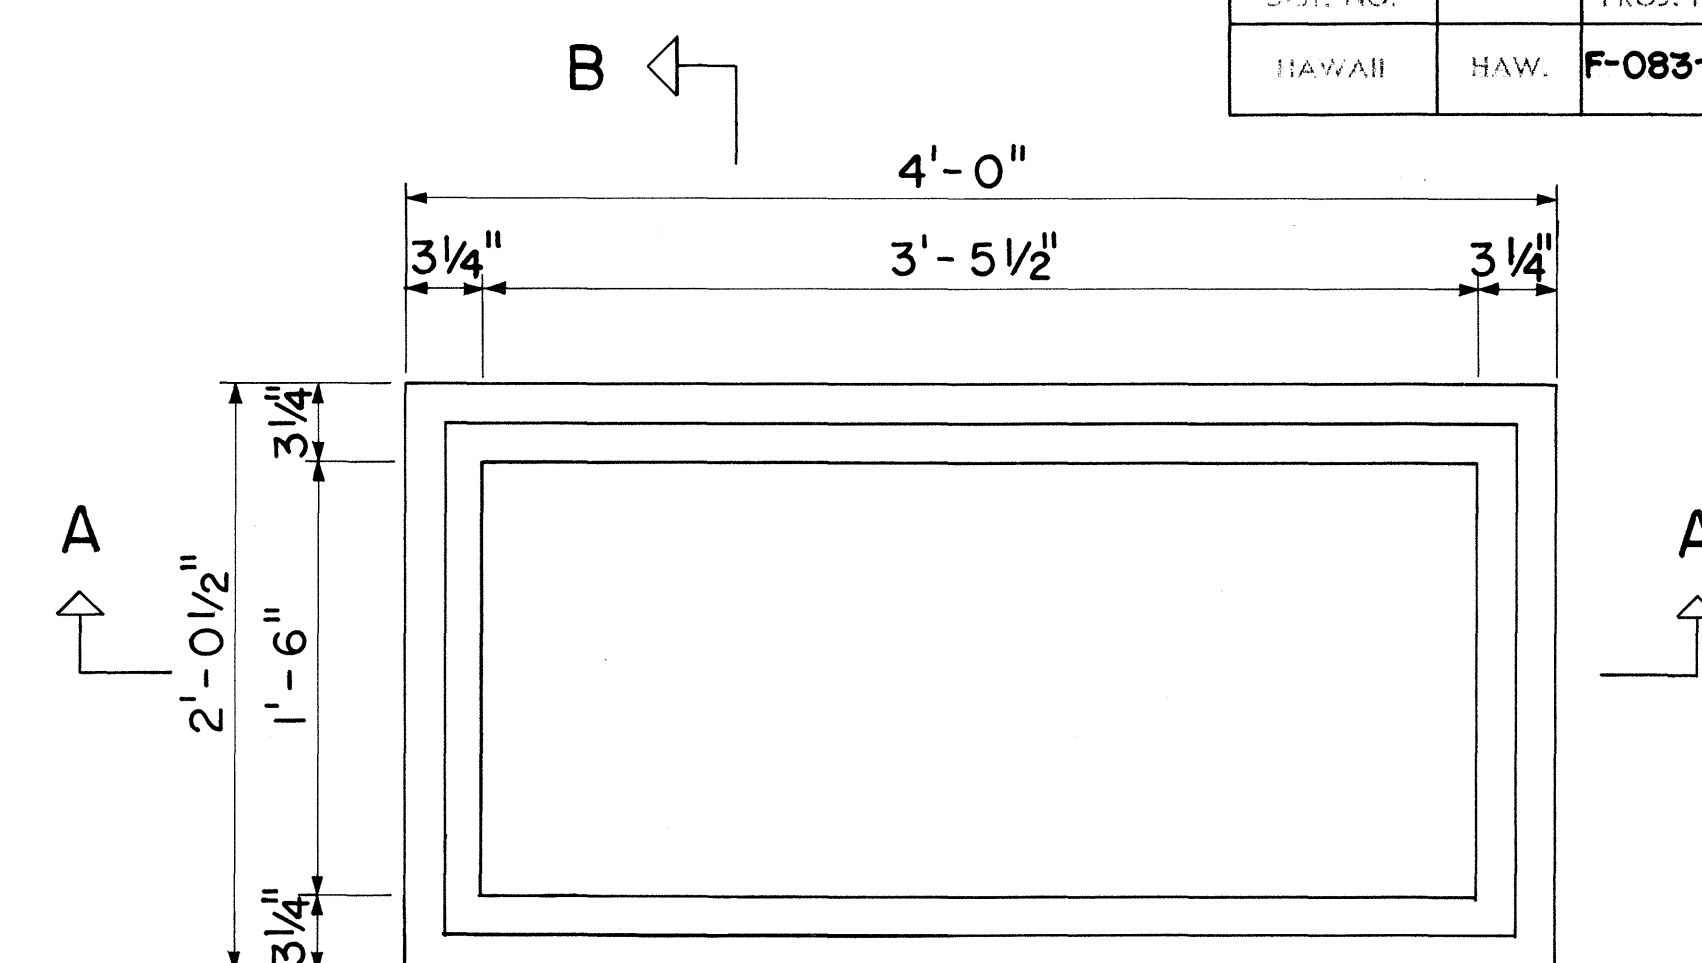

PLAN

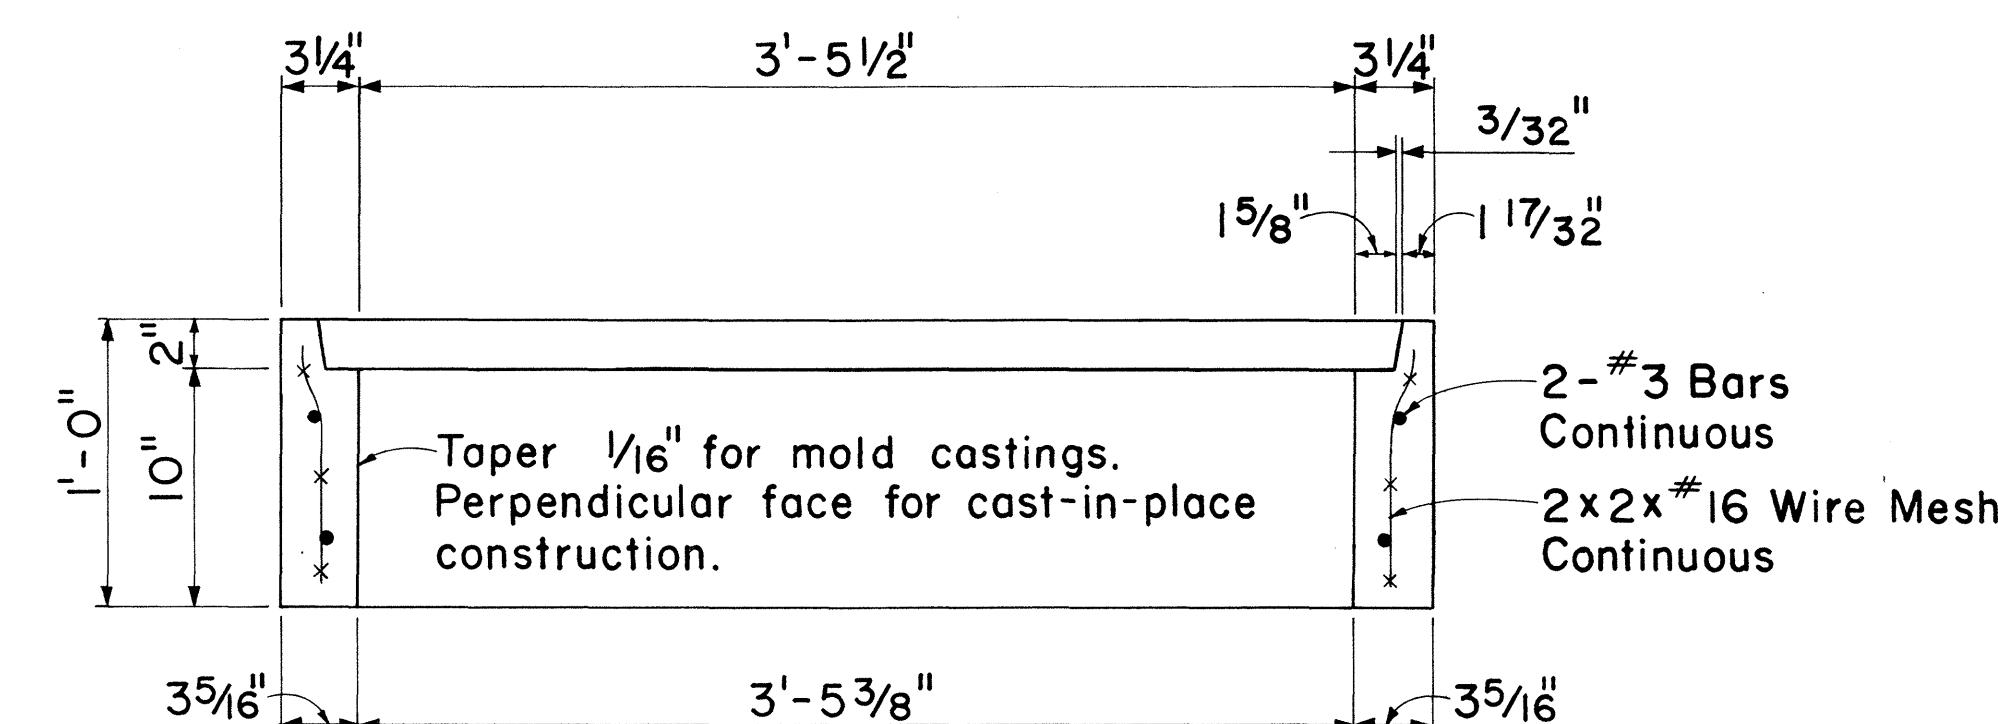

SECTION A-A

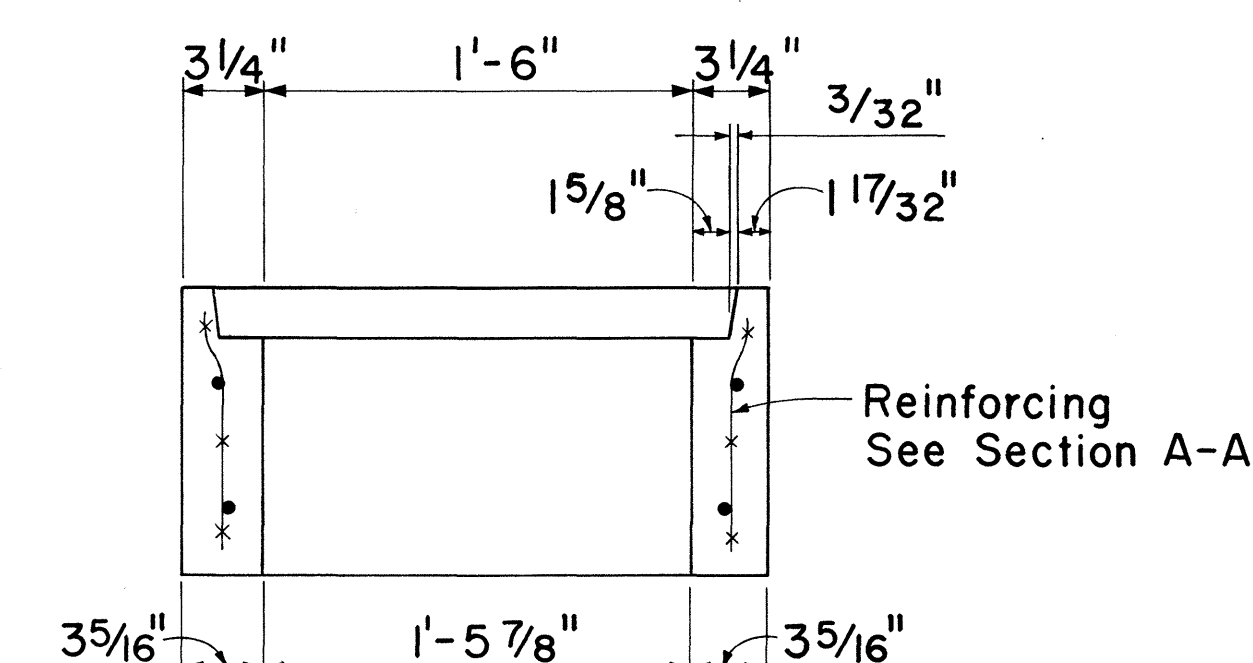

SECTION B-B

CONCRETE SERVICE BOX BODY 1'-6" x 3'-5 1/2" x 1'-0" DEPTH

Scale: 1 1/2" = 1'-0"

NOTES:

- Concrete compressive strength = 3,000 psi in 28 days.
- Weight of box = 412 lbs. $\pm$.
- See Drawing 011312 for Concrete Cover.
- "Contractor Furnished" item.

H.E. Co. DWG. NO.
011310

APPROVED:

9-14-78
HAWAIIAN ELECTRIC Co., Inc. DATE

STATE OF HAWAII
DEPARTMENT OF TRANSPORTATION
LAND TRANSPORTATION FACILITIES DIVISION

STANDARD DETAILS
CONCRETE SERVICE BOX
BODY, EXTENSION AND COVER

Scale: As Noted Date: AUG 1978
SHEET No. 33 OF 38 SHEETS

FED. ROAD DIST. NO.	STATE	FED. AID PROJ. NO.	FISCAL YEAR	SHEET NO.	TOTAL SHEETS
HAWAII	HAW.	F-083-1(10)	1978	82	160


NOTES:

- SEE DWG. 16688 (2 SHEETS) FOR MANHOLE MISCELLANEOUS DETAILS AND GENERAL NOTES.
- SEE PROJECT DWGS. FOR LOCATION OF MANHOLE CONCERNED.
- FOR DUCT ENTRANCES AND LOCATION OF PULLING IRONS. SEE MANHOLE DEVELOPMENTS OF PROJECT CONCERNED.
- PULLING IRONS FOR 8" WALL: TYPE I PREFERRED. TYPE II OPTIONAL. SEE DWG. 16688, SHEET 1 OF 2 FOR DETAILS.


NOTE: IF NON-STD. 28" DIA. M.H. FRAME AND COVER ARE USED. SEE DWG. 16688 FOR NECK DETAIL.

NOTE: USE ALTERNATE M.H. NECK ONLY WHEN DIMENSION "X" IS GREATER THAN 1'-6". SEE DETAIL DWG. 16688


STD. HECO 31" DIA. M.H. FRAME AND COVER FURNISHED AND INSTALLED BY CONTRACTOR. WHEN M.H. FRAME AND COVER ARE SUBJECTED TO HEAVY TRAFFIC. USE ANCHOR BOLTS PER M.H. NECK DETAIL ON DWG. 16688.

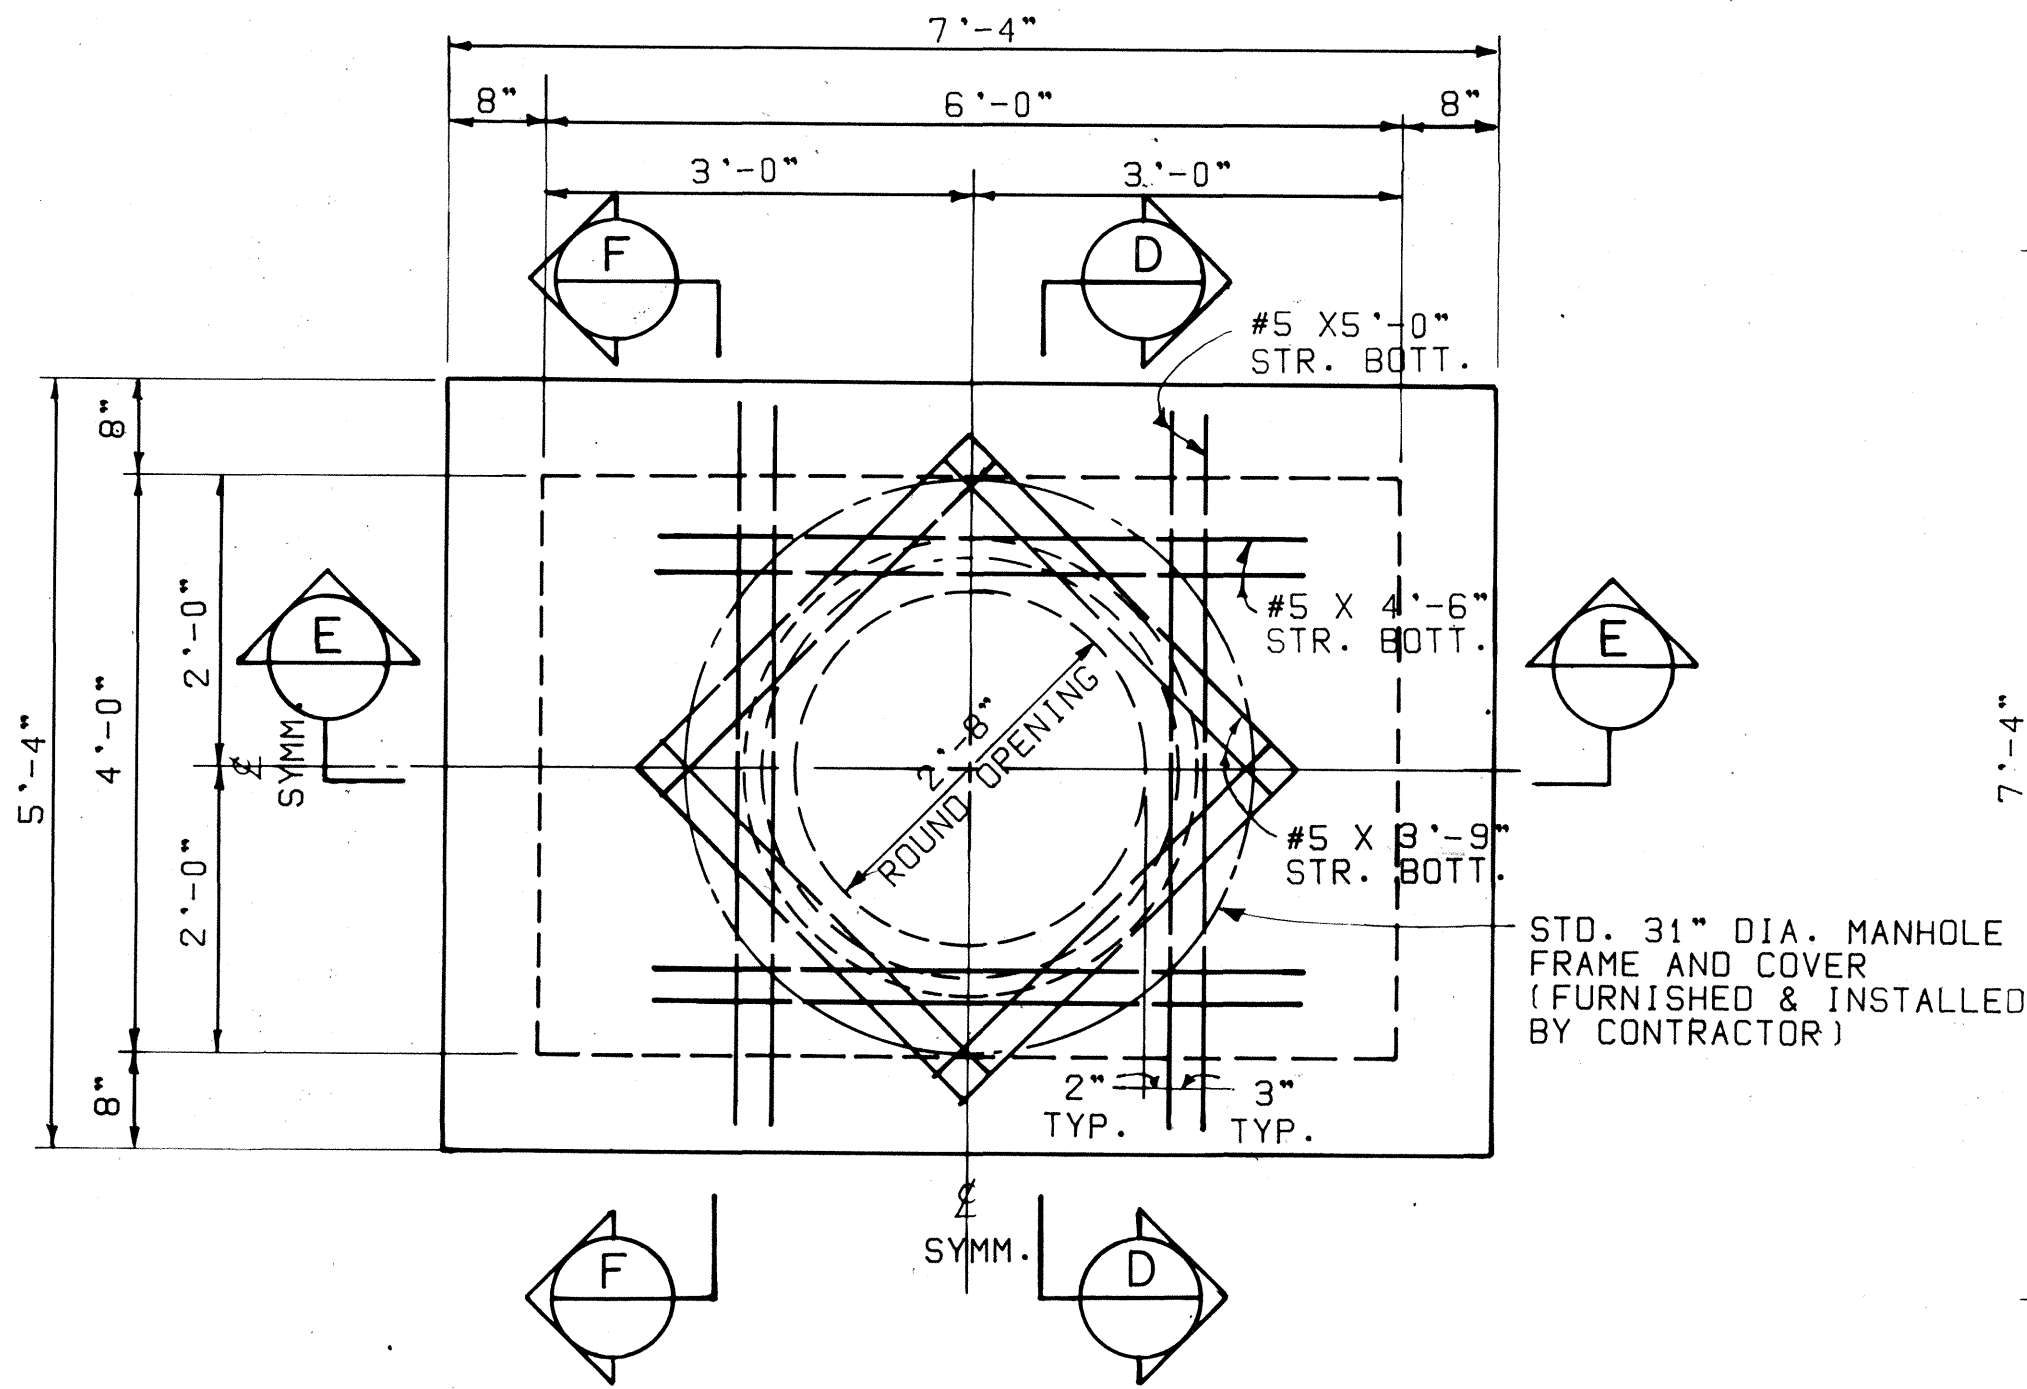


TOP PLAN
3/4" = 1'-0"

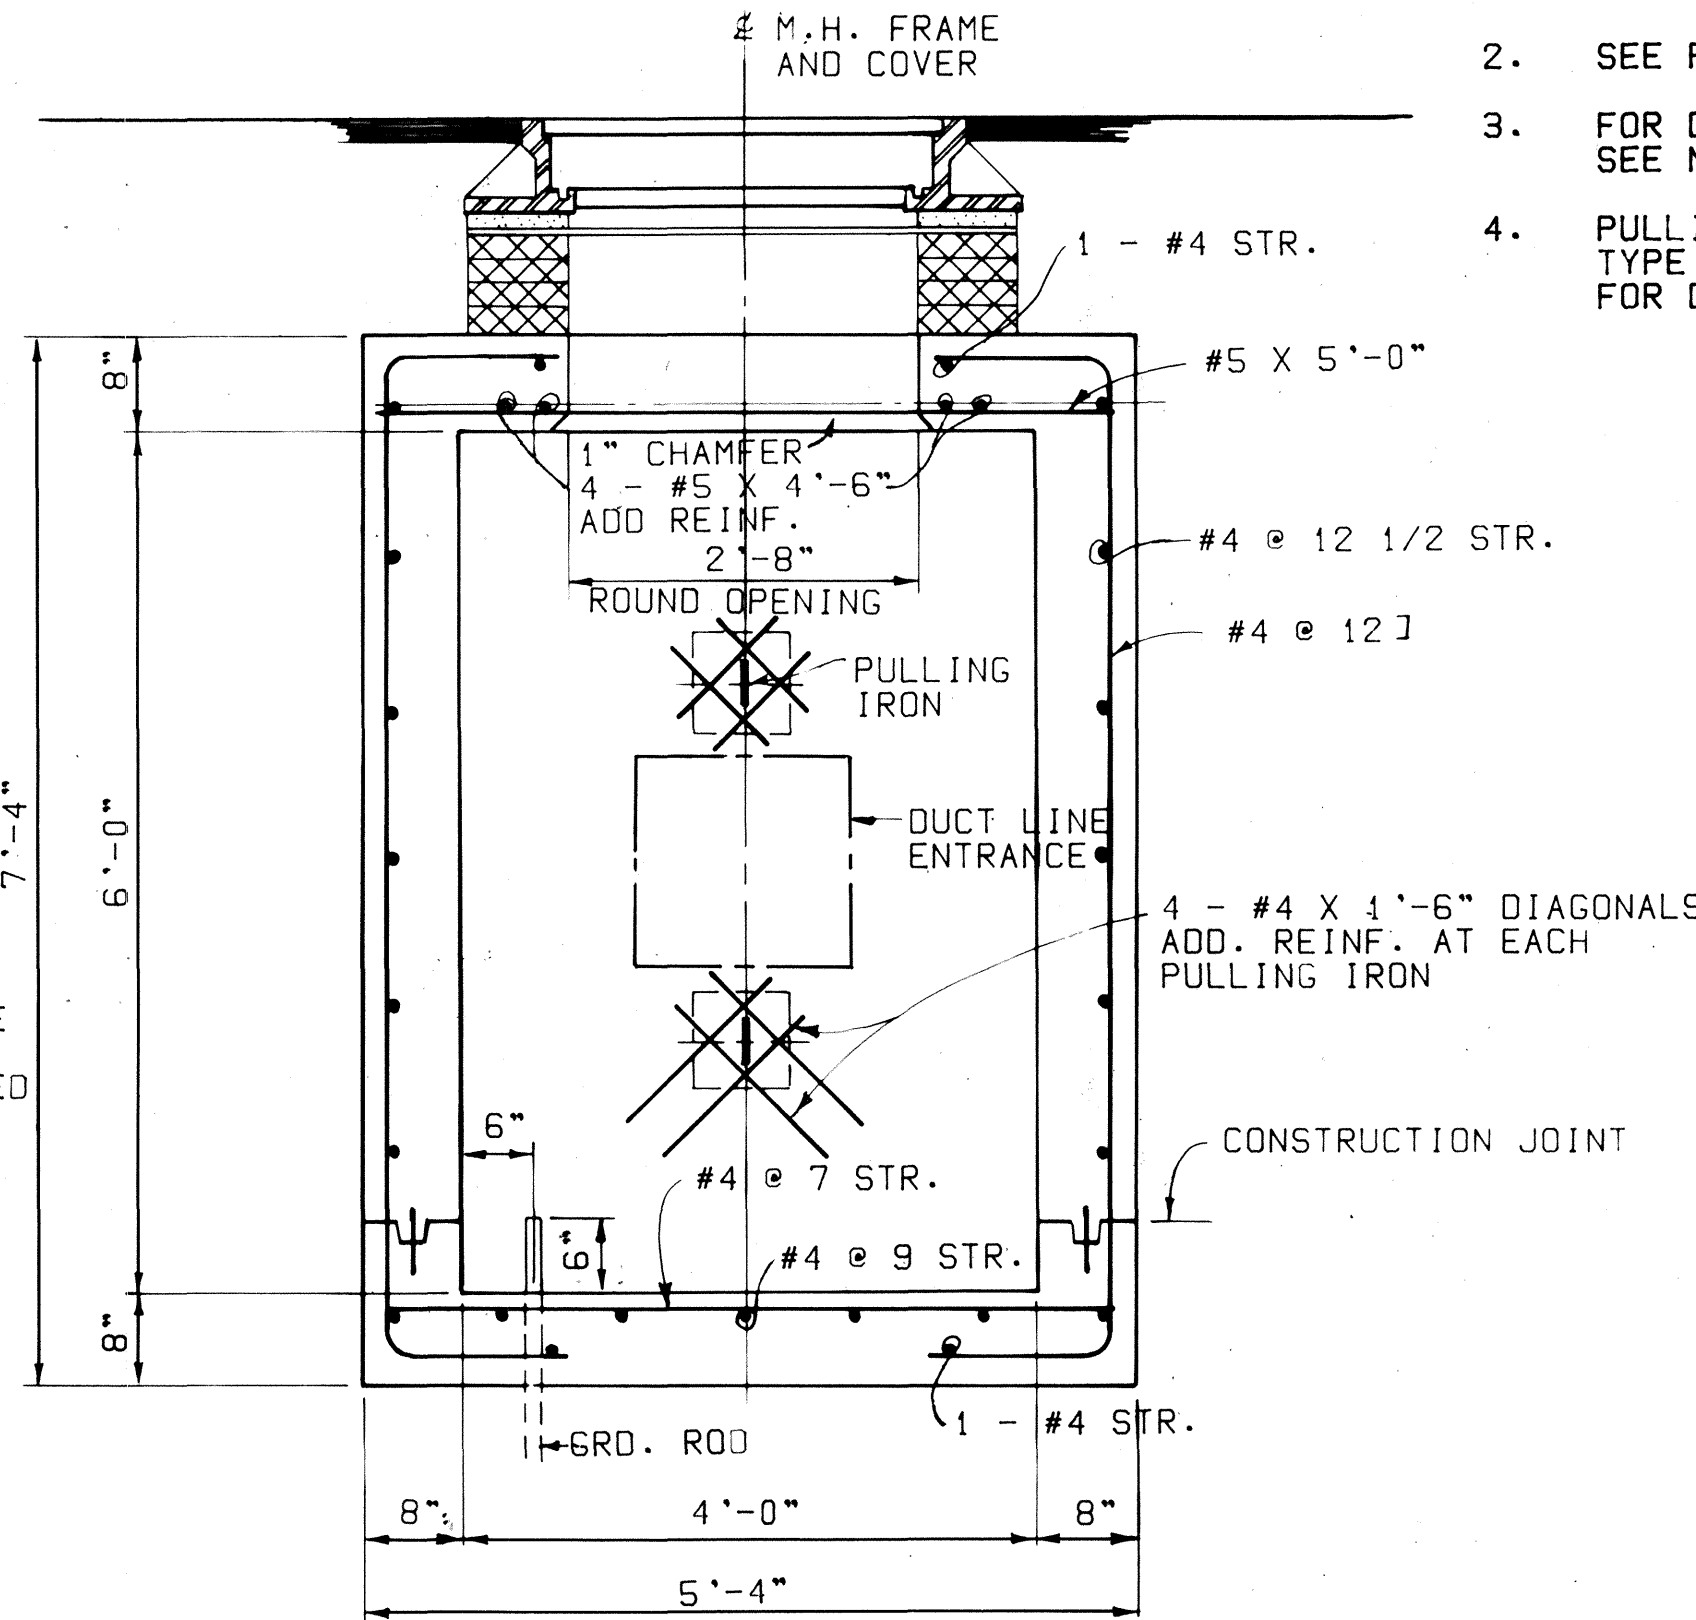


SECTION "D - D"
3/4" = 1'-0"

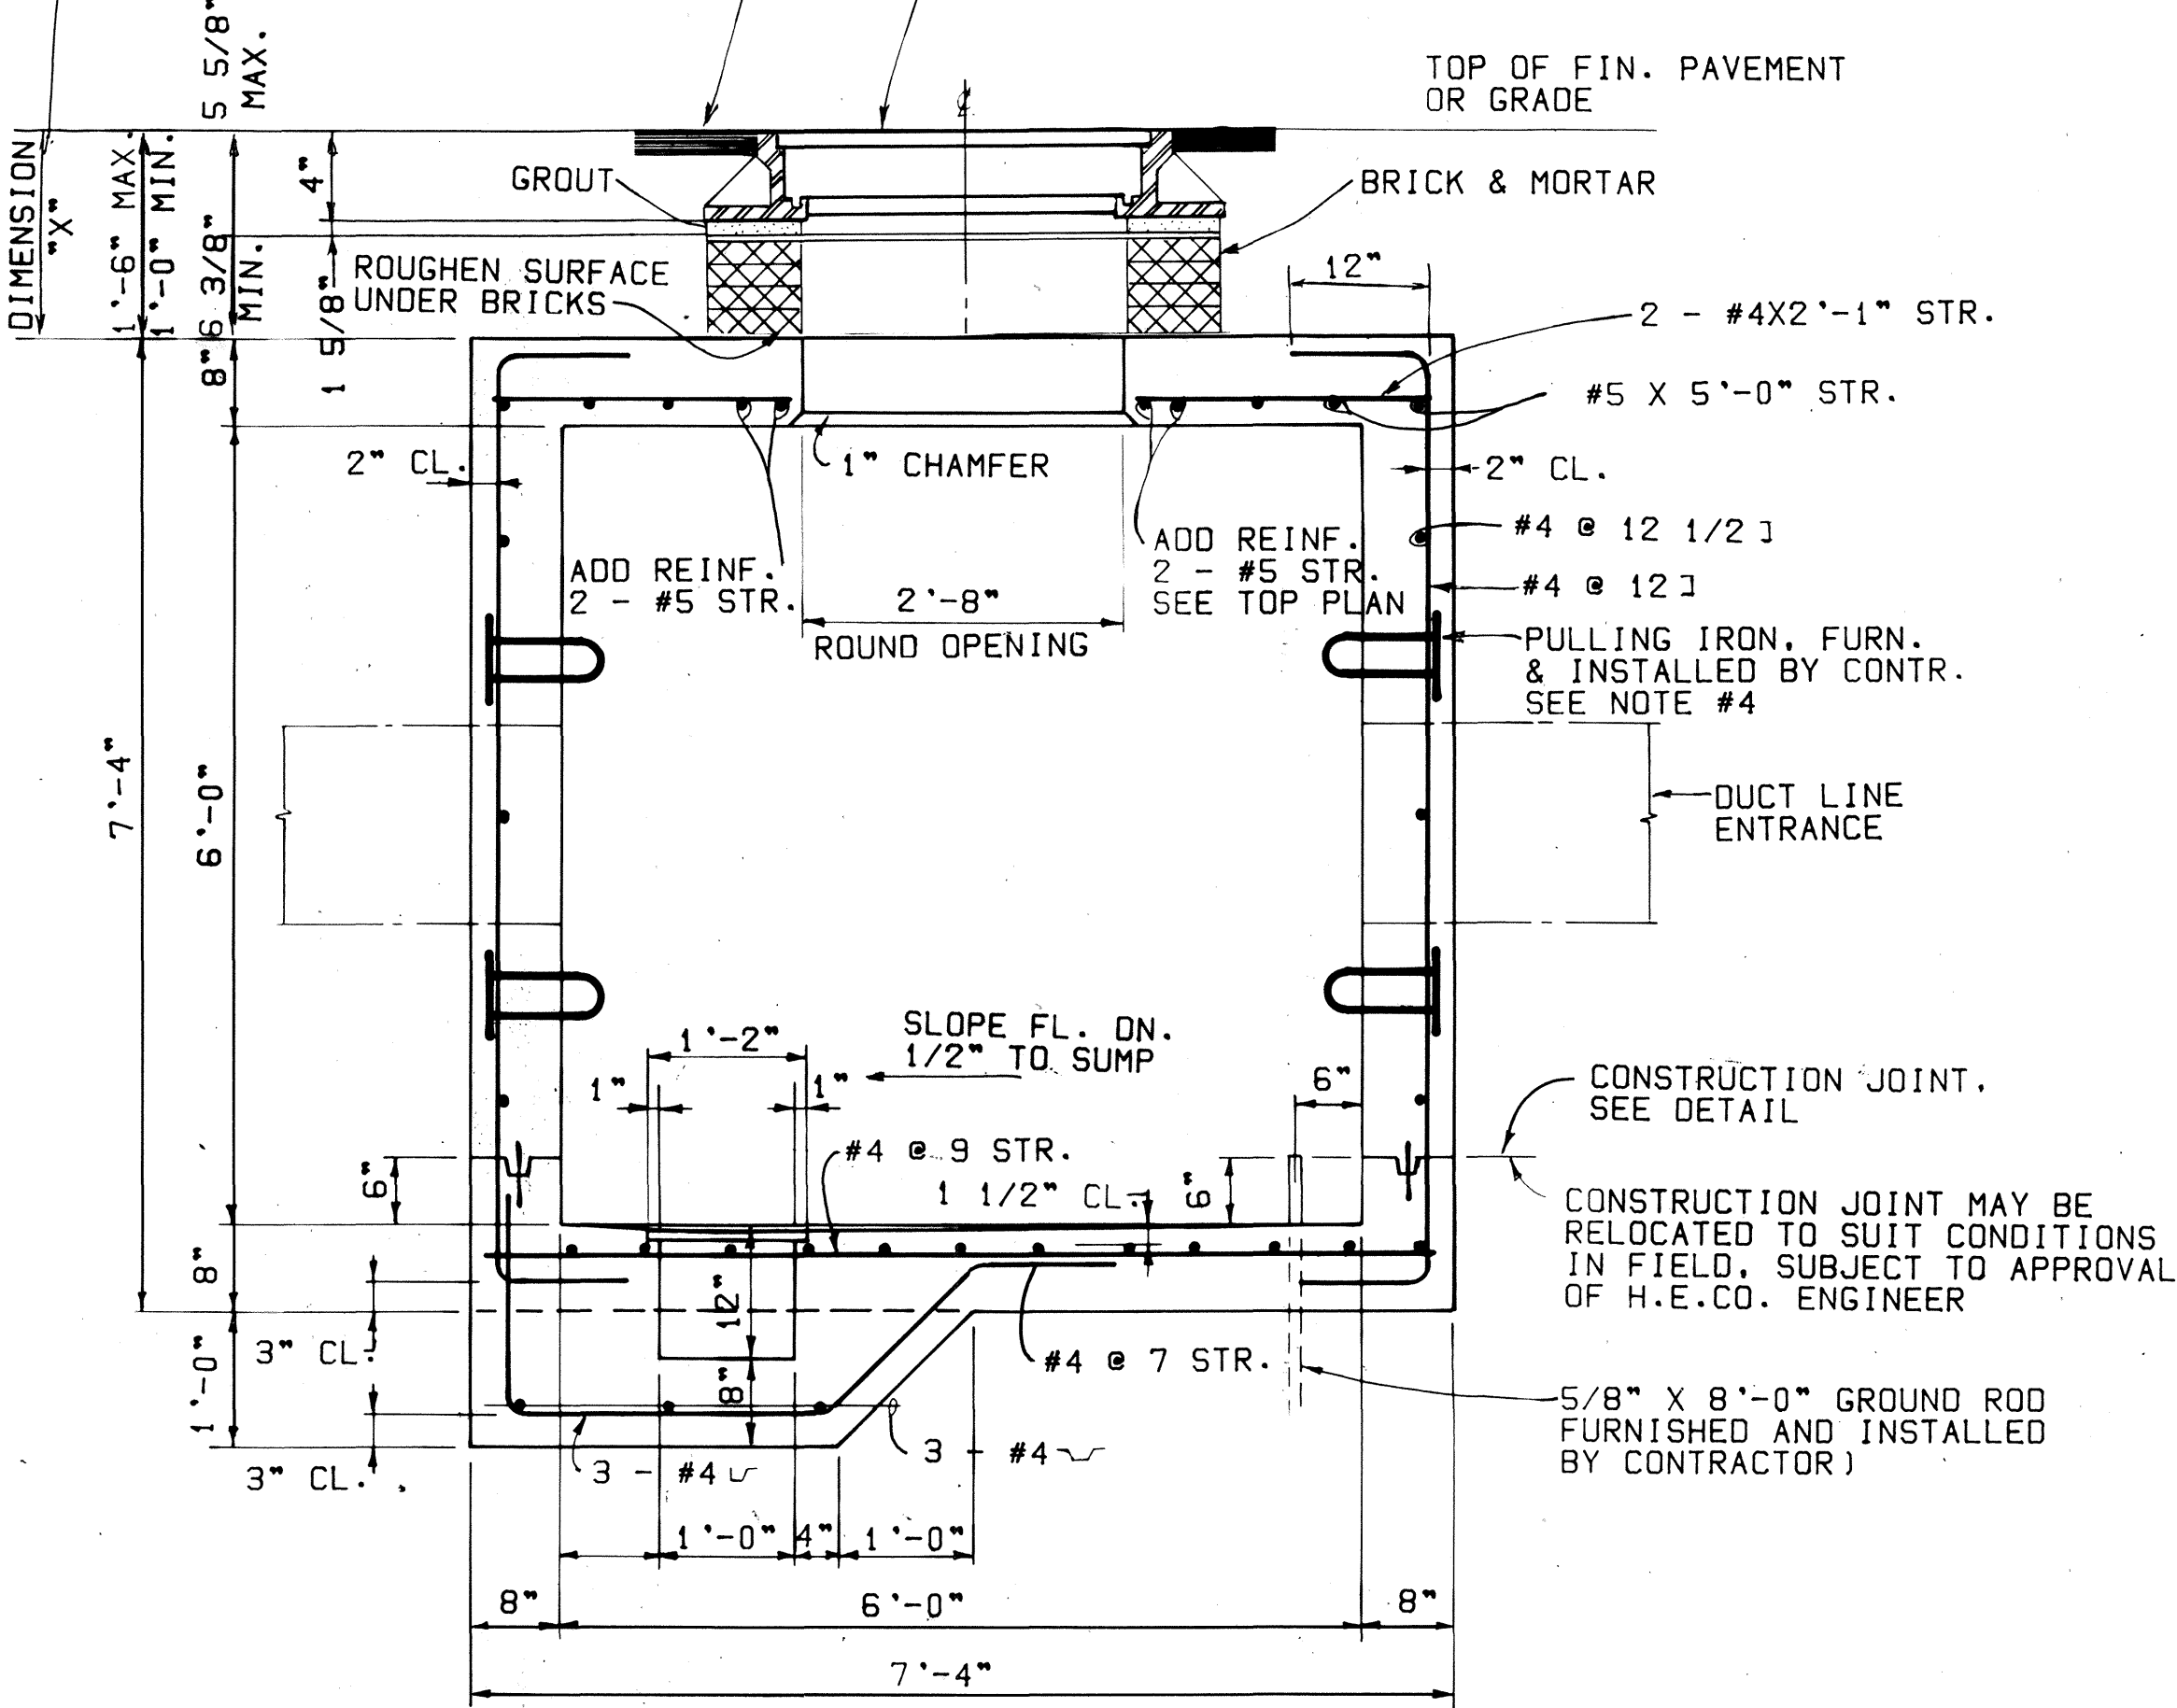

SECTION "E - E"
3/4" = 1'-0"

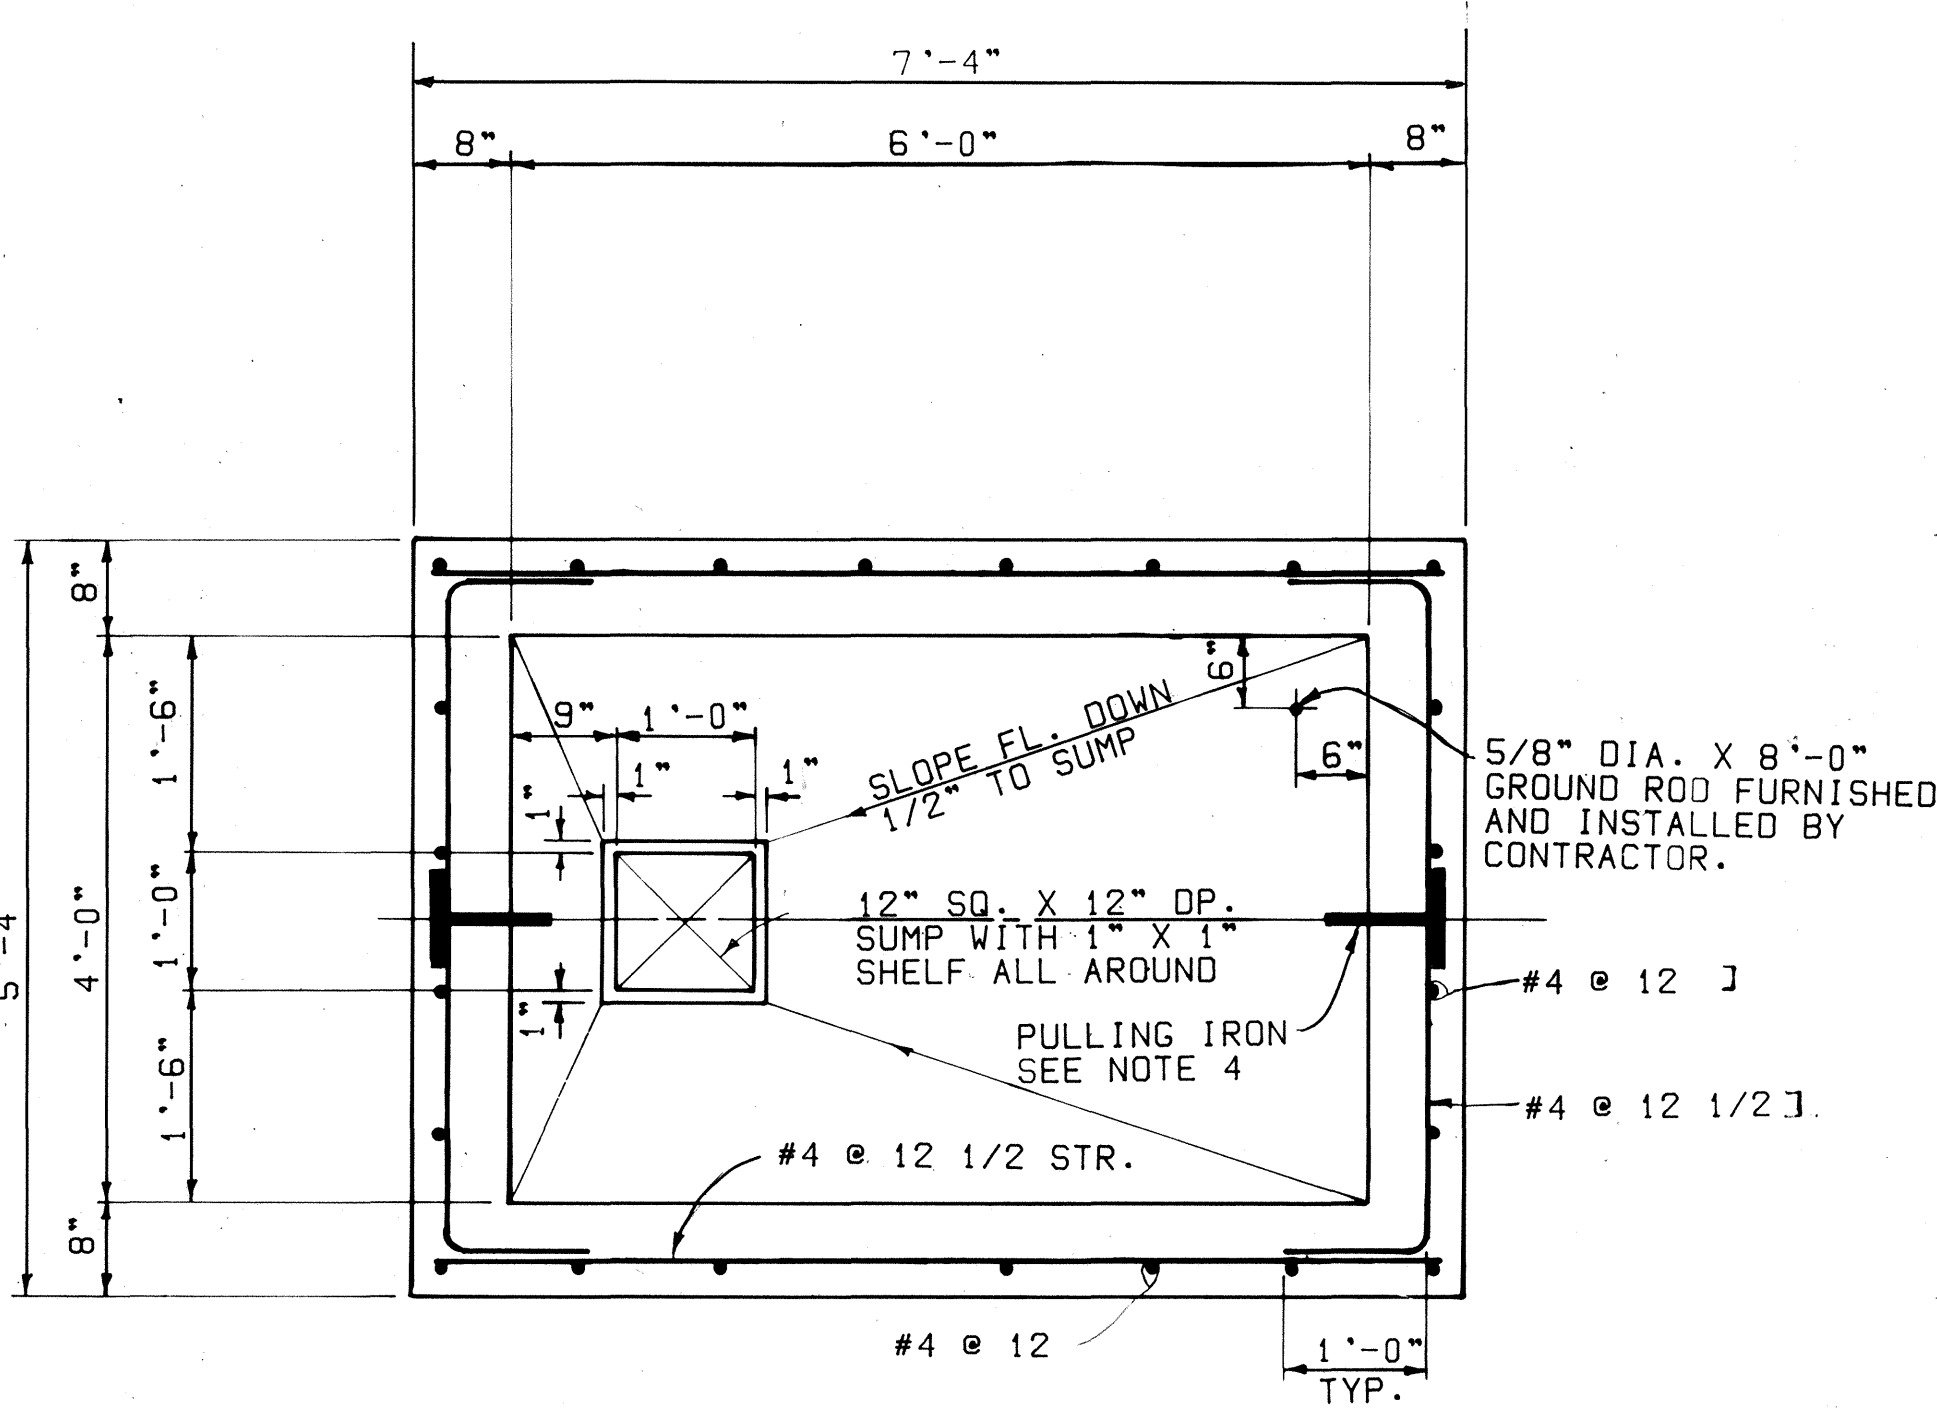

SECTIONAL PLAN
3/4" = 1'-0"

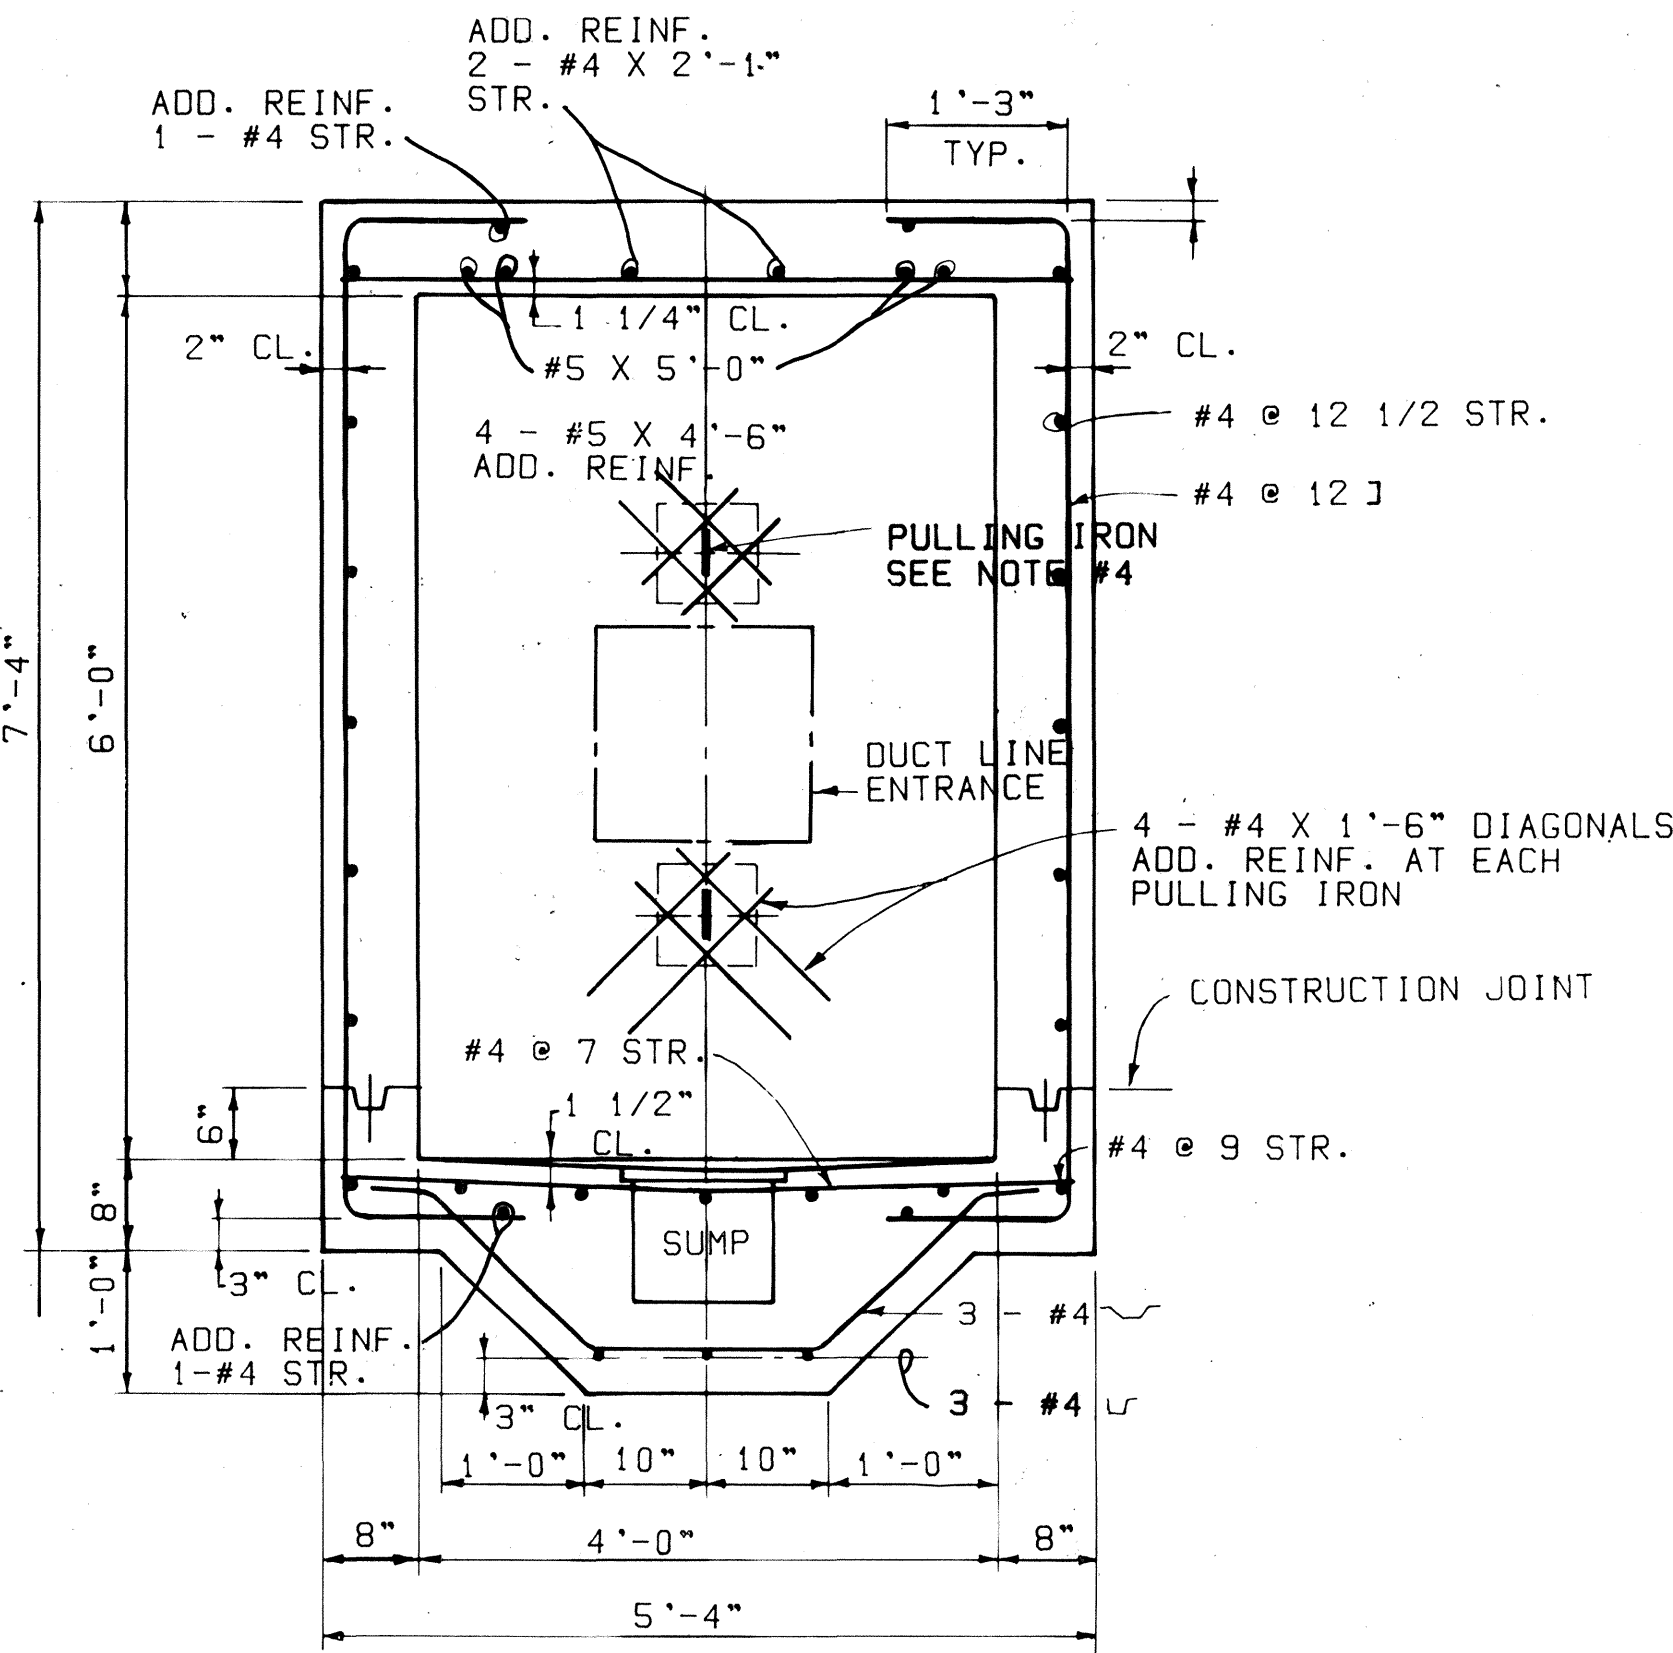

SECTION "F - F"
3/4" = 1'-0"

APPROVED

M. J. Wallace

HAWAIIAN ELECTRIC COMPANY


9-14-78
DATE

HECo., Inc.	Drawing No.
16687	SHEET NO. 1 OF 2 SHEETS
STATE OF HAWAII DEPARTMENT OF TRANSPORTATION LAND TRANSPORTATION FACILITIES DIVISION	
MANHOLE, TYPE 46M (4'-0" x 6'-0") UNDERGROUND STANDARDS	
Scales As Noted	AUG 1978
SHEET No. 34 OF 38 SHEETS	


FED. ROAD DIST. NO.	STATE	FED. AID PROJ. NO.	FISCAL YEAR	SHEET NO.	TOTAL SHEETS
HAWAII	HAW.	F-083-1(10)	1978	83	160

NOTES:


- SEE DWG. 16688 (2 SHEETS) FOR MANHOLE MISCELLANEOUS DETAILS AND GENERAL NOTES.
- SEE PROJECT DWGS. FOR LOCATION OF MANHOLE CONCERNED.
- FOR DUCT ENTRANCES AND LOCATION OF PULLING IRONS. SEE MANHOLE DEVELOPMENTS OF PROJECT CONCERNED.
- PULLING IRONS FOR 8" WALL: TYPE I PREFERRED. TYPE II OPTIONAL. SEE DWG. 16688, SHEET 1 OF 2 FOR DETAILS.

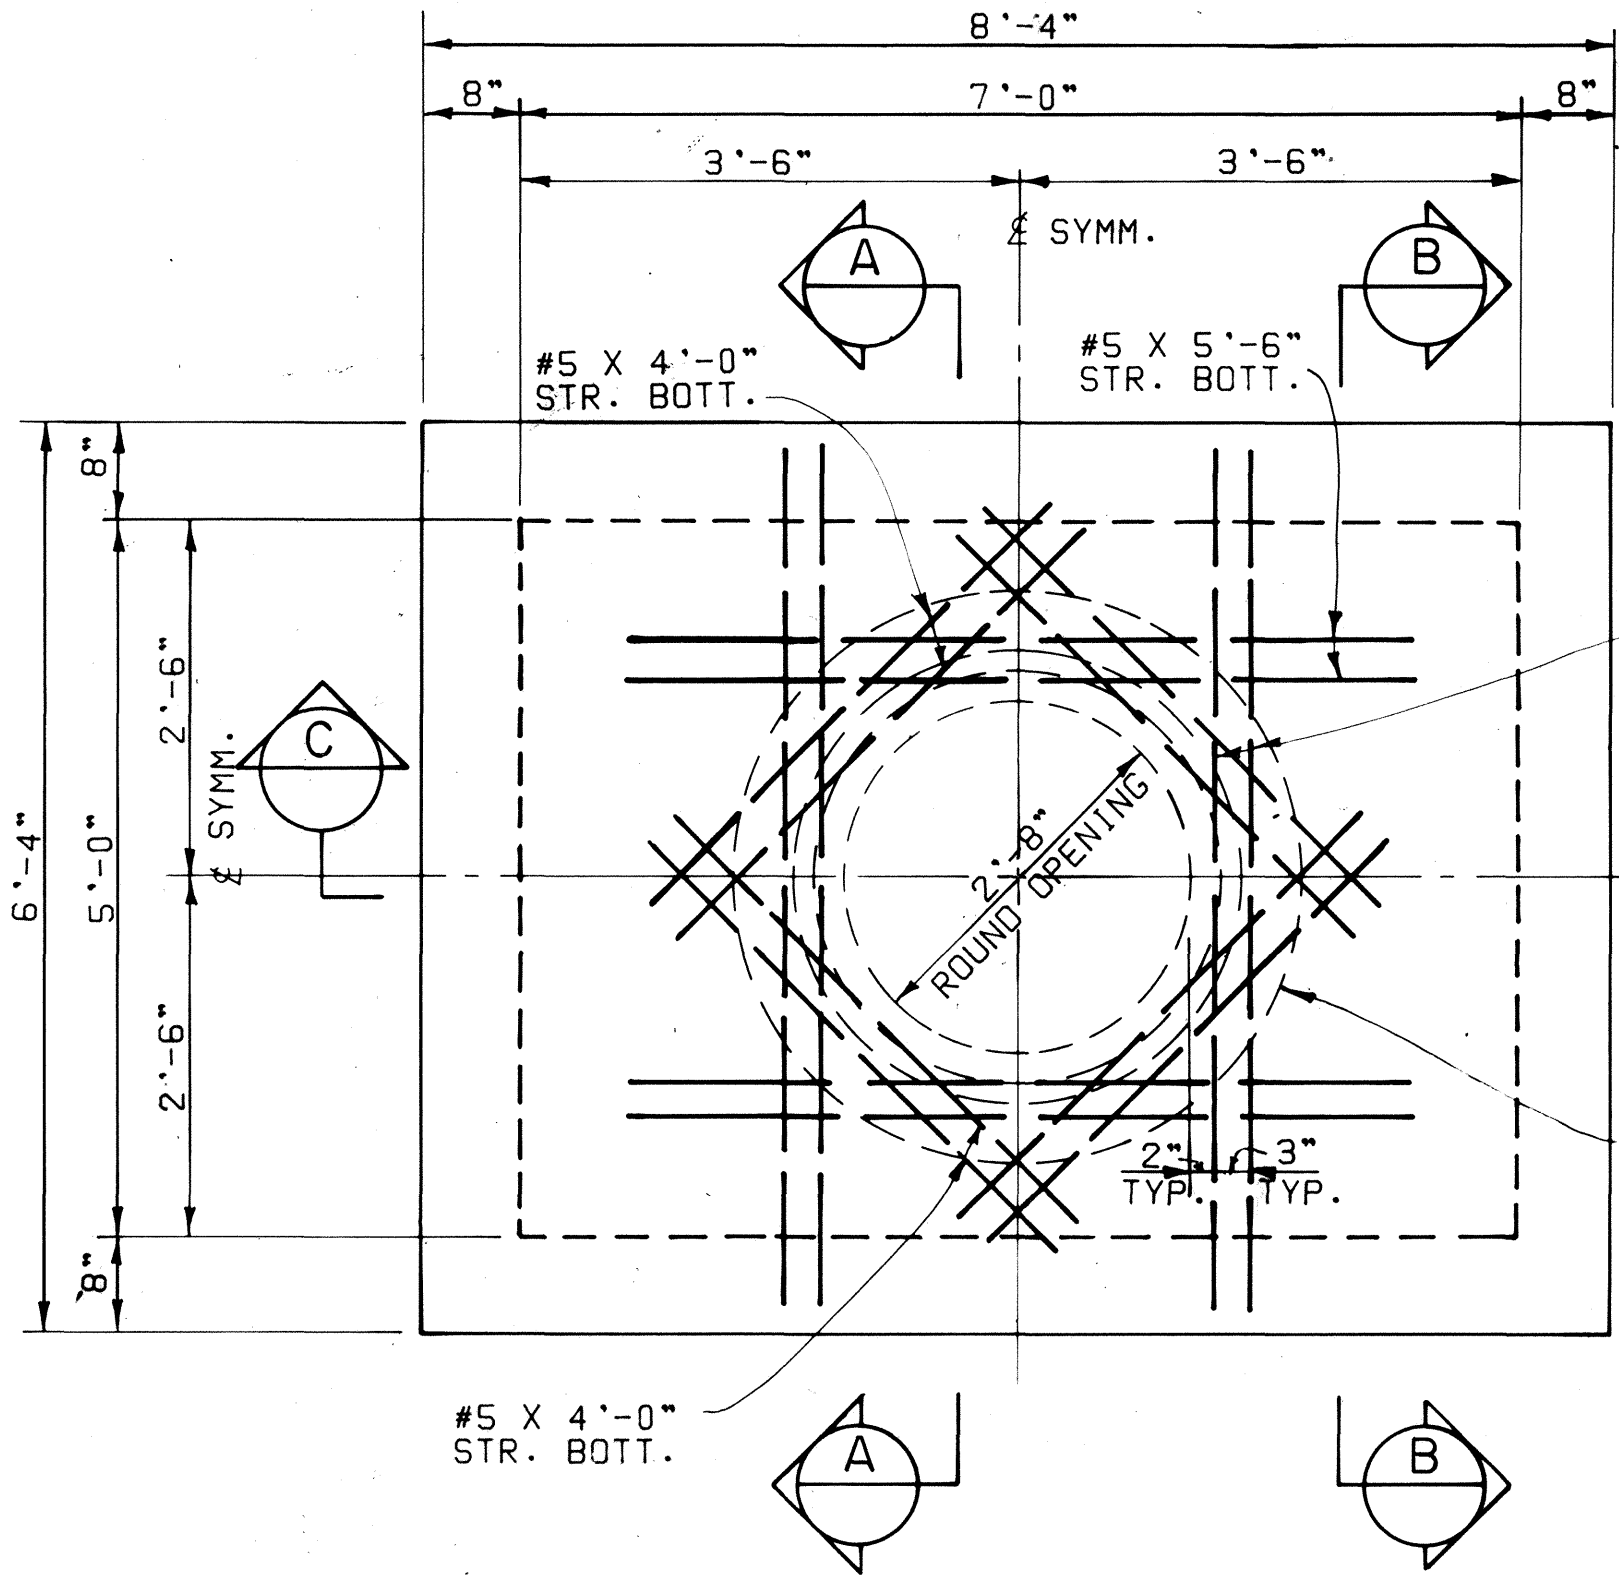


TOP PLAN
3/4" = 1'-0"

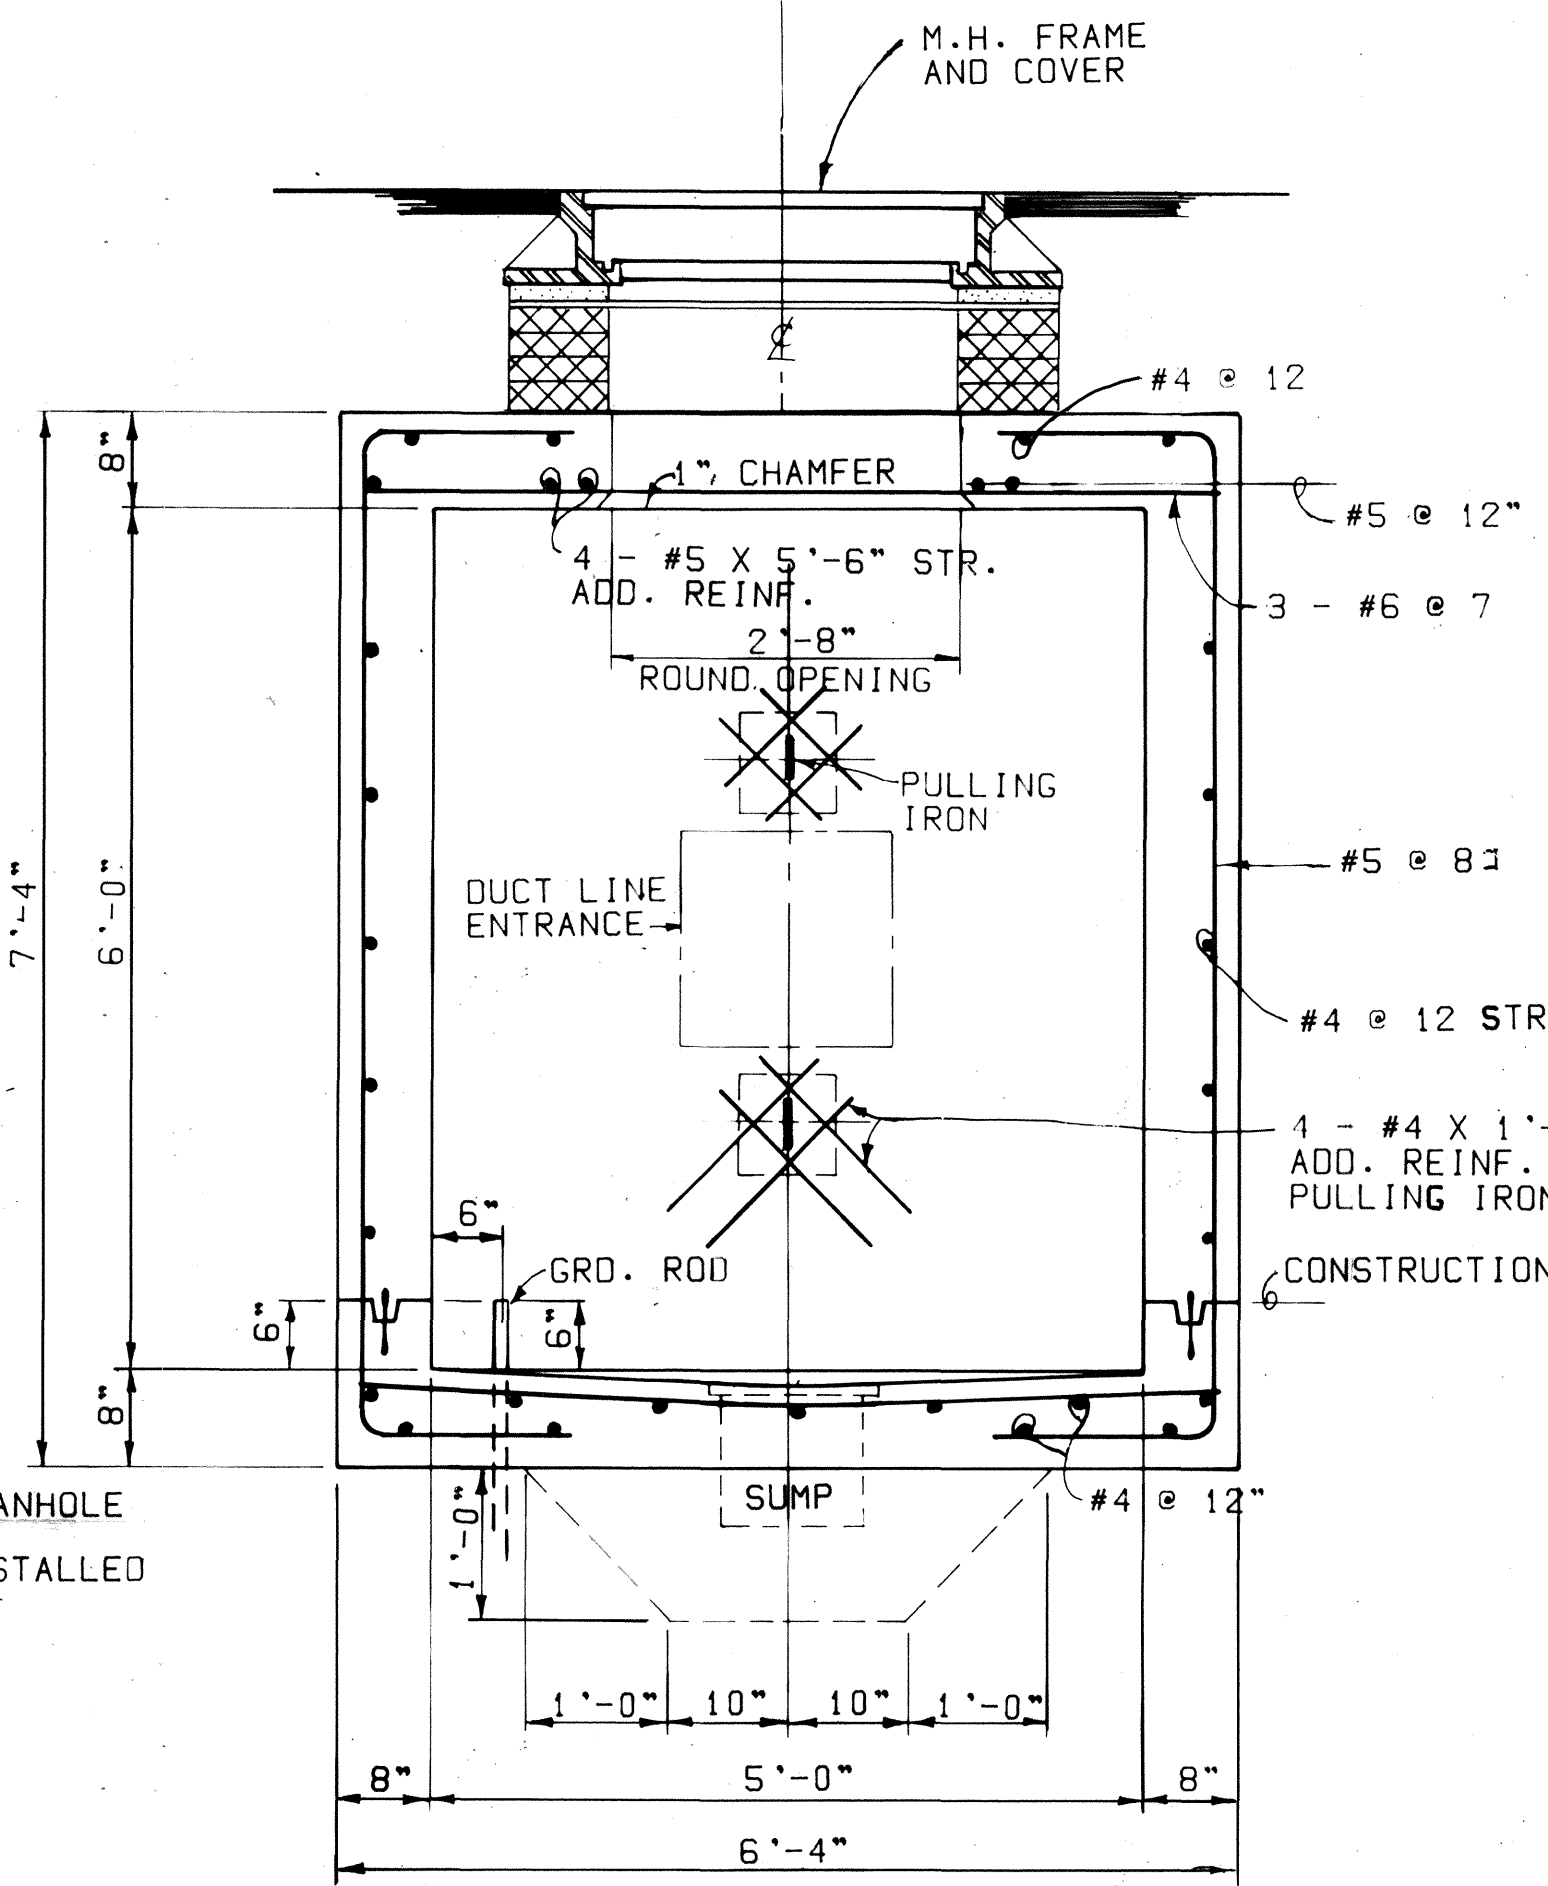


SECTION "A - A"
3/4" = 1'-0"

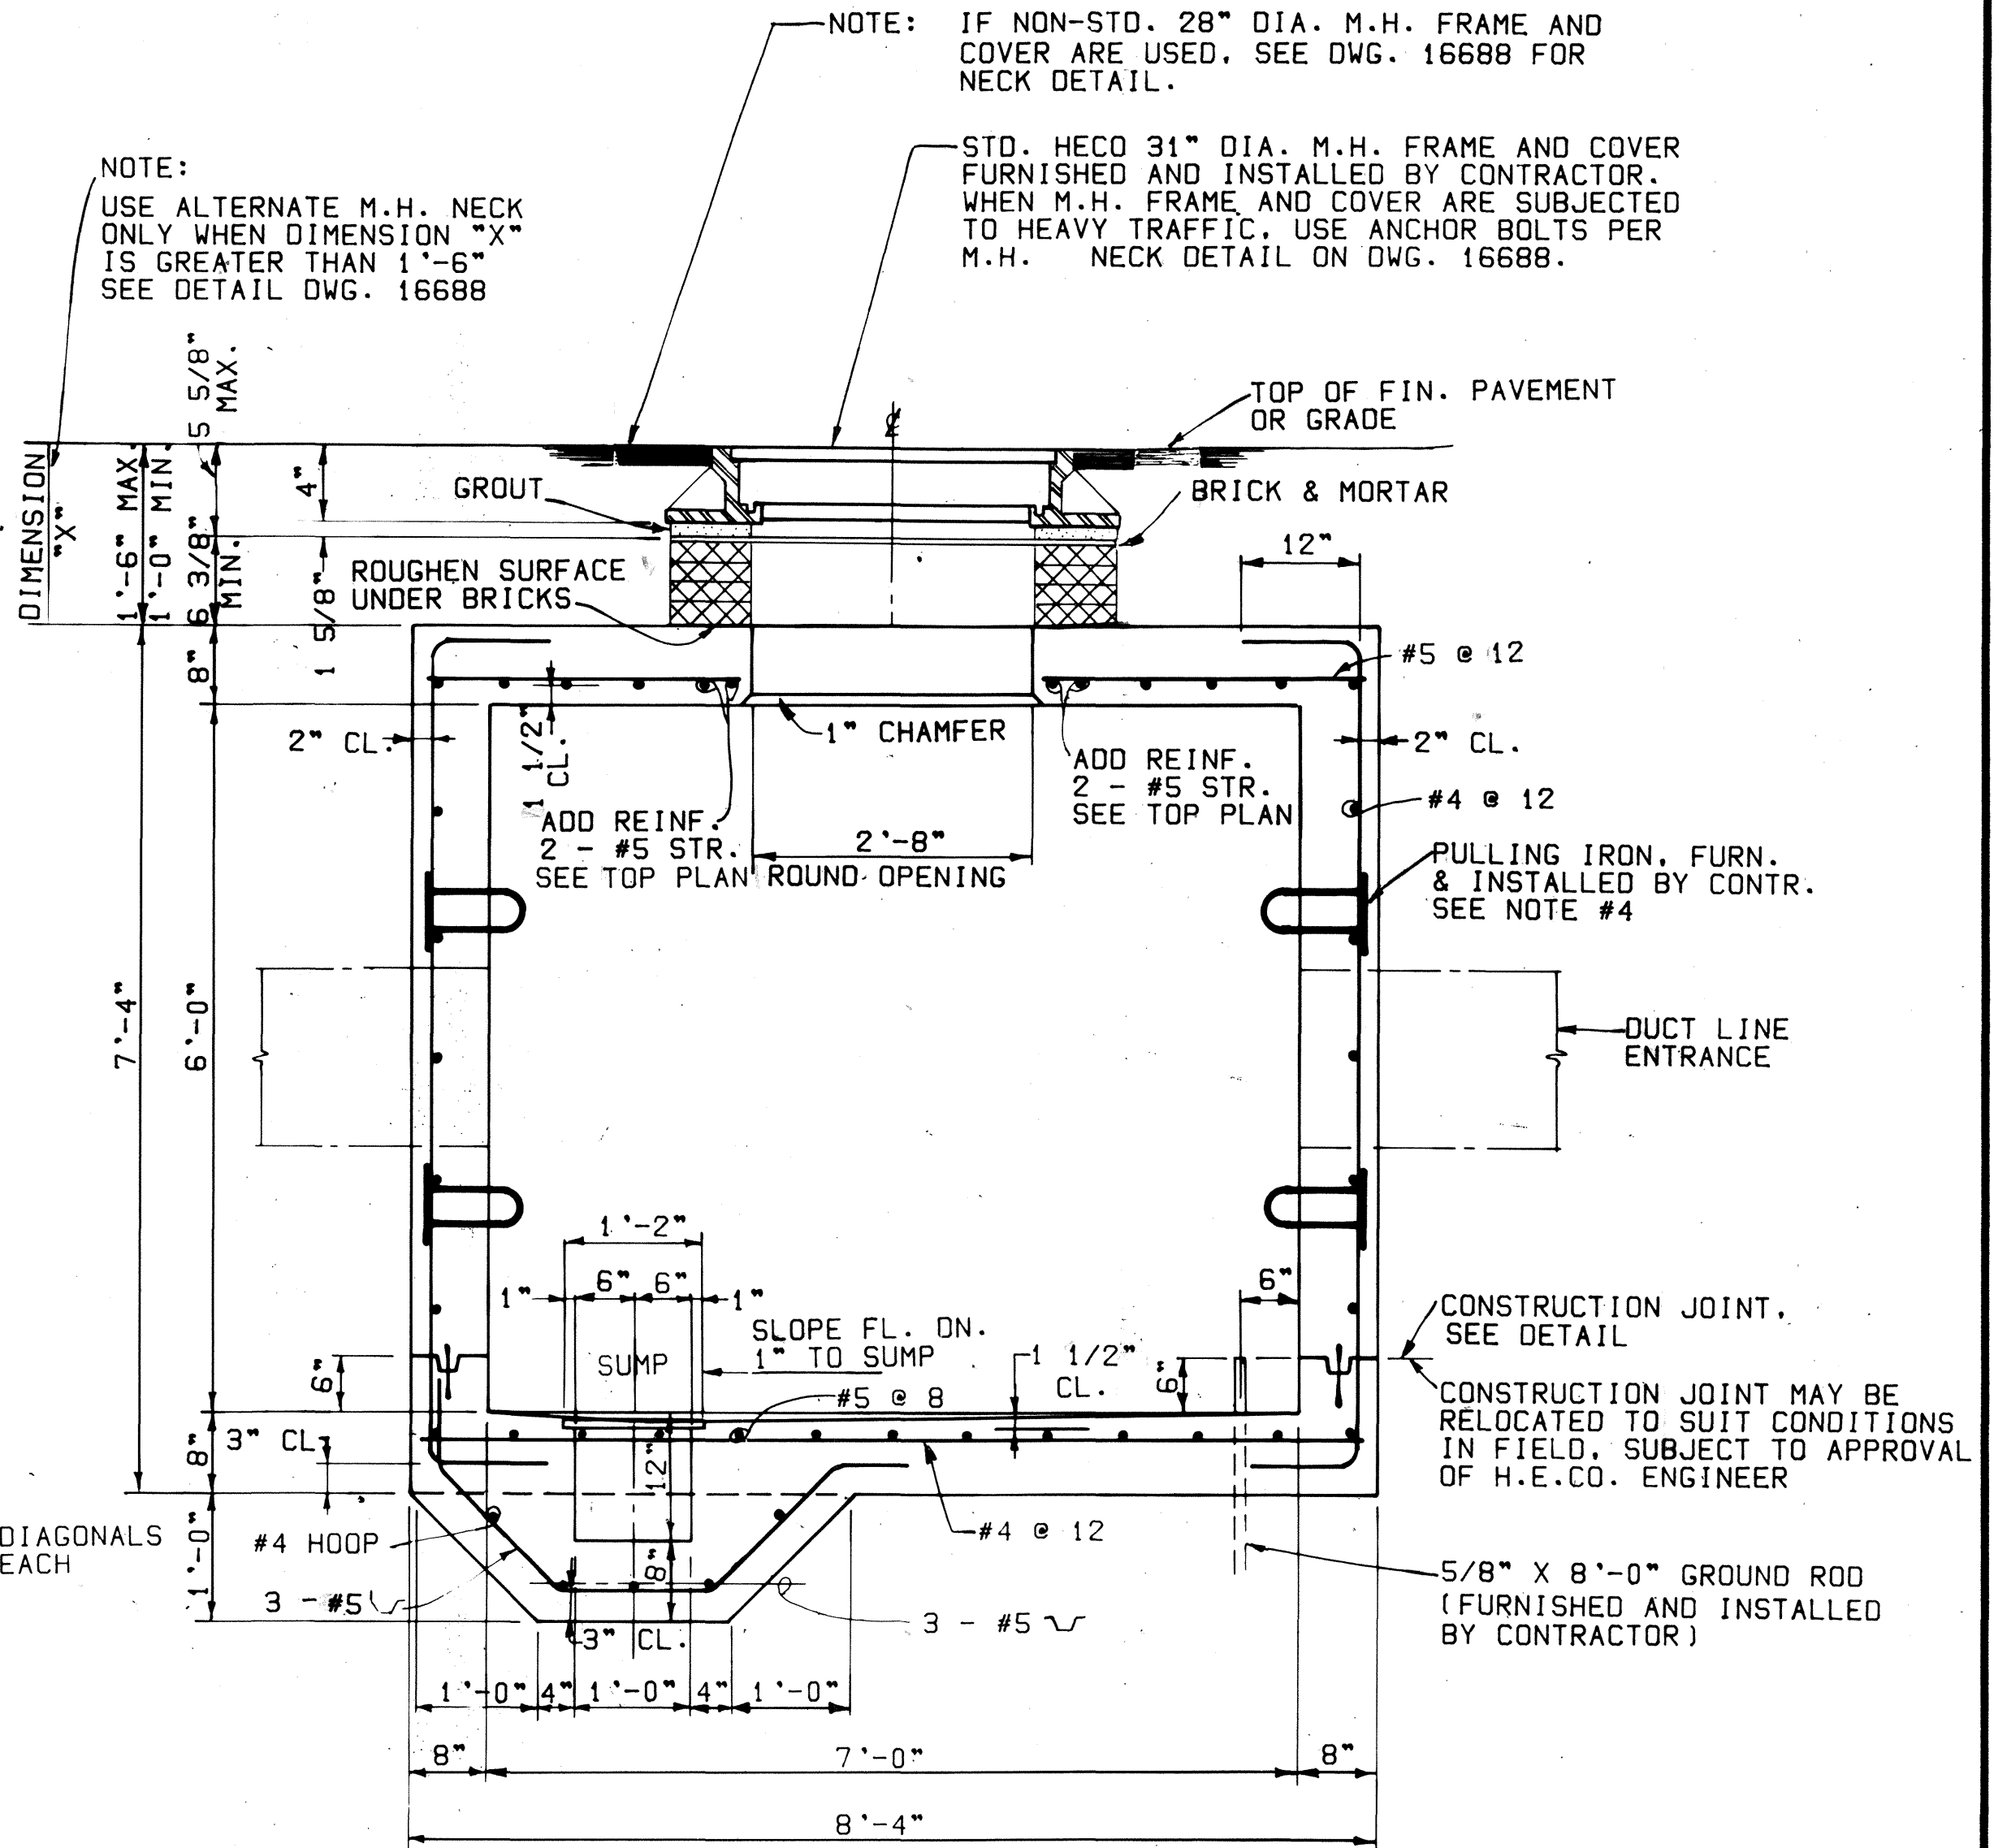

SECTION "C - C"
3/4" = 1'-0"

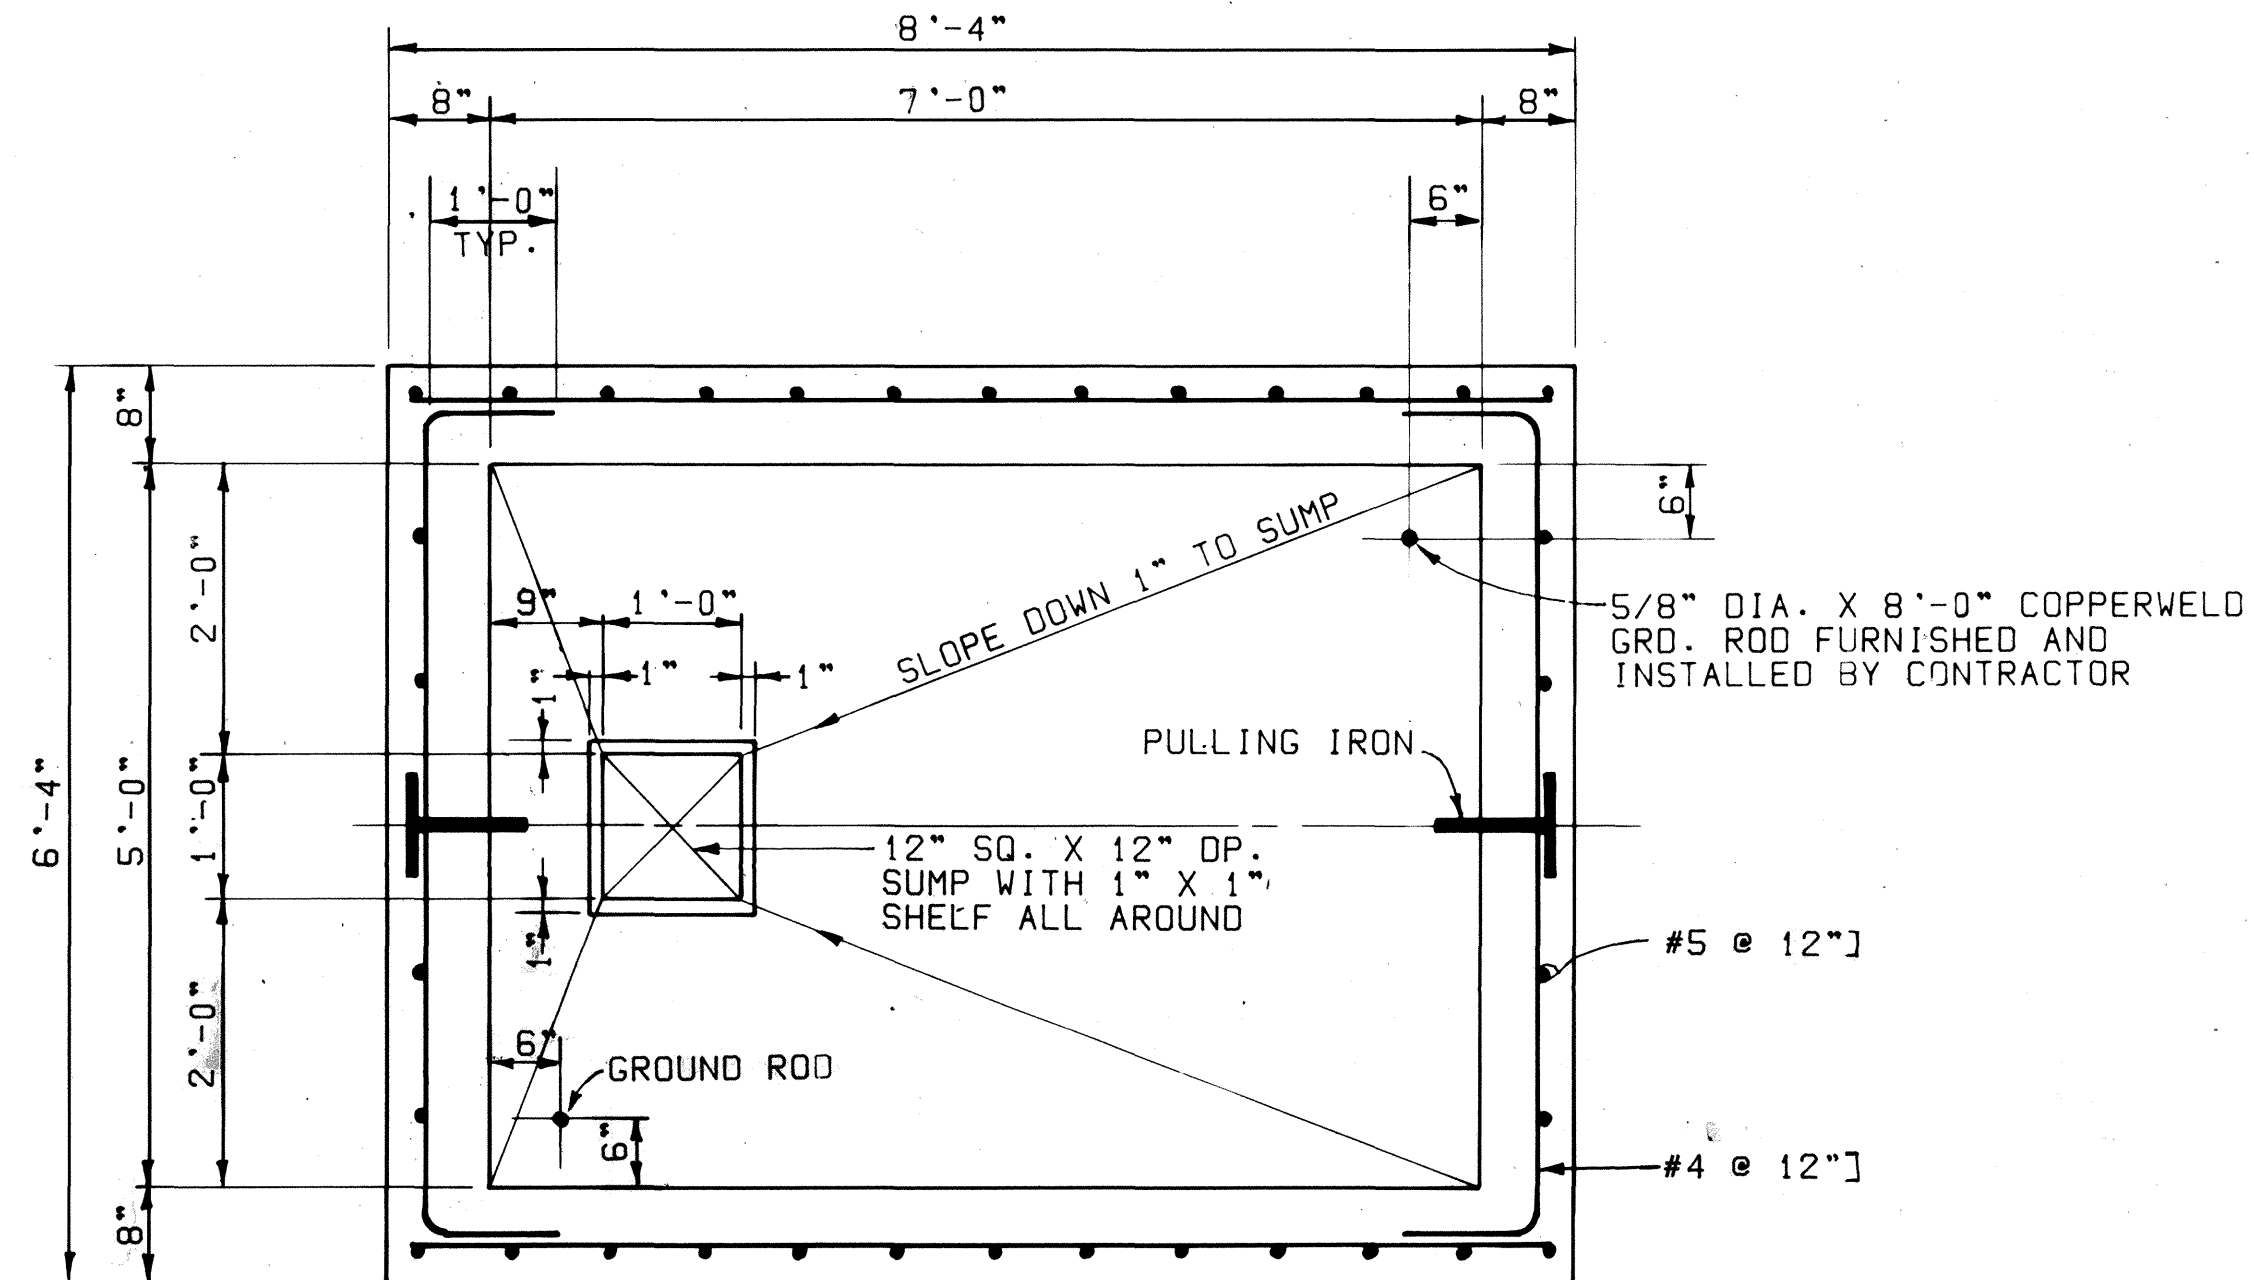

SECTIONAL PLAN
3/4" = 1'-0"

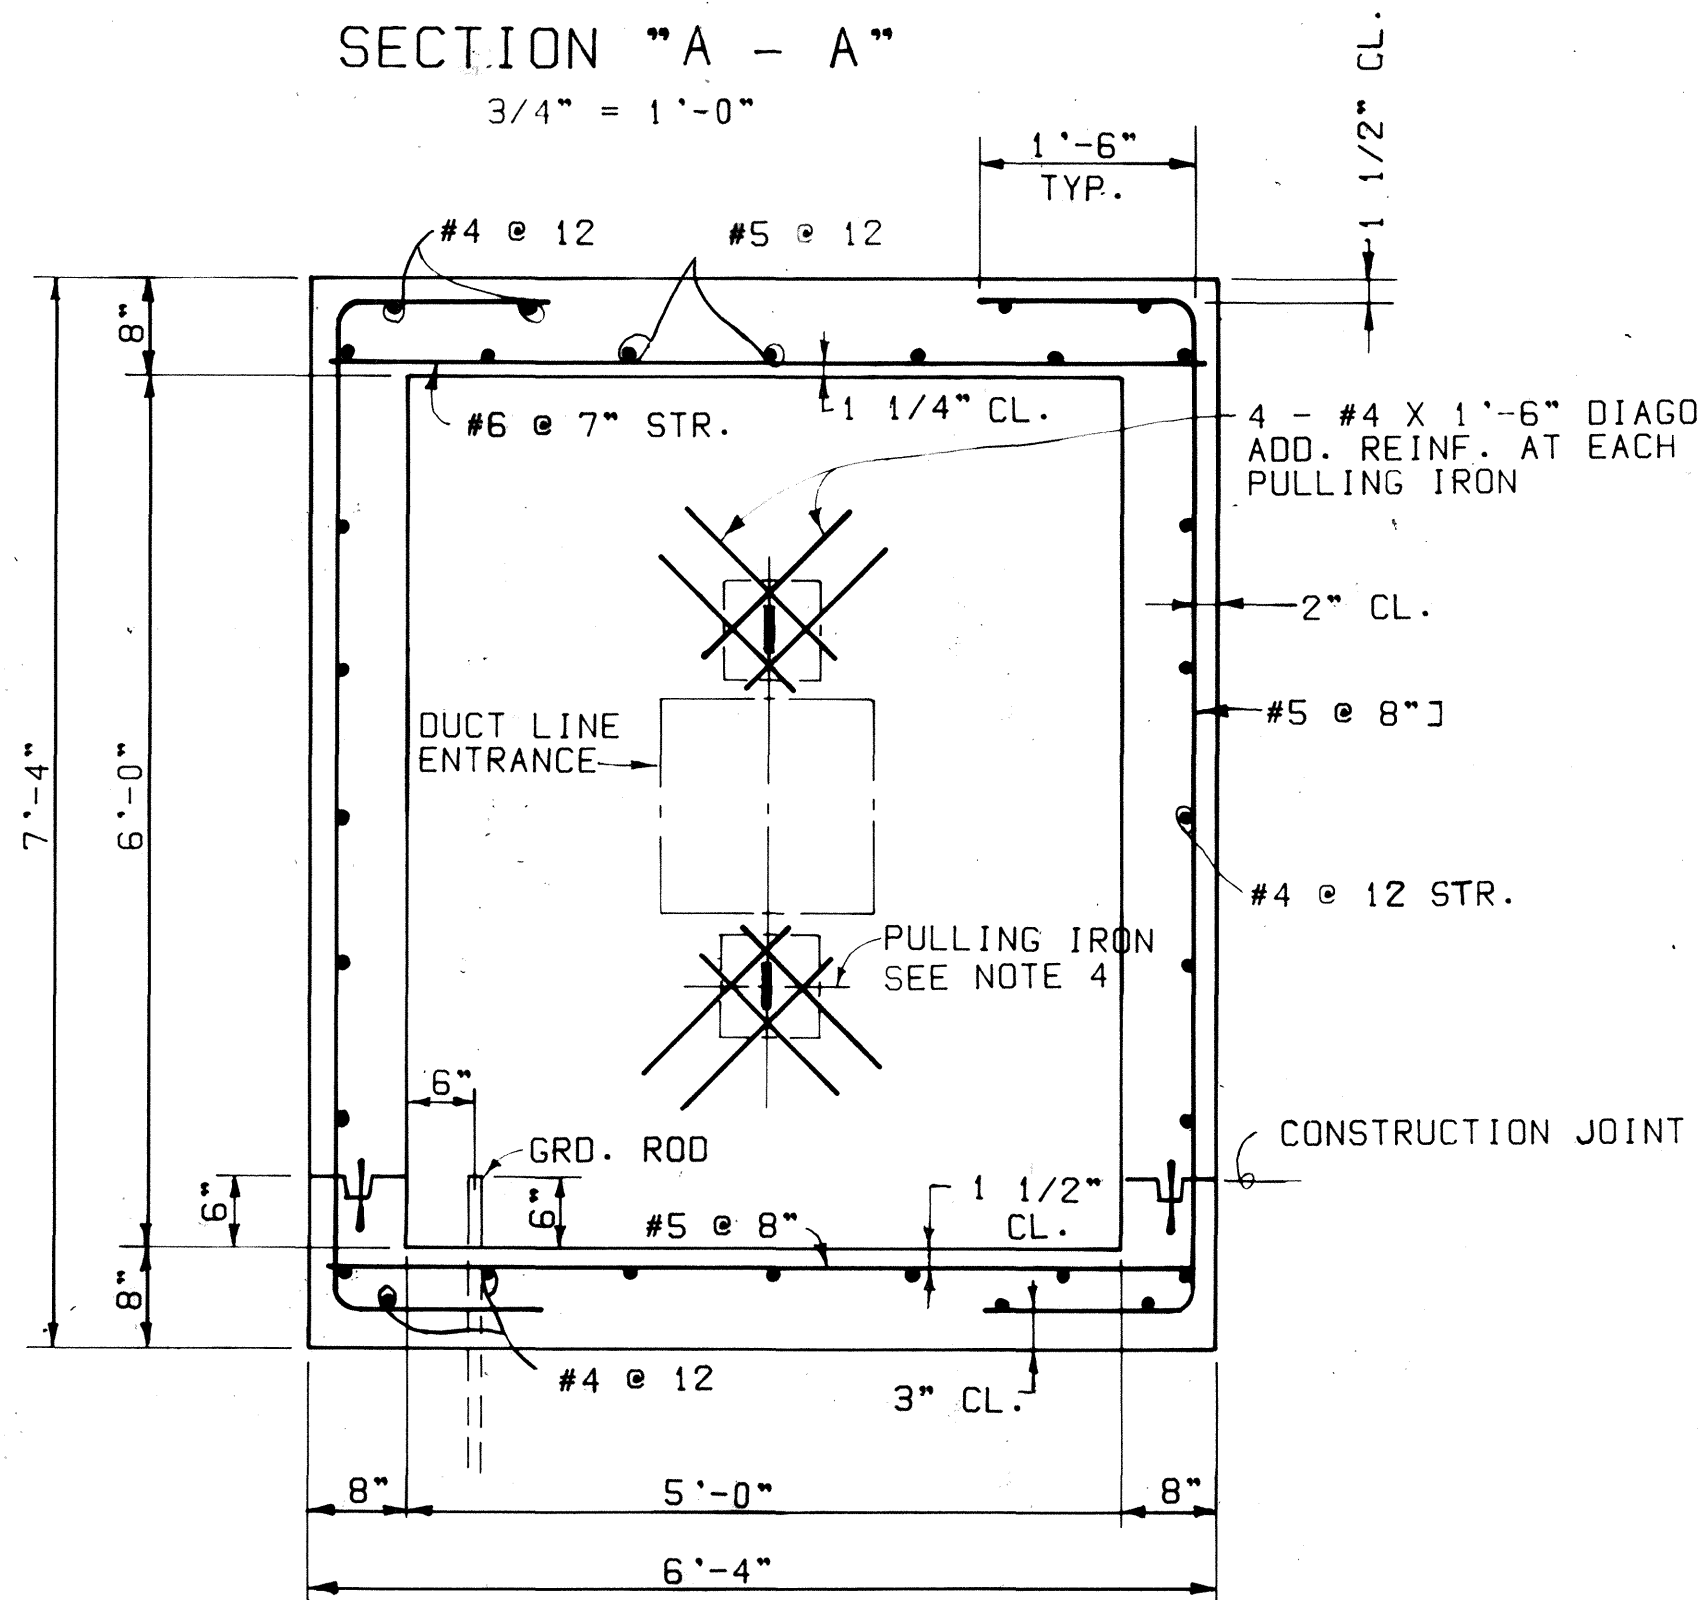

SECTION "B - B"
3/4" = 1'-0"

APPROVED
HAWAIIAN ELECTRIC COMPANY







DATE
9-14-78

HECo, Inc. Drawing No. 16687
SHEET NO. 2 OF 2 SHEETS
STATE OF HAWAII
DEPARTMENT OF TRANSPORTATION
LAND TRANSPORTATION FACILITIES DIVISION
MANHOLE, TYPE 57M
(5'-0" x 7'-0")
UNDERGROUND STANDARDS
Scales As Noted
AUG 1978
SHEET No. 35 OF 38 SHEETS

ORIGINAL PLAN	SURVEY PLOTTED BY _____	DATE _____
	DRAWN BY _____	" _____
	TRACED BY _____	" _____
NOTE BOOK	DESIGNED BY _____	" _____
	QUANTITIES BY _____	" _____
No. _____	CHECKED BY _____	" _____



ORIGINAL PLAN	SURVEY PLOTTED BY _____	DATE _____
NOTE BOOK	DRAWN BY _____	BY _____
	TRACED BY _____	BY _____
	DESIGNED BY _____	BY _____
	QUANTITIES BY _____	BY _____
No. _____	CHECKED BY _____	BY _____

FED. ROAD DIST. NO.	STATE	FED. AID PROJ. NO.	FISCAL YEAR	SHEET NO.	TOTAL SHEETS
HAWAII	HAW.	F-083-110	1978	86	160

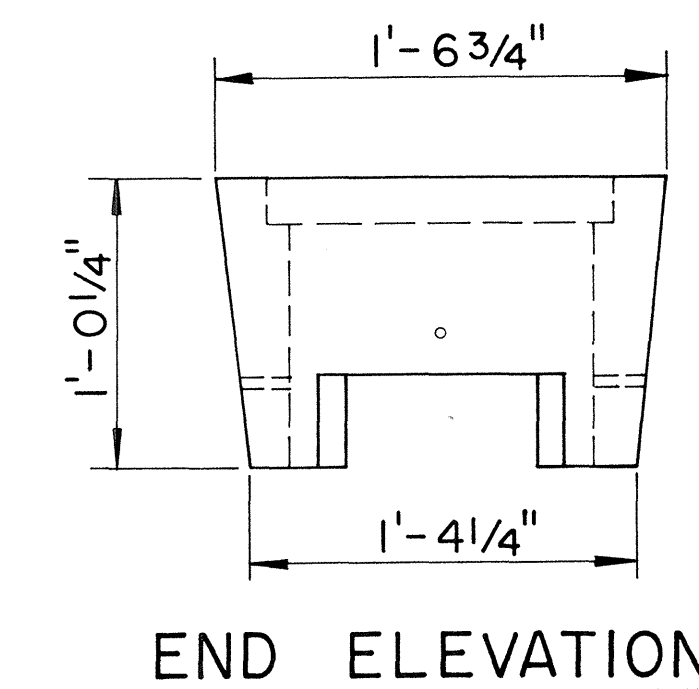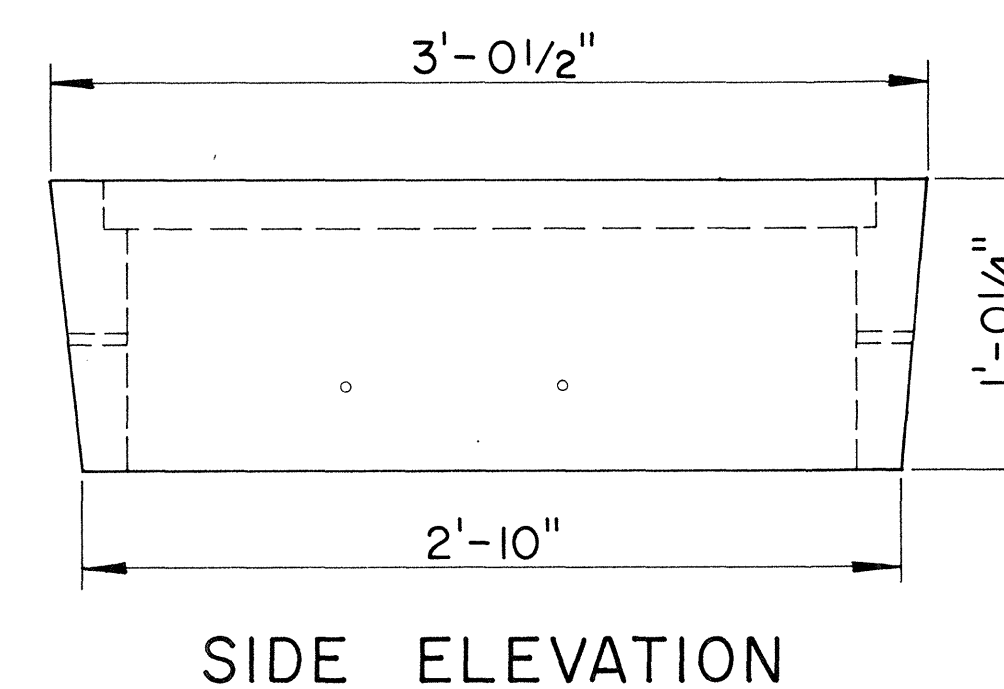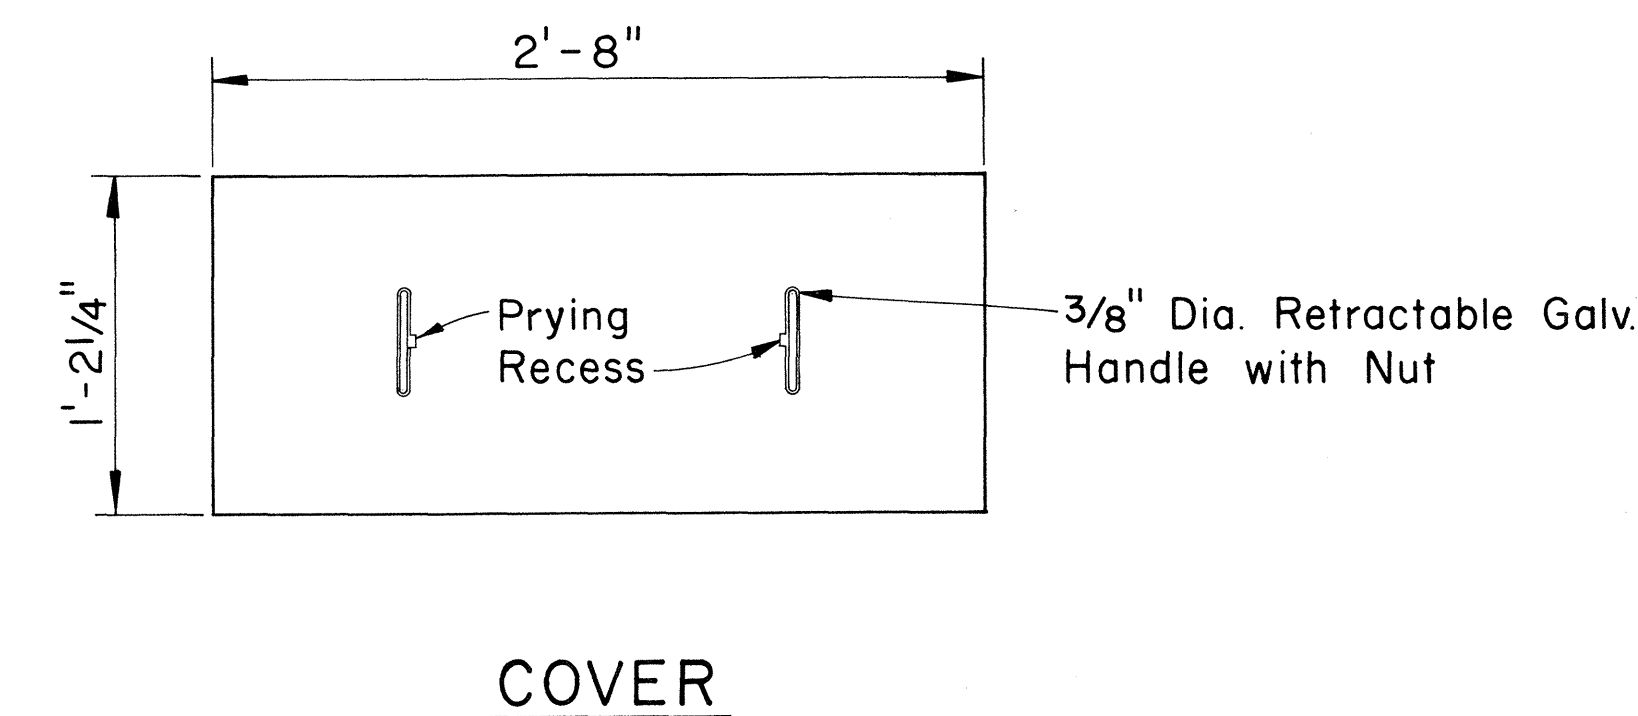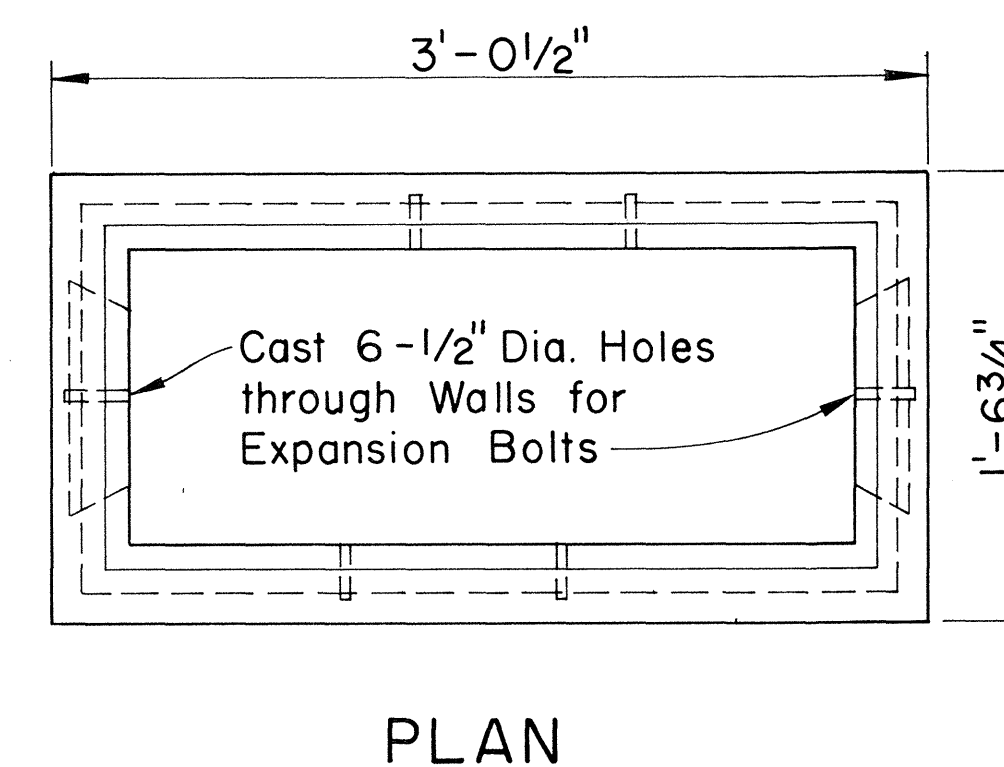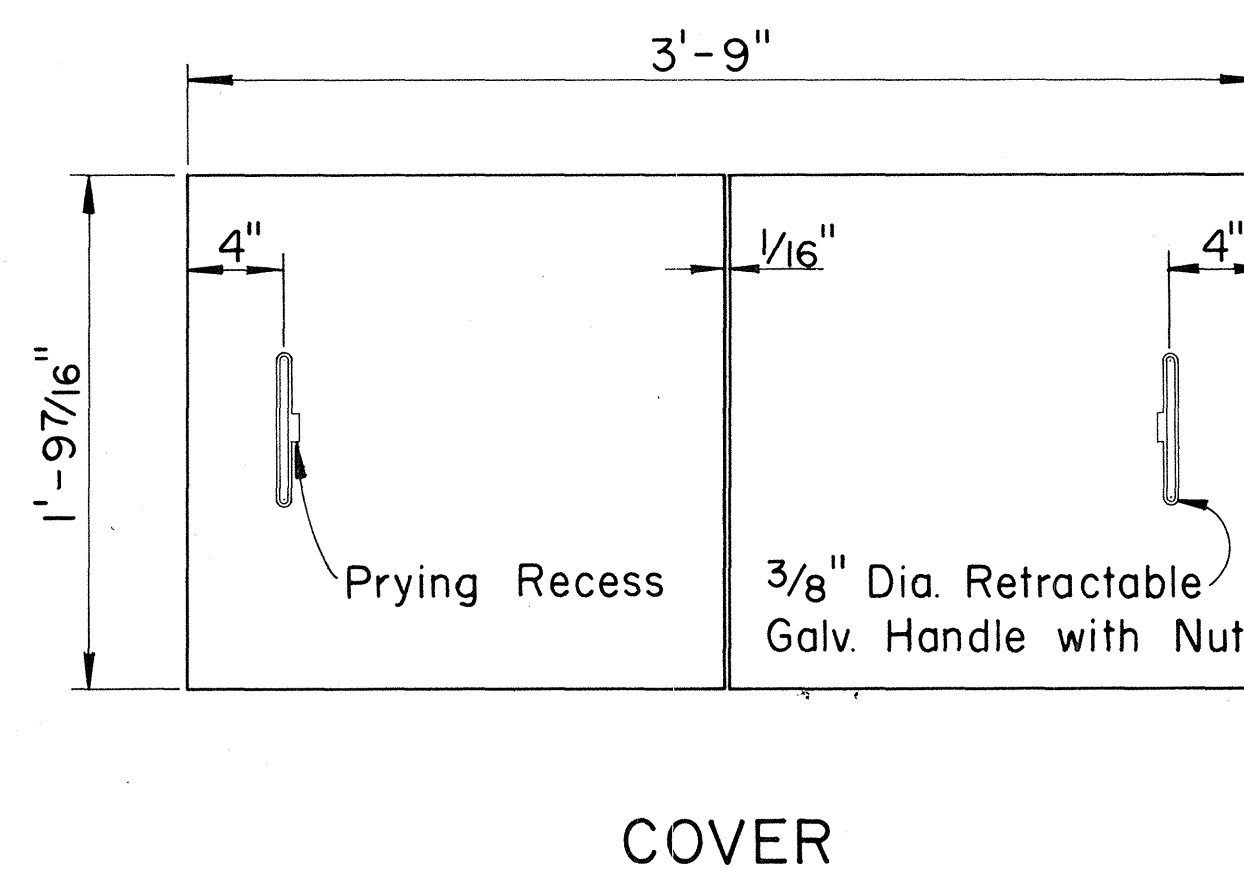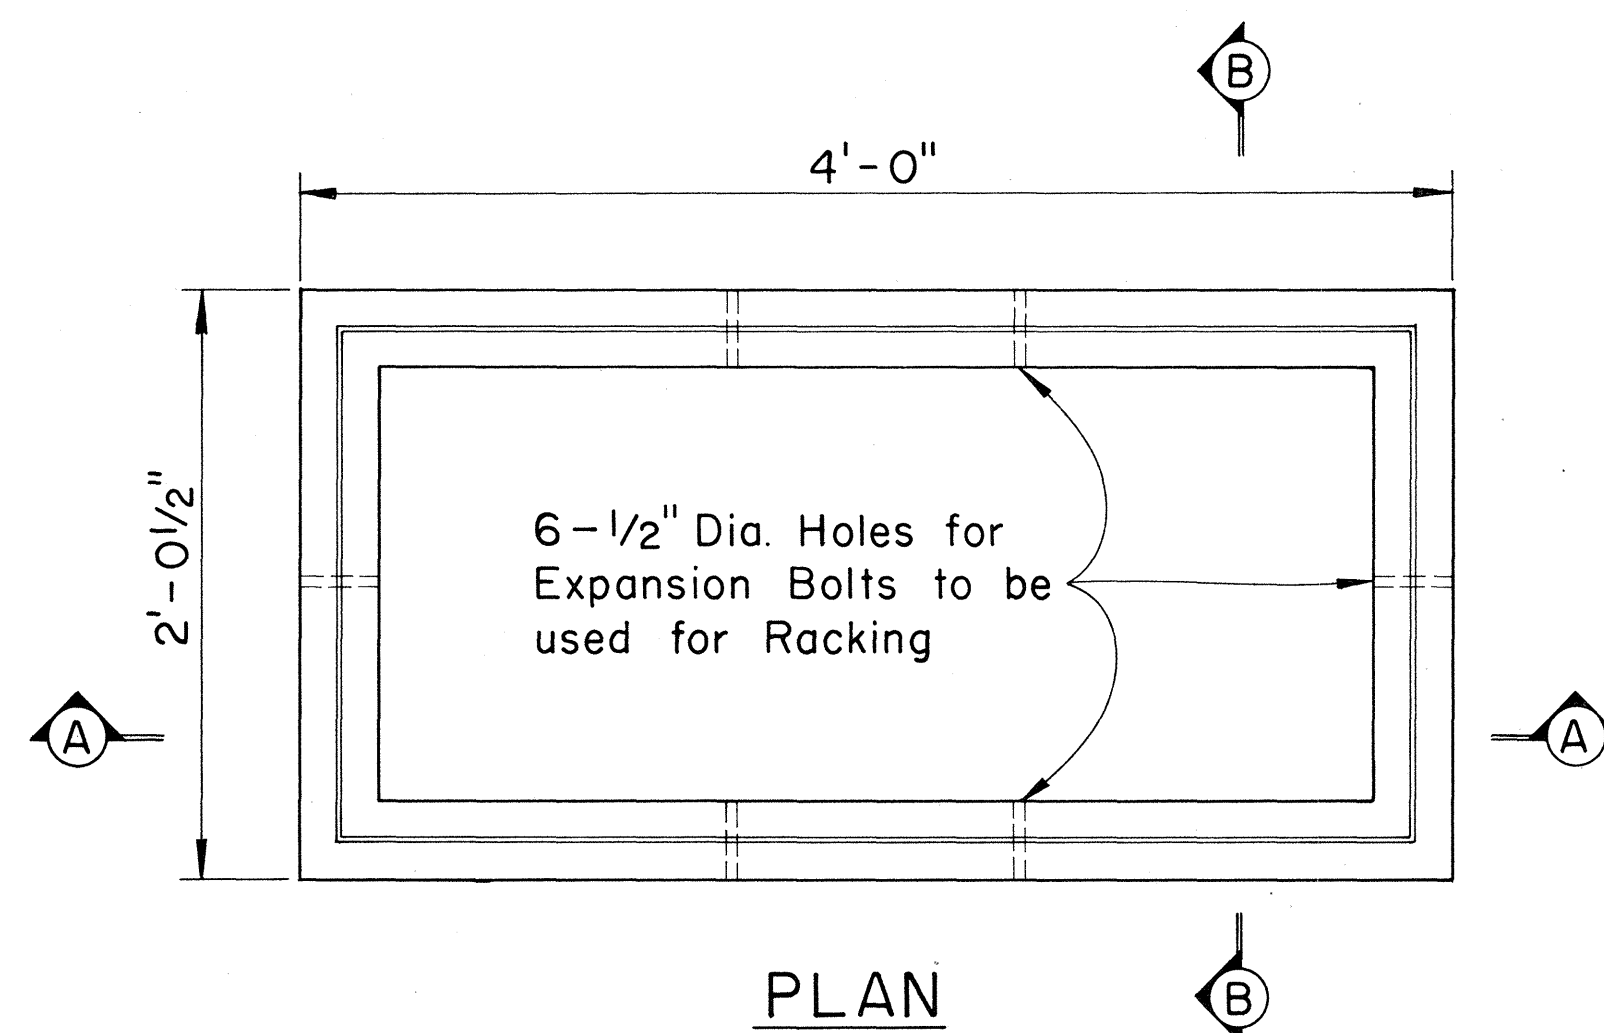



DETAIL OF SMALL PULL BOX NO. 434T

Scale: 1 1/2" = 1'-0"

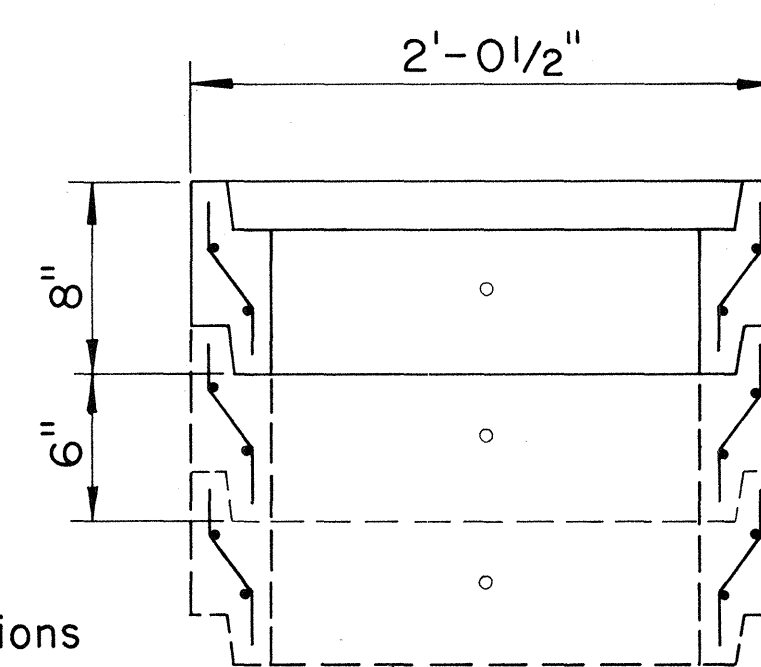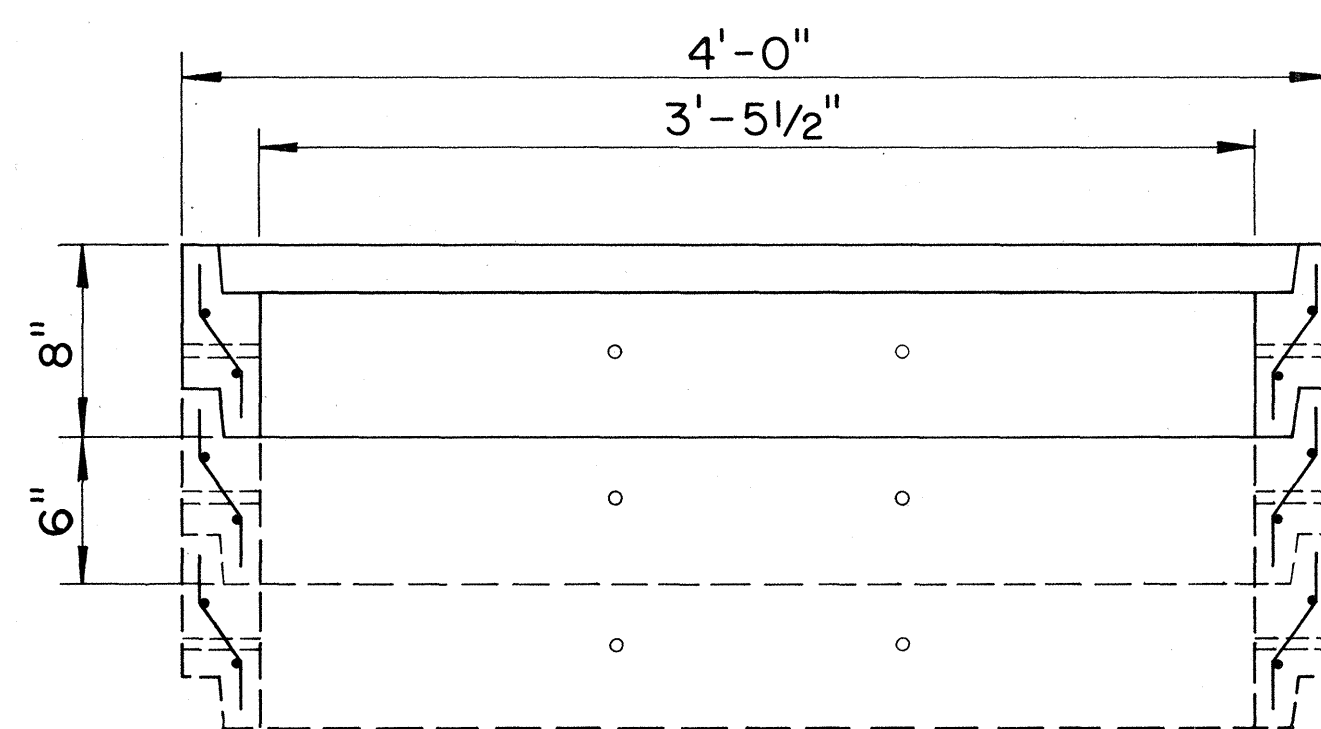

DETAIL OF LARGE PULL BOX NO. 435T-B


Scale: 1 1/2" = 1'-0"

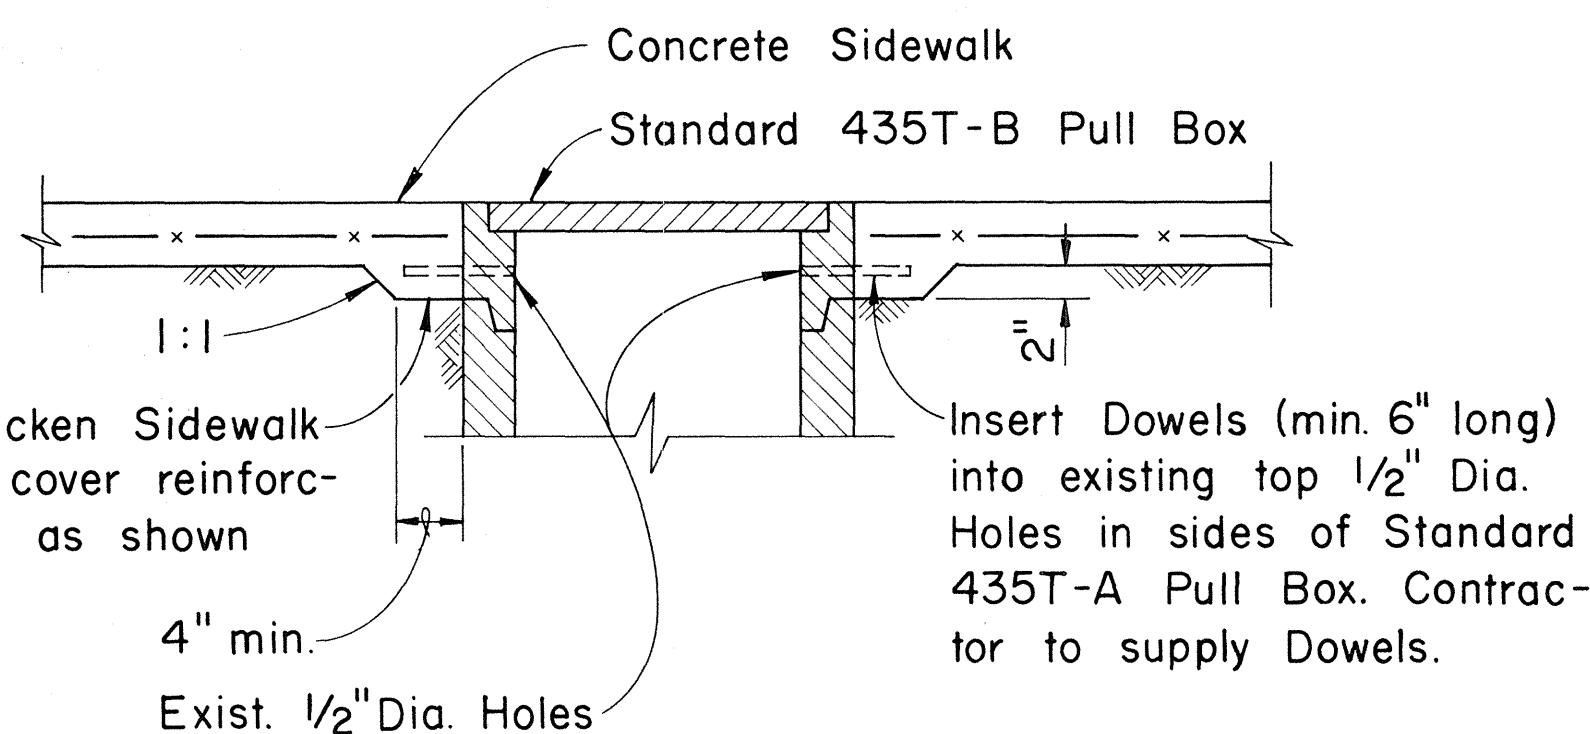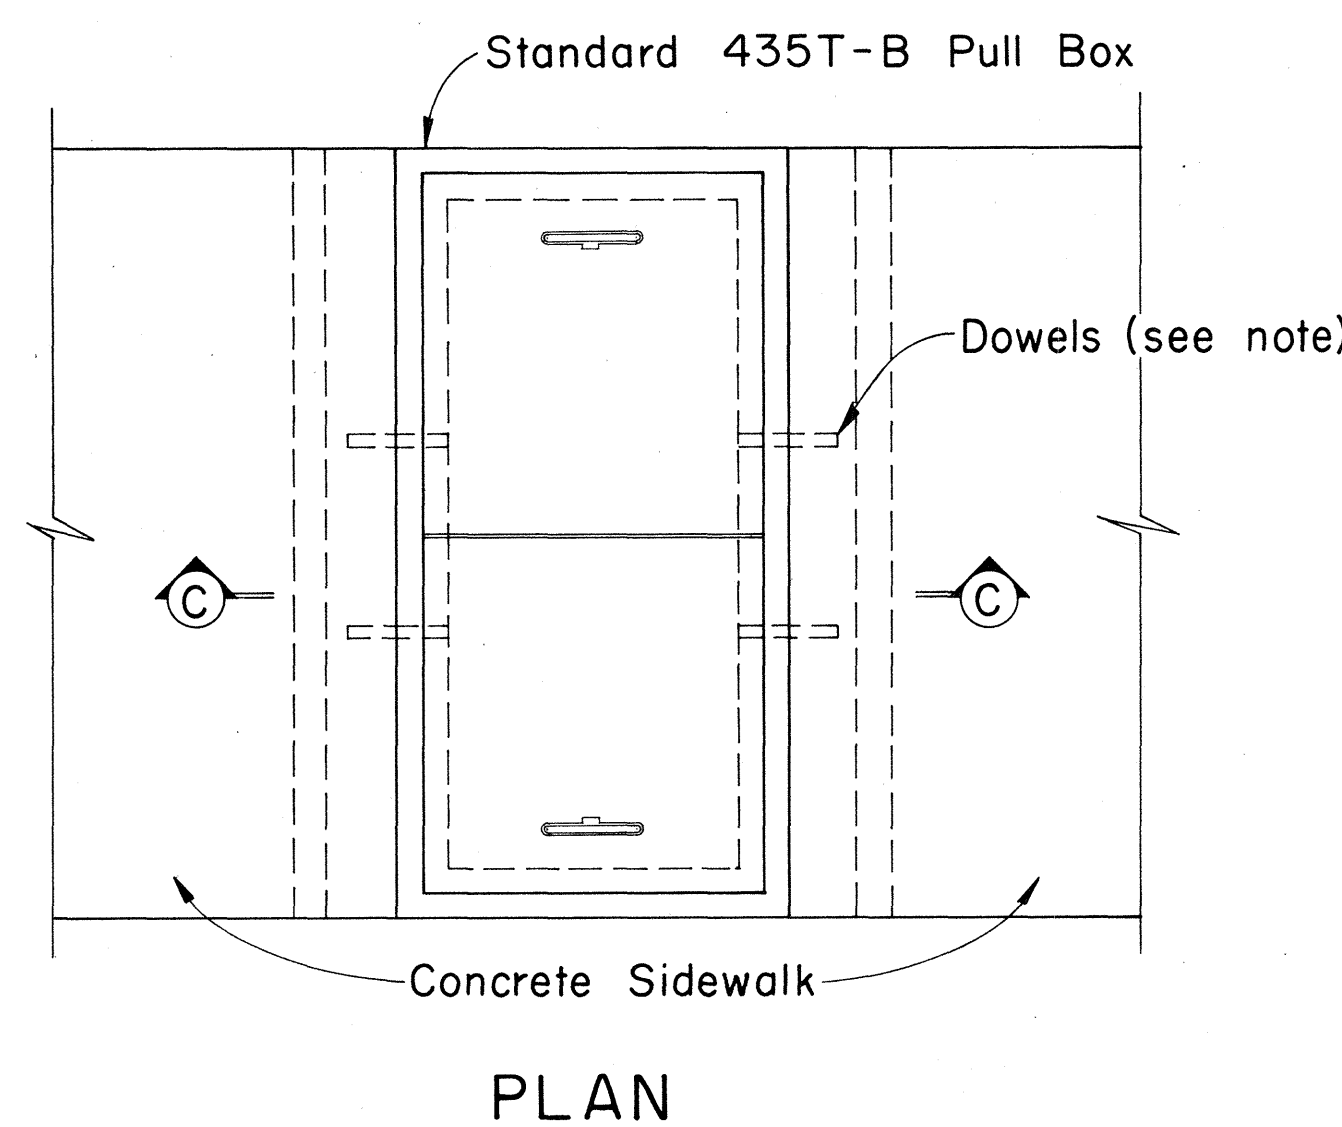

NOTE: Dowels shall be used only where the Sidewalk is as wide or narrower than the Pull Box.


INSTALLATION DETAIL OF PULL BOX NO. 435T-B IN SIDEWALK AREAS

Scale: 1" = 1'-0"

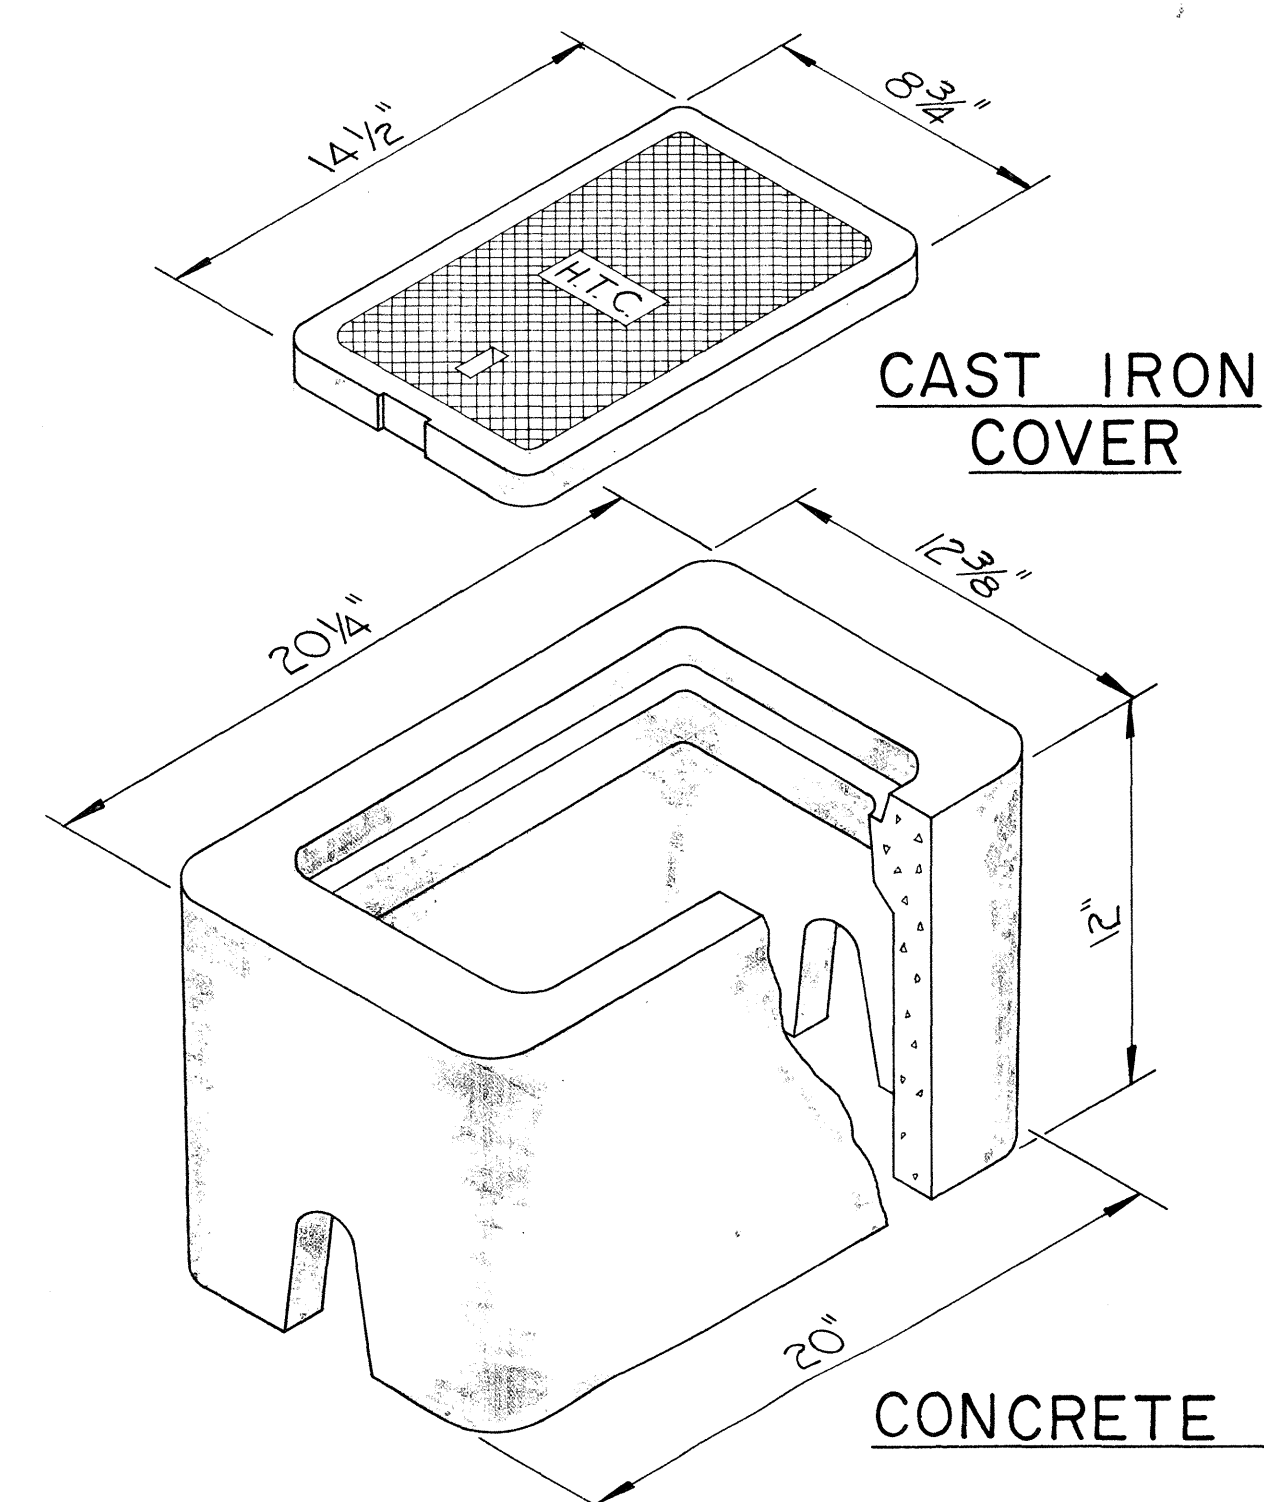

TYPE "B" METER BOX, NO. 436T

Not to Scale

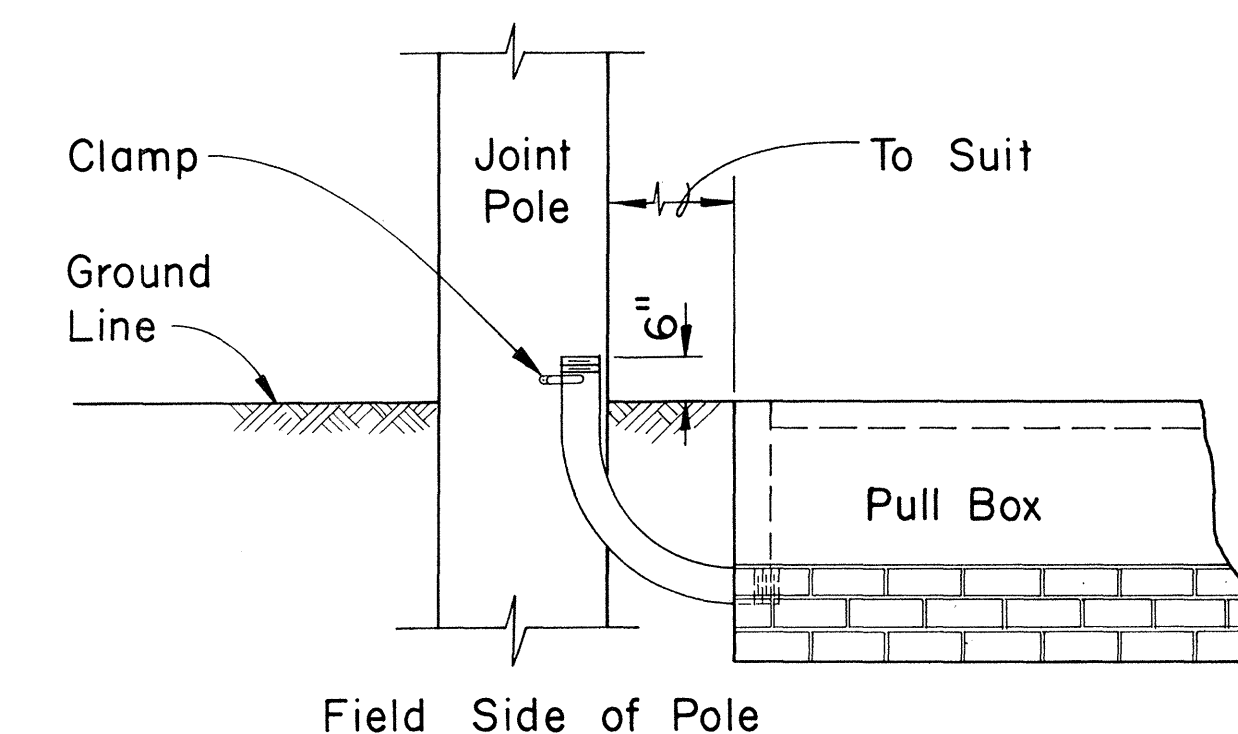

TYPICAL 90° CONDUIT BEND TO POLE

Not to Scale

APPROVED: *K. Yamada* 7-8-78
Hawaiian Telephone Co., Ltd. Date

STATE OF HAWAII
DEPARTMENT OF TRANSPORTATION
LAND TRANSPORTATION FACILITIES DIVISION
STANDARD DETAILS
TELEPHONE PULL BOXES
NOS. 435T-B, 434T, & 436T

Scale: As Shown Date: 11/8 1978
SHEET No. 38 OF 38 SHEETS