

[illegible]

STATE OF HAWAII


DEPARTMENT OF TRANSPORTATION
LAND TRANSPORTATION FACILITIES DIVISION

DISTRICT OF KOOLAULOA
ISLAND OF OAHU

LAYOUT PLAN

LENGTH OF PROJECT..... 17.3 MILES

FED. ROAD DIST. NO.	STATE	FED. AID PROJ. NO.	FISCAL YEAR	SHEET NO.	TOTAL SHEETS
HAWAII	HAW.	PM5-083-1(13)	1979	1	3

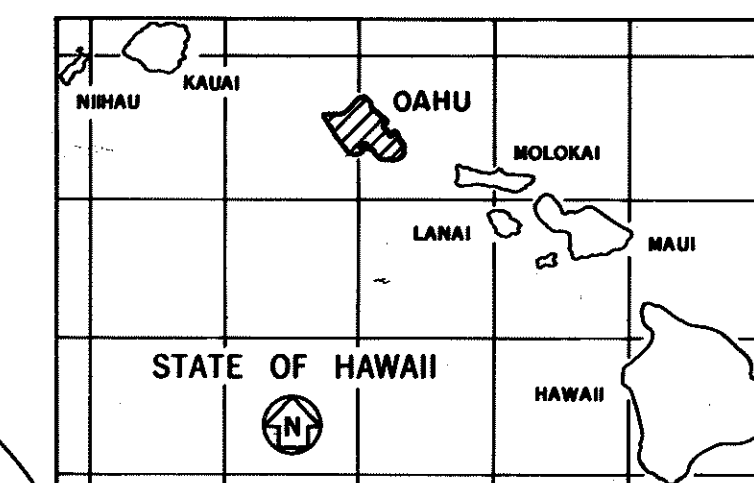

LOCATION OF PROJECT
PMS-083-1(13)

 FEDERAL AID PROJECTS PREVIOUSLY CONSTRUCTED
OR UNDER CONSTRUCTION

Ronald N. Kan
RESIDENT ENGINEER

DEPARTMENT OF TRANSPORTATION
FEDERAL HIGHWAY ADMINISTRATION

DEPARTMENT OF TRANSPORTATION
STATE OF HAWAII