


| FED. ROAD DIST. NO. | STATE | PROJ. NO.                   | FISCAL YEAR | SHEET NO. | TOTAL SHEETS |
|---------------------|-------|-----------------------------|-------------|-----------|--------------|
| HAWAII              | HAW.  | FR-0300(II)<br>6300A-01-80M | 1980        | 6         | 21           |


|                   |      |
|-------------------|------|
| DATE              | ____ |
| SURVEY PLOTTED BY | ____ |
| DRAWN BY          | ____ |
| DESIGNED BY       | ____ |
| NOTED BY          | ____ |
| CHECKED BY        | ____ |
| ORIGINAL PLAN     | ____ |
| NOTE BOOK         | ____ |
| No.               | ____ |

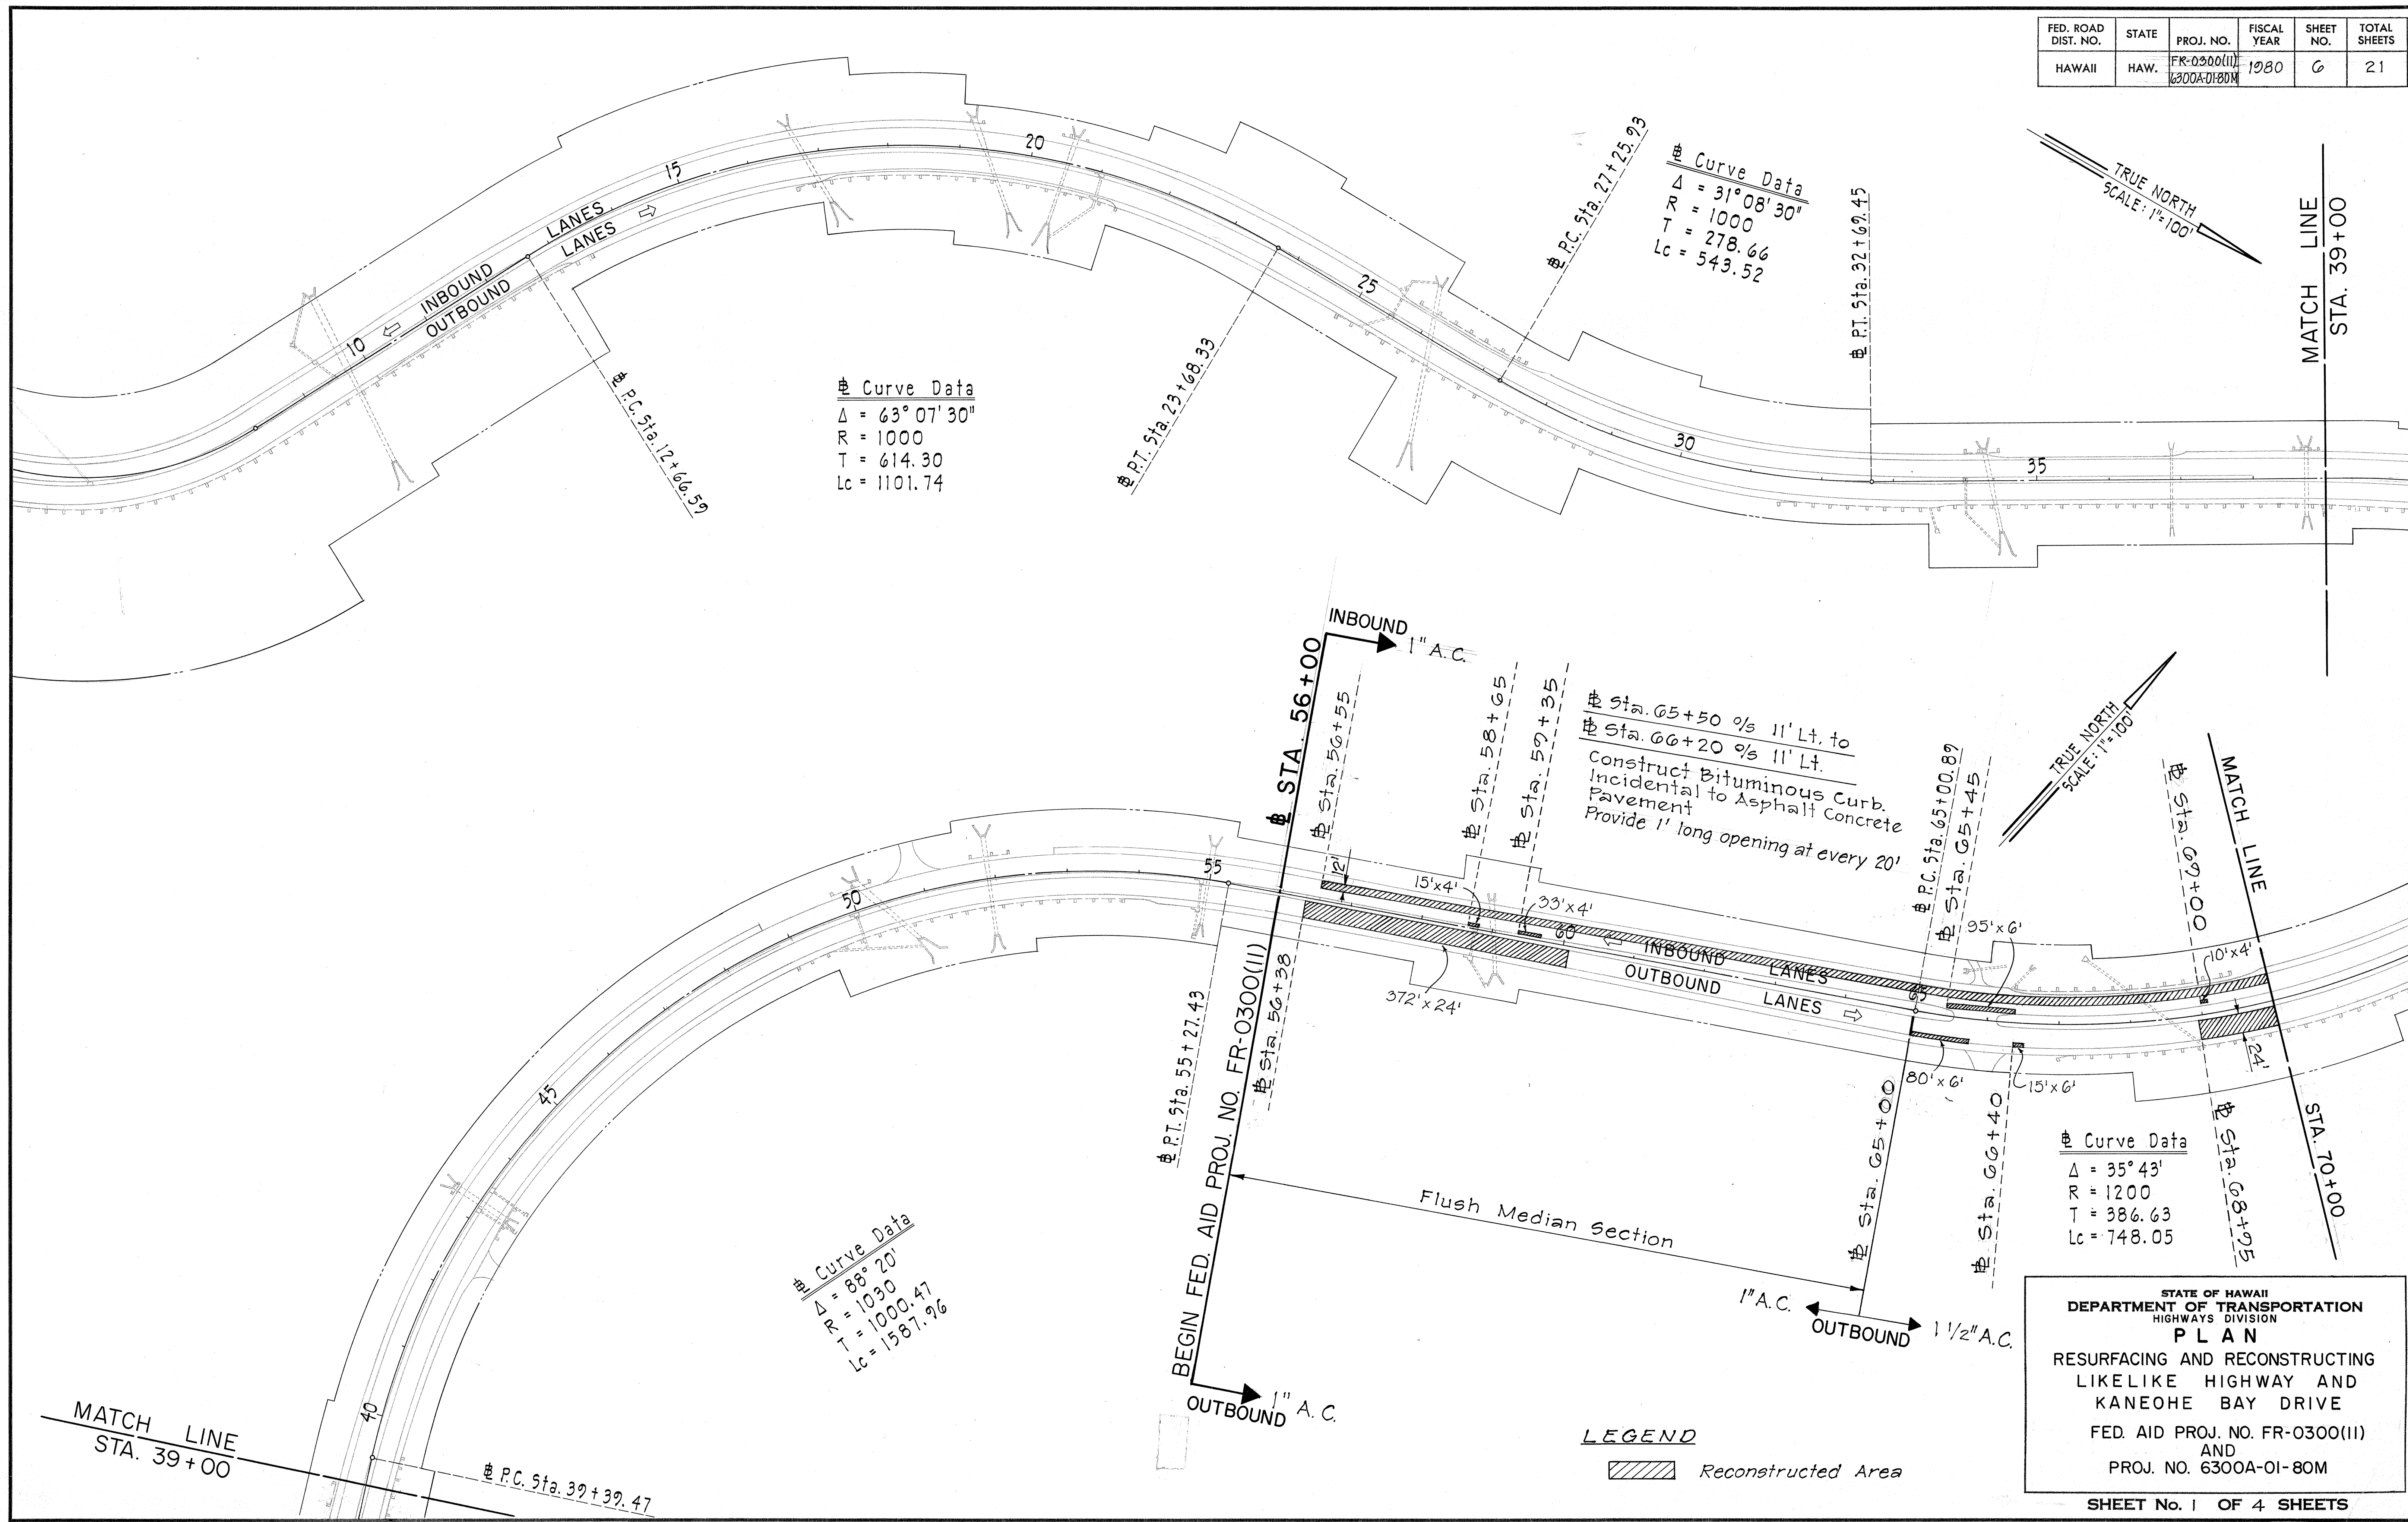

STATE OF HAWAII  
 DEPARTMENT OF TRANSPORTATION  
 HIGHWAYS DIVISION  
**PLAN**  
 RESURFACING AND RECONSTRUCTING  
 LIKELIKE HIGHWAY AND  
 KANEOHE BAY DRIVE  
 FED. AID PROJ. NO. FR-0300(II)  
 AND  
 PROJ. NO. 6300A-01-80M

**LEGEND**  
 Reconstructed Area


| FED. ROAD DIST. NO. | STATE | PROJ. NO.                    | FISCAL YEAR | SHEET NO. | TOTAL SHEETS |
|---------------------|-------|------------------------------|-------------|-----------|--------------|
| HAWAII              | HAW.  | FR-0300(III)<br>6300A-01-80M | 1980        | 7         | 21           |

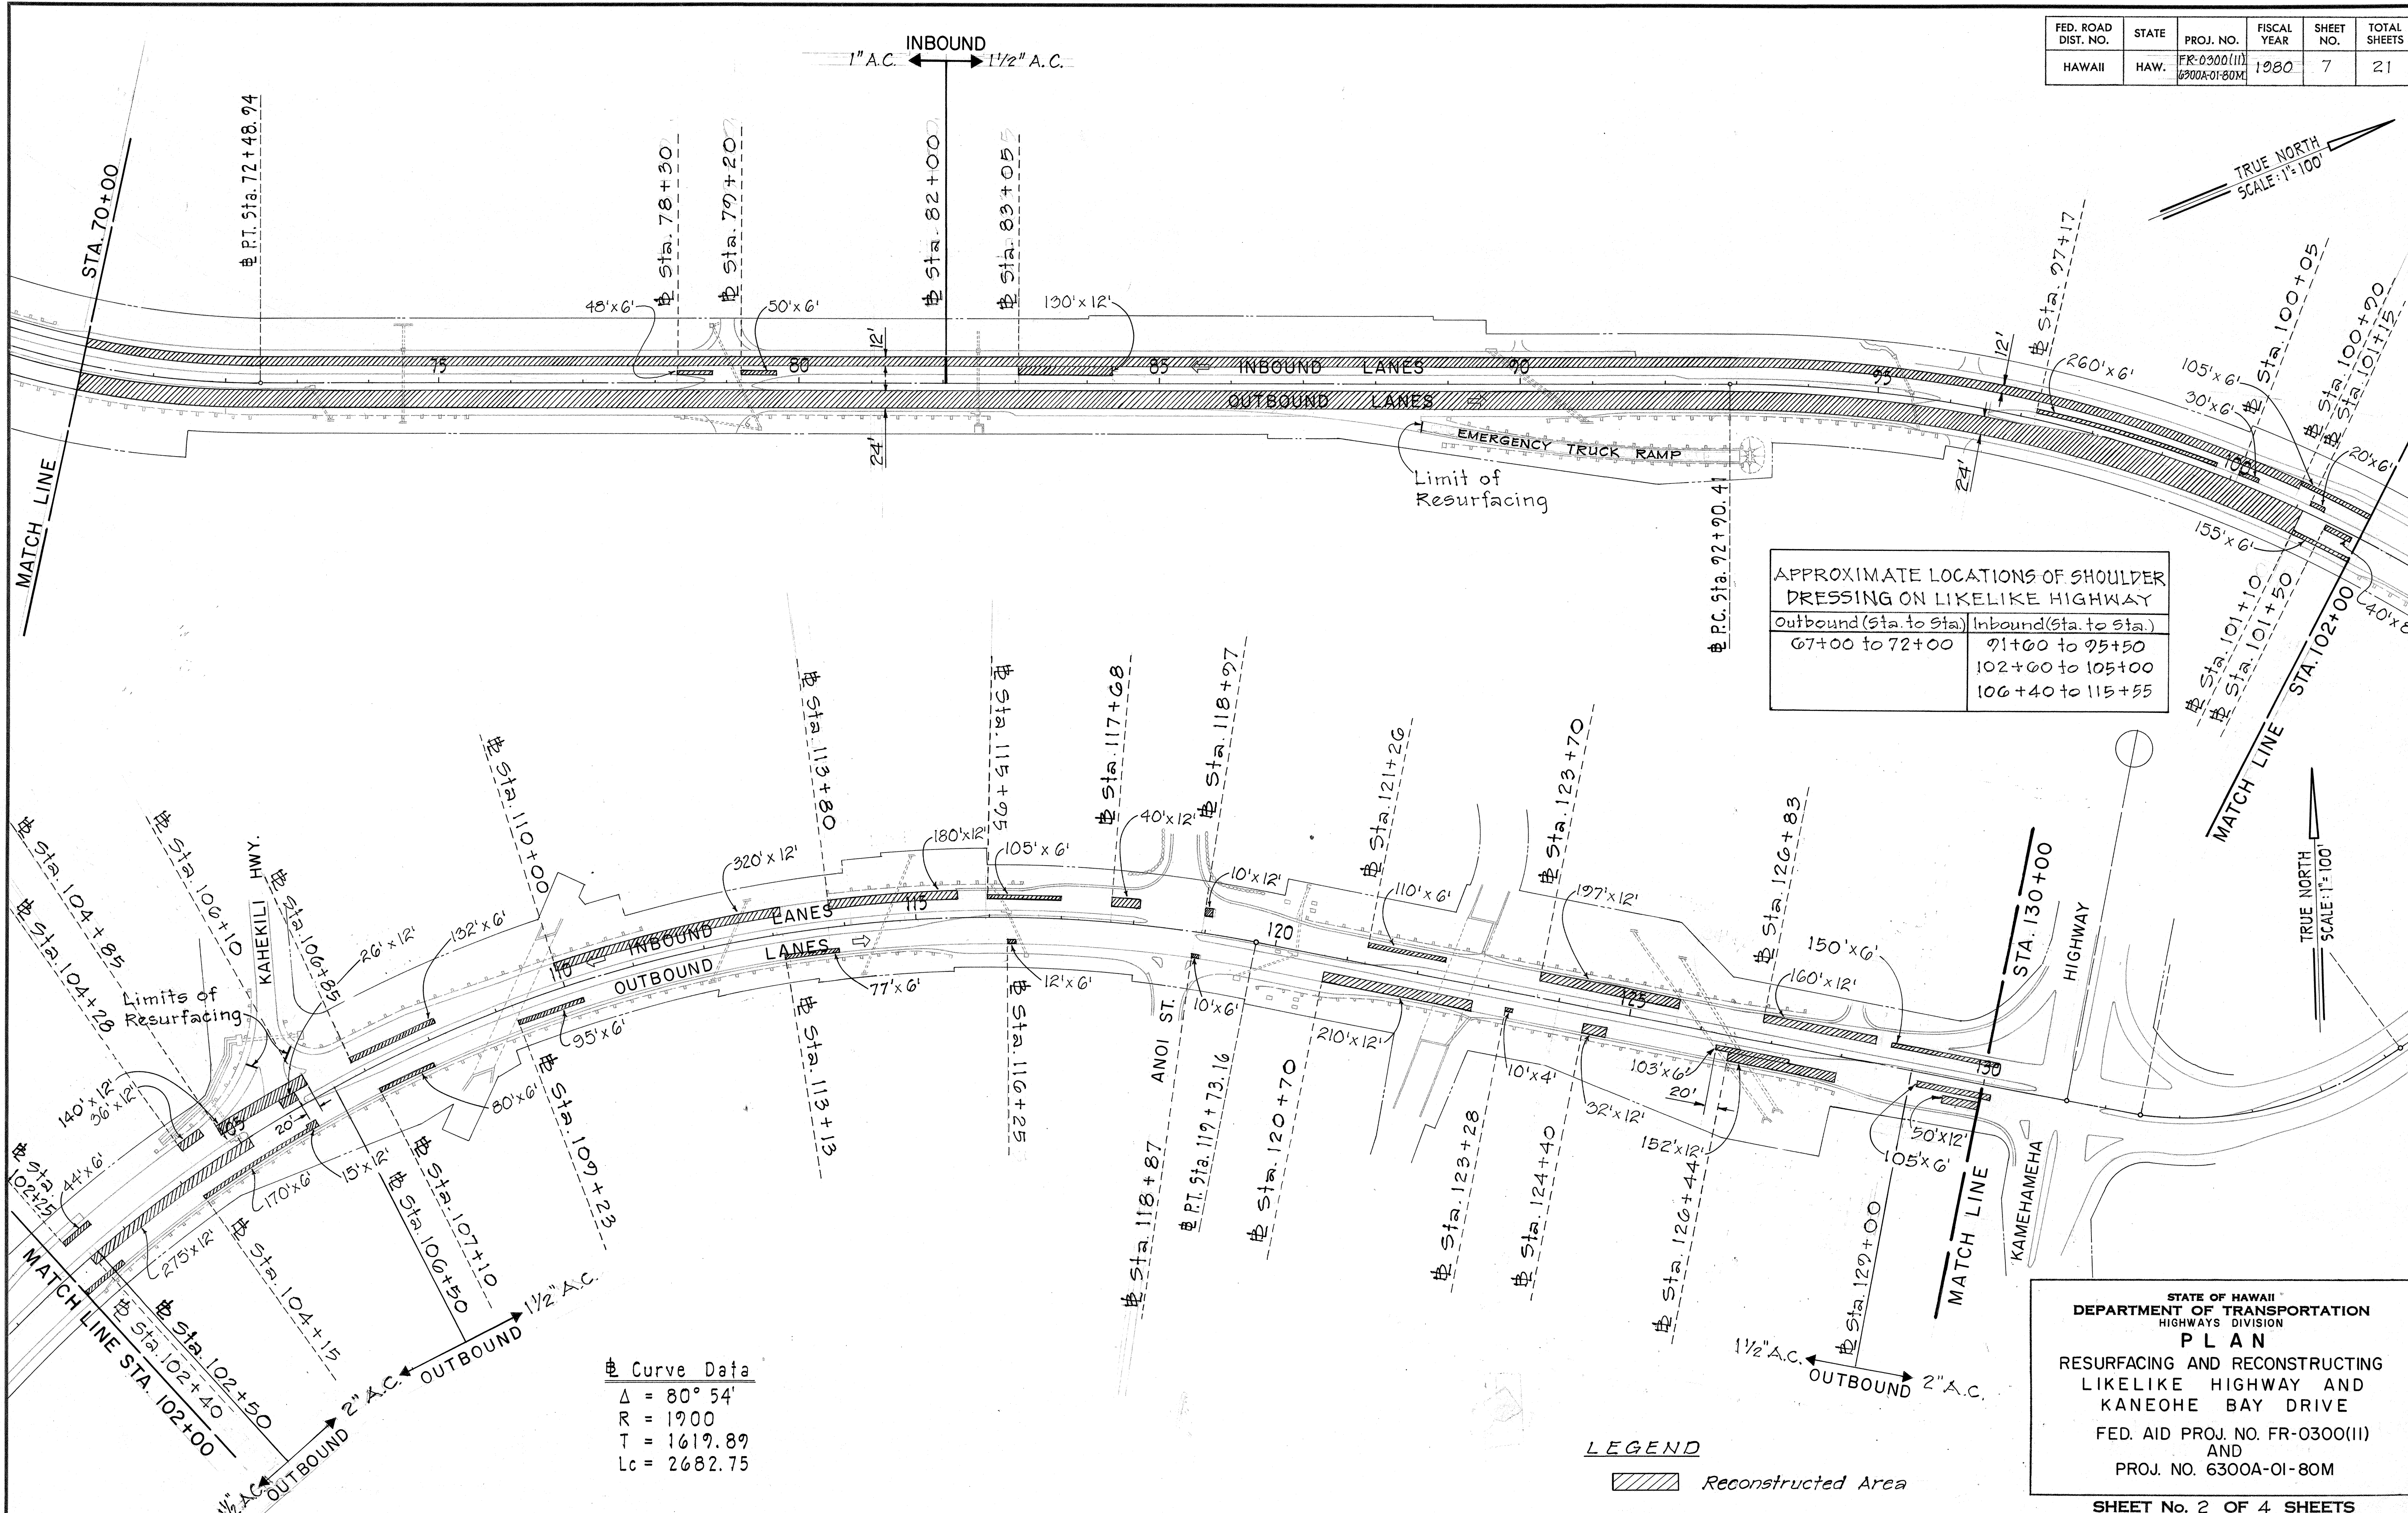

STATE OF HAWAII  
DEPARTMENT OF TRANSPORTATION  
HIGHWAYS DIVISION  
**PLAN**  
RESURFACING AND RECONSTRUCTING  
LIKELIKE HIGHWAY AND  
KANEHOE BAY DRIVE  
FED. AID PROJ. NO. FR-0300(III)  
AND  
PROJ. NO. 6300A-01-80M  
**SHEET No. 2 OF 4 SHEETS**

| ORIGINAL PLAN     | DATE |
|-------------------|------|
| SURVEY PLOTTED BY |      |
| DESIGNED BY       |      |
| NOTED BY          |      |
| CHECKED BY        |      |

|               |  |
|---------------|--|
| DATE          |  |
| DESIGNED BY   |  |
| TRACED BY     |  |
| NOTE BOOK     |  |
| QUANTITIES BY |  |
| CHECKED BY    |  |

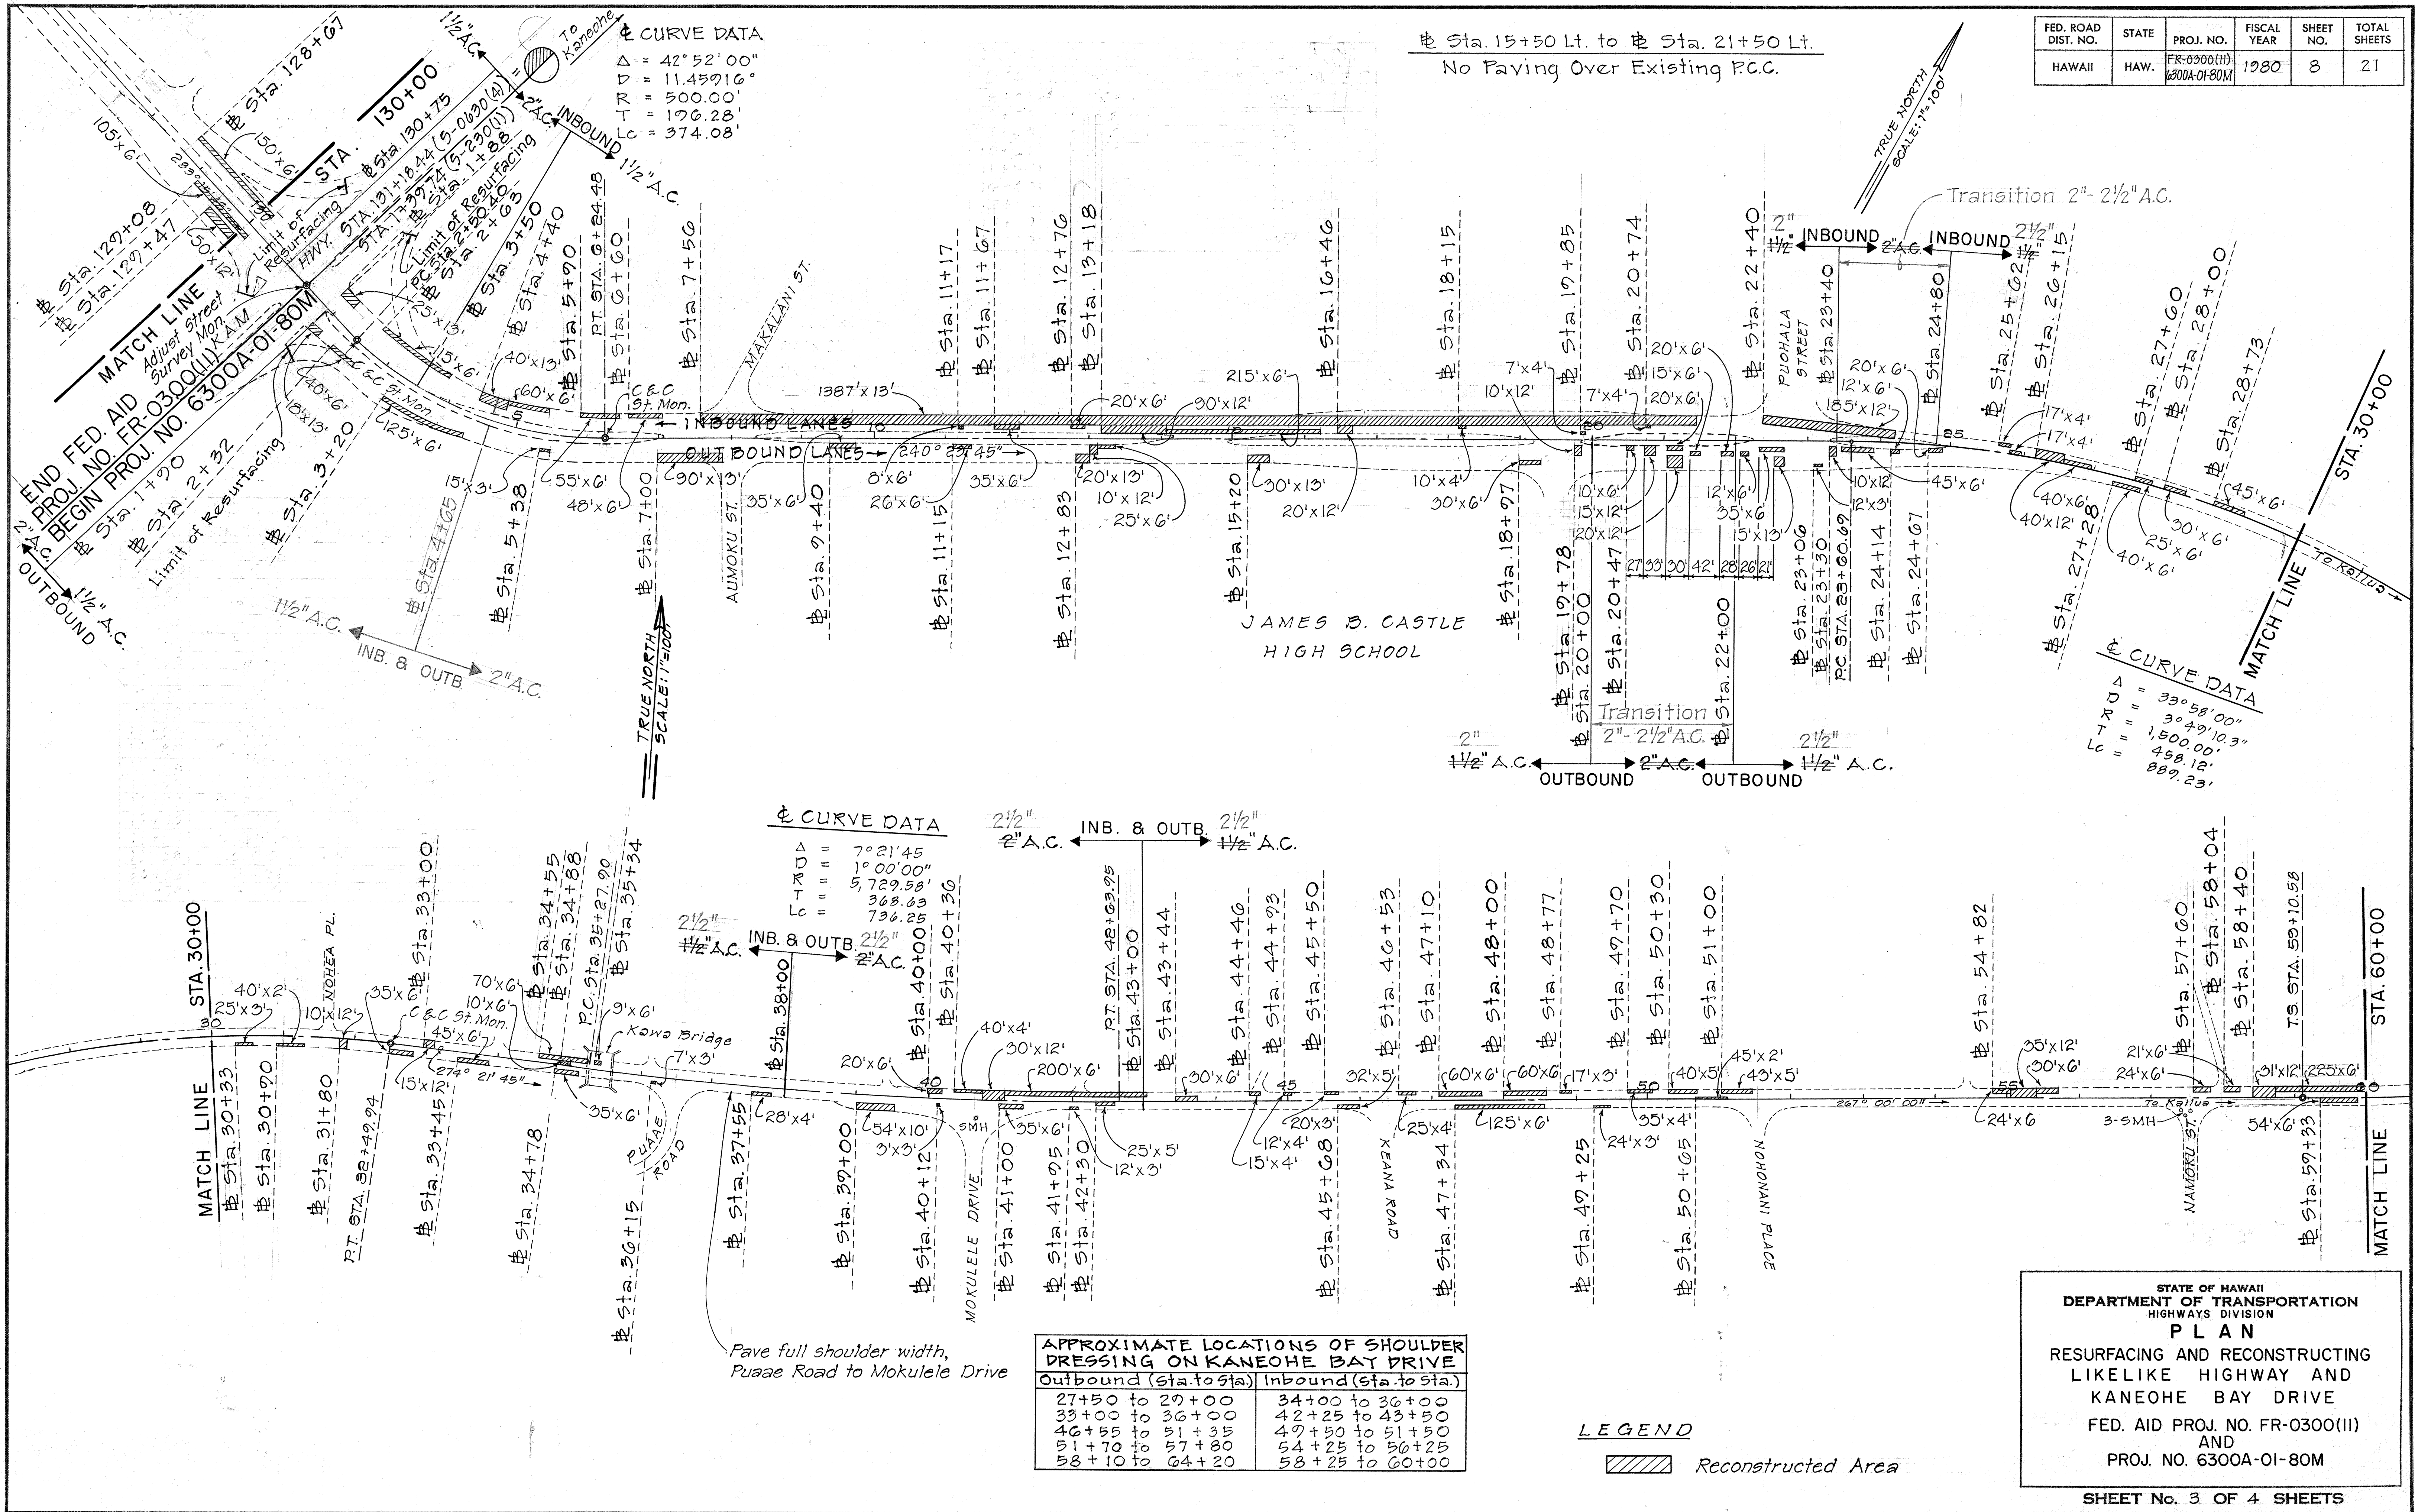

| FED. ROAD DIST. NO. | STATE | PROJ. NO.                    | FISCAL YEAR | SHEET NO. | TOTAL SHEETS |
|---------------------|-------|------------------------------|-------------|-----------|--------------|
| HAWAII              | HAW.  | FR-0300(III)<br>6300A-01-80M | 1980        | 8         | 21           |

APPROXIMATE LOCATIONS OF SHOULDER DRESSING ON KANEHOE BAY DRIVE

| Outbound (Sta. to Sta.) | Inbound (Sta. to Sta.) |
|-------------------------|------------------------|
| 27+50 to 29+00          | 34+00 to 36+00         |
| 33+00 to 36+00          | 42+25 to 43+50         |
| 46+55 to 51+35          | 47+50 to 51+50         |
| 51+70 to 57+80          | 54+25 to 56+25         |
| 58+10 to 64+20          | 58+25 to 60+00         |

LEGEND

Reconstructed Area

STATE OF HAWAII  
DEPARTMENT OF TRANSPORTATION  
HIGHWAYS DIVISION

PLAN

RESURFACING AND RECONSTRUCTING  
LIKELIKE HIGHWAY AND  
KANEHOE BAY DRIVE

FED. AID PROJ. NO. FR-0300(III)  
AND  
PROJ. NO. 6300A-01-80M

SHEET No. 3 OF 4 SHEETS

|           |                         |            |
|-----------|-------------------------|------------|
| ORIGINAL  | SURVEY PLOTTED BY _____ | DATE _____ |
| PLAN      | DRAWN BY _____          | _____      |
|           | TRACED BY _____         | _____      |
| NOTE BOOK | DESIGNED BY _____       | _____      |
|           | QUANTITIES BY _____     | _____      |
| No. _____ | CHECKED BY _____        | _____      |

