INDEX TO DRAWINGS	
SHEET NO.	DESCRIPTION
	TITLE SHEET
2	PLAN
3	TYPICAL WALKWAY SECTIONS AND PROFILE
4 – 8	FOOTBRIDGE PLAN AND DETAILS
• •	
·	

Feb., 1980 DATE

548-7537 PHONE

NISHIMURA
P. S. & E. BY

HWY-DB DESIGNED BY




STATE OF HAWAII

DEPARTMENT OF TRANSPORTATION
HIGHWAYS DIVISION
"AS BUILT"
PLANS FOR

WAIMEA RIVER FOOTBRIDGE

PROJECT NO. 83B - 01 - 78

DISTRICTS OF WAIALUA & KOOLAULOA ISLAND OF OAHU

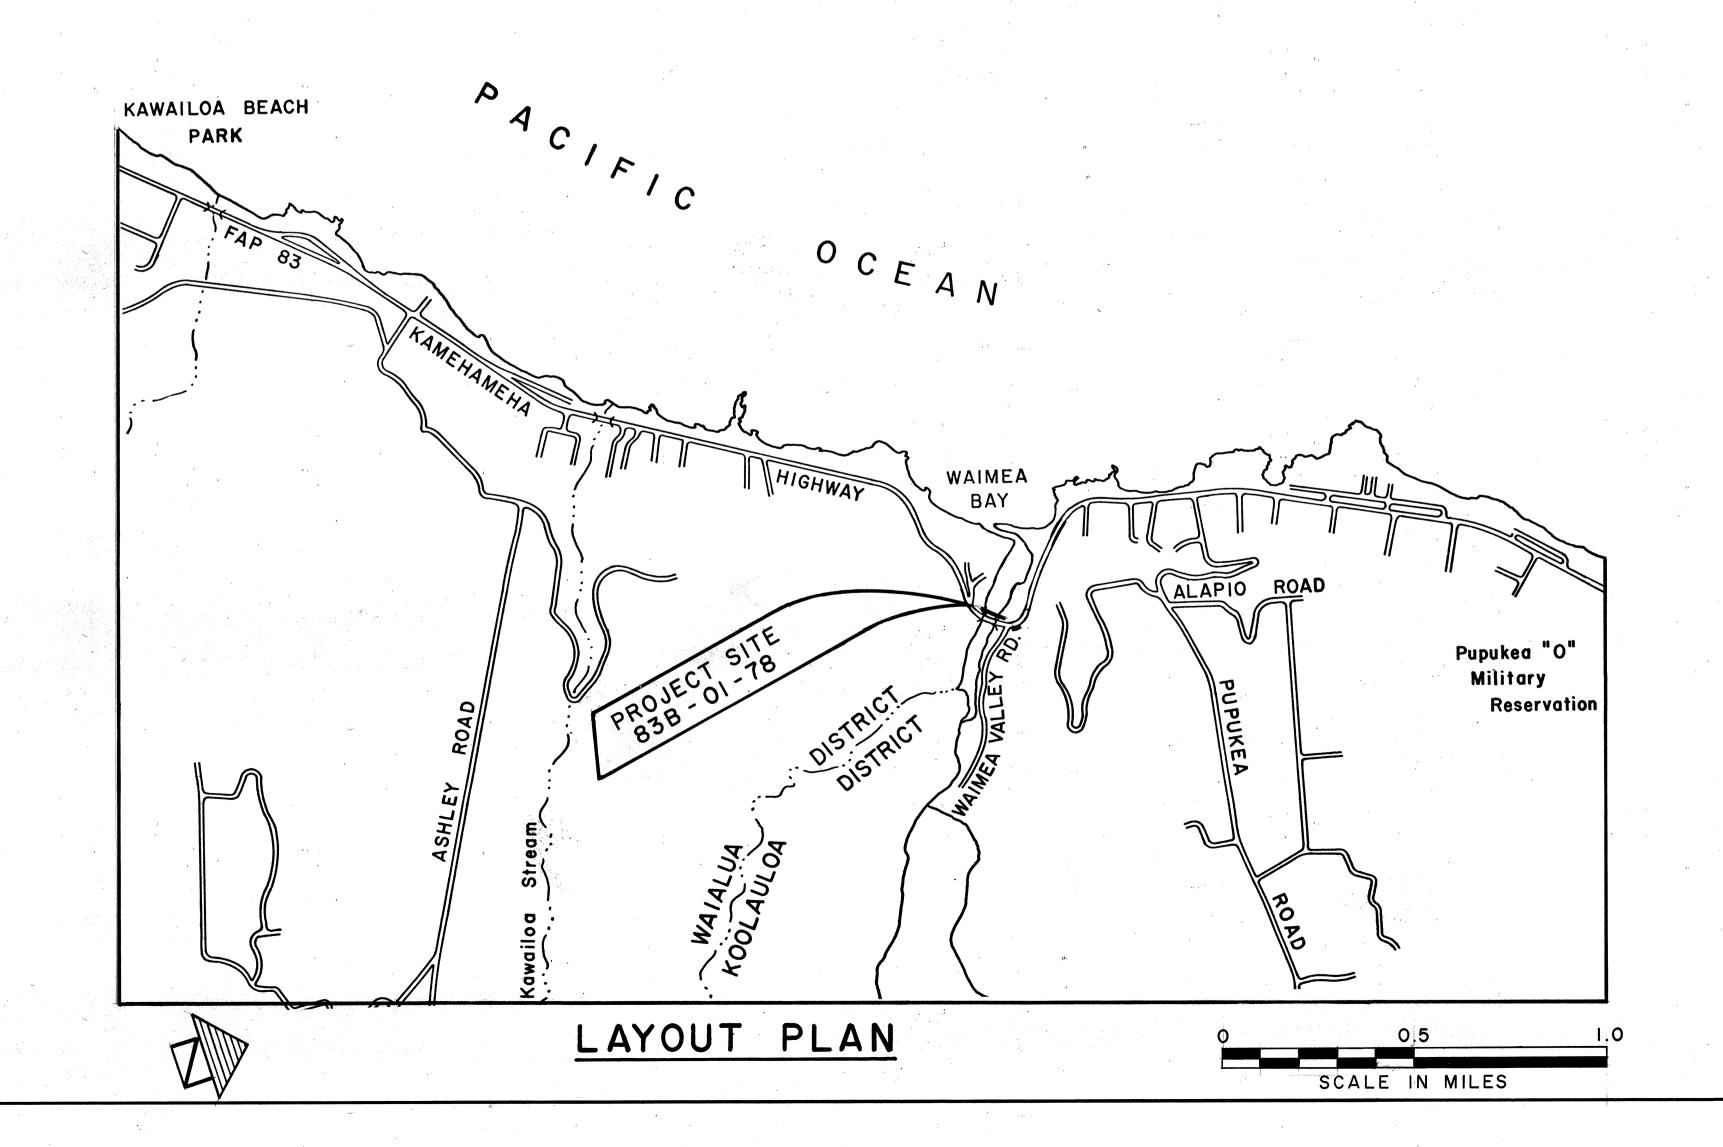

FED. ROAD DIST. NO. 83B-01-78 | 1980 | LOCATION OF PROJ. NO. 83B-01-78 STATE OF HAWAII ALL CHANGES MADE DURING CONSTRUCTION HAVE BEEN INCORPORATED ON THESE PLANS IN RED EXCEPT CHANGES IN THE ORIGINAL THEORETICAL QUANTITIES, REFER TO PROJECT LEDGER AND/OR COMPUTATION BOOK. FEB. 5,1981 DATE RESIDENT ENGINEER DEPARTMENT OF TRANSPORTATION STATE OF HAWAII APPROVED: