


FED. ROAD DIST. NO.	STATE	PROJ. NO.	FISCAL YEAR	SHEET NO.	TOTAL SHEETS
HAWAII	HAW.	NH-083-(K082)	2022	54	99

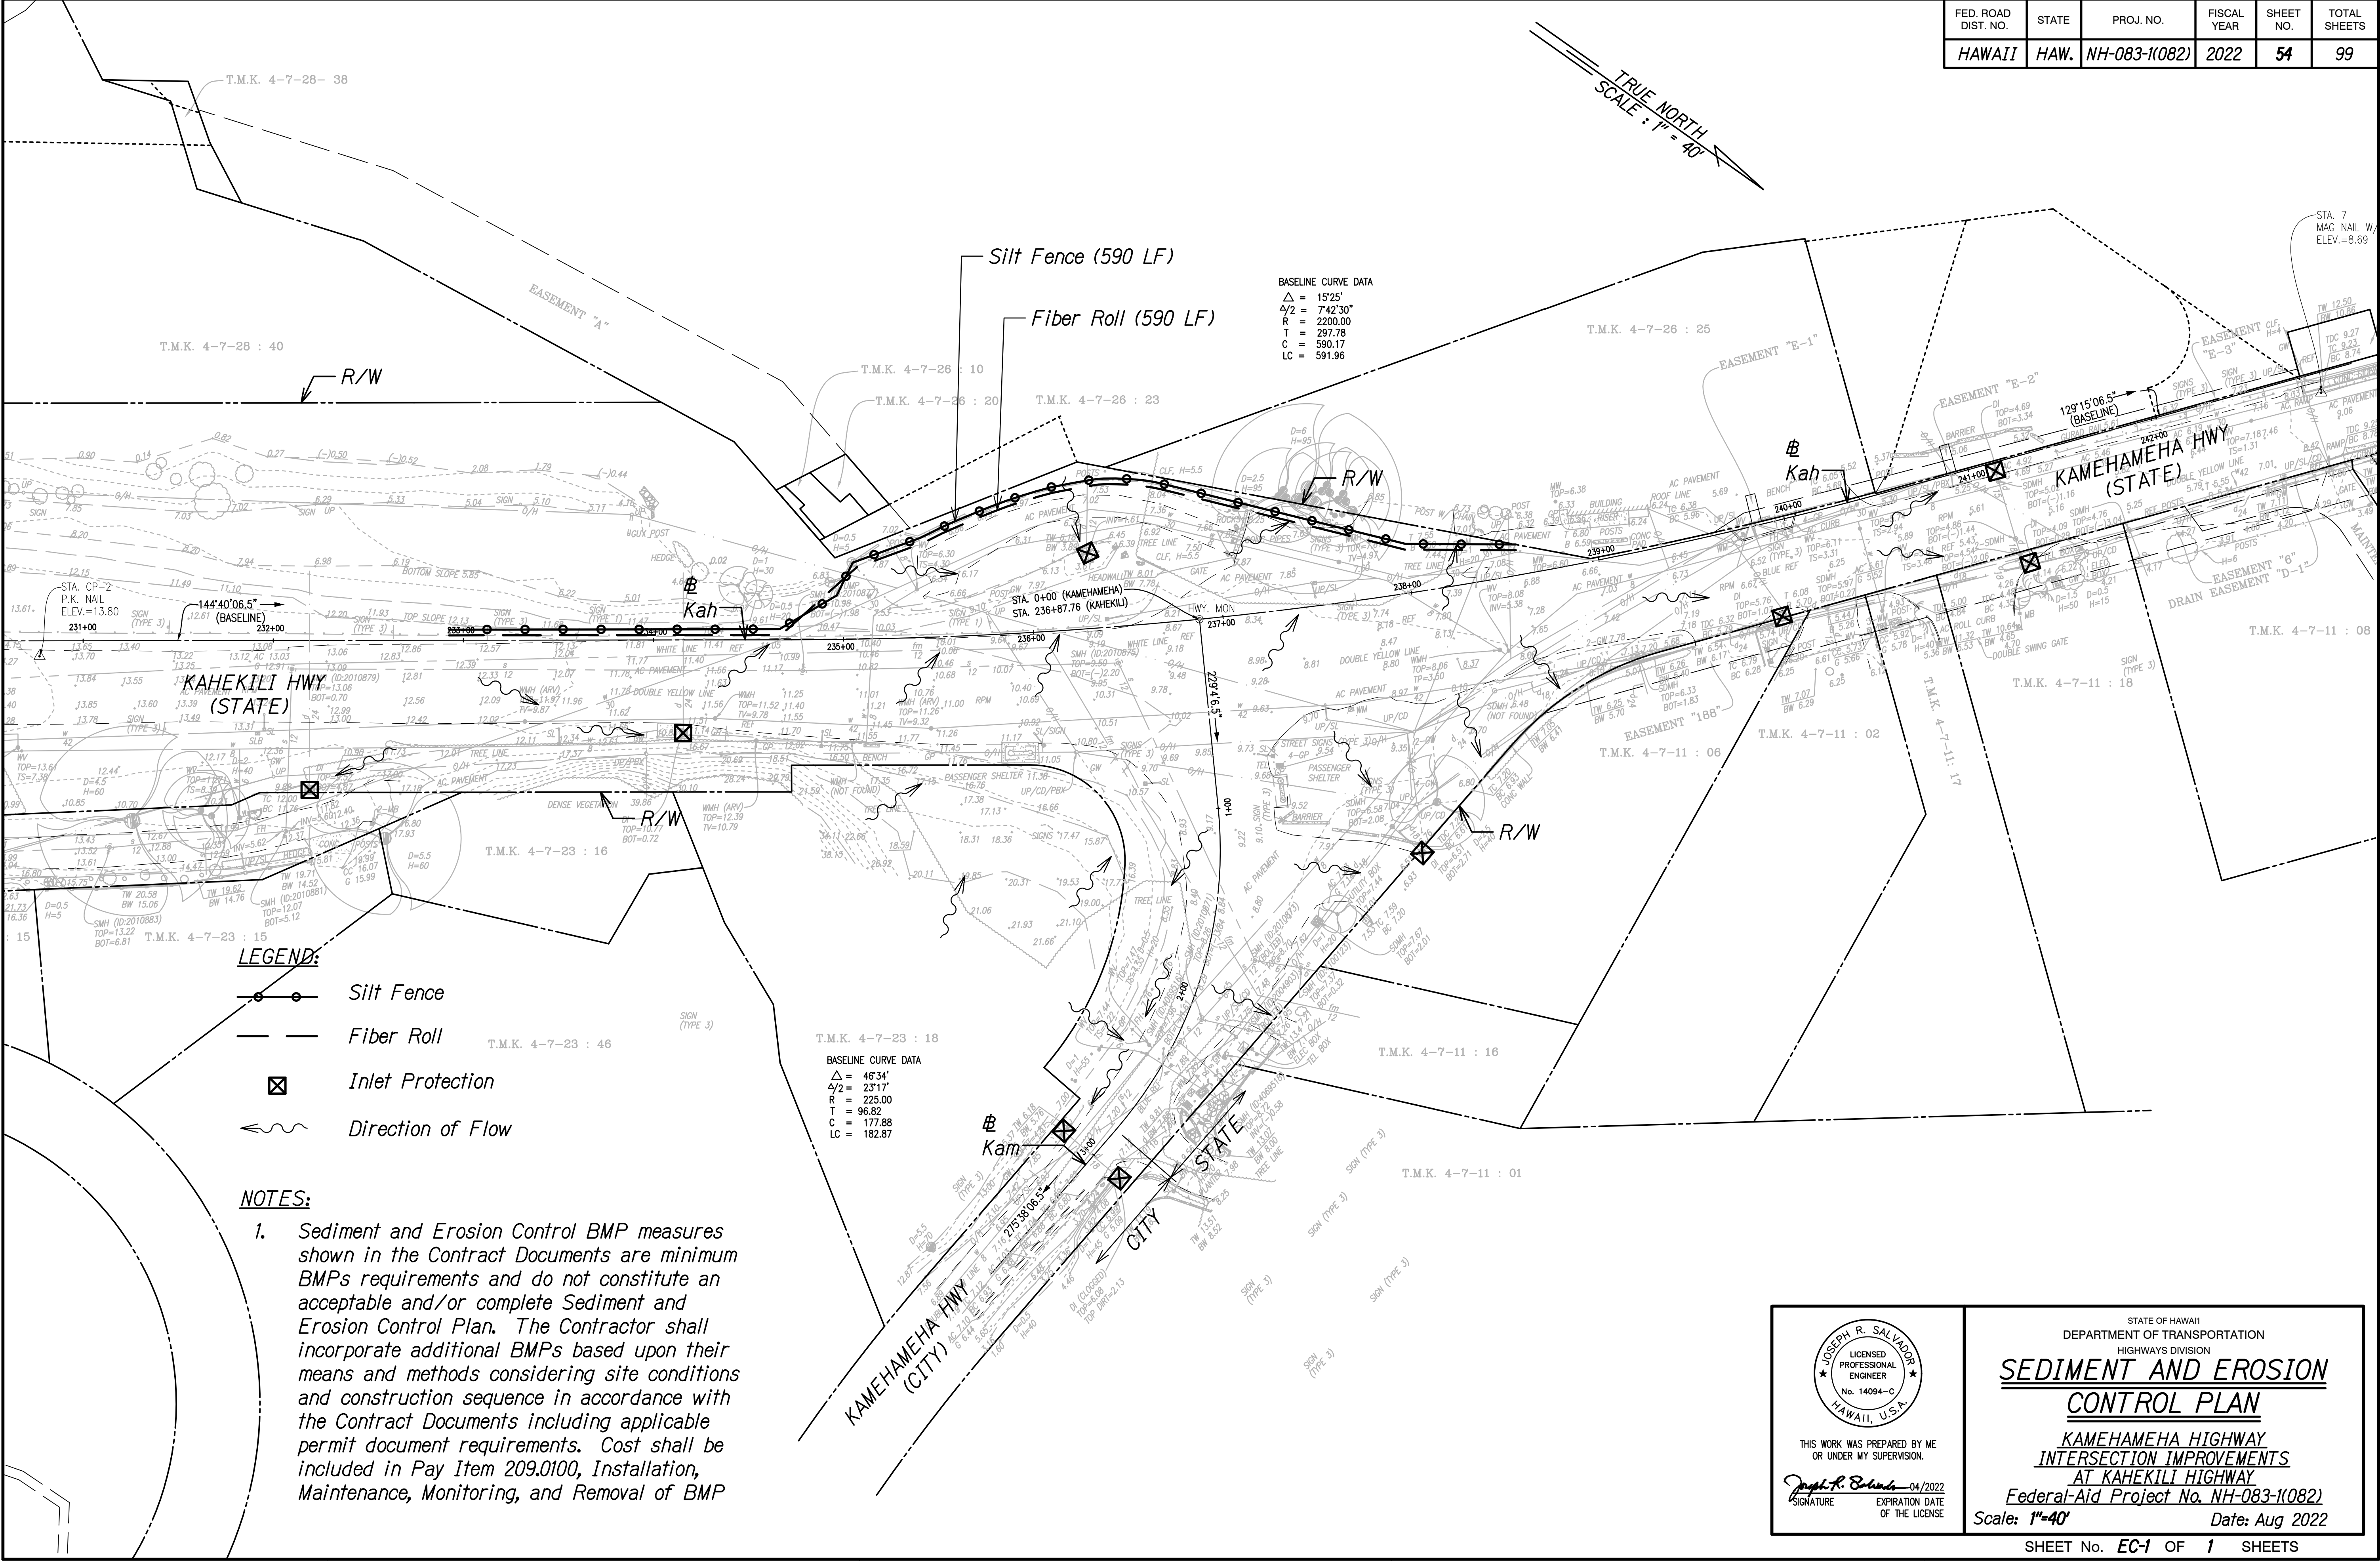

JOSEPH R. SALVADOR

LICENSED PROFESSIONAL ENGINEER

No. 14094-C

HAWAII, U.S.A.

THIS WORK WAS PREPARED BY ME OR UNDER MY SUPERVISION.

Signature

EXPIRATION DATE OF THE LICENSE

STATE OF HAWAII

DEPARTMENT OF TRANSPORTATION

HIGHWAYS DIVISION

SEDIMENT AND EROSION CONTROL PLAN

KAMEHAMEHA HIGHWAY INTERSECTION IMPROVEMENTS AT KAEKILI HIGHWAY

Federal-Aid Project No. NH-083-(K082)

Scale: 1"=40'

Date: Aug 2022

SHEET No. EC-1 OF 1 SHEETS

54