



FED. ROAD DIST. NO.	STATE	PROJ. NO.	FISCAL YEAR	SHEET NO.	TOTAL SHEETS
HAWAII	HAW.	NH-083-1(082)	2022	15	99

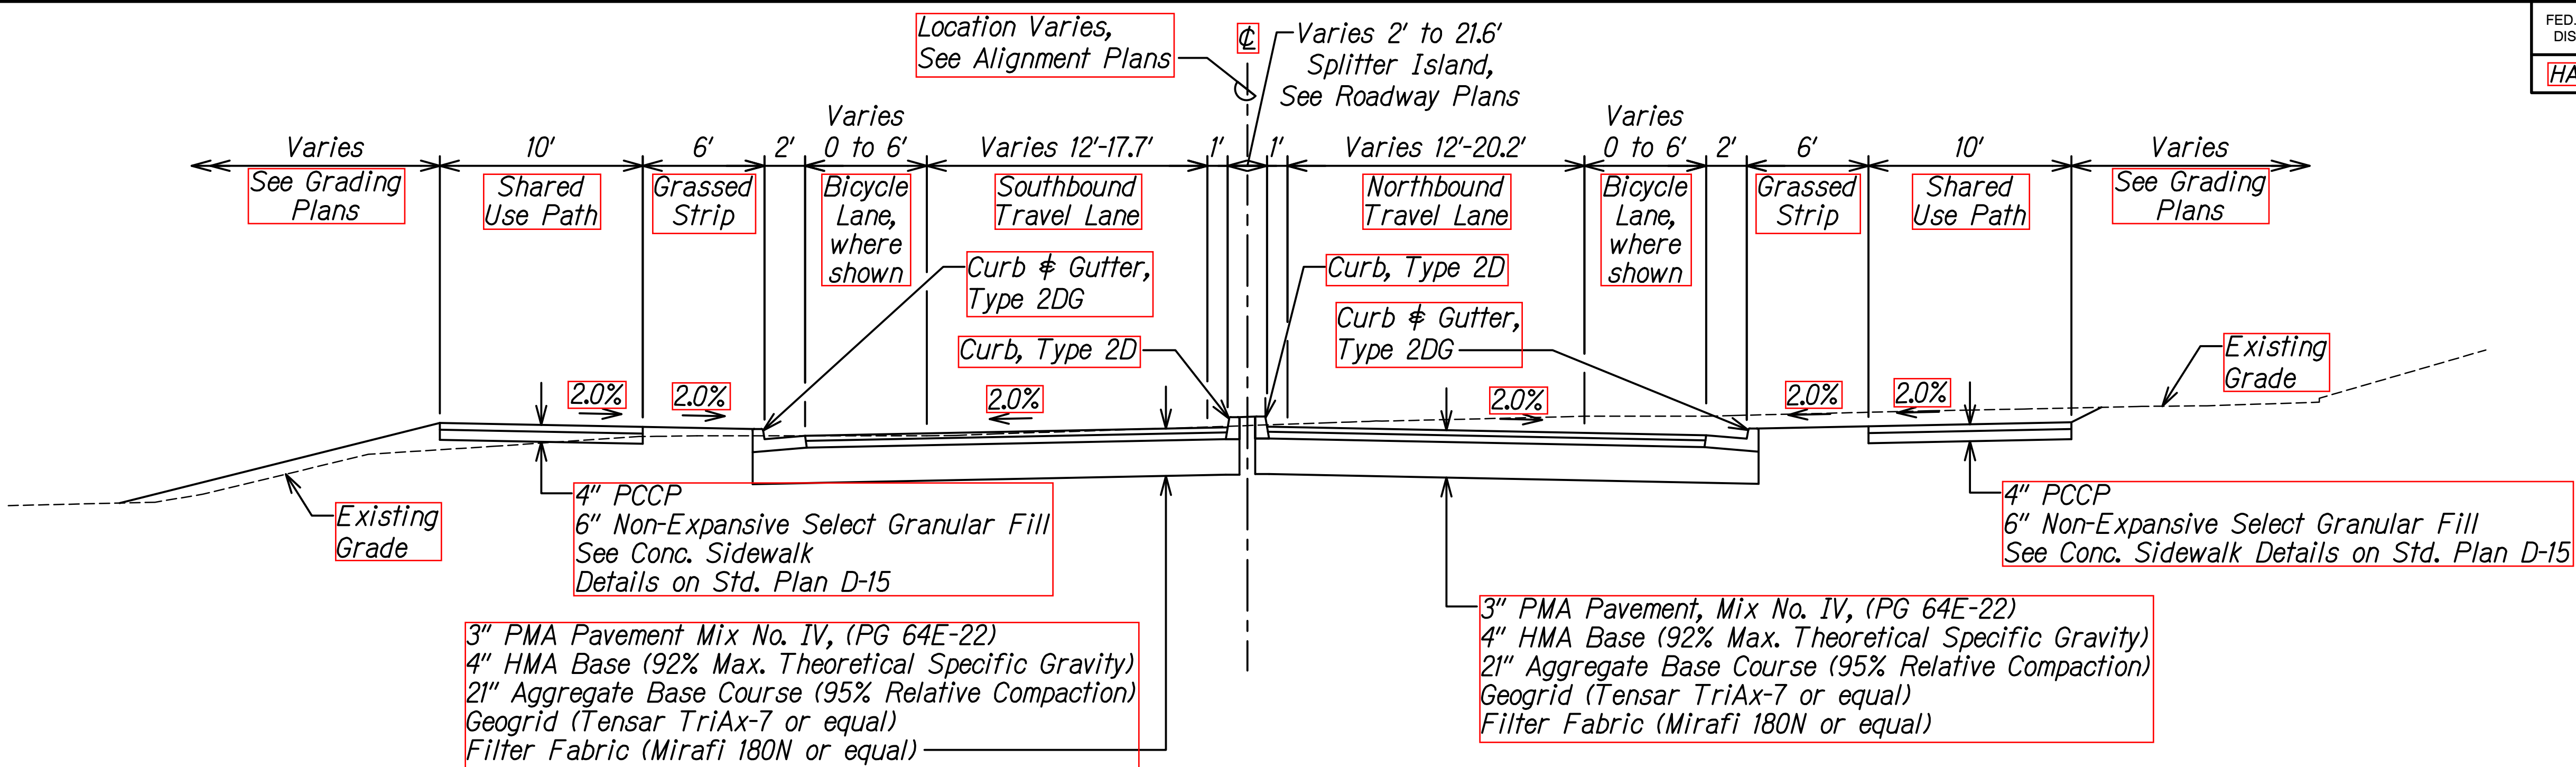


TYPICAL SECTION - ROADWAY INTERSECTION APPROACH

Scale: 1" = 5'

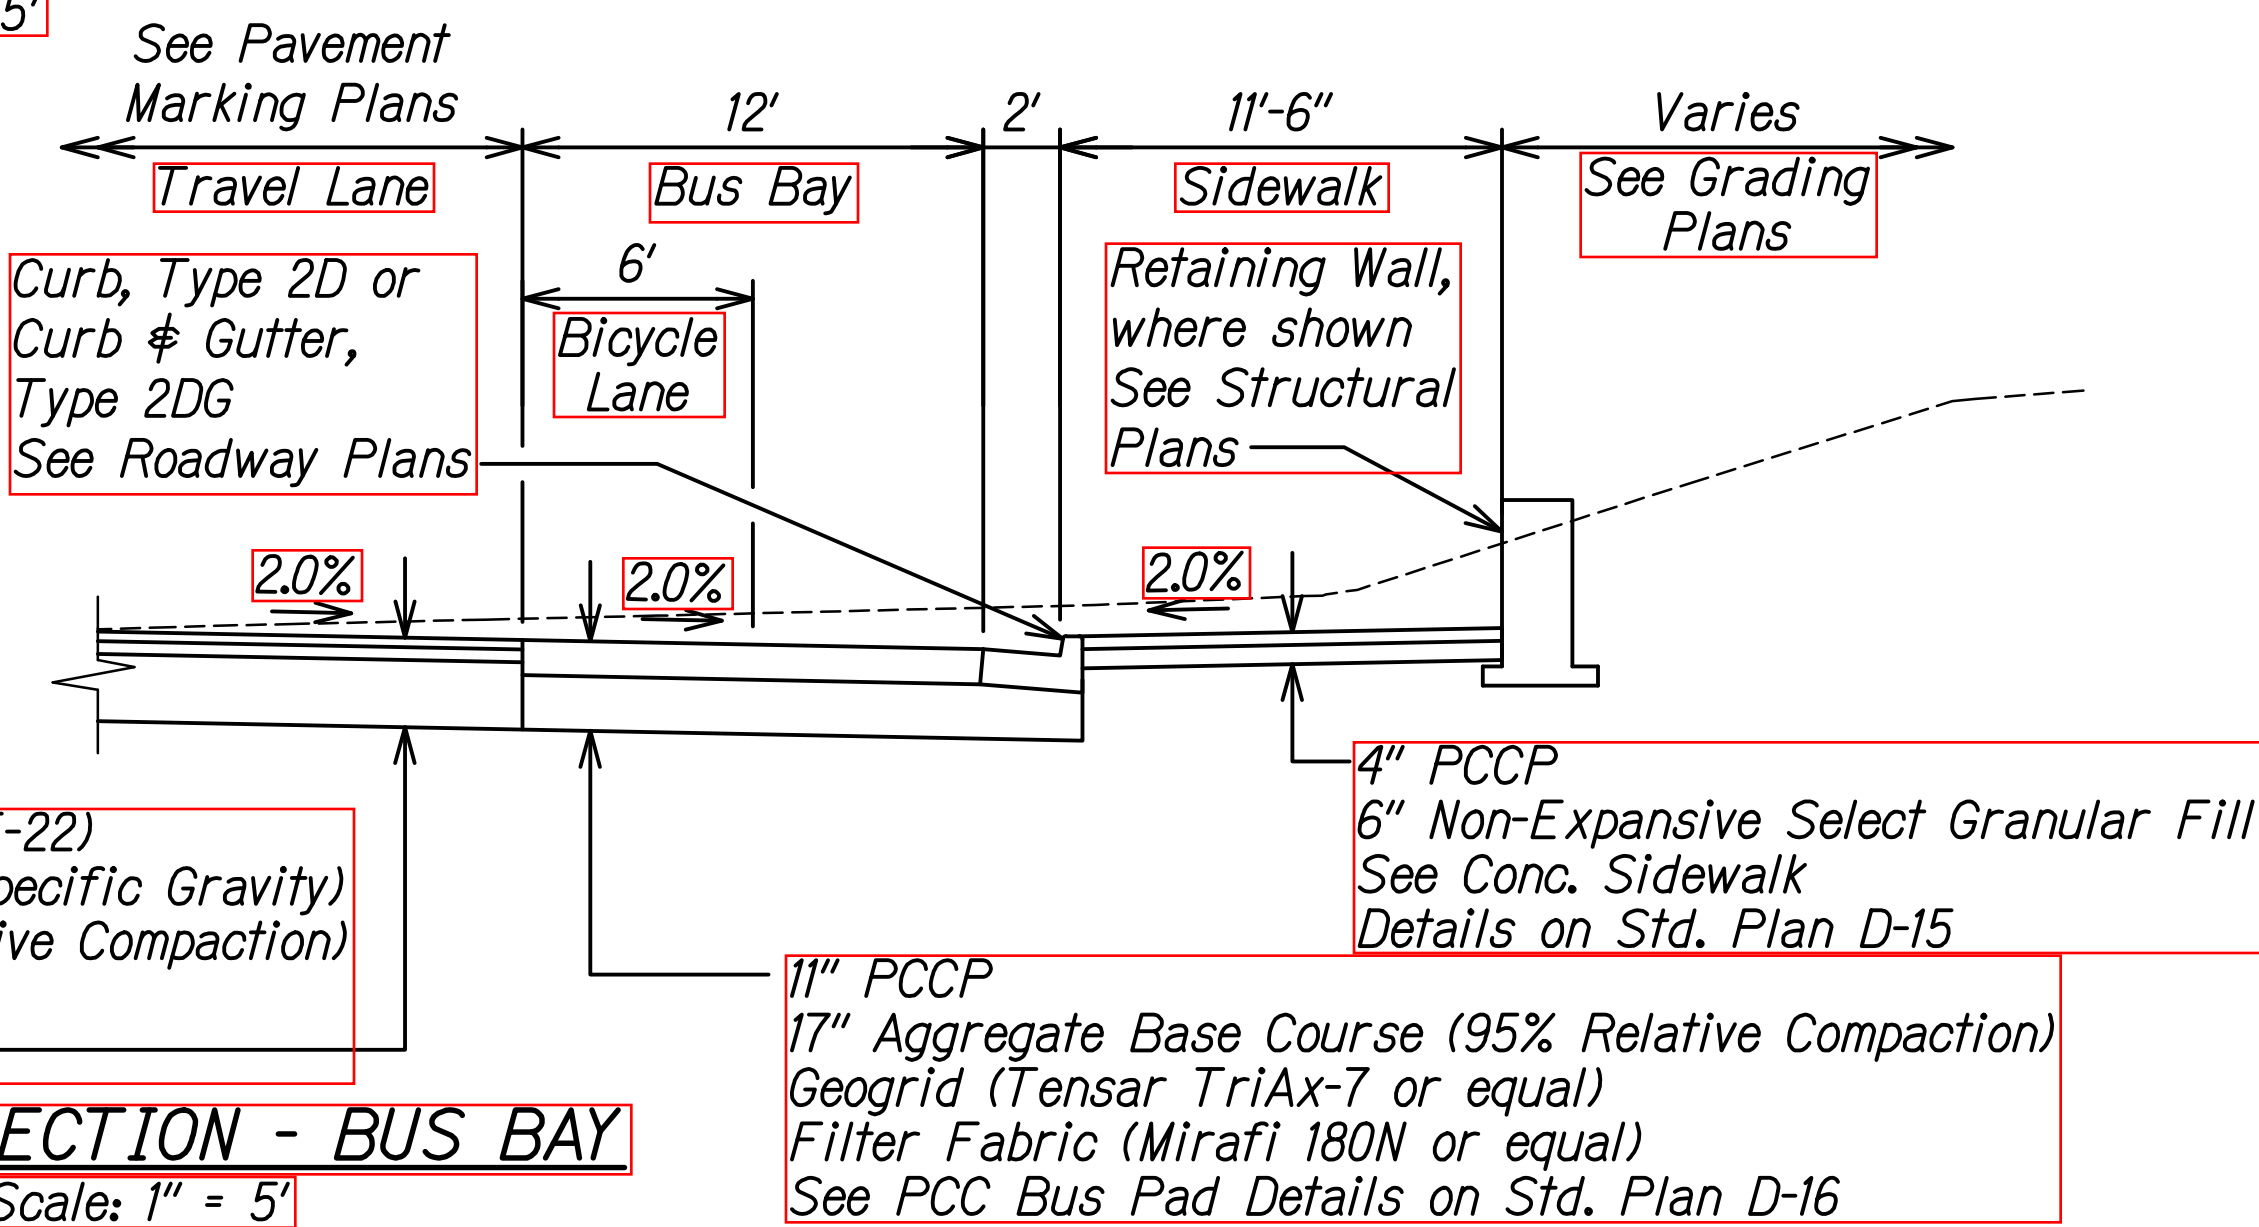

TYPICAL SECTION - BUS BAY

Scale: 1" = 5'

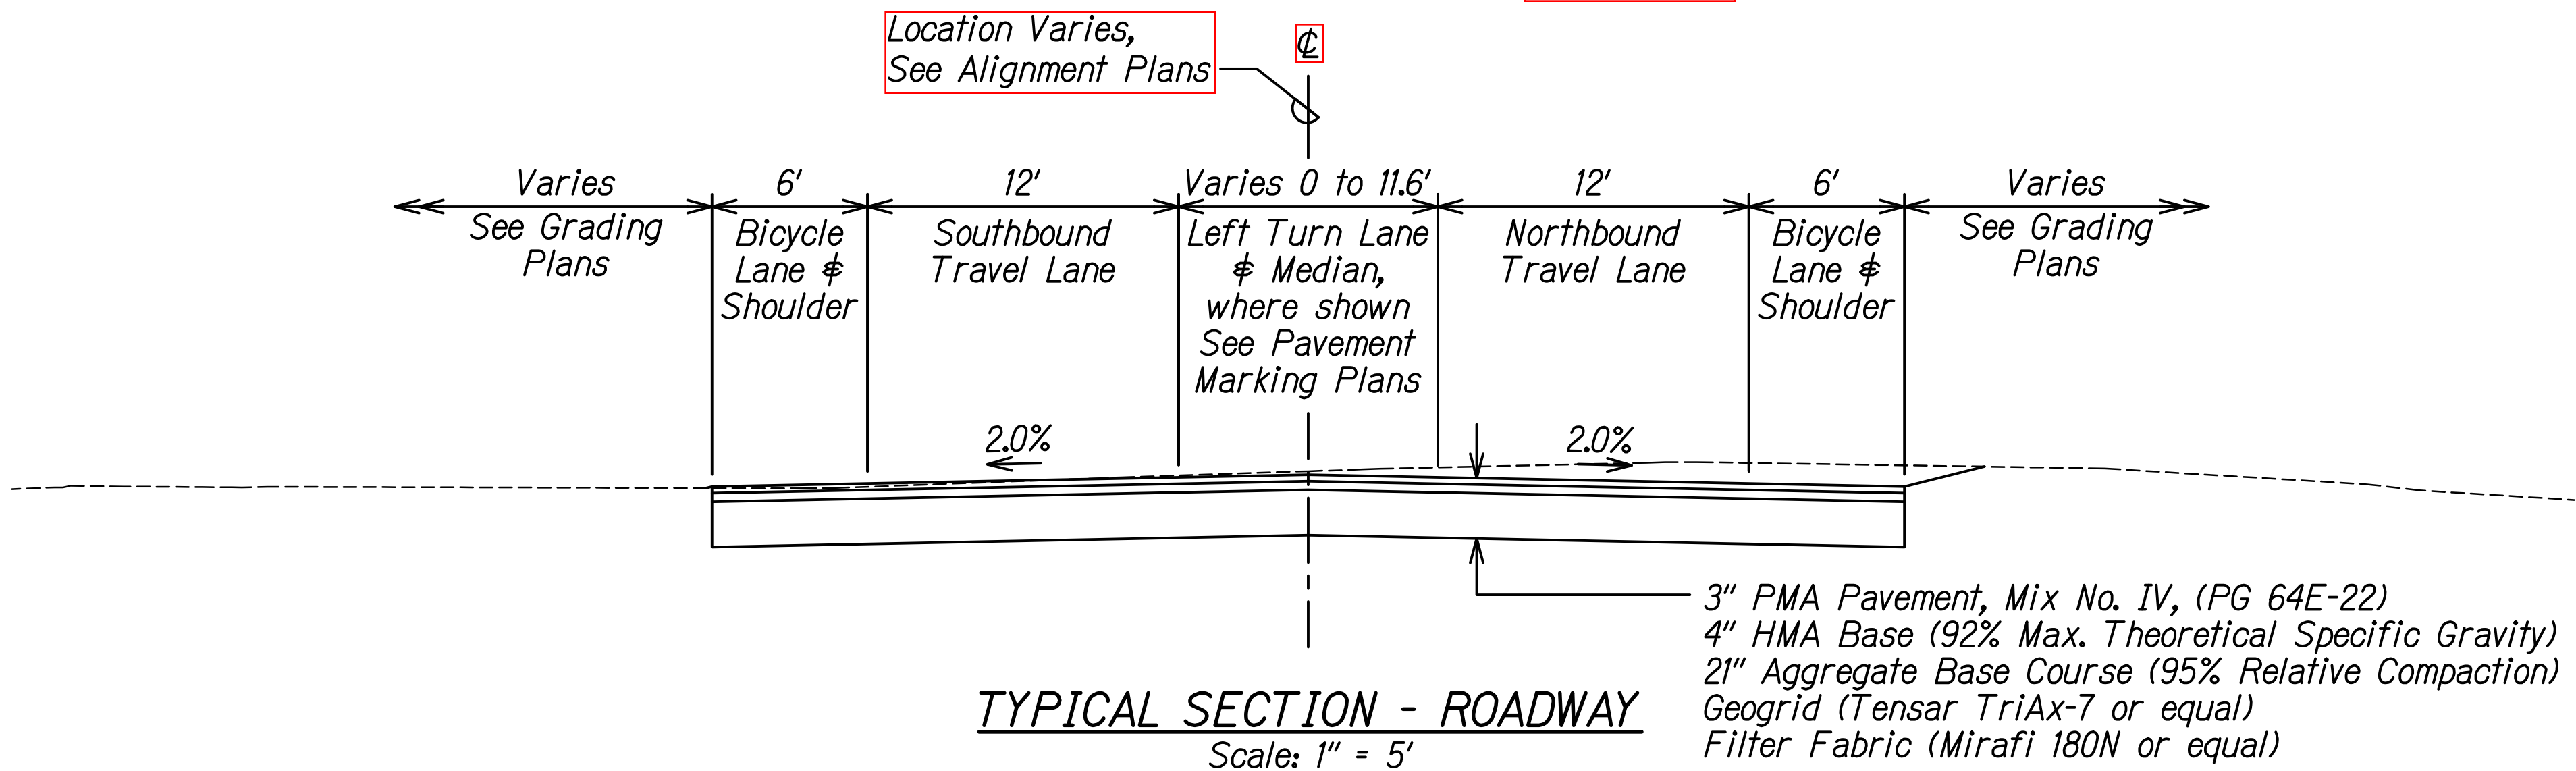

TYPICAL SECTION - ROADWAY

Scale: 1" = 5'

DATE	08/08/22
SURVEY PLOTTED BY	_____
DRAWN BY	_____
DESIGNED BY	_____
QUANTITIES BY	_____
CHECKED BY	_____
ORIGINAL PLAN	_____
NOTE BOOK	_____
No.	_____

THIS WORK WAS PREPARED BY ME OR UNDER MY SUPERVISION.

Joseph R. Salvador 04/2022
SIGNATURE EXPIRATION DATE OF THE LICENSE


STATE OF HAWAII
DEPARTMENT OF TRANSPORTATION
HIGHWAYS DIVISION

TYPICAL SECTIONS - 1

KAMEHAMEHA HIGHWAY
INTERSECTION IMPROVEMENTS
AT KAHAKULI HIGHWAY
Federal-Aid Project No. NH-083-1(082)


Scale: 1" = 5' Date: Sept. 2022

FED. ROAD DIST. NO.	STATE	PROJ. NO.	FISCAL YEAR	SHEET NO.	TOTAL SHEETS
HAWAII	HAW.	NH-083-1(082)	2022	16	99

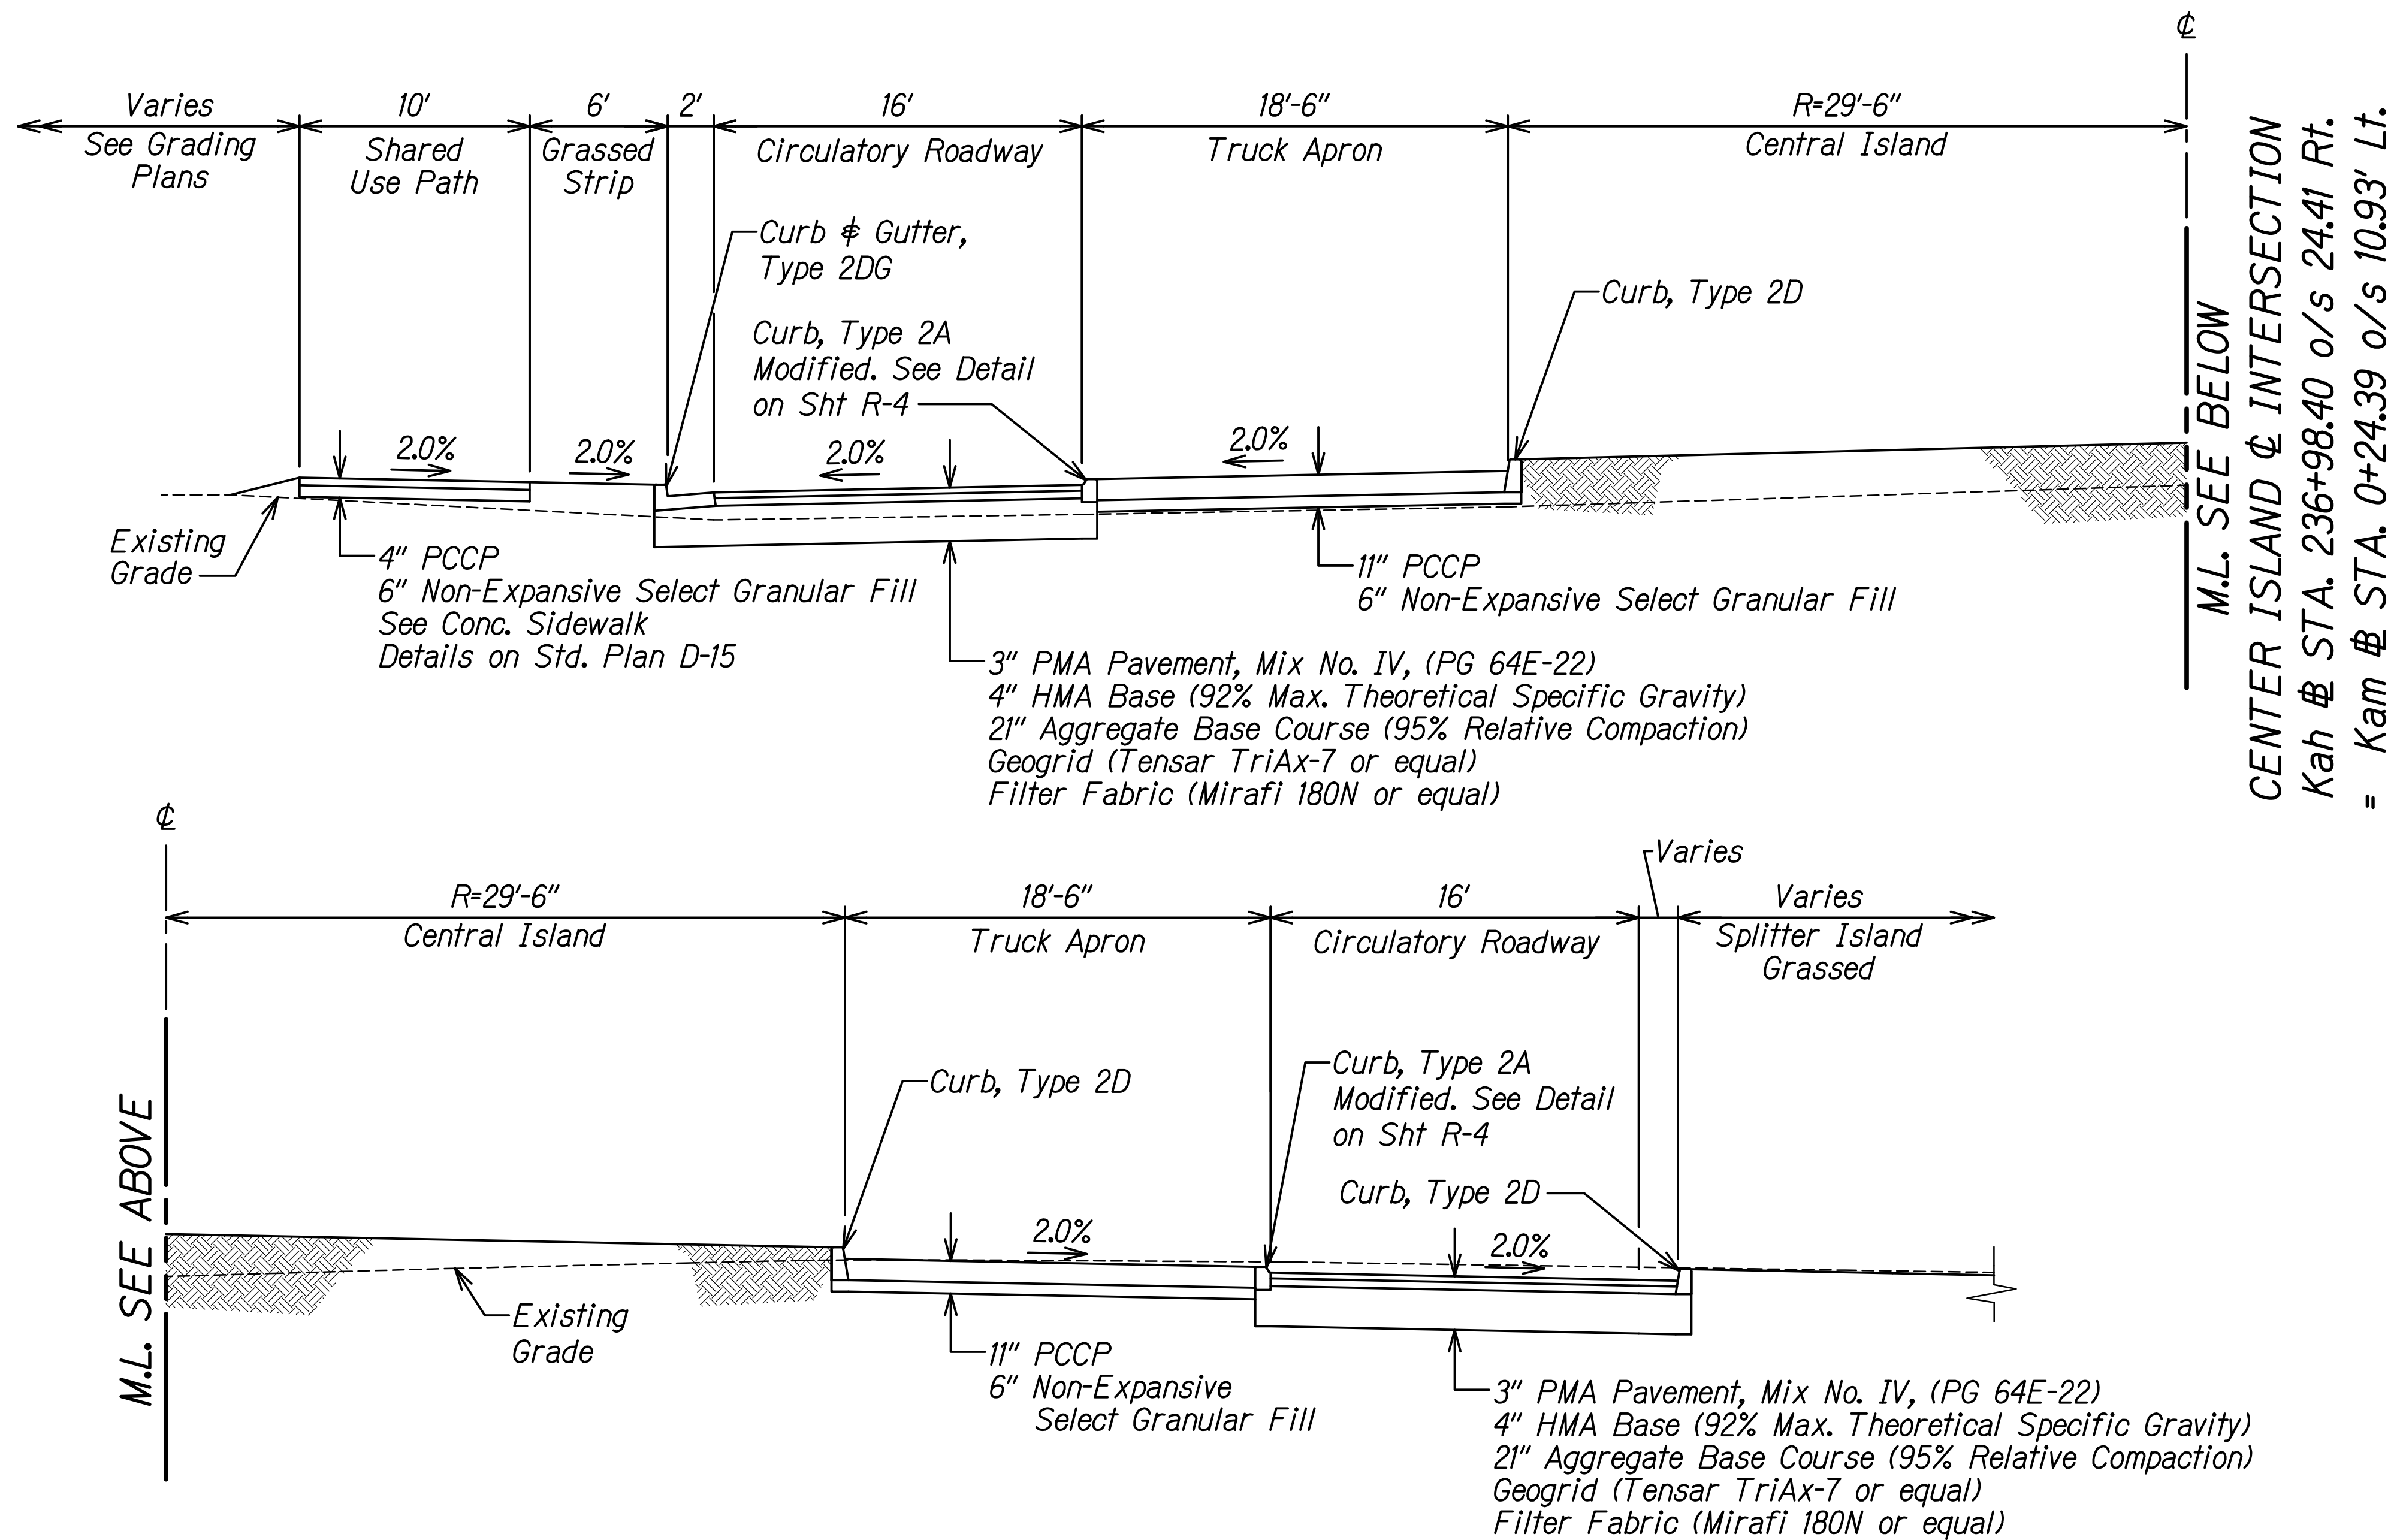

**TYPICAL SECTION - KAMEHAMEHA HIGHWAY
ROUNDBOUT AT KAHEKILI ALONG & INTERSECTION**
Scale: 1" = 5'

DATE	____
SURVEY PLOTTED BY	____
DRIVEN BY	____
TRACED BY	____
DESIGNED BY	____
QUANTITIES BY	____
CHECKED BY	____
ORIGINAL PLAN	____
NOTE BOOK	____
No.	____

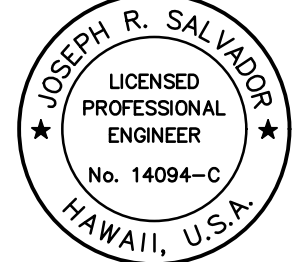 THIS WORK WAS PREPARED BY ME OR UNDER MY SUPERVISION. <i>Joseph R. Salvador</i> SIGNATURE 04/2022 EXPIRATION DATE OF THE LICENSE	STATE OF HAWAII DEPARTMENT OF TRANSPORTATION HIGHWAYS DIVISION
	TYPICAL SECTIONS - 2
	KAMEHAMEHA HIGHWAY INTERSECTION IMPROVEMENTS AT KAHEKILI HIGHWAY
	Federal-Aid Project No. NH-083-1(082) Scale: 1" = 5' Date: Sept. 2022