





FED. ROAD DIST. NO.	STATE	FED. AID. PROJ. NO.	FISCAL YEAR	SHEET NO.	TOTAL SHEETS
HAWAII	HAW.	BR-083-1(42)	2009	C.O.37	121

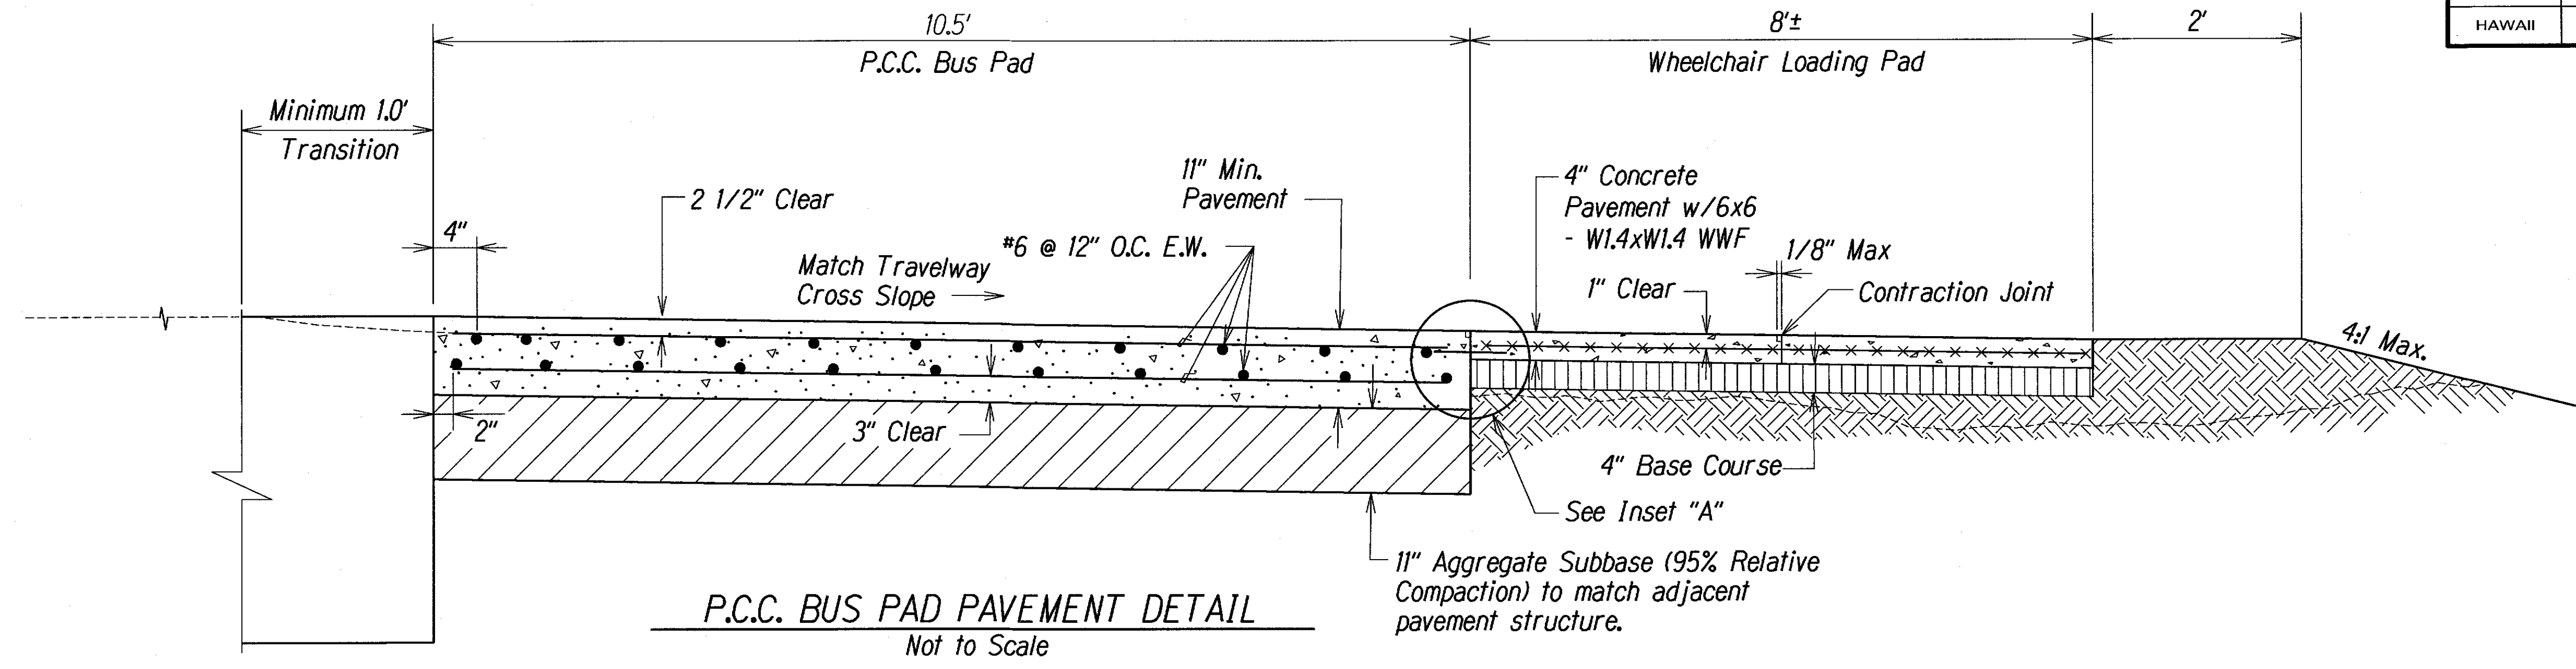

Provide a constant grade on the New P.C.C. Bus Pad and match adjacent A.C. Pavement to the New Bus Pad within the transition area

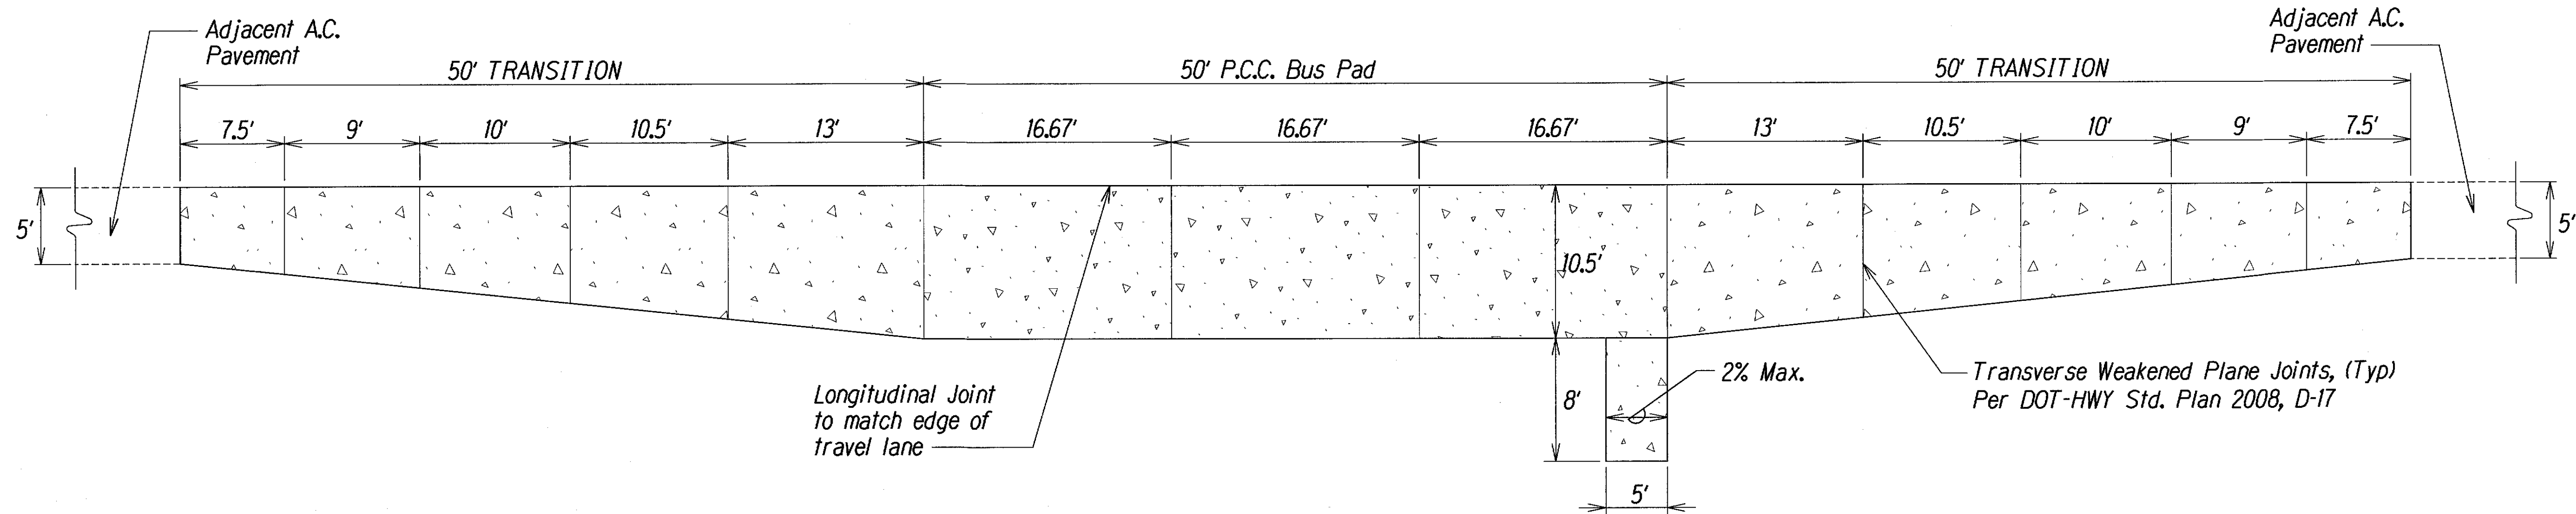

- Note:
1. Provide Continuously Reinforced Bus Pad w/ Transverse Weakened Plane Joints
  2. Refer to DOT-HWY Standard Plan 2008 (D-16 - D-21) for Bus Pad Details

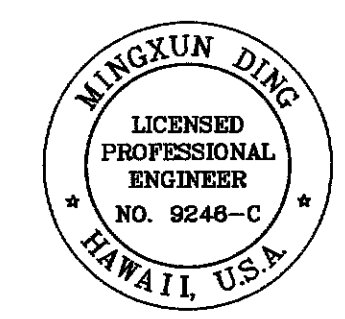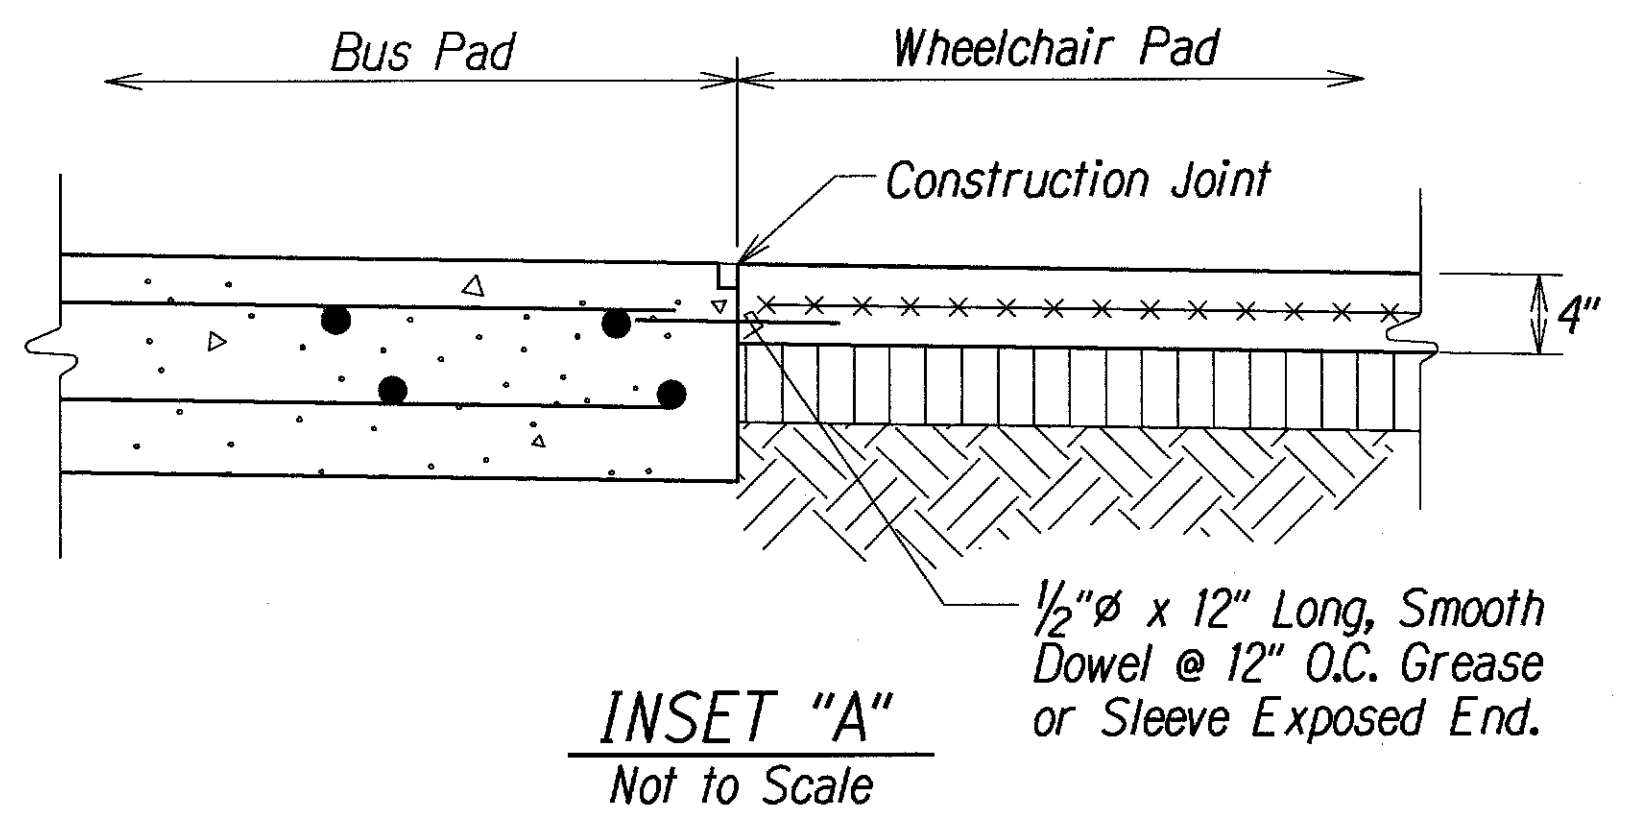

THIS WORK WAS PREPARED BY ME OR UNDER MY SUPERVISION.  
 SIGNATURE: *LP-18* EXPIRATION DATE OF LICENSE: 4/30/16

3/13/12 [1] Revised detail

STATE OF HAWAII  
 DEPARTMENT OF TRANSPORTATION  
 HIGHWAYS DIVISION

**BUS BAY DETAILS**

KAMEHAMEHA HIGHWAY - REPLACEMENT  
 OF SOUTH PUNALUU STREAM BRIDGE  
 Federal Aid Project No. BR-083-1(42)

Scale: \_\_\_\_\_ Date: May 2009

SHEET No. C37 OF 40 SHEETS

DESIGNED BY	DATE
DRAWN BY	
CHECKED BY	
APPROVED BY	
ORIGINAL PLAN	
NOTE BOOK	
QUANTITIES BY	
CHECKED BY	