


FED.ROAD DIST.NO.	STATE	PROJ. NO.	FISCAL YEAR	SHEET NO.	TOTAL SHEETS
OAHU	HAW.	83G-01-10	2011	23	38



LEGEND FOR AS-BUILT POSTINGS

- ~~~~~ Squiggly line for as-built deletion
- ~~100.00~~ Double line for as-built deletion
- Roadway Text for as-built posting

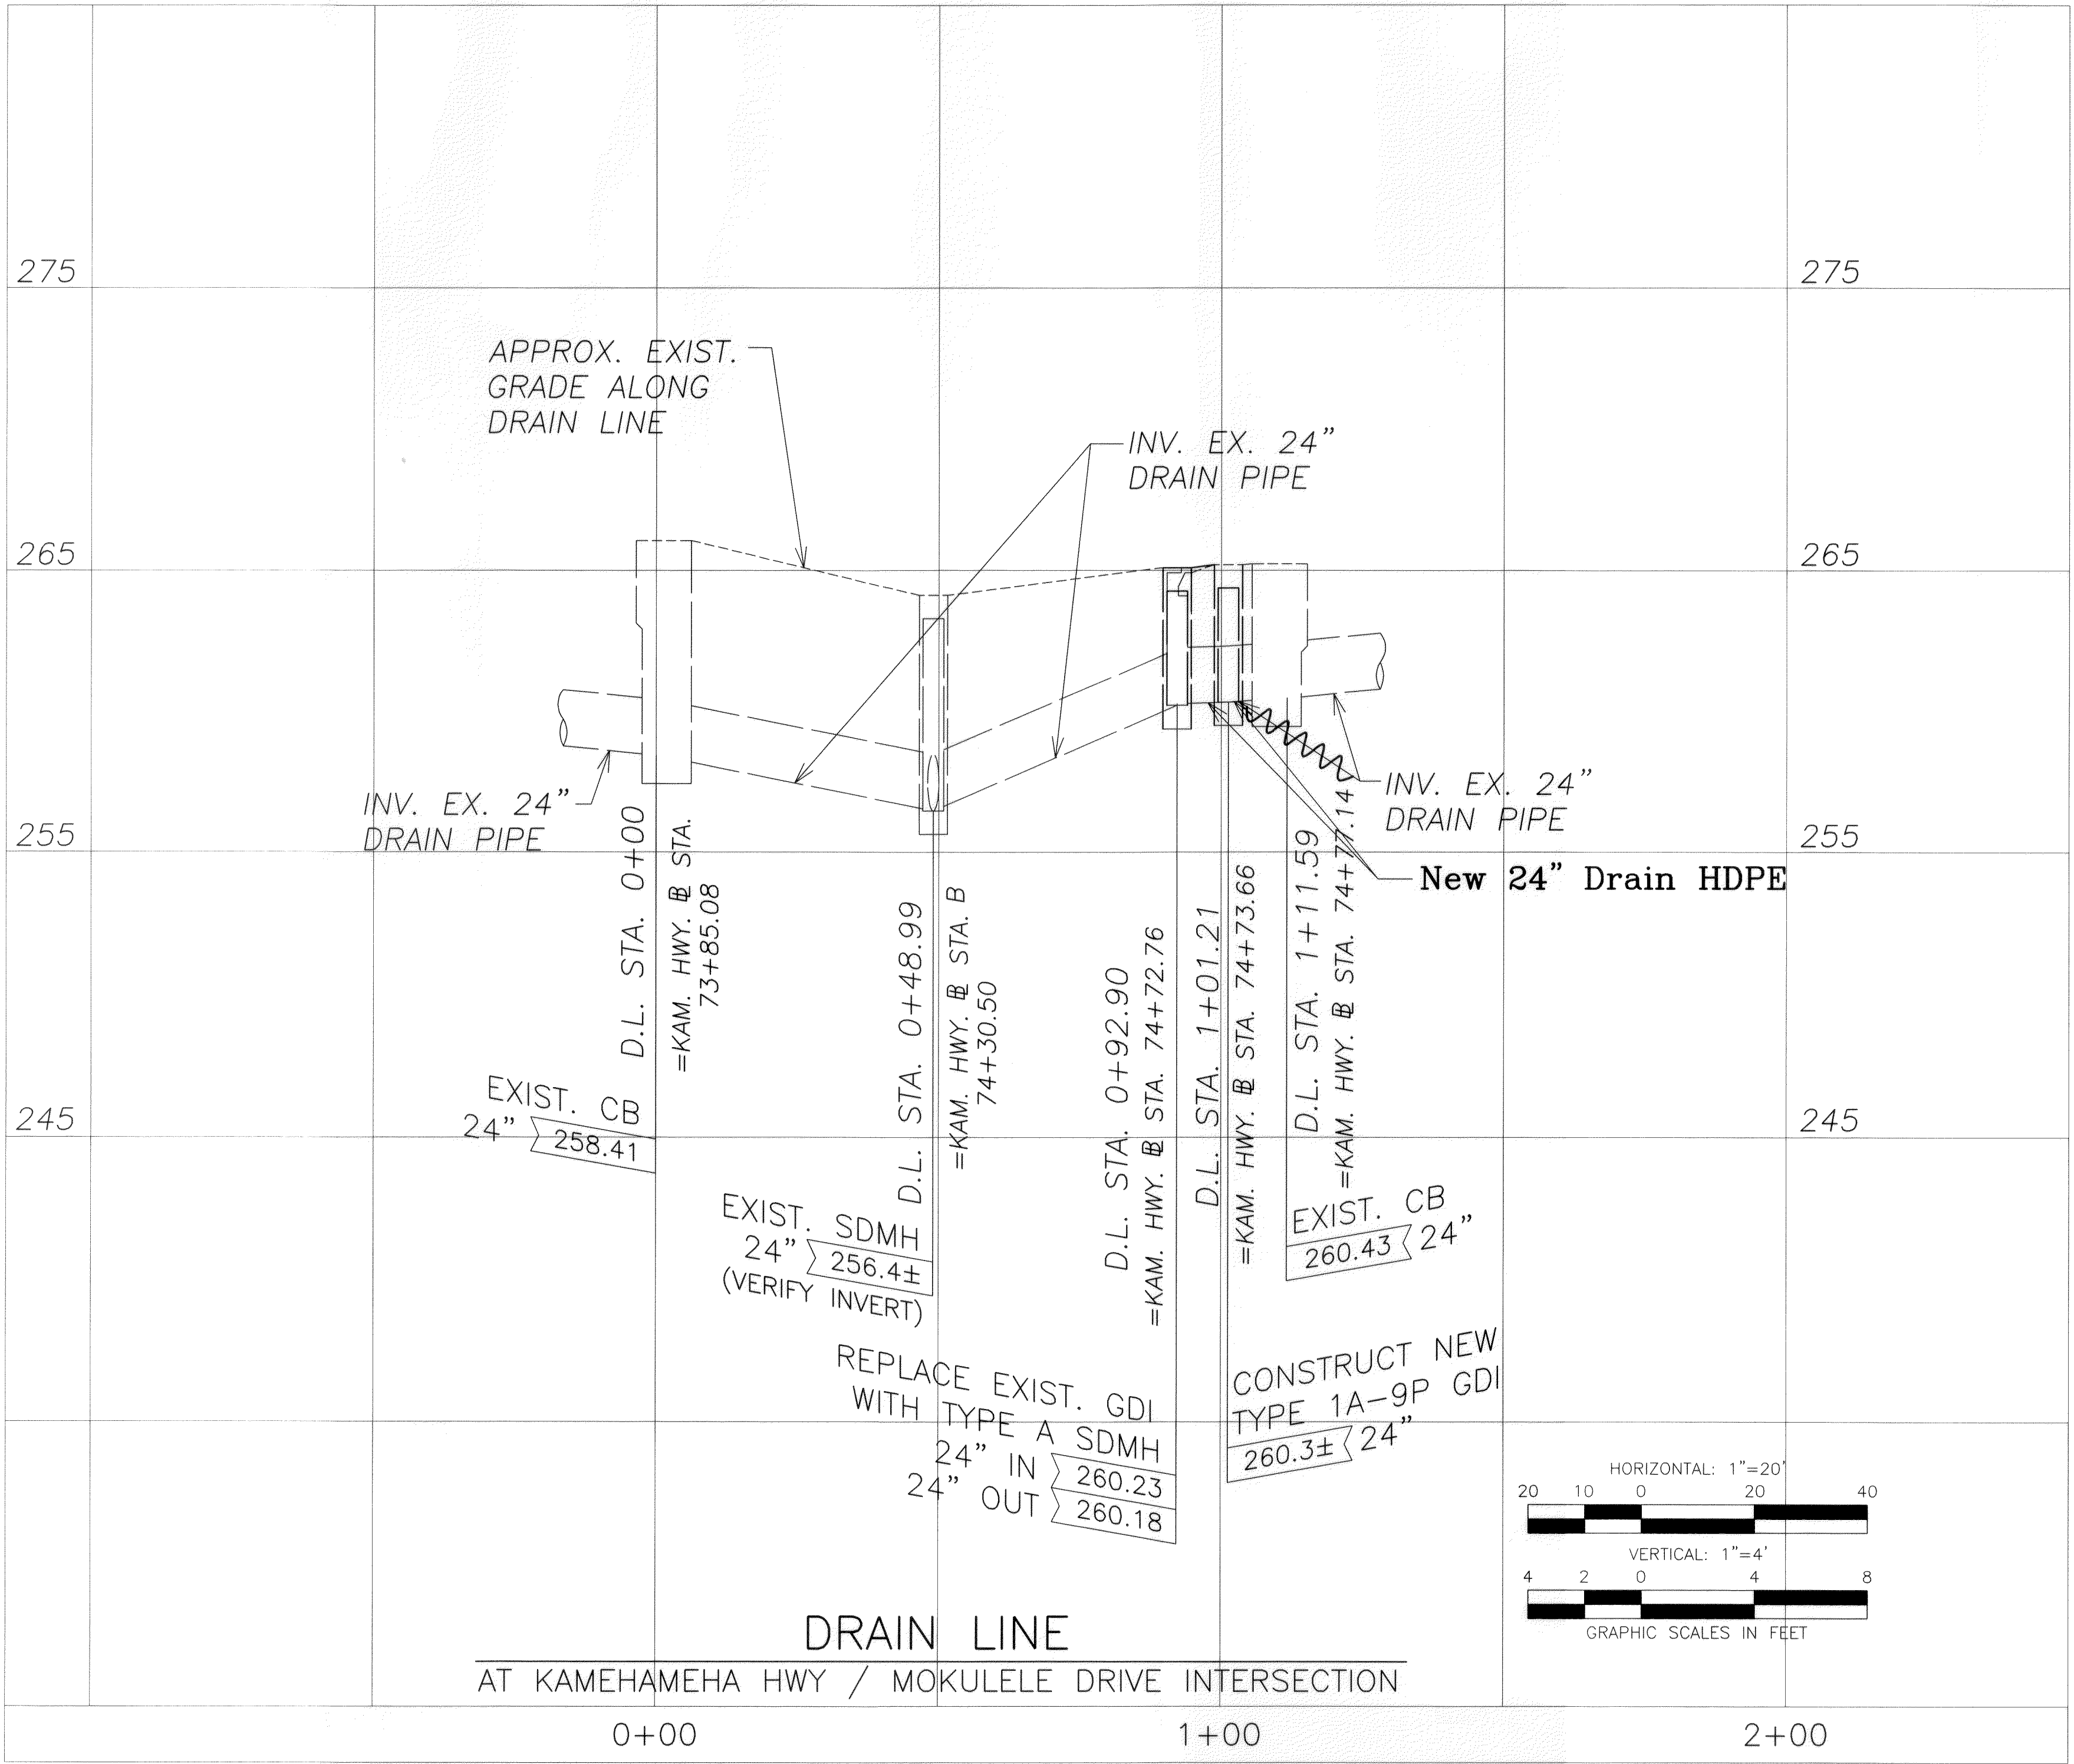

THIS WORK WAS PREPARED BY ME OR UNDER MY SUPERVISION AND CONSTRUCTION OF THIS PROJECT WILL BE UNDER MY OBSERVATION. ("OBSERVATION OF CONSTRUCTION" SHALL BE AS DEFINED IN CHAPTER 115, RULES OF THE BOARD OF PROFESSIONAL ENGINEERS, ARCHITECTS AND SURVEYORS, STATE OF HAWAII, SUBCHAPTER 1, SECTION 16-115-2, DEFINITIONS, EFFECTIVE 08/29/94.)

Peter L. Mow
ENGINEERS SURVEYORS HAWAII, INC.
MY LICENSE EXPIRES: APRIL 30, 2014

STATE OF HAWAII
DEPARTMENT OF TRANSPORTATION
HIGHWAYS DIVISION

DRAIN PROFILE

TRAFFIC OPERATIONAL IMPROVEMENTS
AT VARIOUS LOCATIONS
VICINITY OF KAMEHAMEHA HIGHWAY AND MOKULELE DRIVE
Project No. 83G-01-10

Scale: As Noted Date: May 2011
SHEET No. 1 OF 1 SHEETS

"AS-BUILT"

23