


FED. ROAD DIST. NO.	STATE	PROJ. NO.	FISCAL YEAR	SHEET NO.	TOTAL SHEETS
OAHU	HAW.	83G-01-10	2011	12	38

True North
Scale : 1" = 20'

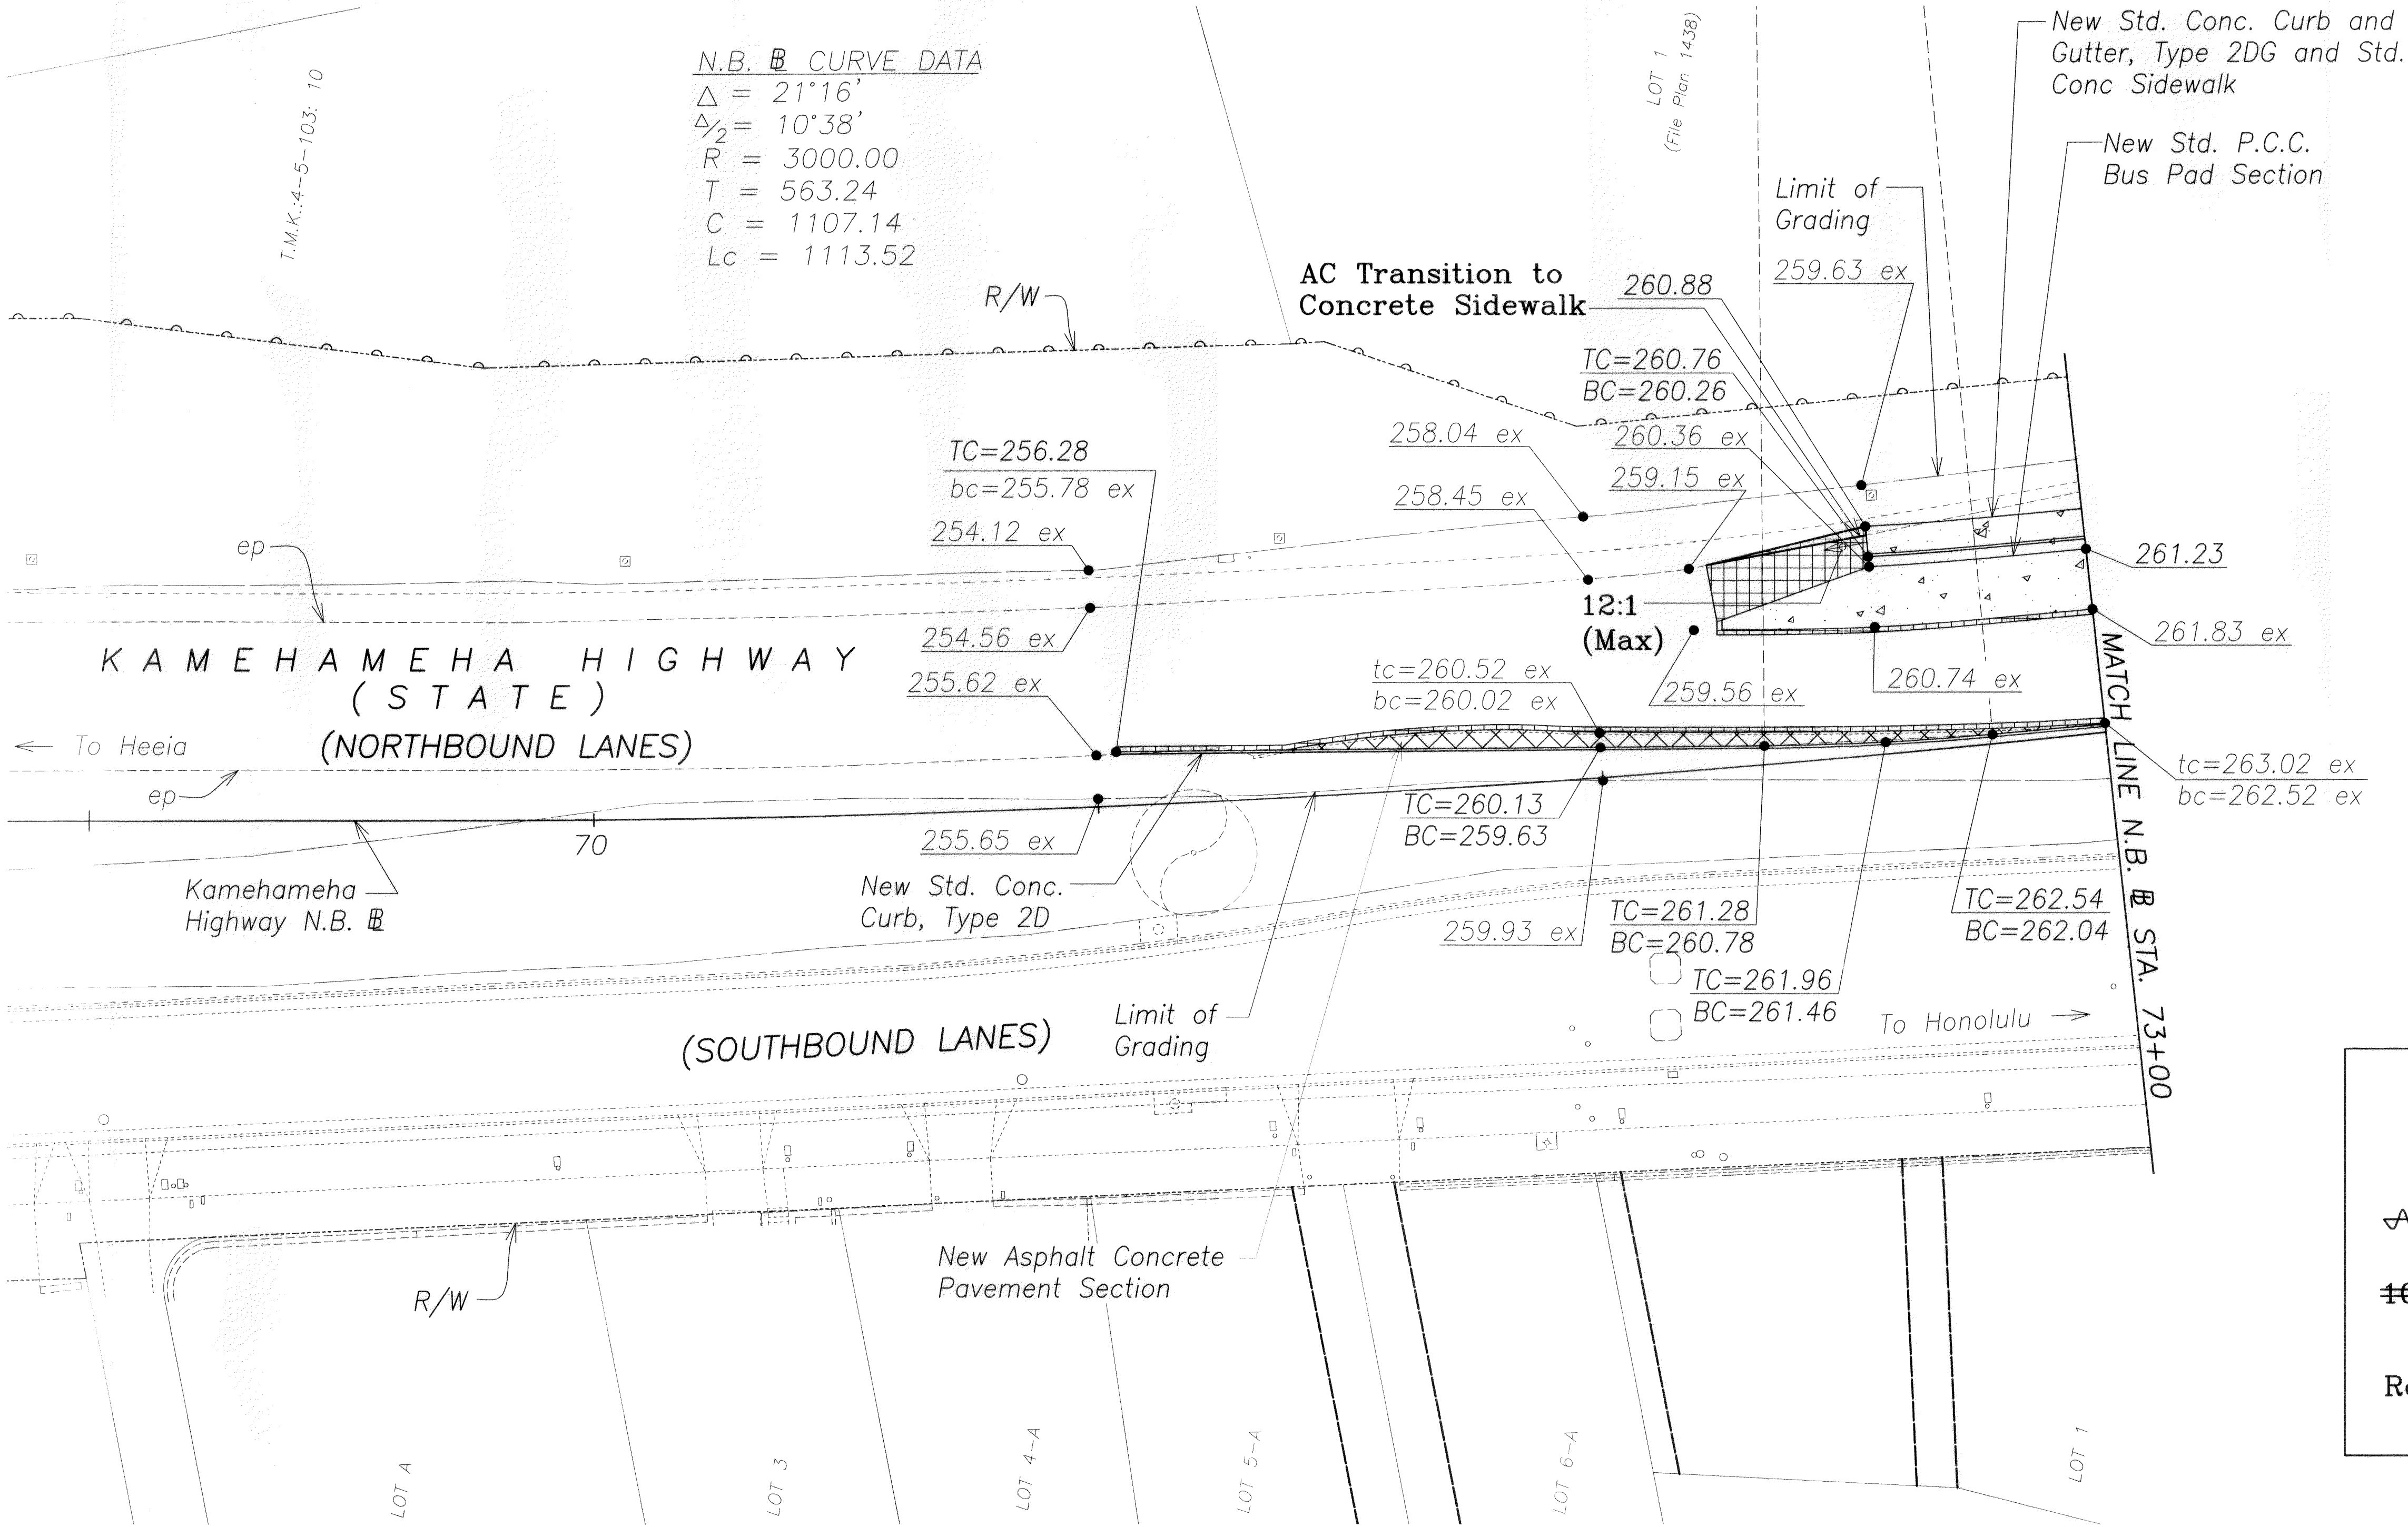


LEGEND FOR AS-BUILT POSTINGS

Squiggly line for as-built deletion

Double line for as-built deletion

Roadway Text for as-built posting

ORIGINAL PLAN	DATE
DESIGNED BY	
TRACED BY	
NOTE BOOK	
QUANTITIES BY	
CHECKED BY	
No.	

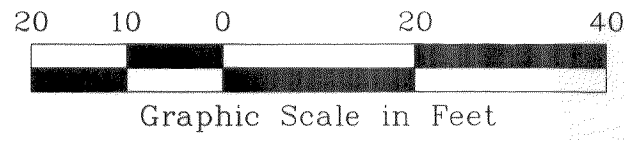

THIS WORK WAS PREPARED BY ME OR UNDER MY SUPERVISION AND CONSTRUCTION OF THIS PROJECT WILL BE UNDER MY OBSERVATION. ("OBSERVATION OF CONSTRUCTION" SHALL BE AS DEFINED IN CHAPTER 115, RULES OF THE BOARD OF PROFESSIONAL ENGINEERS, ARCHITECTS AND SURVEYORS, STATE OF HAWAII, SUBCHAPTER 1, SECTION 16-15-2, DEFINITIONS, EFFECTIVE 08/29/94).

Peter L. Mow
 ENGINEERS SURVEYORS HAWAII, INC.
 MY LICENSE EXPIRES: APRIL 30, 2014

STATE OF HAWAII
 DEPARTMENT OF TRANSPORTATION
 HIGHWAYS DIVISION

FINISH GRADE PLANS



TRAFFIC OPERATIONAL IMPROVEMENTS
 AT VARIOUS LOCATIONS
 VICINITY OF KAMEHAMEHA HIGHWAY AND MOKULELE DRIVE
 Project No. 83G-01-10

Scale: As Noted Date: May 2011

SHEET No. 1 OF 3 SHEETS

"AS-BUILT"

FED. ROAD DIST. NO.	STATE	PROJ. NO.	FISCAL YEAR	SHEET NO.	TOTAL SHEETS
OAHU	HAW.	83G-01-10	2011	13	38

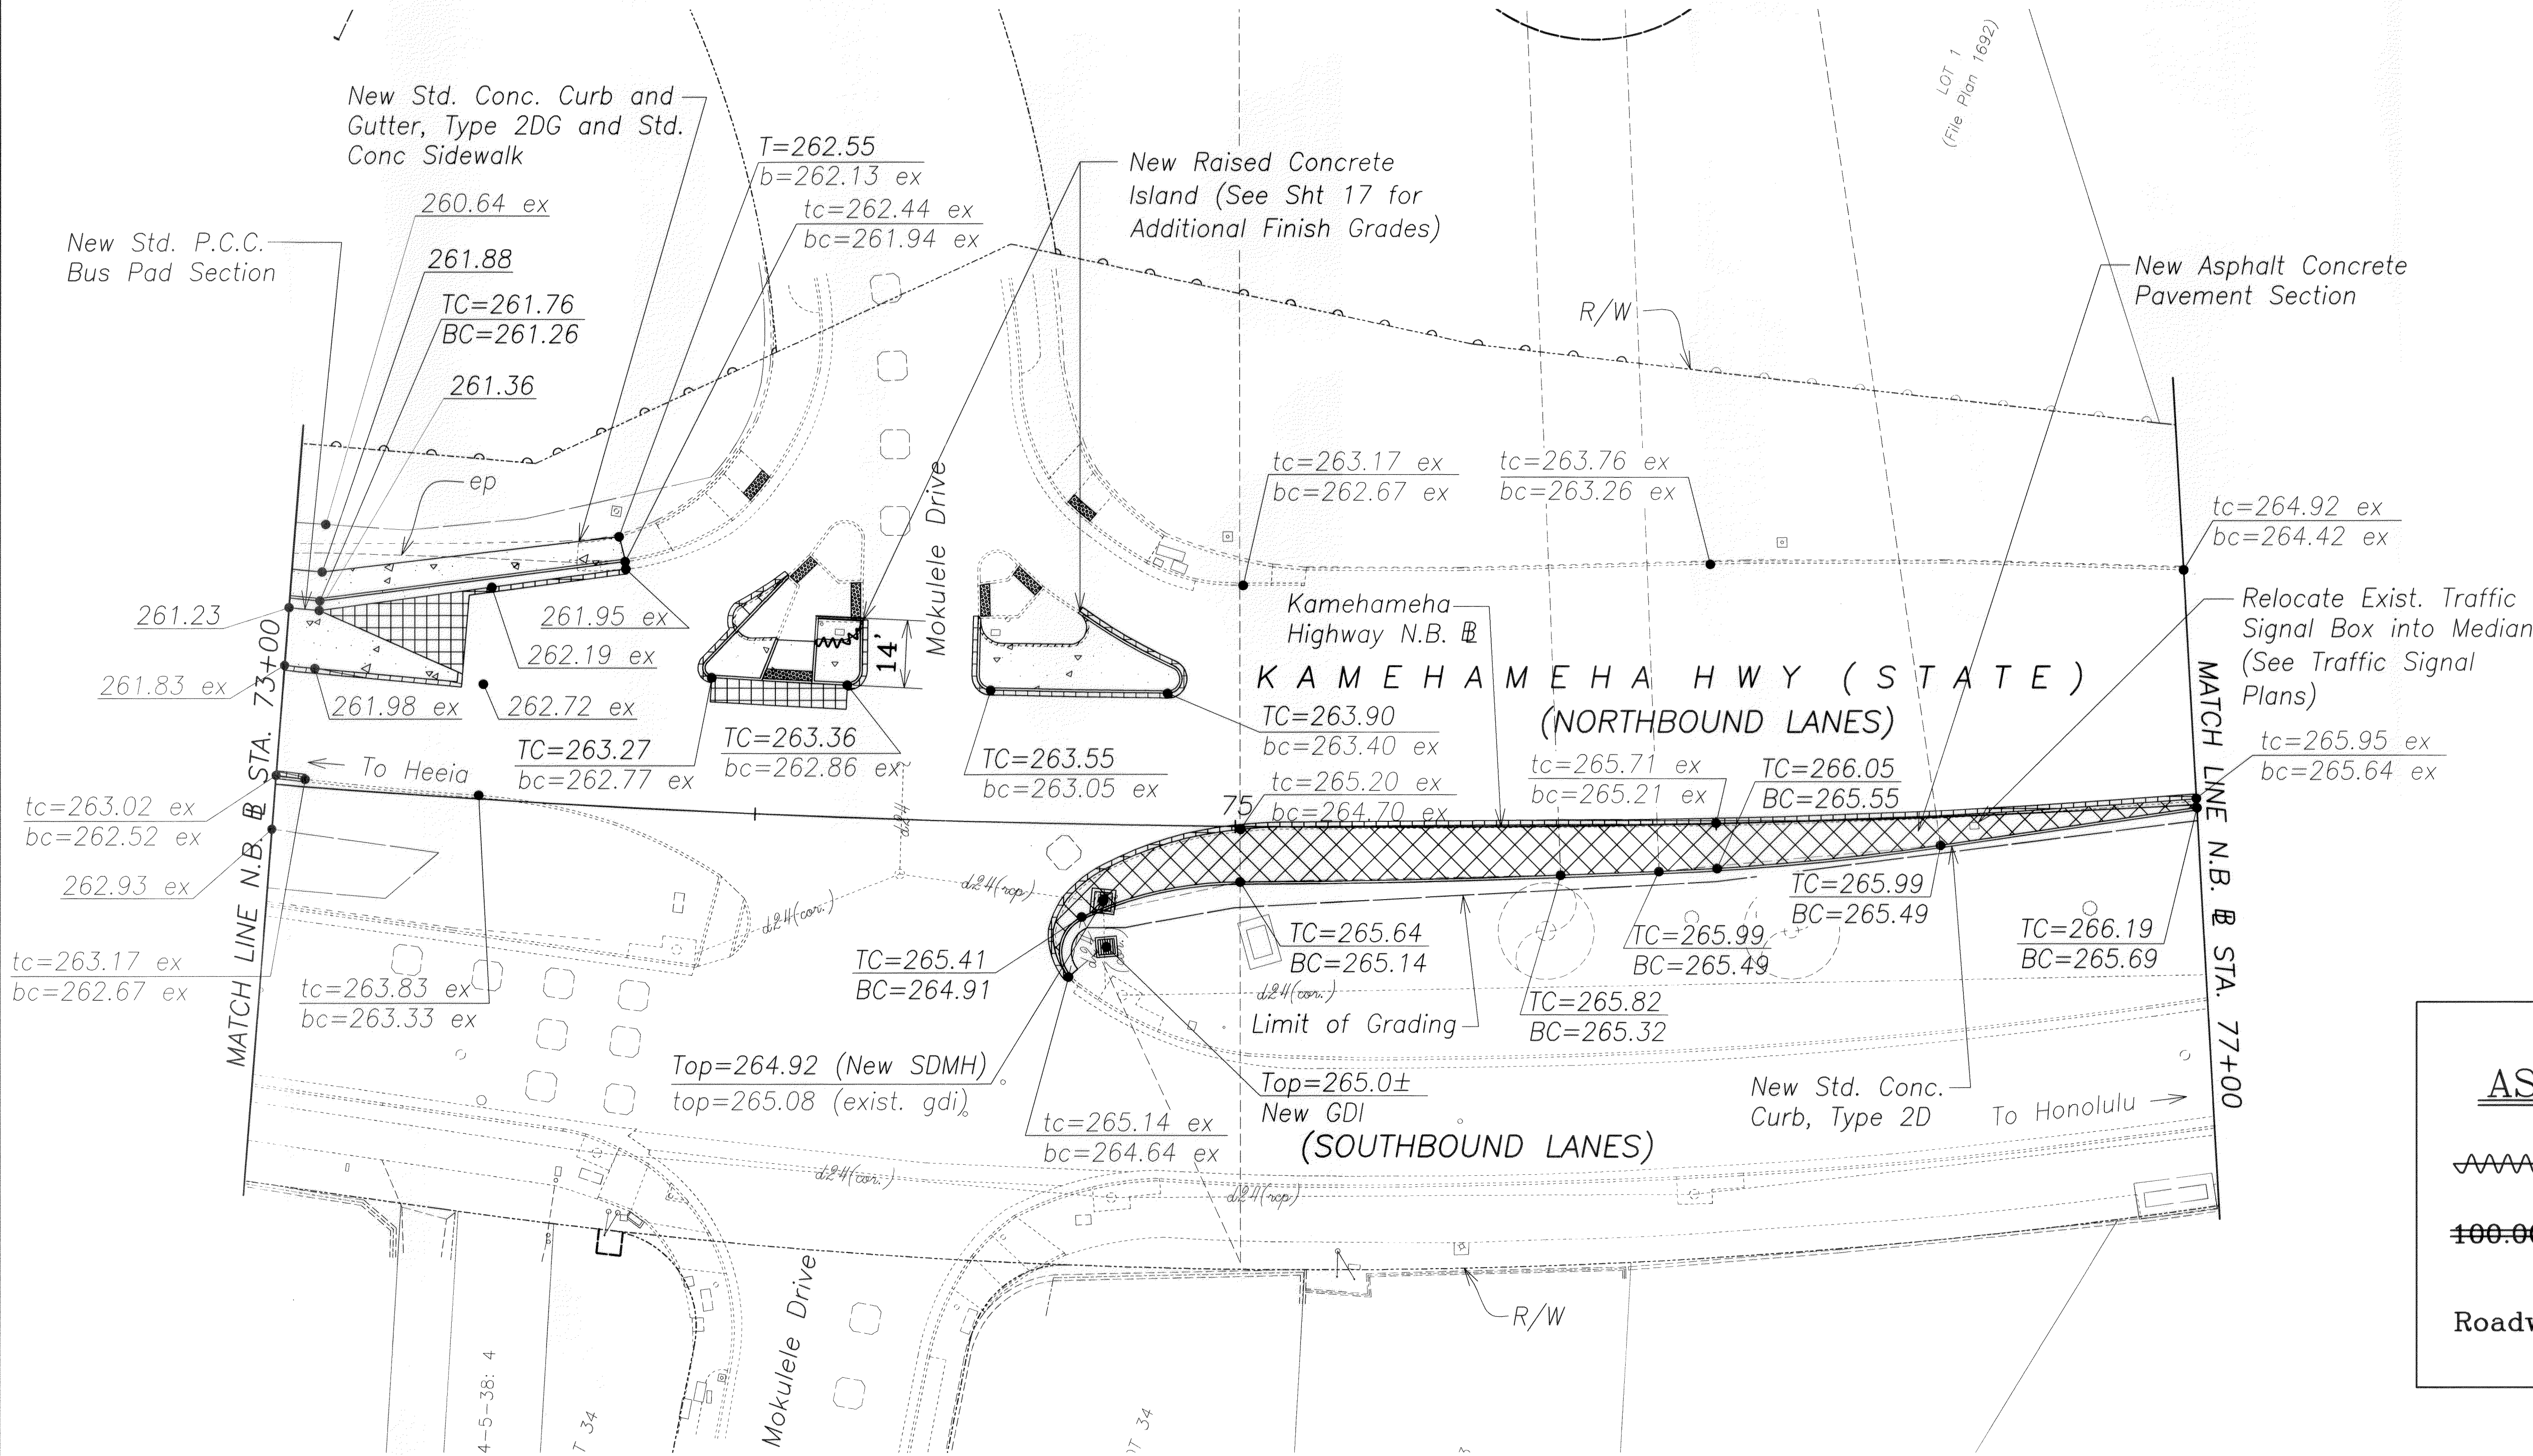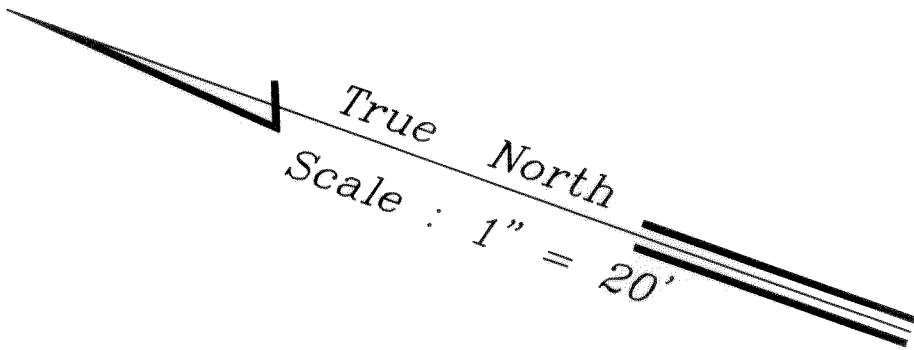

LEGEND FOR AS-BUILT POSTINGS


Squiggly line for as-built deletion

Double line for as-built deletion

Roadway

Text for as-built posting

ORIGINAL PLAN	DATE
DESIGNED BY	
TRACED BY	
NOTE BOOK	
QUANTITIES BY	
CHECKED BY	
NO.	

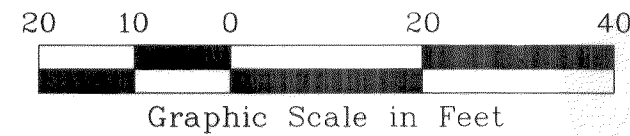

THIS WORK WAS PREPARED BY ME OR UNDER MY SUPERVISION AND CONSTRUCTION OF THIS PROJECT WILL BE UNDER MY OBSERVATION. ("OBSERVATION OF CONSTRUCTION" SHALL BE AS DEFINED IN CHAPTER 115, RULES OF THE BOARD OF PROFESSIONAL ENGINEERS, ARCHITECTS AND SURVEYORS, STATE OF HAWAII, SUBCHAPTER 1, SECTION 16-115-2, DEFINITIONS, EFFECTIVE 08/28/94).

Peter L. Mow

ENGINEERS SURVEYORS HAWAII, INC.
MY LICENSE EXPIRES: APRIL 30, 2014

STATE OF HAWAII
DEPARTMENT OF TRANSPORTATION
HIGHWAYS DIVISION

FINISH GRADE PLANS



TRAFFIC OPERATIONAL IMPROVEMENTS
AT VARIOUS LOCATIONS
VICINITY OF KAMEHAMEHA HIGHWAY AND MOKULELE DRIVE
Project No. 83G-01-10

Scale: As Noted Date: May 2011


SHEET No. 2 OF 3 SHEETS

"AS-BUILT"

FED. ROAD DIST. NO.	STATE	PROJ. NO.	FISCAL YEAR	SHEET NO.	TOTAL SHEETS
OAHU	HAW.	83G-01-10	2011	14	38

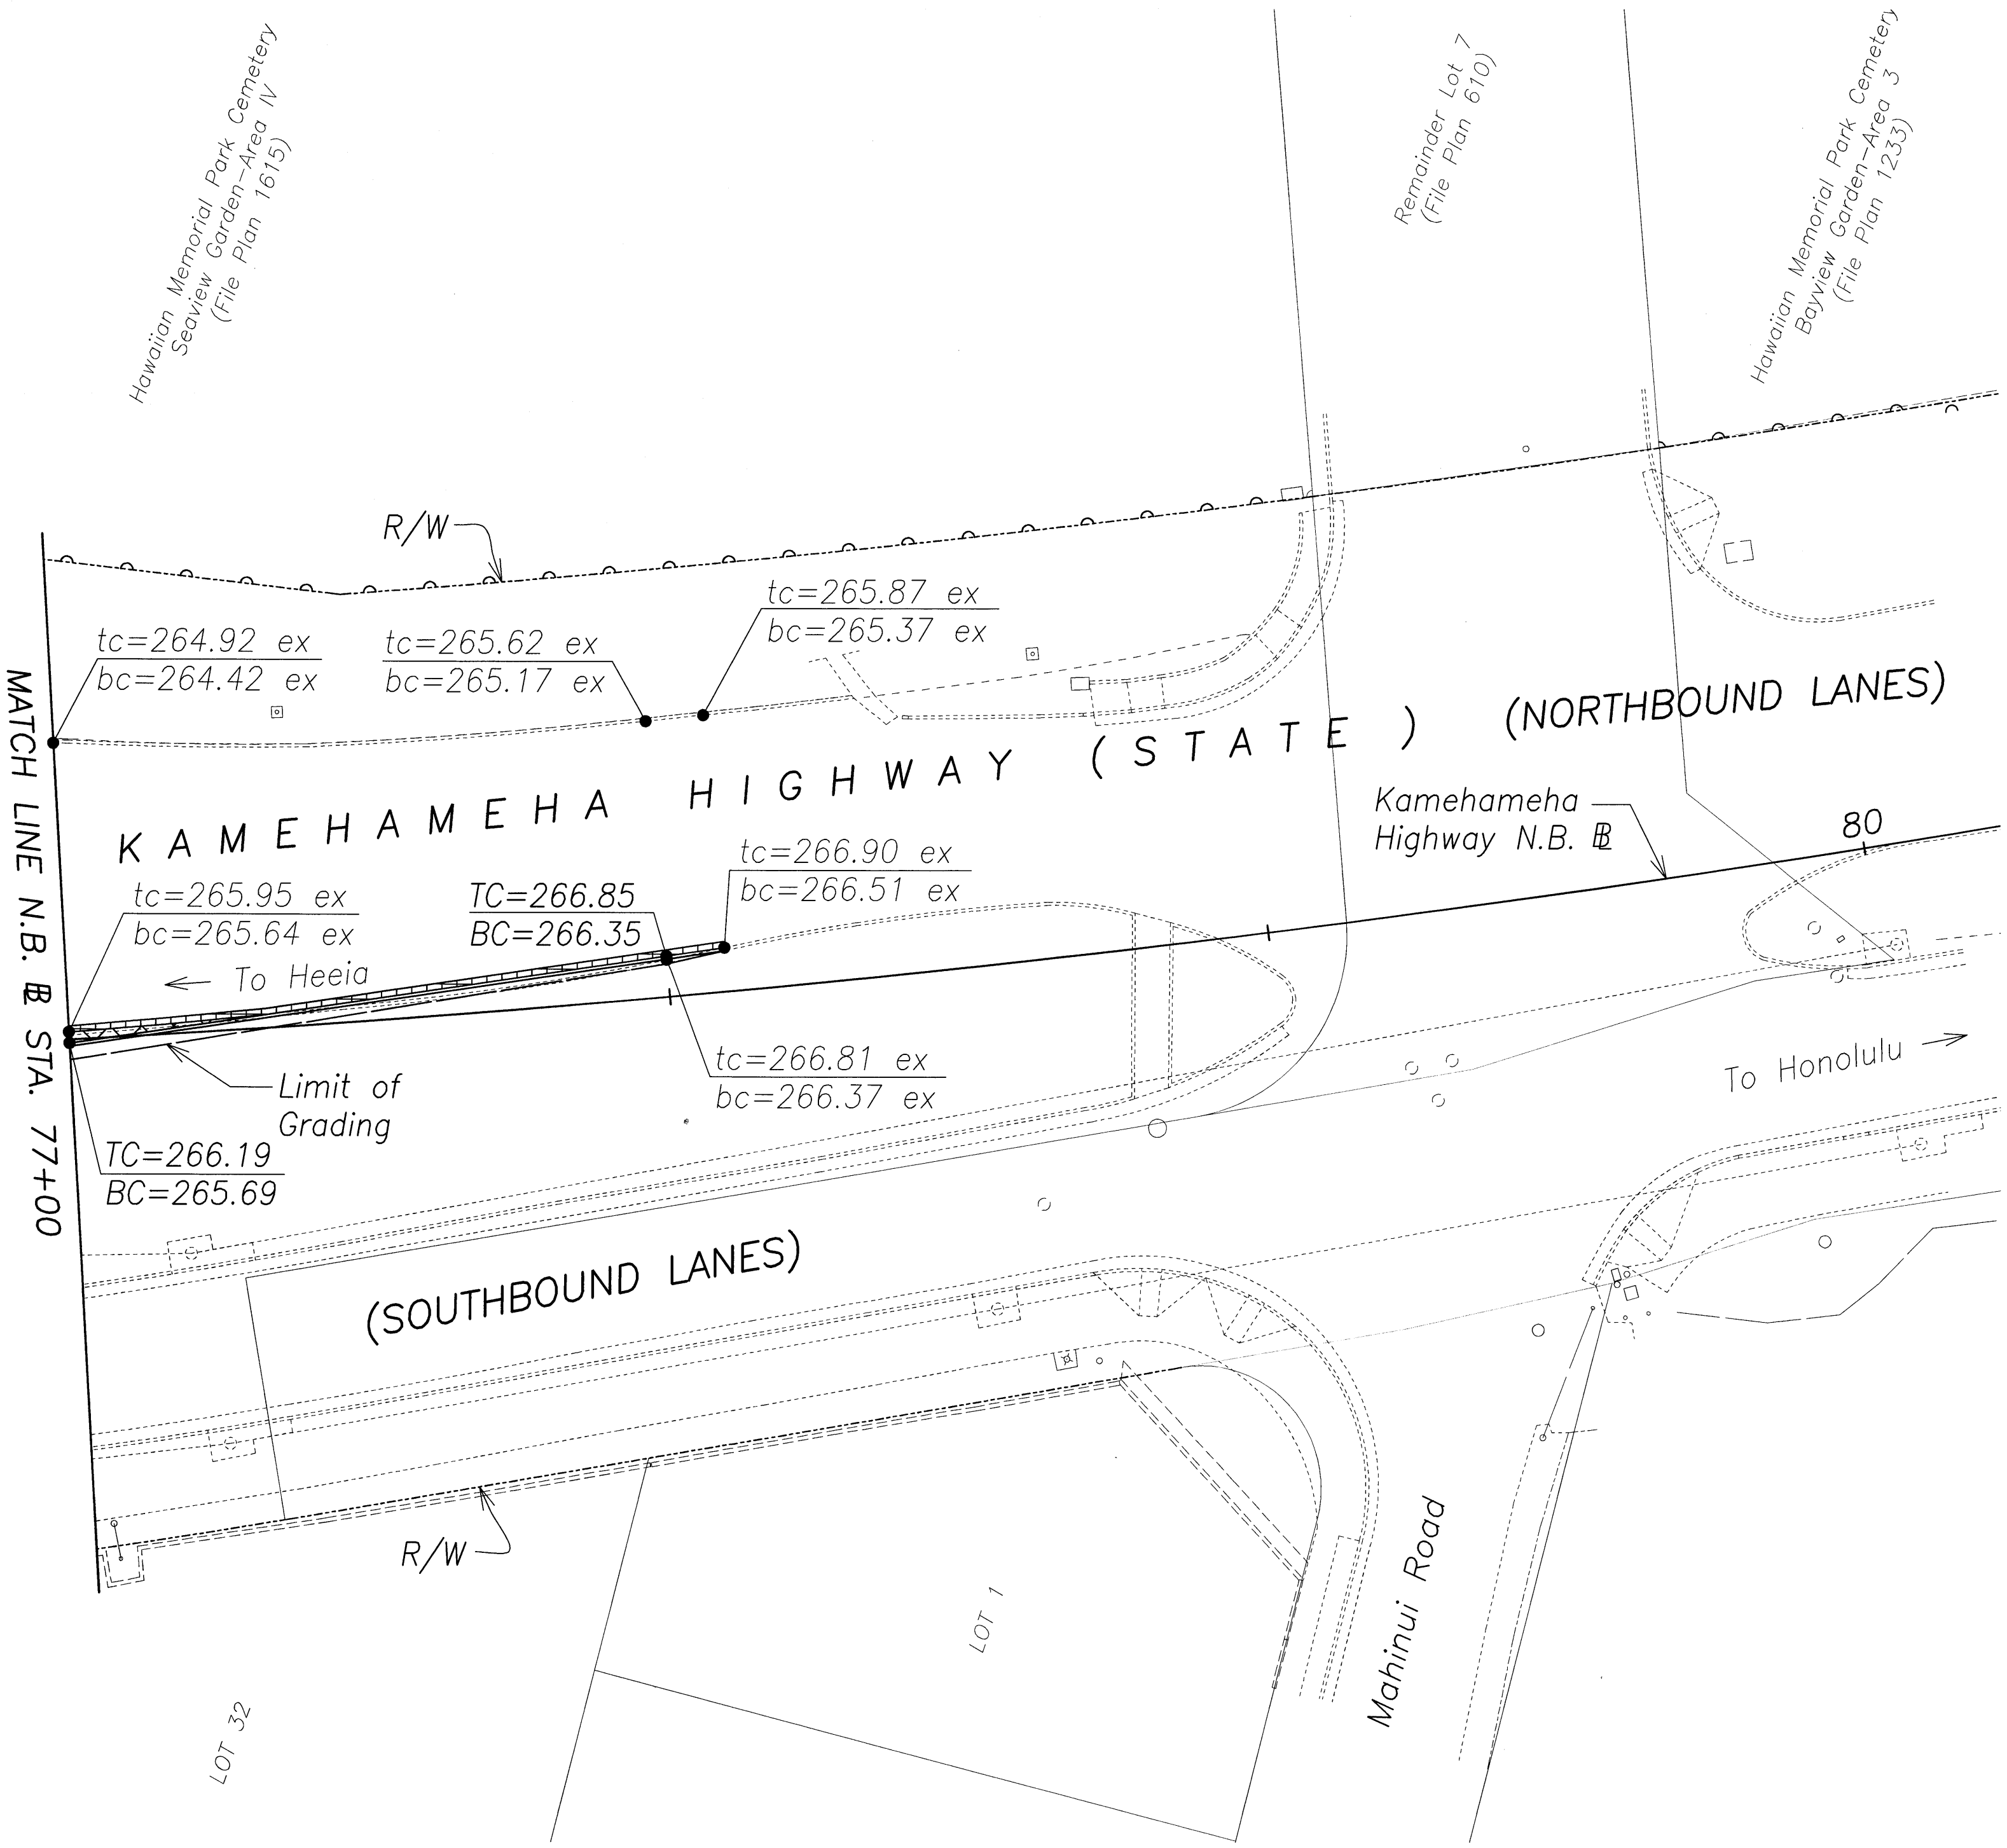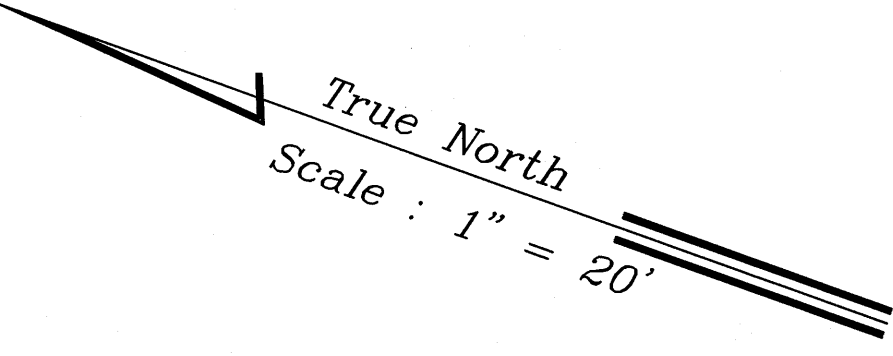

SURVEY PLOTTED BY	DATE
DRAWN BY	
DESIGNED BY	
QUANTITIES BY	
CHECKED BY	
No.	

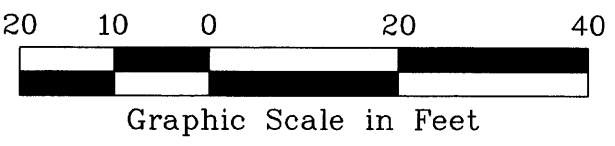

THIS WORK WAS PREPARED BY ME OR UNDER MY SUPERVISION AND CONSTRUCTION OF THIS PROJECT WILL BE UNDER MY OBSERVATION. ("OBSERVATION OF CONSTRUCTION" SHALL BE AS DEFINED IN CHAPTER 115, RULES OF THE BOARD OF PROFESSIONAL ENGINEERS, ARCHITECTS AND SURVEYORS, STATE OF HAWAII, SUBCHAPTER 1, SECTION 16-115-2, DEFINITIONS, EFFECTIVE 08/29/94).
05-25-11
Peter L. Mow
 ENGINEERS SURVEYORS HAWAII, INC.
MY LICENSE EXPIRES: APRIL 30, 2012

STATE OF HAWAII
DEPARTMENT OF TRANSPORTATION
HIGHWAYS DIVISION

FINISH GRADE PLANS

TRAFFIC OPERATIONAL IMPROVEMENTS
AT VARIOUS LOCATIONS
VICINITY OF KAMEHAMEHA HIGHWAY AND MOKULELE DRIVE
Project No. 83G-01-10

Scale: As Noted Date: May 2011

SHEET No. 3 OF 3 SHEETS

C:\Documents and Settings\Peter Mow\Documents\AutoCAD Files\Projects\2009-028 Traffic Operational Improvements\Plans\1b Kamehameha HQB-14_17_25-27_PLANS.dwg Wed, May 25, 2011 - 11:10am