

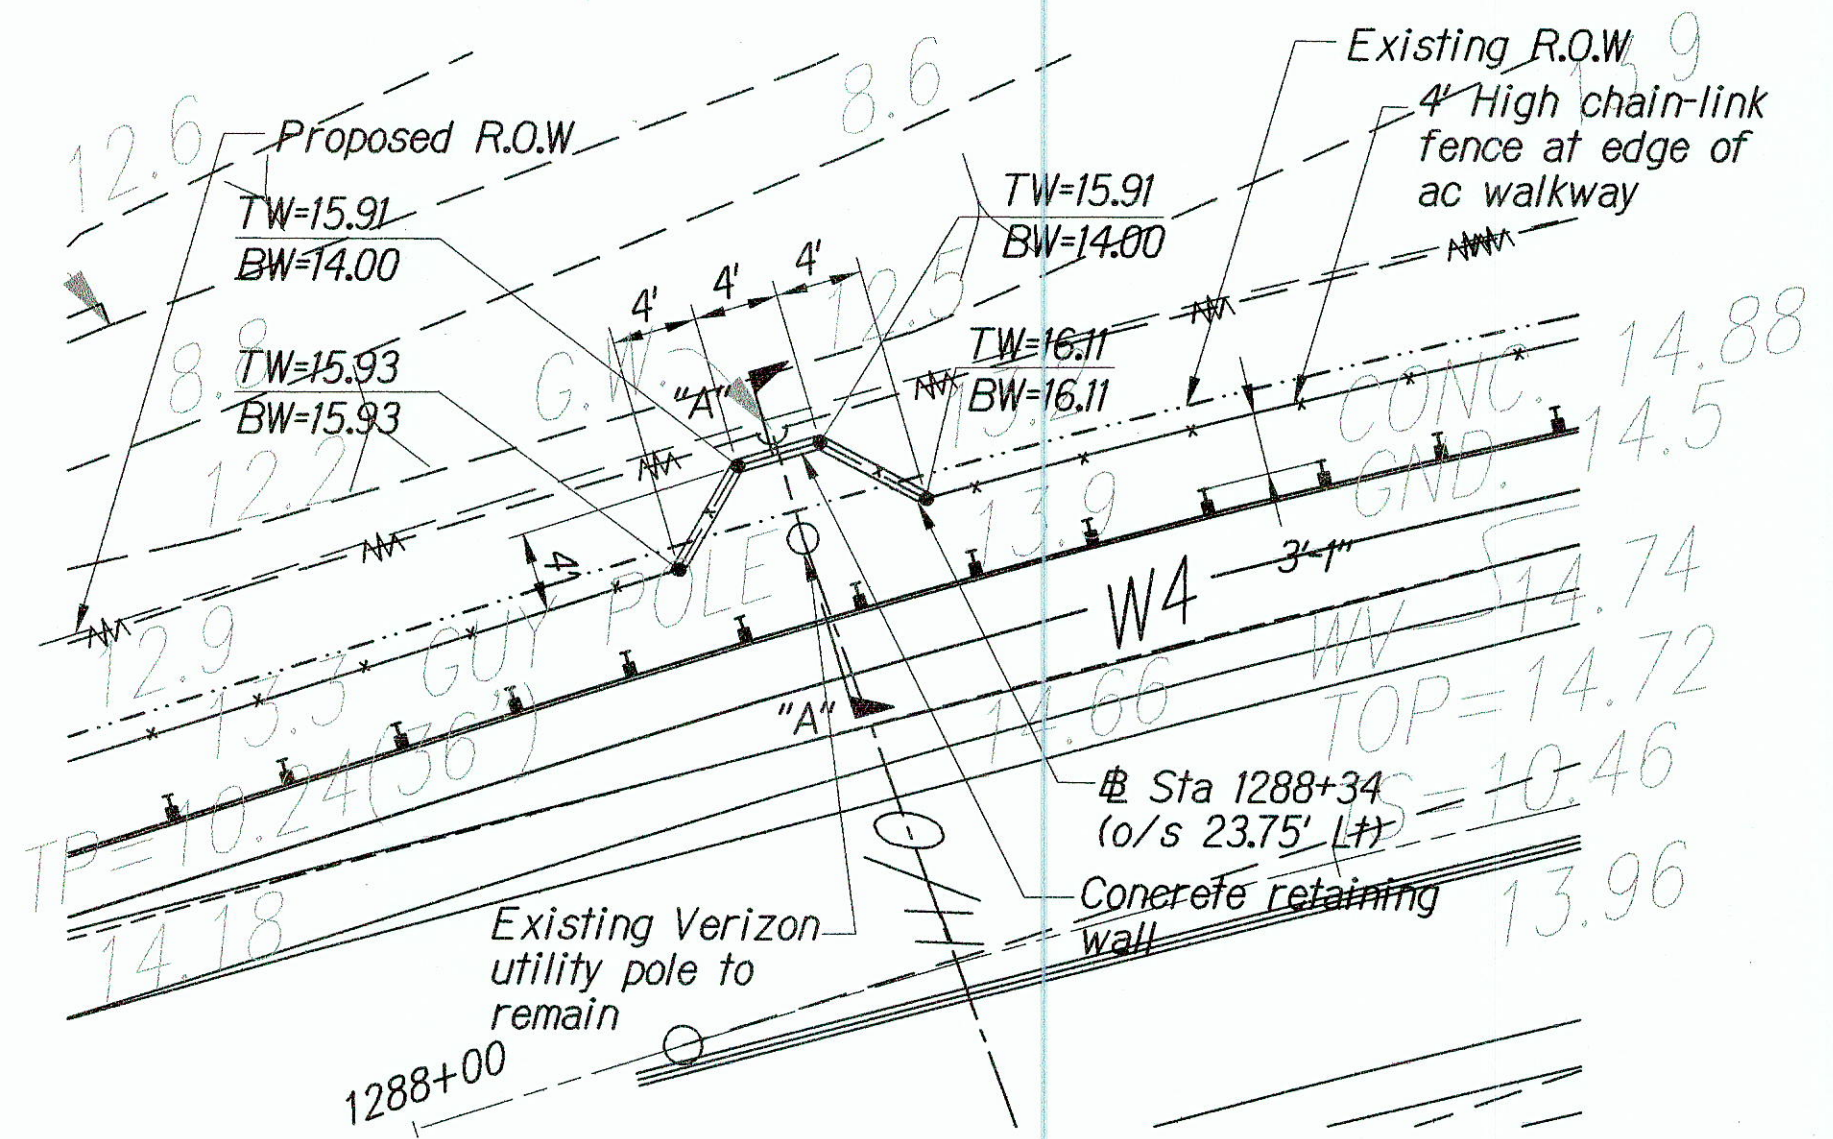
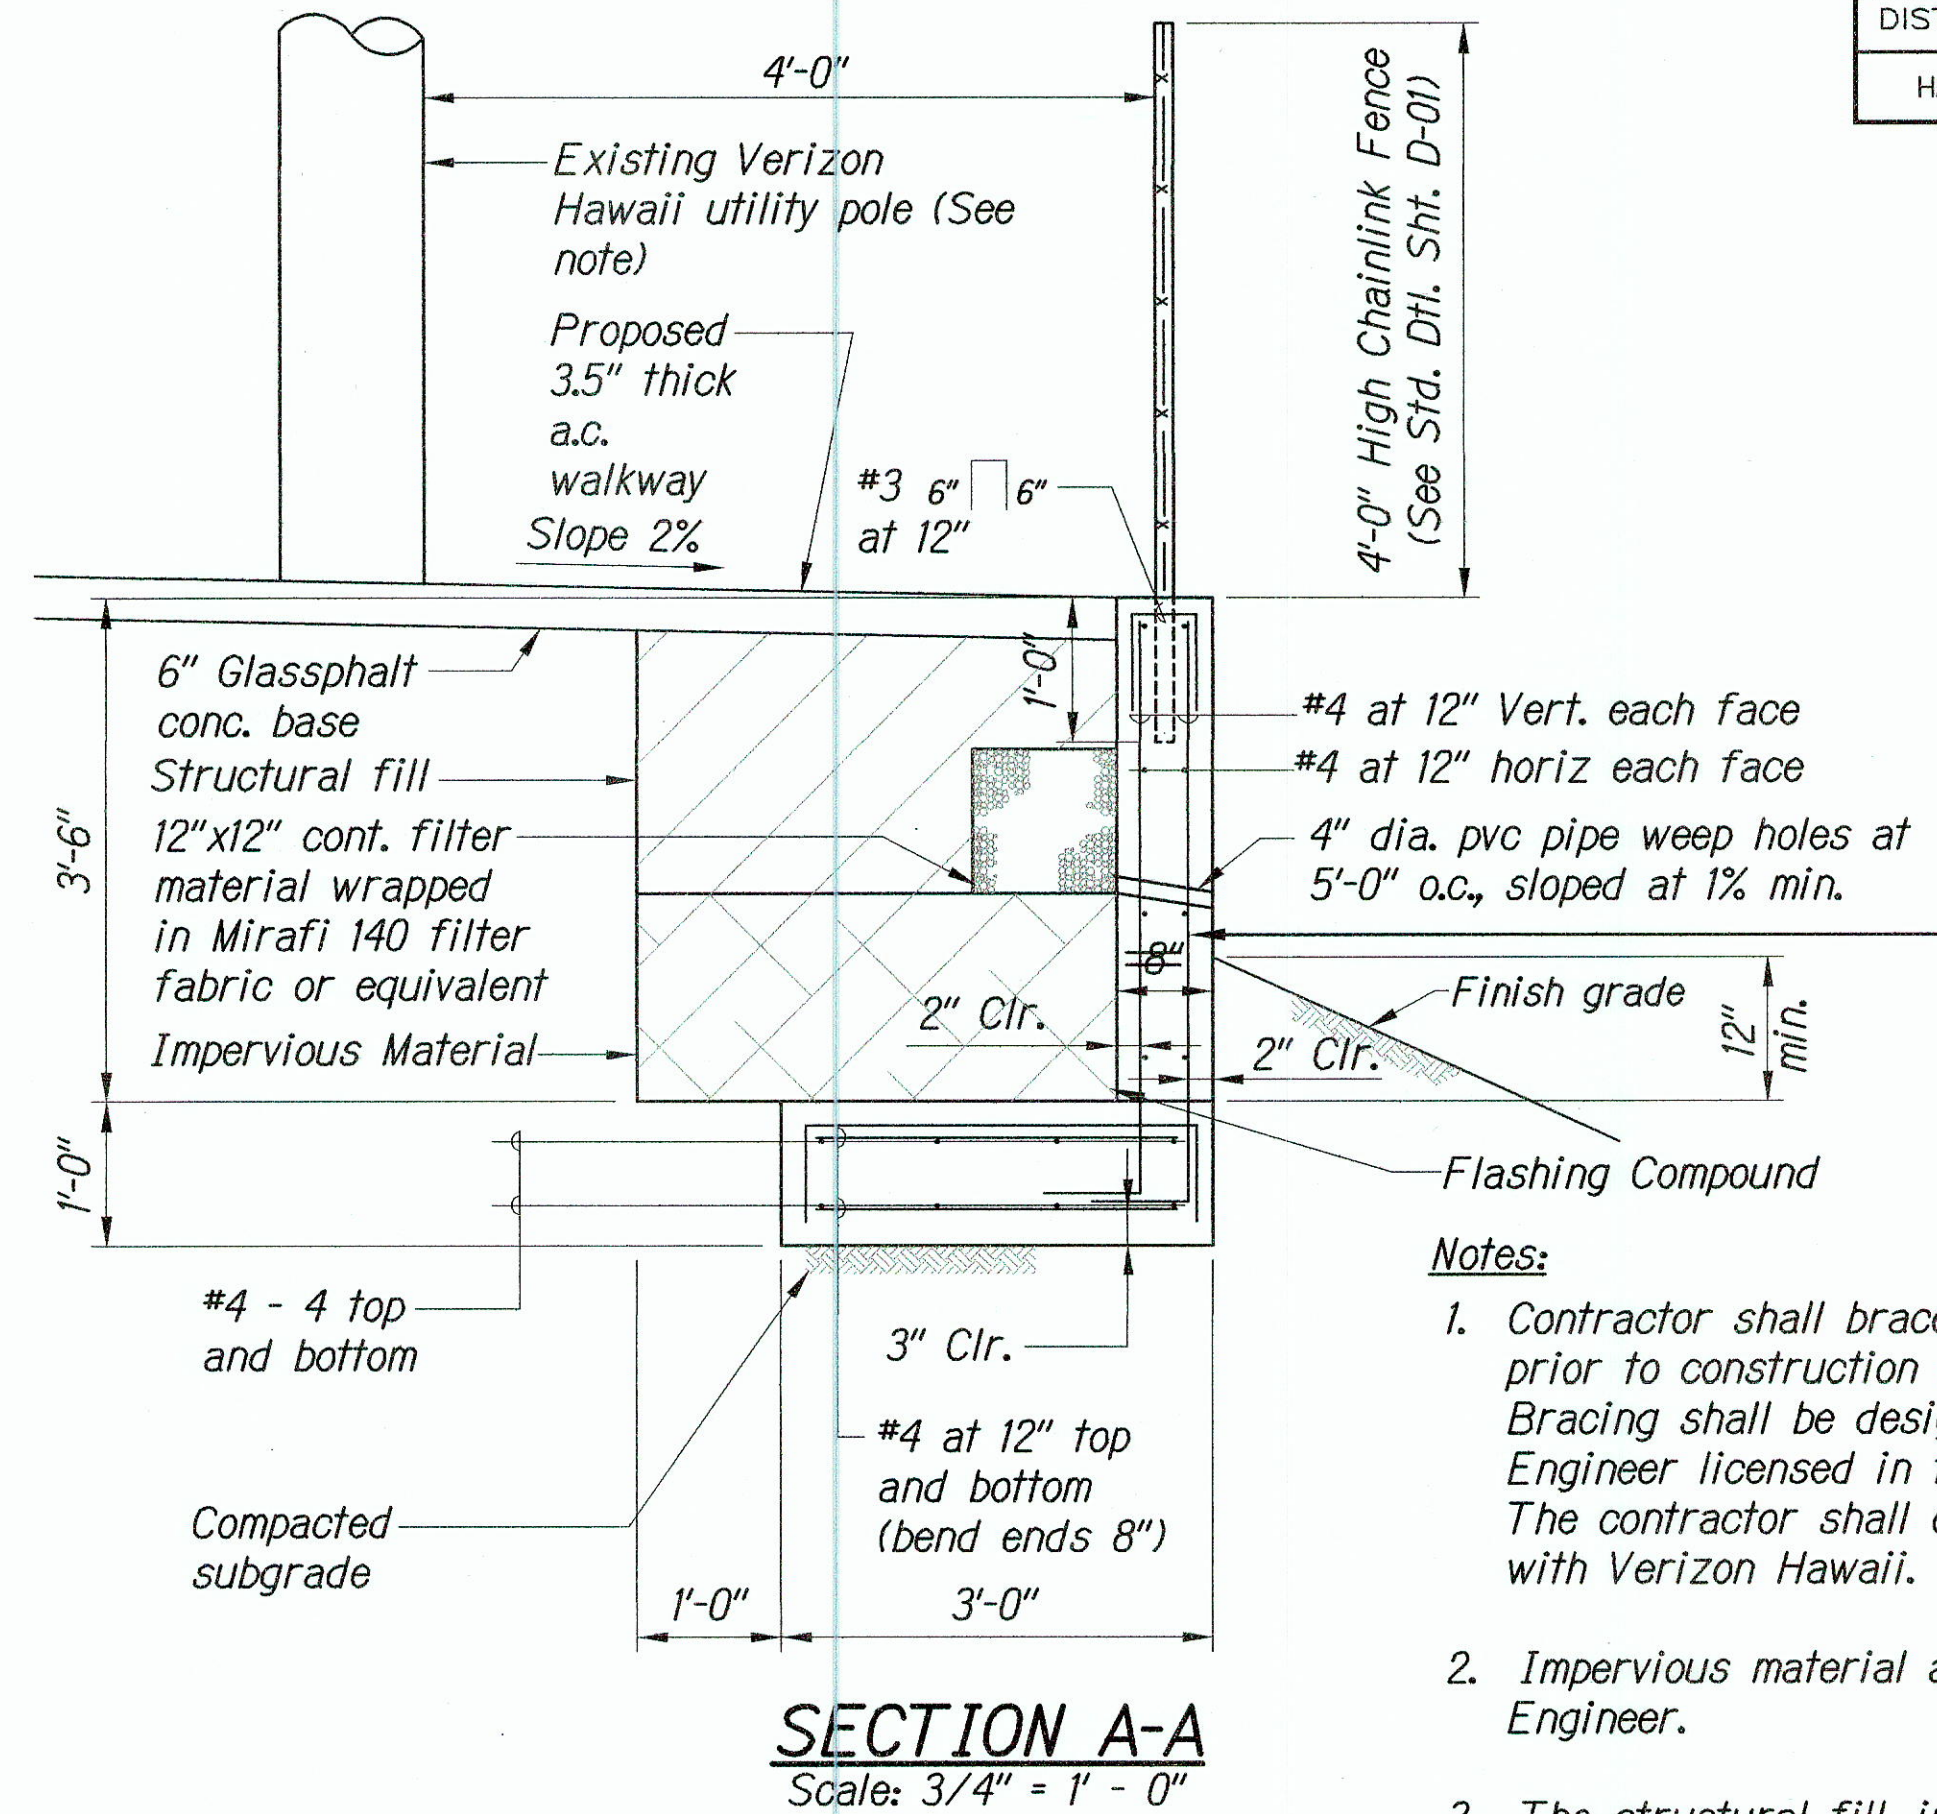
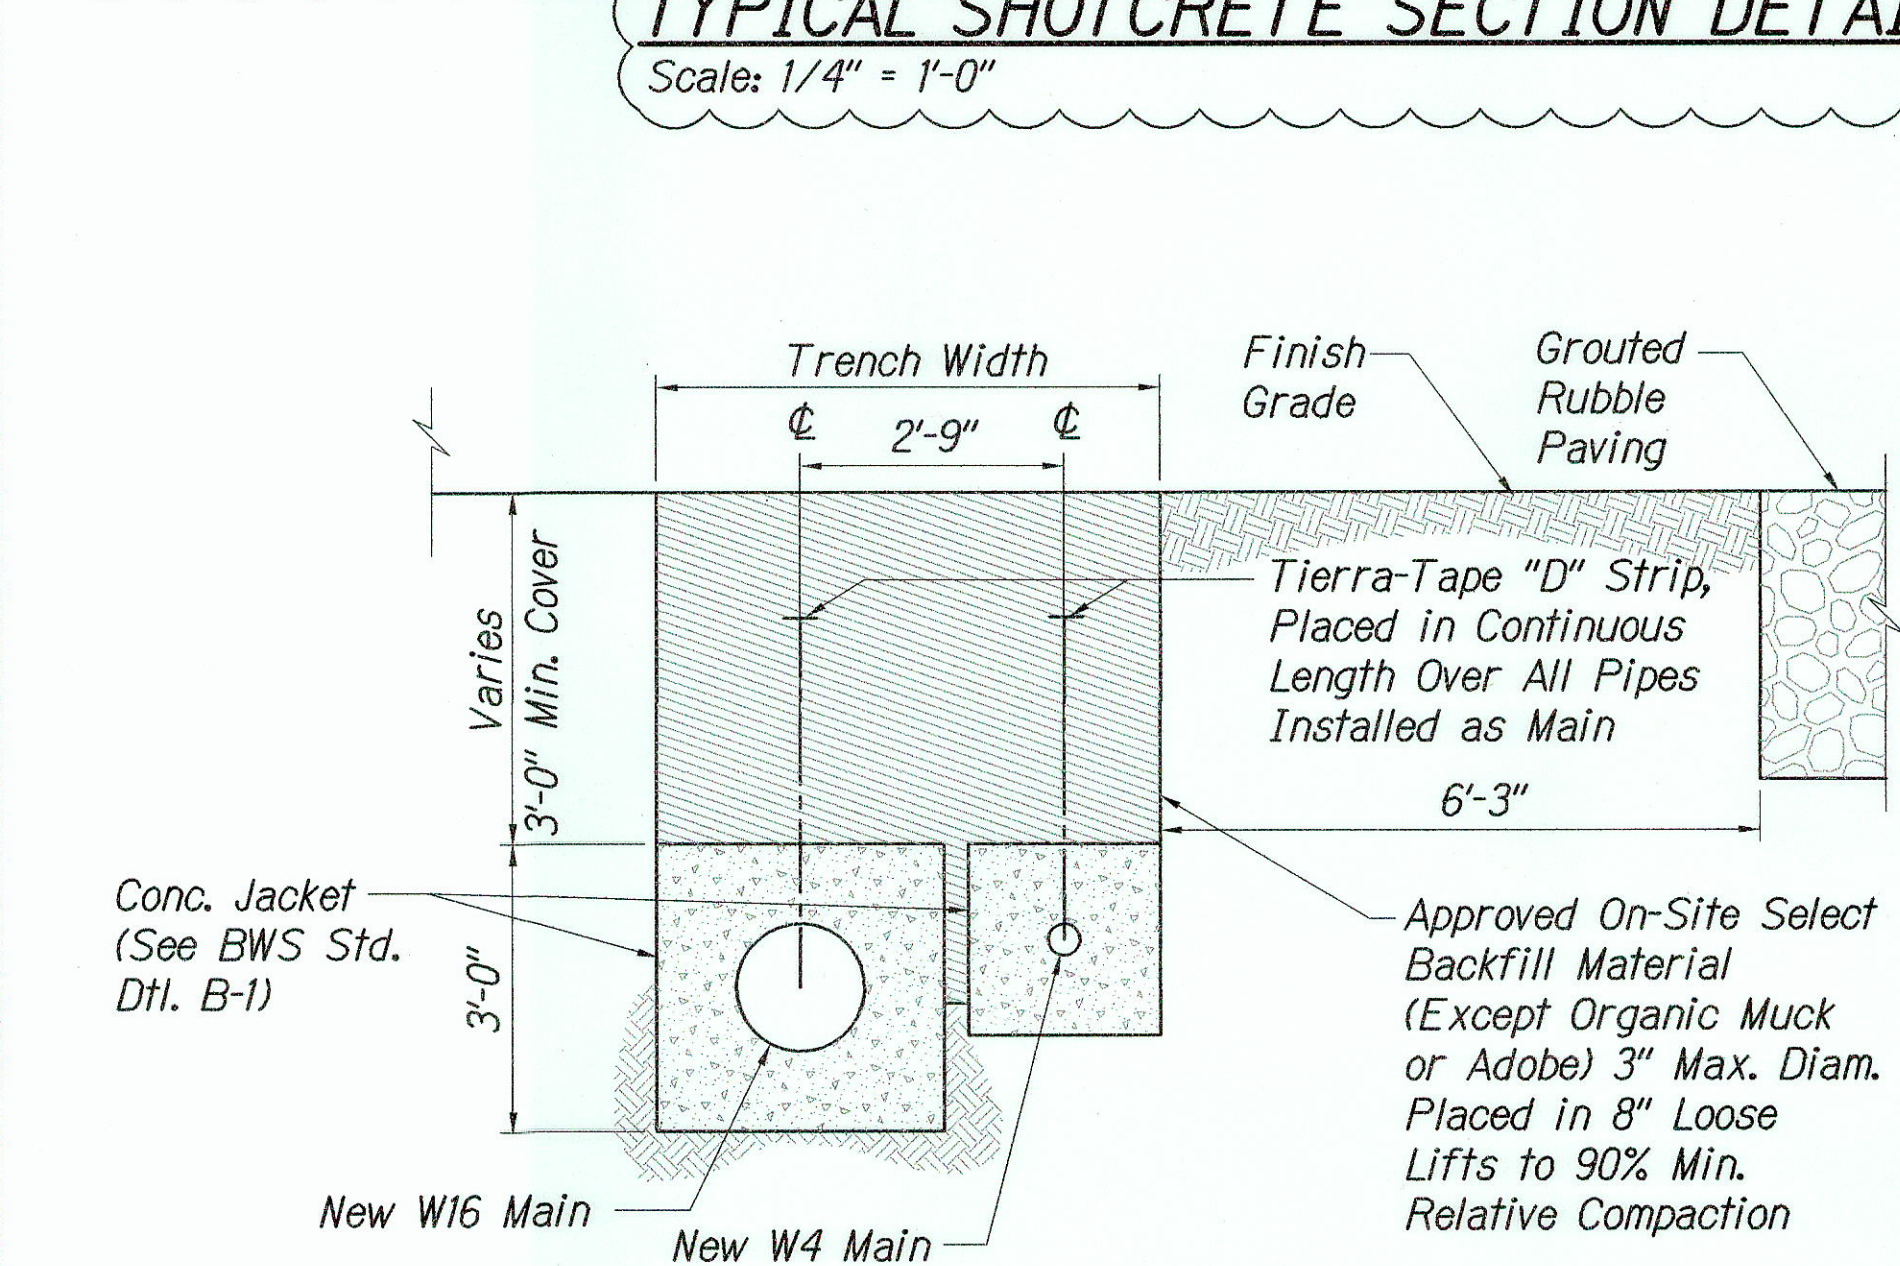
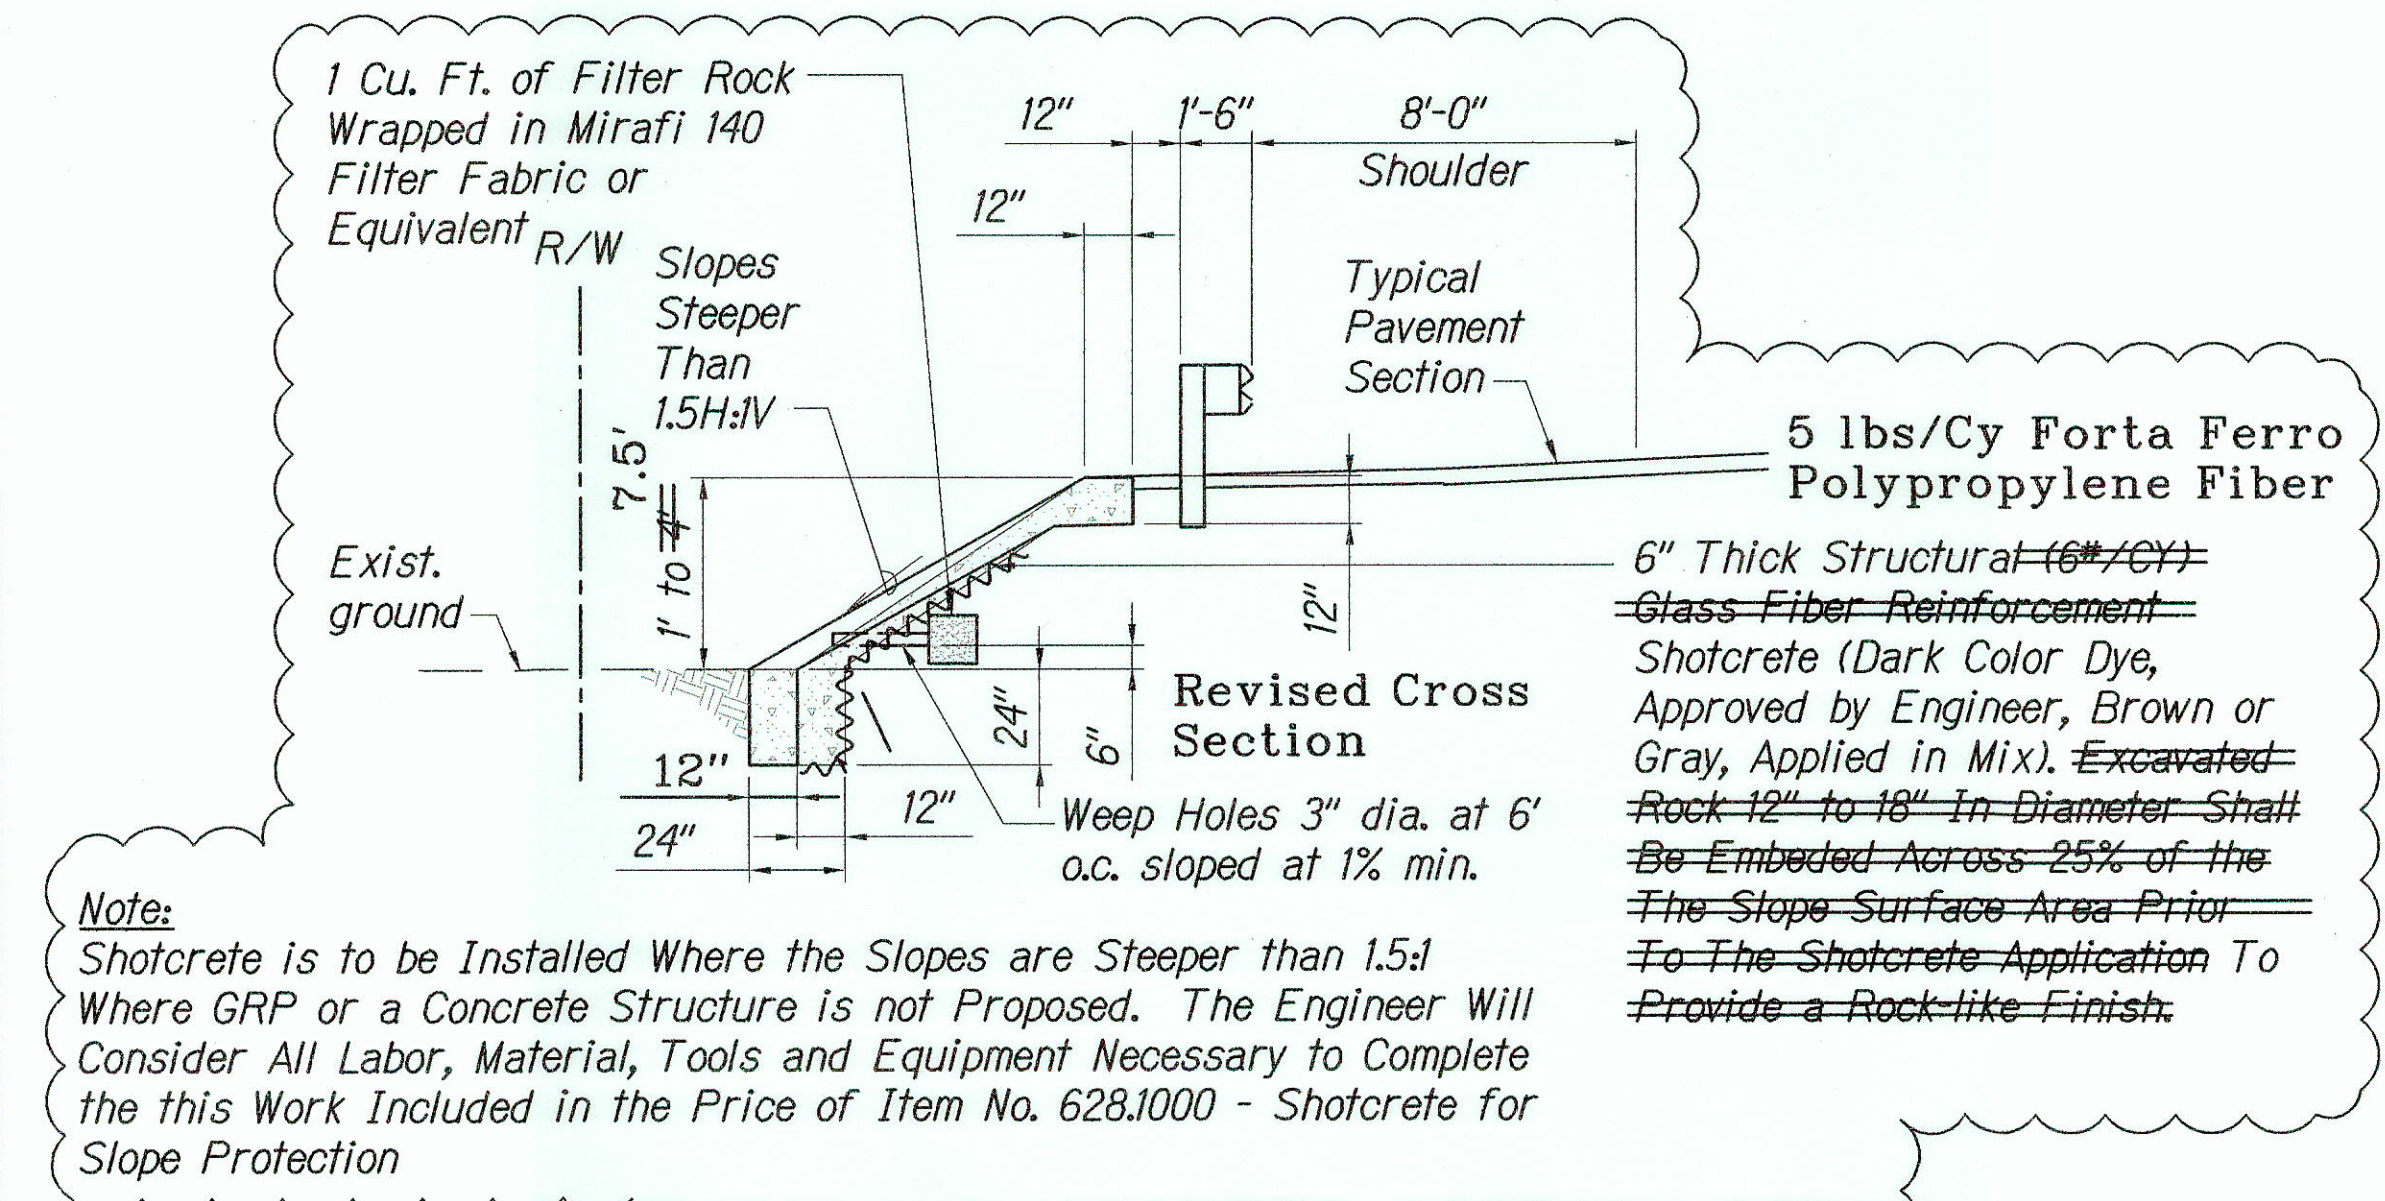


FED. ROAD DIST. NO.	STATE	FED. AID PROJ. NO.	FISCAL YEAR	SHEET NO.	TOTAL SHEETS
HAWAII	HAWAII	BR-083-1(50)	2005	43	81

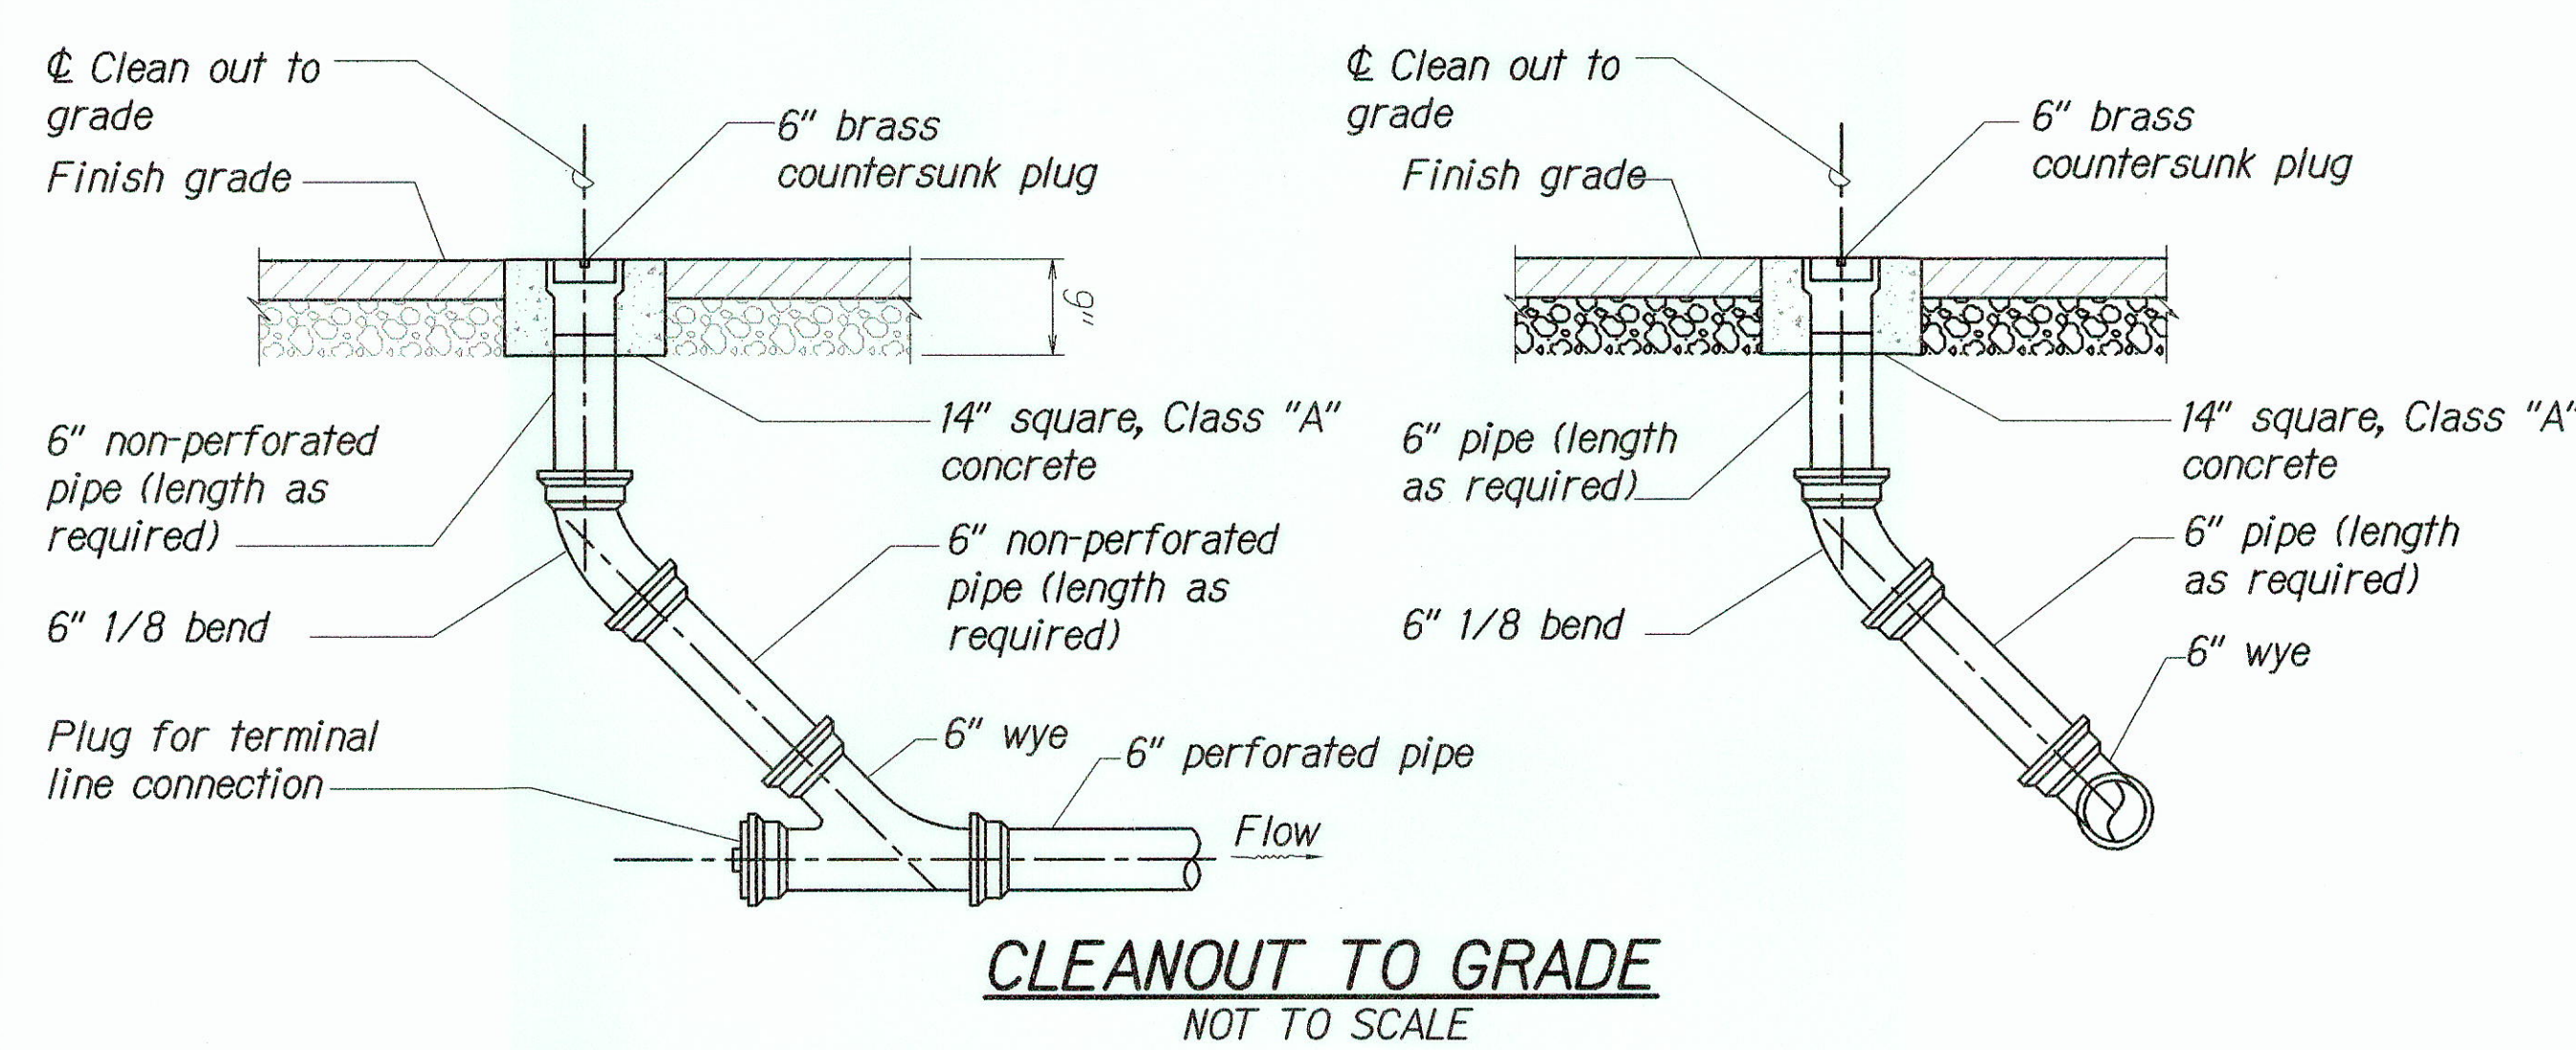

LEGEND FOR AS-BUILT POSTING	
	Squiggly line for as-built deletion
	Double line for as-built deletion
	Text for as-built posting

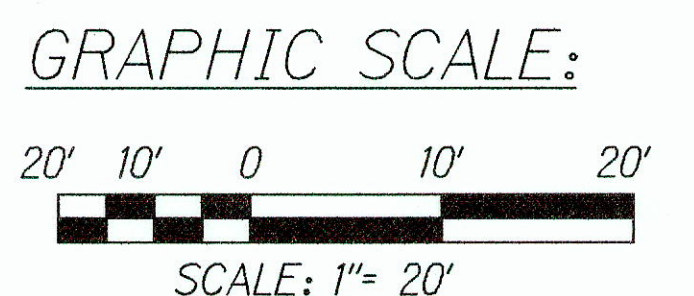

STATE OF HAWAII

DEPARTMENT OF TRANSPORTATION

HIGHWAYS DIVISION

MISCELLANEOUS DETAILS

KAMEHAMEHA HIGHWAY

REPLACEMENT OF KOKOLOLIO STREAM BRIDGE

Federal Aid Project No. BR-083-1(50)

Scale: As Noted

Date: August 2004

CHAD M. McDONALD

LICENSED PROFESSIONAL ENGINEER

No. 9793-C

HAWAII, U.S.A.

This work was prepared by me or under my supervision

4/30/2014

MITSUNAGA & ASSOCIATES, INC. EXP. DATE

NOTE: Contractor to check and verify dimensions at job before proceeding with work.

PLAN  
 Scale: 1"=10'  
 RETAINING WALL AT UTILITY POLE

Approval:   
 Principal Executive, Maintenance Unit, BWS  
 Date: 9/22/09

"AS-BUILT"

SURVEY PLOTTED BY	DATE
DRAWN BY	
DESIGNED BY	
QUANTITIES BY	
CHECKED BY	
ORIGINAL PLAN	
NOTE BOOK	
NO.	