

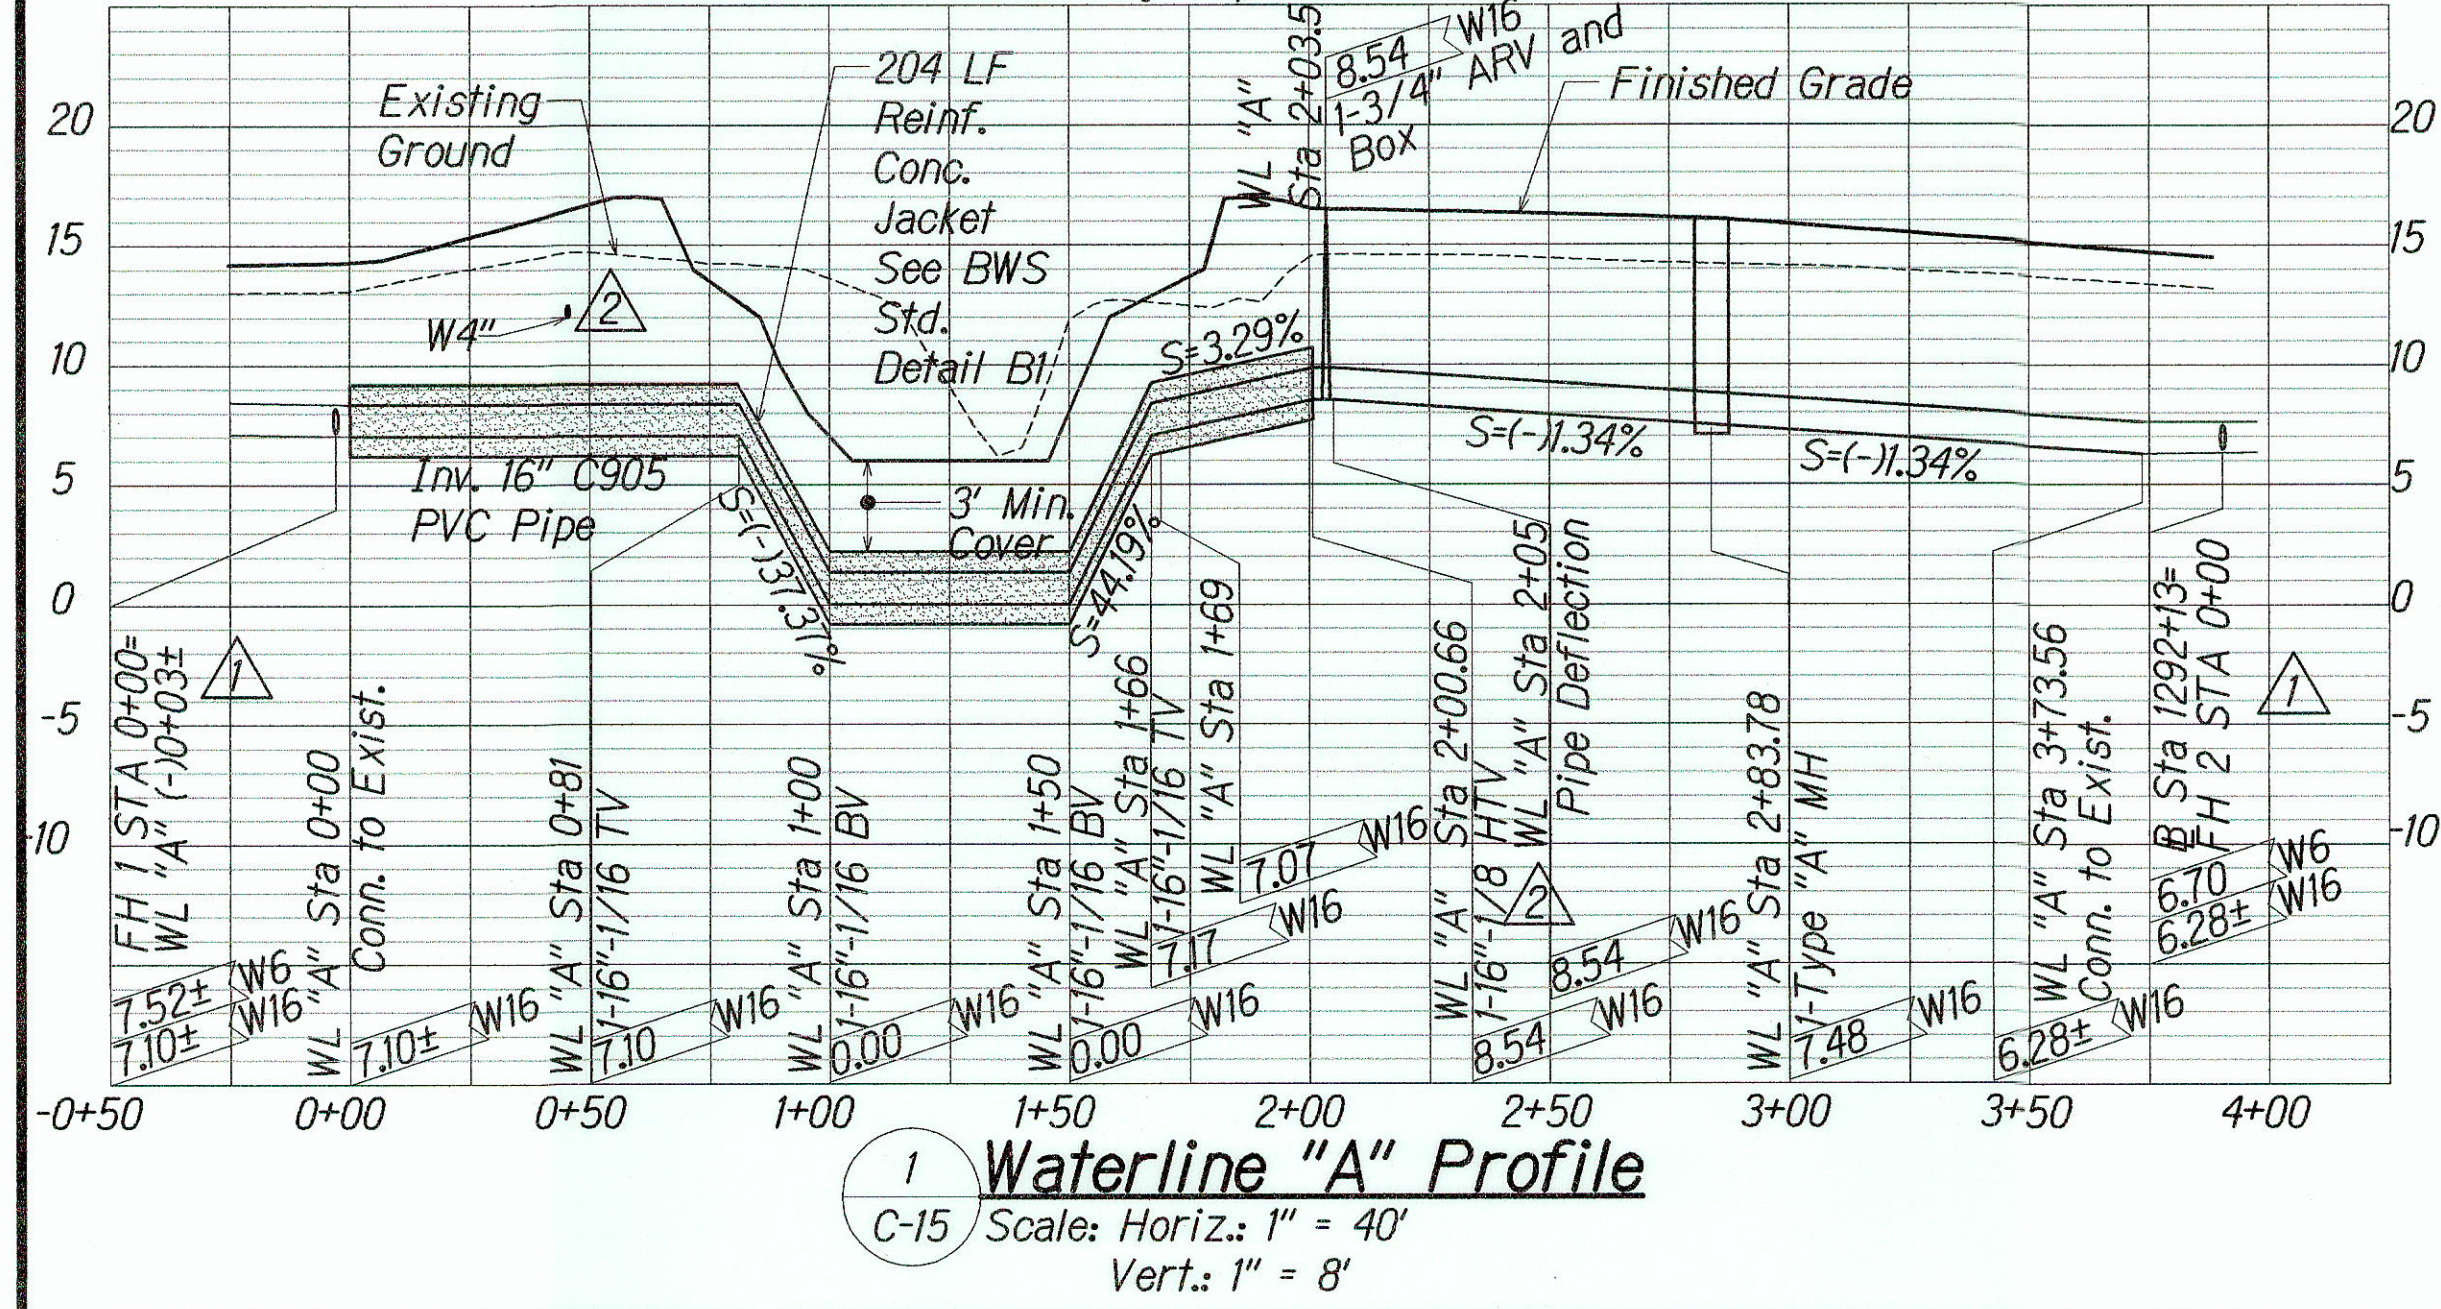
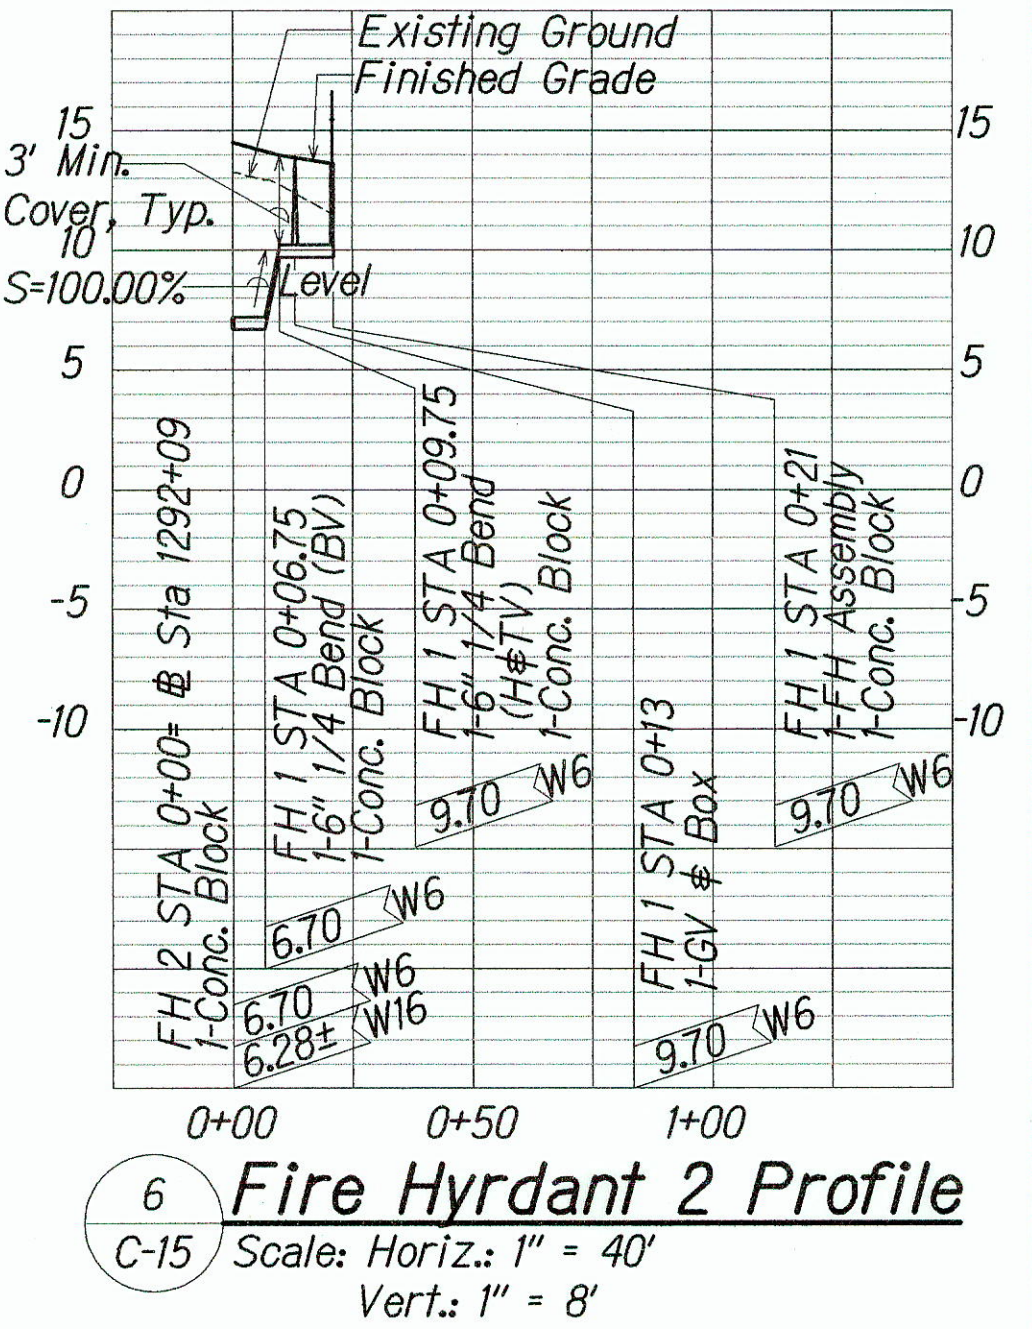
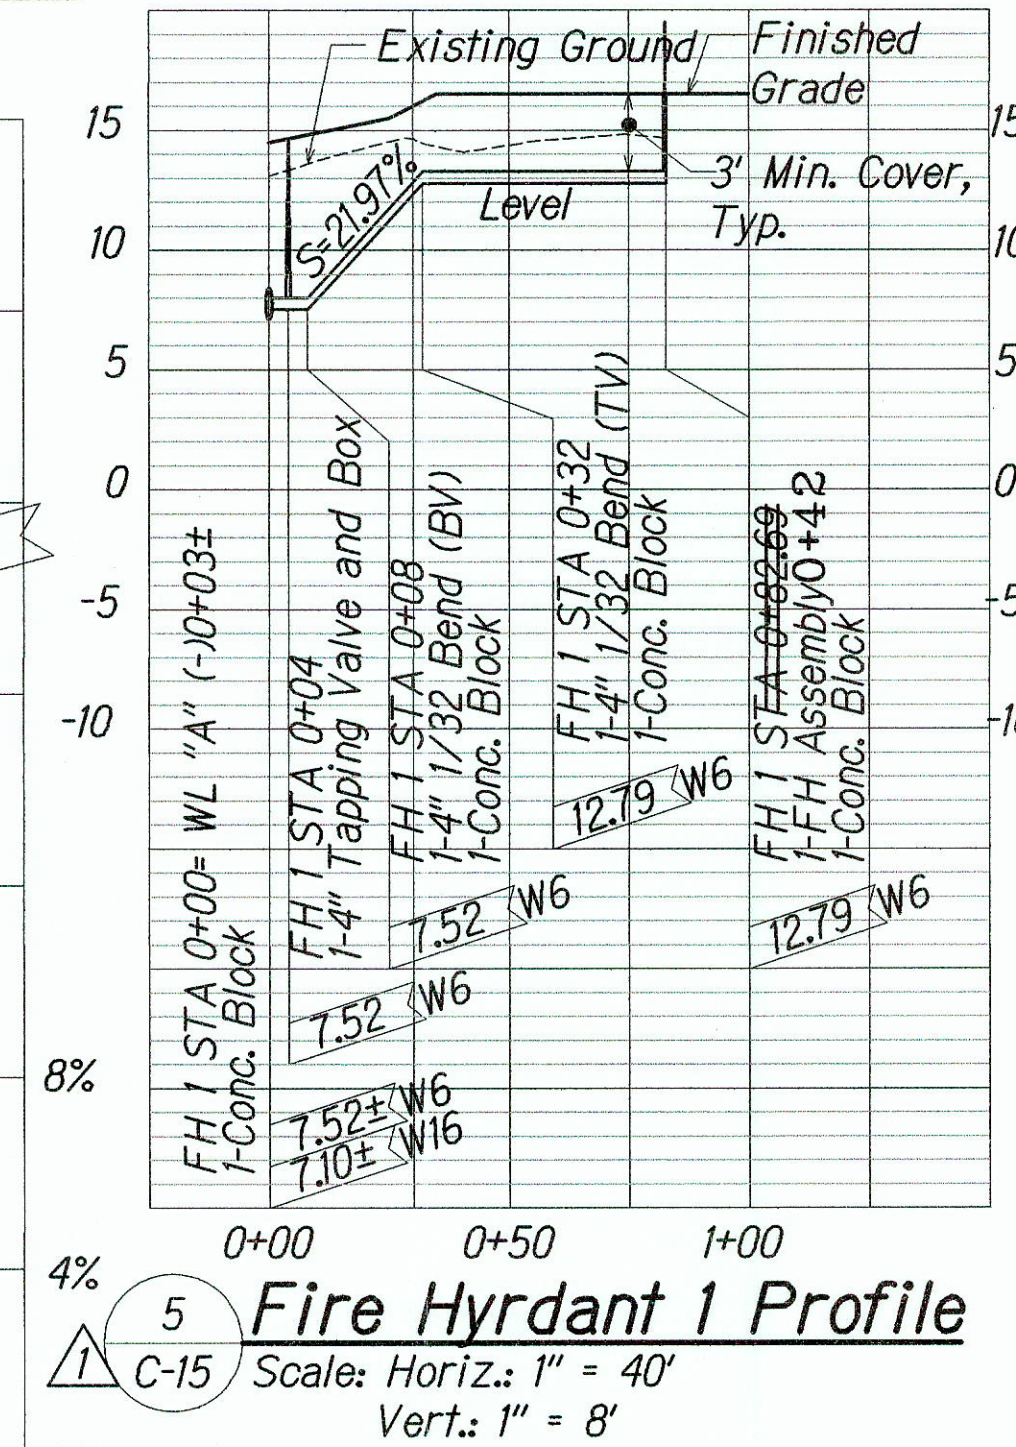
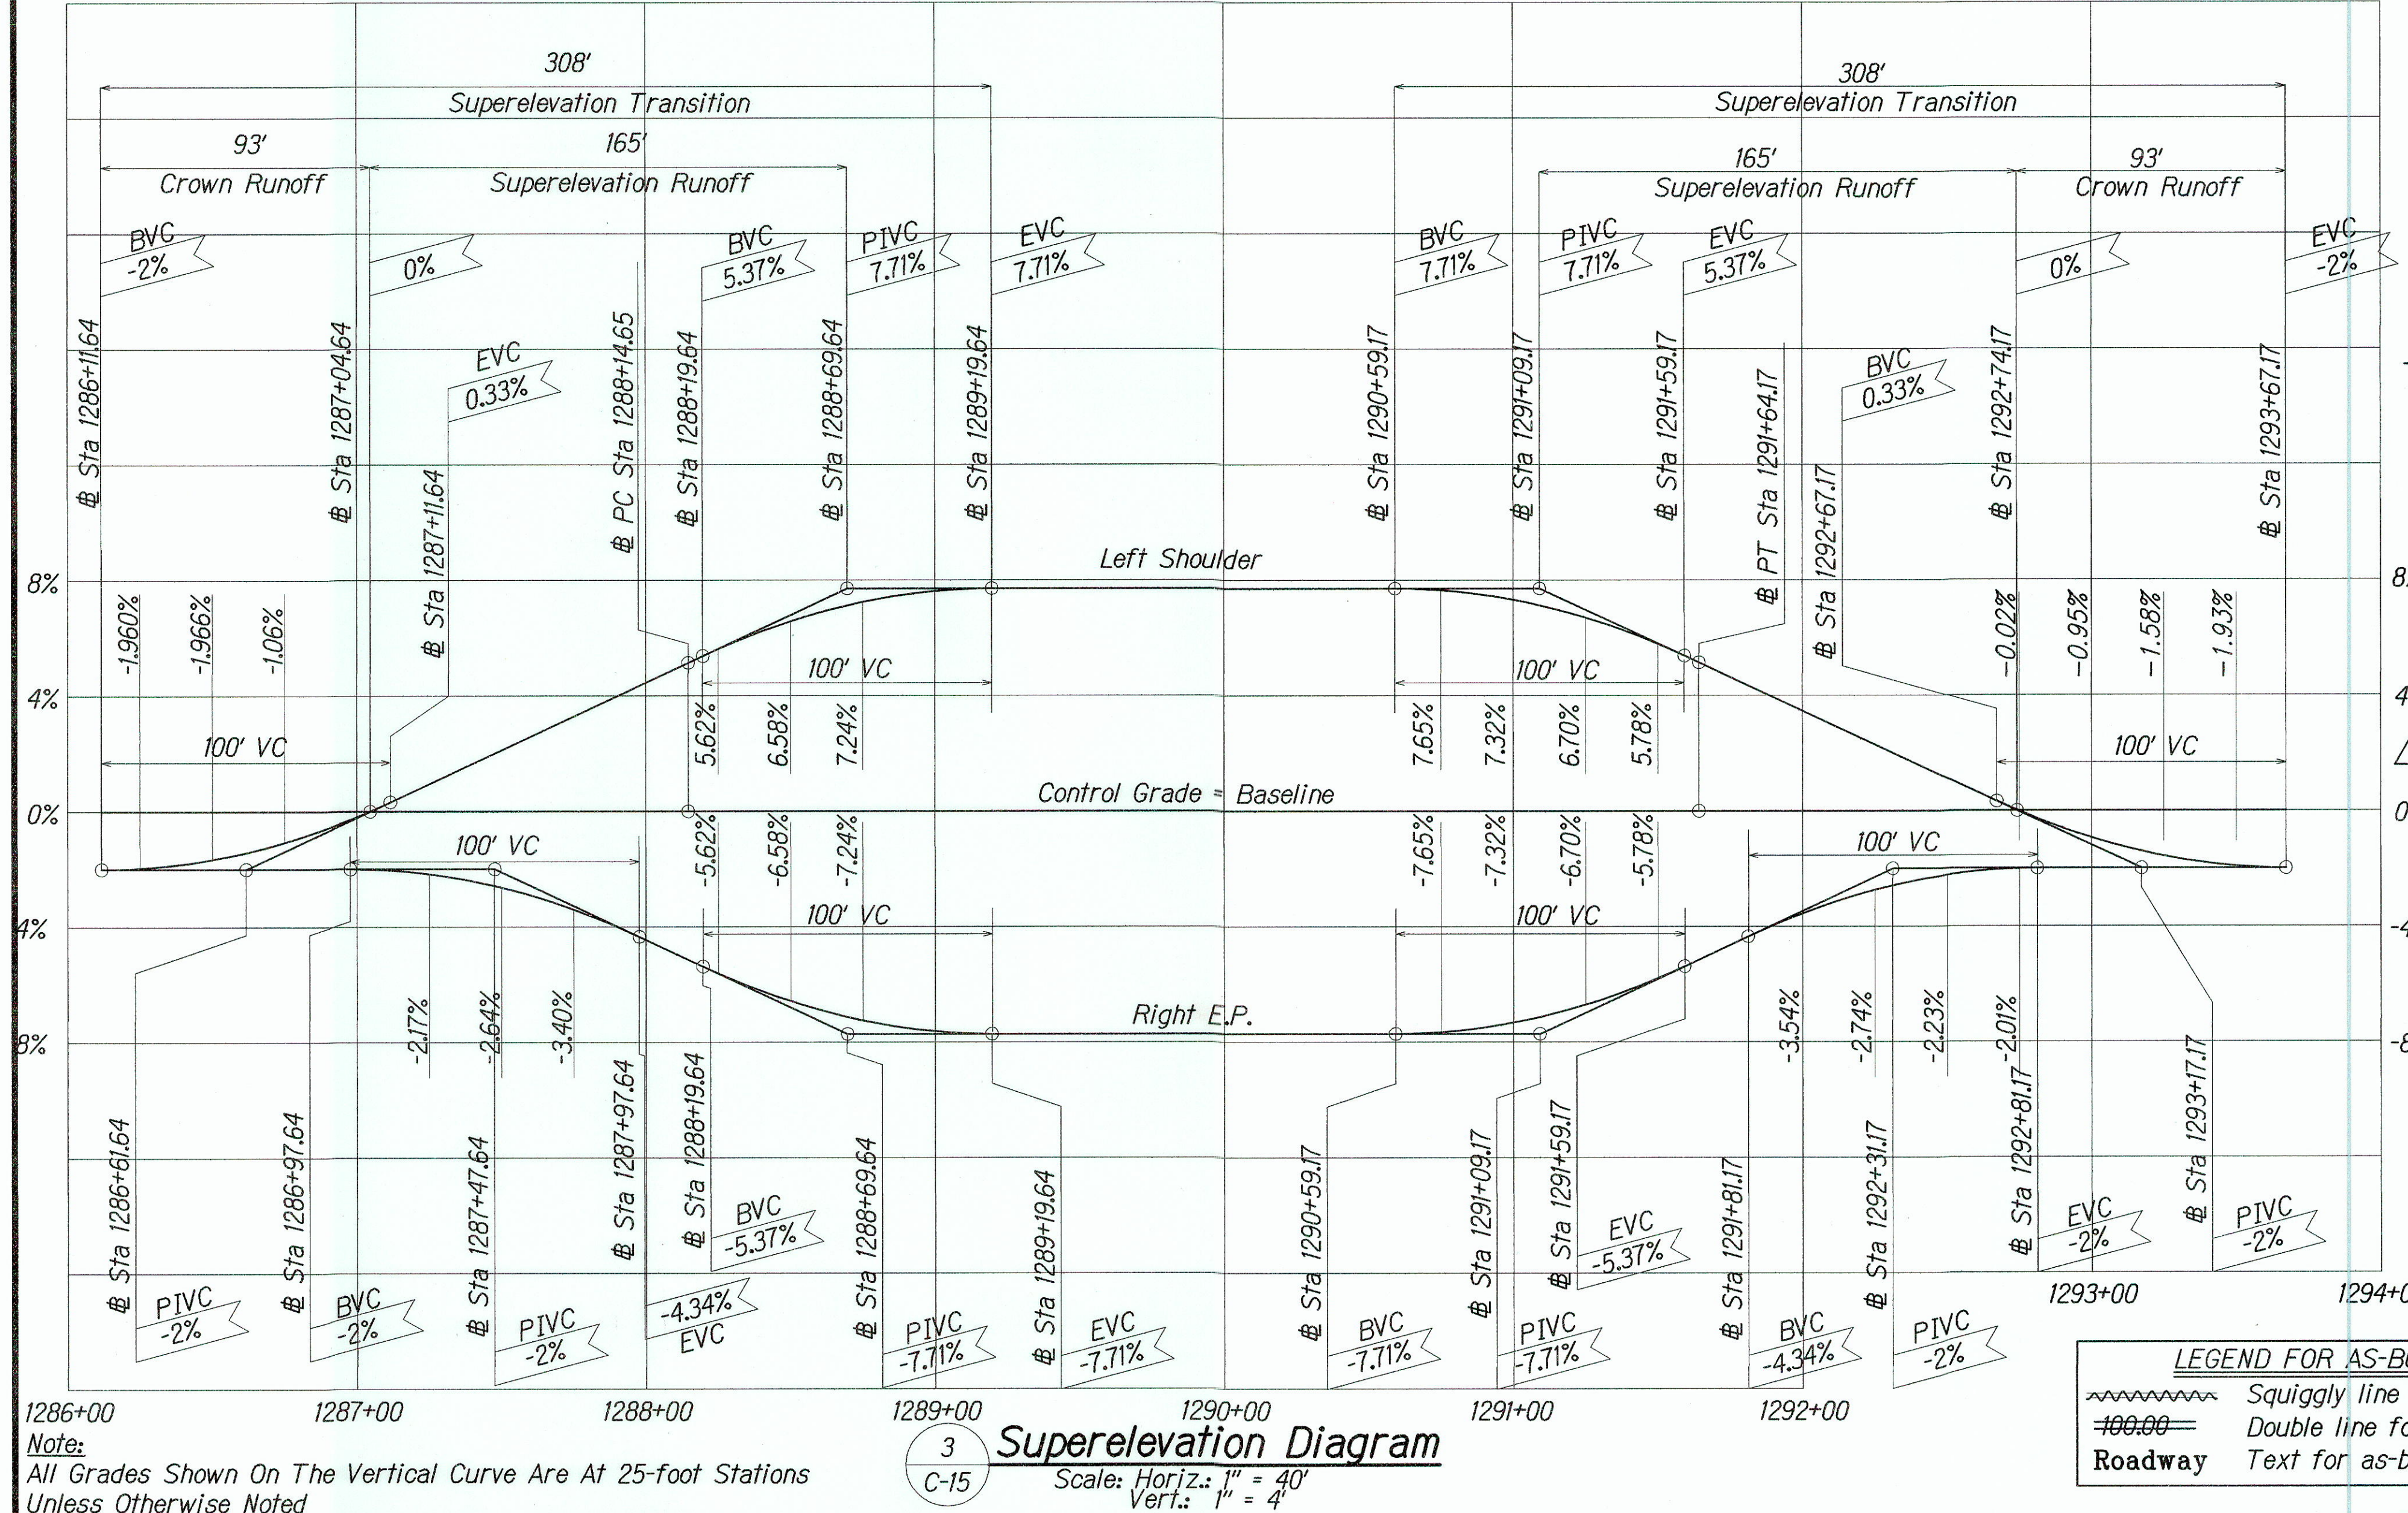


FED. ROAD DIST. NO.	STATE	FED. AID PROJ. NO.	FISCAL YEAR	SHEET NO.	TOTAL SHEETS
HAWAII	HAWAII	BR-083-1(50)	2005	C.O. 17	81

Note: Joints shall be Ductile Iron with Class-52 Polywrap. Waterline Concrete Jacketed Shall Be Ductile Iron.

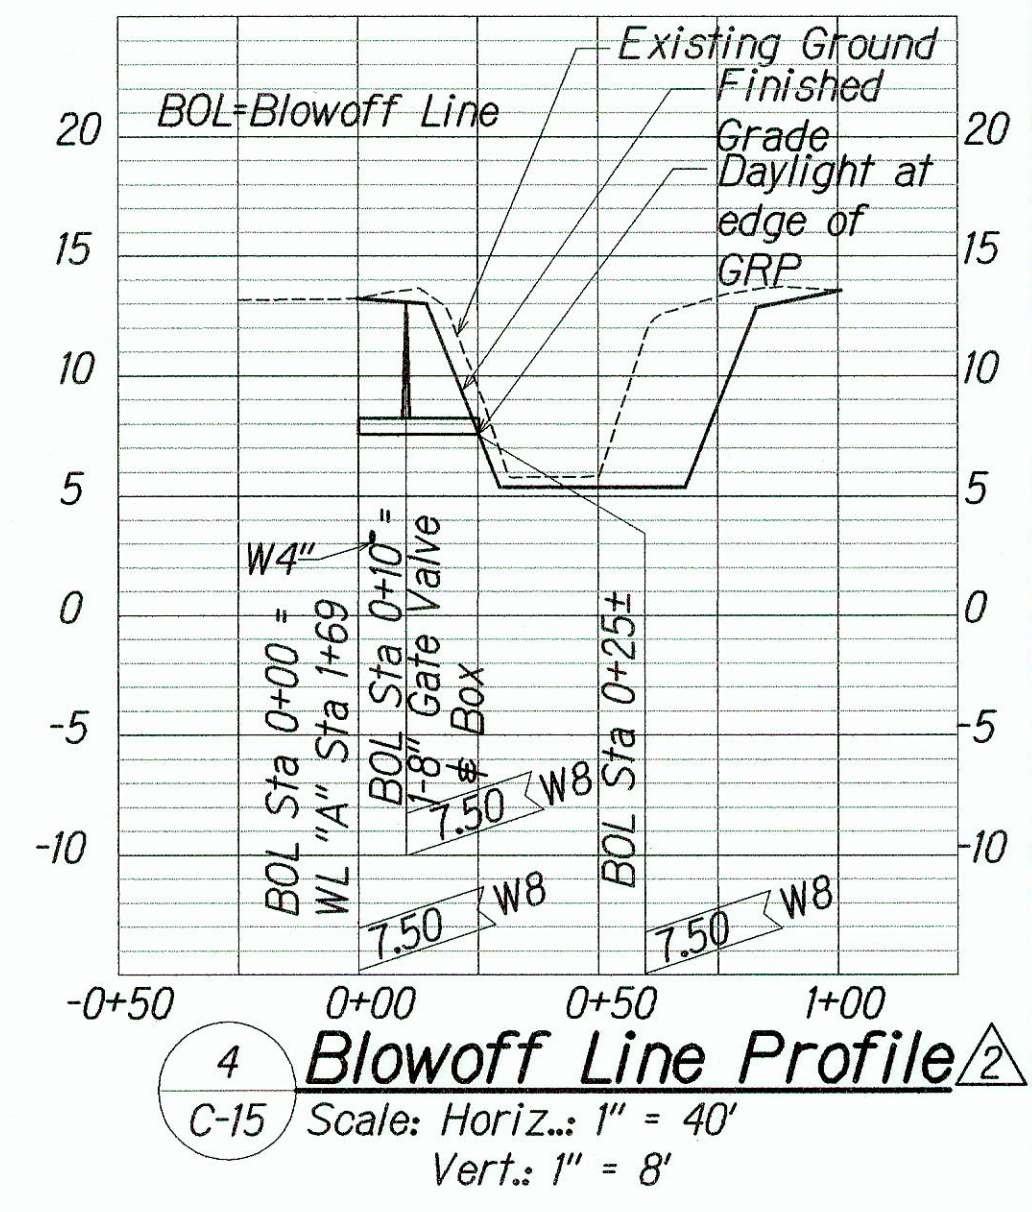

Note: Joints shall be Ductile Iron with Class-52 Polywrap. Waterline Concrete Jacketed Shall Be Ductile Iron.

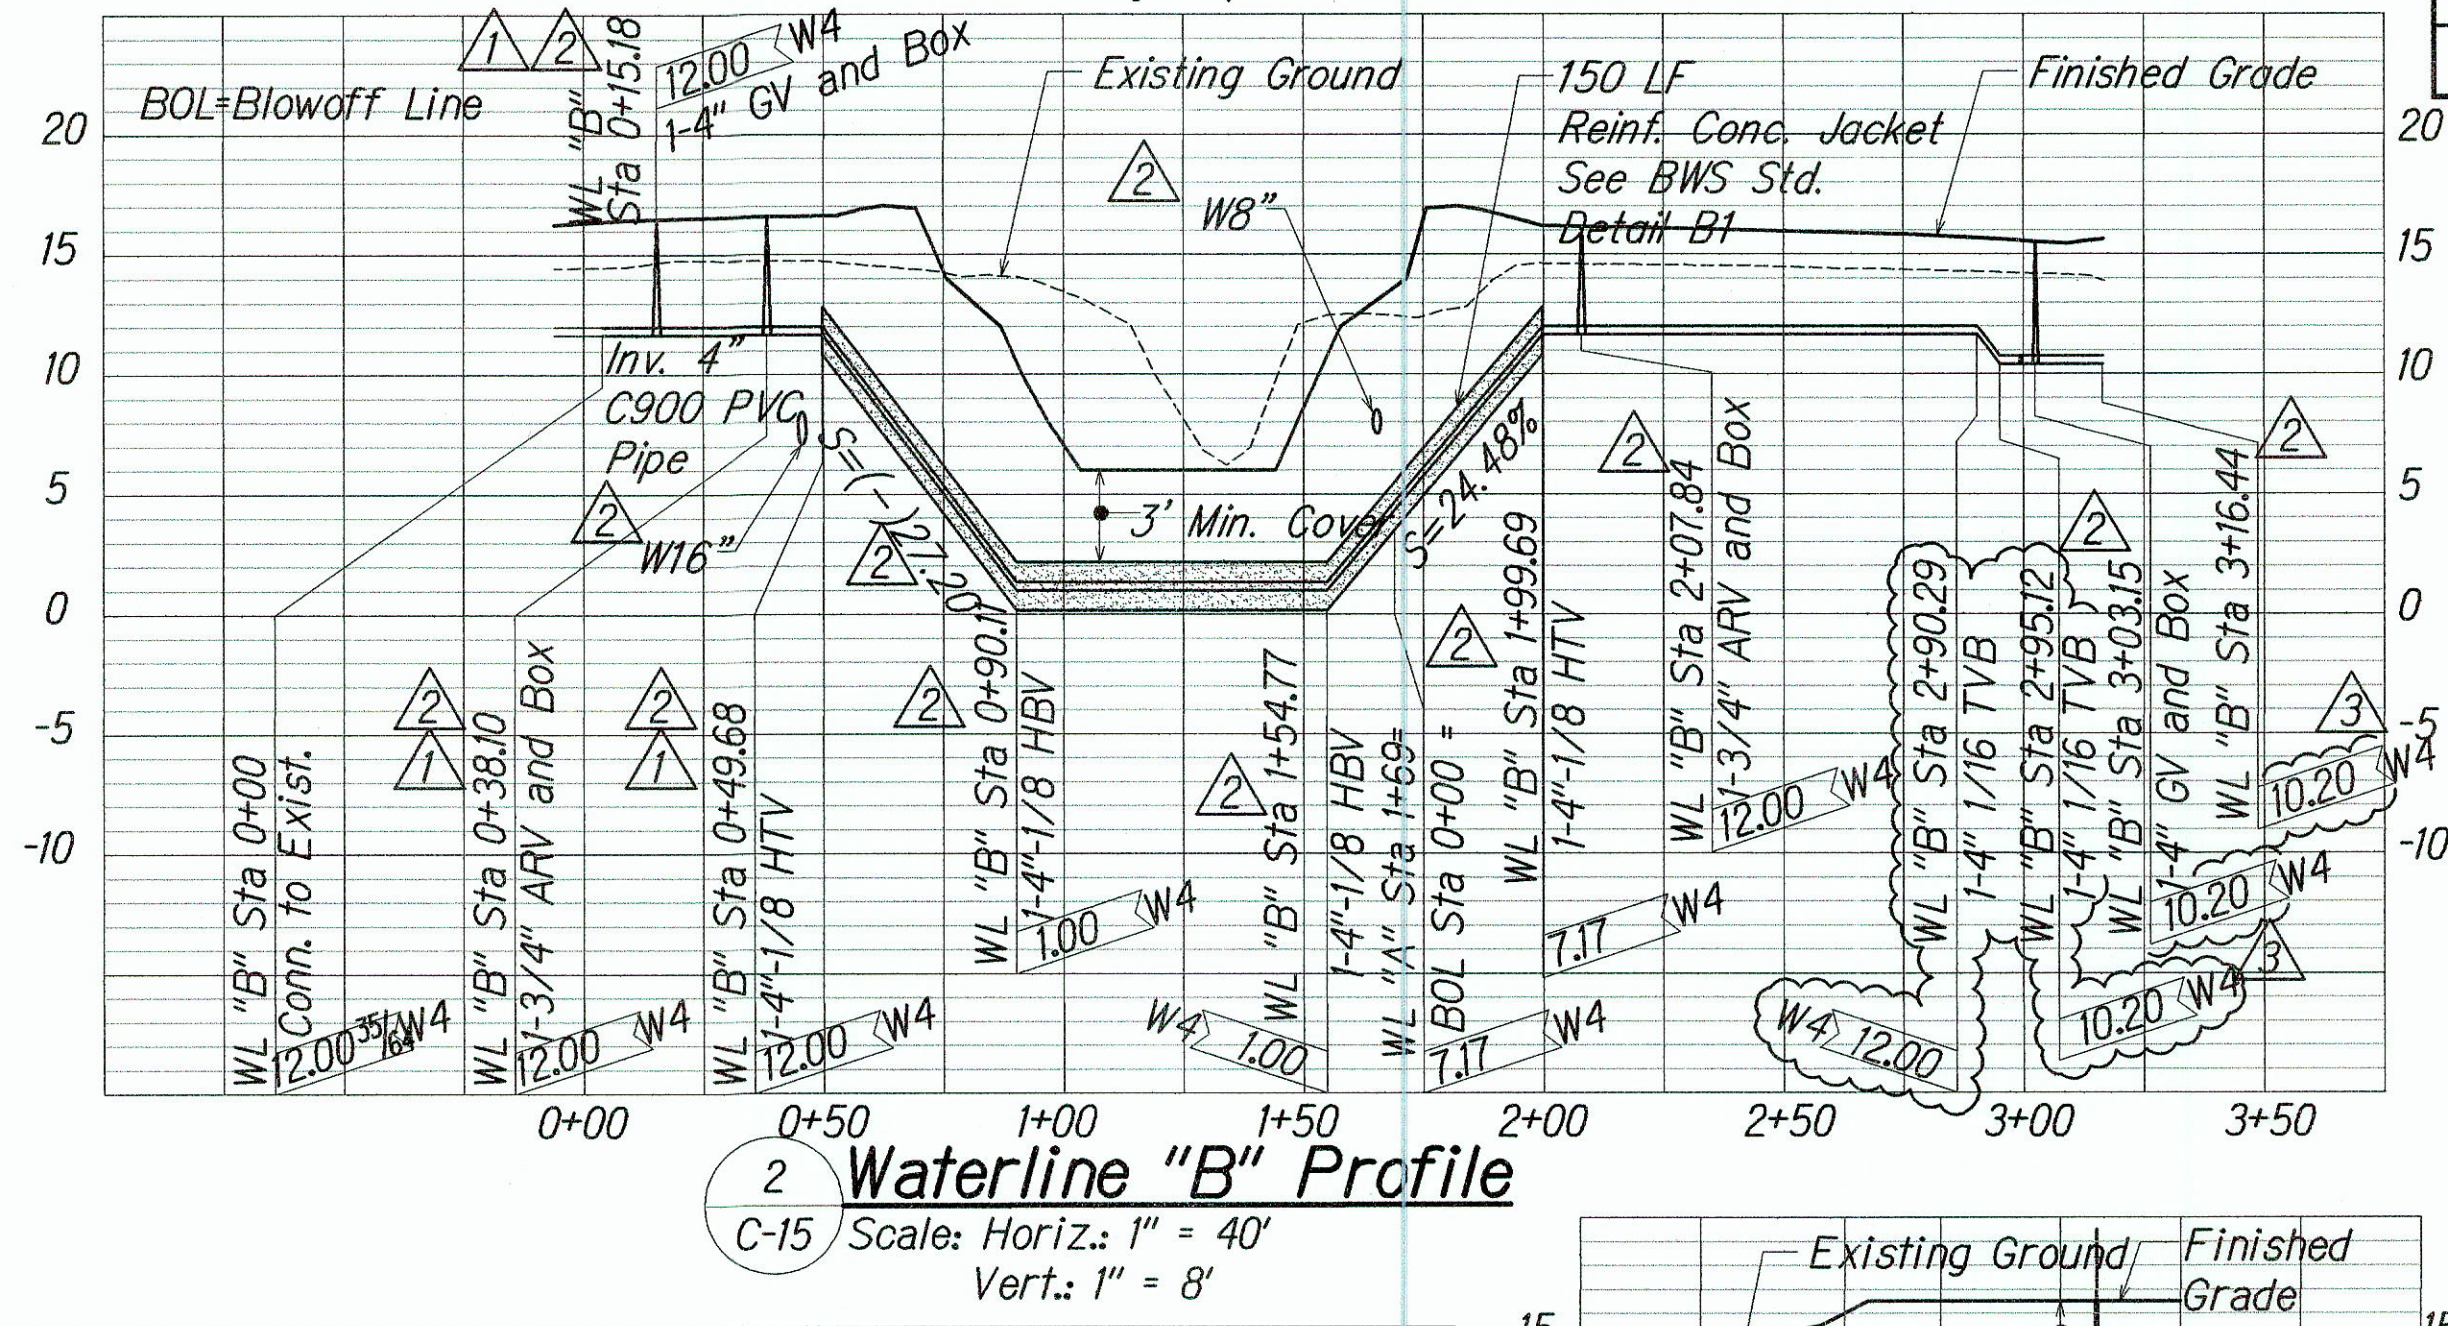

GRAPHIC SCALE:



SCALE: 1" = 40'



SCALE: 1" = 8'

Approval:

Robert Chun
Chief, Capital Projects Division, BWS
7/19/06
Date

6/21/07	3	Rev. W.L. "B" Profile for RFI No. 121
		Rev. W.L. profiles, Blowoff Line Profiles
		Rev. W.L. Profiles, Added FH Profiles

DATE	REVISION
------	----------

STATE OF HAWAII
DEPARTMENT OF TRANSPORTATION
HIGHWAYS DIVISION

KAMEHAMEHA HWY PROFILE

KAMEHAMEHA HIGHWAY
REPLACEMENT OF KOKOLOLO STREAM BRIDGE
Federal Aid Project No. BR-083-1(50)
Scale: As Shown Date: August 2004

SHEET No. **C-15** OF **51** SHEETS

LEGEND FOR AS-BUILT POSTING
Squiggly line for as-built deletion
Double line for as-built deletion
Roadway Text for as-built posting

CHAD M. McDONALD
LICENSED PROFESSIONAL ENGINEER
No. 9793-C
HAWAII, U.S.A.


This work was prepared by me or under my supervision

CHAD M. McDONALD
4/30/2014
MITSUNAGA & ASSOCIATES, INC. EXP. DATE

NOTE: Contractor to check and verify dimensions at job before proceeding with work.


"AS-BUILT"

FED. ROAD DIST. NO.	STATE	FED. AID PROJ. NO.	FISCAL YEAR	SHEET NO.	TOTAL SHEETS
HAWAII	HAWAII	BR-083-1(50)	2005	C.O. 17S-1	81

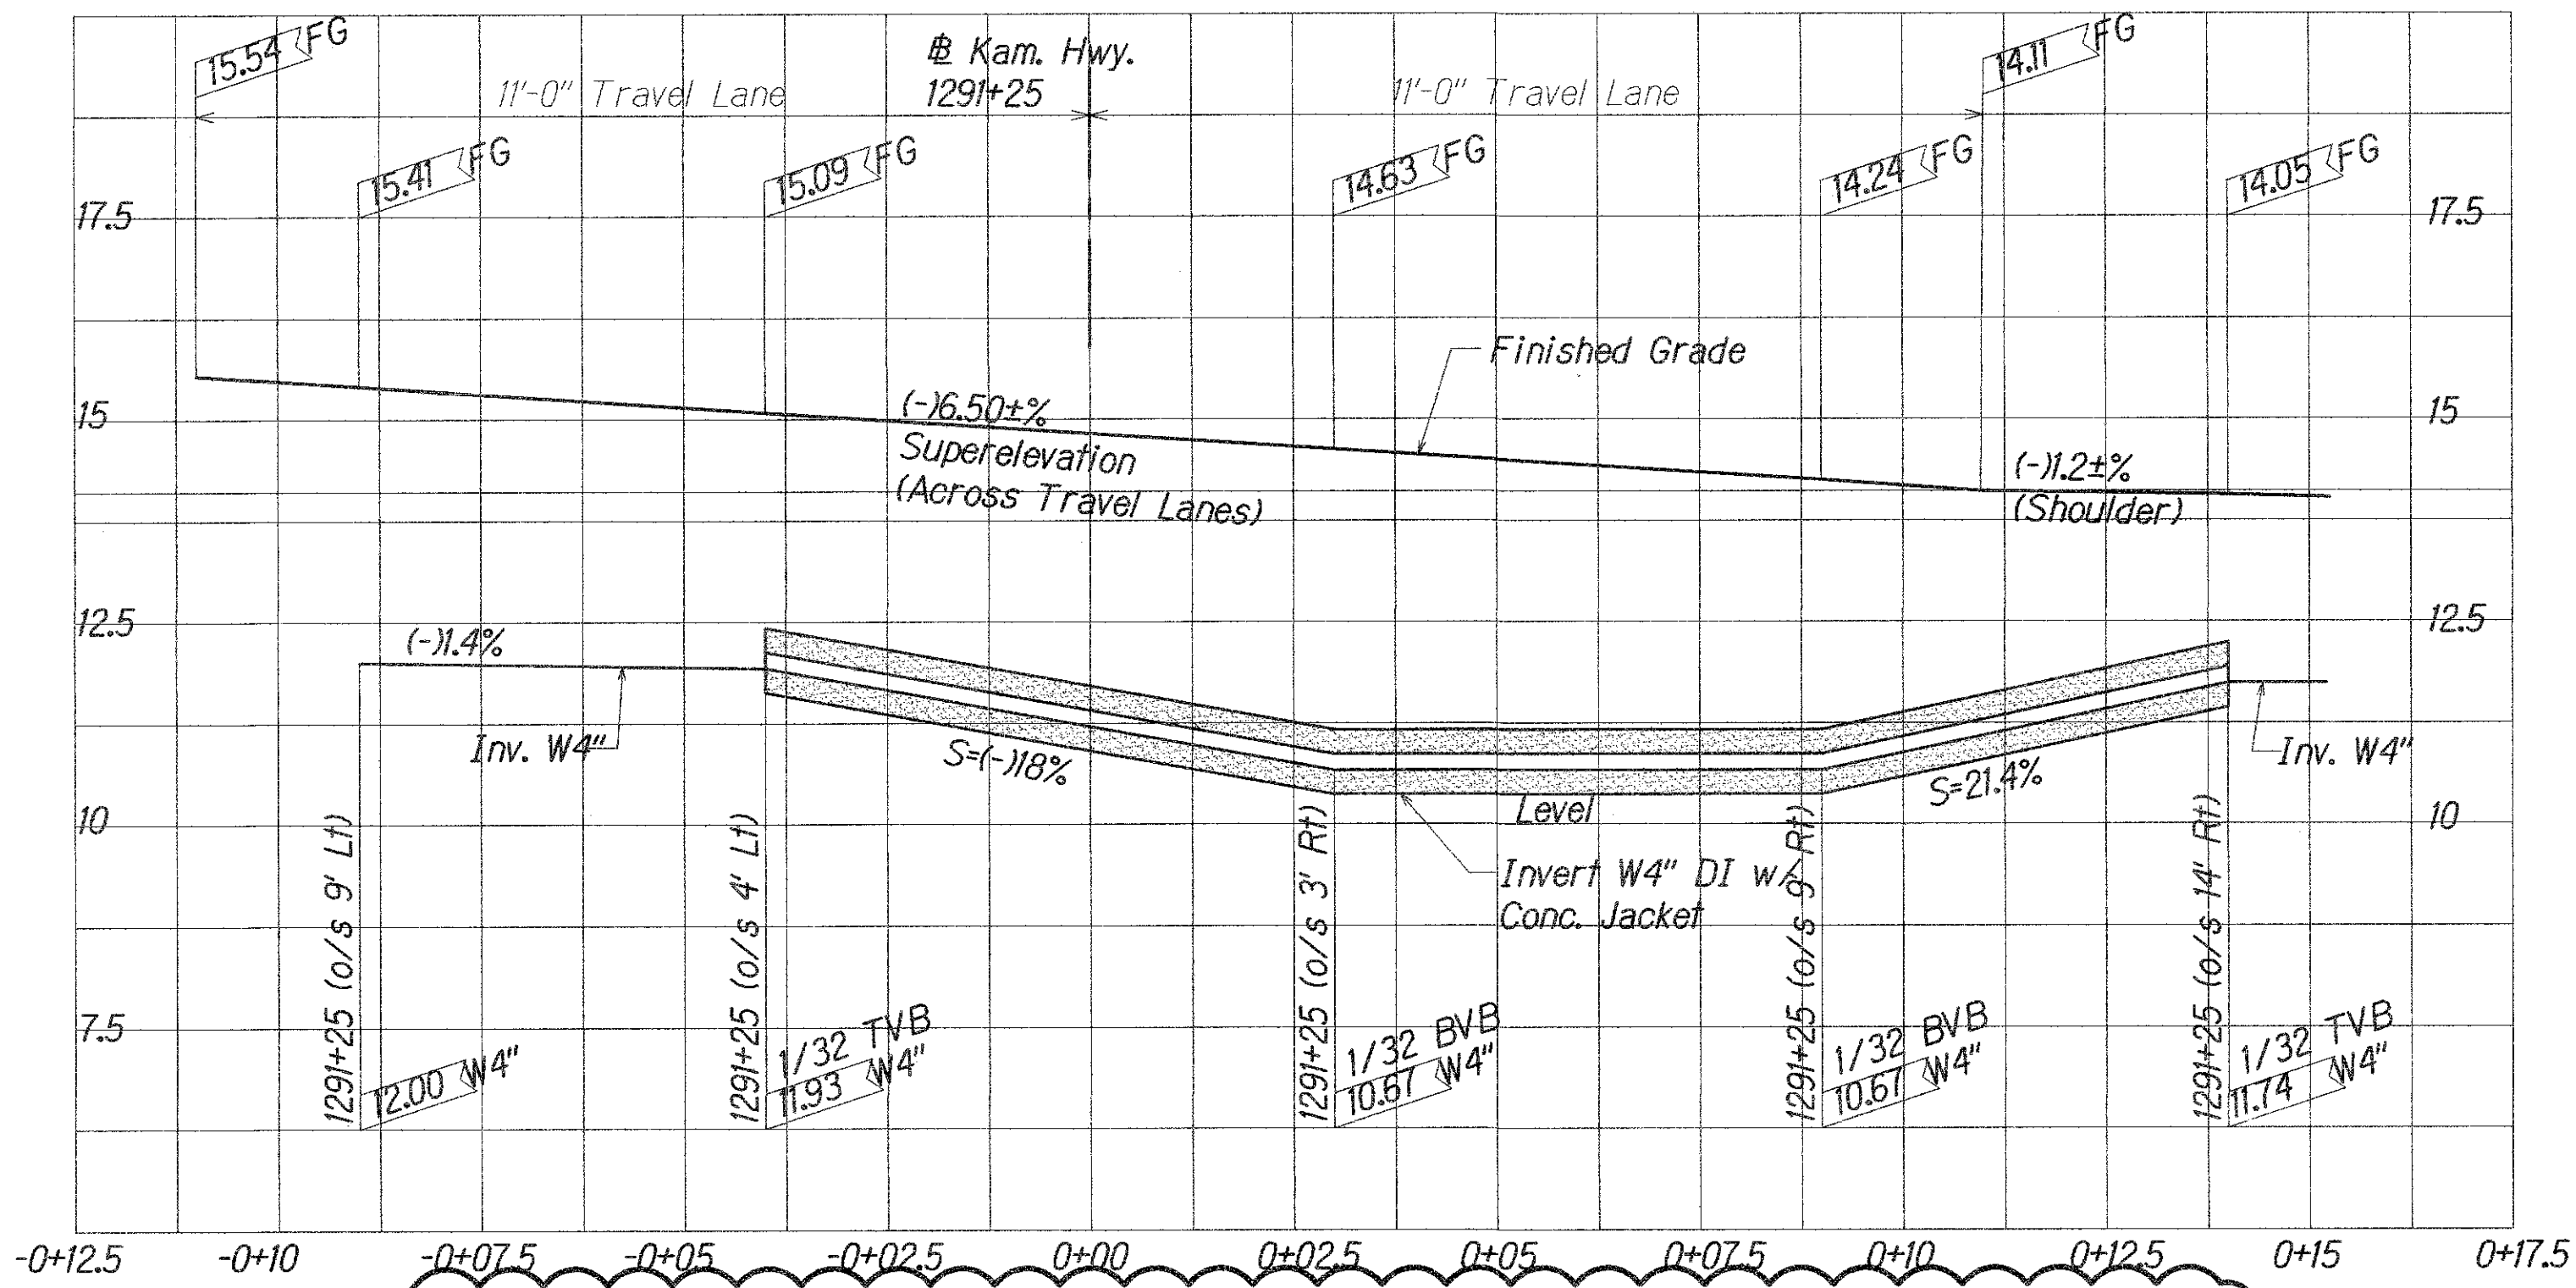

1 Waterline Lateral Profile at B.L. Sta. Kamehameha Hwy 1291+25
 C-15a Scale: Horiz.: 1" = 2'
 Vert.: 1" = 2'

SURVEY PLOTTED BY	DATE
DESIGNED BY	
TRACED BY	
DESIGNED BY	
QUANTITIES BY	
CHECKED BY	
ORIGINAL PLAN	
NOTE BOOK	
No.	

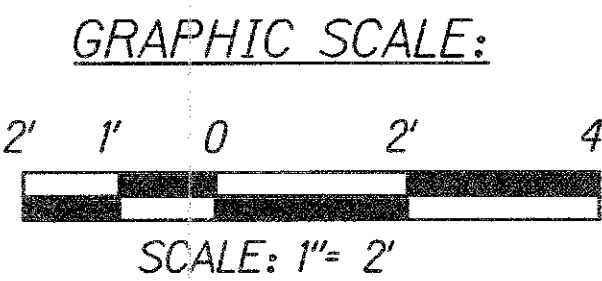

CHAD M. MCDONALD
 LICENSED PROFESSIONAL ENGINEER
 No. 9793-C
 HAWAII, U.S.A.

This work was prepared by me or under my supervision

Chad M. McDonald
 4/30/2014
 MITSUNAGA & ASSOCIATES, INC. EXP. DATE

NOTE: Contractor to check and verify dimensions at job before proceeding with work.

6/21/07	3 Added Sht. W.L. Lateral Prof.-RFI #118
DATE	REVISION

STATE OF HAWAII
 DEPARTMENT OF TRANSPORTATION
 HIGHWAYS DIVISION

KAMEHAMEHA HWY PROFILE

KAMEHAMEHA HIGHWAY
 REPLACEMENT OF KOKOLOLO STREAM BRIDGE
 Federal Aid Project No. BR-083-1(50)
 Scale: As Noted Date: August 2004

SHEET No. C-15a OF 51 SHEETS