




FED. ROAD DIST. NO.	STATE	FED. AID PROJ. NO.	FISCAL YEAR	SHEET NO.	TOTAL SHEETS
HAWAII	HAWAII	BR-083-1(50)	2005	7	81

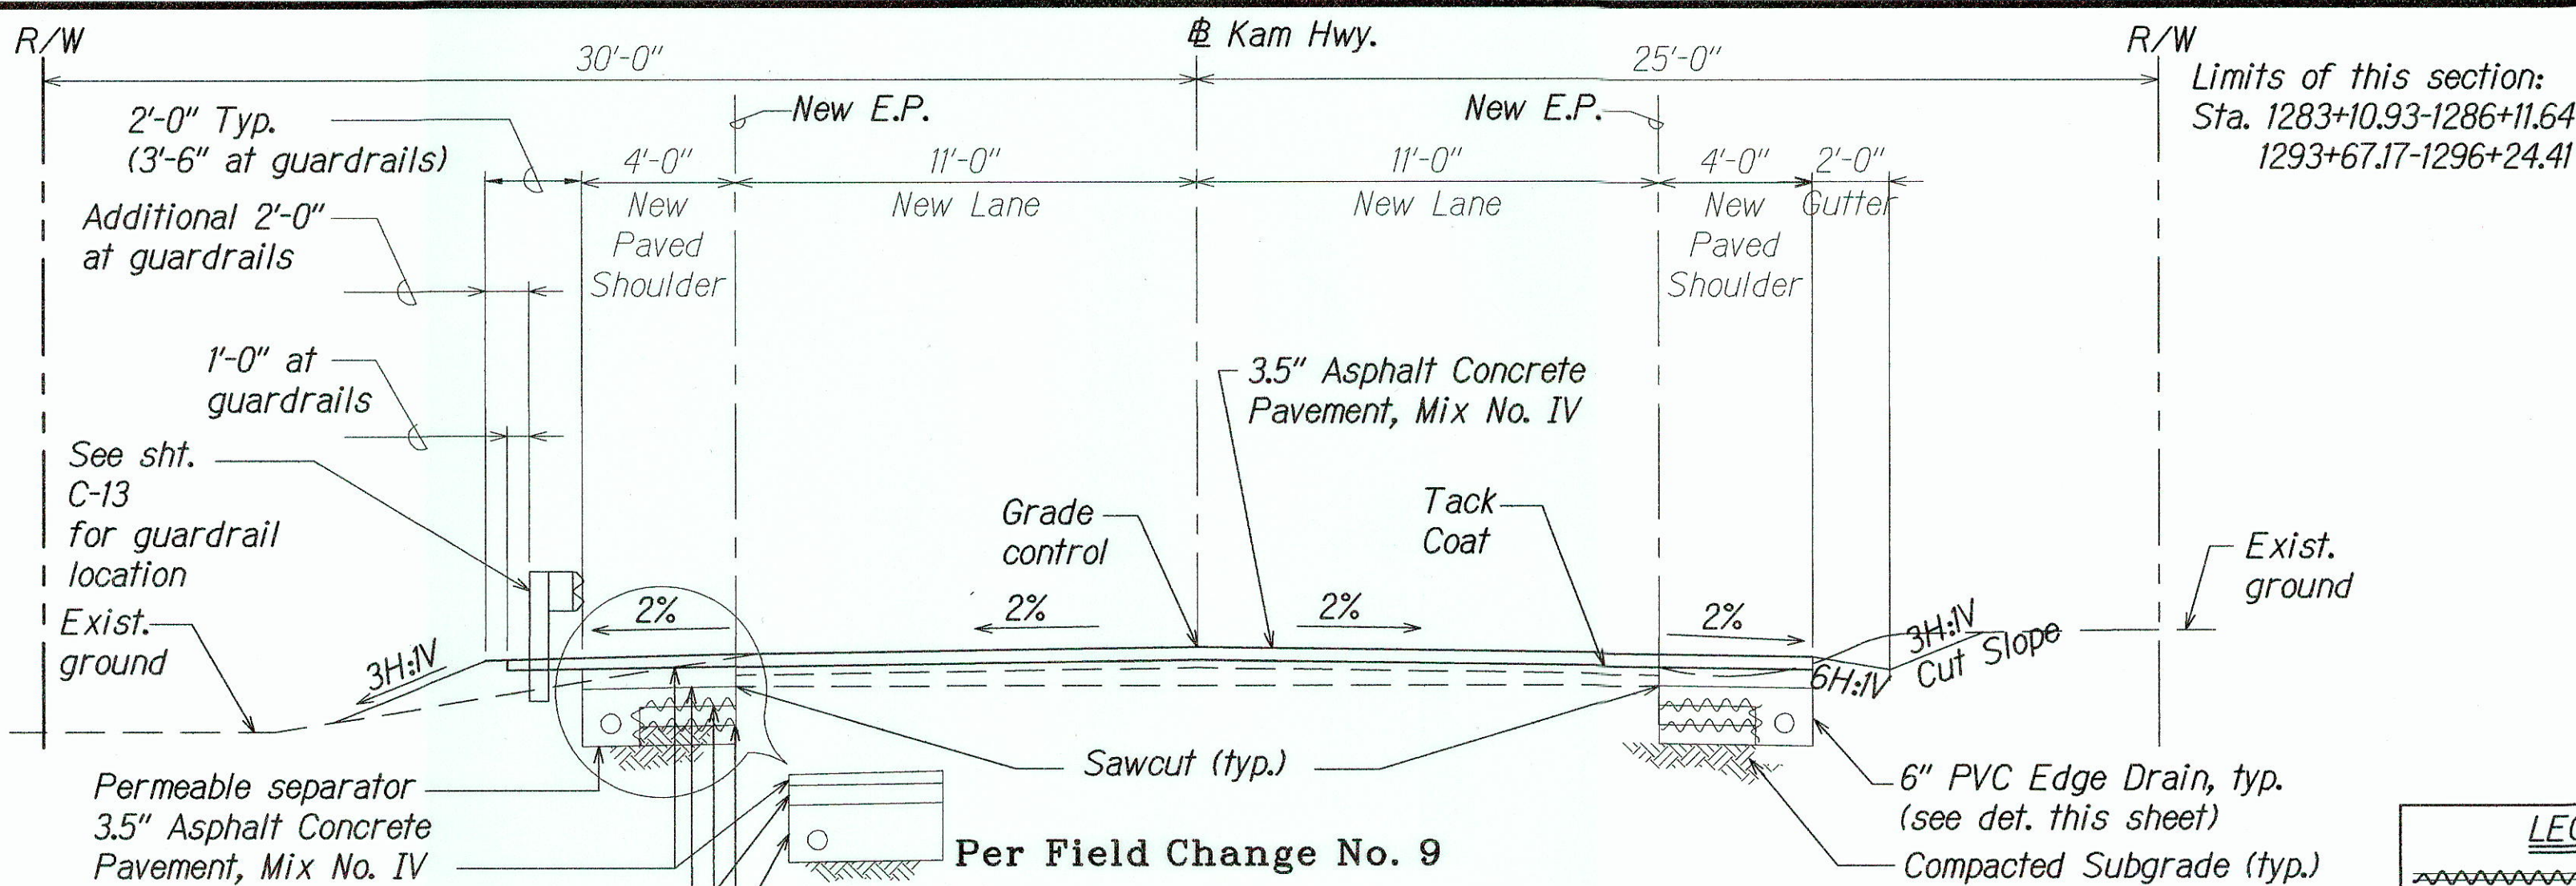

TYPICAL TANGENT SECTION - 1
Scale: 1/4" = 1'-0"

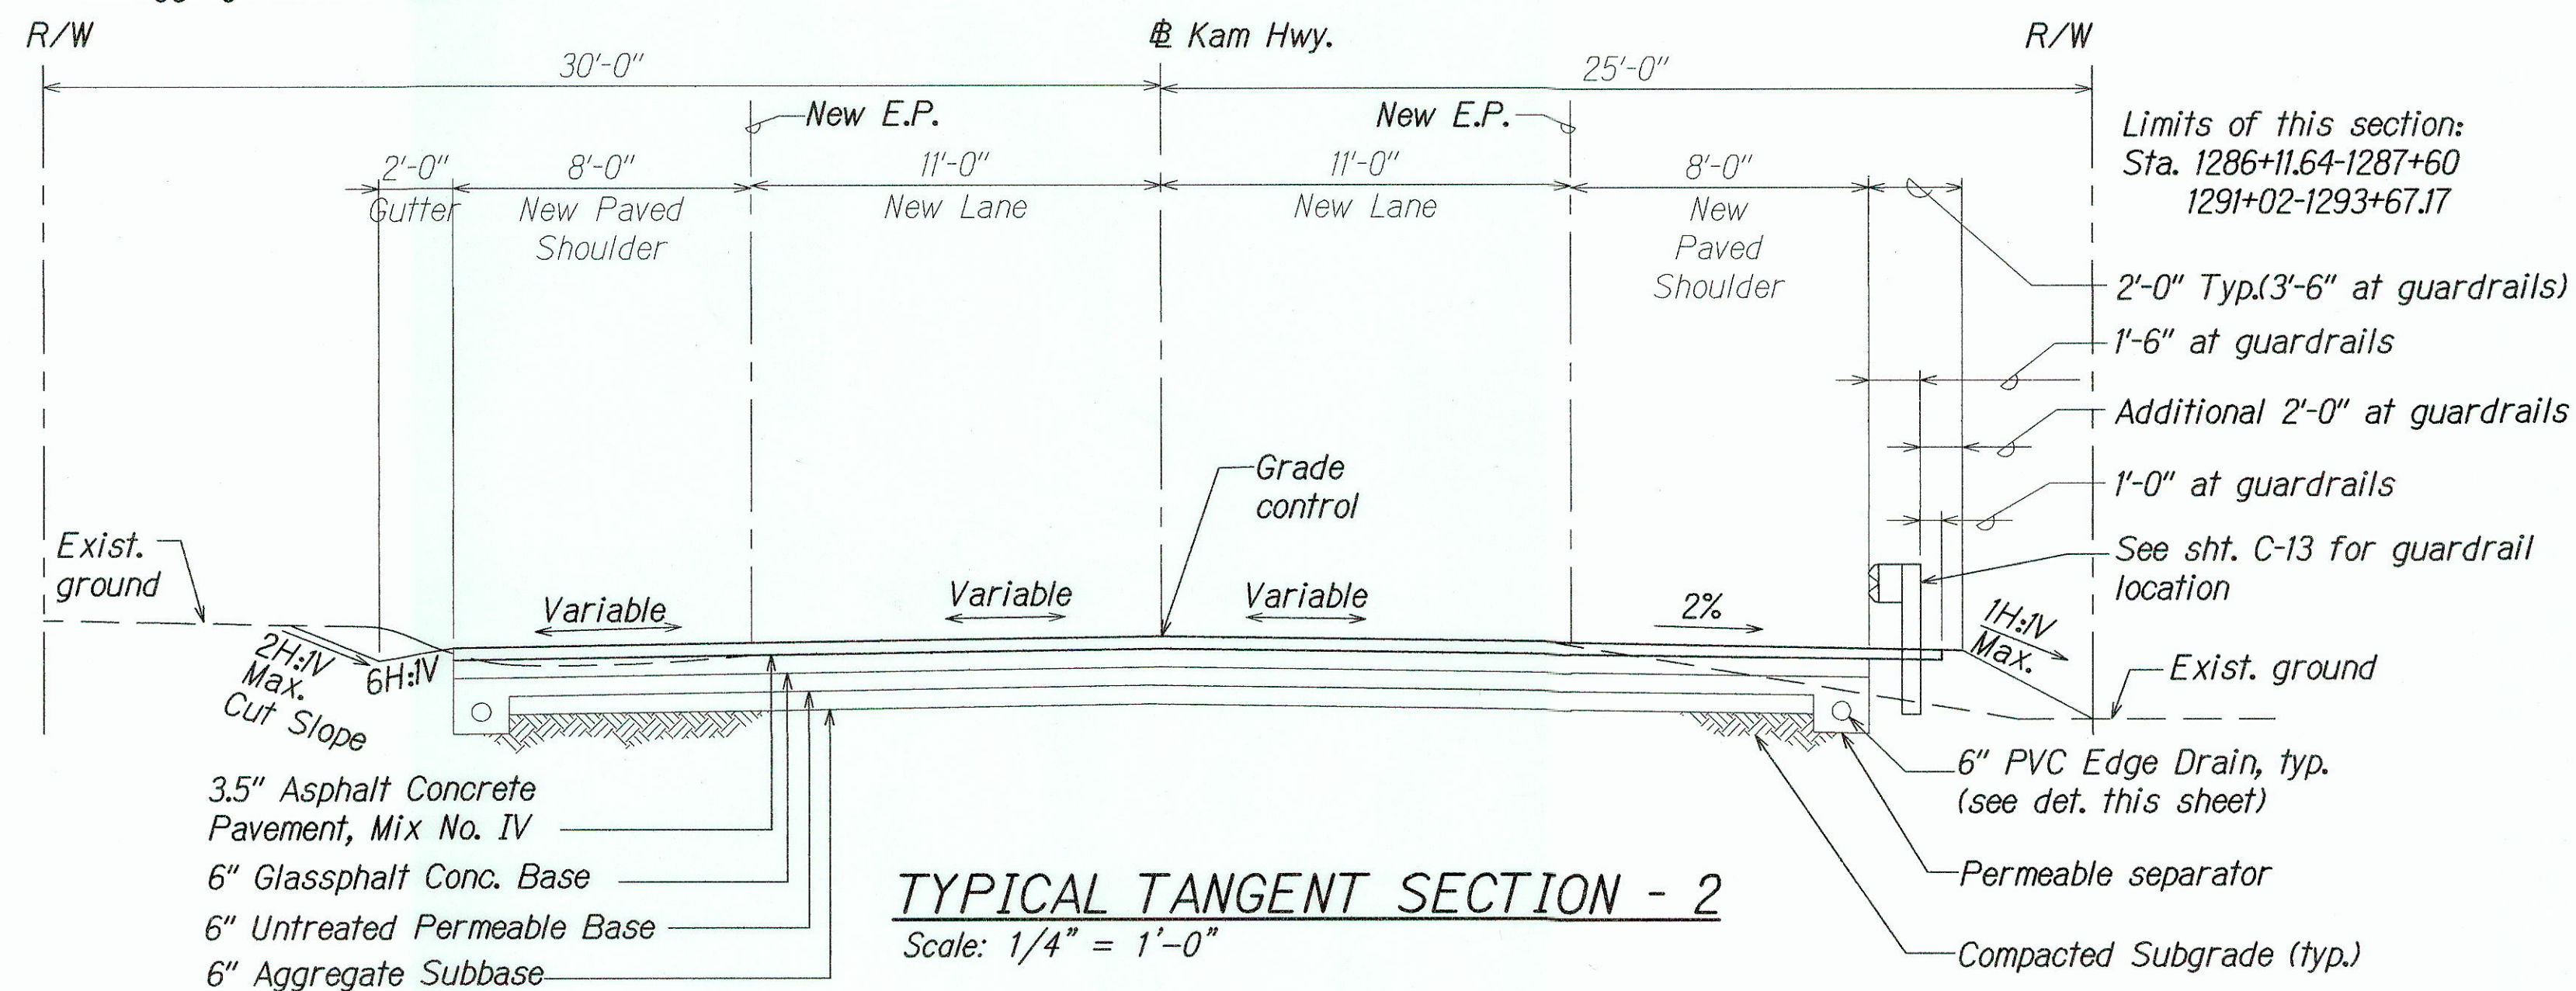


TYPICAL TANGENT SECTION - 2
Scale: 1/4" = 1'-0"

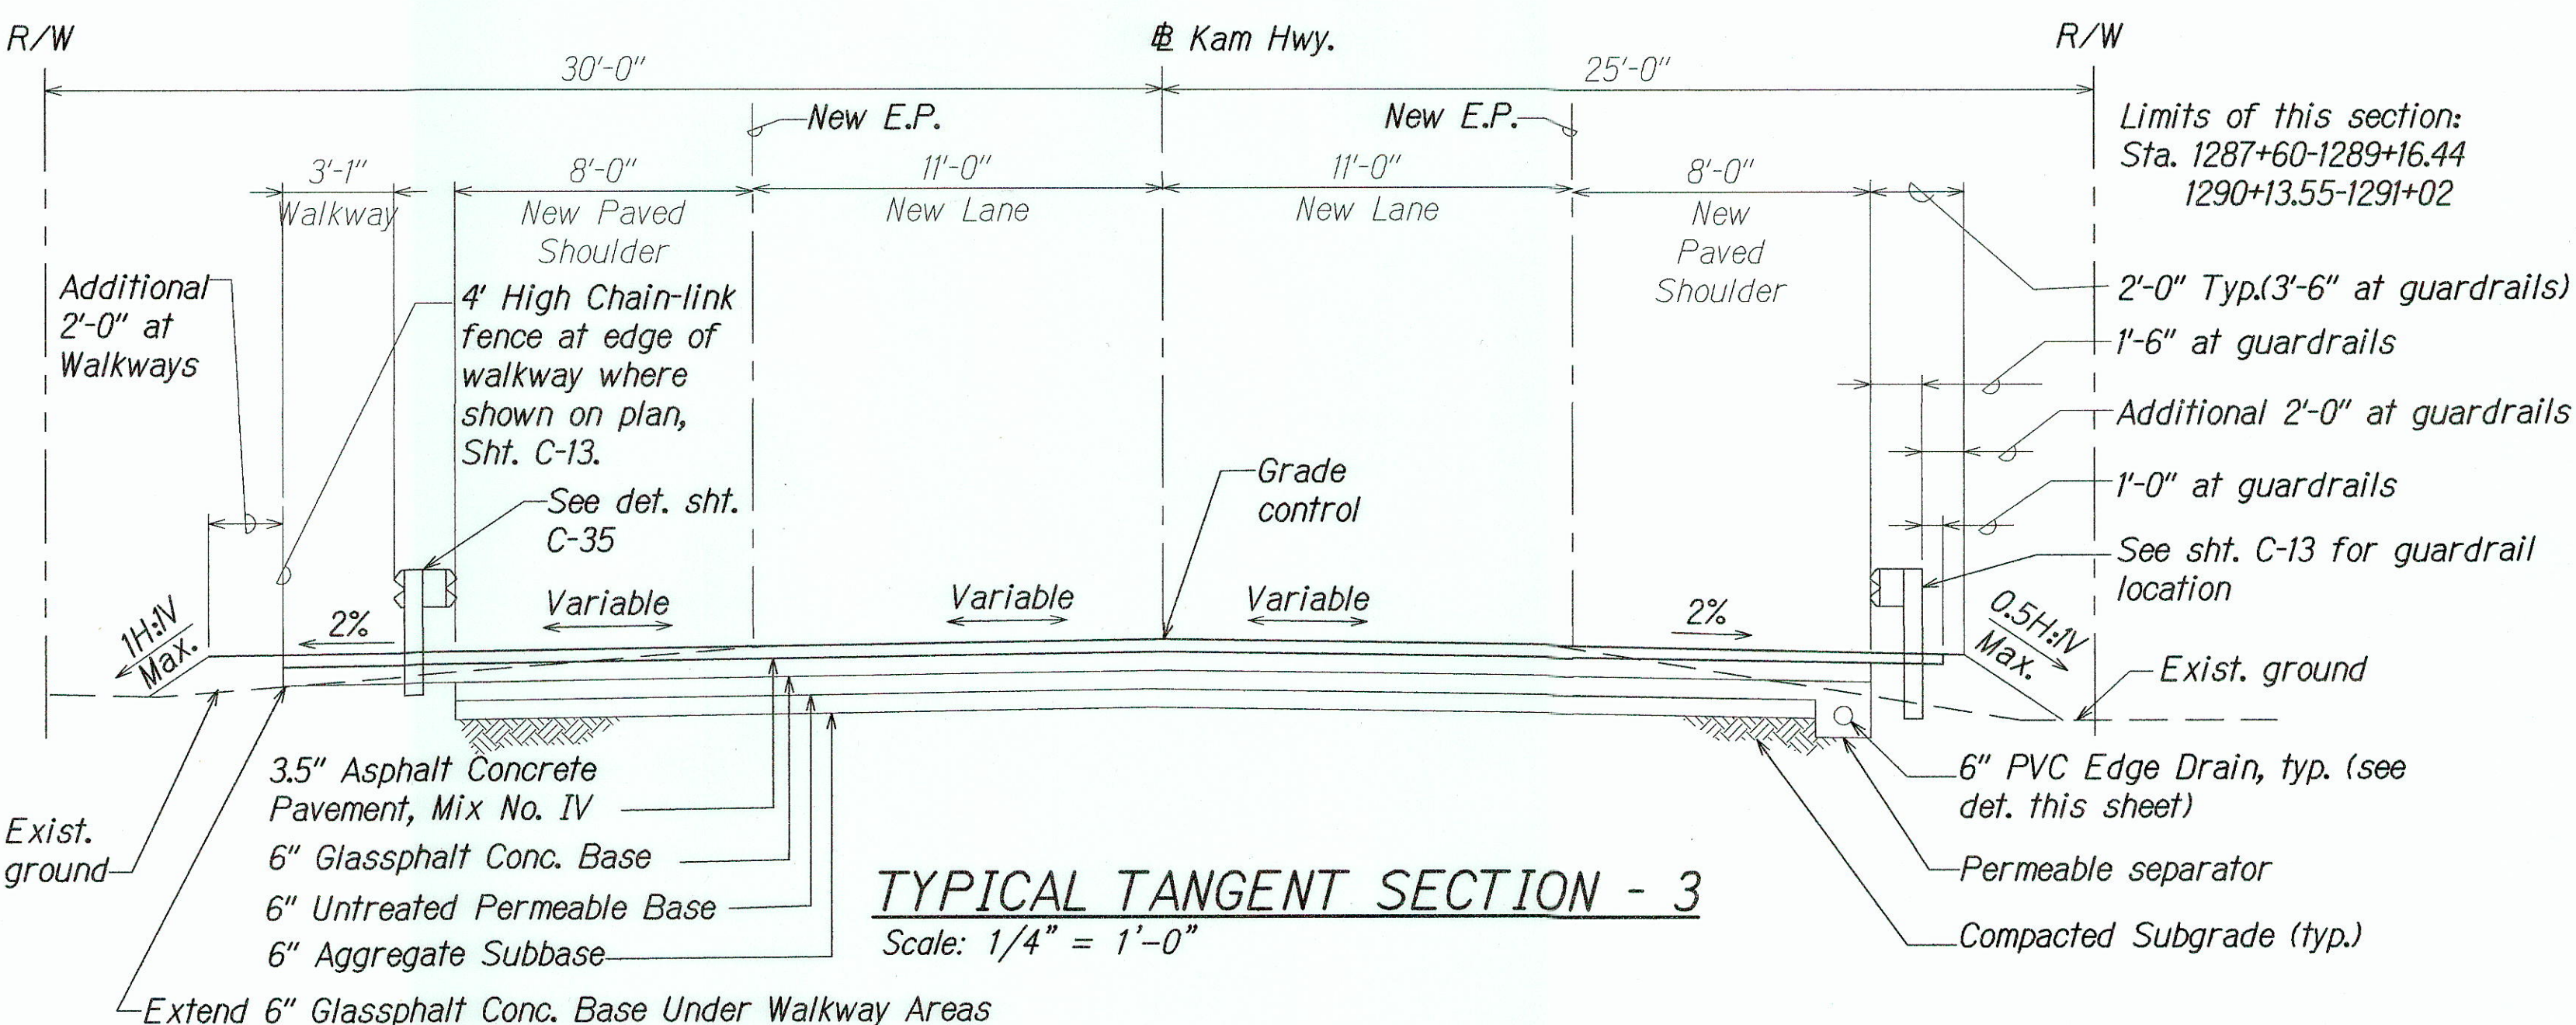


TYPICAL TANGENT SECTION - 3
Scale: 1/4" = 1'-0"


Sta. 1283+10.93-1283+165 Rt
Tangent Section Built per Plan
-Field Change No. 9

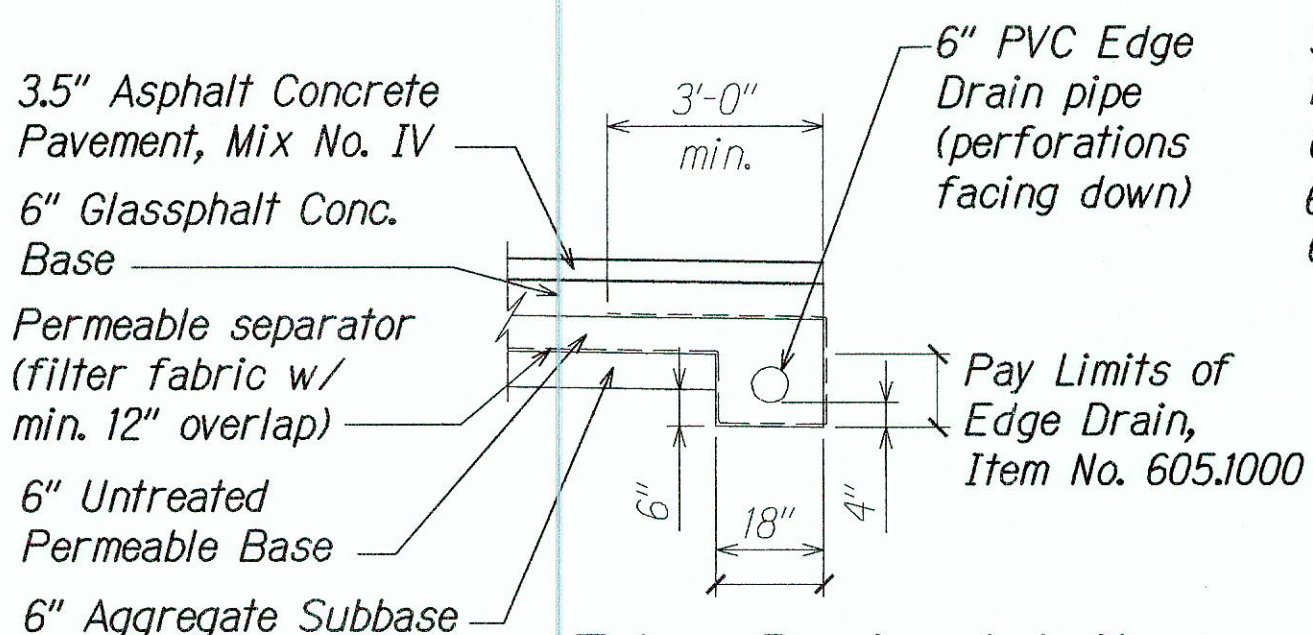


Edge Drain detail
Not to scale

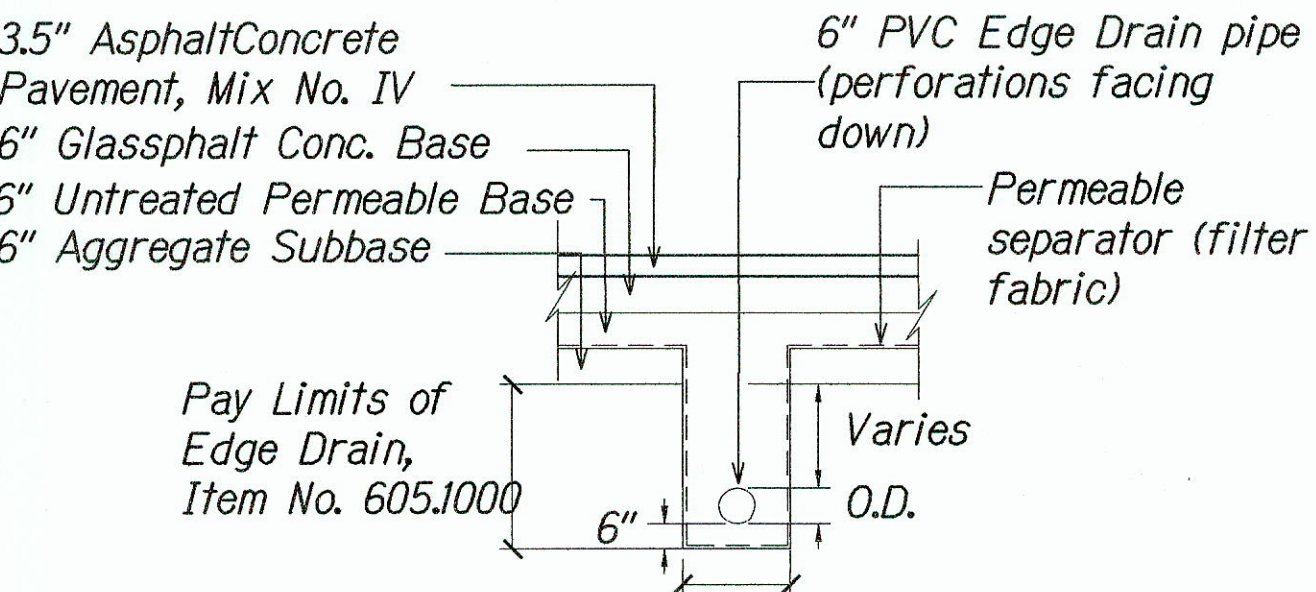

Transverse Edge Drain detail
Not to scale


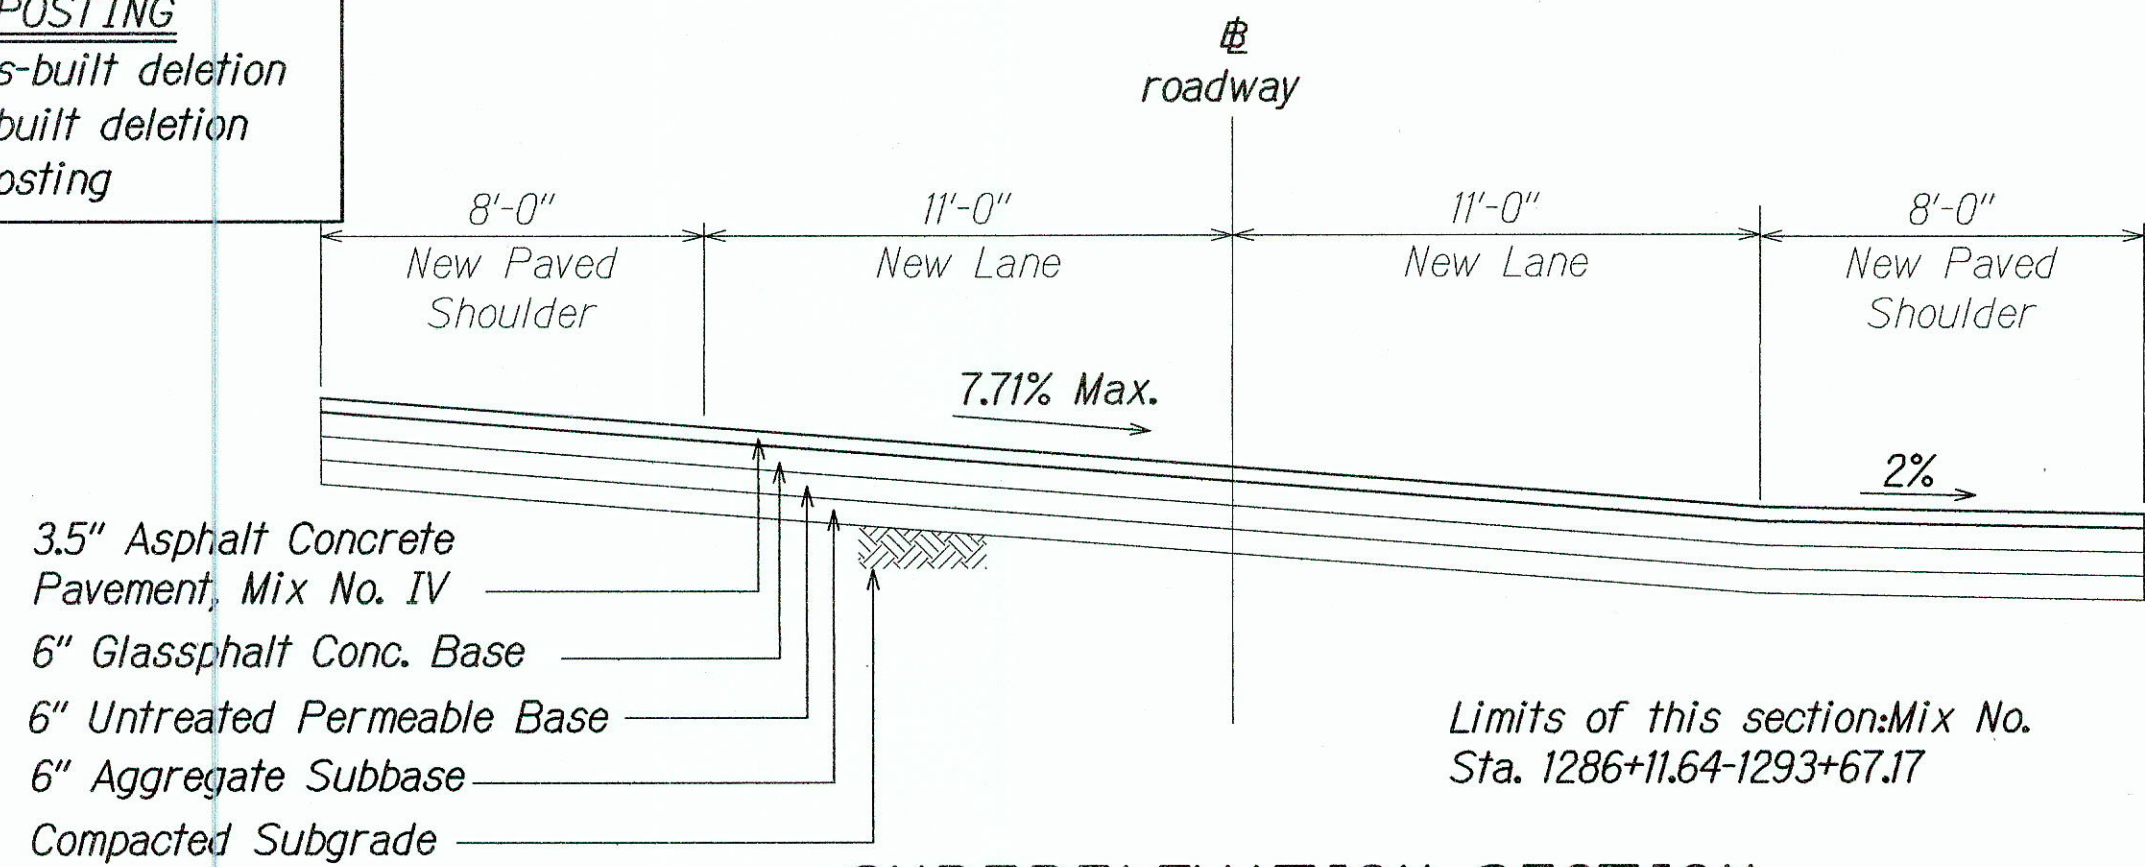


SUPERELEVATION SECTION
Scale: 1/4" = 1'-0"

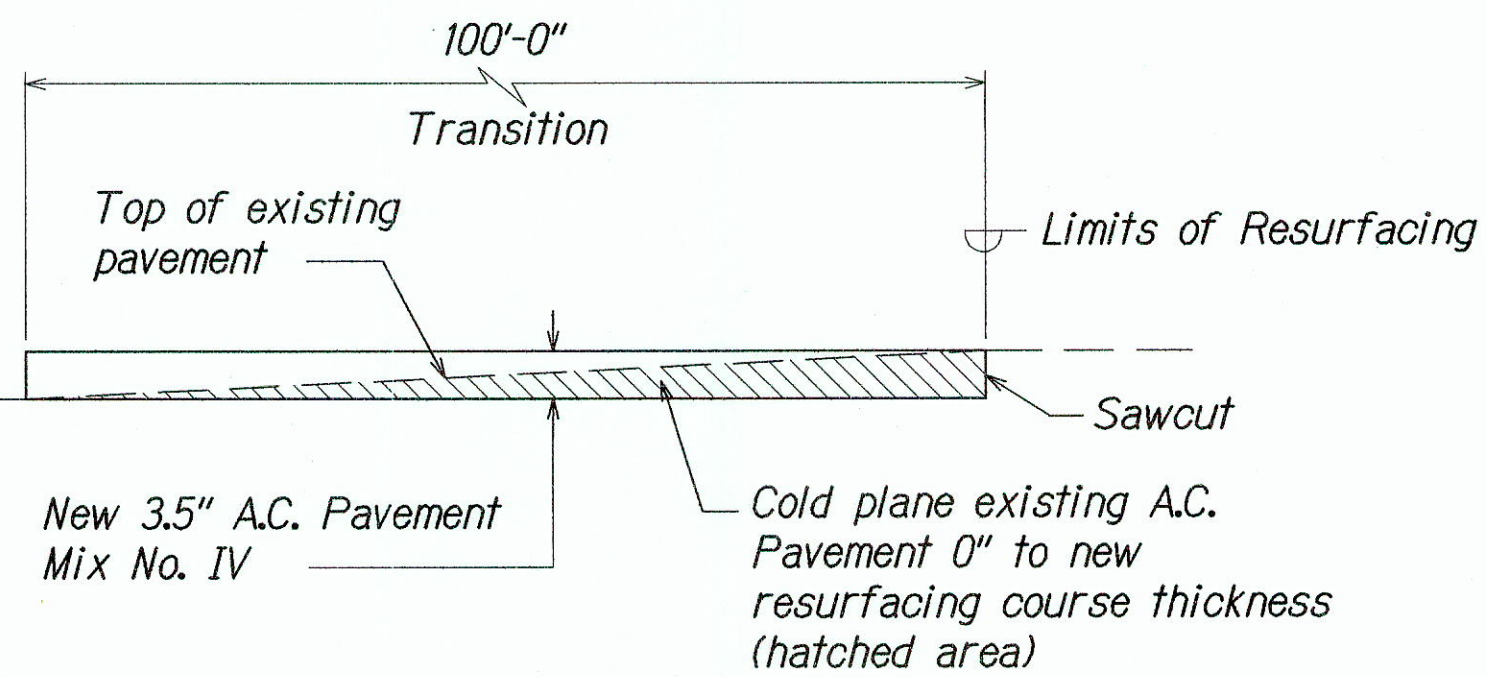

**COLD PLANED TRANSITION
TO EXISTING A.C. PAVEMENT
BEGIN AND END OF PROJECT**
Not To Scale

Note:
Shotcrete is to be Installed
Where the Fill or Cut Slopes
are 0.5:1 to 1.5:1 and Where
GRP or a Concrete Structure
is not Proposed. See Sht.
C-41 for Detail.

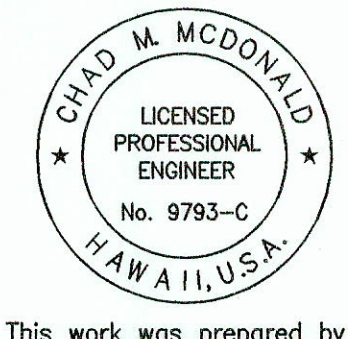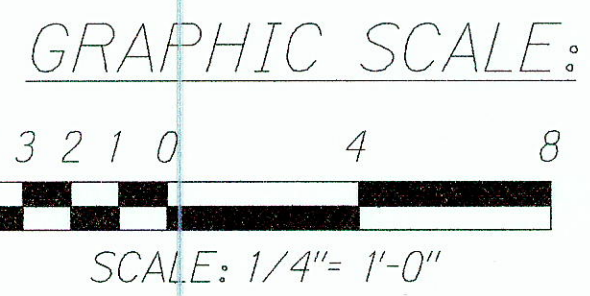

This work was prepared by
me or under my supervision
Chad M. McDonald
4/30/2014
MITSUNAGA & ASSOCIATES, INC. EXP. DATE
NOTE: Contractor to check and verify
dimensions at job before proceeding with work.

STATE OF HAWAII
DEPARTMENT OF TRANSPORTATION
HIGHWAYS DIVISION

TYPICAL SECTIONS - 1

KAMEHAMEHA HIGHWAY
REPLACEMENT OF KOKOLOLO STREAM BRIDGE
Federal Aid Project No. BR-083-1(50)
Scale: As Noted Date: August 2004

SHEET No. **C-5** OF **51** SHEETS

SURVEY PLOTTED BY	DATE
DRAWN BY	
DESIGNED BY	
CHECKED BY	
ORIGINAL PLAN	
NOTE BOOK	
NO.	

"AS-BUILT"

