



| FED. ROAD DIST. NO. | STATE | PROJ. NO.  | FISCAL YEAR | SHEET NO.   | TOTAL SHEETS |
|---------------------|-------|------------|-------------|-------------|--------------|
| HAWAII              | HAW.  | 83C-01-81M | 1981        | CO ADD 75-1 | 14           |

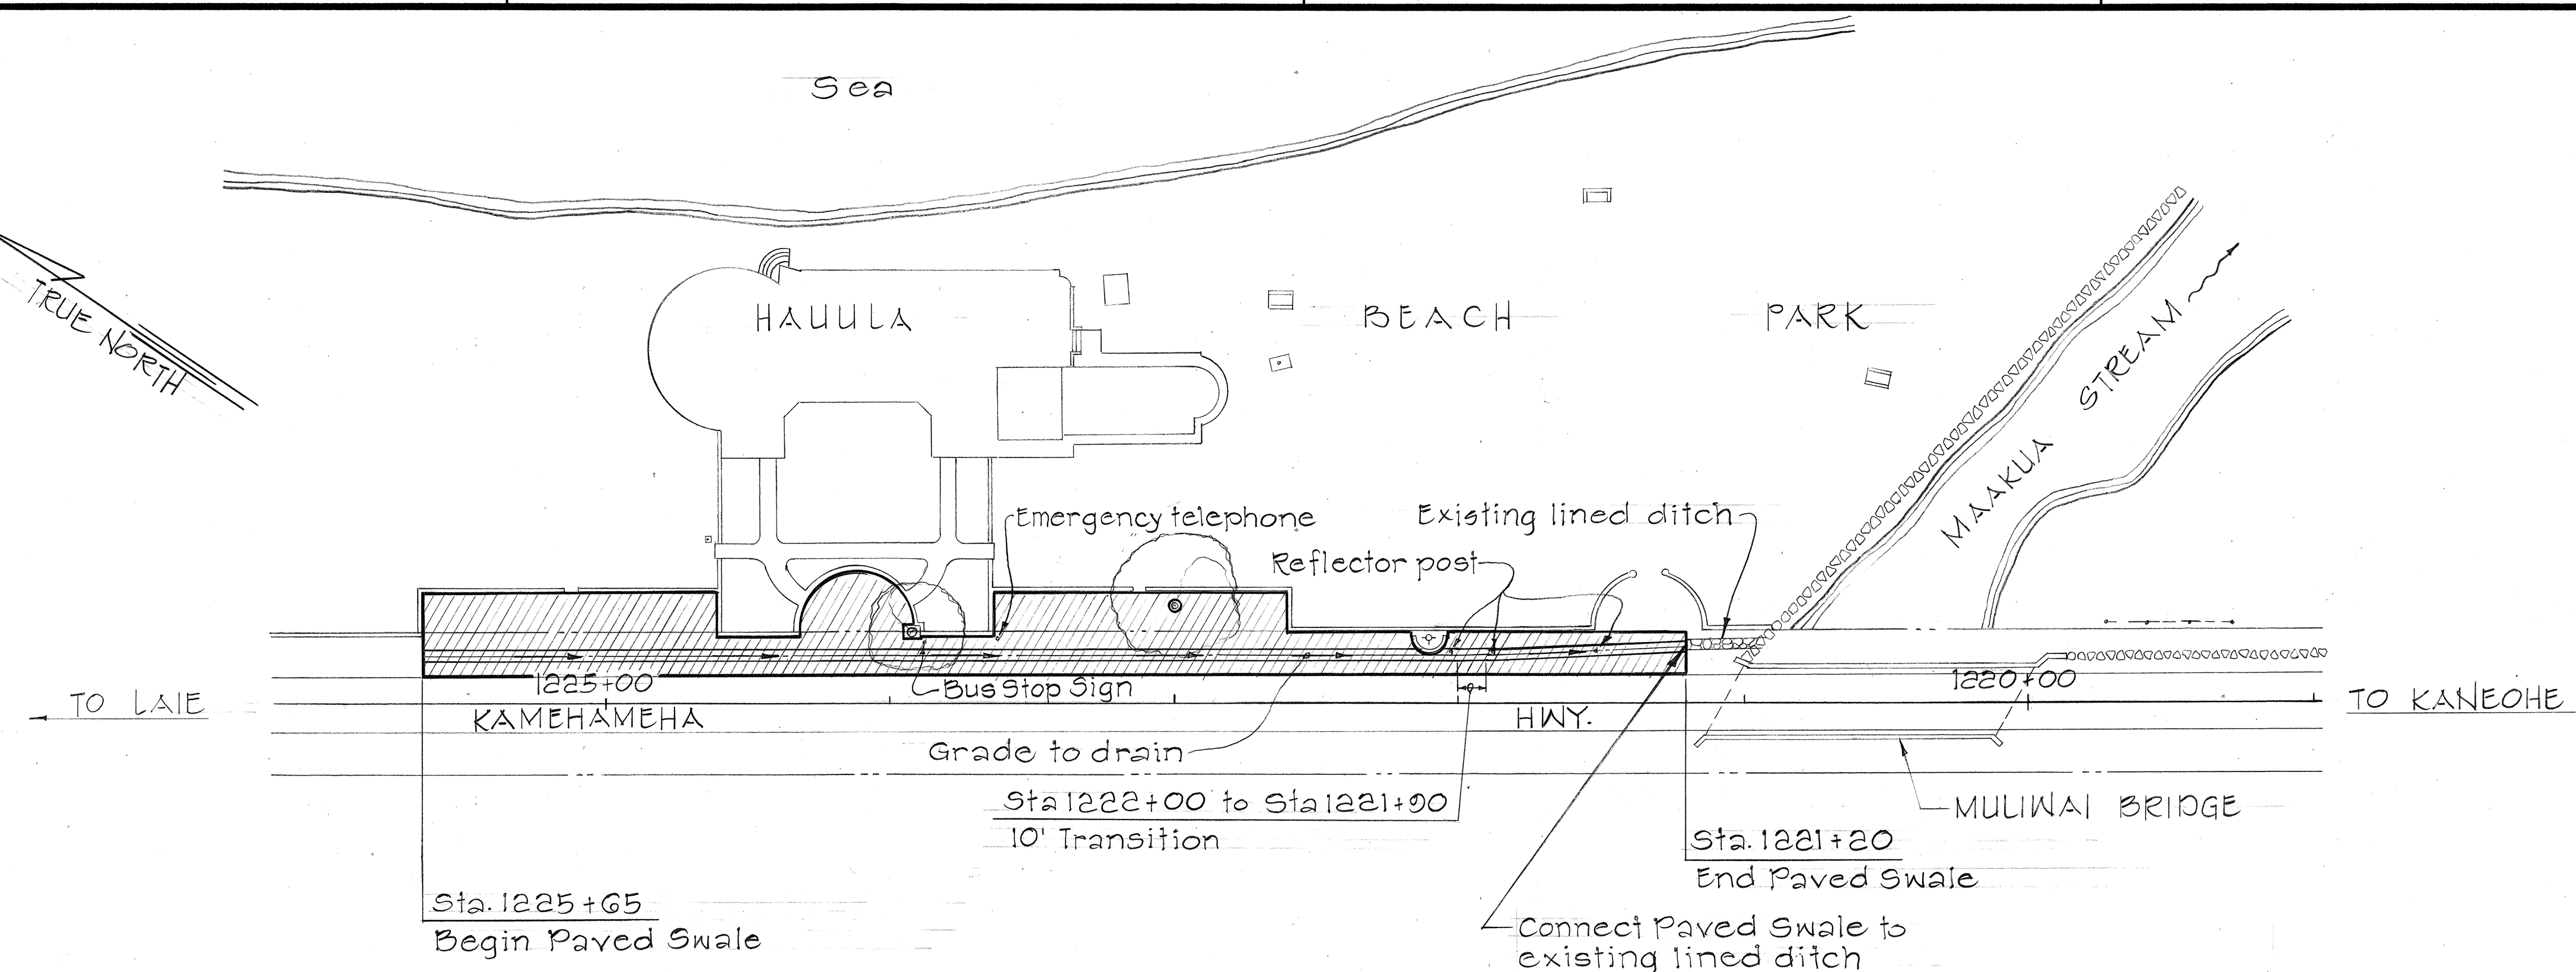

PLAN  
Scale: 1" = 40'

GENERAL NOTES:

1. Paved Swale shall be sloped to drain to Maakua Stream.
2. Invert alignment of the paved swale may be changed to the satisfaction of the Engineer.
3. Provide smooth connections between pavement and existing sidewalks and openings in the walls leading to the park.

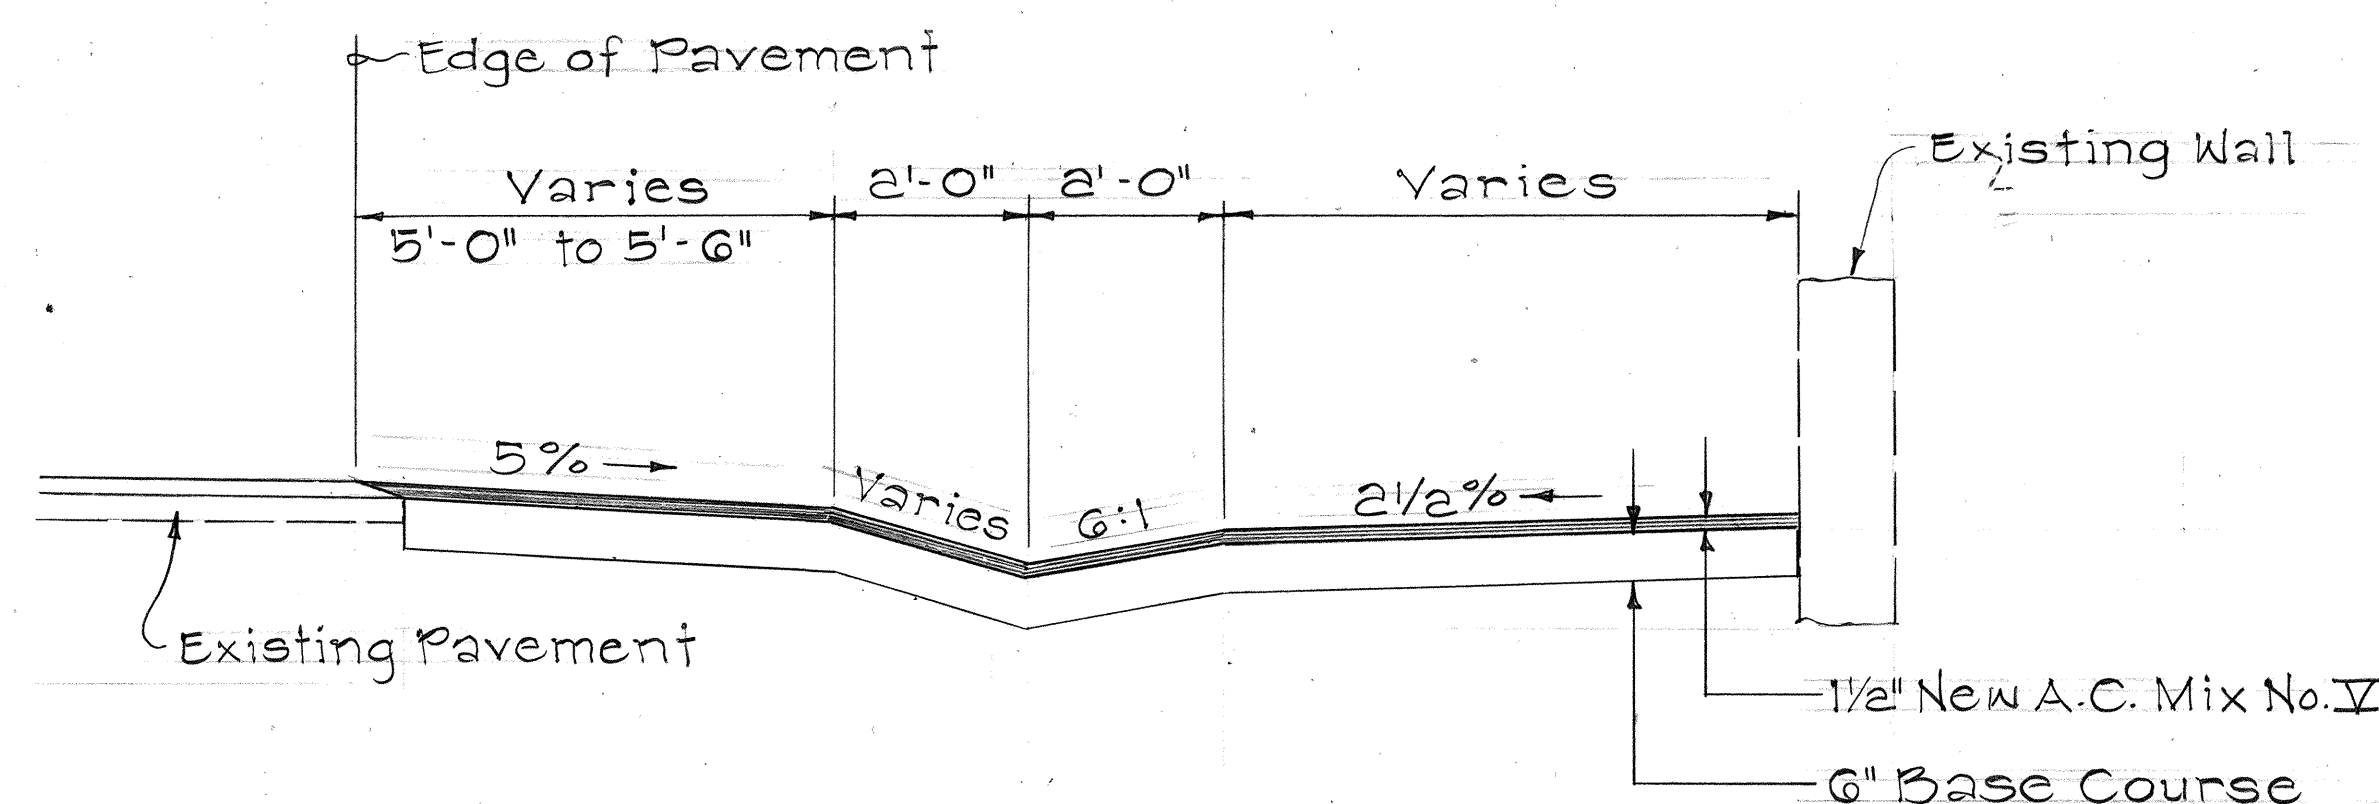

TYPICAL SECTION - PAVED SWALE  
Scale: 1/2" = 1'-0"

|          |             |            |
|----------|-------------|------------|
| DATE     | DESIGNED BY | CHECKED BY |
| 01/22/81 | PLANNED BY  | NO. 1      |
|          | DESIGNED BY | NO. 2      |
|          | DESIGNED BY | NO. 3      |
|          | DESIGNED BY | NO. 4      |
|          | DESIGNED BY | NO. 5      |
|          | DESIGNED BY | NO. 6      |
|          | DESIGNED BY | NO. 7      |
|          | DESIGNED BY | NO. 8      |
|          | DESIGNED BY | NO. 9      |
|          | DESIGNED BY | NO. 10     |

01/22/81 Sheet added to Contract Plan to show drainage details

DATE REVISION

STATE OF HAWAII  
DEPARTMENT OF TRANSPORTATION  
LAND TRANSPORTATION FACILITIES DIVISION

DRAINAGE PLAN

KAMEHAMEHA HWY. RESURFACING  
HAUULA HOMESTEAD ROAD  
TOWARDS PAKOLO LANE  
PROJECT NO. 83C-01-81M

Scale: As Noted Date: Jan, 1981

SHEET No. 1 OF 1 SHEETS

CO ADD.7 S-1