

| INDEX TO DRAWINGS |                                         |
|-------------------|-----------------------------------------|
| SHEET NO.         | DESCRIPTION                             |
| 1                 | TITLE SHEET                             |
| 2                 | GENERAL NOTES                           |
| 3-4               | WATER POLLUTION & EROSION CONTROL NOTES |
| 5                 | DEMOLITION PLAN                         |

STATE OF HAWAII

DEPARTMENT OF TRANSPORTATION

HIGHWAYS DIVISION

HONOLULU, HAWAII

"AS-BUILT"

PLANS FOR


KAMEHAMEHA HIGHWAY

KAIPAPAU STREAM BRIDGE REPLACEMENT, PHASE 1

DEMOLITION OF STRUCTURE AT LOT 55, TMK: 5-4-11: 21



FEDERAL AID PROJECT NO. BR-083-1(48), UNIT 1

| FED. ROAD DIST. NO. | STATE | FED. AID PROJ. NO.   | FISCAL YEAR | SHEET NO. | TOTAL SHEETS |
|---------------------|-------|----------------------|-------------|-----------|--------------|
| HAWAII              | HAW.  | BR-083-1(48), UNIT 1 | 2011        | 1         | 5            |

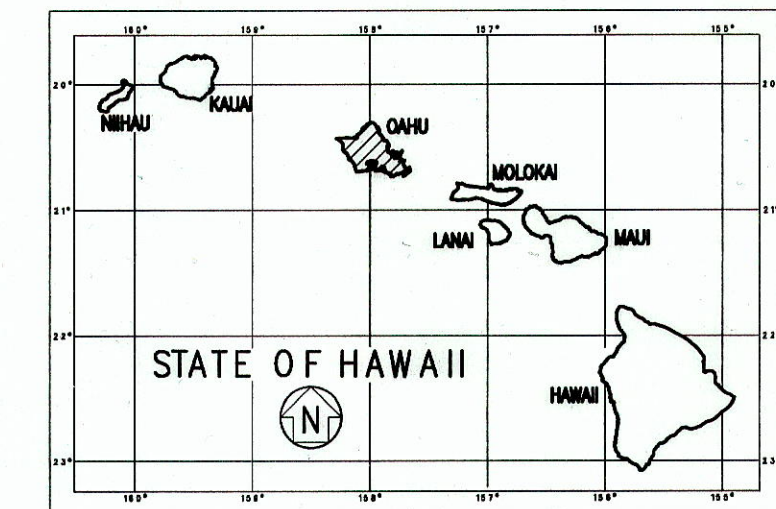

DISTRICT OF KOOLAULOA

ISLAND OF OAHU

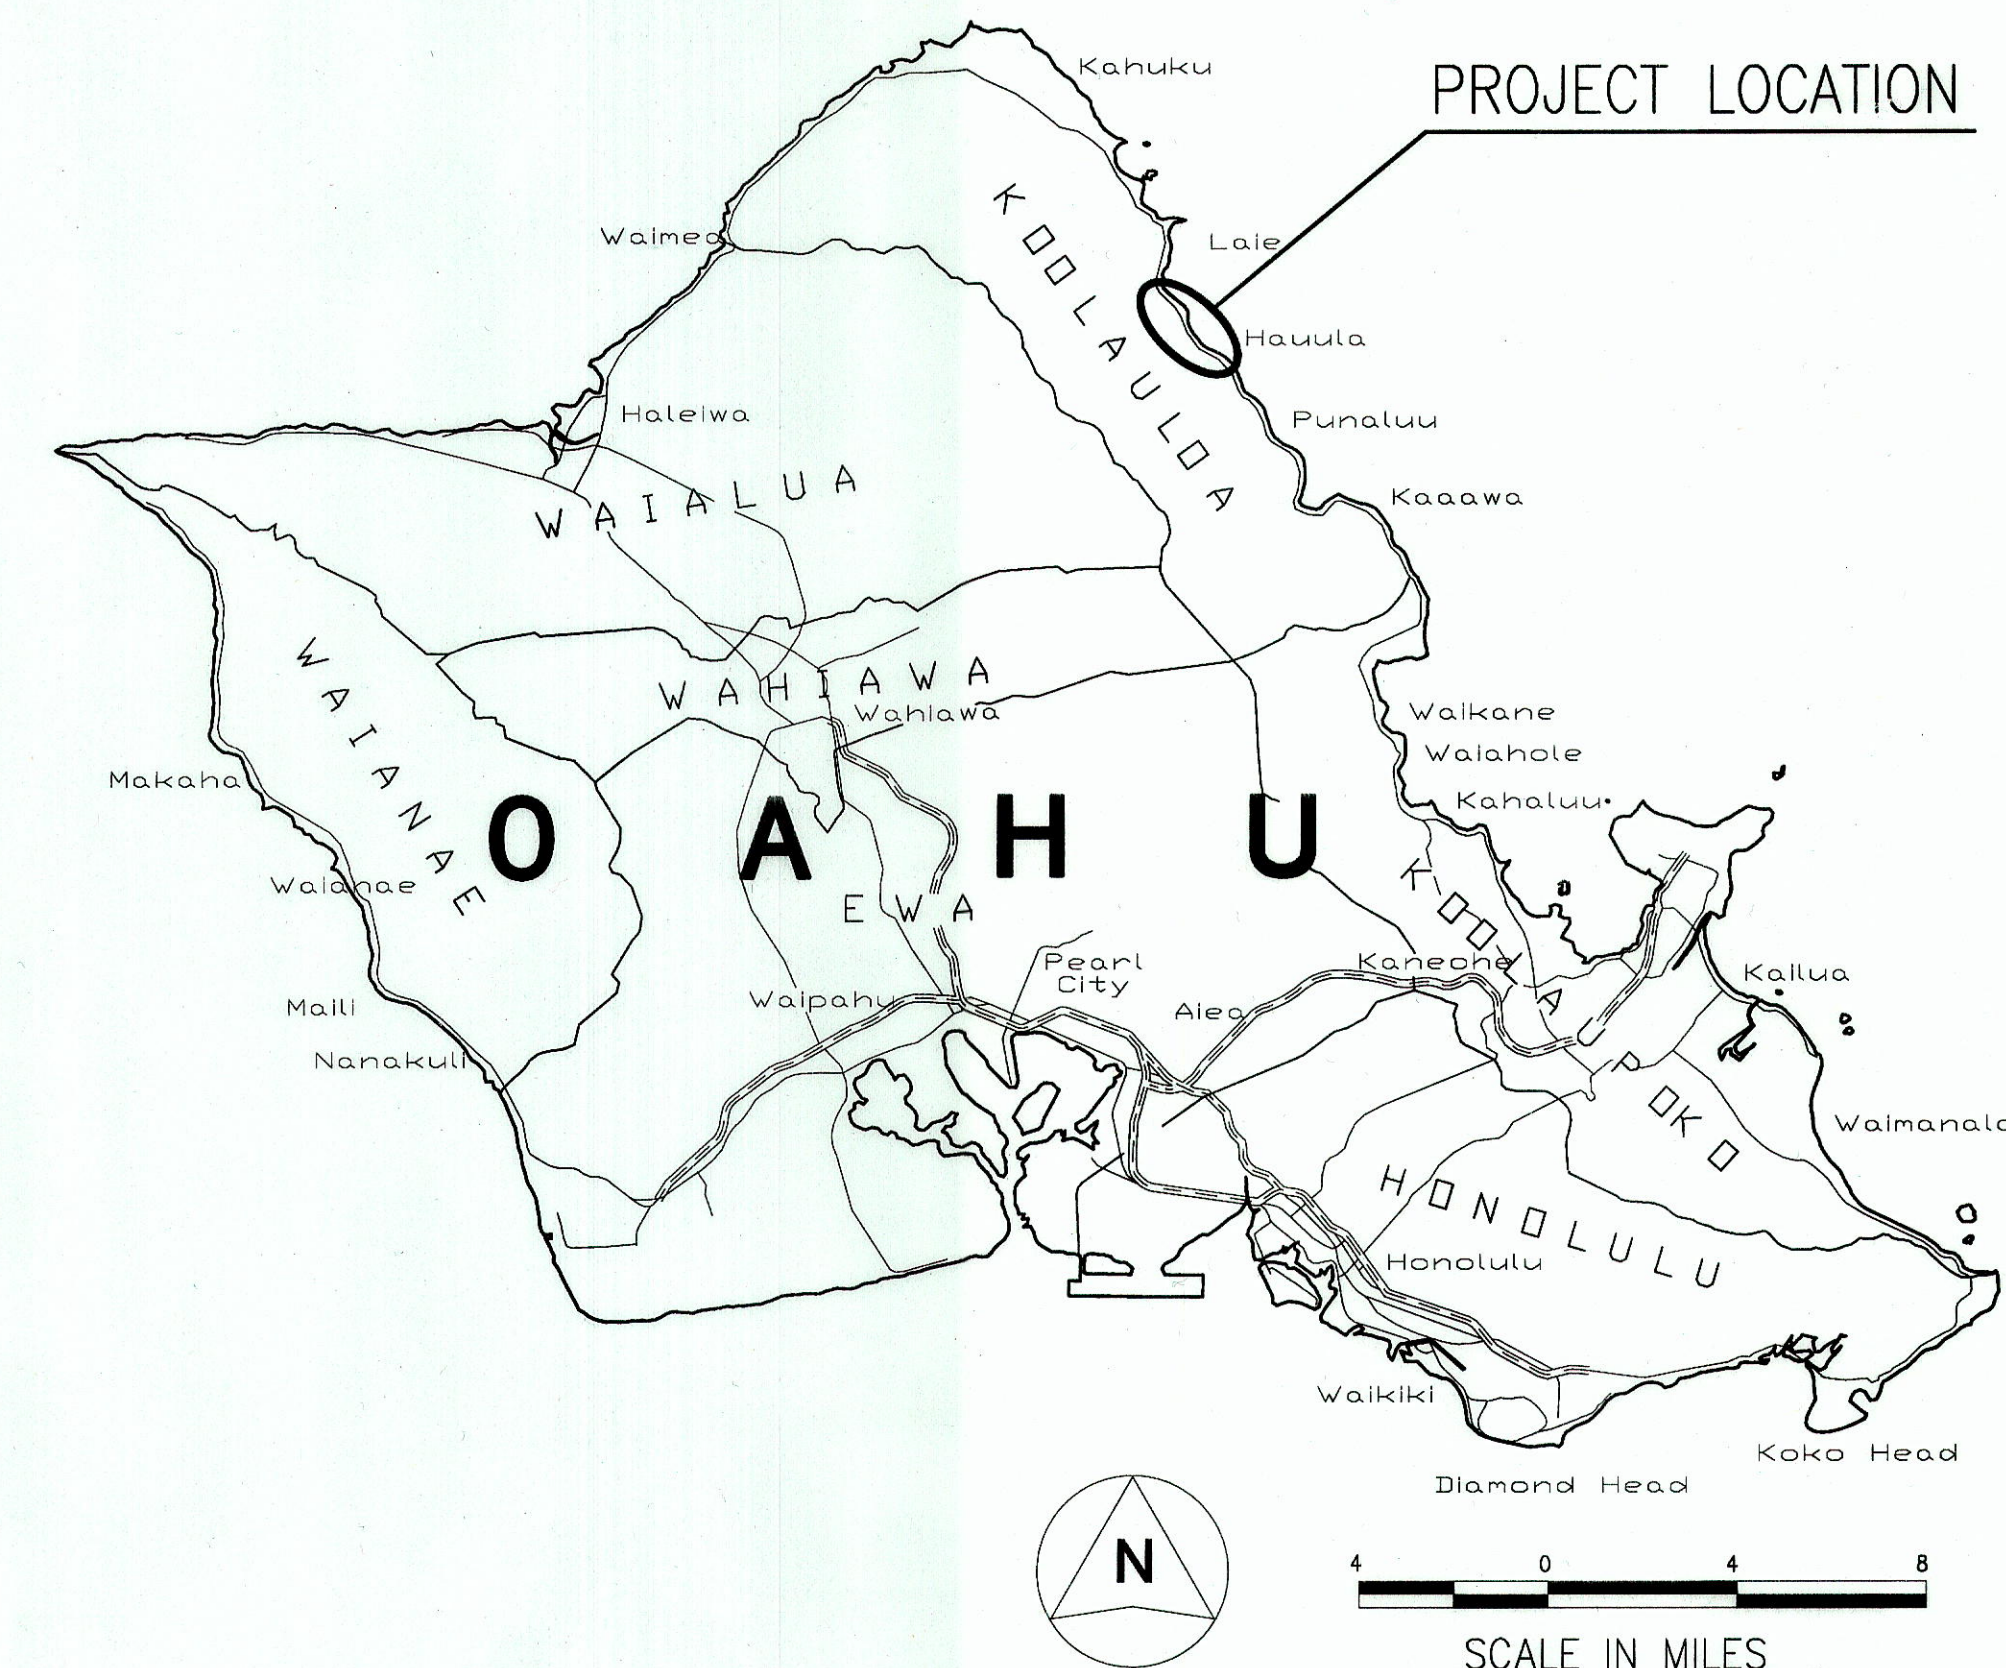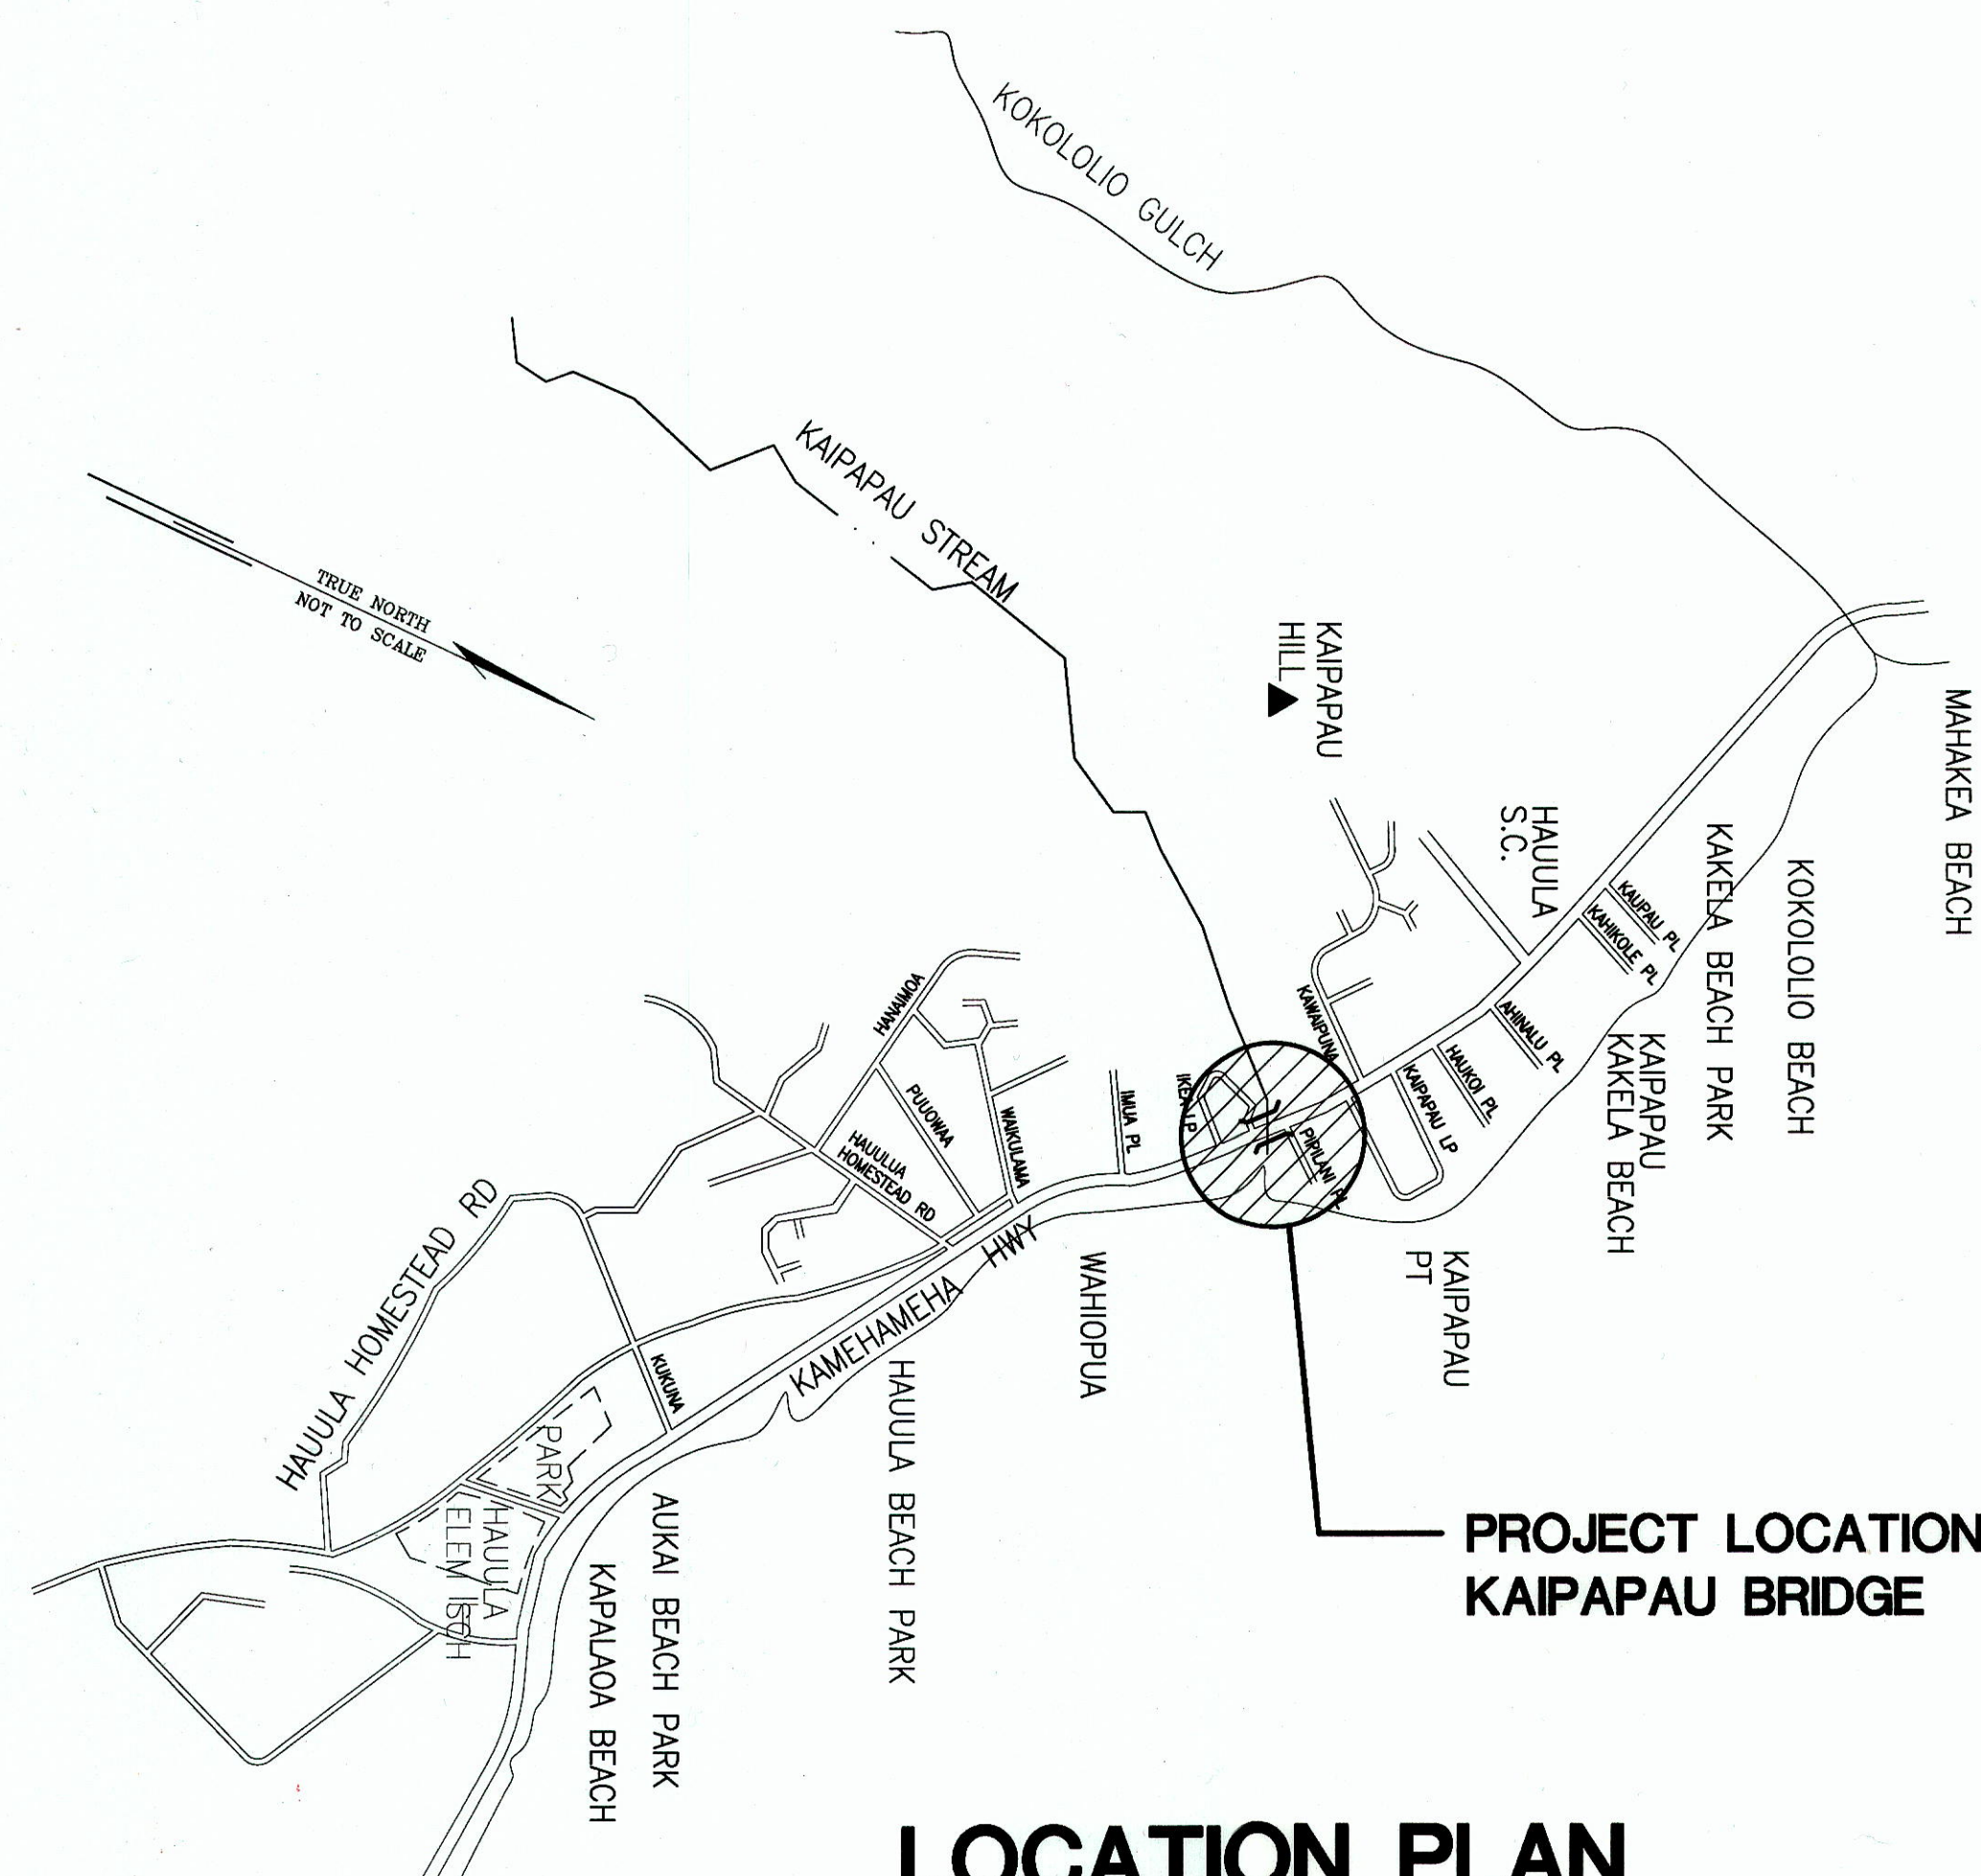

=====

FEDERAL AID PROJECTS PREVIOUSLY CONSTRUCTED OR UNDER CONSTRUCTION

CHANGES MADE DURING CONSTRUCTION HAVE BEEN INCORPORATED ON THESE PLANS EXCEPT CHANGES IN THE ORIGINAL THEORETICAL QUANTITIES. FOR ACTUAL QUANTITIES, REFER TO PROJECT LEDGER AND/OR COMPUTATION BOOK.

*Danny Ayer* 4/12/2013  
RESIDENT ENGINEER DATE

|                                                 |         |
|-------------------------------------------------|---------|
| DEPARTMENT OF TRANSPORTATION<br>STATE OF HAWAII |         |
| APPROVED:<br><i>ALB</i>                         | 2/14/11 |
| DIR. OF TRANSPORTATION                          | DATE    |

| ORIGINAL PLAN     | DATE |
|-------------------|------|
| SURVEY PLOTTED BY | BY   |
| DESIGNED BY       | BY   |
| TRACED BY         | BY   |
| NOTED BY          | BY   |
| QUANTITIES BY     | BY   |
| CHECKED BY        | BY   |
| No.               |      |

R.M. TOWILL CORP.

DESIGNED BY

HWY-DD

MANAGED BY

692-7581

PHONE

DECEMBER 2010

DATE