

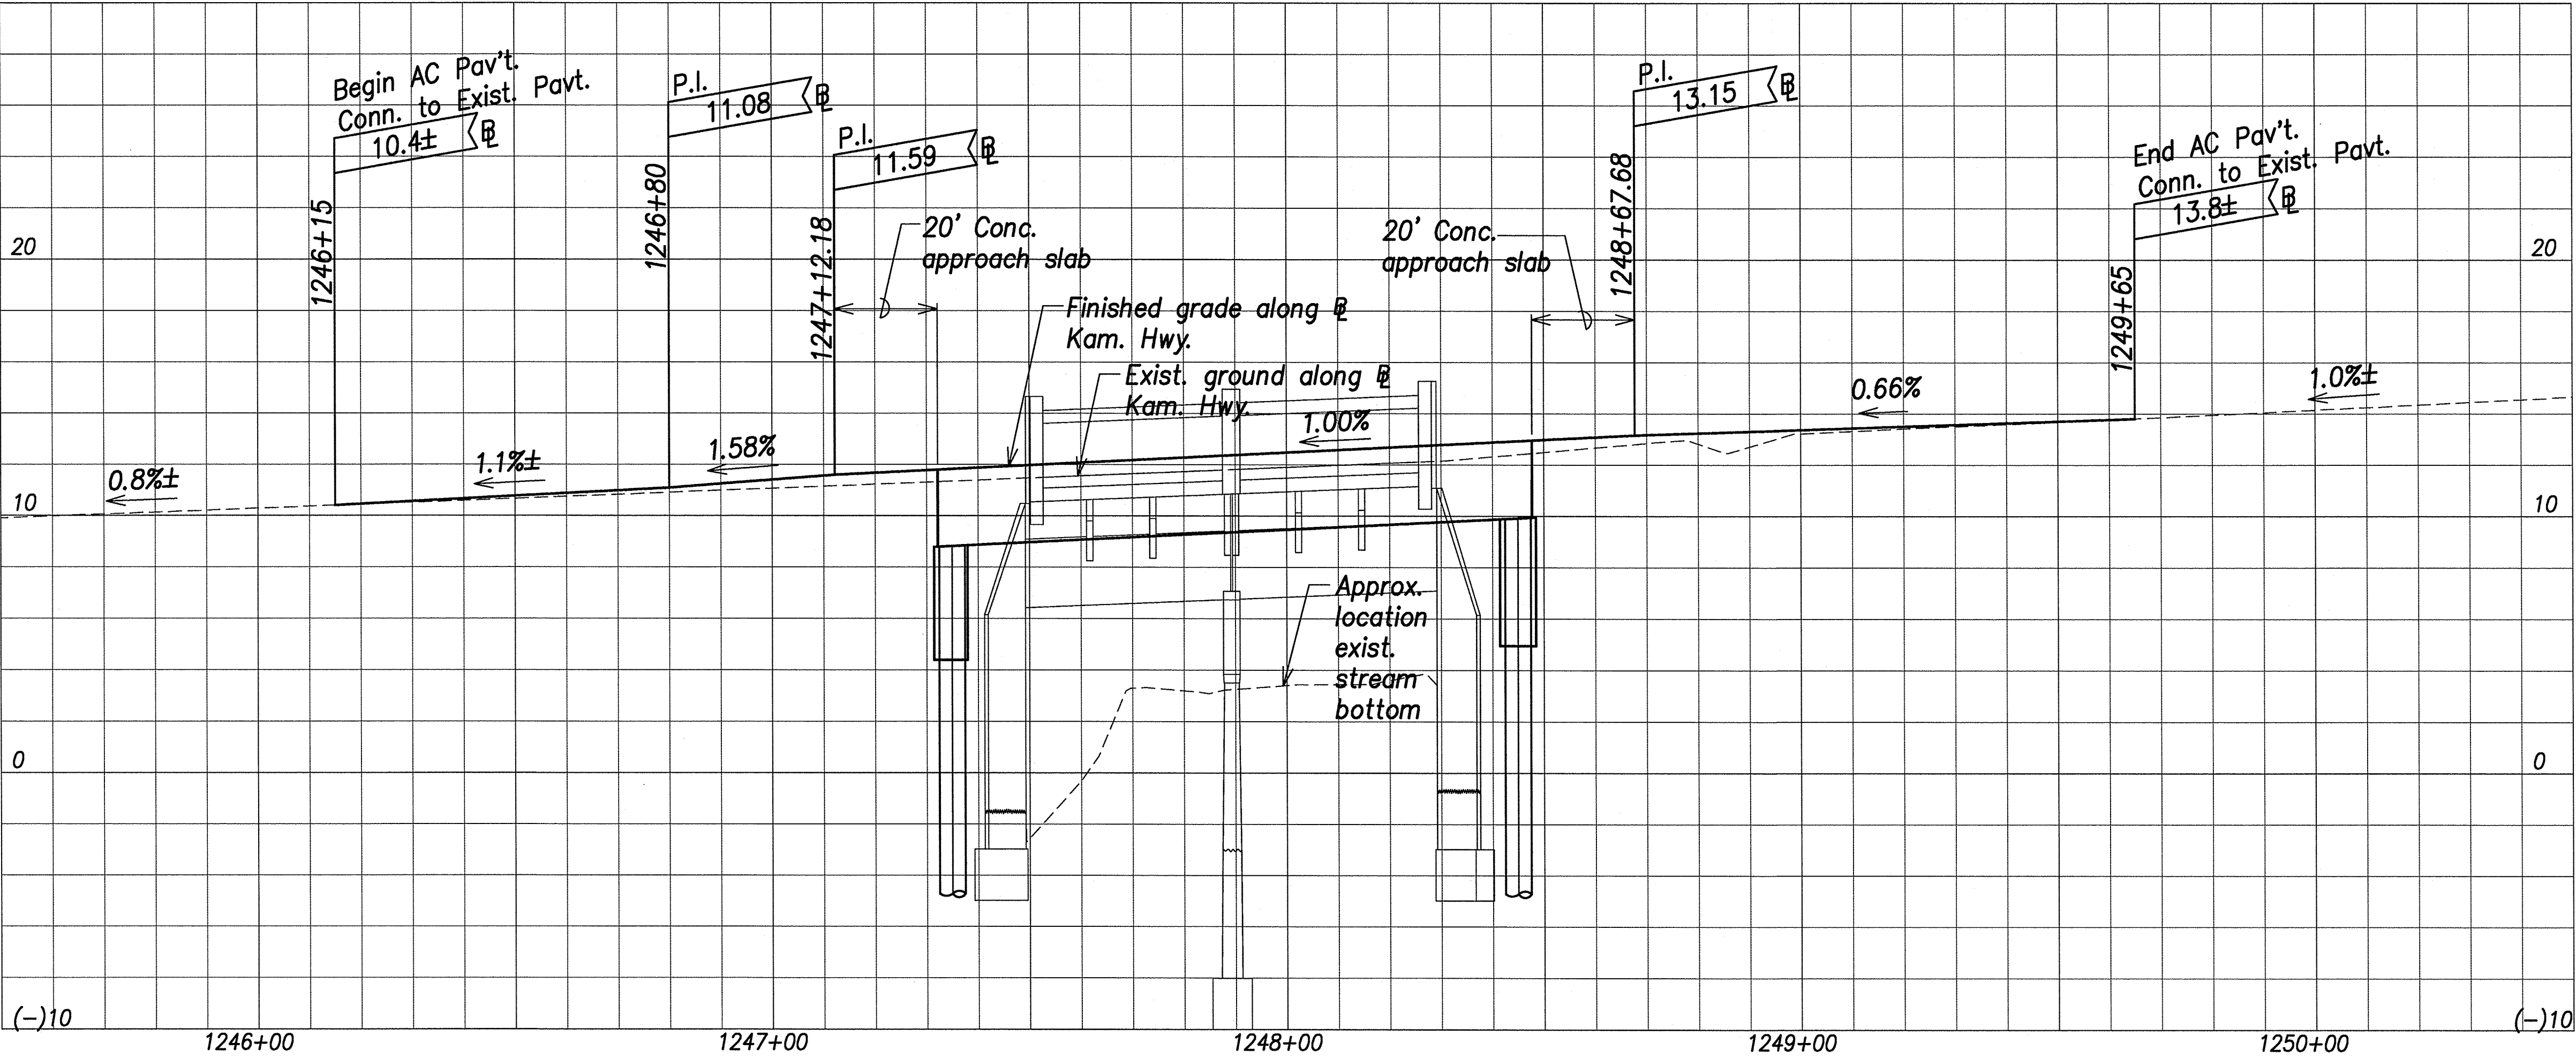


FED. ROAD DIST. NO.	STATE	PROJ. NO.	FISCAL YEAR	SHEET NO.	TOTAL SHEETS
HAWAII	HAW.	BR-083-1(48)	2021	17	161

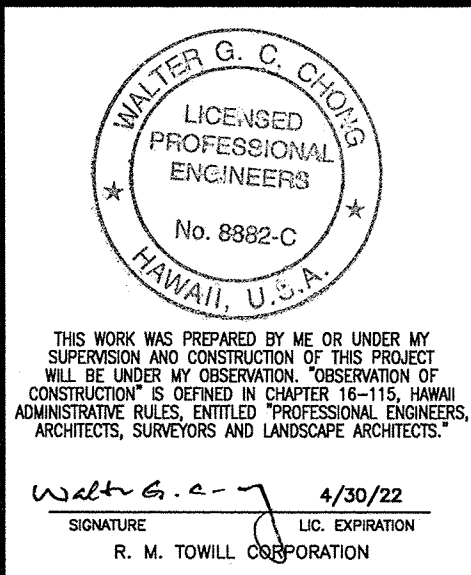

PROFILE: KAMEHAMEHA HIGHWAY
Scales: 1"=20' Horiz.
1"=4' Vert.

SURVEY PLOTTED BY	DATE
DRAWN BY	REV
DESIGNED BY	WC
CHECKED BY	
NOTE BOOK	
No.	

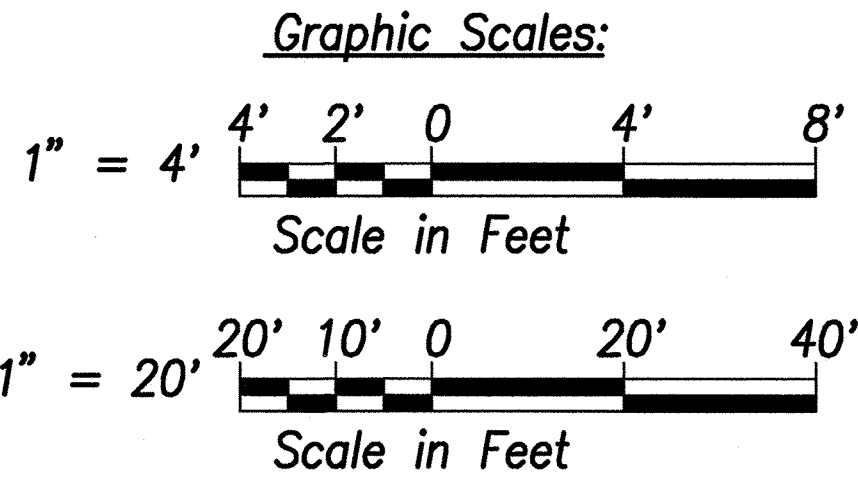

STATE OF HAWAII
DEPARTMENT OF TRANSPORTATION
HIGHWAYS DIVISION

PROFILE KAMEHAMEHA HWY.

*Kamehameha Highway
Kaipapau Stream Bridge Replacement
Federal Aid Project No. BR-083-1(48)*

Scale: As Noted Date: February 2021

SHEET No. C-15 OF SHEETS