


FED. ROAD DIST. NO.	STATE	PROJ. NO.	FISCAL YEAR	SHEET NO.	TOTAL SHEETS
HAWAII	HAW.	BR-083-1(48)	2021	ADD. 44	161

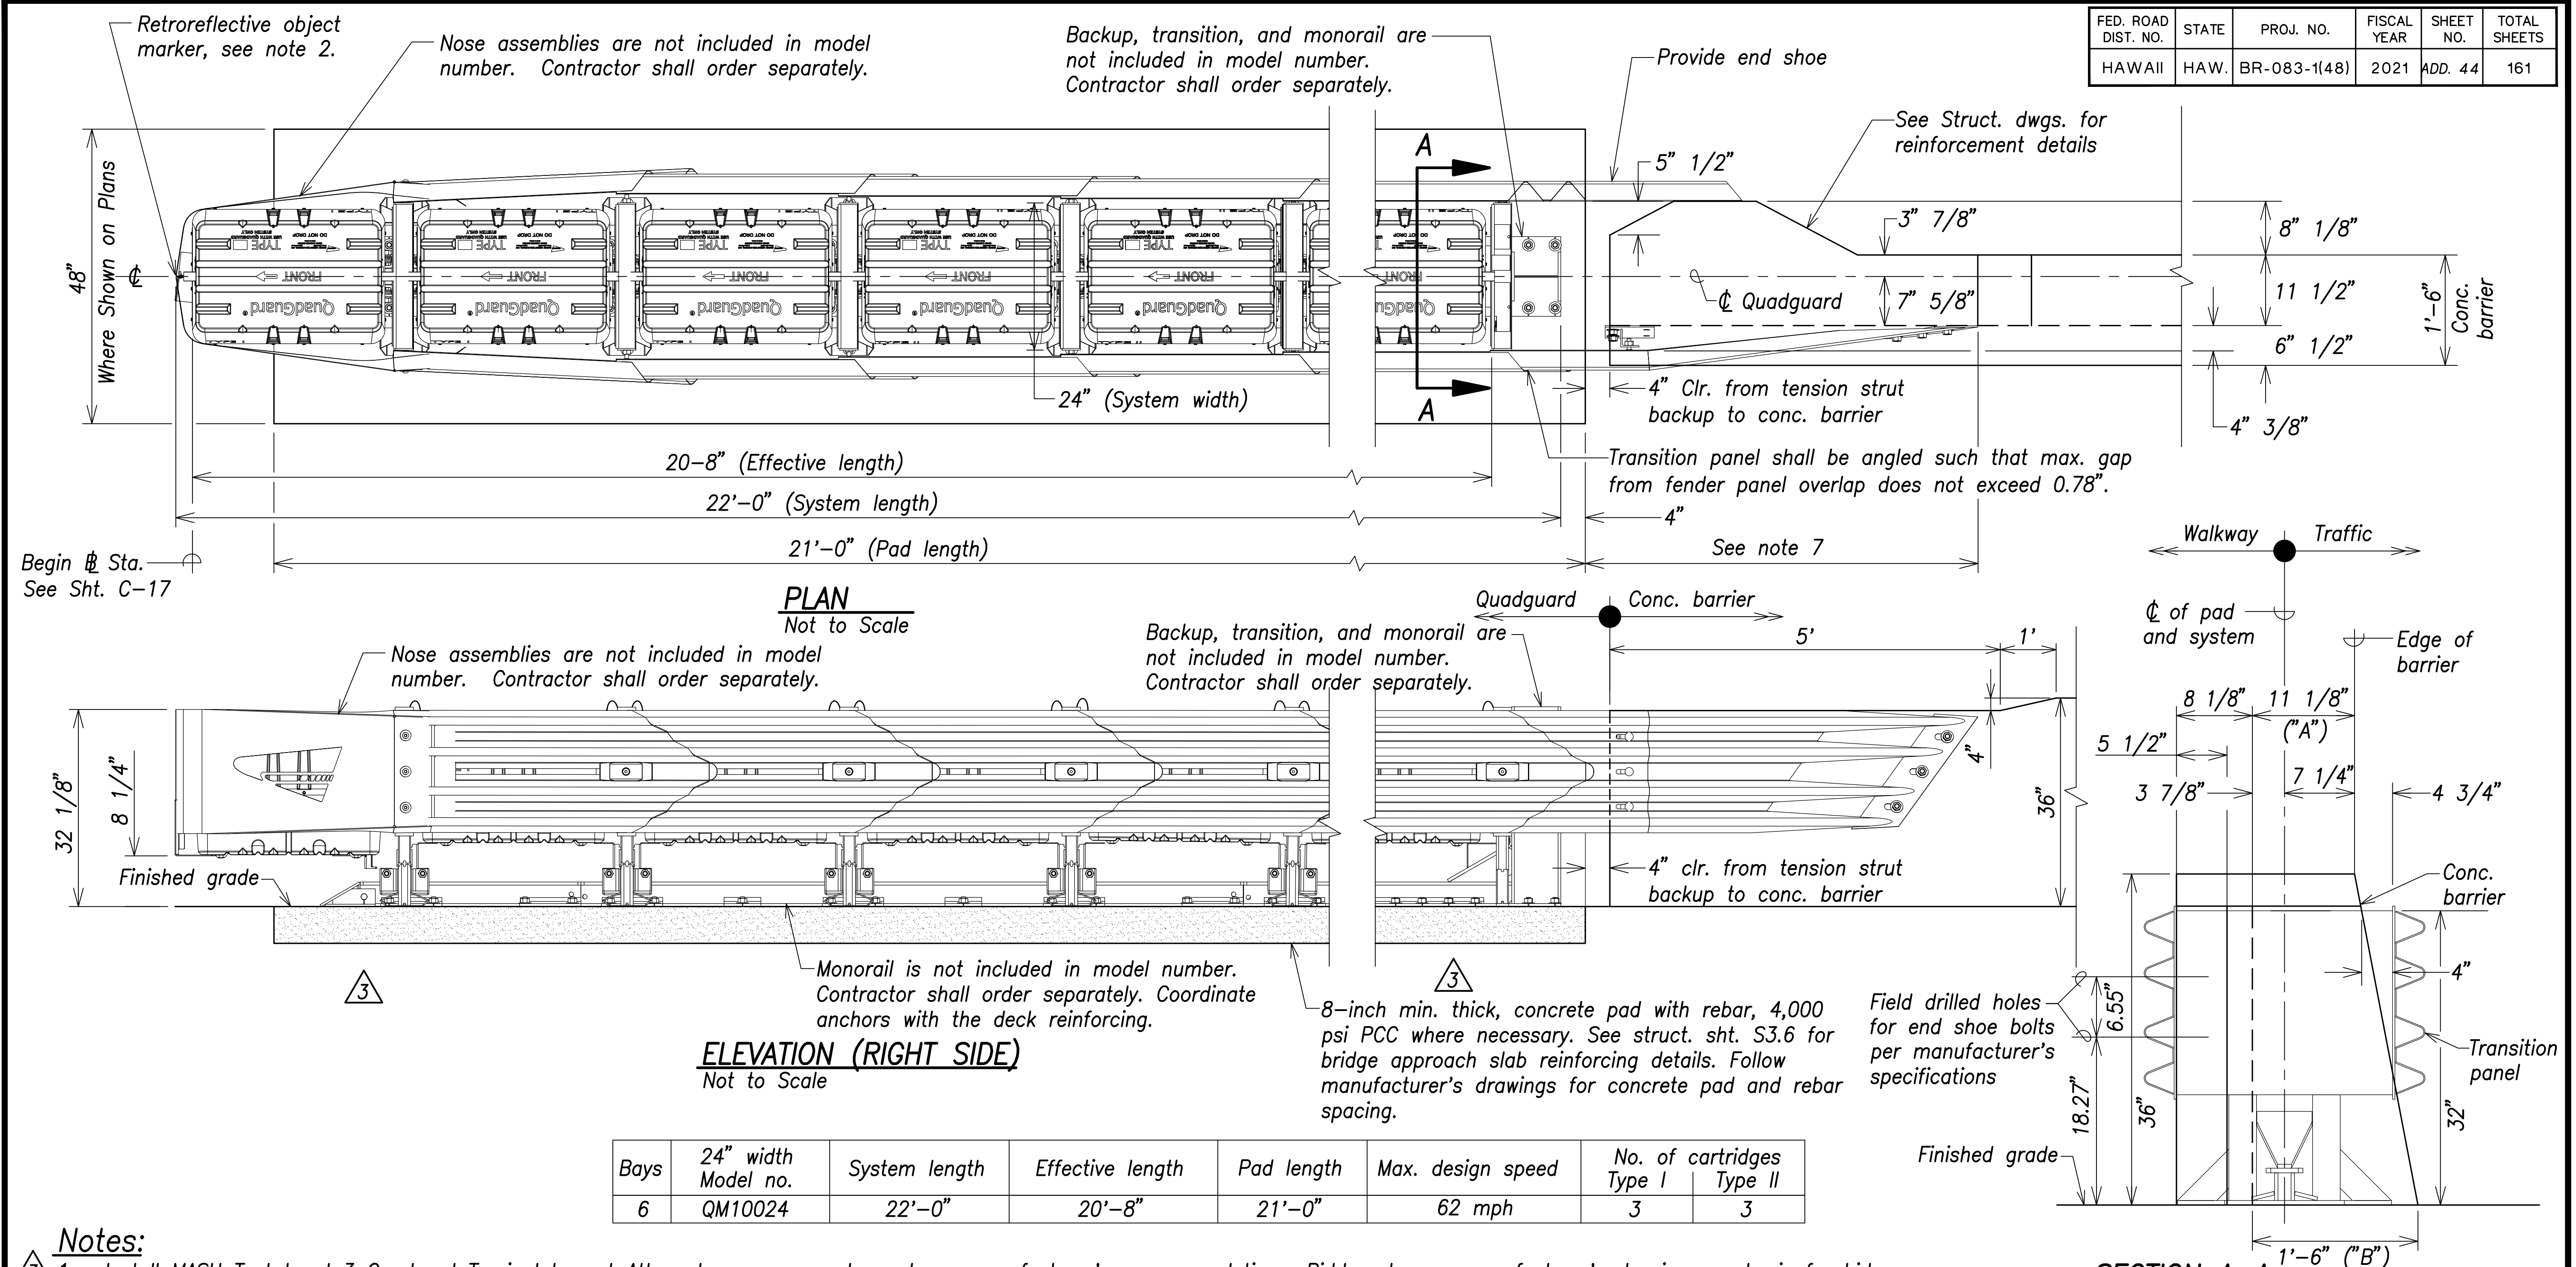


Notes:

- Notes:**
- ③ 1. Install MASH Test Level 3 Quadguard Terminal Impact Attenuator or approved equal per manufacturer's recommendations. Bidders to use manufacturer's drawings as basis for bid.
 2. The contractor shall order crash cushion object marker from the Quadguard manufacturer and install on the nose of the Quadguard per the manufacturer's specifications. Object marker shall be considered incidental to the Quadguard attenuator.
 3. In compliance with the AASHTO 2011 Roadside Design Guide, manufacturer recommends removal of all curbs and islands to ensure proper impact performance.
 4. Provision shall be made for rear fender panels to slide rearward upon impact 30 inches, min.
 - ③ 5. 8" min. reinforced 4,000 PSI PC concrete pad or 8" min. non-reinforced 4,000 PSI concrete roadway, measuring at least 12'-0" wide by 50'-0" long.
 6. See the "Quadguard M10 System Product Manual" for a description of its impact performance characteristics and design limitations before placing a system at a given site.
 7. Where necessary, the customer shall supply an adequate transition from the Quadguard M10 system to the object being shielded.
 8. Backup, monorail, and nose assemblies are not included in model number, order separately.

SECTION A-A
Not to Scale

7/21/21	Rev. Conc pad. Rev. notes 1 & 5
DATE	REVISION


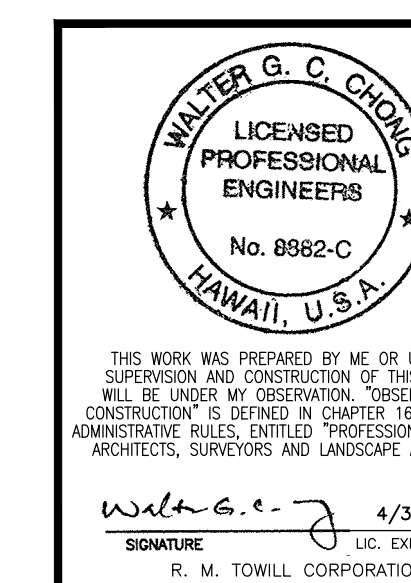


STATE OF HAWAII
 DEPARTMENT OF TRANSPORTATION
 HIGHWAYS DIVISION


QUADGUARD DETAILS
Kamehameha Highway
Kaipapau Stream Bridge Replacement
Federal Aid Project No. BR-083-1(48)

FED. ROAD DIST. NO.	STATE	PROJ. NO.	FISCAL YEAR	SHEET NO.	TOTAL SHEETS
HAWAII	HAW.	BR-083-1(48)	2021	ADD. 45	161

Note:
Monorail & backup assembly must be straight to within 0.5".

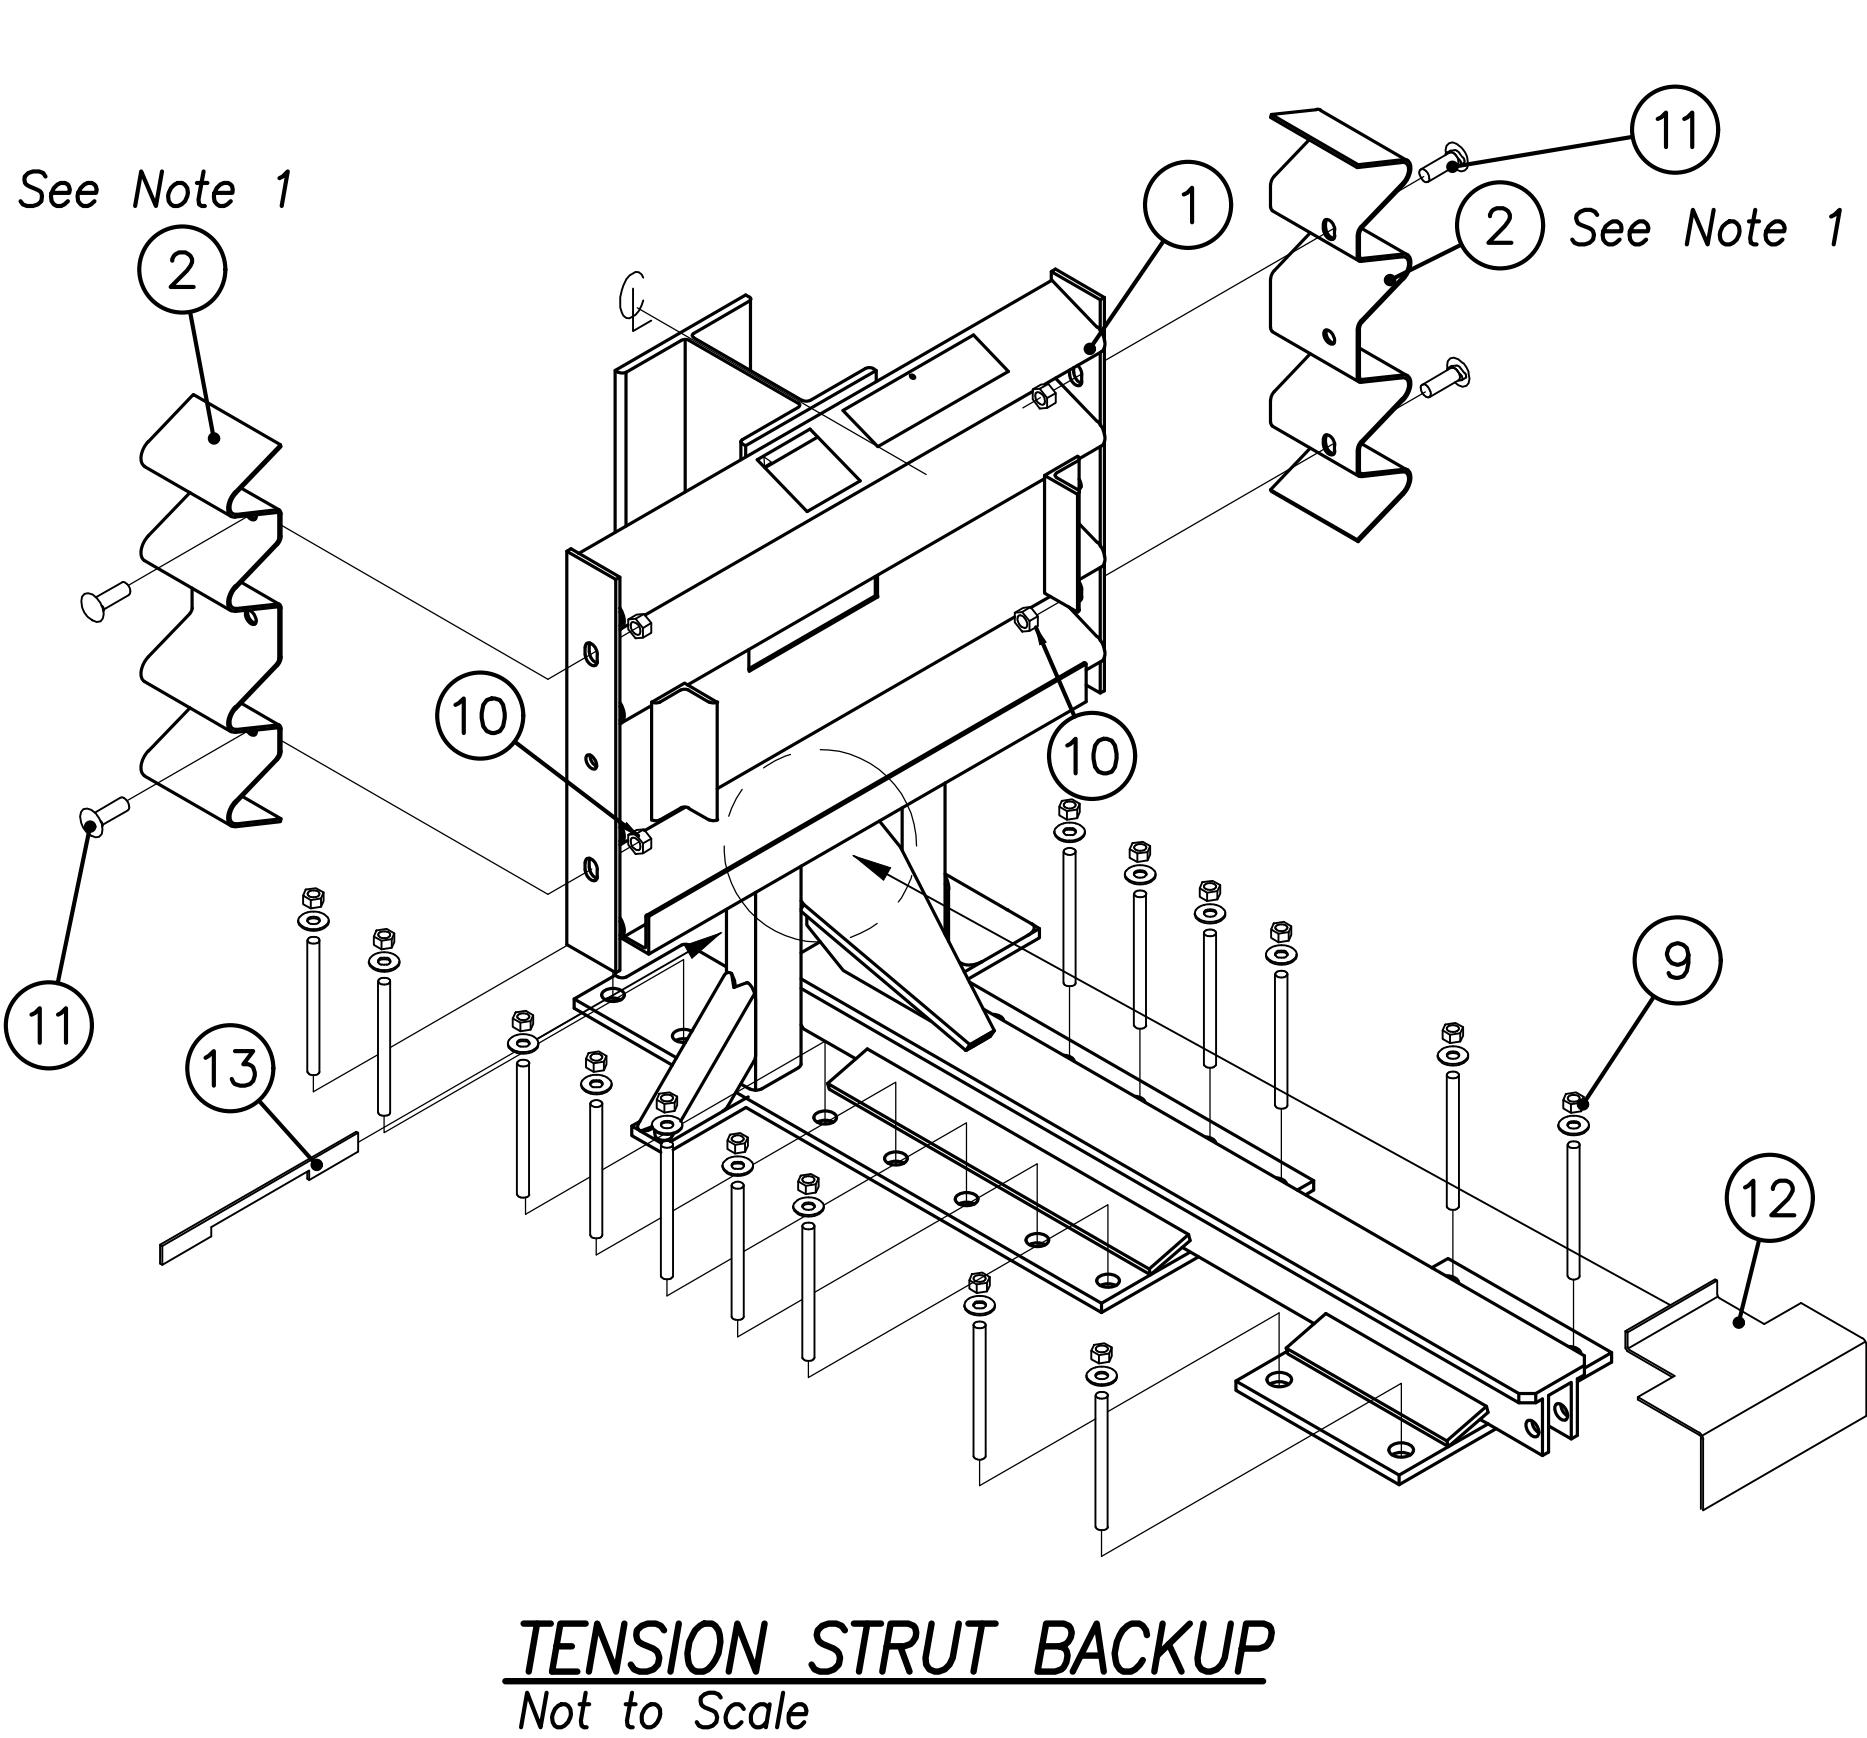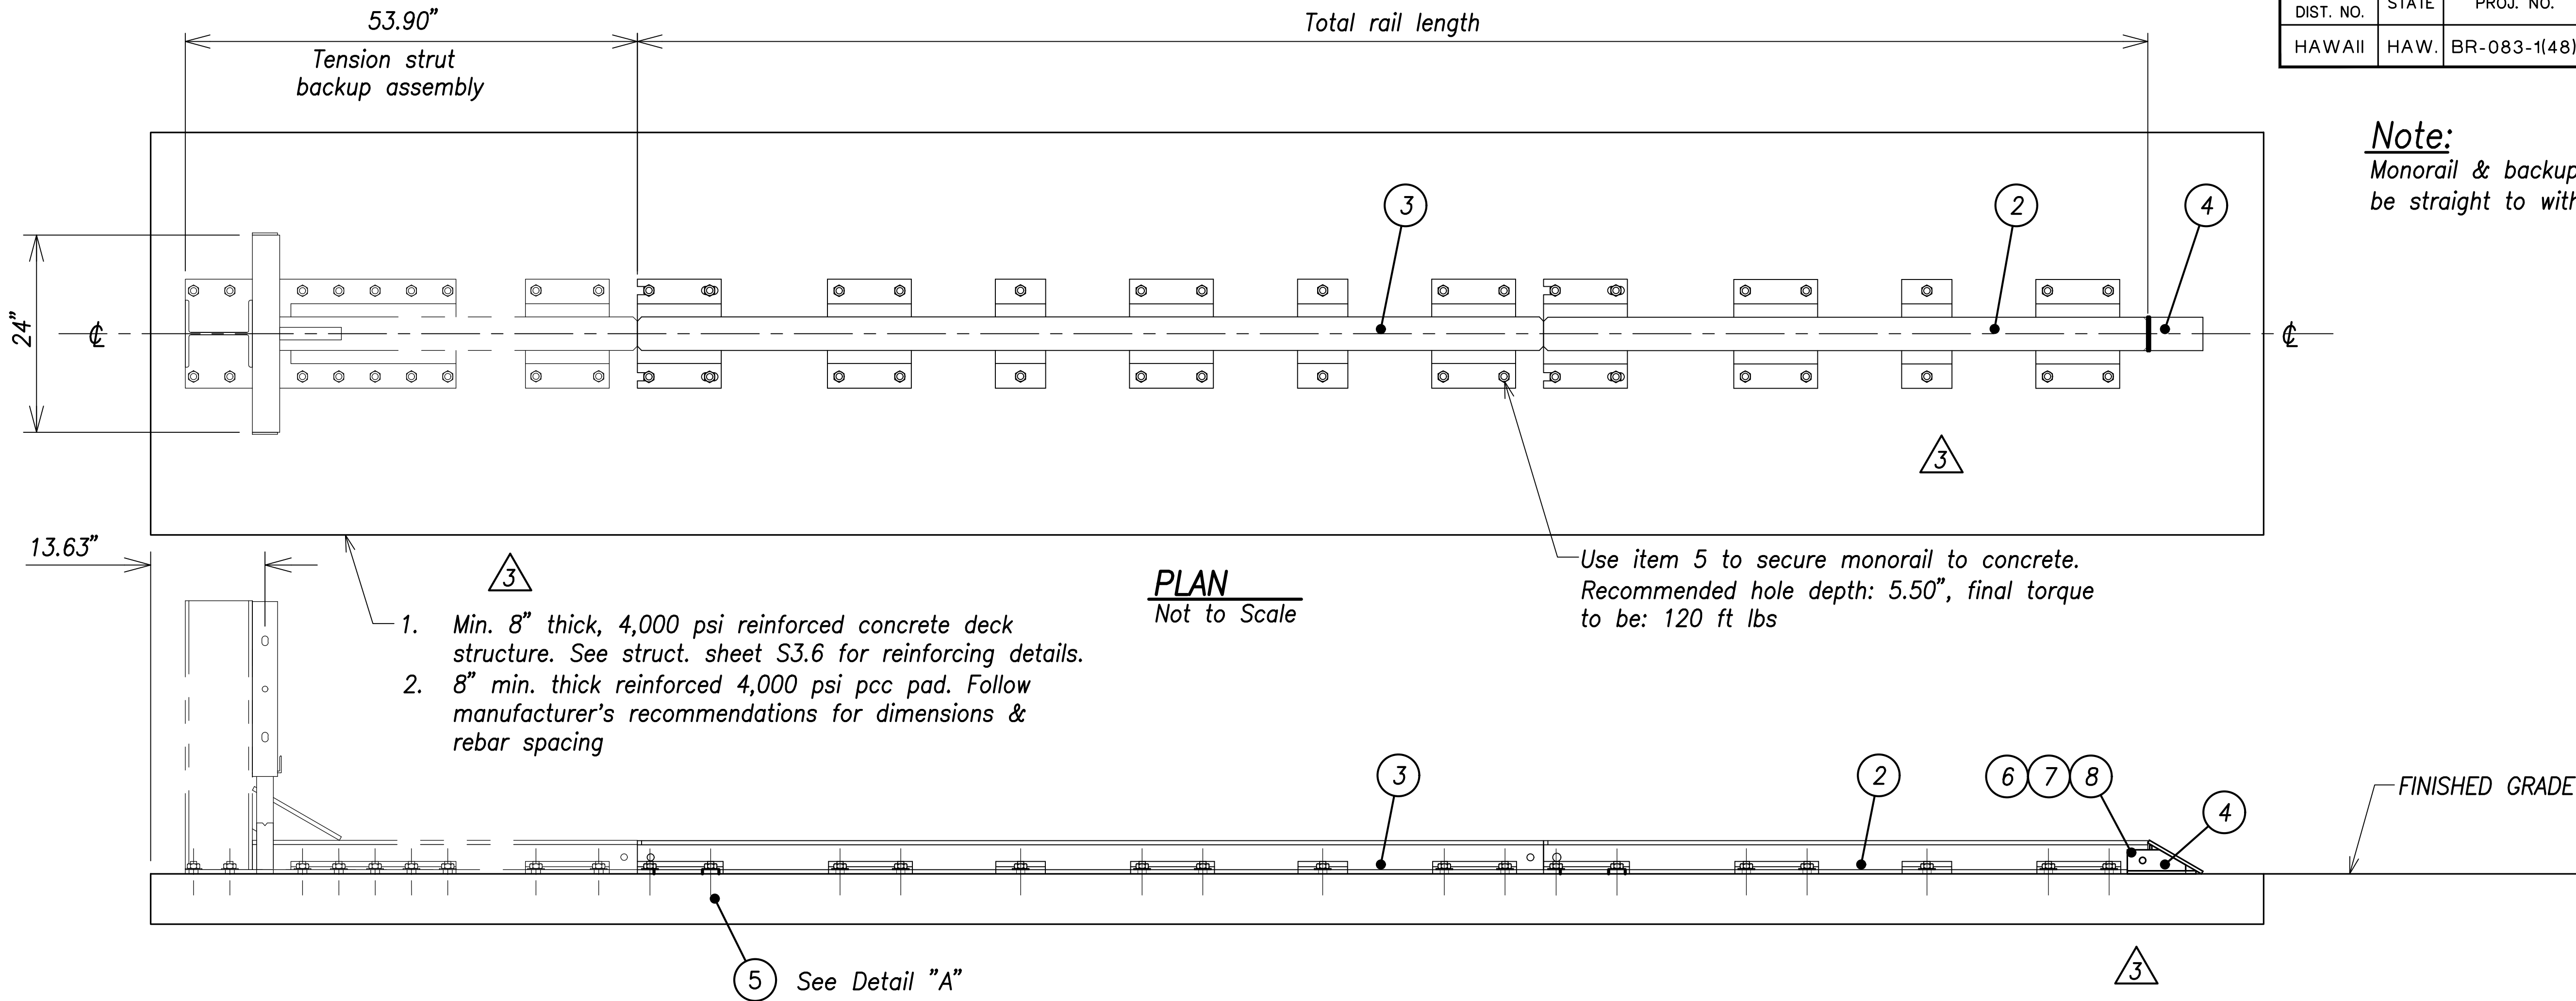


ELEVATION (W/ TENSION STRUT BACKUP)
Not to Scale

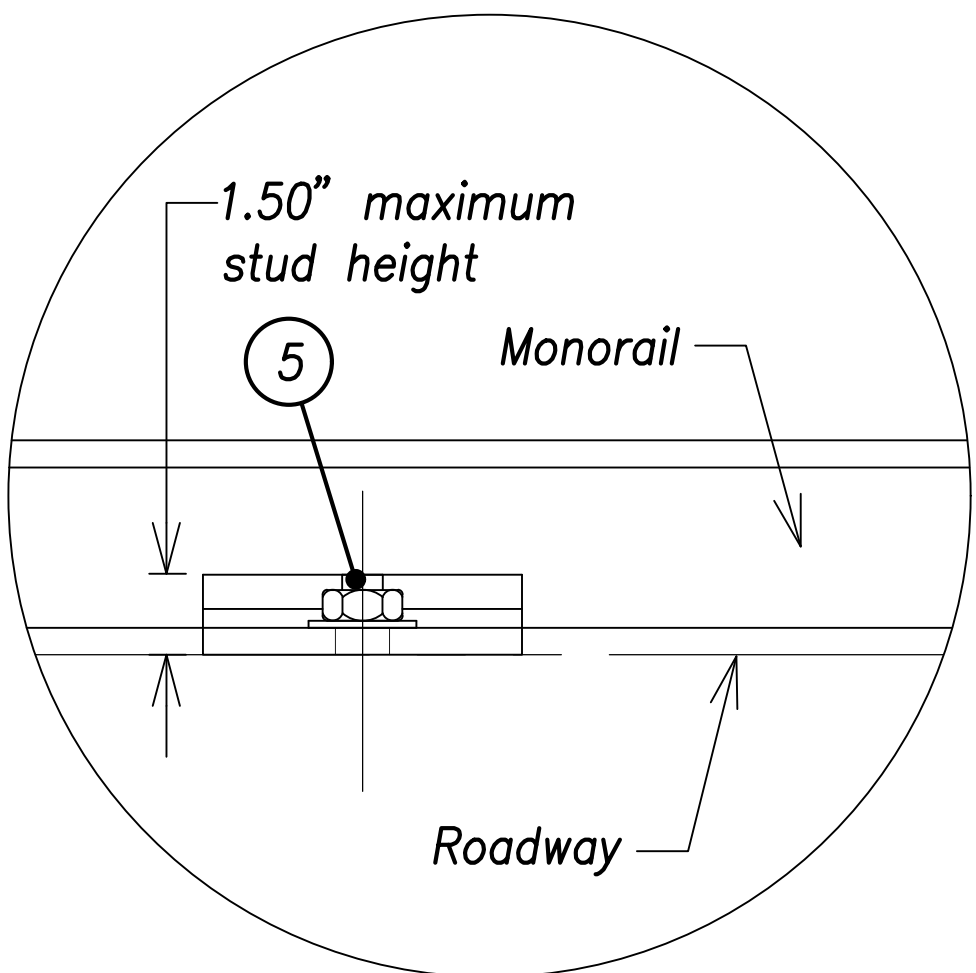

- Notes:
1. Use monorail(s) (items 1, 2 and 3) as template(s) to locate mp-3 anchor bolts (item 5) and install per manufacturer's directions.
 2. Cross slope of pad shall not exceed 2% in any direction.
 3. Units of measurement are inches unless otherwise noted.
 4. Every stud must be embedded to a depth of 5.50-inches. If rebar is encountered in a pcc pad, drill through it. If rebar is encountered on a deck structure, ask the engineer for direction.

7/21/21	REV. CONC PAD
DATE	REVISION

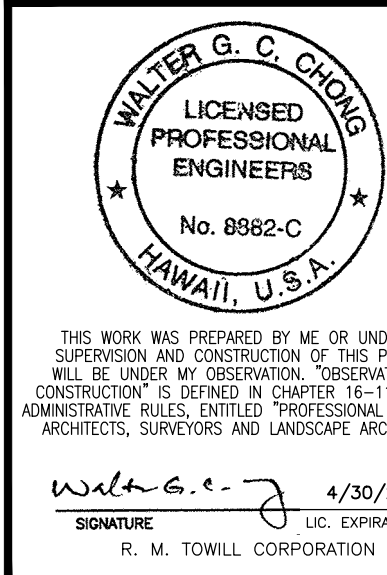

STATE OF HAWAII
DEPARTMENT OF TRANSPORTATION
HIGHWAYS DIVISION

QUADGUARD DETAILS

Kamehameha Highway
Kaipapau Stream Bridge Replacement
Federal Aid Project No. BR-083-1(48)

Scale: As Noted Date: February 2021

STRUCTURAL GENERAL NOTES

FED. ROAD DIST. NO.	STATE	FEDERAL AID PROJ. NO.	FISCAL YEAR	SHEET NO.	TOTAL SHEETS
HAWAII	HAW.	BR-083-1(48)	2021	ADD. 65	161

1. GENERAL SPECIFICATIONS:

(A) Hawaii Department of Transportation, Hawaii Standard Specifications for Road and Bridge Construction, 2005, together with Special Provisions prepared for this Contract.

2. DESIGN SPECIFICATIONS:

(A) AASHTO 2012 LRFD Bridge Design Specifications (Sixth Edition) and its subsequent interim specifications with interim supplements and modifications by the HDOT Highways Division.

(B) HDOT Document dated March 1, 2013 with subject title "Design Criteria for Bridges and Structures"

(C) AASHTO 2013 Standard Specifications for structural supports for Highways, Signs, Luminaires, and Traffic Signals (Sixth Edition) and its subsequent interim specifications with interim supplements and modifications by the HDOT Highways Division.

3. LOADS:

(A) Dead Load: A 25 psf allowance for future wearing surface of asphalt concrete has been included in Dead Load calculations. Concrete unit weight of 160 pcf has been assumed for Dead Load calculations. A future utilities load on each side of the Bridge of 150 plf has been included.

(B) Live Load: HL-93 Service and Strength Limit States

(C) Seismic: In accordance with AASHTO LRFD Bridge Design Specifications, 6th Edition, 2012:

Peak Ground Acceleration (PGA = 0.18g), modified by the Site Coefficient ($F_{PGA} = 1.44$) to give a spectrum acceleration, $A_S = 0.26g$

Short period acceleration at 0.2 seconds ($S_S = 0.40g$) modified by the Site Coefficient ($F_a = 1.48$) to give the short period spectrum acceleration, $S_{DS} = 0.592g$

Long Period acceleration at 1.0 seconds ($S_1 = 0.11g$) modified by the Site Coefficient ($F_v = 2.36$) to give the long period spectrum acceleration, $S_{D1} = 0.260g$

Site Class = D
Seismic Zone = 2
Operational Category = Essential

(D) Federal Emergency Management Agency (FEMA)
-Flood Hazard Designation:

Zone: AE
Base Flood Elevation: El. = 14
(Upstream of Bridge)
Non-Bore Tsunami Run up: El. = 10

3. LOADS (Cont.):

(E) Combined Scour Elevations:
Abutment No. 1: 100 year Scour El. = -8.0

Abutment No. 2: 100 year Scour El. = -8.0

(F) Railing Test Level TL-3

(G) Seismic Parameters for Segmental Retaining Wall - Refer to S12.5.

4. MATERIALS:

(A) All concrete strengths shall be as noted below:

Item No.	Structural Parts	Compressive Strength f'c (28 Days)	Maximum Water (W/C)	Maximum Cement (lbs/cyd)	Maximum Cementitious Material Content (lbs/cyd)
(1)	Drilled Shafts including Trial and Load Test Shafts See Note (E) in this section	4500 psi	0.45	720	720
(2)	Drilled Shaft Cap Beam, End Beam, Aesthetic Railing, End Post, Concrete Barrier, Corbel for Approach Slab, Corbel for Conc. Encased Ducts, Diaphragms, Girder Seats, Barrier Wall, Wing Walls and Wing Wall return See Notes (D), (E), and (F) in this section	5000 psi	0.40	670	670
(3)	Prestressed Girders See Note (E) in this section and Sheet S4.5	10000 psi (12000 psi at 56 days)	0.40	670	752
(4)	Precast Deck Form See Notes (D), (E) and (F)	6000 psi	0.40	670	670
(5)	Bridge Deck, Topping over End Beam, Approach Slabs, Concrete encasing ducts within bridge, and Sleeper Slab. See Notes (D), (E) and (F).	SBD (See Section 601)	--	--	--
(6)	Temporary Bridge Abutments, Piers, Footings, and Miscellaneous Concrete	4000 psi	0.45	670	670
(7)	Deck and End beam Closure Pours (Including Corbel), See Note (E)	VESLMC (See Section 540)	-	-	-
(8)	Concrete for Waterline: a. Cradle See notes (D), (E), and (F) b. Curtain wall shall be light weight concrete (Density < 120 lbs/cu. ft.)	5000 psi 3000 psi (See Section 627)	0.40 -	670 -	670 -
(9)	All others, except as noted otherwise	4000 psi	0.45	670	670

4. MATERIALS (Cont.):

(B) Concrete mixes shall be designed to be pumpable and flowable with minimum segregation and separation.

(C) The use of calcium chloride in any concrete is prohibited.

(D) A shrinkage reducing admixture (SRA), such as Master Life SRA35 by BASF or Eclipse by W.R. Grace & Co., or accepted equal, shall be added to the concrete mix for Items No. (2), (4), (5) and (8)a, under note 4.(A). The minimum dosage requirement shall be 128 ounces per cubic yard of concrete. Include the weight of the SRA with the total water in computation of the Water to Cement Ratio.

(E) A migrating corrosion inhibitor amine carboxylate water-based admixture shall be added to the concrete mix for Item Nos. (1), (2), (3), (4), (5), (7) and (8). under Note 4.(A). The minimum dosage shall be 24 ounces per cubic yard of concrete.

(F) A 1 1/2" long macro synthetic fiber such as Forta Ferro, Strux 90/40, Max Matrix, or approved equal shall be added to the concrete mix for items No. (2), (4), (5) and (8)a. under note 4.(A). The minimum dosage shall be 7.5 pounds per cubic yard of concrete.


(G) Non-shrink Grout shall be a pre-mixed product consisting of non-staining, non-metallic aggregate cement, water reducing and plasticizing agents capable of developing a minimum compressive strength of 4000 psi in 3 days and 7000 psi in 28 days. The non-shrink grout shall contain at least 10 grams of migrating amine carboxylate corrosion inhibiting admixture per 0.4 to 0.5 cubic feet of non-shrink grout.

(H) Cure concrete as specified in the Contract documents. Remove curing that may affect binding from all areas requiring future bonding unless a curing agent such as SINAK Lithium Cure or accepted equal that does not affect bond and provide equal or better curing is used.

(I) All concrete shall include at least one of the three methods stated in Section 601 of the Special Provisions, or approved equal, to reduce the embodied carbon footprint in concrete.

3

7/21/21	Revised Comp. Strength for Prestressed Girders
DATE	REVISION
STATE OF HAWAII DEPARTMENT OF TRANSPORTATION HIGHWAYS DIVISION	
STRUCTURAL GENERAL NOTES	
KAMEHAMEHA HIGHWAY Kaipapau Stream Bridge Replacement Federal Aid Proj. No. BR-083-1(48)	
Scale: None	Date: February 2021
SHEET No. S04 OF 12 SHEETS	

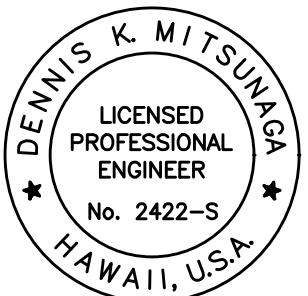

THIS WORK WAS PREPARED BY
ME OR UNDER MY SUPERVISION
SIGNATURE: [Signature] LIC. EXPIRATION: 4/30/22
MITSUNAGA & ASSOCIATES, INC.