

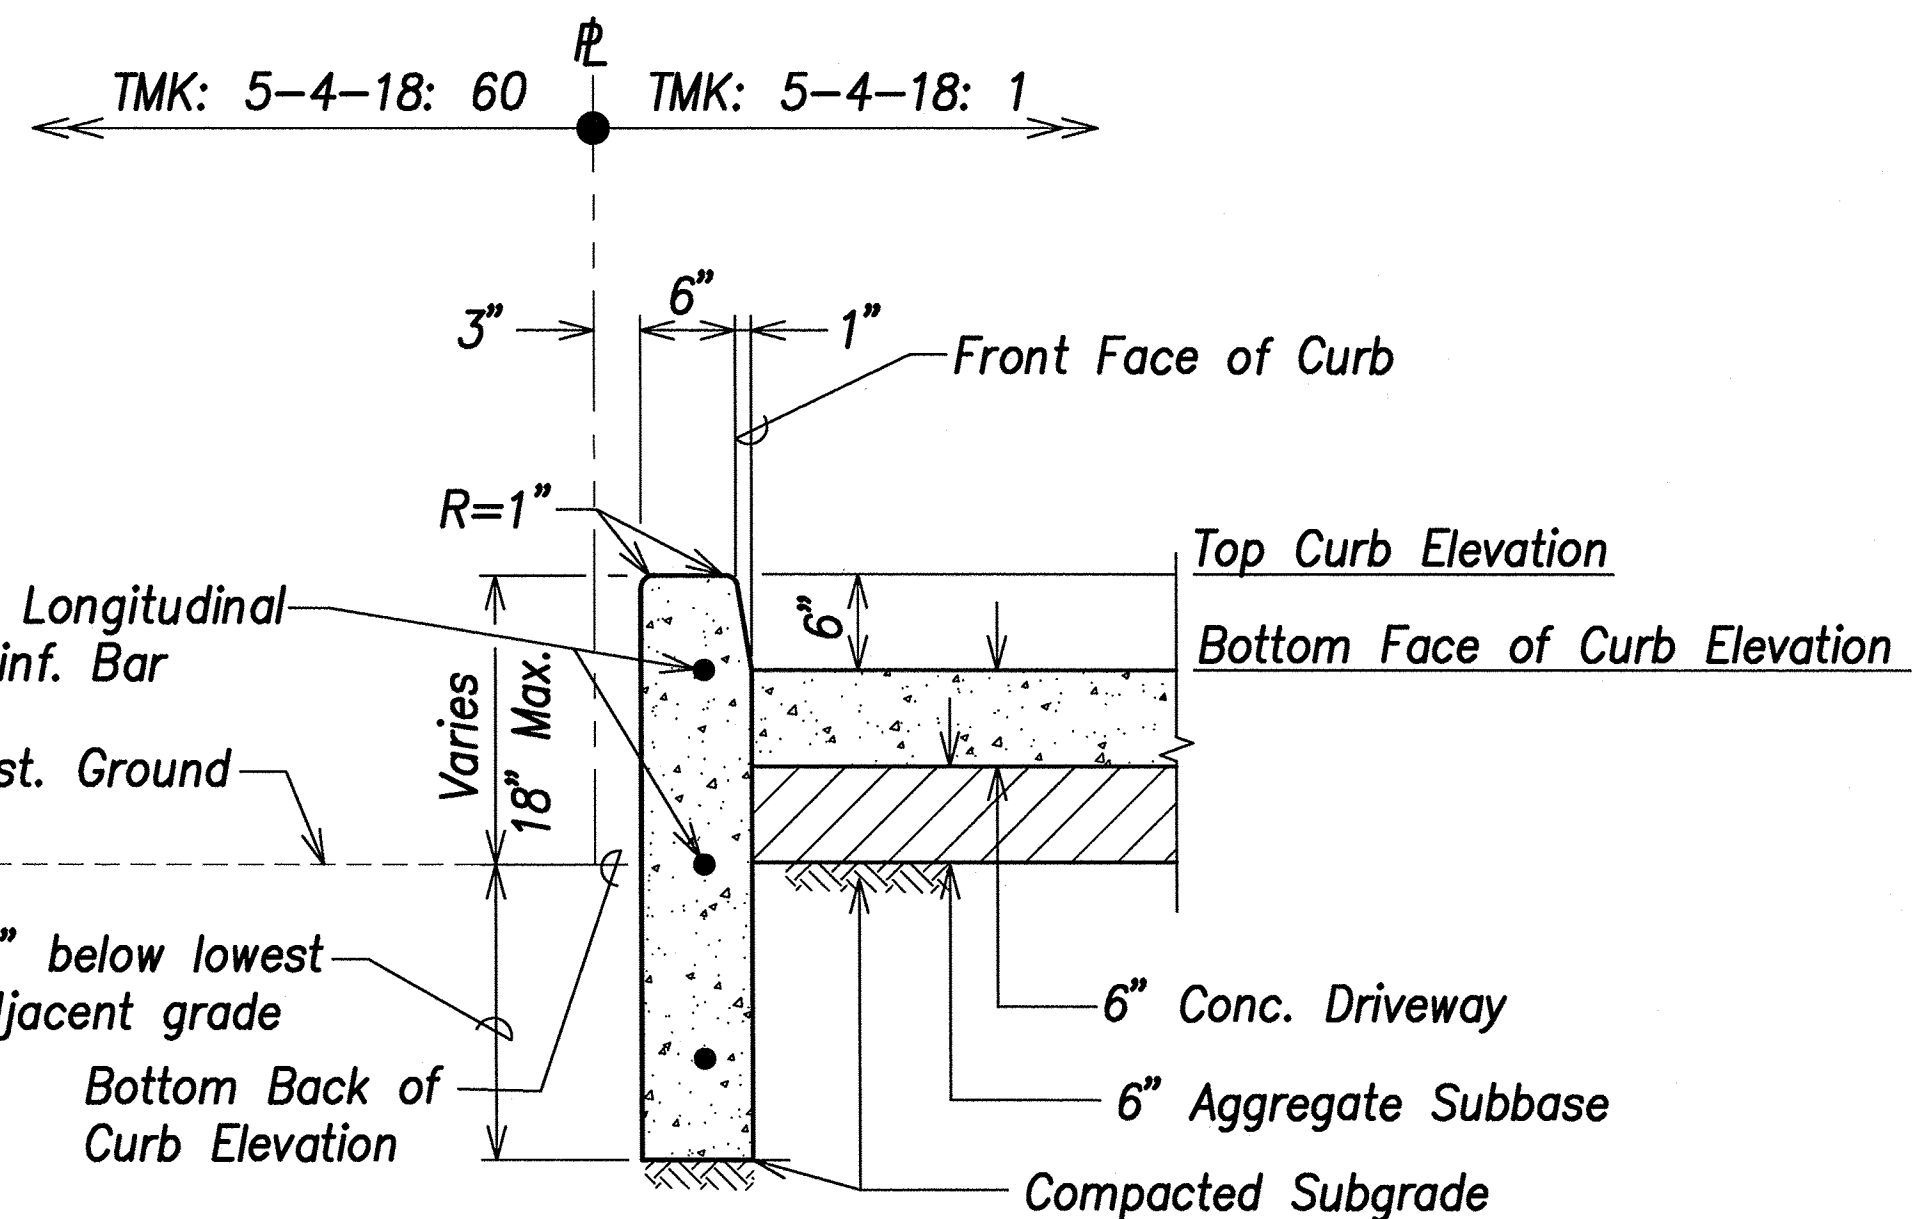
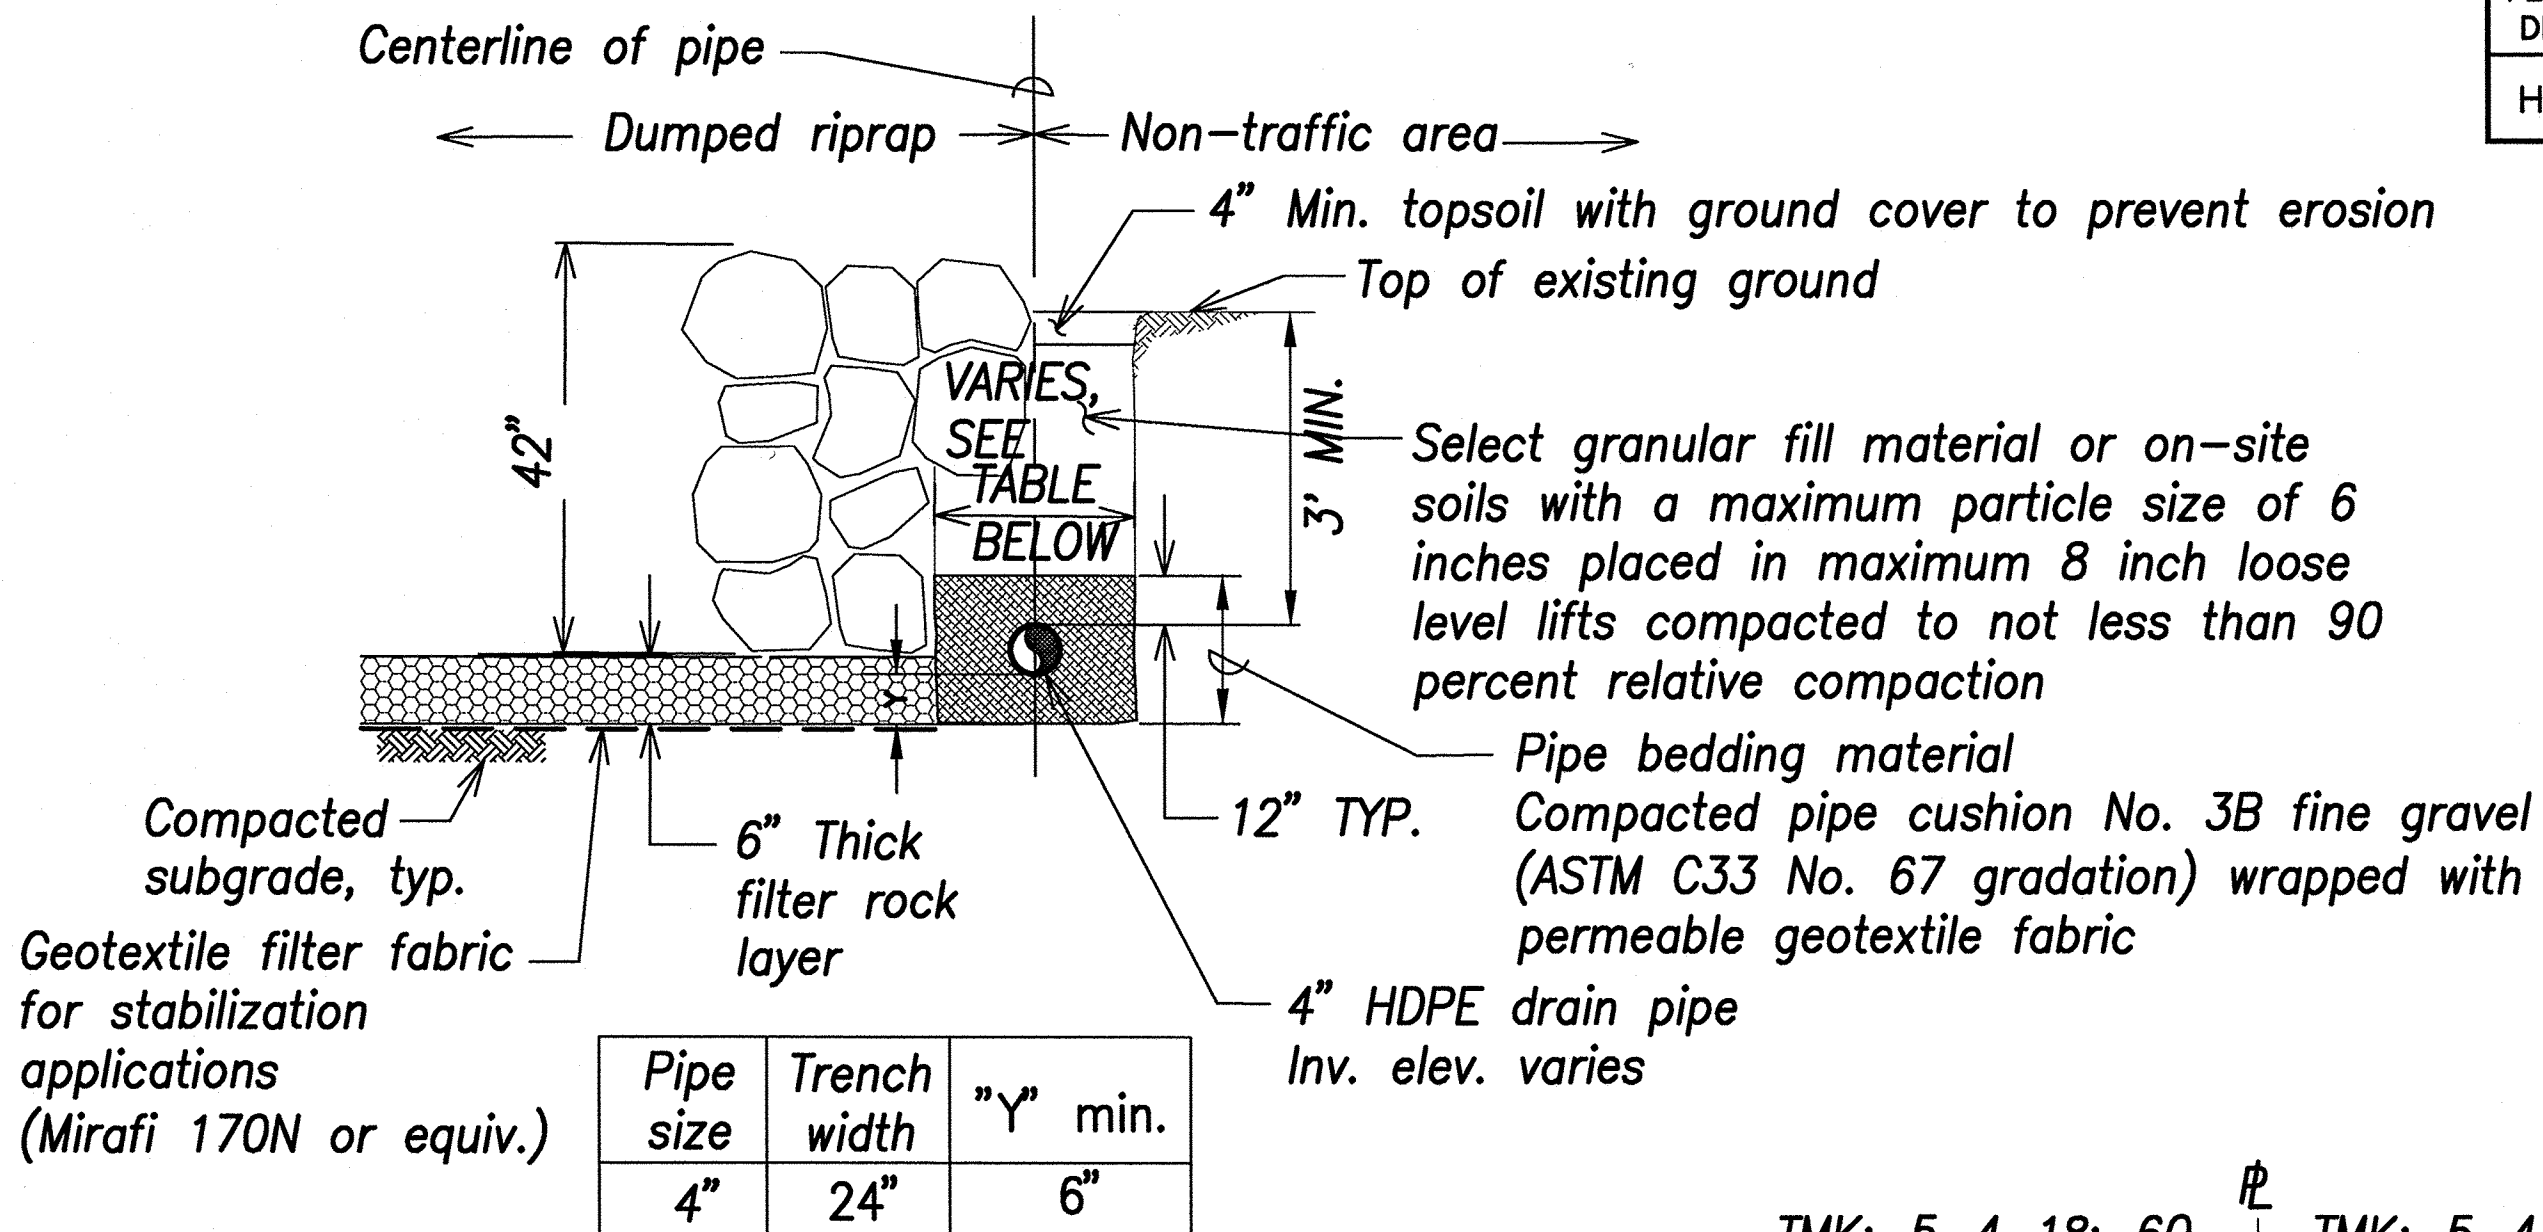


FED. ROAD DIST. NO.	STATE	PROJ. NO.	FISCAL YEAR	SHEET NO.	TOTAL SHEETS
HAWAII	HAW.	BR-083-1(48)	2021	40	161


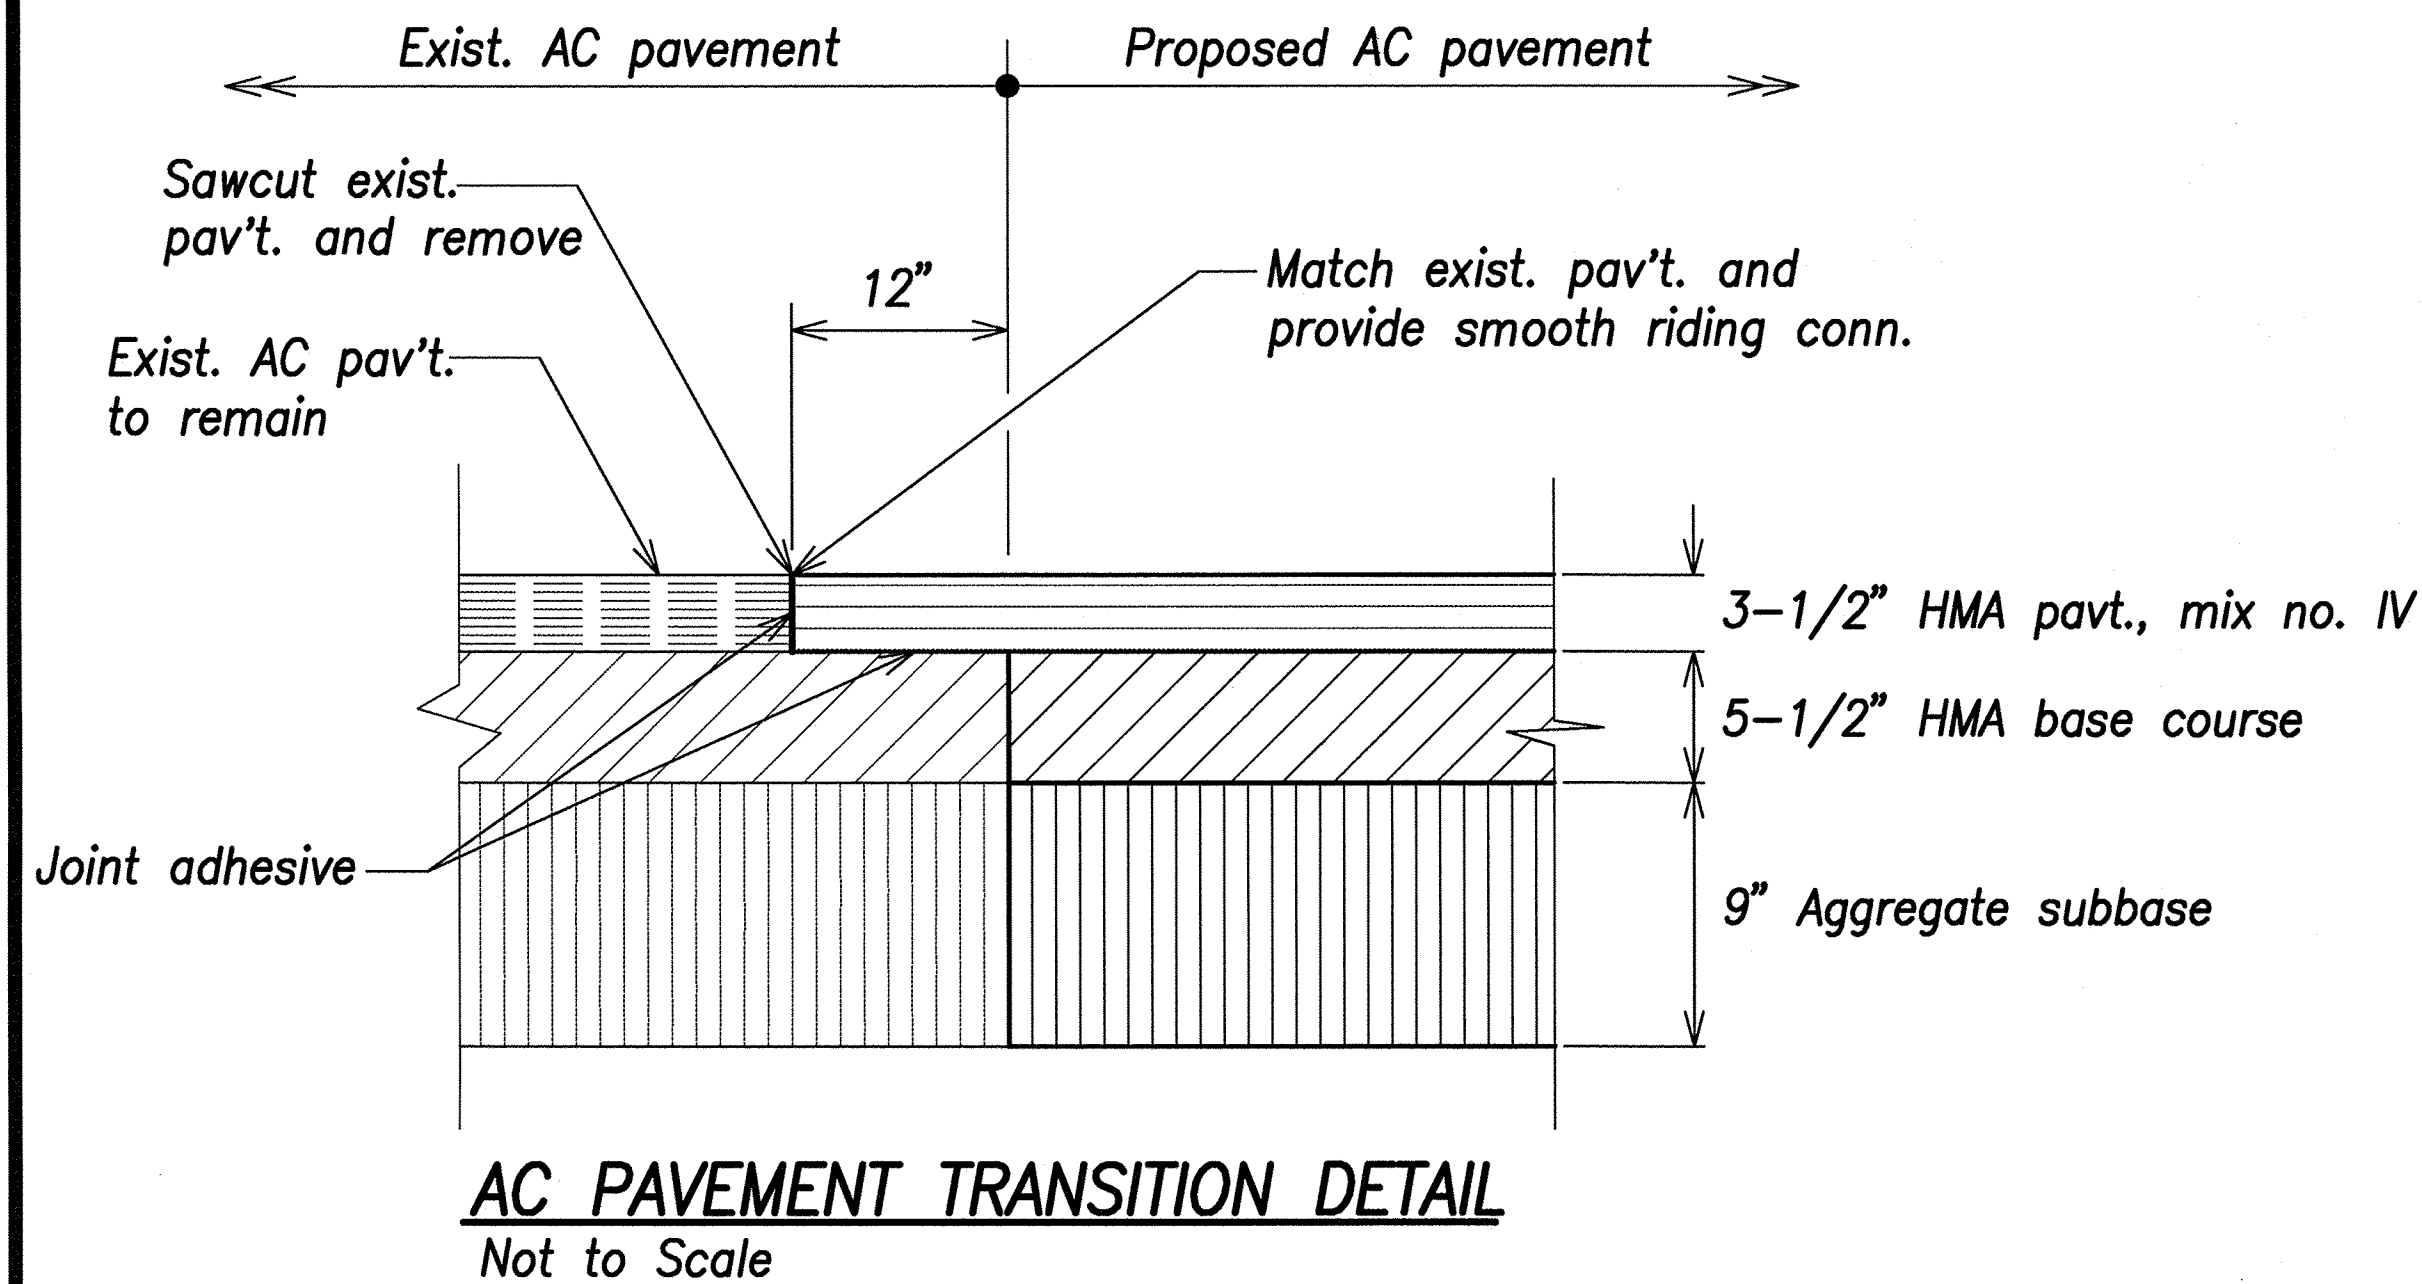


Note:
For remainder concrete curb details, see Standard Plan D-05, Curb, Type 3D (Similar).

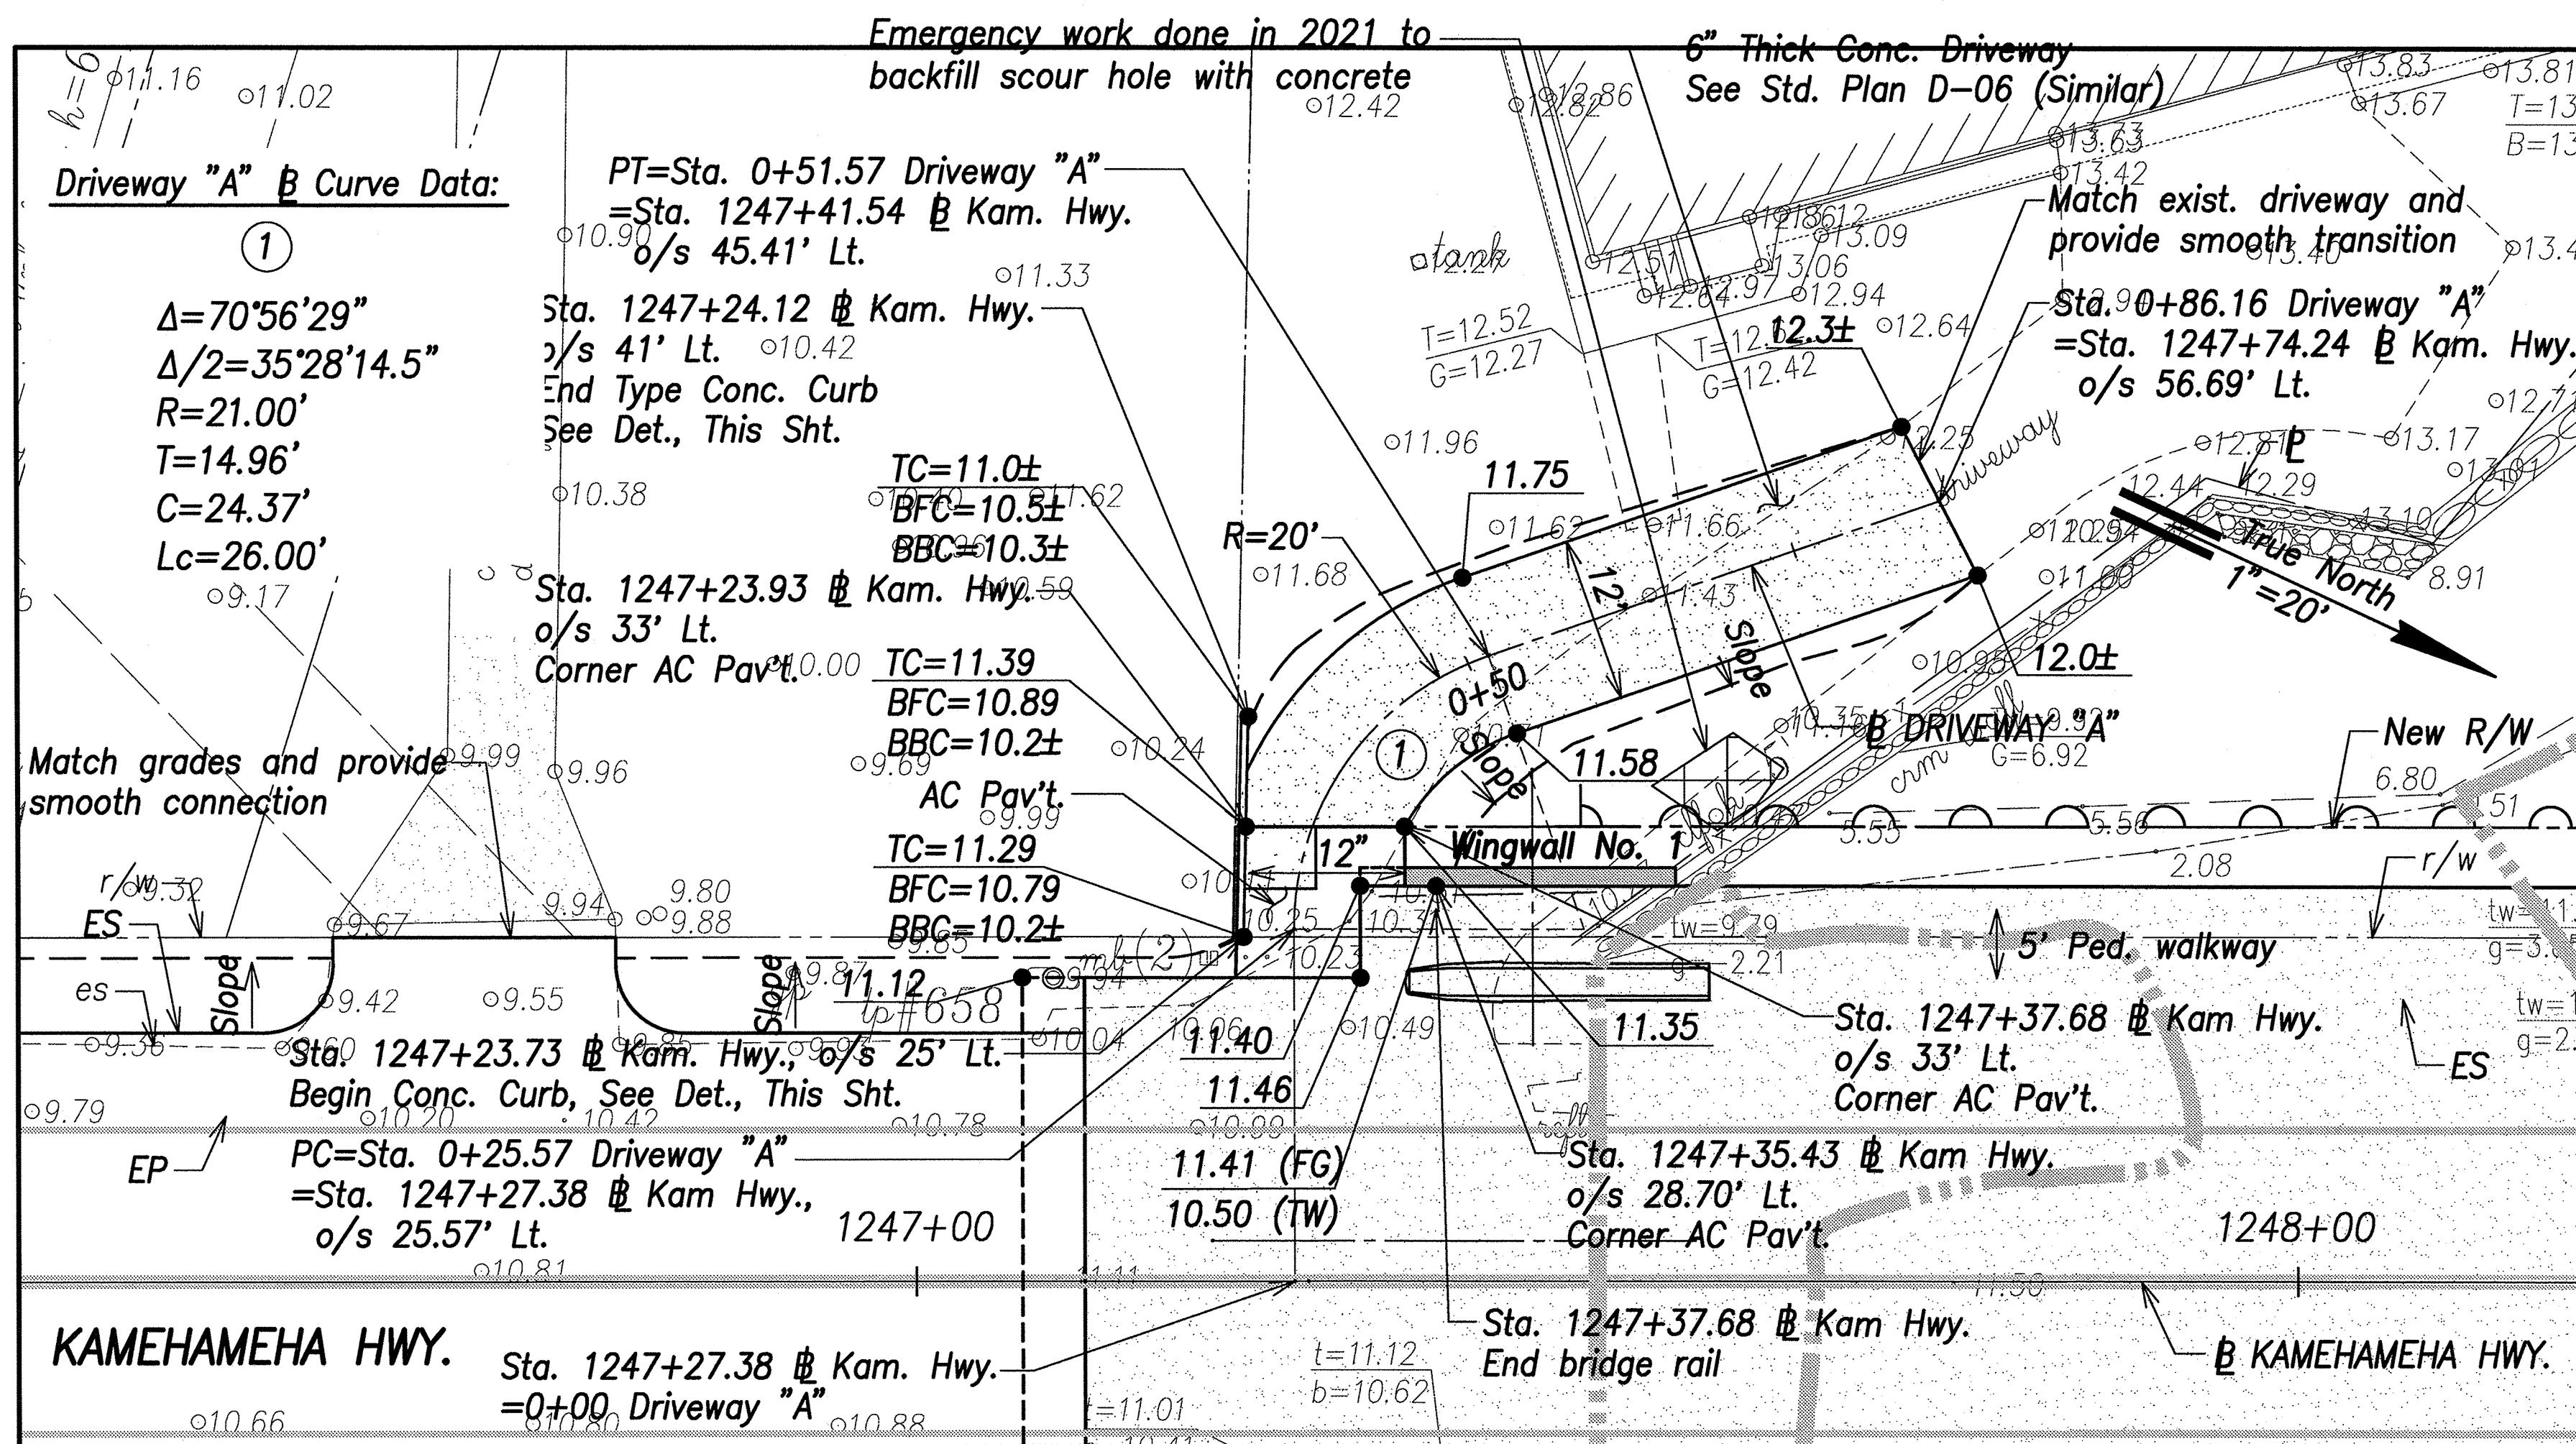

Legend:

- 10.00 Finished Grade Elevation
- TC=11.29 Top Curb Elevation
- BFC=10.79 Bottom Face of Curb Elevation
- BBC=10.21 Bottom Back of Curb Elevation

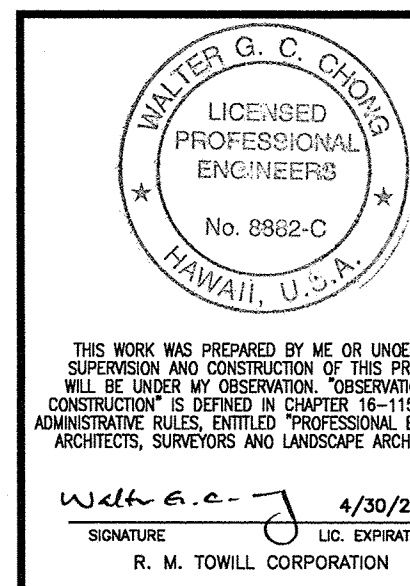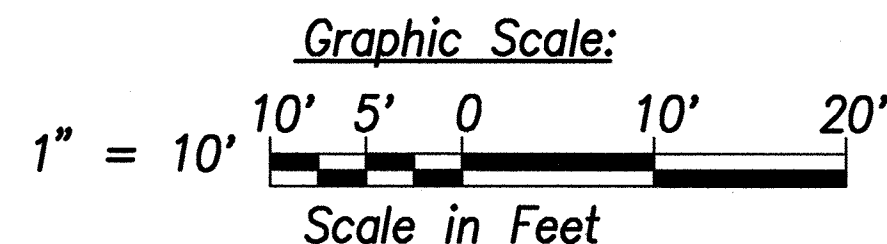

STATE OF HAWAII
DEPARTMENT OF TRANSPORTATION
HIGHWAYS DIVISION
**DRIVEWAY "A" RECONSTRUCTION PLAN
& AC PAVEMENT TRANSITION DETAIL**
Kamehameha Highway
Kaipapau Stream Bridge Replacement
Federal Aid Project No. BR-083-1(48)

Scale: As Noted Date: February 2021

SHEET No. C-38 OF SHEETS