


FED. ROAD DIST. NO.	STATE	PROJ. NO.	FISCAL YEAR	SHEET NO.	TOTAL SHEETS
HAWAII	HAW.	BR-083-1(48)	2021	11	161

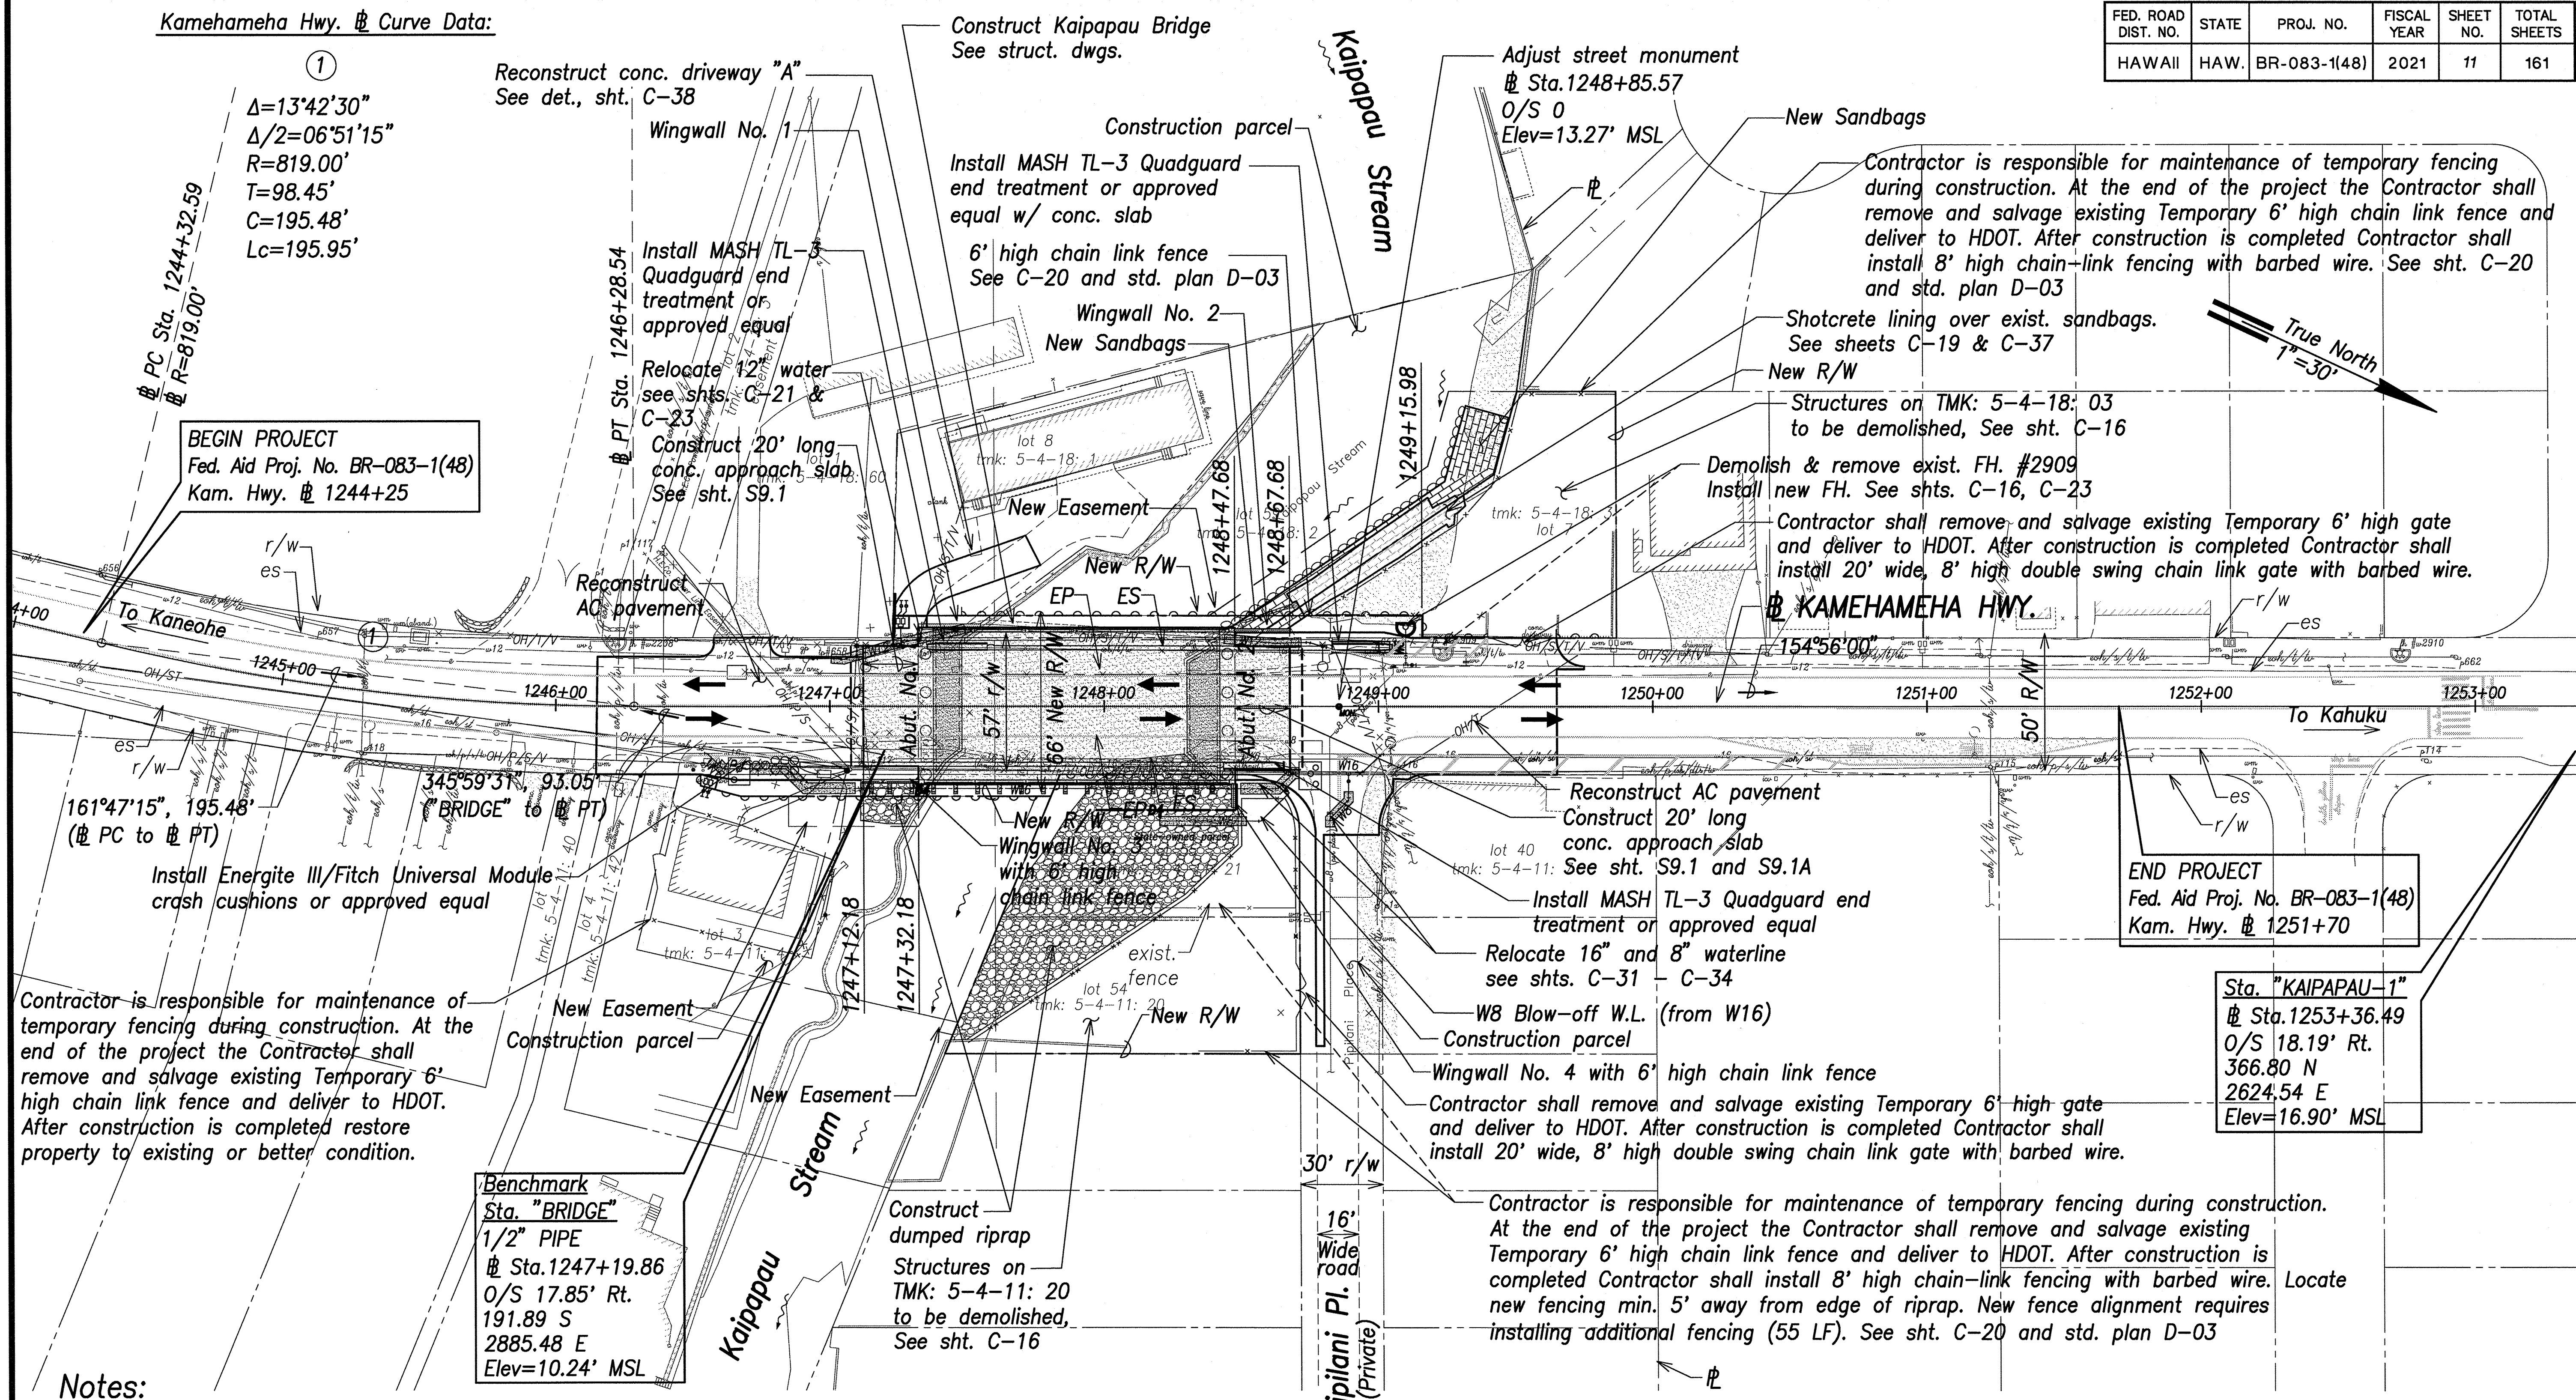

WALTER G. G. CHONG  
LICENSED PROFESSIONAL ENGINEERS  
No. 8882-C  
HAWAII, U.S.A.

THIS WORK WAS PREPARED BY ME OR UNDER MY SUPERVISION AND CONSTRUCTION OF THIS PROJECT WILL BE UNDER MY OBSERVATION. OBSERVATION OF CONSTRUCTION IS DEFINED IN CHAPTER 10-115, HAWAII ADMINISTRATIVE RULES, ENTITLED "PROFESSIONAL ENGINEERS, ARCHITECTS, SURVEYORS AND LANDSCAPE ARCHITECTS."

4/30/22  
R. M. TOWILL CORPORATION

STATE OF HAWAII  
DEPARTMENT OF TRANSPORTATION  
HIGHWAYS DIVISION

**GENERAL SITE PLAN**

*Kamehameha Highway  
Kaipapau Stream Bridge Replacement  
Federal Aid Project No. BR-083-1(48)*

Scale: As Noted      Date: February 2021

**SHEET No. C-9 OF SHEETS**