
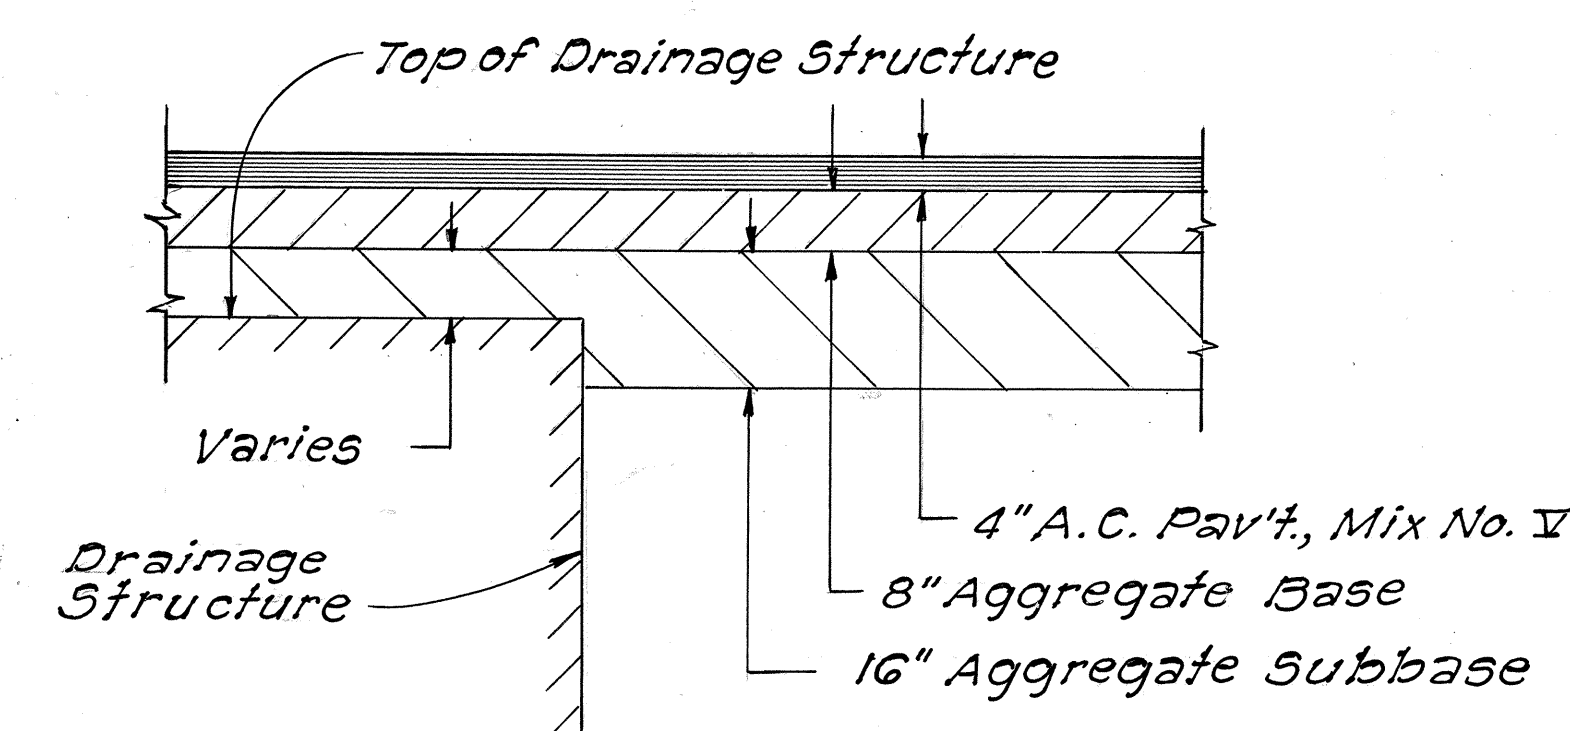


FED. ROAD DIST. NO.	STATE	FED. AID PROJ. NO.	FISCAL YEAR	SHEET NO.	TOTAL SHEETS
HAWAII	HAW.	FR-083-1(14) HES-083-1(16)	1981	8	30

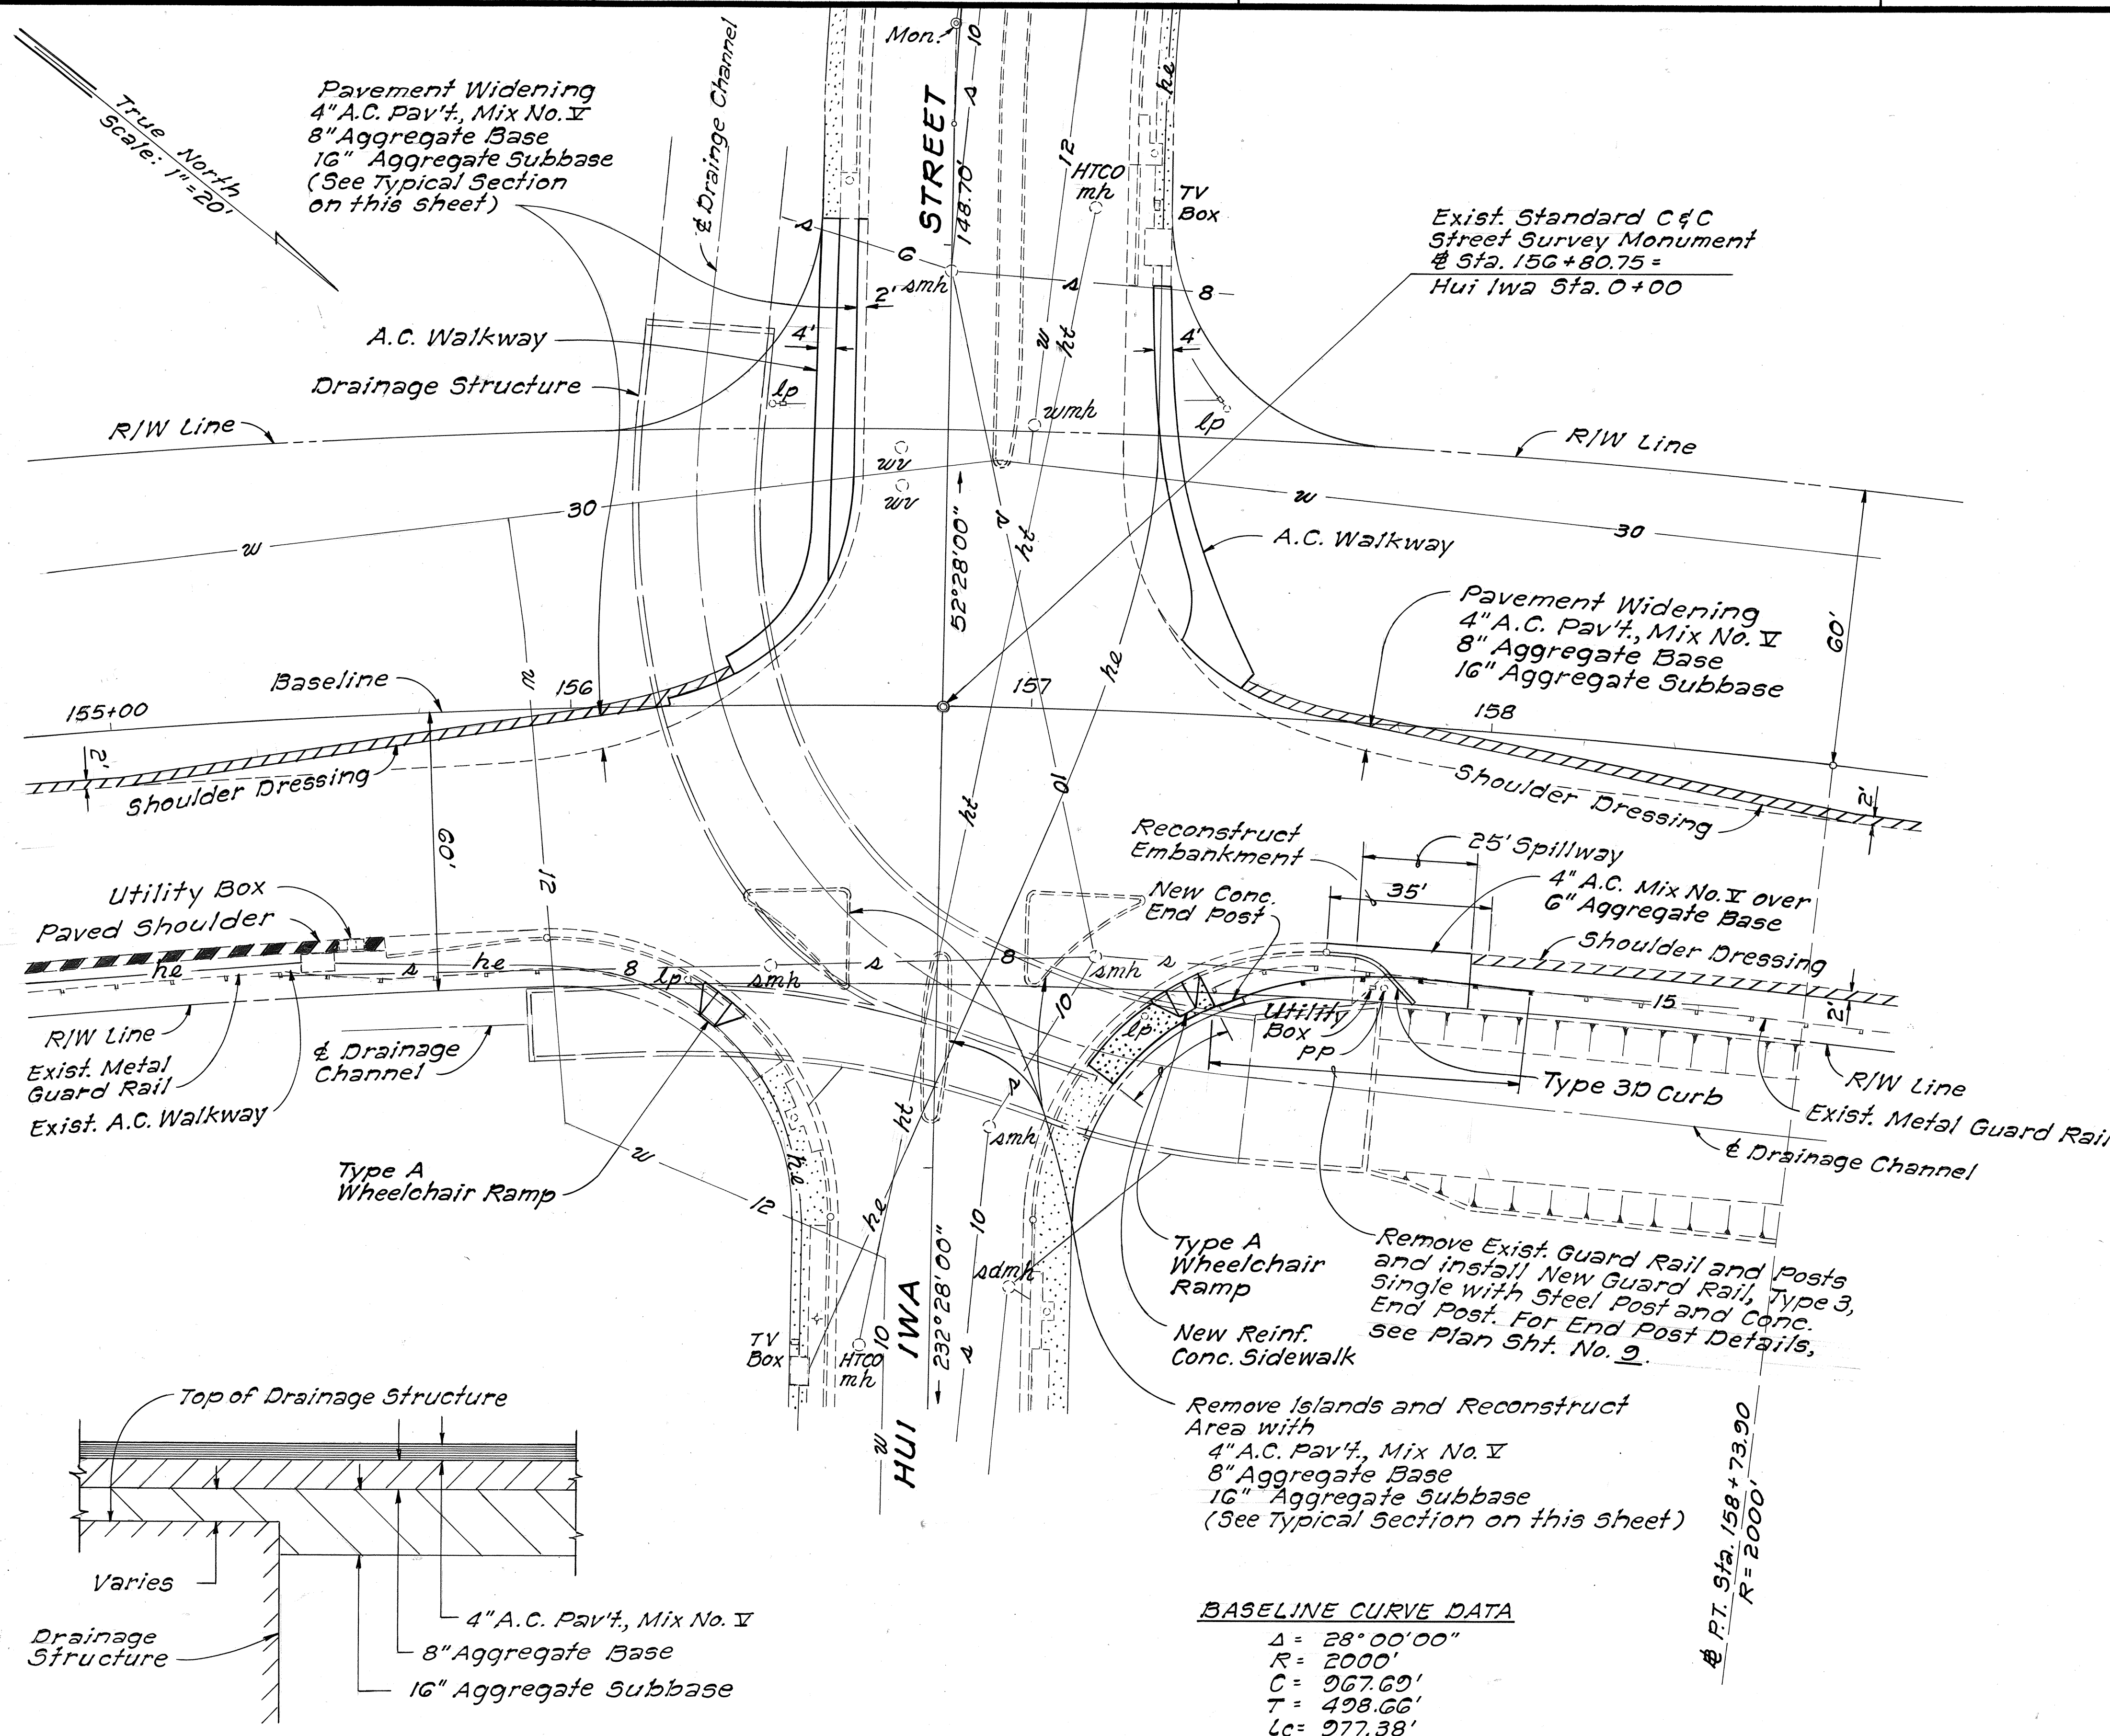

**TYPICAL SECTION
OVER DRAINAGE STRUCTURE**
Scale: 1/2" = 1'-0"

STATE OF HAWAII
DEPARTMENT OF TRANSPORTATION
LAND TRANSPORTATION FACILITIES DIVISION

PLAN
HUI IWA INTERSECTION
KAHEKILI HIGHWAY
F.A. PROJ. NO. FR-083-1(14)
F.A. PROJ. NO. HES-083-1(16)
Scale: As Shown Date: Apr, 1981
SHEET NO. 1 OF 1 SHEETS