


FED. ROAD DIST. NO.	STATE	FED. AID PROJ. NO.	FISCAL YEAR	SHEET NO.	TOTAL SHEETS
HAWAII	HAW.	PR-083-1(14) HES-083-1(16)	1981	26	30

GENERAL NOTES

1. LOCATIONS OF EXISTING UNDERGROUND STRUCTURES AND UTILITIES SUCH AS PIPELINES, CONDUITS, CABLES, ETC. SHOWN ON THE PLANS ARE APPROXIMATE ONLY. IT IS THE RESPONSIBILITY OF THE CONTRACTOR TO VERIFY THE LOCATIONS OF ALL EXISTING UTILITIES WITH THE RESPECTIVE OWNERS. EXISTING UTILITIES DAMAGED BY THE CONTRACTOR SHALL BE REPAIRED BY THE CONTRACTOR AT HIS OWN EXPENSE.
2. THE LOCATIONS OF THE TRAFFIC SIGNAL STANDARDS, MAST ARMS, PEDESTRIAN PUSH BUTTONS, PULL BOXES, CONDUITS AND LOOP DETECTORS SHALL BE STAKED OUT BY THE CONTRACTOR AND APPROVED BY THE ENGINEER PRIOR TO CONSTRUCTION AND INSTALLATION.
3. LOCATIONS OF TRAFFIC MARKINGS AND MARKERS (LANE LINES, STOP LINES, CROSSWALKS, ETC.) SHOWN ON THE PLANS SHALL BE VERIFIED BY THE CONTRACTOR WITH THE ENGINEER PRIOR TO INSTALLATION OF THE TRAFFIC SIGNAL.
4. ALL TRAFFIC SIGNAL WORK SHALL CONFORM TO THE REQUIREMENTS OF THE "MANUAL ON UNIFORM TRAFFIC CONTROL DEVICES FOR STREETS AND HIGHWAYS," FEDERAL HIGHWAY ADMINISTRATION (1978) AND AMENDMENTS.
5. THE CONTRACTOR SHALL COORDINATE WORK AND ARRANGE FOR INSPECTION OF WORK WITH THE DEPARTMENT OF TRANSPORTATION SERVICES, CITY AND COUNTY OF HONOLULU, HIGHWAYS DIVISION, DEPARTMENT OF TRANSPORTATION, STATE OF HAWAII, AND OTHER AGENCIES AS REQUIRED.
6. EXISTING TRAFFIC SIGNAL STANDARDS SHALL ONLY BE REMOVED AFTER THE NEW TRAFFIC SIGNAL SYSTEM IS IN OPERATION.
7. ABANDON EXISTING 6'x6' LOOP DETECTORS ON HUI IWA STREET.

ORIGINAL PLAN	DATE
SURVEY PLOTTED BY	
DRAWN BY	
DESIGNED BY	
QUANTITIES BY	
CHECKED BY	
NO.	

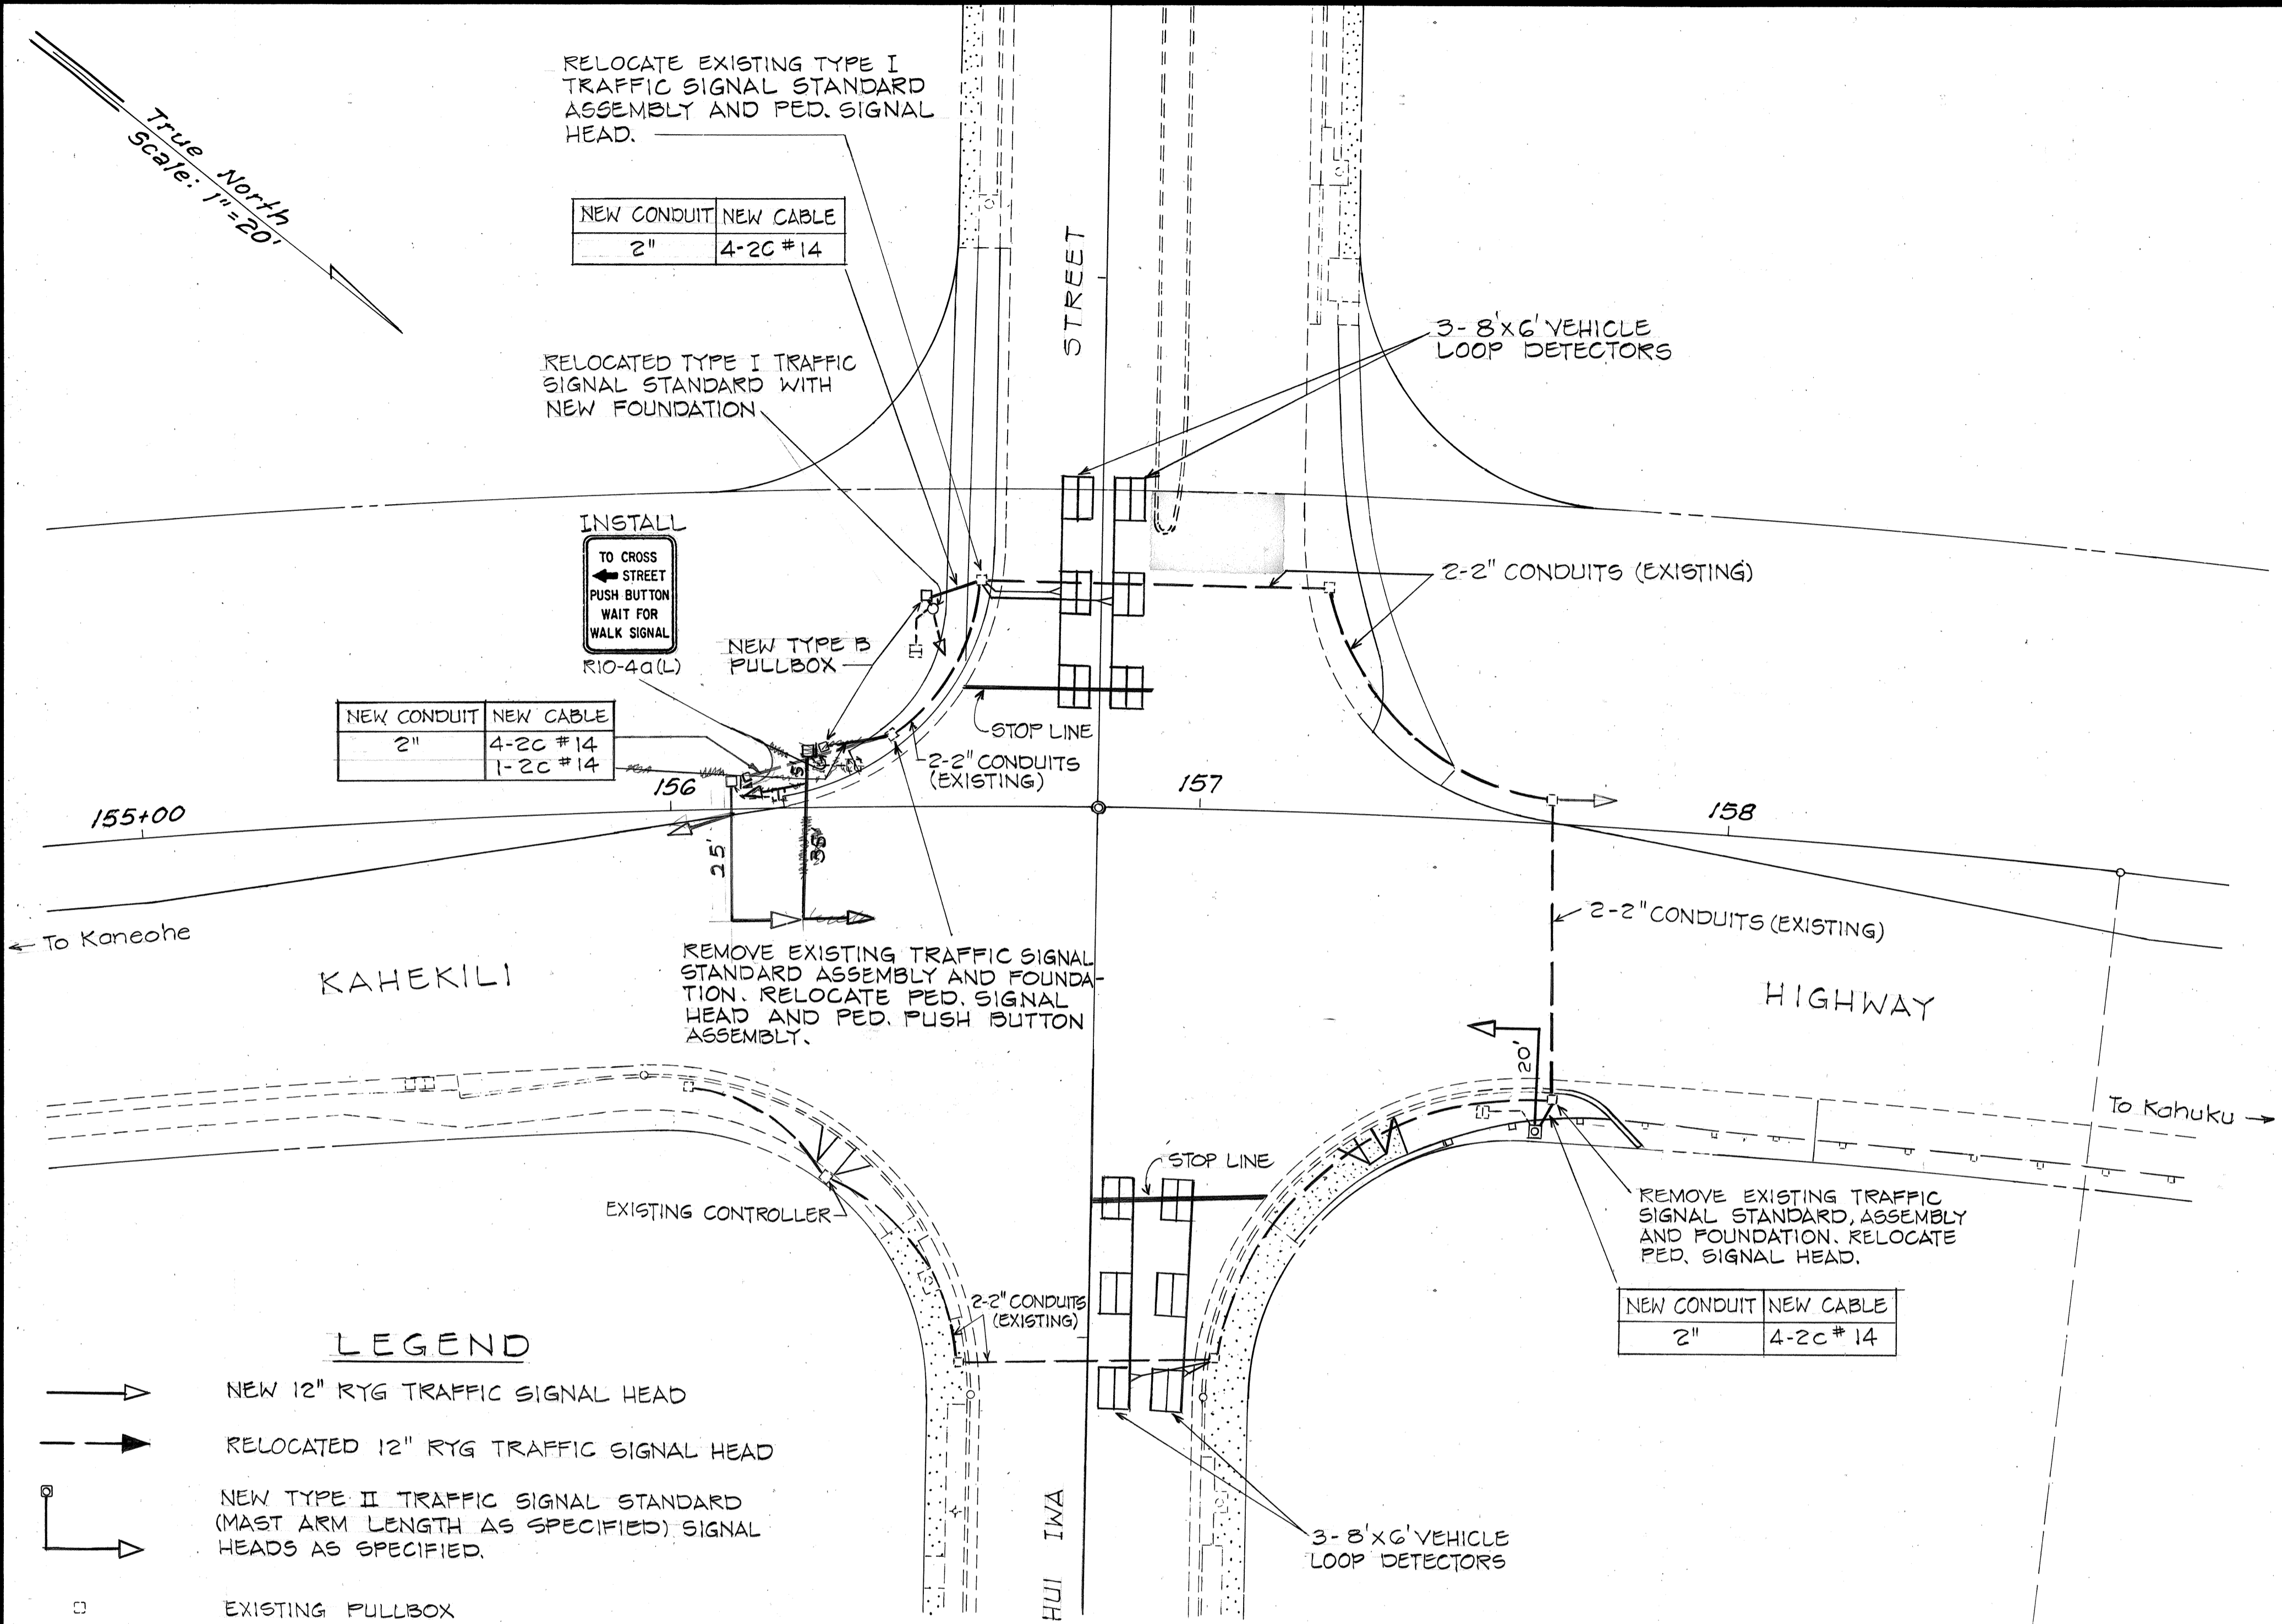

LEGEND

- ➔ NEW 12" RYG TRAFFIC SIGNAL HEAD
- ➔ RELOCATED 12" RYG TRAFFIC SIGNAL HEAD
- ➔ NEW TYPE II TRAFFIC SIGNAL STANDARD (MAST ARM LENGTH AS SPECIFIED) SIGNAL HEADS AS SPECIFIED.
- EXISTING PULLBOX
- NEW TYPE B PULLBOX
- NEW TRAFFIC SIGNAL DUCTLINE
- EXISTING TRAFFIC SIGNAL CONDUIT
- RELOCATED PEDESTRIAN SIGNAL HEAD

6/12/81	ADDED CONSTRUCTION NOTES AND REVISED TRAFFIC AND PEDESTRIAN SIGNAL HEADS
DATE	REVISION

STATE OF HAWAII
DEPARTMENT OF TRANSPORTATION
LAND TRANSPORTATION FACILITIES DIVISION
TRAFFIC SIGNALS

KAHEKILI HIGHWAY
F.A.P. No. PR-083-1(14)
F.A.R. No. HES-083-1(16)

SCALE: 1"=20'
DATE: APRIL, 1981
SHEET NO. 1 OF 1 SHEETS