

ORIGINAL PLAN	NOTED BOOK	QUANTITIES BY	CHECKED BY	DATE	X				
						DESIGNED BY	X		
								TRACED BY	X

GENERAL NOTES

- The scope of work for this project includes cold planing; resurfacing; reconstruction of weakened pavement areas; pavement marking and striping; guardrail improvements; adjusting utility manholes and boxes; drainage improvements; and installation of milled rumble strips.
- The Contractor is reminded of the requirements of Subsection 105.16 - Subcontract Requirements, which requires him to perform work to not less than 30 percent of the total contract cost less deductible items. Non-compliance with this Subsection may be grounds for rejection of bid.
- The Contractor's attention is directed to the following Sections: Subsection 104.11 - Utilities and Services; Subsection 107.06 - Contractor Duty Regarding Public Convenience; and Section 645 - Work Zone Traffic Control.
- At the end of each day's work, the Contractor shall remove all equipment and other obstructions to permit free and safe passage of public traffic.
- The existence and location of underground utilities, manholes, monuments and structures as shown on the plans are from the latest available data, but the accuracy is not guaranteed. The encountering of other obstacles during the course of work is possible. The Contractor shall tone for the exact locations and depths of all underground facilities, either shown on or omitted from the plans, in areas where work, such as the placement of sign posts, traffic signal conduits, etc. may affect these properties. Toning shall be considered incidental to the Various Contract Items and will not be paid for separately. The Contractor shall be held liable for any damages incurred to the existing facilities and/or improvements as a result of his operations.
- The Contractor shall notify, the Oahu Transit Services, Lowell Tom (848-4578) or Ed Sniffen (848-4571), two (2) weeks prior to construction, informing them of location, scope of work, and clo-sure of Name of Highway and/or traffic lanes and dates of clo-sure. (For Oahu projects only. For other islands, check with your local bus company.)
- The Contractor shall notify the Engineer in writing, two (2) weeks prior to starting construction operations.
- The Contractor shall obtain a Community Noise permit from the State Department of Health, Noise and Radiation Branch, 591 Ala Moana Blvd., Room 136, Honolulu, HI 96813-2498; Telephone No. 586-4700. This shall be considered incidental to the Various Contract Items and will not be paid for separately.
- The Contractor shall indemnify and be solely responsible for the protection of adjacent properties, utilities and existing structures from damages due to construction. Repairing any damage shall be at the Contractor's own expense, to the satisfaction of the Engineer.
- Contractor to restore all landscaped areas damaged according to Section 641, Hydro-Mulch Seeding. Grass restoration shall be considered incidental to Various Contract Items.
- Earth swale shall be graded to drain. This work shall be considered incidental to Various Contract Items.
- Smooth riding connections shall be constructed at all limits of project, including the beginning and end of project, connecting approaches, side streets, walkways and driveways as shown on the plans and/or as directed by the Engineer. This work shall be considered incidental to Asphalt Concrete and will not be paid for separately.

- The Contractor shall clean and remove any accumulation of aggregates along the roadside within 10 feet of the edge of pavement. This work shall be considered incidental to Bulk of Work or the Various Contract Items and will not be paid for separately.
- Removal and disposal of existing curb and gutter, curb, sidewalk and asphalt concrete pavement, curb, sidewalk and any debris shall be considered incidental to their res-pective bid items.
- All saw cutting work shall be considered incidental to Roadway Excavation or Asphalt Concrete or Various Contract Items or their respective bid items.
- Prior to placement of new aggregate subbase course, the existing subbase shall be compacted to a relative compaction greater than or equal to 95%.
- The top of the Asphalt Concrete Base Course prior to placement of the new A.C. Pavement, Mix No. IV shall comply with the ten-foot straight edge requirement. The variation of the surface from a straight edge with two contacts with the surface, shall not exceed 3/16."
- After completion of resurfacing, the Contractor and the Engineer will test for, and determine ponding areas (i.e. low spots, within the resurfaced area). It shall be the responsibility of the Contractor to correct and resurface and/or repair all such ponding areas. Corrective measures shall be approved by the Engineer.
- The Contractor shall be advised of the following neighboring projects during this project's duration:

Kamehameha Highway, Kaipapau Stream Bridge Replacement

Kamehameha Highway, Kamananui Rd and Wilikina Rehabilitation, Vicinity of Weed Circle to Route H-2

The Engineer will inform the Contractor when more information is known about the neighboring projects. The Contractor shall adjust trucking routes and loads accordingly. This cost shall be considered incidental to Various Contract Items.


The Contractor shall be advised of legal size and weight limits for vehicles and equipment in HRS 291-34 and HRS 291-35. In compliance with the law, the operation or transport of any equipment or truck which exceeds these limits shall apply for an Oversized and/or Overweight Vehicle permit through the Department of Transportation in accordance with HRS 291-36.
- The Contractor shall provide and maintain for access to and from all existing driveways , sidewalks and ADA access routes, and side streets and cross streets at all times. This work shall be considered incidental to Sidewalk or the Various Contract Items and will not be paid for separately.
- The Contractor shall provide and maintain a temporary pedestrian-safe and easily accessible route or detour with barricades in or near the work zone. This temporary route or detour shall be paved at least an inch of Asphalt Concrete Pavement, Mix No. IV or steel and/or wood planks and shall be American With Disabilities Act (ADA) compliant [This is only applicable if existing surface is dirt and/or if existing surface is non-ADA compliant.]. This work shall be incidental to Curb Ramps, or Sidewalk, or the Various Contract Items and will not be paid for separately.
- The Contractor shall remove and dispose of all existing raised pavement markers, thermoplastic line markings, traffic tapes, and epoxy adhesives prior to the overlaying of Asphalt Concrete. This work shall be considered incidental to Asphalt Concrete Pavement, Mix No. IV and will not be paid for seperately.

- No material and/or equipment shall be stockpiled or otherwise stored within the highway right-of-way except at locations designed in writing and approved by the Engineer. If use of location is approved by the engineer, the Contractor shall obtain a permit to use the property within the highway right-of-way from the Oahu District Office at Telephone No. 831-6712.
- Probing for guardrail utilities shall be considered incidental to Guardrail Items and will not be paid for separately.
- Removal of existing guardrail sections and end treatments shall be considered incidental to Various Guardrail Items and will not be paid for separately.
- Drilling of holes shall be considered incidental to Various Guardrail Items and will not be paid for separately.
- Temporary paving for recon areas to restore to original grades shall be removed during final cold planing and will not be paid for. Any temporary paving for recon areas not incorporated into the roadway pavement will not be paid for. This work shall be considered incidental to Cold Planing.
- Any unfinished shoulder widening, metal railings, guardrails, and median drainage work shall not be left unshielded at the end of the work day. If such work is not completed within the work day, that section shall be shielded by NCHRP TL-2 rated portable physical barriers. The physical barriers shall be protected by end treatments in compliance with NCHRP TL-2 and the manufacturer's recommendations/requirements and State Standard Plan TE-43. At the end of the work day, all travel lanes shall be open. The contractor shall develop a Traffic Control Plan to include these portable physical barriers and all necessary Traffic Control Devices and shall be approved by the Engineer. All work mentioned above including furnishing, installing, and maintaining physical barriers shall be considered incidental to Contract Item No. 645.1000 - Traffic Control and shall not be paid for separately.
- The exact locations and limits or areas to be excavated, reconstructed and cold planed shall be determined in the field by Engineer.
- All lanes shall be open to traffic during the hours from 6:30 P.M. to 8:00 A.M. No lane closures shall be allowed during the period of November 15th to January 1st for North Shore related surfing events. Individual lane closure length shall not exceed 1,000 L.F., excluding lane closure tapers at both approaches. Consecutive lane closures shall be separated by a minimum distance of 1-mile. Refer to Section 645 of the Special Provisions for additional details regarding lane closure hours, no lane closures, and allowable closure length.


The Contractor shall close only one lane at a time, not exceeding more than 1000 feet excluding tapers. There shall be no more than 3 concurrent lane closures between the project limits spaced a minimum of 1 mile apart.

03/15/2021	Revised Note 19
03/17/2021	Revised Note 19
05/27/2021	Revised Note 30
DATE	REVISION
STATE OF HAWAII DEPARTMENT OF TRANSPORTATION HIGHWAYS DIVISION GENERAL NOTES & LEGEND KAMEHAMEHA HIGHWAY REHABILITATION Vicinity of Kapuhi Street to Dairy Road Federal Aid Project No. NH-083-1(77) Date: June, 2020	


FED. ROAD DIST. NO.	STATE	FED. AID PROJ. NO.	FISCAL YEAR	SHEET NO.	TOTAL SHEETS
HAWAII	HAW.	NH-083-1(77)	2021	11	87

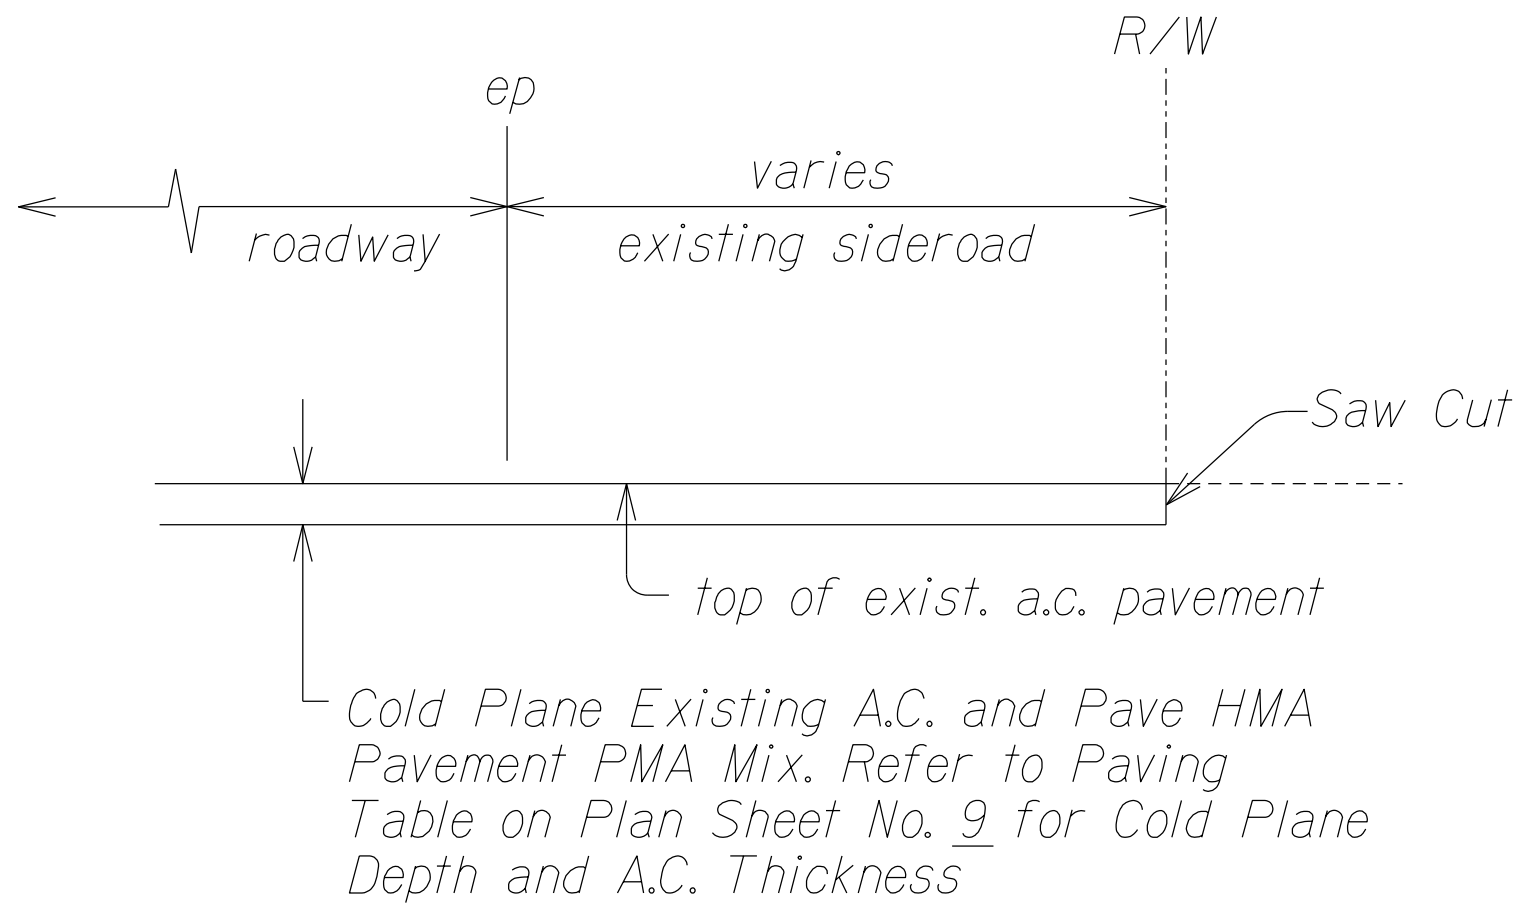


DETAIL OF PAVING AT PAVED SIDEROADS
Scale: N.T.S.

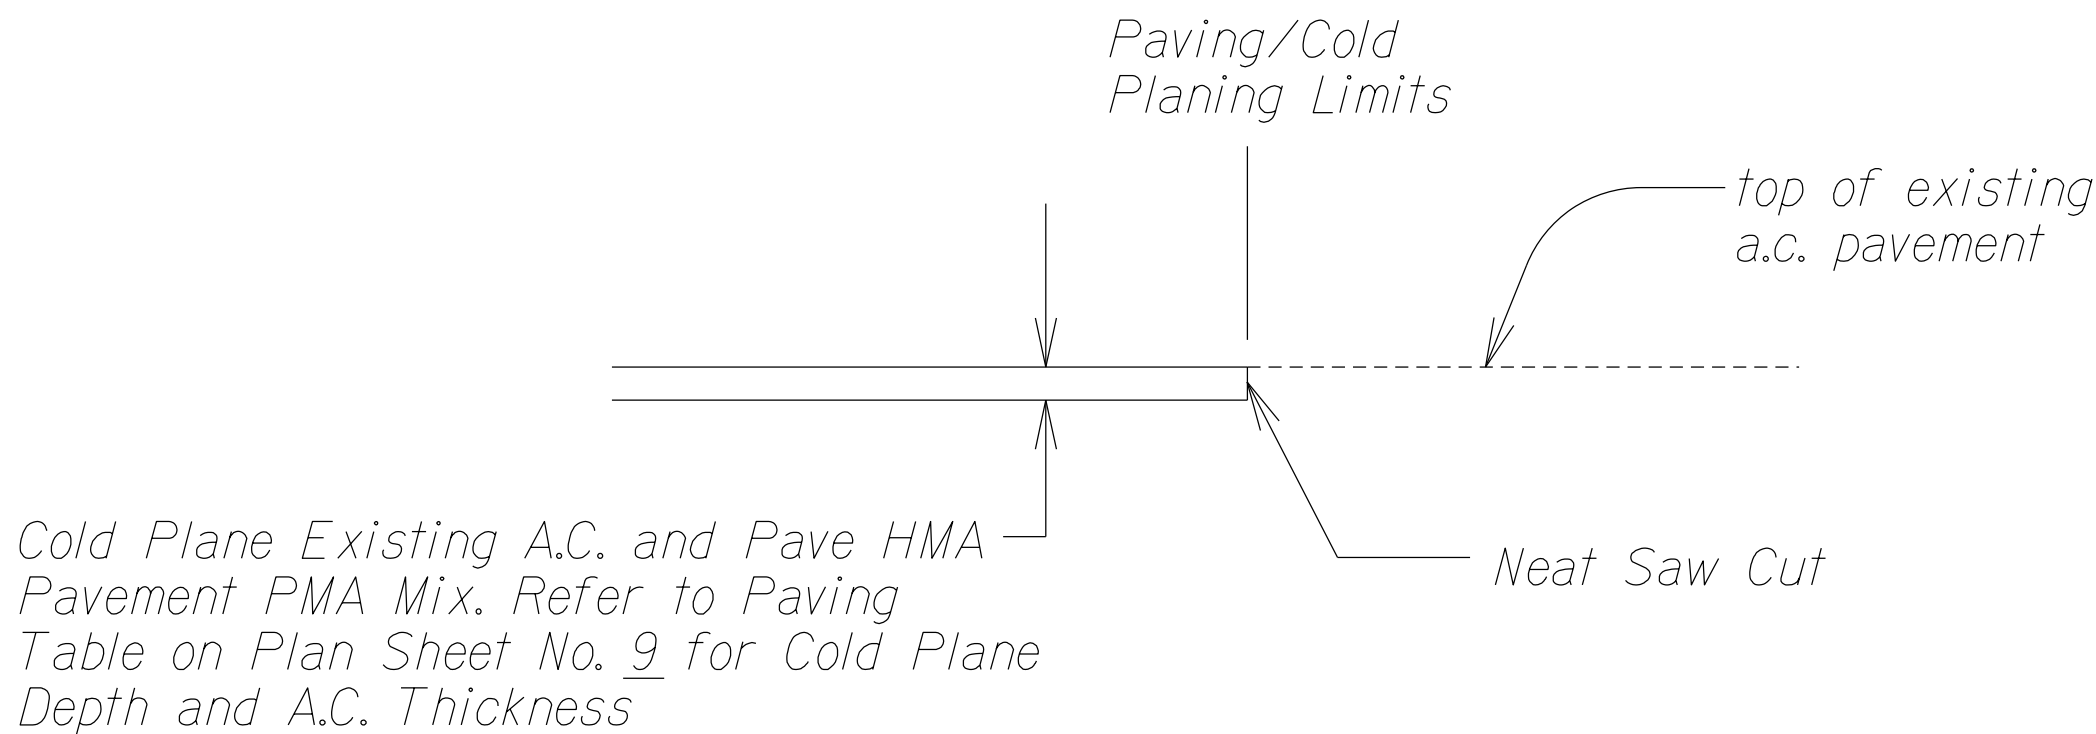


SMOOTH RIDING CONNECTION DETAIL AT
PAVING/COLD PLANING LIMITS. (COLD PLANE AREAS)
Scale: N.T.S.

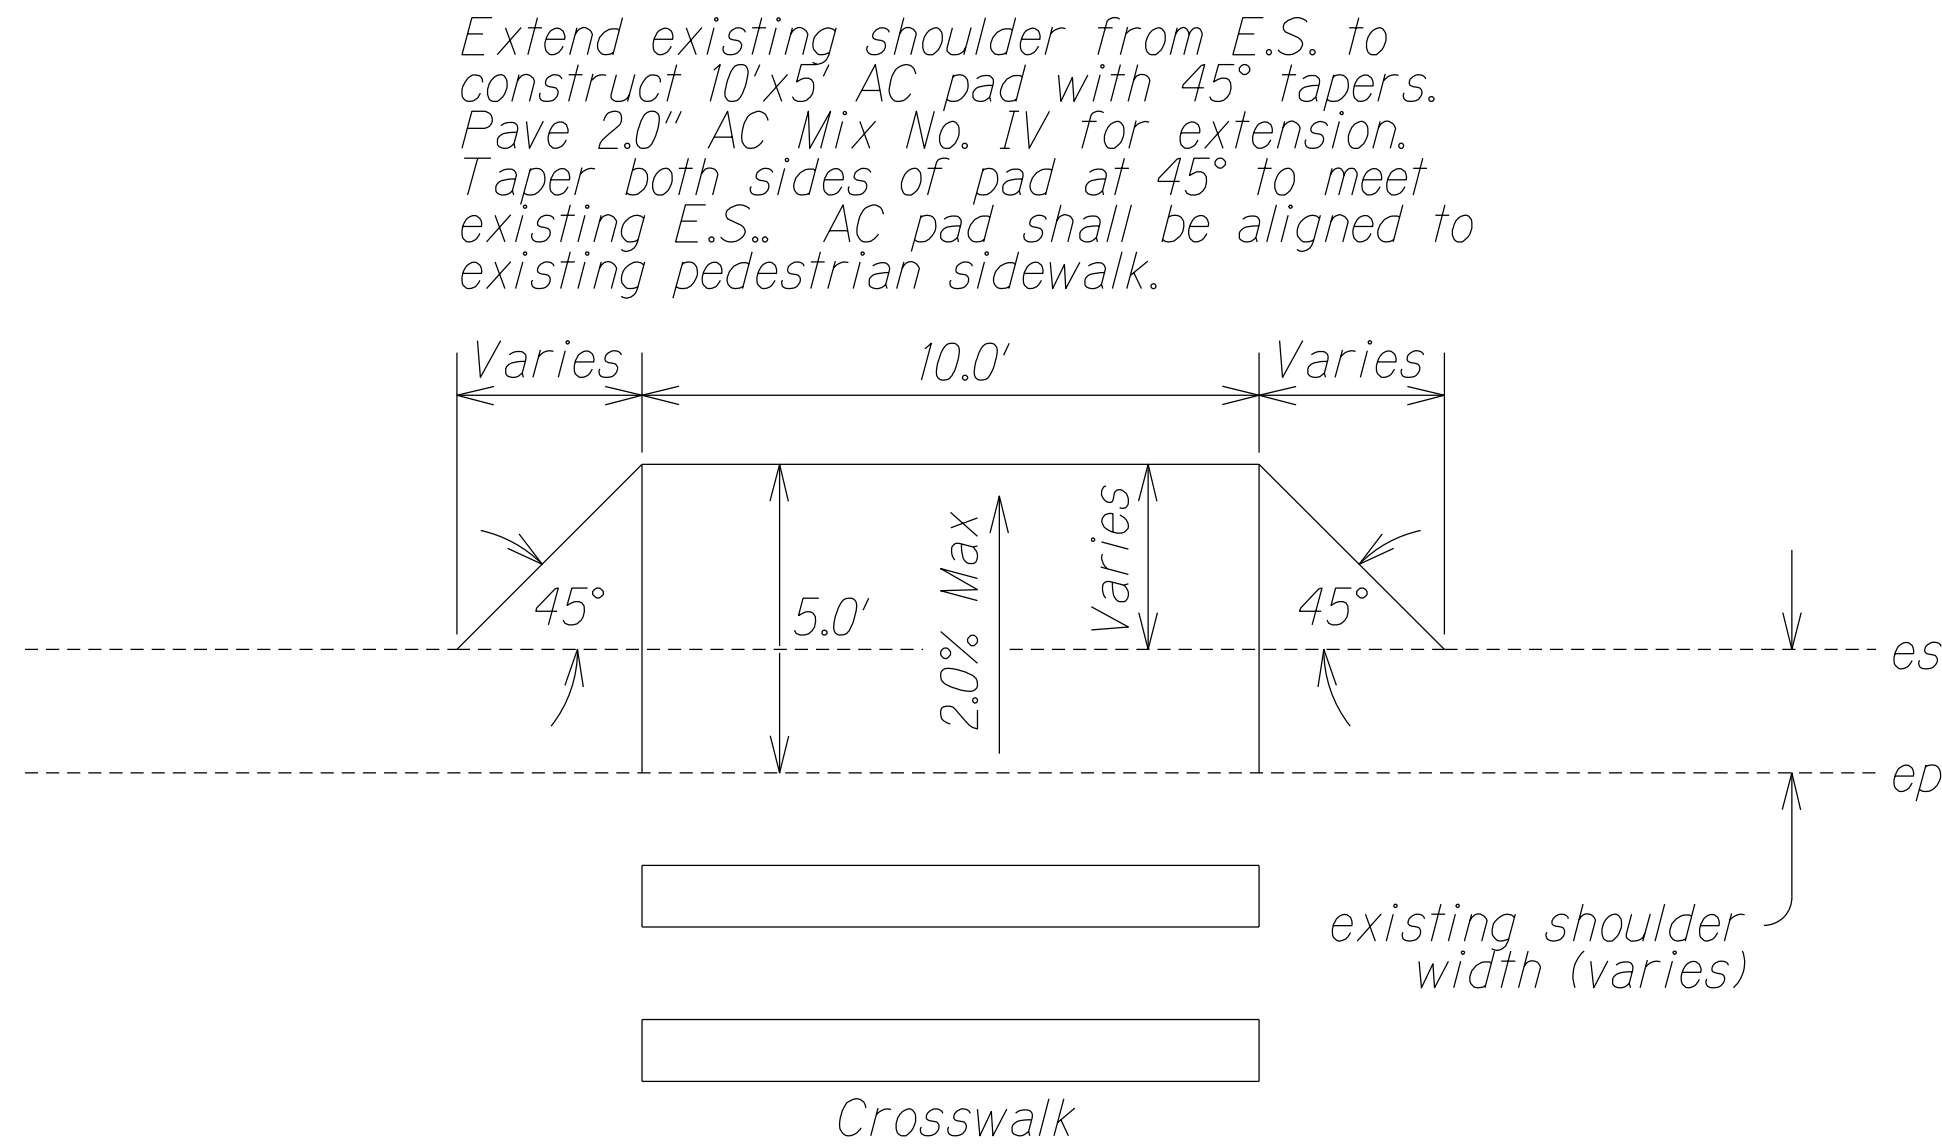


WHEEL CHAIR TURNING PAD DETAIL
Scale: N.T.S.

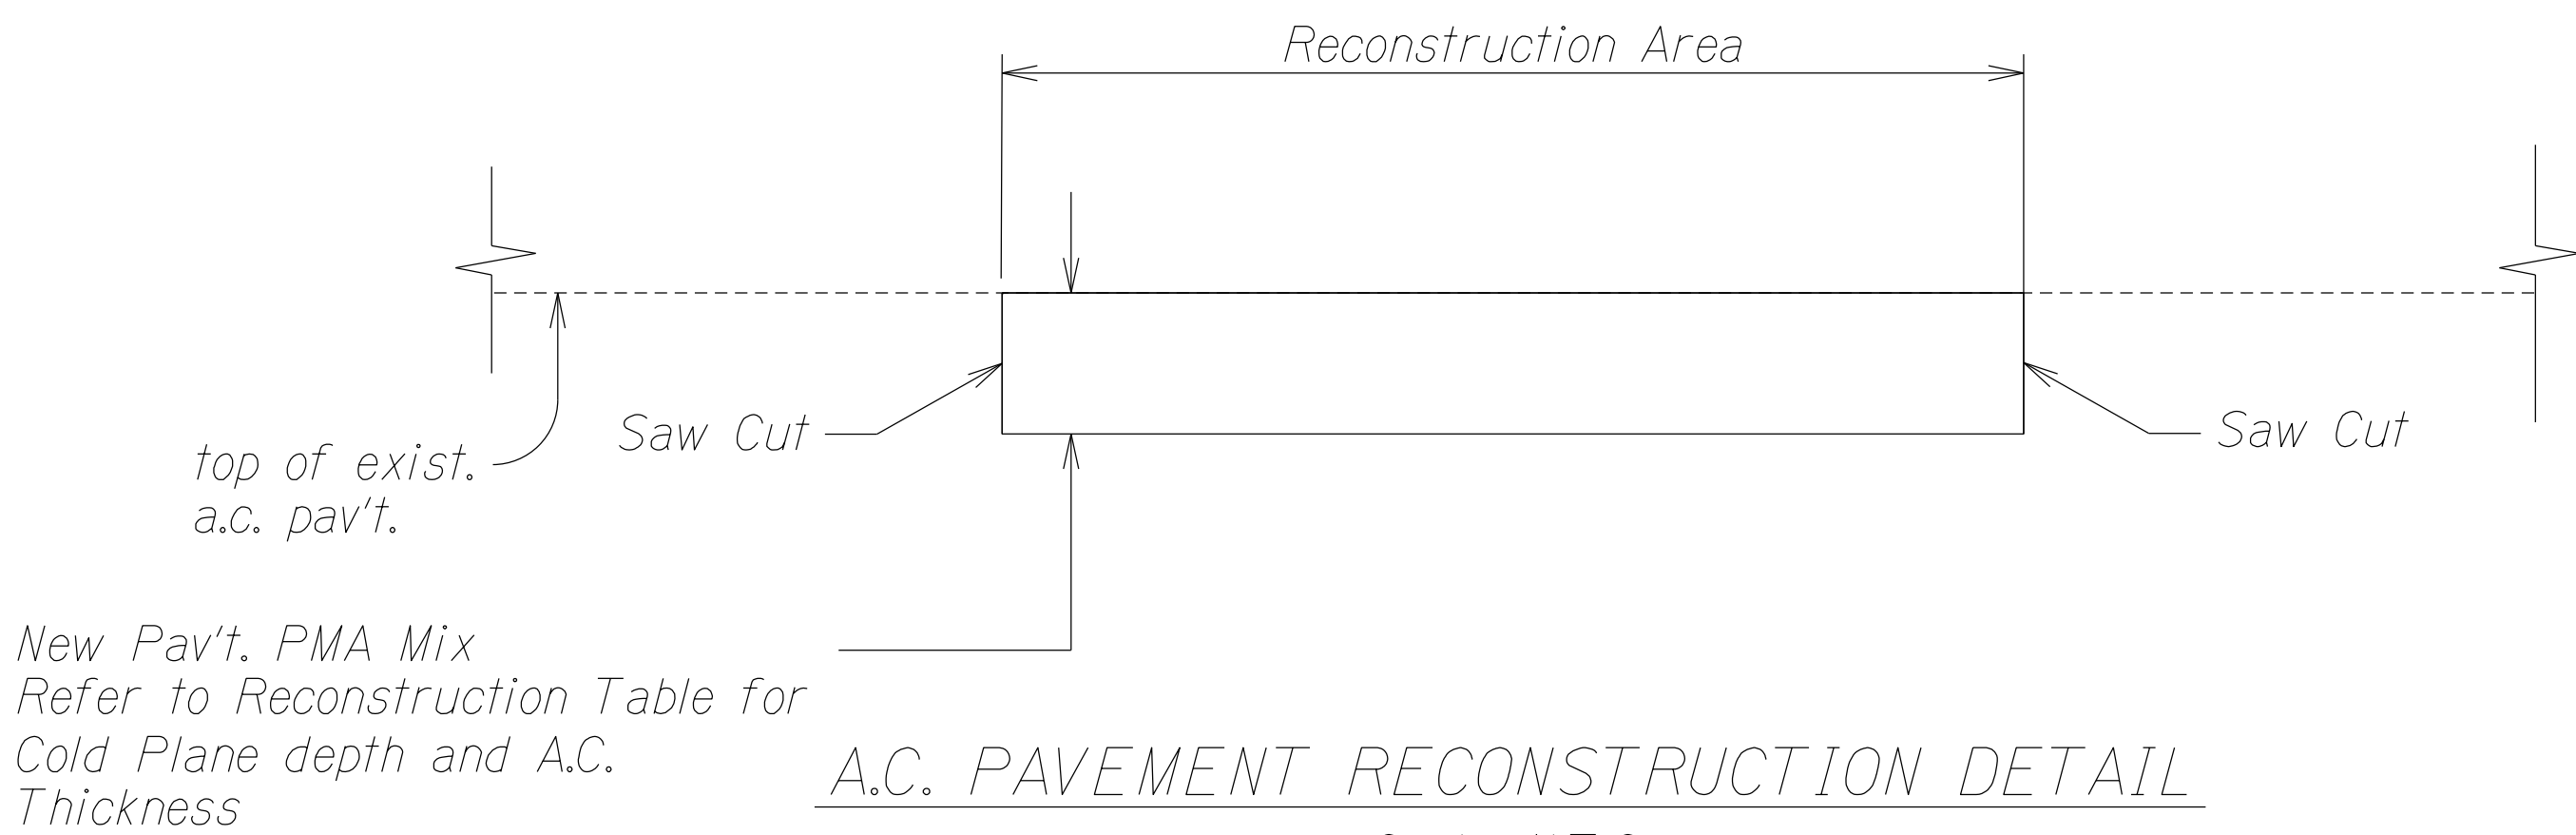

A.C. PAVEMENT RECONSTRUCTION DETAIL
Scale: N.T.S.

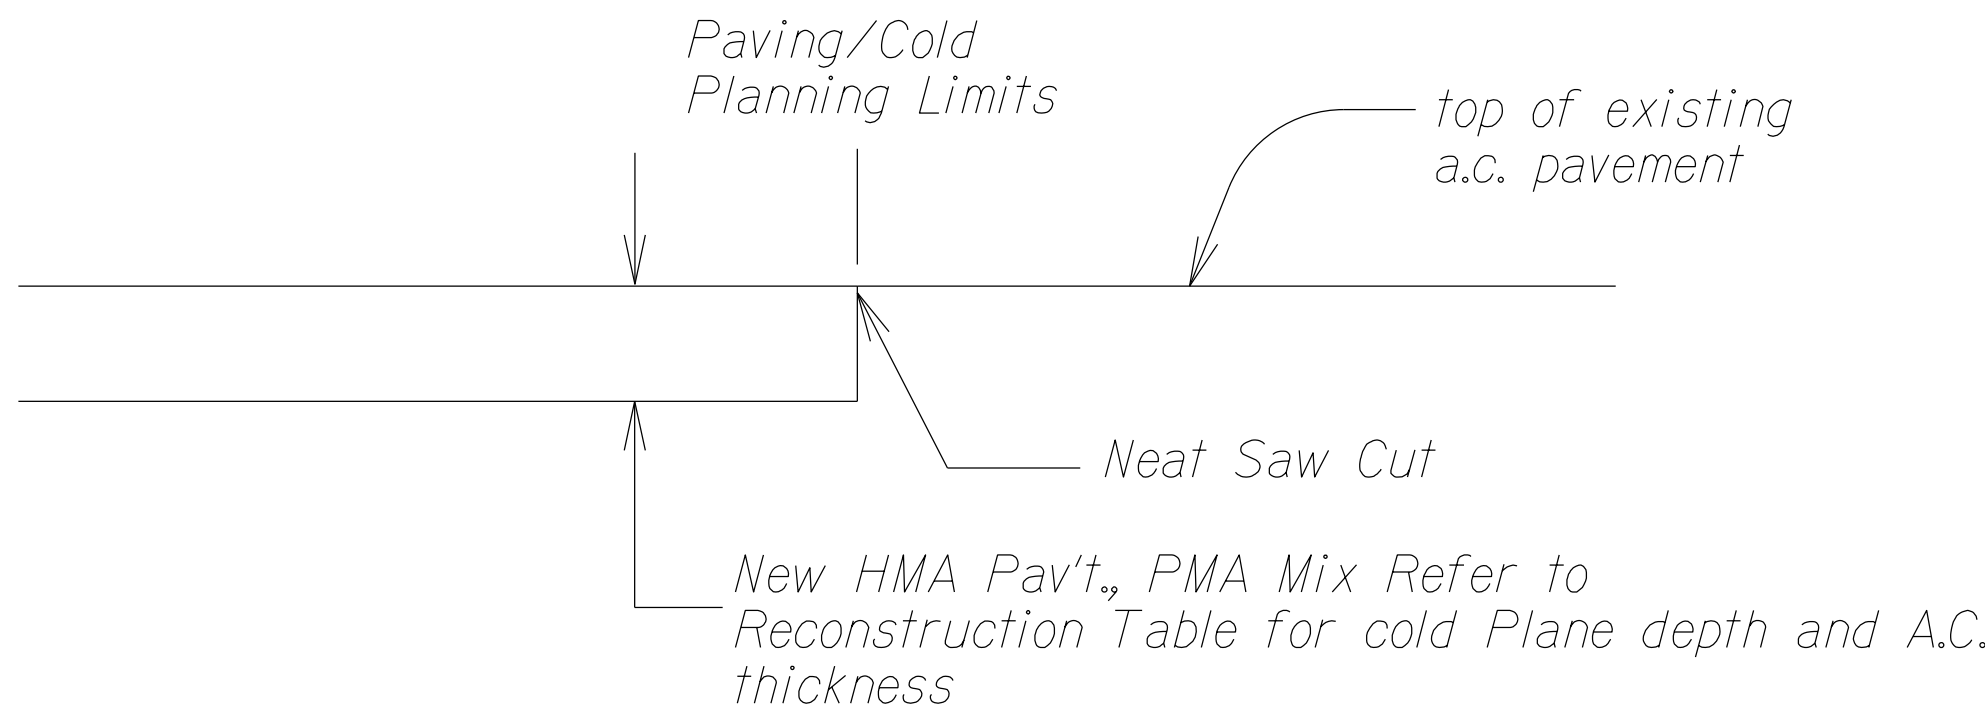

SMOOTH RIDING CONNECTION DETAIL AT
PAVING/COLD PLANING LIMITS. (RECONSTRUCTION AREAS)
Scale: N.T.S.

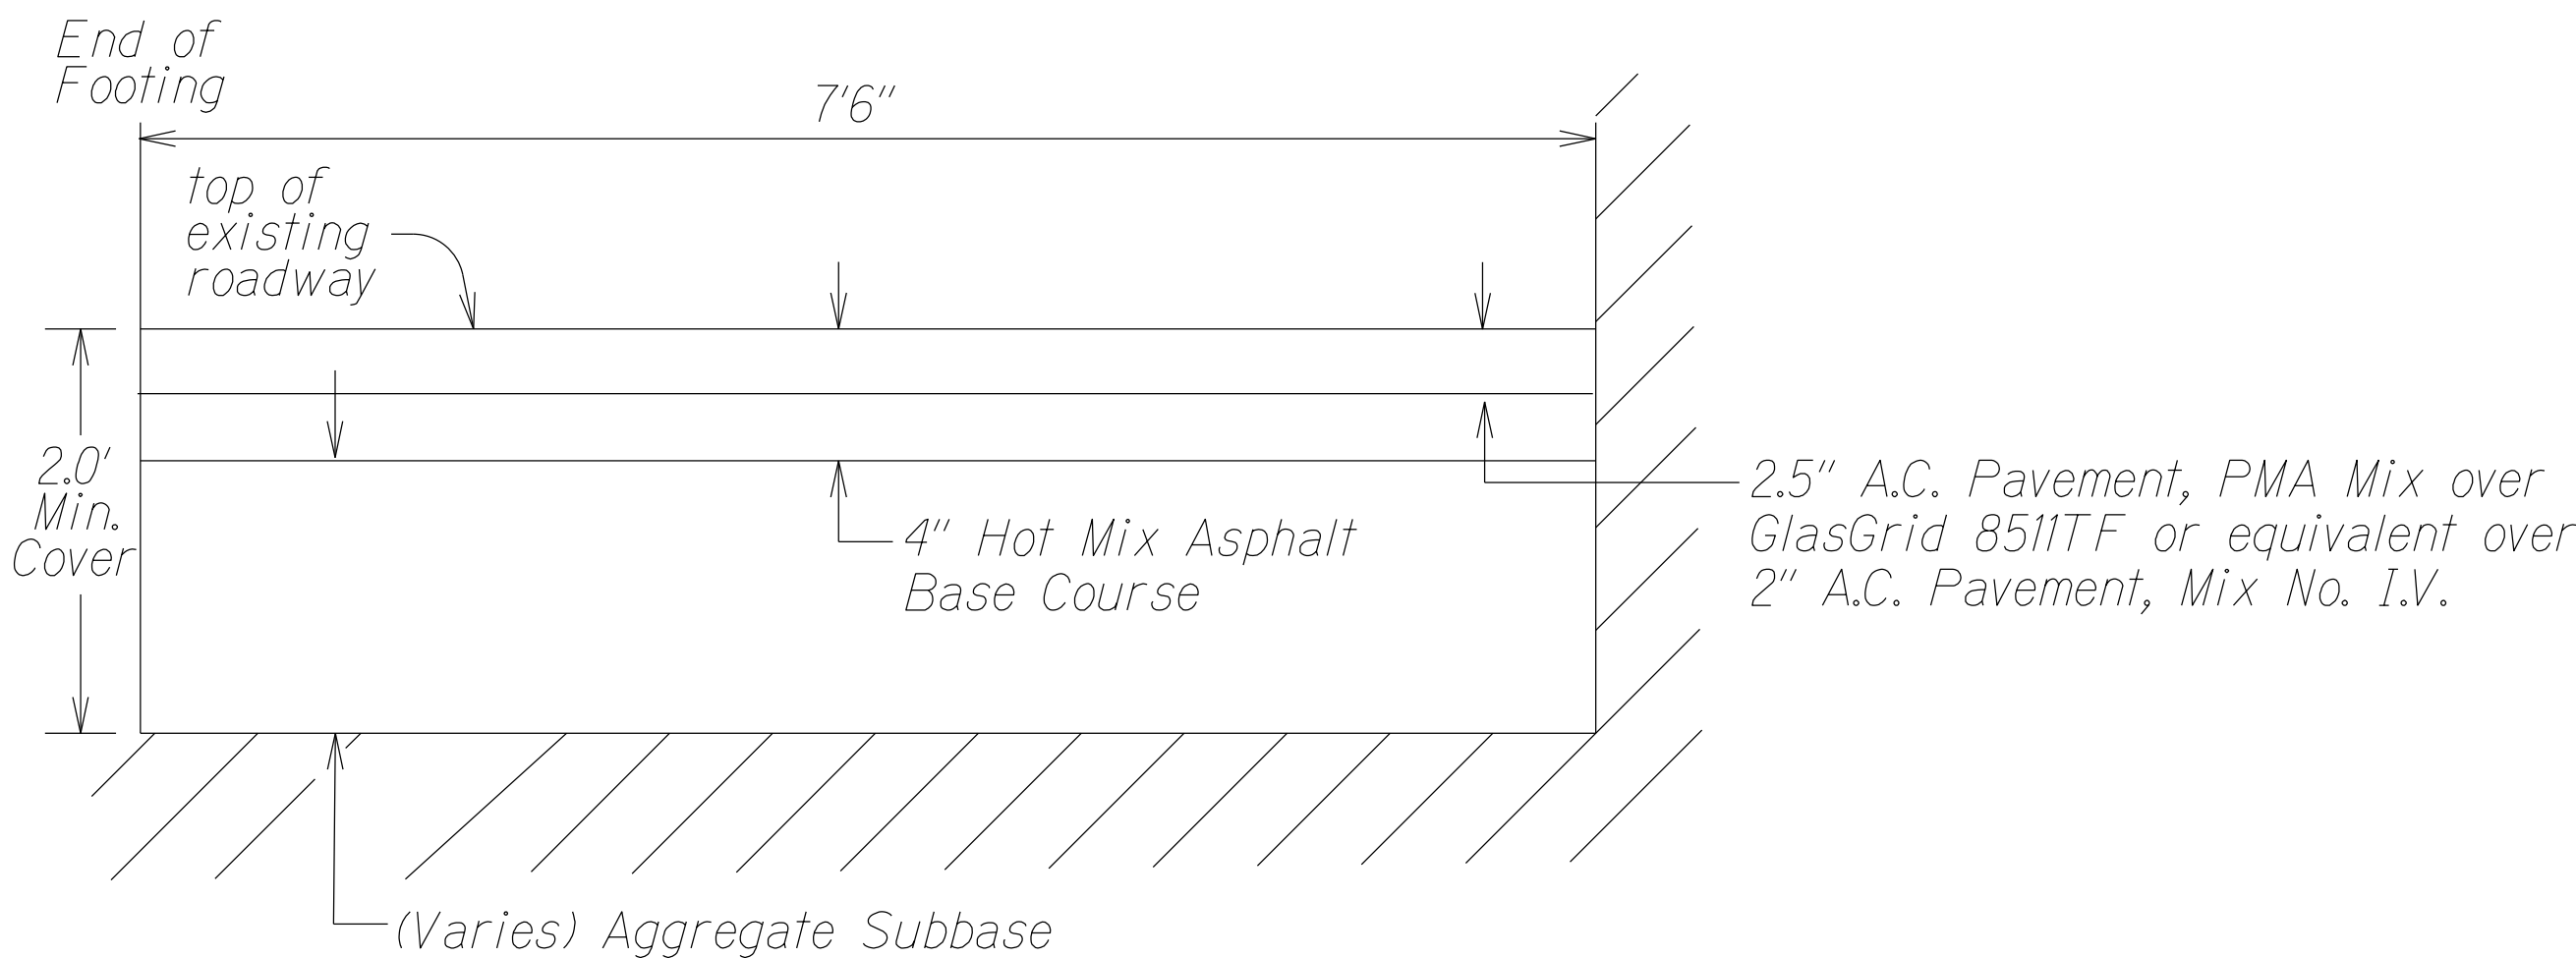

DETAIL OF PAVEMENT SECTION ABOVE CONCRETE FOOTING
FOR CULVERT AT # STA. 337+98.50
Scale: N.T.S.

Reconstruction Table

Cold Plane Depth	6.5"
Paving Thickness	2"
Paving Grid	Glas Grid 8511TF
Paving Thickness	2"
Paving Grid	Glas Grid 8511TF
Paving Thickness	2.5"


- Notes:
- Refer to Bridge Plan Sheets Q4 - Q6 for Culvert and Footing Details.
 - Pavement Section Length is 36 L.F. as Shown on Plan Sheet Q4 (Total Length of Concrete Footing).

DATE	DATE
DESIGNED BY	DESIGNED BY
TRACED BY	TRACED BY
NOTE BOOK	NOTE BOOK
QUANTITIES BY	QUANTITIES BY
CHECKED BY	CHECKED BY
N.	N.

05/25/2021	Revised All Details
DATE	REVISION
STATE OF HAWAII DEPARTMENT OF TRANSPORTATION HIGHWAYS DIVISION	
DETAILS	
KAMEHAMEHA HIGHWAY REHABILITATION Vicinity of Kapuhi Street to Dairy Road Federal Aid Project No. NH-083-1(77)	
Scale: NTS	Date: June 2020
SHEET No. 3 OF 3 SHEETS	

FED. ROAD DIST. NO.	STATE	FED. AID PROJ. NO.	FISCAL YEAR	SHEET NO.	TOTAL SHEETS
HAWAII	HAW.	NH-083-1(77)	2021	22	87

Sta. 202+31.22± to # Sta. 203+81.65± Lt.
Do Not Remove Guardrail before HECO Utility Poles
Located at # Sta. 203.07 to # Sta. 204+65.
Use Obstruction Installation for Power Poles.

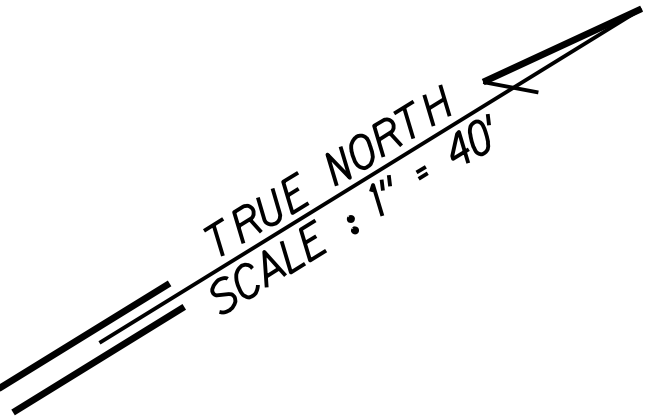


Sta. 202+31.22± to # Sta. 203+81.65± Lt.
Transition Existing W-Beam to Strong
Post Thrie Beam Guardrail. Install MSKT-SP TL-2
or Equivalent (1 Ea.) at Trailing End.


Sta. 203+6.65± to # Sta. 204+56.65± Lt.
Transition Existing W-Beam to Strong Post
Thrie Beam. Install 100.00 L.F. Strong Post
Thrie Beam Guardrail (8' Posts) and
Transition from Strong Post Thrie Beam
to Existing W-Beam

Sta. 204+69.15± to # Sta. 205+81.65± Lt.
Transition Existing W-Beam to Strong Post
W-Beam Guardrail. Install 25 L.F. Strong
Post W-Beam Guardrail. Install 37.5 L.F.
Nested Long Span Strong Post
W-Beam Guardrail over 18'-9" Obstacle.
Install 25 L.F. Strong Post W-Beam Guardrail.
Install MSKT-SP TL-2 or Equivalent
(1 Ea.) at Approach End.



Sta. 202+67± to # Sta. 205+42± Lt.
Remove Existing Guardrail with Rubrail except
where noted on plans.

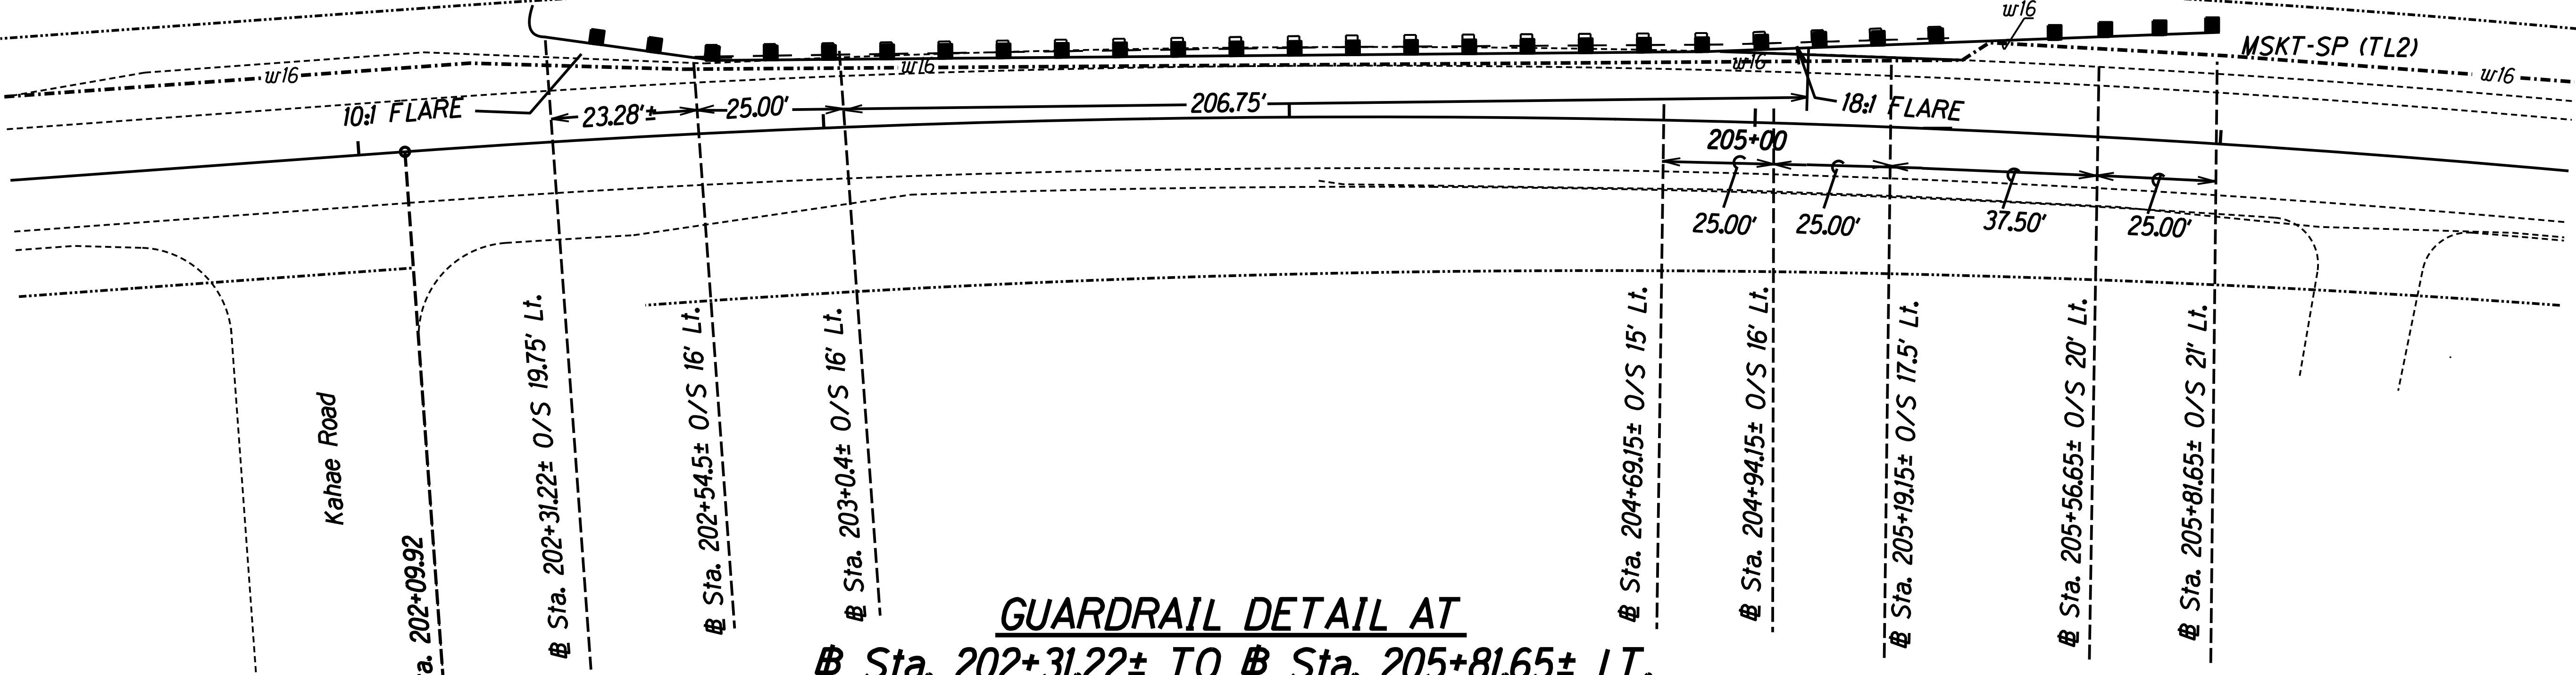

GUARDRAIL DETAIL AT
Sta. 202+31.22± TO # Sta. 205+81.65± LT.
Scale: Not to Scale

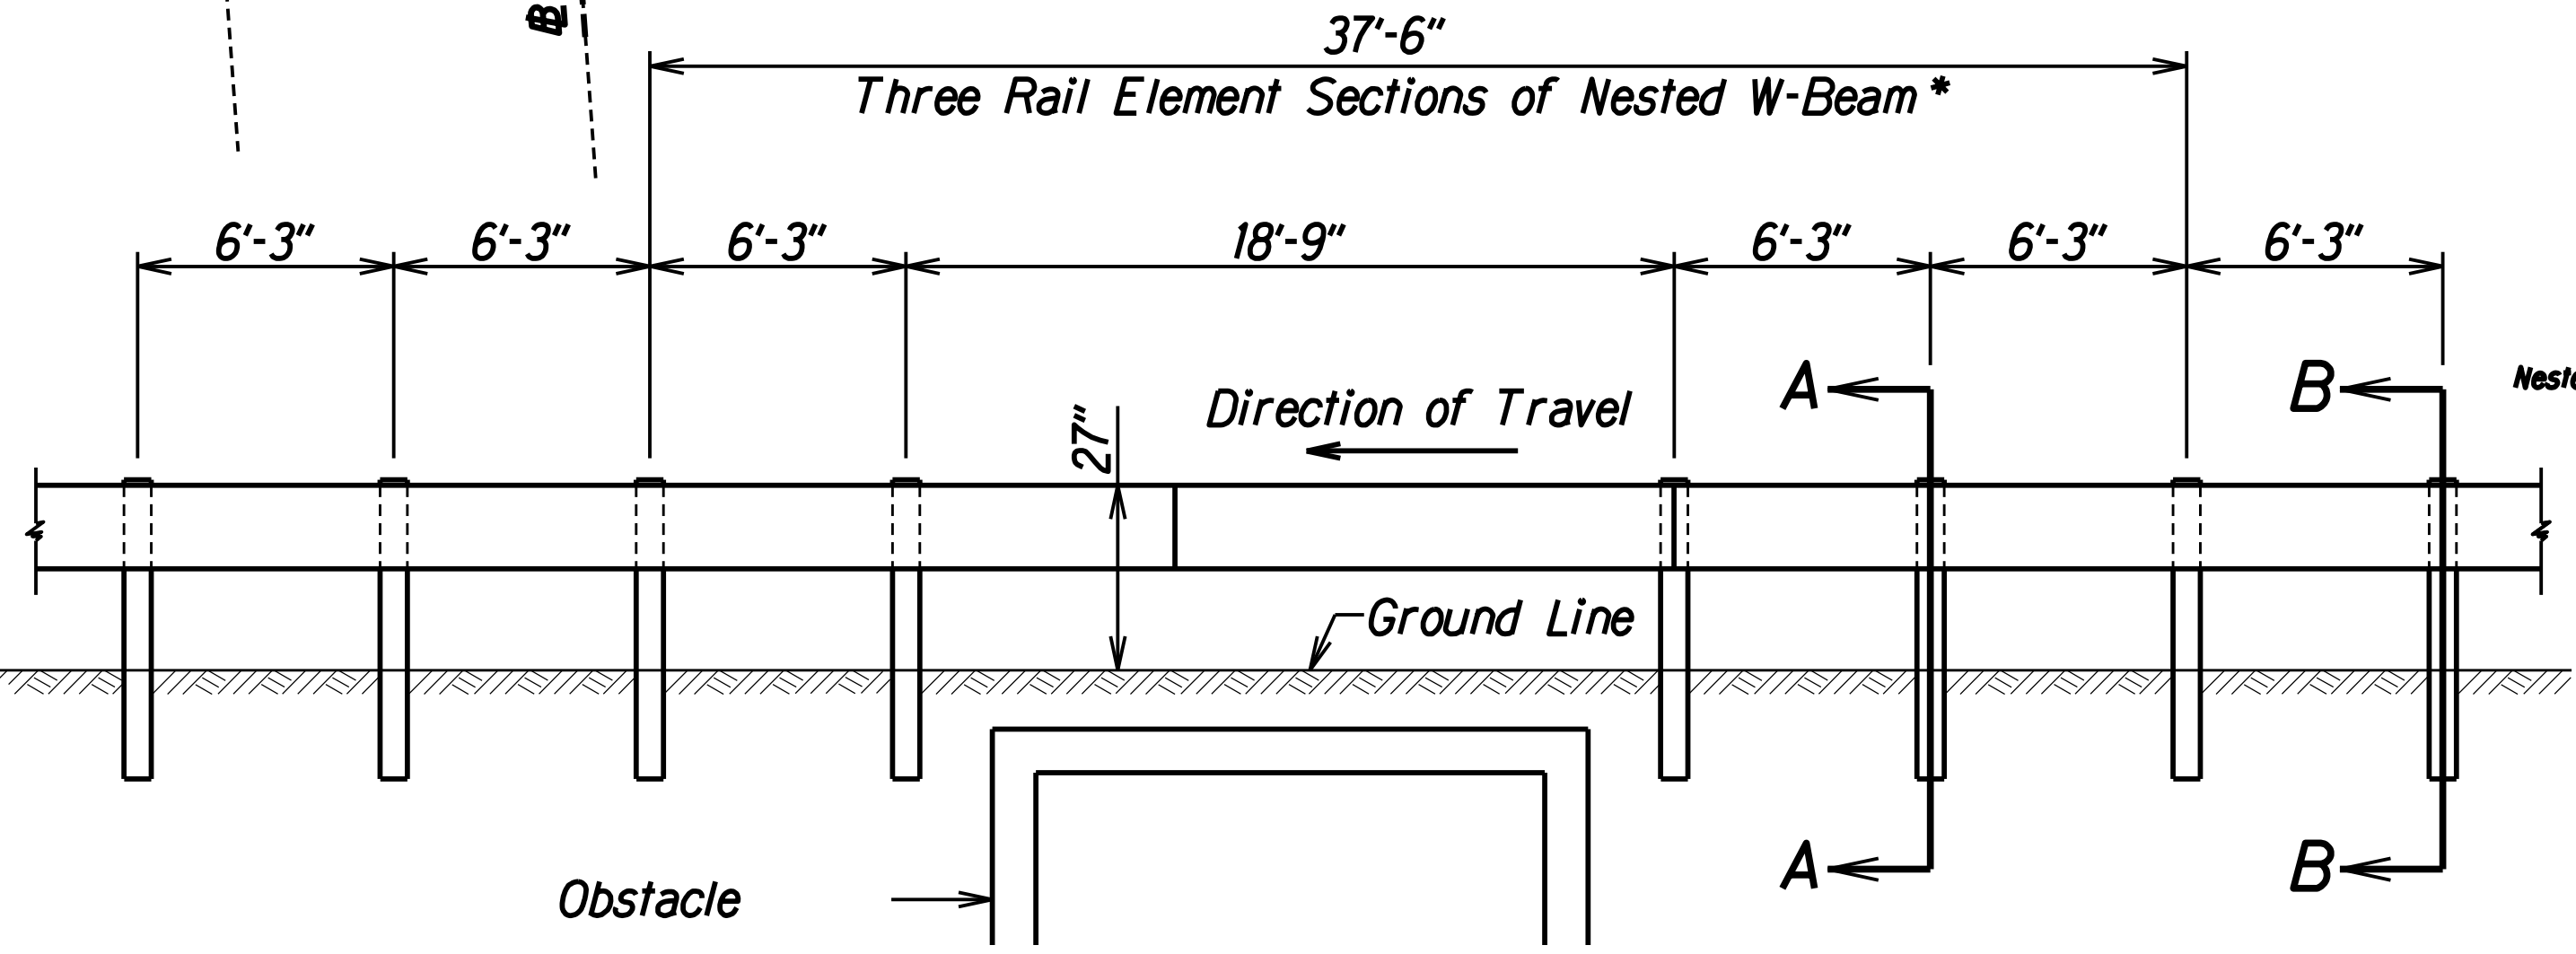

NESTED LONG SPAN STRONG POST
W-BEAM GUARDRAIL OVER 18'-9" OBSTACLE
Scale: N.T.S.

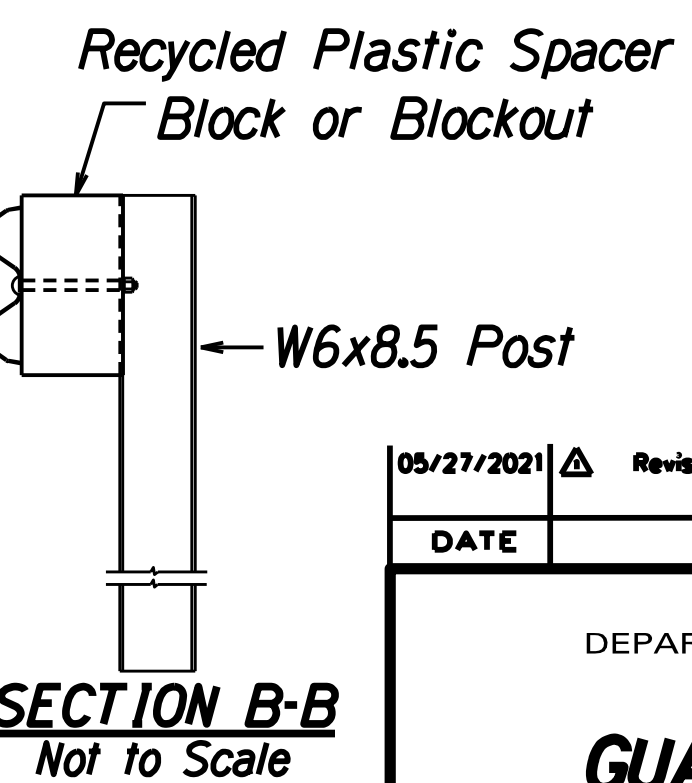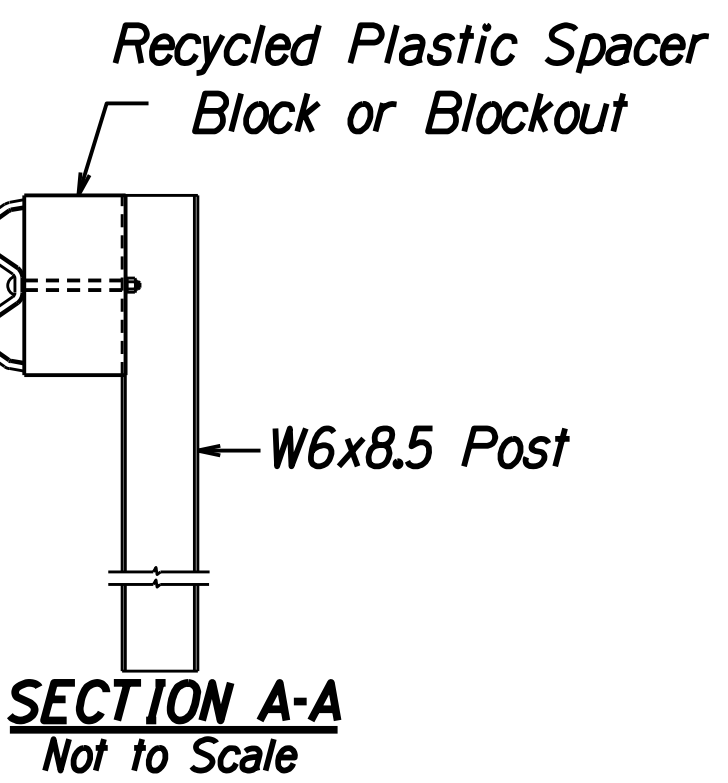

NOTE: All Rail Elements Sections are 12'-6"
and All Posts are 6' Long
All nested W-Beam splice points shall be staggered.

DATE	9/7/09
DESIGNED BY	
TRACED BY	
NOTED BY	
QUANTITIES BY	
CHECKED BY	

05/27/2021	Revised Sheet
DATE	REVISION
	STATE OF HAWAII DEPARTMENT OF TRANSPORTATION HIGHWAYS DIVISION
	GUARDRAIL DETAIL
	KAMEHAMEHA HIGHWAY REHABILITATION
	Vicinity of Kapuhi Street to Dairy Road
	Federal Aid Project No. NH-083-1(77)
	Scale: 1" = 20' Date: June, 2020
	SHEET No. 11 OF 11 SHEETS


FED. ROAD DIST. NO.	STATE	FED. AID PROJ. NO.	FISCAL YEAR	SHEET NO.	TOTAL SHEETS
HAWAII	HAW.	NH-083-1(77)	2021	23	87

Reconstruction Area Schedule (Westbound Lanes)


Station		Apx. Offset from BL to Center of Reconstruction Area (L.F.)		Length (L.F.)	Width (L.F.)	Approximate Area (S.F.)
From	To	Left	Right			
144+00	144+65	2.75		65	5.5	357.50
144+65	145+50	5.50		85	11	935
148+40	148+50	8.25		40	5	200
282+60	282+90	5.50		30	11	330
283+90	284+10	5.50		20	11	220
291+60	293+90	8.25		230	5.5	1265
296+60	297+00	2.75		40	5.5	220
297+40	297+80	7.25		40	5.5	220
297+80	299+00	5.50		120	11	1320
300+50	301+50	2.75		100	5.5	550
302+45	302+60	2.75		15	5.5	82.50
304+30	304+50	2.75		20	5.5	110
304+85	305+00	5.50		15	11	165
305+70	305+90	8.25		20	5.5	110
306+20	306+60	2.75		40	5.5	220
308+60	308+90	2.75		30	5.5	165
309+50	310+25	5.50		75	11	825
310+25	310+40	2.75		15	5.5	82.50
					Total	6996

Station		Apx. Offset from BL to Center of Reconstruction Area (L.F.)		Length (L.F.)	Width (L.F.)	Approximate Area (S.F.)
From	To	Left	Right			
311+00	311+15	7.25		15	5.5	82.50
311+97	312+17	2.75		20	5.5	110
312+17	312+52	5.50		35	11	385
313+50	314+40	8.25		90	5.5	495
314+40	314+70	5.50		30	11	330
314+70	315+20	8.25		50	5.5	275
316+90	317+50	2.75		60	5.5	330
318+30	318+50	8.25		20	5.5	110
319+00	319+20	5.50		15	11	165
319+70	320+45	2.75		75	5.5	412.50
320+75	321+15	2.75		40	5.5	220
321+40	322+60	5.50		120	11	1320
324+00	324+50	5.50		50	11	550
328+85	329+20	5.50		35	11	385
338+35	340+10	5.50		175	11	1925
341+10	341+30	2.75		20	5.5	110
341+45	341+85	5.50		40	11	440
Total						15,022.50

ORIGINAL PLAN	SURVEY PLOTTED BY _____		DATE _____
	DRAWN BY _____		_____
NOTE BOOK	TRACED BY _____		_____
	DESIGNED BY _____		_____
	QUANTITIES BY _____		_____
N _o _____	CHECKED BY _____		_____

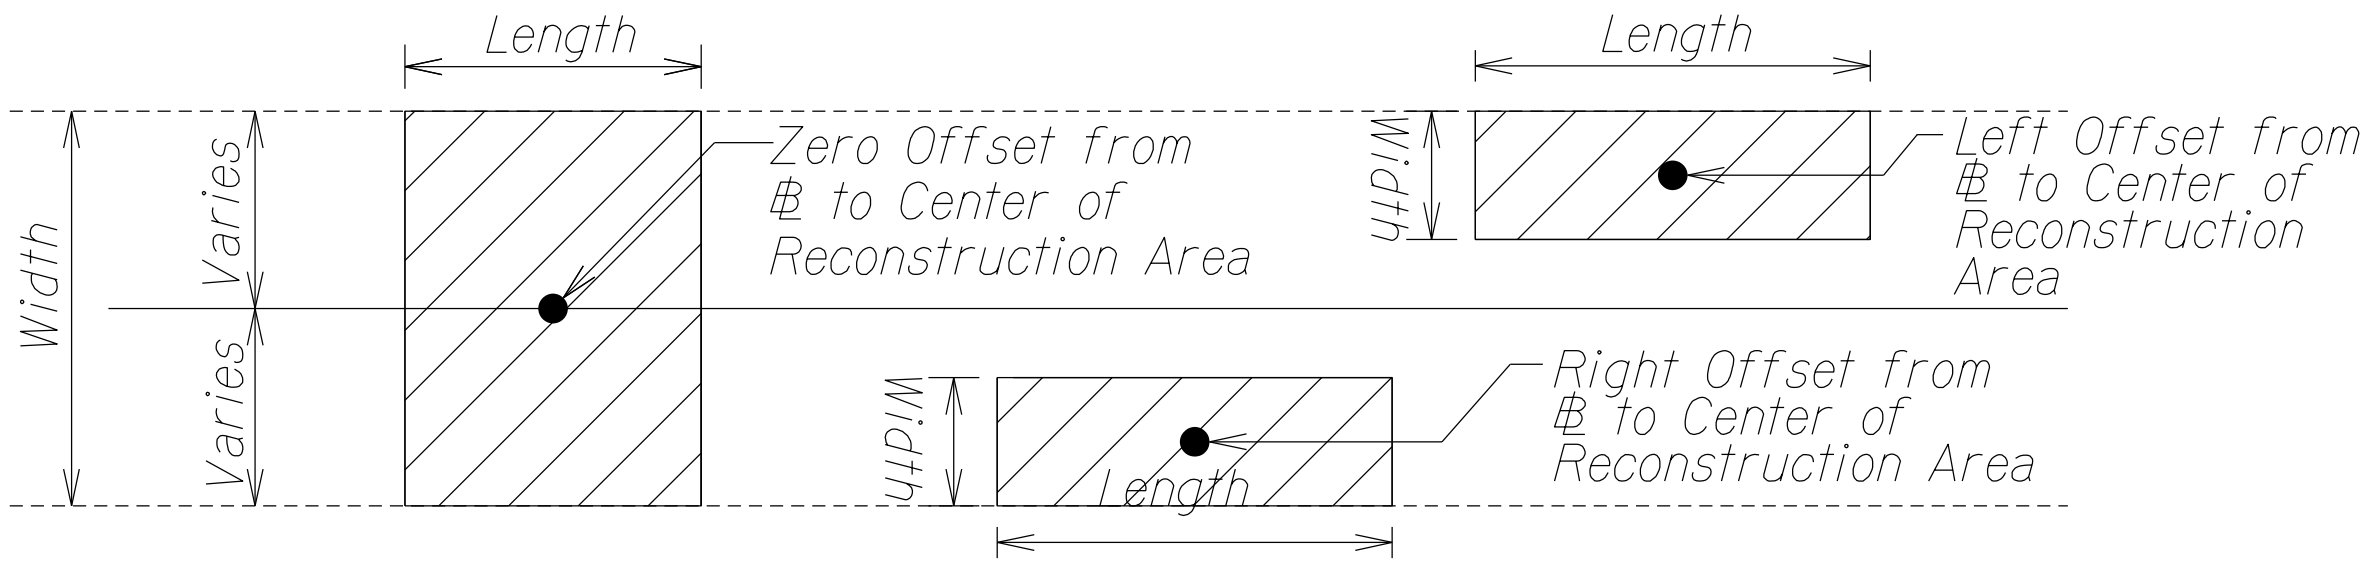

LOCATION OF WEAKENED PAVEMENT DETAIL
Not to Scale

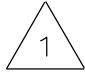05/27/2021	Revised Schedule
DATE	REVISION
<p>STATE OF HAWAII DEPARTMENT OF TRANSPORTATION HIGHWAYS DIVISION</p>	
	
<h1>RECONSTRUCTION AREA SCHEDULE</h1>	
<p><u>KAMEHAMEHA HIGHWAY REHABILITATION</u> <u>Vicinity of Kapuhi Street to Dairy Road</u> <u>Federal Aid Project No. NH-083-1(77)</u></p>	
<p>Date: June, 2020</p>	

ORIGINAL PLAN	DATE	SURVEY PLOTTED BY	_____
		DRAWN BY	_____
		TRACED BY	_____
		DESIGNED BY	_____
NOTE BOOK	N.	QUANTITIES BY	_____
		CHECKED BY	_____



Reconstruction Area Schedule (Eastbound Lanes)						
Station		Apx. Offset from BL to Center of Reconstruction Area (L.F.)		Length (L.F.)	Width (L.F.)	Approximate Area (S.F.)
From	To	Left	Right			
144+00	144+65		2.75	85	5.5	467.50
144+65	145+50		2.75	65	5.5	357.50
148+10	150+80		5	270	10	2700
163+90	164+10		8.50	20	5	100
166+10	166+35		8.50	25	5	125
167+20	168+40		13	120	6	720
167+50	167+75		5	25	10	250
168+60	169+30		8.50	70	5	350
173+05	173+45		8.50	40	5	200
178+00	178+50		11.50	50	6	300
178+00	178+70		3	70	5	350
185+75	186+40		8.50	65	5	325
187+00	188+15		8.50	115	5	575
189+80	190+90		5	110	10	1100
193+38	193+78		12	40	24	960
196+35	197+10		5	75	10	750
197+10	197+90		7.50	80	5	400
198+40	200+15		8.50	175	5	875
201+56	202+06		18	50	14	700
203+30	203+75		8.50	45	5	225
208+80	209+00		8.50	20	5	100
210+35	210+50		8.50	15	5	75
282+60	282+90		5.50	30	11	330
282+90	283+90		6.25	100	5.5	550
283+90	284+10		5.50	20	11	220
284+10	284+70		7.75	60	5.5	330
289+40	289+90		8.25	50	5.5	275
304+85	305+00		0	15	22	330

FED. ROAD DIST. NO.	STATE	FED. AID PROJ. NO.	FISCAL YEAR	SHEET NO.	TOTAL SHEETS
HAWAII	HAW.	NH-083-1(77)	2021	24	87

Station		Apx. Offset from BL to Center of Reconstruction Area (L.F.)		Length (L.F.)	Width (L.F.)	Approximate Area (S.F.)
From	To	Left	Right			
305+30	305+70		8.25	40	5.5	220
306+20	306+60		2.75	40	5.5	220
308+60	308+90		2.75	30	5.5	165
309+30	309+60		2.75	30	5.5	165
311+97	312+17		2.75	20	5.5	110
313+30	313+50		8.25	20	5.5	110
314+40	314+55		8.25	15	5.5	82.50
316+90	317+50		2.75	60	5.5	330
318+35	318+55		8.25	20	5.5	110
318+92	319+07		8.25	20	5.5	110
319+70	320+45		2.75	75	5.5	412.50
320+75	321+15		2.75	40	5.5	220
321+25	321+40		8	15	6	90
325+30	325+80		8.25	50	5.5	275
327+00	327+15		8.25	15	5.5	82.50
327+50	327+75		2.75	25	5.5	137.50
328+05	328+40		8.25	35	5.5	192.50
328+85	329+20		5.5	35	11	385
338+75	338+89		5.5	14	11	154
339+49	339+65		5.5	16	11	176
340+55	340+75		8.25	20	5.5	110
341+10	341+30		5.5	20	11	220
					Total	17,947.50

05/27/2021	Revised Schedule
DATE	REVISION
STATE OF HAWAII DEPARTMENT OF TRANSPORTATION HIGHWAYS DIVISION	
RECONSTRUCTION AREA SCHEDULE	
KAMEHAMEHA HIGHWAY REHABILITATION Vicinity of Kapuhi Street to Dairy Road Federal Aid Project No. NH-083-1(77)	
Date: June, 2020	

FED. ROAD DIST. NO.	STATE	FED. AID PROJ. NO.	FISCAL YEAR	SHEET NO.	TOTAL SHEETS
HAWAII	HAW.	NH-083-1(77)	2021	27	87

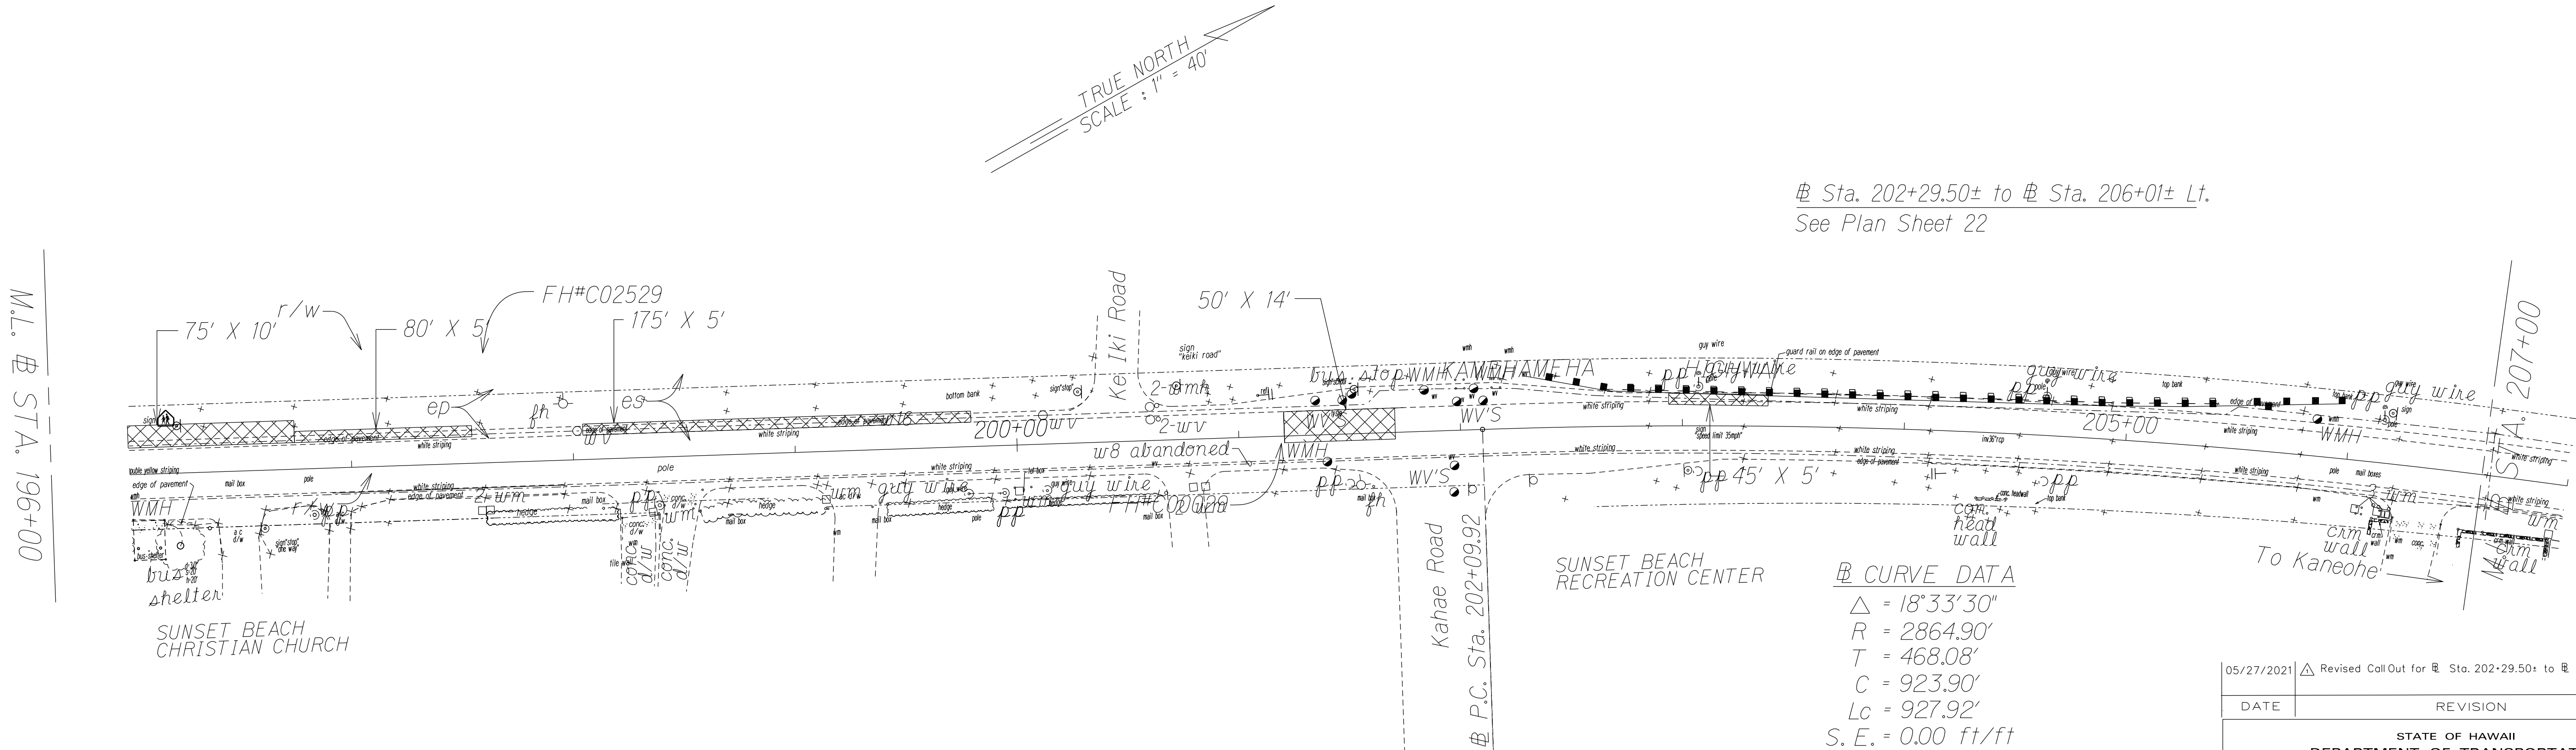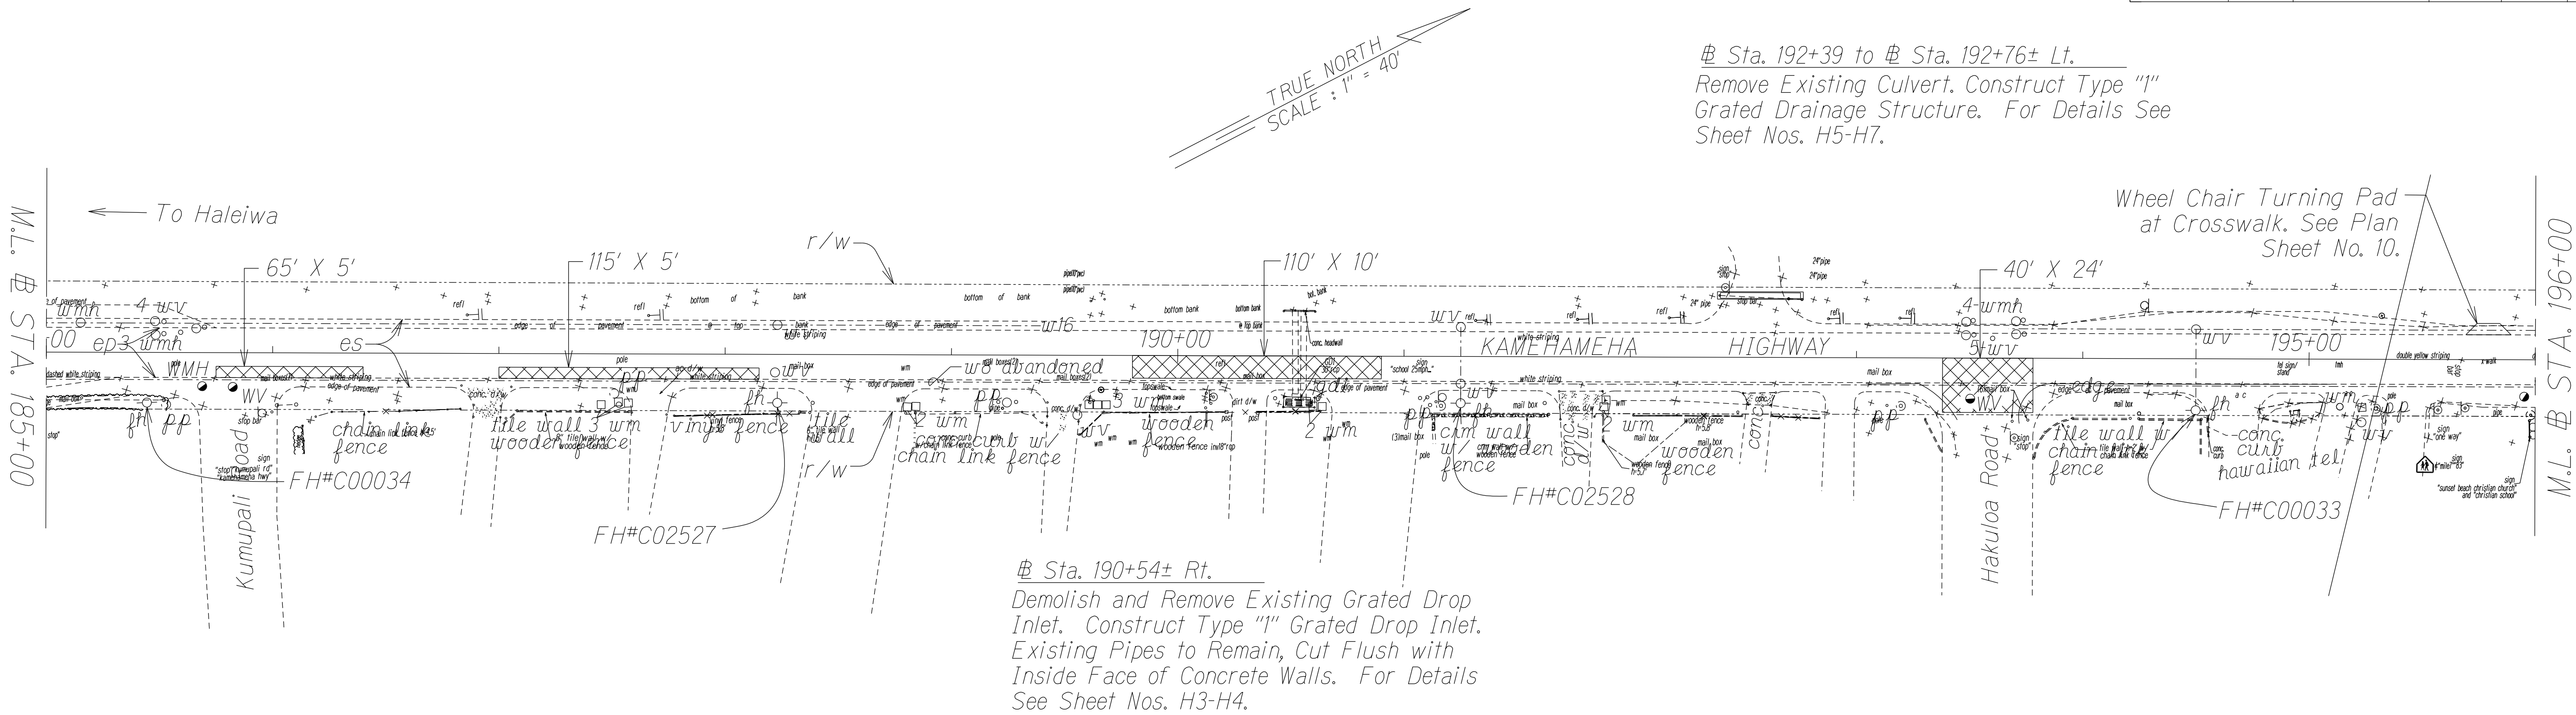

DATE	SURVEY PLOTTED BY
	DESIGNED BY
	TRACED BY
	NOTE BOOK
	QUANTITIES BY
	CHECKED BY
	N.

05/27/2021 | Δ Revised Call Out for Ⓜ Sta. 202+29.50± to Ⓜ Sta. 206+01± Lt.

DATE REVISION

STATE OF HAWAII
DEPARTMENT OF TRANSPORTATION
HIGHWAYS DIVISION

ROADWAY PLANS

KAMEHAMEHA HIGHWAY REHABILITATION

Vicinity of Kapuhi Street to Dairy Road



Federal-Aid Project No. NH-083-1(77)

Scale: 1" = 40' Date: June, 2020

SHEET No. 3 OF 10 SHEETS

ADD. 4 27

FED. ROAD DIST. NO.	STATE	FED. AID PROJ. NO.	FISCAL YEAR	SHEET NO.	TOTAL SHEETS
HAWAII	HAW.	NH-083-1(77)	2021	28	87

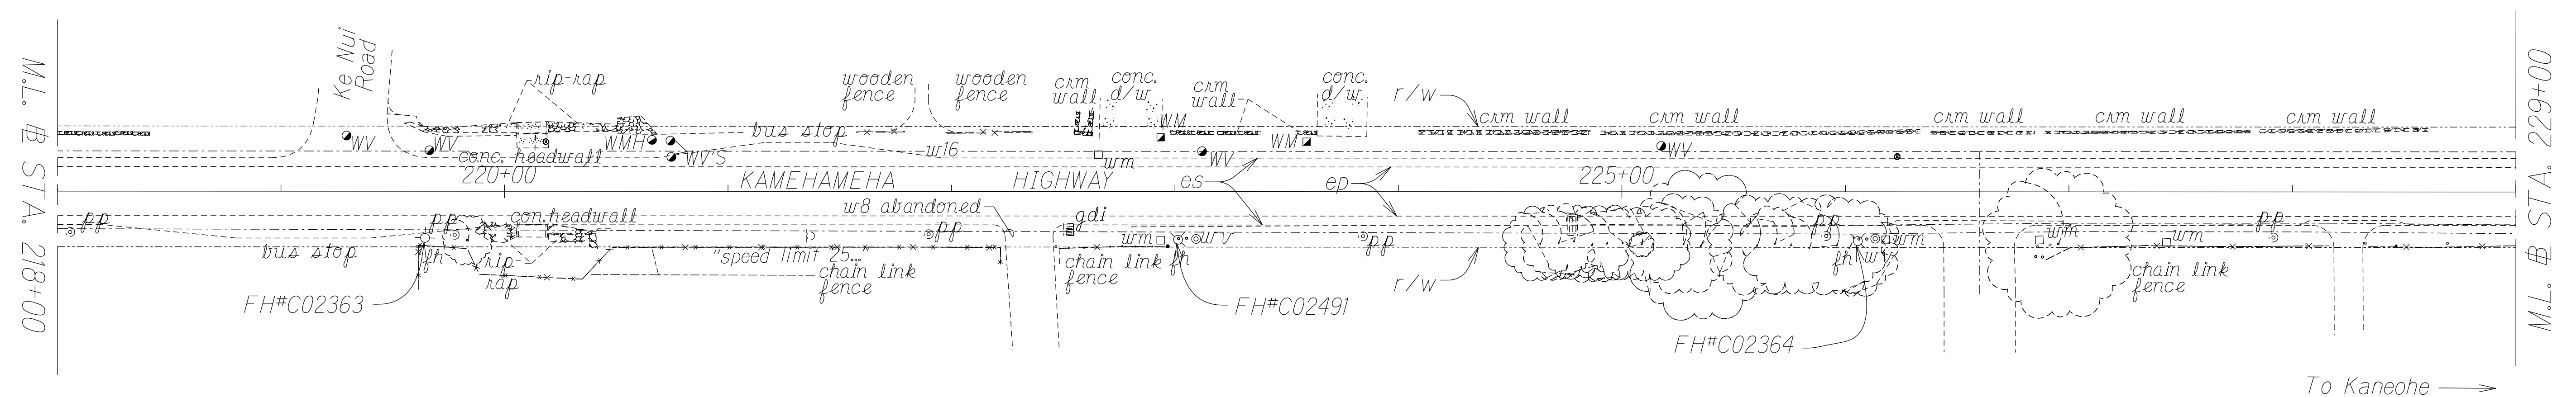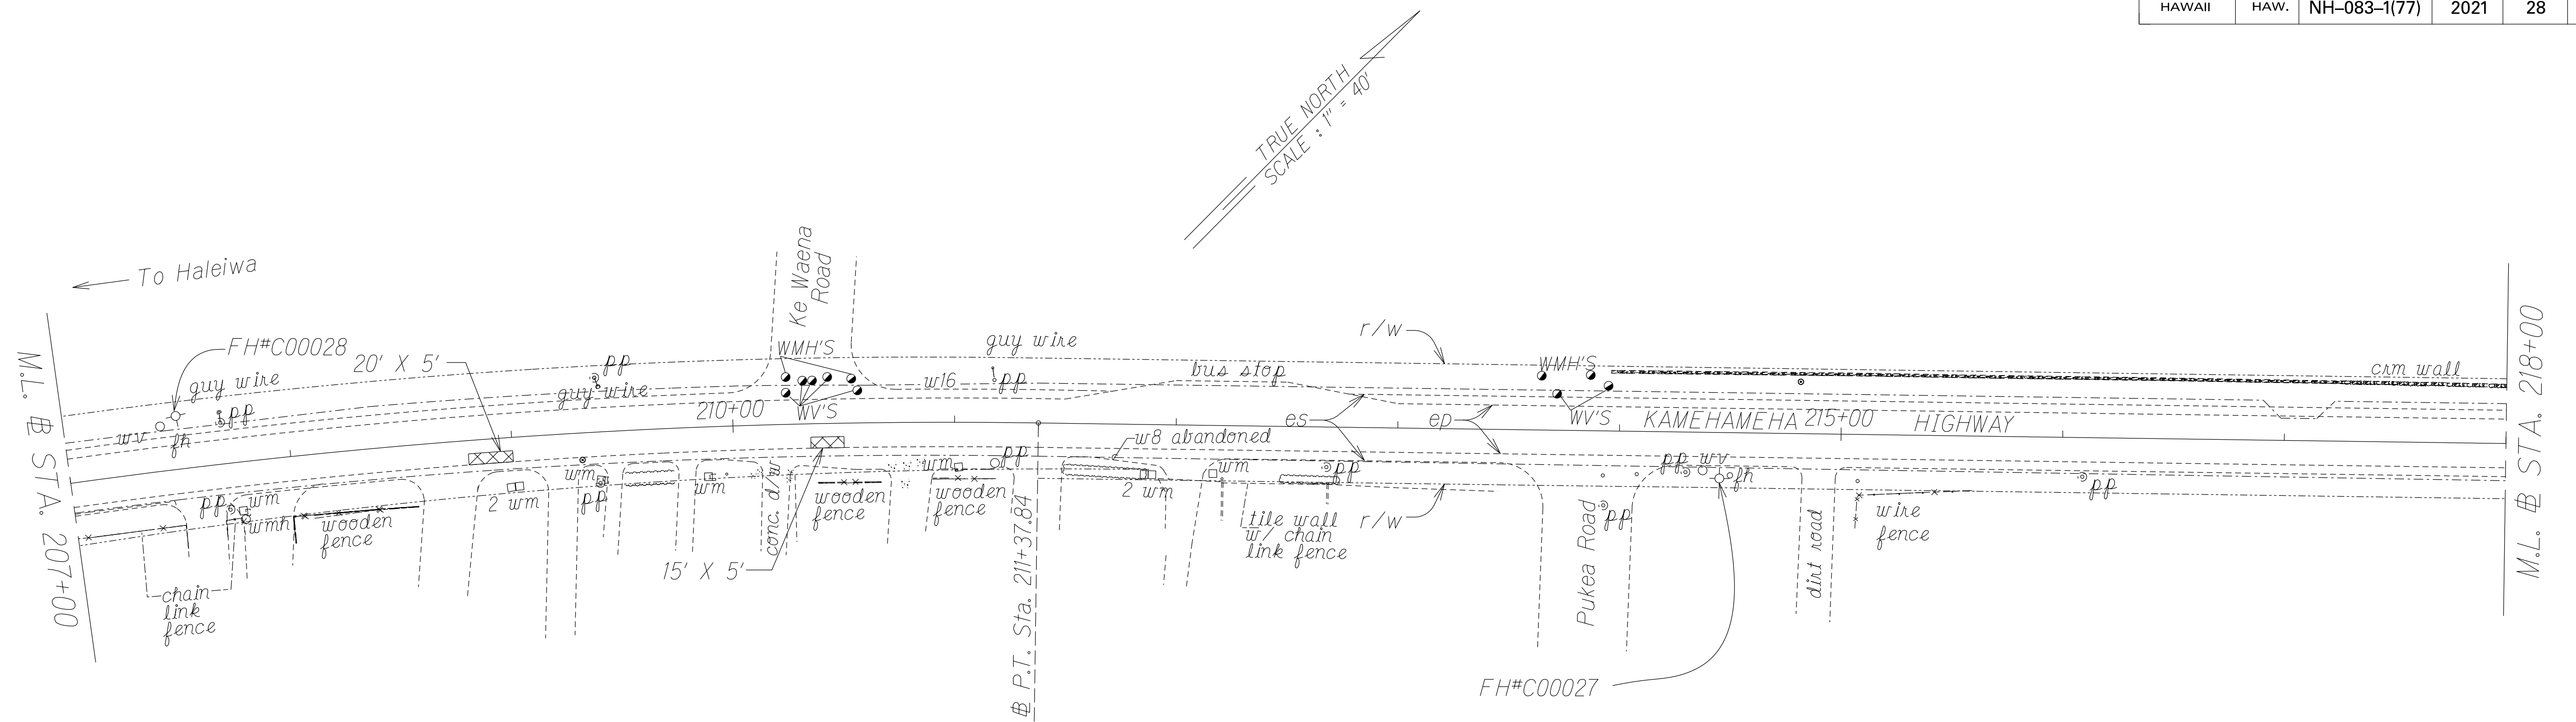

ORIGINAL PLAN	SURVEY PLOTTED BY _____	DATE _____
NOTE BOOK	DRAWN BY _____	_____
	DESIGNED BY _____	_____
	QUANTITIES BY _____	_____
	CHECKED BY _____	_____
No. _____		

Approved:

Manager and Chief Engineer, BWS
(For Work Affecting BWS Facilities
in City/State R/W and BWS Easement Only)

Date _____

05/25/2021	A Removed reference to Metal Railings
DATE	REVISION

STATE OF HAWAII

DEPARTMENT OF TRANSPORTATION A

HIGHWAYS DIVISION

ROADWAY PLANS

KAMEHAMEHA HIGHWAY REHABILITATION

Vicinity of Kapuhi Street to Dairy Road

Federal-Aid Project No. NH-083-1(77)

Scale: 1" = 40'

Date: June, 2020


SHEET No. 4 OF 10 SHEETS

FED. ROAD DIST. NO.	STATE	FED. AID PROJ. NO.	FISCAL YEAR	SHEET NO.	TOTAL SHEETS
HAWAII	HAW.	NH-083-1(77)	2021	33	87

± Sta. 317+57± to ± Sta. 318+51± o/s 15.0'± Lt.

Retain Existing Thrie Beam (25.00 L.F.). Remove Existing Guardrails and Transition at Trailing End (68.75 L.F.). Transition from Existing Guardrail (6.25 L.F.) to Strong Post W-Beam. Install 6.25 L.F. of Strong Post W-Beam. Install 37.5 L.F. of Nested Long Span Strong Post W-Beam. Install 6.25 L.F. of Strong Post W-Beam. Install QuadGuard QG28024 with anchor block or Equivalent on Trailing End (1 Ea.).

± Sta. 316+58± to ± Sta. 318+04± o/s 16.0'± Lt.
Install 146.00 L.F. New 8.0' - 10.0' HMA Sidewalk.

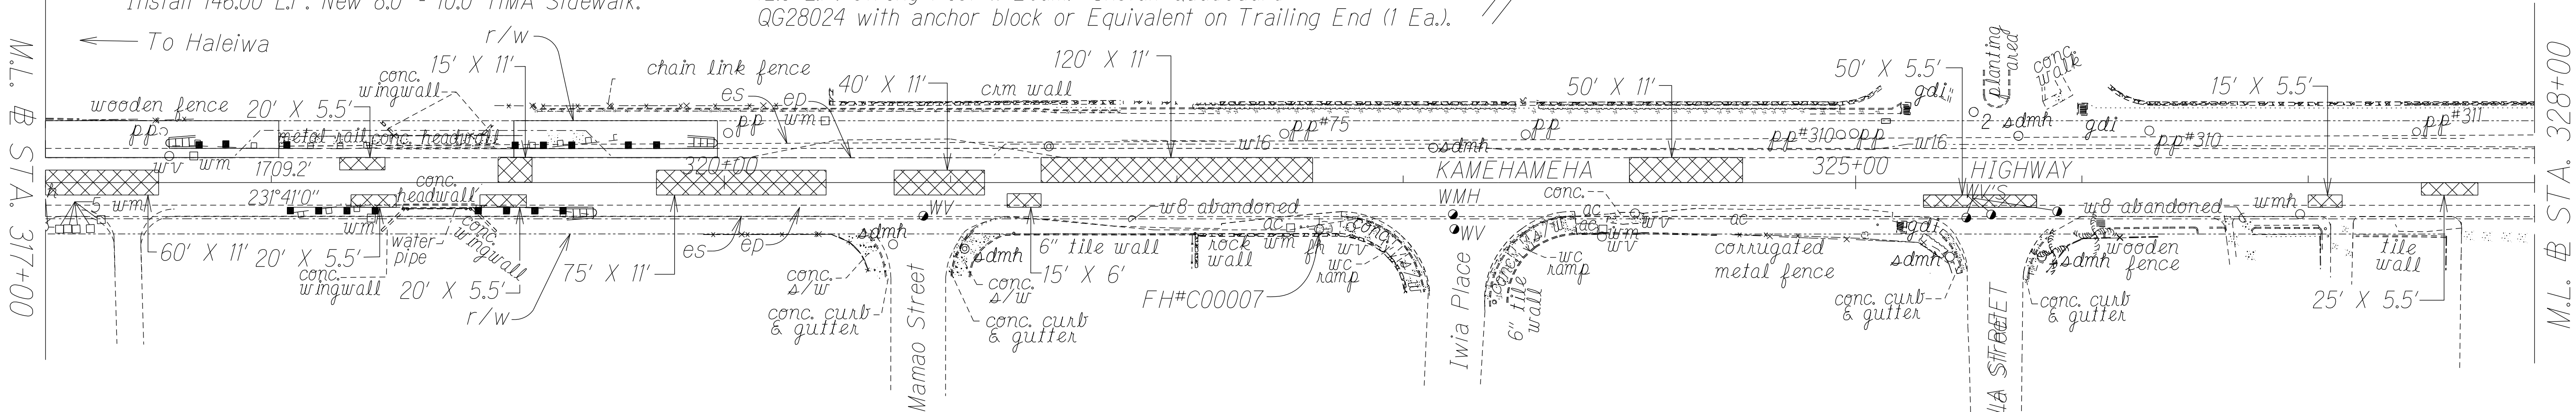

± Sta. 318+07 ± to ± Sta. 318+57± o/s 10.0' Rt.

Retain Existing Thrie Beam (25.00 L.F.). Remove Existing Guardrail and Transition at Approaching End (25.00 L.F.). Transition from Existing Guardrail (6.25 L.F.) to 31" W-Beam with Standard 8" Offset Block. Install Trailing-End Anchorage System on Approach End (1 Ea.).

± Sta. 318+90± to ± Sta. 319+40± o/s 10.0' Rt.


Retain Existing Thrie Beam (25.00 L.F.). Remove Existing Guardrail and Transition at Trailing End (25.00 L.F.). Install 12.50 L.F. of Strong Post Thrie Beam. Install QuadGuard QG28024 with anchor block or Equivalent on Trailing Edge (1 Ea.).

± CURVE DATA

Δ = 7°51'00"
R = 5729.65'
T = 393.14'
C = 784.44'
Lc = 785.01'
S.E. = 0.00 ft/ft

± 337+2± to ± 339+20± o/s 20' Lt.

Remove 112.50 L.F. of Existing Guardrail. Demolish Existing Culvert Rail and Endposts. Install Modified Delaware Retrofit and 18'-9" L.F. Guardrail Type 3 Thrie Beam Transition on Both Ends. At Trailing End, Install 6.25 L.F. of 31" W-Beam with Standard 8" Offset Block (8' Posts) and MSKT-SP TL-2 or Equivalent (1 Ea.). At Approach End, Install 62.50 L.F. of Strong Post Thrie Beam (8' Posts) with 1' 6¾" Post Spacing. Transition to 6.25 L.F. of 31" W-Beam with 8" Standard Offset Block (8' Posts) and Install MSKT-SP TL-2 or Equivalent (1 Ea.). Refer to Sheet No. Q4 to Q5 for Bridge Details.

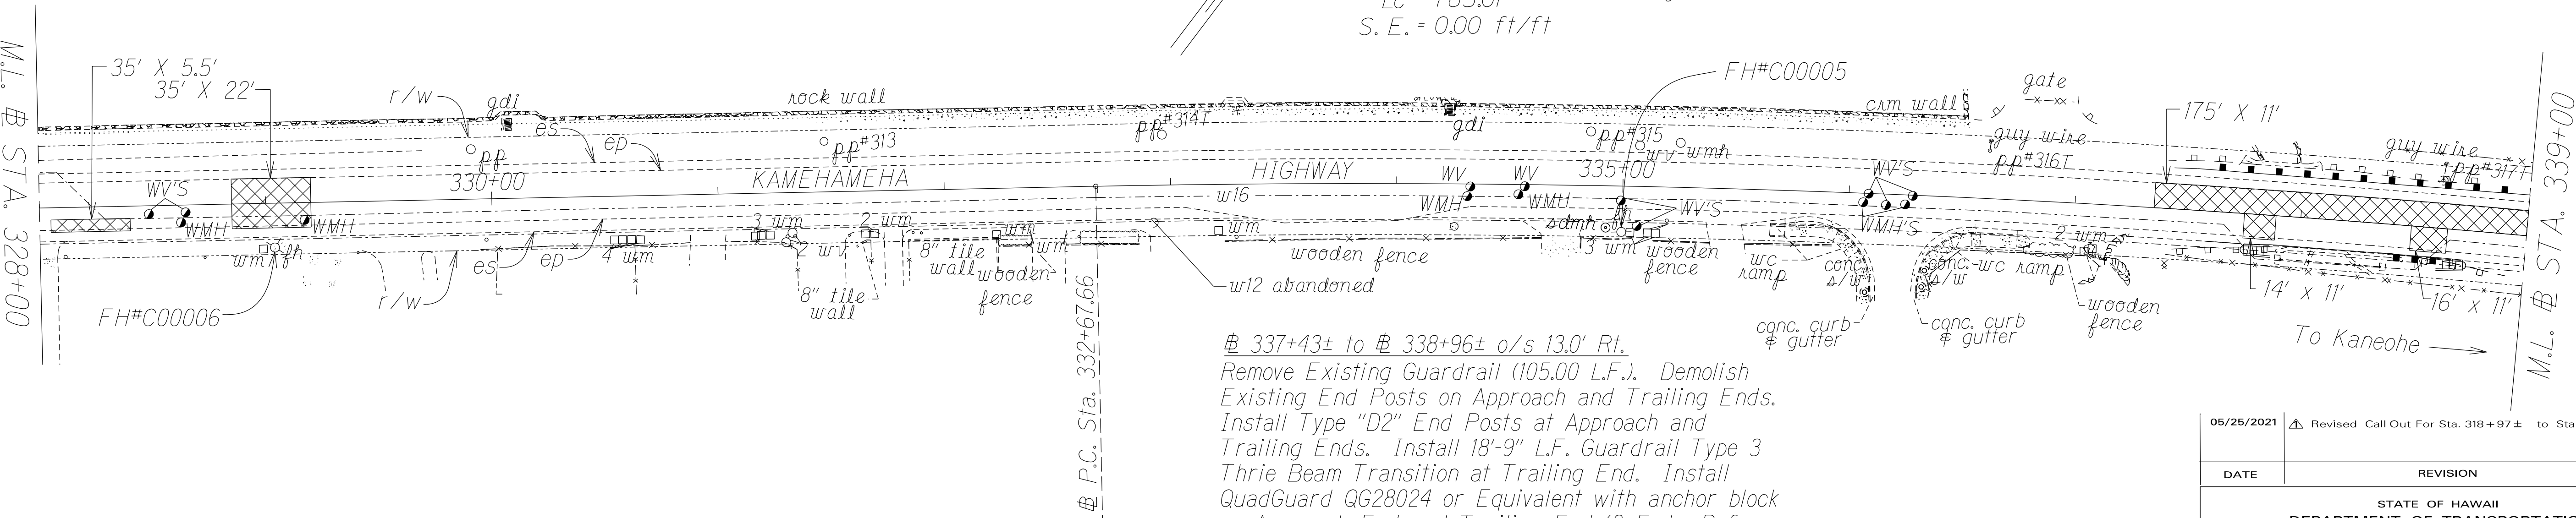

± 337+43± to ± 338+96± o/s 13.0' Rt.

Remove Existing Guardrail (105.00 L.F.). Demolish Existing End Posts on Approach and Trailing Ends. Install Type "D2" End Posts at Approach and Trailing Ends. Install 18'-9" L.F. Guardrail Type 3 Thrie Beam Transition at Trailing End. Install QuadGuard QG28024 or Equivalent with anchor block on Approach End and Trailing End (2 Ea.). Refer to Sheet No. Q4 to Q5 for Bridge Details.

Approved:

Manager and Chief Engineer, BWS
(For Work Affecting BWS Facilities
in City/State R/W and BWS Easement Only)

Date

05/25/2021 Δ Revised Call Out For Sta. 318+97± to Sta. 319+97±

DATE REVISION

STATE OF HAWAII
DEPARTMENT OF TRANSPORTATION
HIGHWAYS DIVISION

ROADWAY PLANS

KAMEHAMEHA HIGHWAY REHABILITATION
Vicinity of Kapuhi Street to Dairy Road
Federal-Aid Project No. NH-083-1(77)

Scale: 1" = 40' Date: June, 2020

SHEET No. 9 OF 10 SHEETS

ADD. 4 33

