


FED. ROAD DIST. NO.	STATE	FED. AID PROJ. NO.	FISCAL YEAR	SHEET NO.	TOTAL SHEETS
HAWAII	HAW.	NH-083-1(77)	2021	23	87

Reconstruction Area Schedule (Westbound Lanes)						
Station		Apx. Offset from BL to Center of Reconstruction Area (L.F.)		Length (L.F.)	Width (L.F.)	Approximate Area (S.F.)
From	To	Left	Right			
144+00	144+65	2.75		65	5.5	357.50
144+65	145+50	5.50		85	11	935
148+40	148+50	8.25		40	5	200
282+60	282+90	5.50		30	11	330
283+90	284+10	5.50		20	11	220
291+60	293+90	8.25		230	5.5	1265
296+60	297+00	2.75		40	5.5	220
297+40	297+80	7.25		40	5.5	220
297+80	299+00	5.50		120	11	1320
300+50	301+50	2.75		100	5.5	550
302+45	302+60	2.75		15	5.5	82.50
304+30	304+50	2.75		20	5.5	110
304+85	305+00	5.50		15	11	165
305+70	305+90	8.25		20	5.5	110
306+20	306+60	2.75		40	5.5	220
308+60	308+90	2.75		30	5.5	165
309+50	310+25	5.50		75	11	825
310+25	310+40	2.75		15	5.5	82.50
					Total	6996

Station		Apx. Offset from BL to Center of Reconstruction Area (L.F.)		Length (L.F.)	Width (L.F.)	Approximate Area (S.F.)
From	To	Left	Right			
311+00	311+15	7.25		15	5.5	82.50
311+97	312+17	2.75		20	5.5	110
312+17	312+52	5.50		35	11	385
313+50	314+40	8.25		90	5.5	495
314+40	314+70	5.50		30	11	330
314+70	315+20	8.25		50	5.5	275
316+90	317+50	2.75		60	5.5	330
318+30	318+50	8.25		20	5.5	110
319+00	319+20	5.50		15	11	165
319+70	320+45	2.75		75	5.5	412.50
320+75	321+15	2.75		40	5.5	220
321+40	322+60	5.50		120	11	1320
324+00	324+50	5.50		50	11	550
328+85	329+20	5.50		35	11	385
338+35	340+10	5.50		175	11	1925
341+10	341+30	2.75		20	5.5	110
341+45	341+85	5.50		40	11	440
Total						15,022.50

ORIGINAL PLAN	SURVEY PLOTTED BY _____ DATE _____	
	DRAWN BY _____	
NOTE BOOK	TRACED BY _____	
	DESIGNED BY _____	
	QUANTITIES BY _____	
	CHECKED BY _____	
N _o _____		

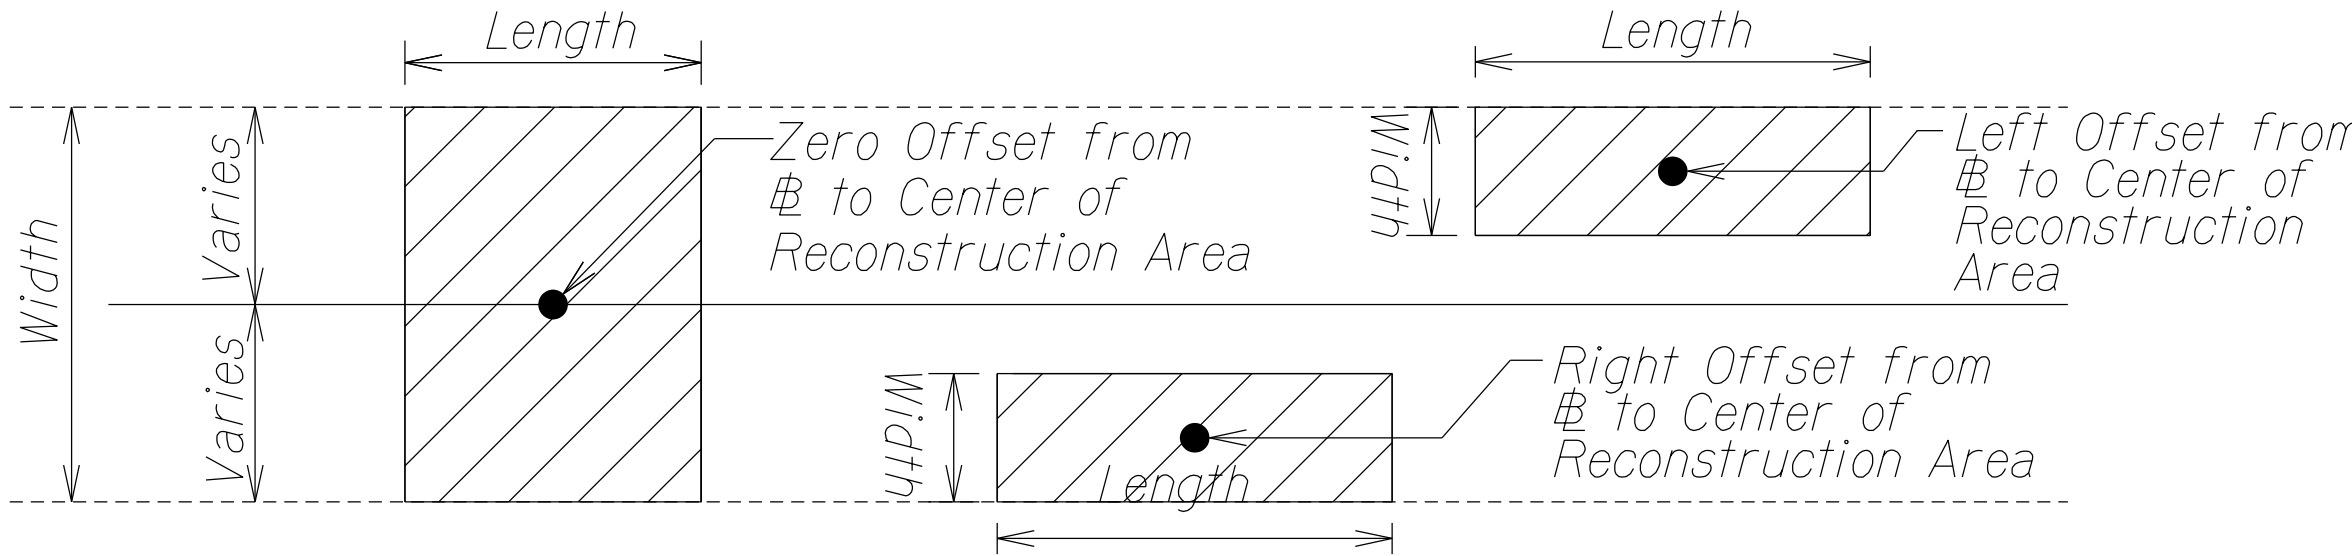

LOCATION OF WEAKENED PAVEMENT DETAIL

Not to Scale

05/27/2021	△ Revised Schedule
DATE	REVISION
STATE OF HAWAII DEPARTMENT OF TRANSPORTATION HIGHWAYS DIVISION  <u>RECONSTRUCTION AREA SCHEDULE</u> <u>KAMEHAMEHA HIGHWAY REHABILITATION</u> <u>Vicinity of Kapuhi Street to Dairy Road</u> <u>Federal Aid Project No. NH-083-1(77)</u> <i>Date: June, 2020</i>	

ORIGINAL PLAN	DATE	SURVEY PLOTTED BY	_____
		DRAWN BY	_____
		TRACED BY	_____
		DESIGNED BY	_____
NOTE BOOK	N.	QUANTITIES BY	_____
		CHECKED BY	_____

Reconstruction Area Schedule (Eastbound Lanes)						
Station		Apx. Offset from BL to Center of Reconstruction Area (L.F.)		Length (L.F.)	Width (L.F.)	Approximate Area (S.F.)
From	To	Left	Right			
144+00	144+65		2.75	85	5.5	467.50
144+65	145+50		2.75	65	5.5	357.50
148+10	150+80		5	270	10	2700
163+90	164+10		8.50	20	5	100
166+10	166+35		8.50	25	5	125
167+20	168+40		13	120	6	720
167+50	167+75		5	25	10	250
168+60	169+30		8.50	70	5	350
173+05	173+45		8.50	40	5	200
178+00	178+50		11.50	50	6	300
178+00	178+70		3	70	5	350
185+75	186+40		8.50	65	5	325
187+00	188+15		8.50	115	5	575
189+80	190+90		5	110	10	1100
193+38	193+78		12	40	24	960
196+35	197+10		5	75	10	750
197+10	197+90		7.50	80	5	400
198+40	200+15		8.50	175	5	875
201+56	202+06		18	50	14	700
203+30	203+75		8.50	45	5	225
208+80	209+00		8.50	20	5	100
210+35	210+50		8.50	15	5	75
282+60	282+90		5.50	30	11	330
282+90	283+90		6.25	100	5.5	550
283+90	284+10		5.50	20	11	220
284+10	284+70		7.75	60	5.5	330
289+40	289+90		8.25	50	5.5	275
304+85	305+00		0	15	22	330

FED. ROAD DIST. NO.	STATE	FED. AID PROJ. NO.	FISCAL YEAR	SHEET NO.	TOTAL SHEETS
HAWAII	HAW.	NH-083-1(77)	2021	24	87

Station		Apx. Offset from BL to Center of Reconstruction Area (L.F.)		Length (L.F.)	Width (L.F.)	Approximate Area (S.F.)
From	To	Left	Right			
305+30	305+70		8.25	40	5.5	220
306+20	306+60		2.75	40	5.5	220
308+60	308+90		2.75	30	5.5	165
309+30	309+60		2.75	30	5.5	165
311+97	312+17		2.75	20	5.5	110
313+30	313+50		8.25	20	5.5	110
314+40	314+55		8.25	15	5.5	82.50
316+90	317+50		2.75	60	5.5	330
318+35	318+55		8.25	20	5.5	110
318+92	319+07		8.25	20	5.5	110
319+70	320+45		2.75	75	5.5	412.50
320+75	321+15		2.75	40	5.5	220
321+25	321+40		8	15	6	90
325+30	325+80		8.25	50	5.5	275
327+00	327+15		8.25	15	5.5	82.50
327+50	327+75		2.75	25	5.5	137.50
328+05	328+40		8.25	35	5.5	192.50
328+85	329+20		5.5	35	11	385
338+75	338+89		5.5	14	11	154
339+49	339+65		5.5	16	11	176
340+55	340+75		8.25	20	5.5	110
341+10	341+30		5.5	20	11	220
					Total	17,947.50

05/27/2021	△ Revised Schedule
DATE	REVISION
STATE OF HAWAII DEPARTMENT OF TRANSPORTATION HIGHWAYS DIVISION	
RECONSTRUCTION AREA SCHEDULE	
KAMEHAMEHA HIGHWAY REHABILITATION Vicinity of Kapuhi Street to Dairy Road Federal Aid Project No. NH-083-1(77)	
Date: June, 2020	