
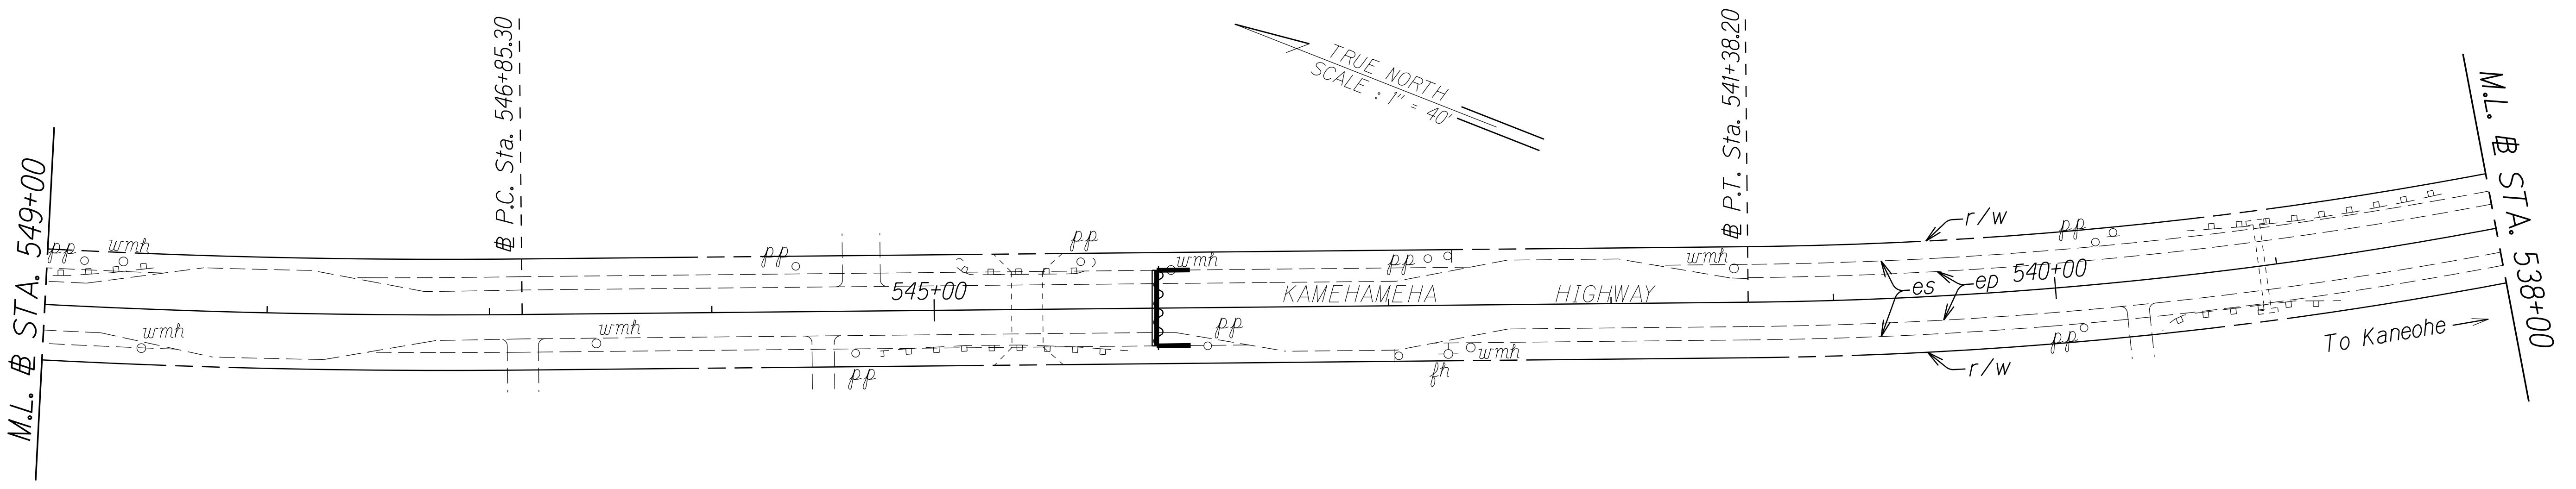


FED. ROAD DIST. NO.	STATE	FED. AID PROJ. NO.	FISCAL YEAR	SHEET NO.	TOTAL SHEETS
HAWAII	HAW.	HSIP-083-1(66)	2019	11	36

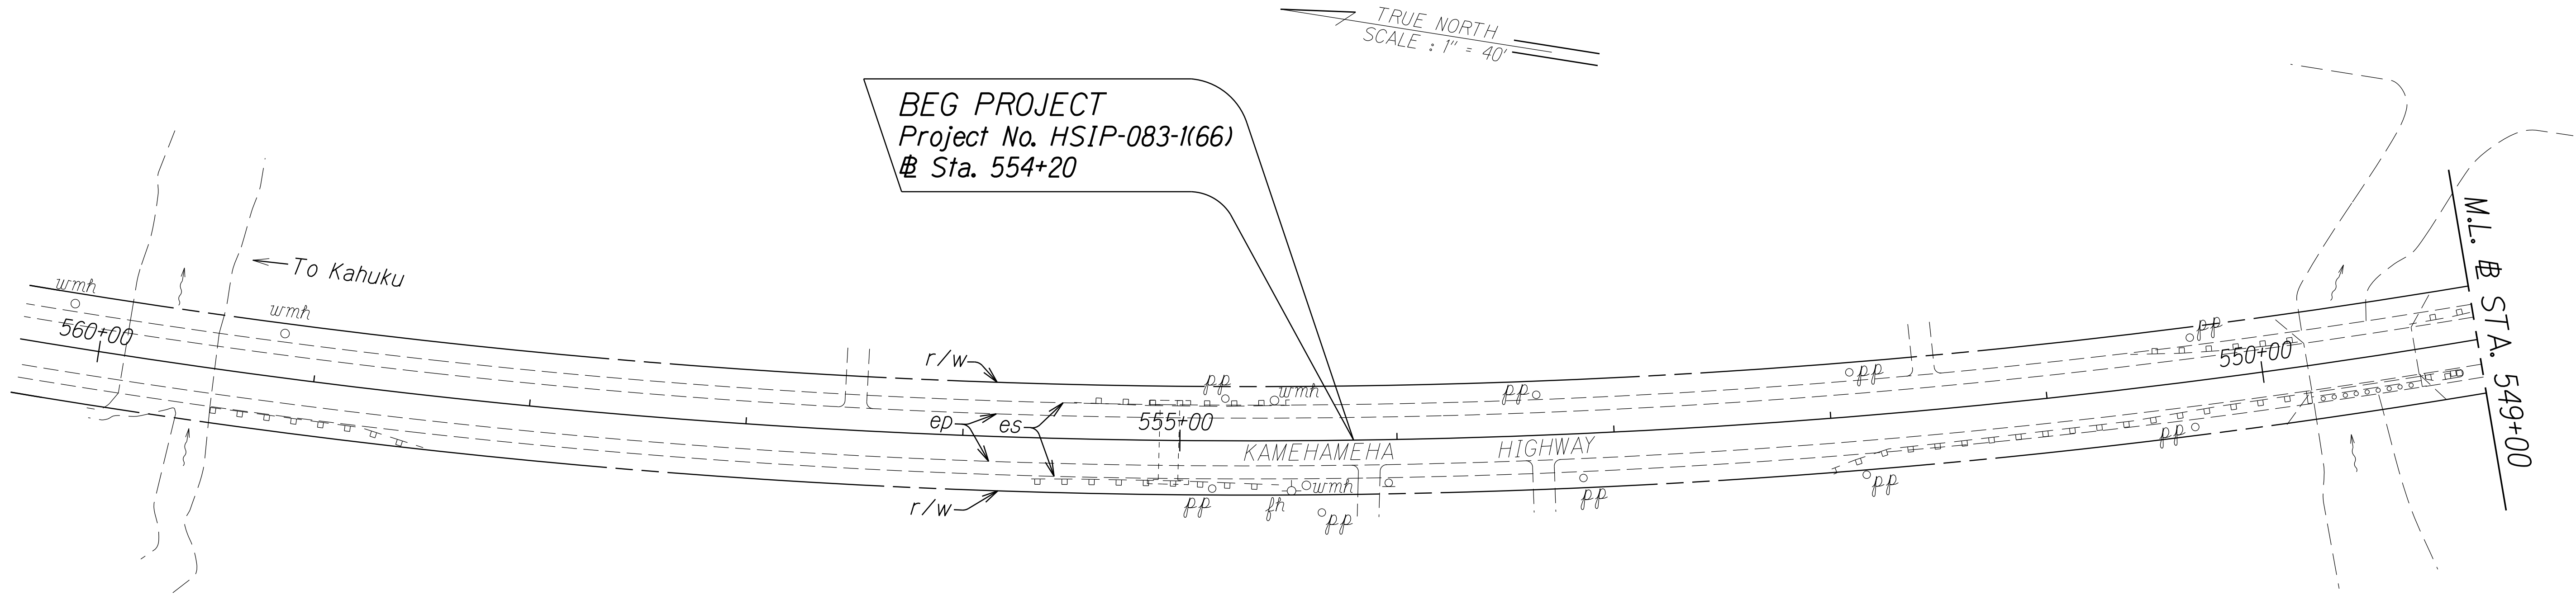

ORIGINAL PLAN	SURVEY PLOTTED BY	DATE
NOTE BOOK	DRAWN BY	11
003.pwg	DESIGNED BY	
N.skmh.dgn	CHECKED BY	

528+71 544+04
~~# Sta. 528+75 to # Sta. 544+00~~
Install High Friction Surface Treatment
(with modified Epoxy binder or Equivalent)
within the Travel Way.

LEGEND FOR AS-BUILT POSTINGS	
	Squiggly line for as-built deletion
	Double line for as-built deletion
Roadway	Text for as-built posting


STATE OF HAWAII
DEPARTMENT OF TRANSPORTATION
HIGHWAYS DIVISION

ROADWAY PLAN
KAMEHAMEHA HIGHWAY SAFETY IMPROVEMENTS
Waikane Valley Road to
Vicinity of Kahekili Highway
Federal Aid Project No. HSIP-083-1(66)
Scale: 1" = 40' Date: Sept., 2018

SHEET No. 1 OF 9 SHEETS

"AS-BUILT"

FED. ROAD DIST. NO.	STATE	FED. AID PROJ. NO.	FISCAL YEAR	SHEET NO.	TOTAL SHEETS
HAWAII	HAW.	HSIP-083-1(66)	2019	12	36

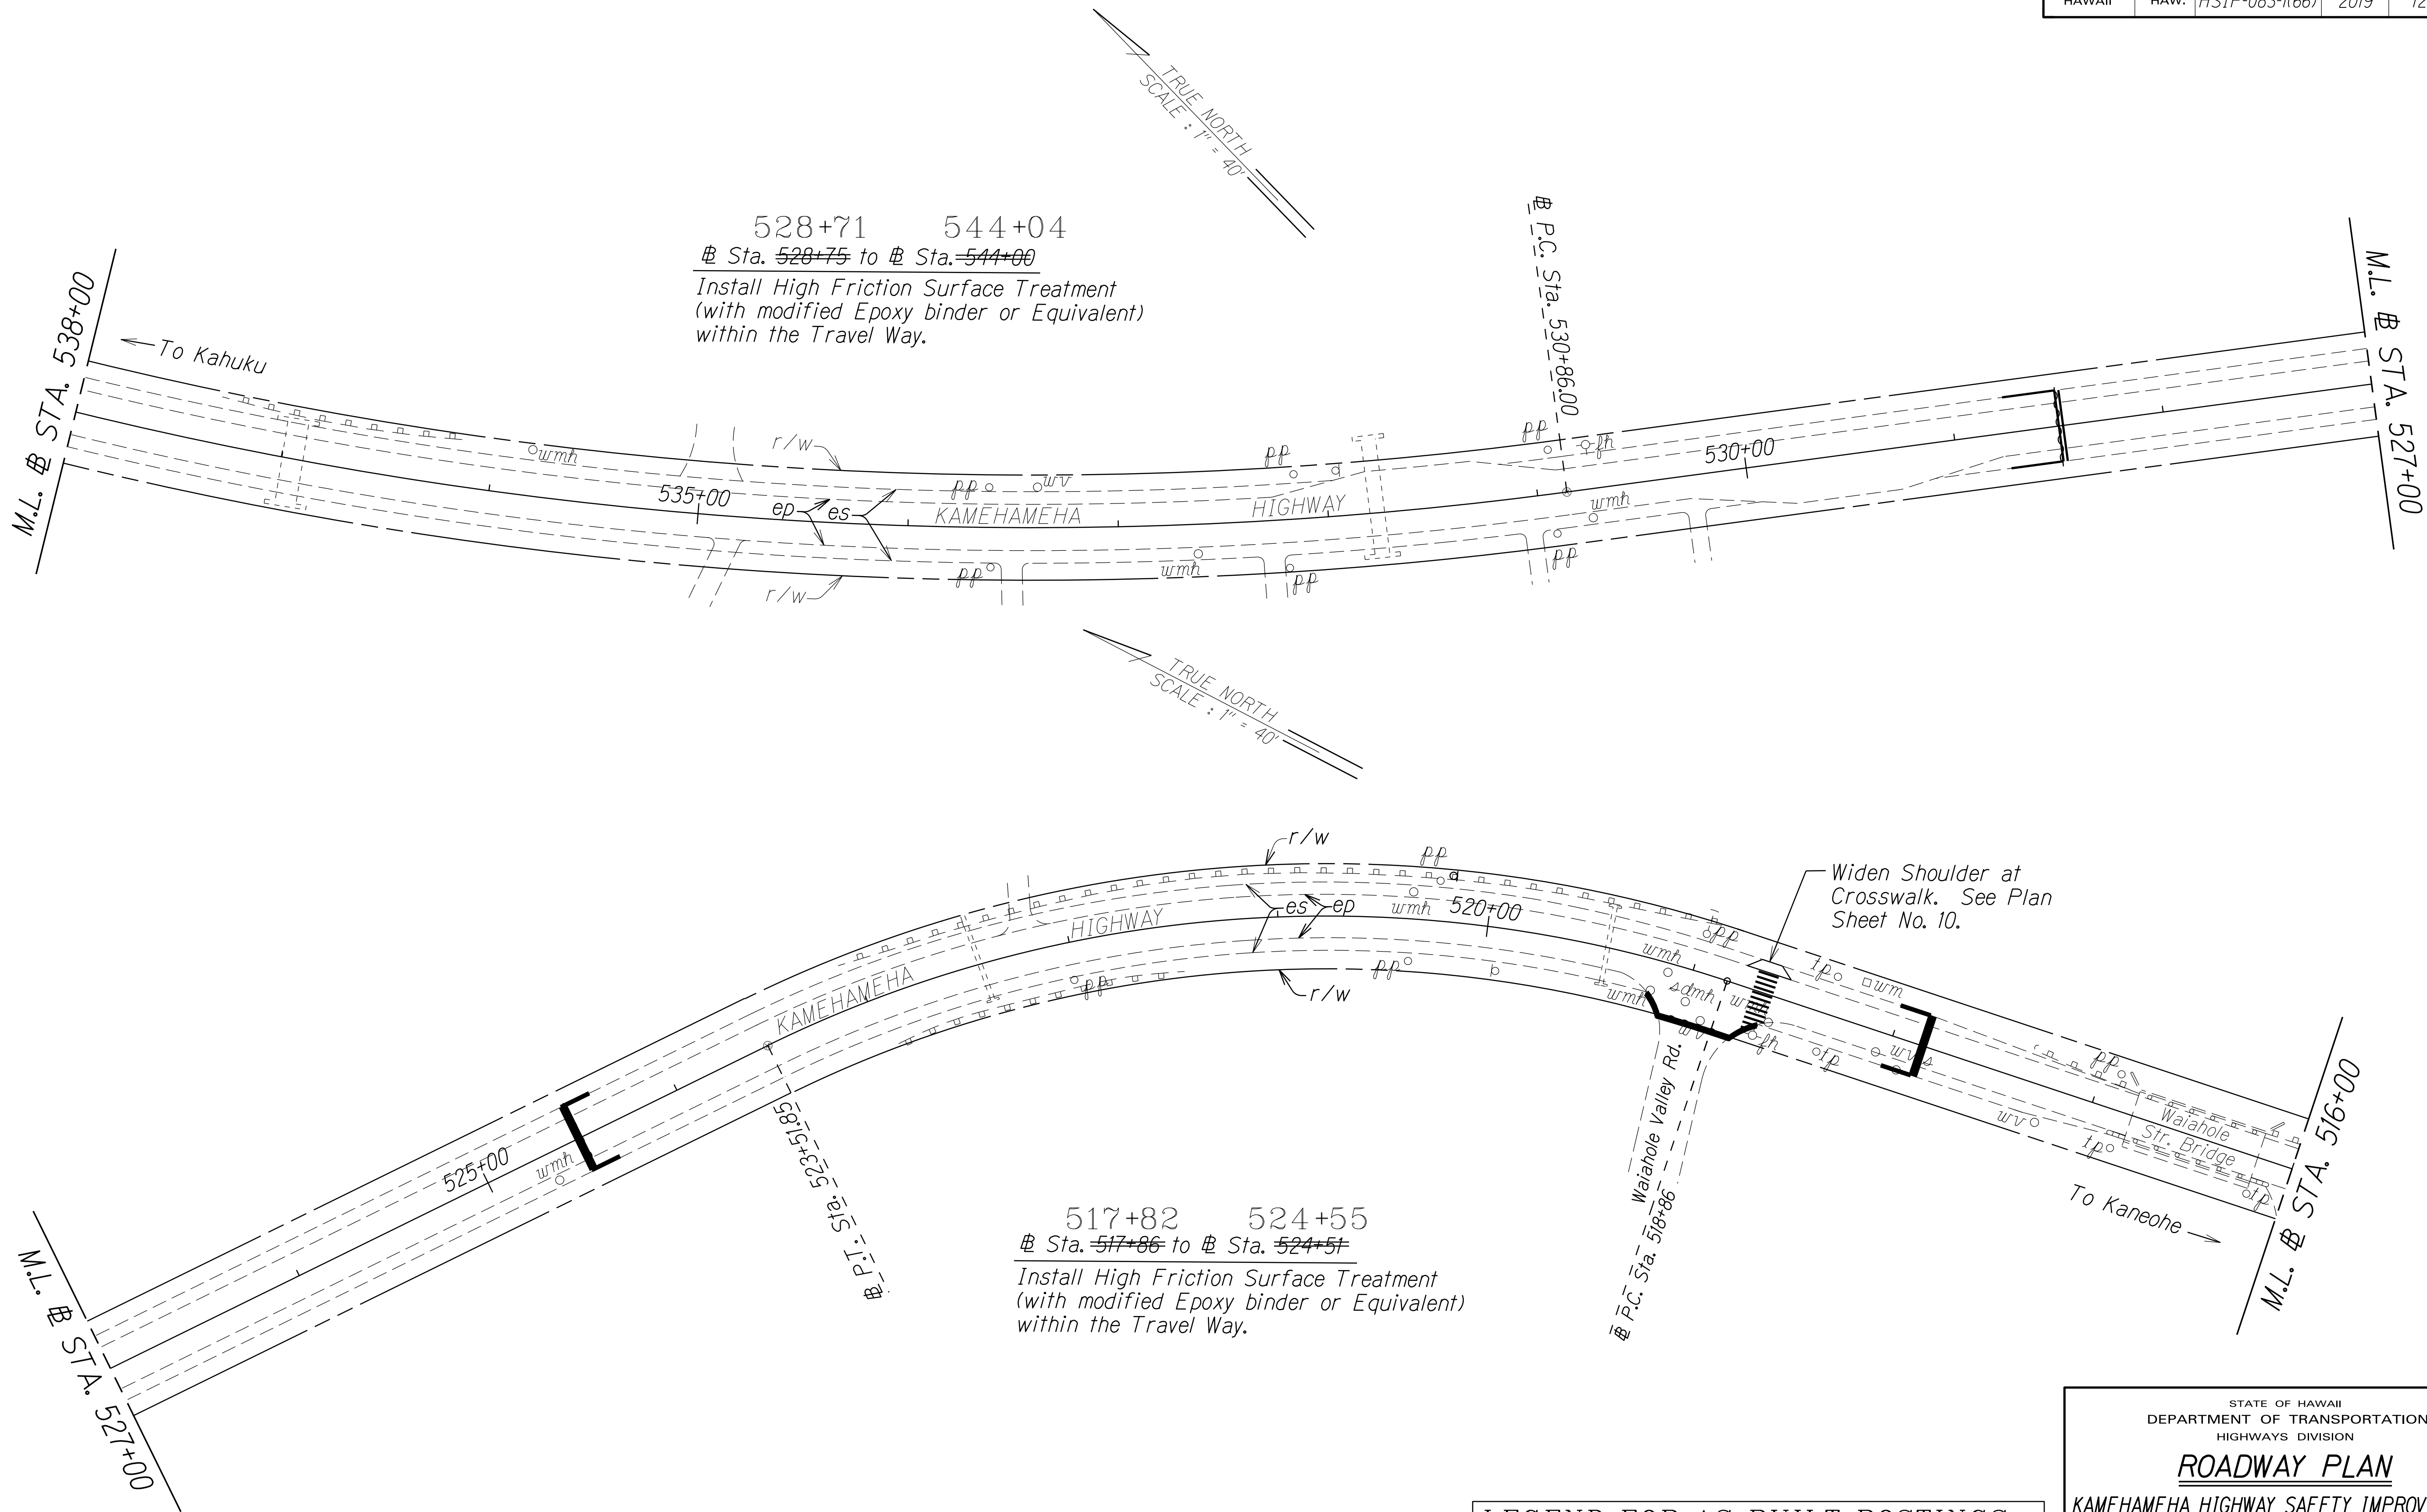

ORIGINAL PLAN	SURVEY PLOTTED BY	DATE
NOTE BOOK	DRAWN BY	X
DESIGNED BY	TRACED BY	X
CHECKED BY	DESIGNED BY	X
SKM/dgn	CHECKED BY	X

LEGEND FOR AS-BUILT POSTINGS	
	Squiggly line for as-built deletion
	Double line for as-built deletion
Roadway	Text for as-built posting

STATE OF HAWAII
DEPARTMENT OF TRANSPORTATION
HIGHWAYS DIVISION


ROADWAY PLAN

KAMEHAMEHA HIGHWAY SAFETY IMPROVEMENTS
Waikane Valley Road to
Vicinity of Kahekili Highway
Federal Aid Project No. HSIP-083-1(66)
Scale: 1" = 40' Date: Sept., 2018

SHEET No. 2 OF 9 SHEETS

"AS-BUILT"

FED. ROAD DIST. NO.	STATE	FED. AID PROJ. NO.	FISCAL YEAR	SHEET NO.	TOTAL SHEETS
HAWAII	HAW.	HSIP-083-1(66)	2019	13	36

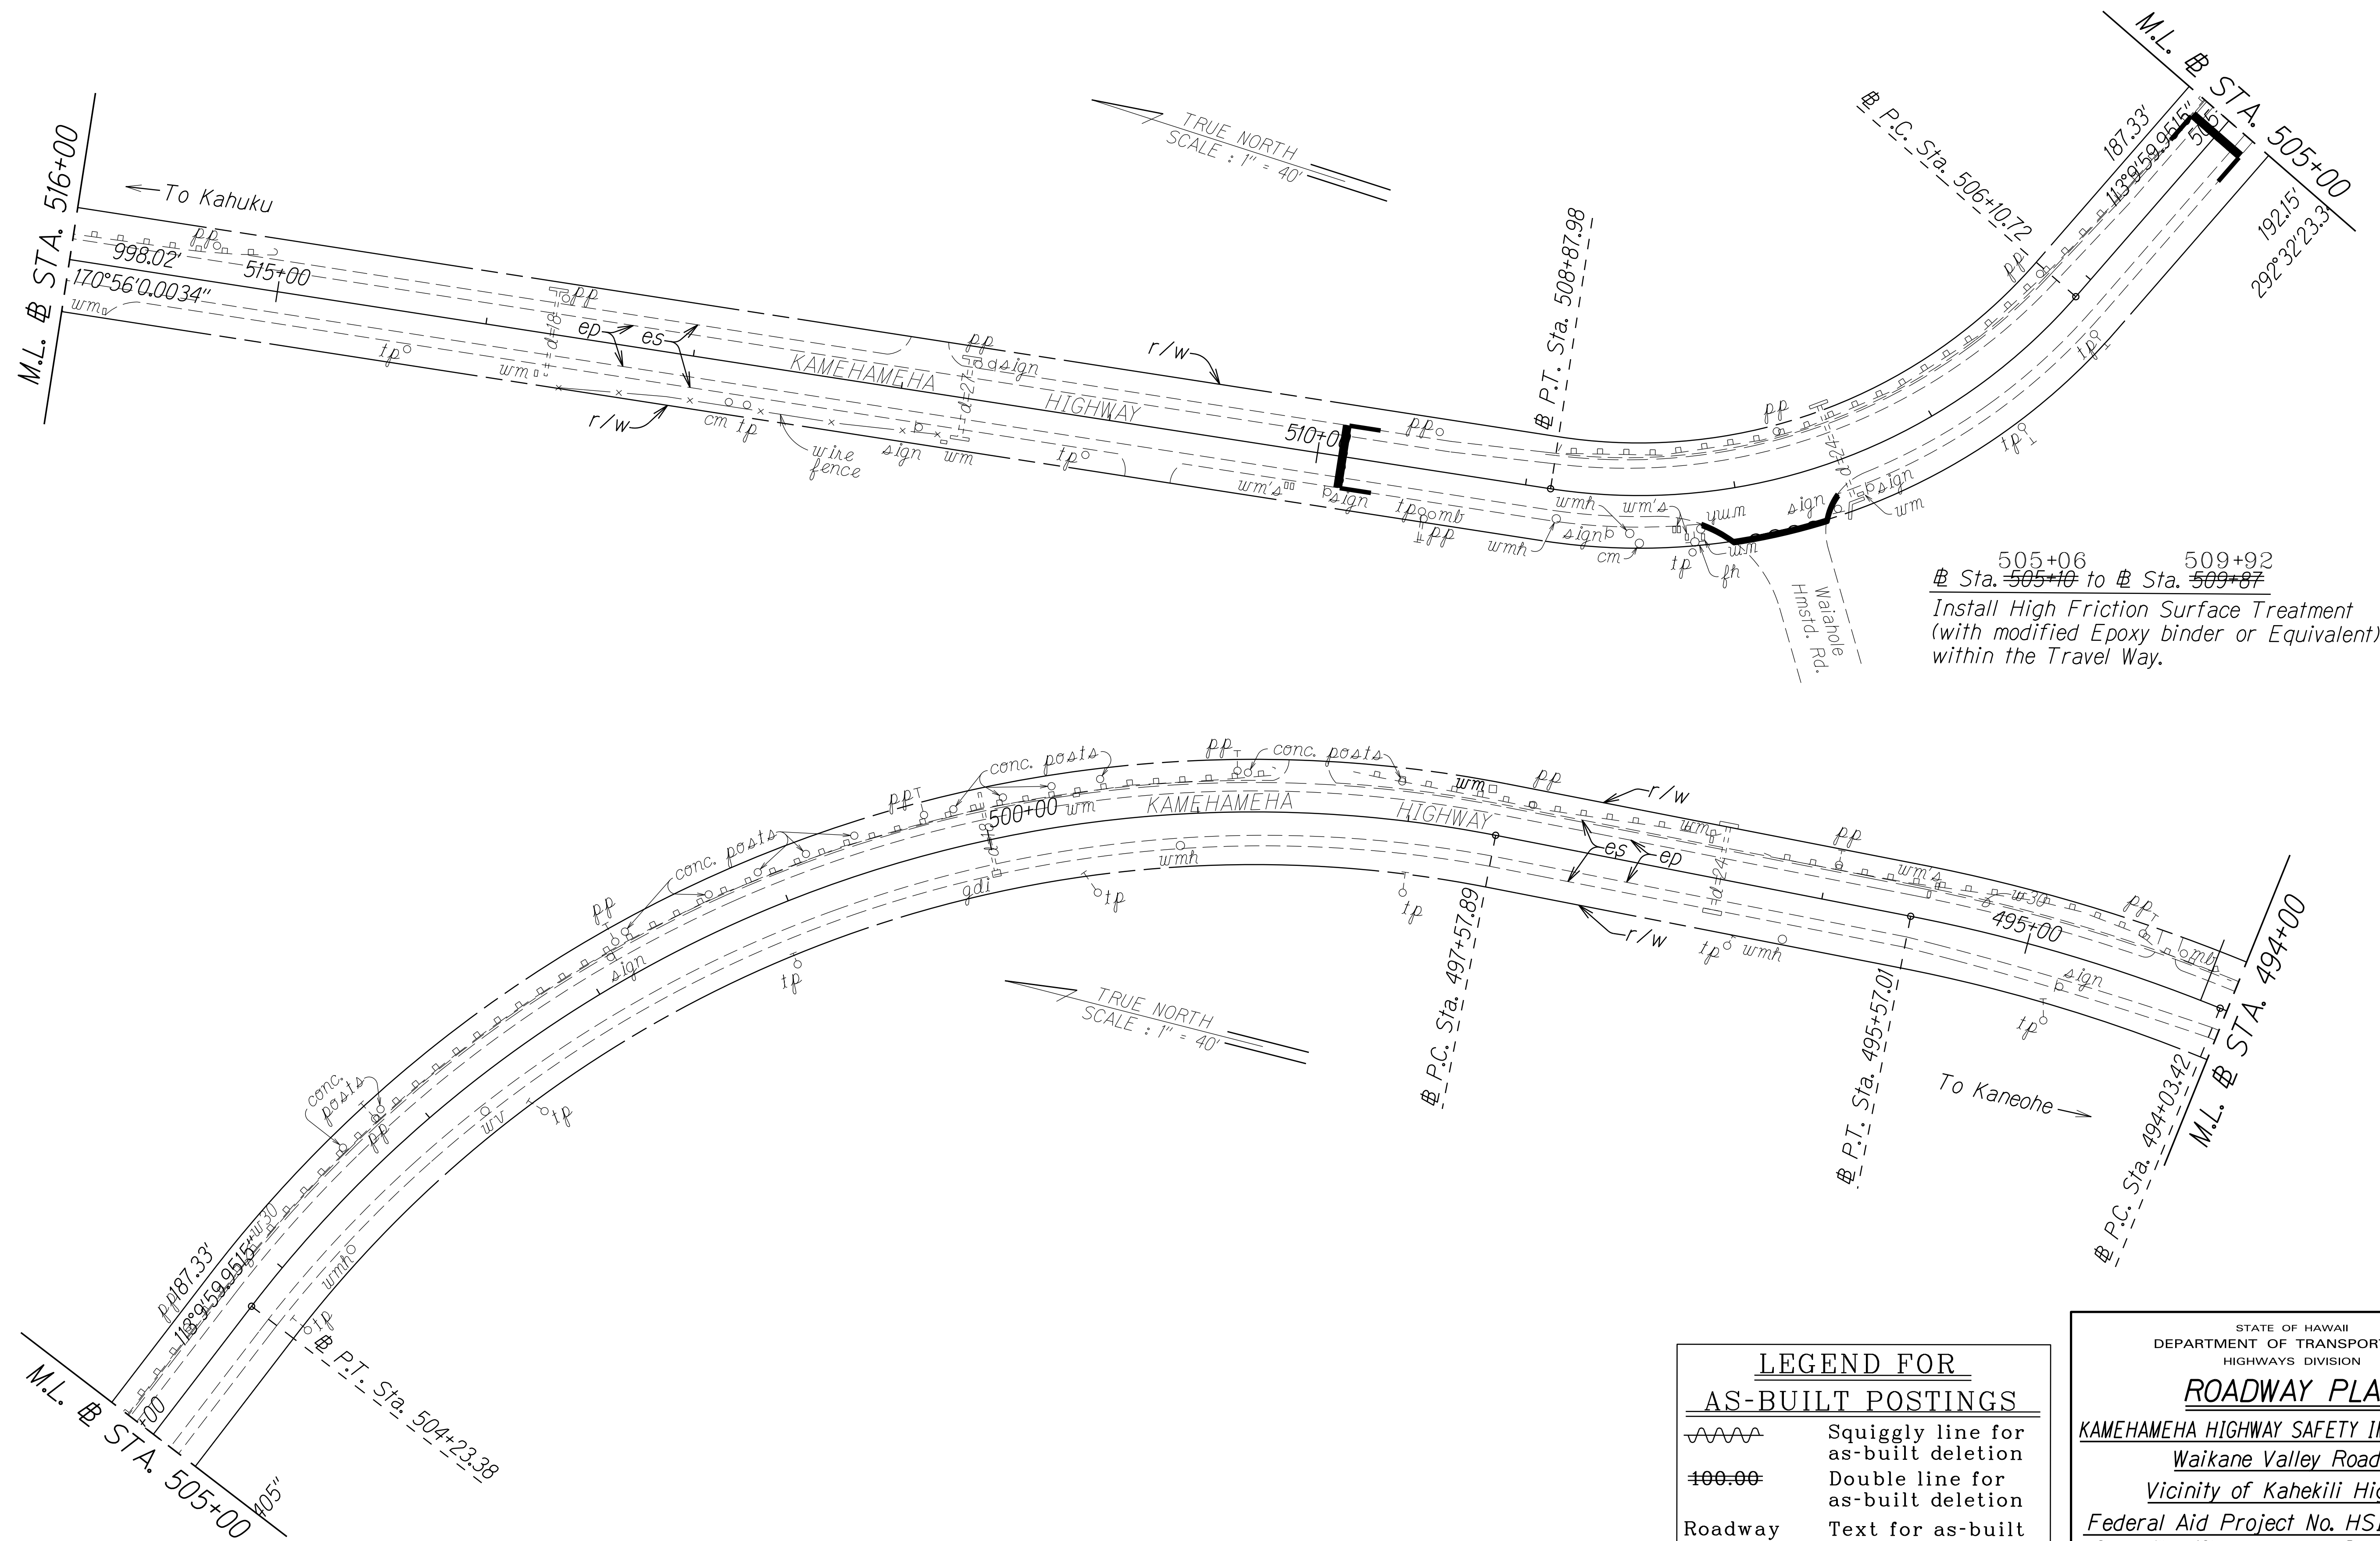

ORIGINAL PLAN	SURVEY PLOTTED BY	DATE
NOTE BOOK	DRAWN BY	11/1/18
003.pwg	DESIGNED BY	
	CHECKED BY	

LEGEND FOR AS-BUILT POSTINGS	
	Squiggly line for as-built deletion
	Double line for as-built deletion
Roadway	Text for as-built posting

STATE OF HAWAII
DEPARTMENT OF TRANSPORTATION
HIGHWAYS DIVISION

ROADWAY PLAN

KAMEHAMEHA HIGHWAY SAFETY IMPROVEMENTS



Waikane Valley Road to
Vicinity of Kahekili Highway

Federal Aid Project No. HSIP-083-1(66)

Scale: 1" = 40' Date: Sept., 2018

SHEET No. 3 OF 9 SHEETS

FED. ROAD DIST. NO.	STATE	FED. AID PROJ. NO.	FISCAL YEAR	SHEET NO.	TOTAL SHEETS
HAWAII	HAW.	HSIP-083-1(66)	2019	14	36

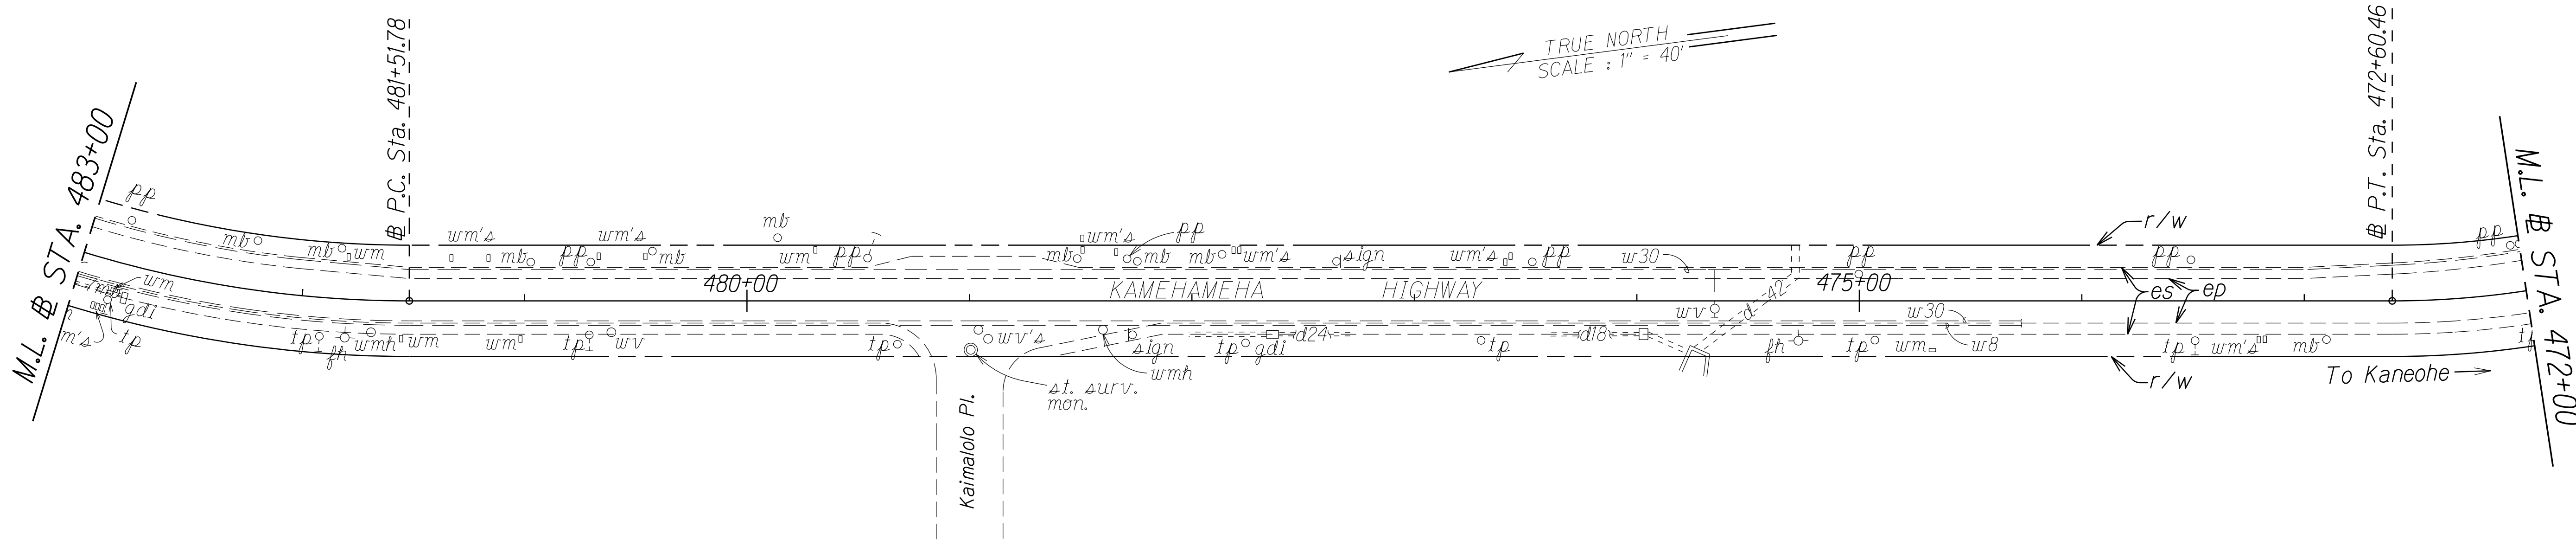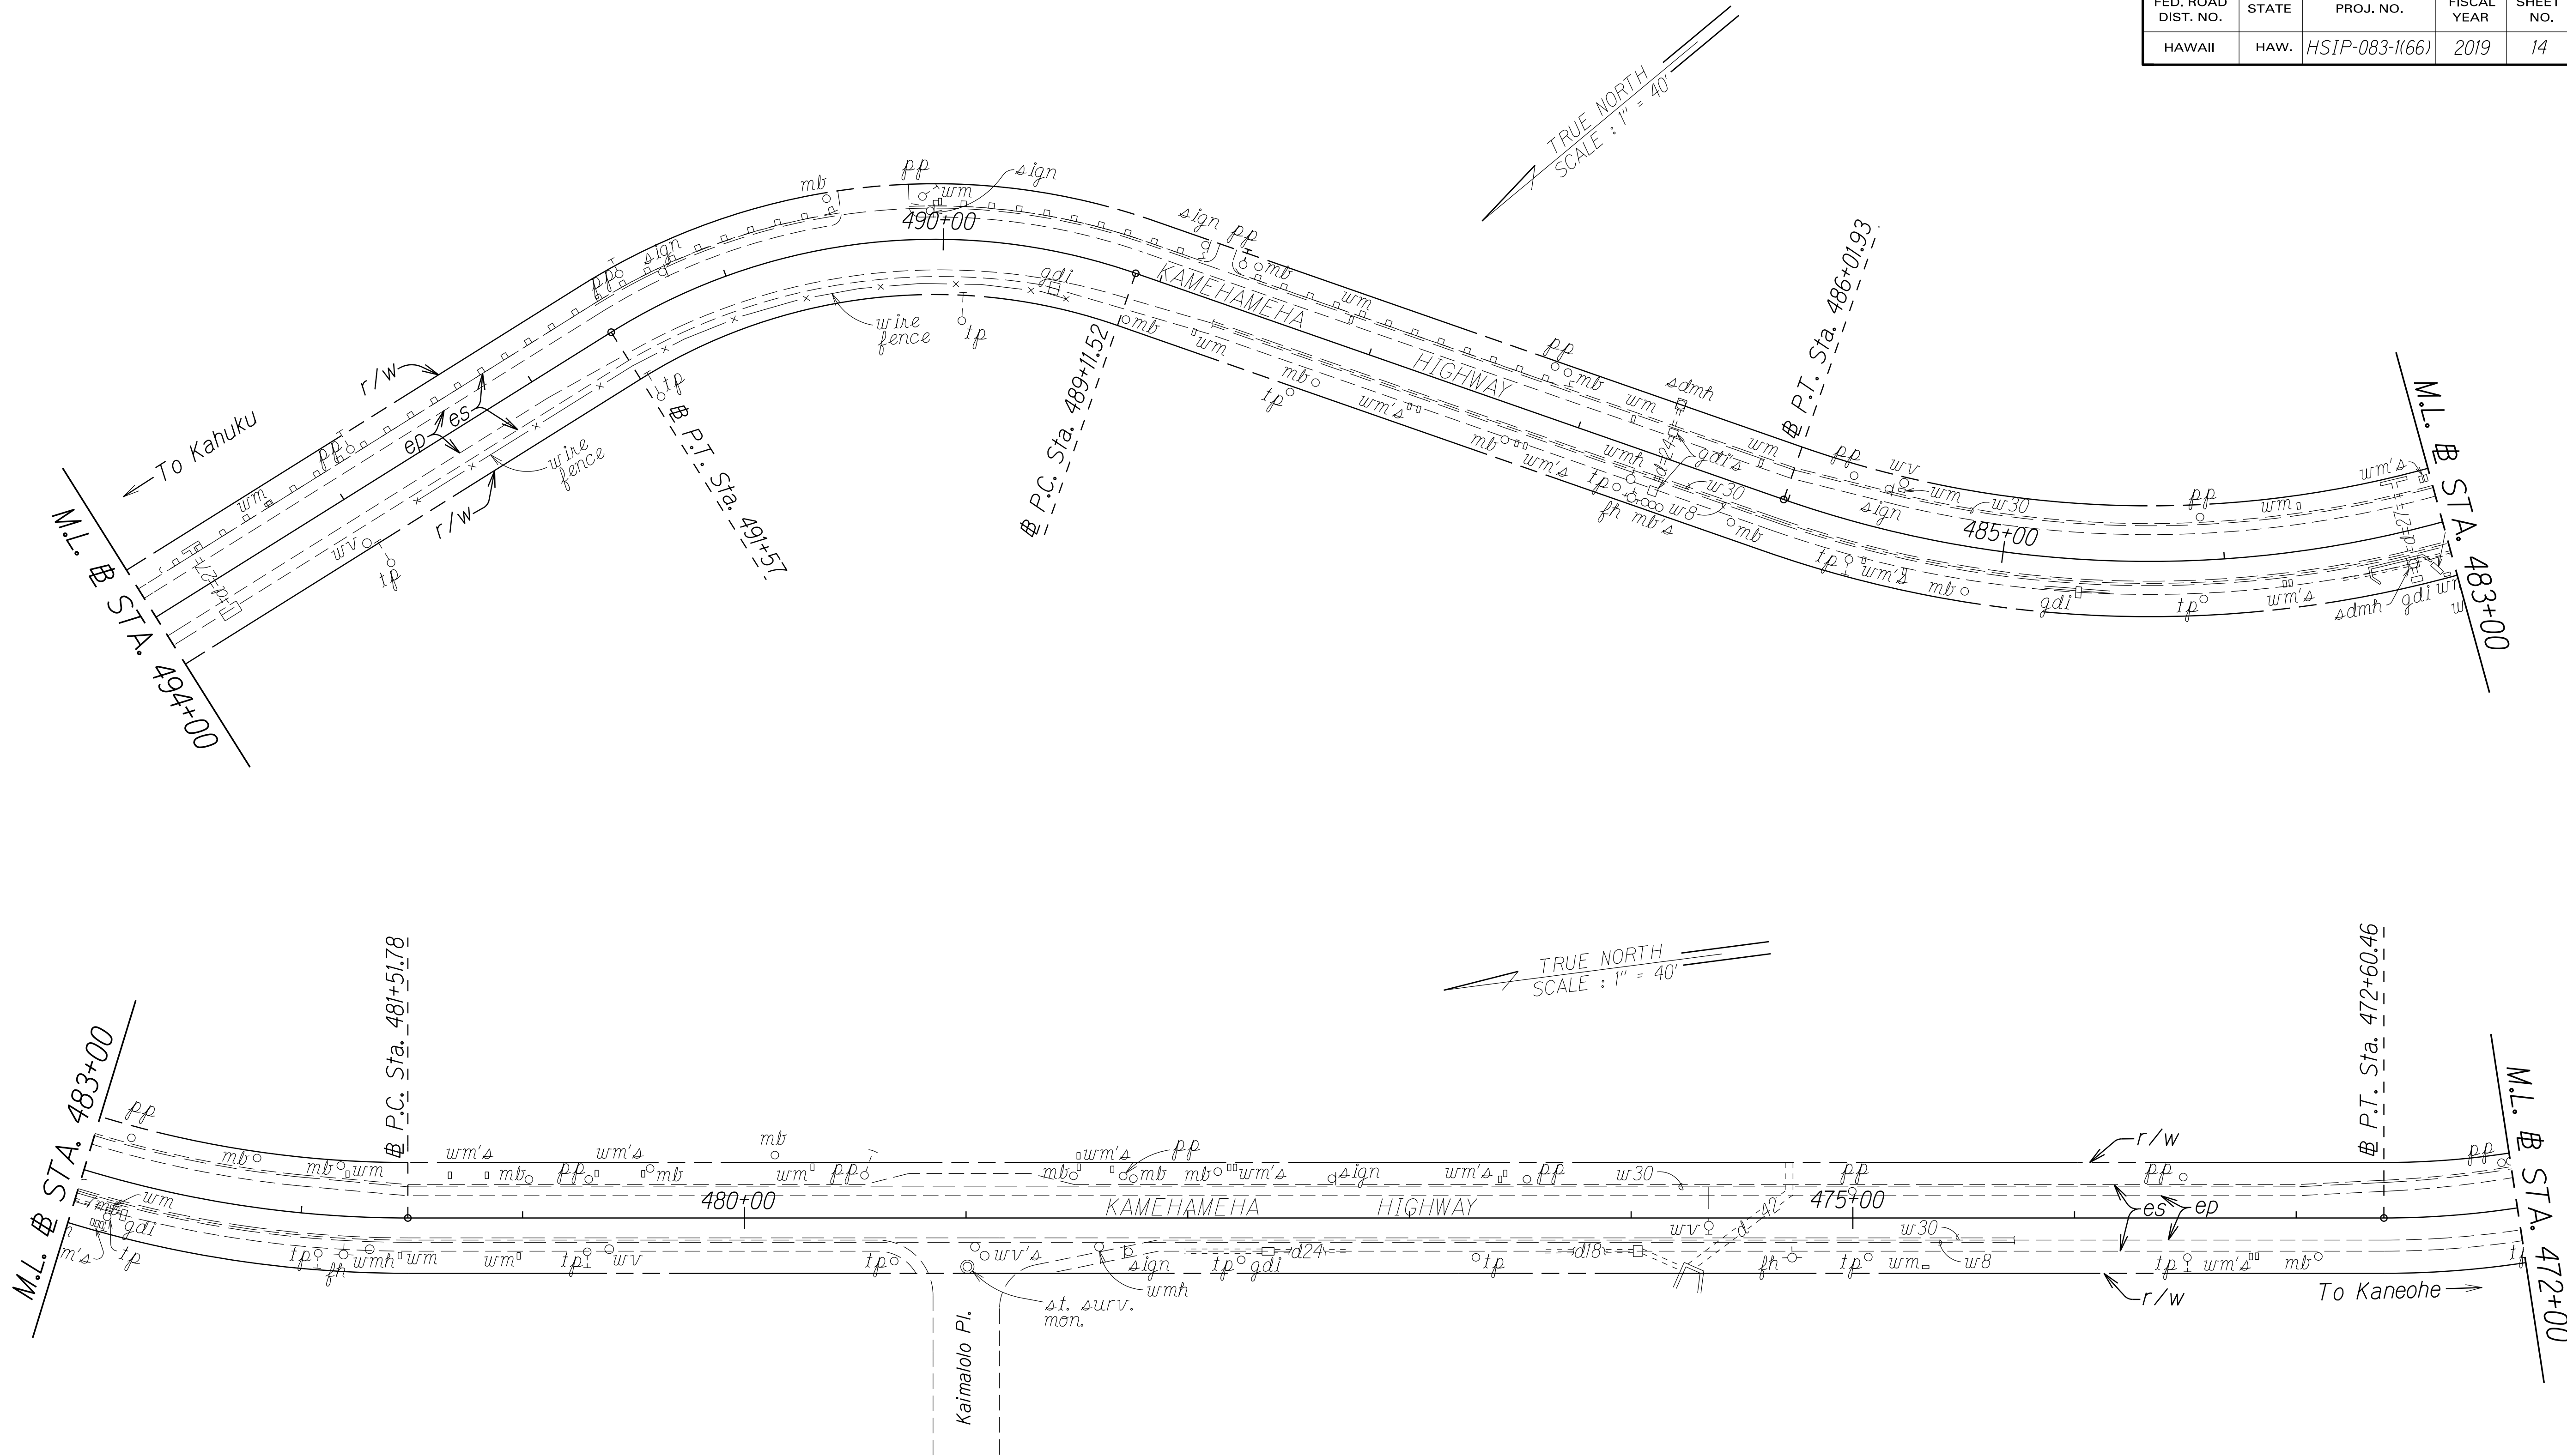

ORIGINAL PLAN	SURVEY PLOTTED BY	DATE
NOTE BOOK	DRAWN BY	1
003.pwn	DESIGNED BY	
N.skmhggp	CHECKED BY	

LEGEND FOR AS-BUILT POSTINGS	
	Squiggly line for as-built deletion
	Double line for as-built deletion
Roadway	Text for as-built posting

STATE OF HAWAII
DEPARTMENT OF TRANSPORTATION
HIGHWAYS DIVISION

ROADWAY PLAN

KAMEHAMEHA HIGHWAY SAFETY IMPROVEMENTS

Waikane Valley Road to

Vicinity of Kahekili Highway



Federal Aid Project No. HSIP-083-1(66)

Scale: 1" = 40' Date: Sept., 2018

SHEET No. 4 OF 9 SHEETS

"AS-BUILT"

FED. ROAD DIST. NO.	STATE	FED. AID PROJ. NO.	FISCAL YEAR	SHEET NO.	TOTAL SHEETS
HAWAII	HAW.	HSIP-083-1(66)	2019	15	36

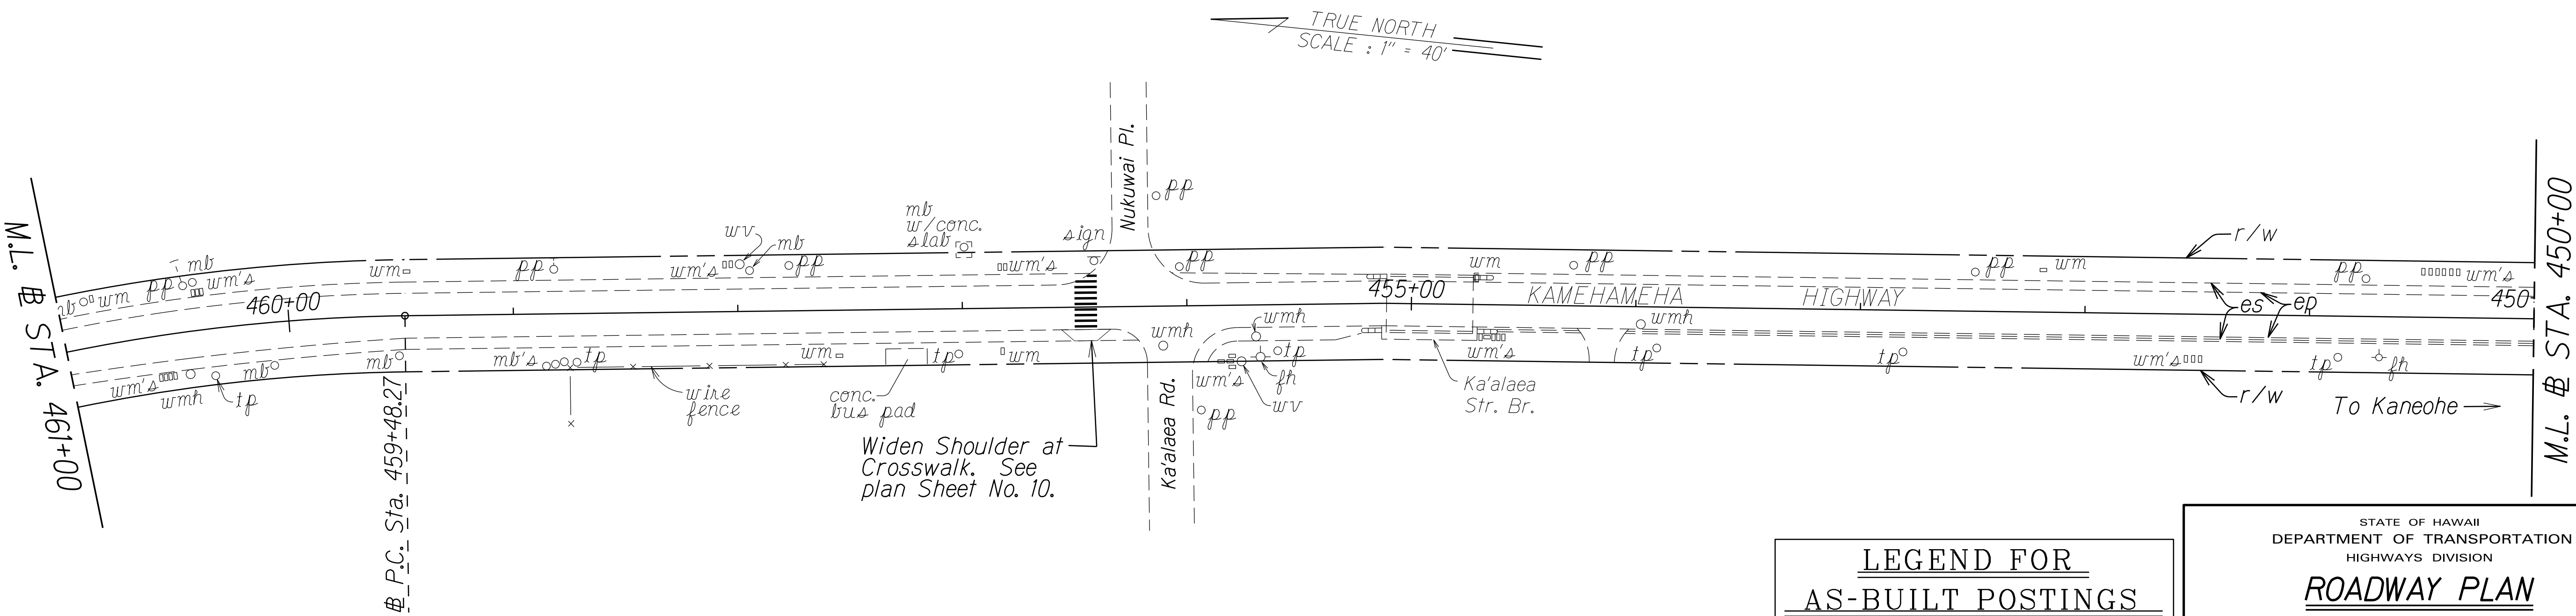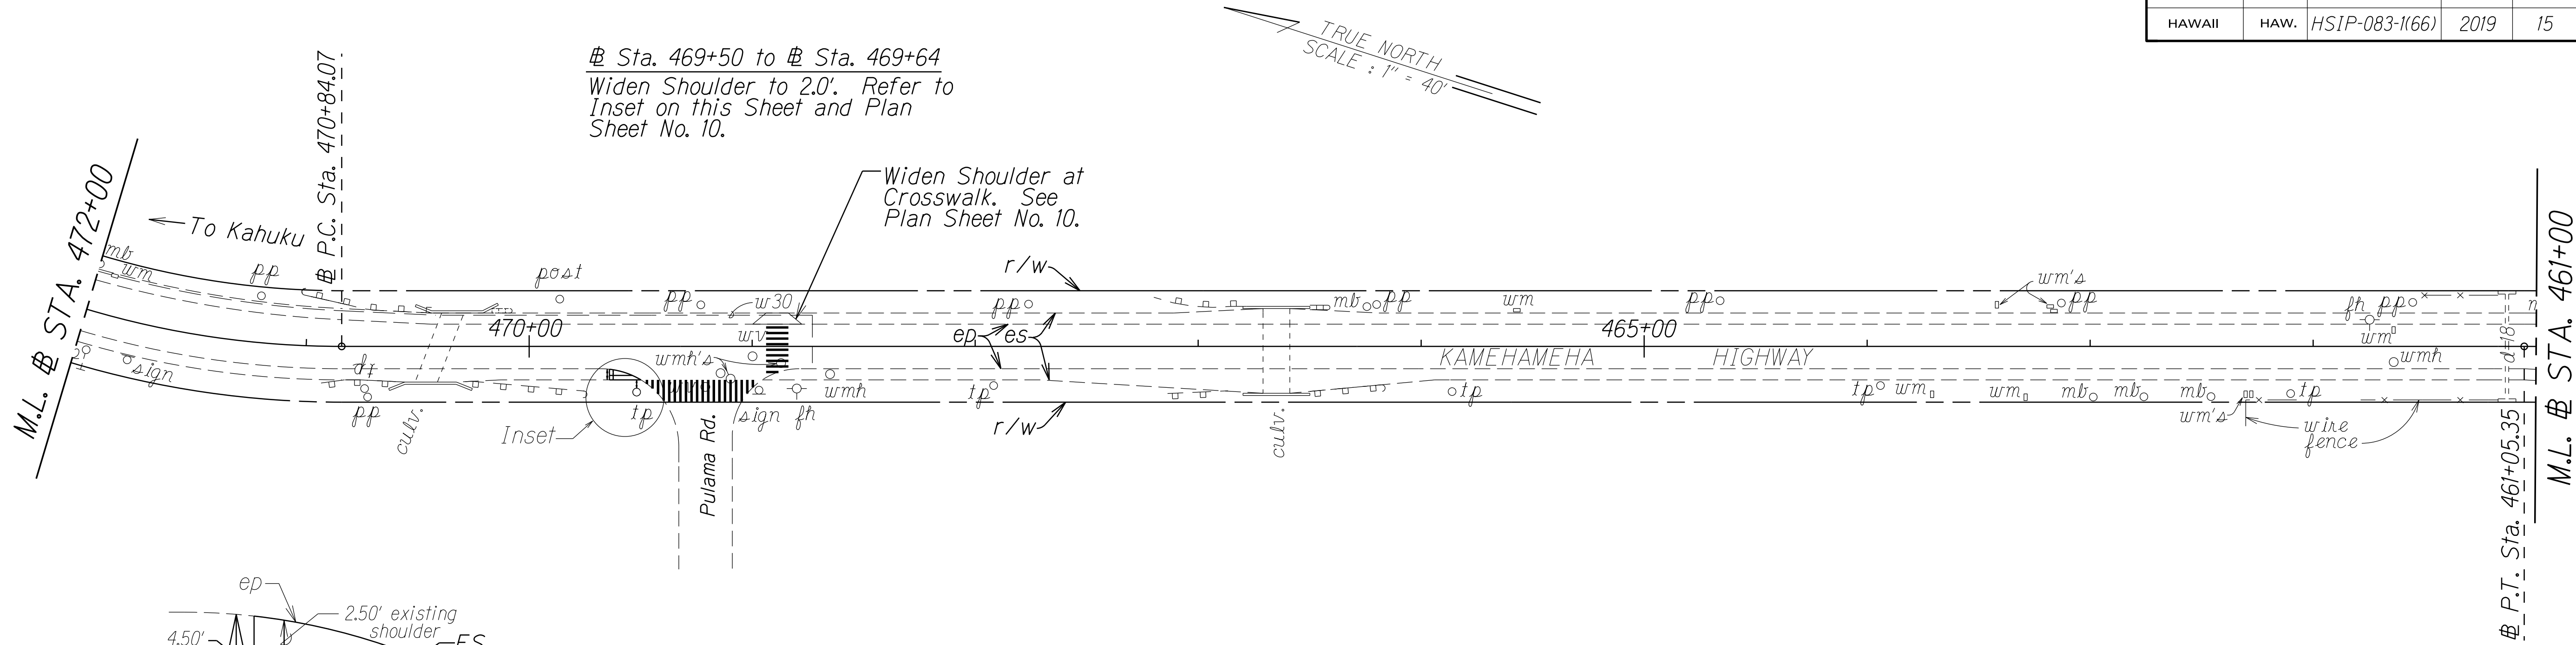

ORIGINAL PLAN	SURVEY PLOTTED BY	DATE
NOTE BOOK	DRAWN BY	1
003.pwg	DESIGNED BY	
N-skmggn	CHECKED BY	

LEGEND FOR AS-BUILT POSTINGS	
	Squiggly line for as-built deletion
	Double line for as-built deletion
Roadway	Text for as-built posting

STATE OF HAWAII
DEPARTMENT OF TRANSPORTATION
HIGHWAYS DIVISION

ROADWAY PLAN

KAMEHAMEHA HIGHWAY SAFETY IMPROVEMENTS



Waikane Valley Road to
Vicinity of Kahekili Highway

Federal Aid Project No. HSIP-083-1(66)

Scale: 1" = 40' Date: Sept., 2018

SHEET No. 5 OF 9 SHEETS

FED. ROAD DIST. NO.	STATE	FED. AID PROJ. NO.	FISCAL YEAR	SHEET NO.	TOTAL SHEETS
HAWAII	HAW.	HSIP-083-1(66)	2019	16	36

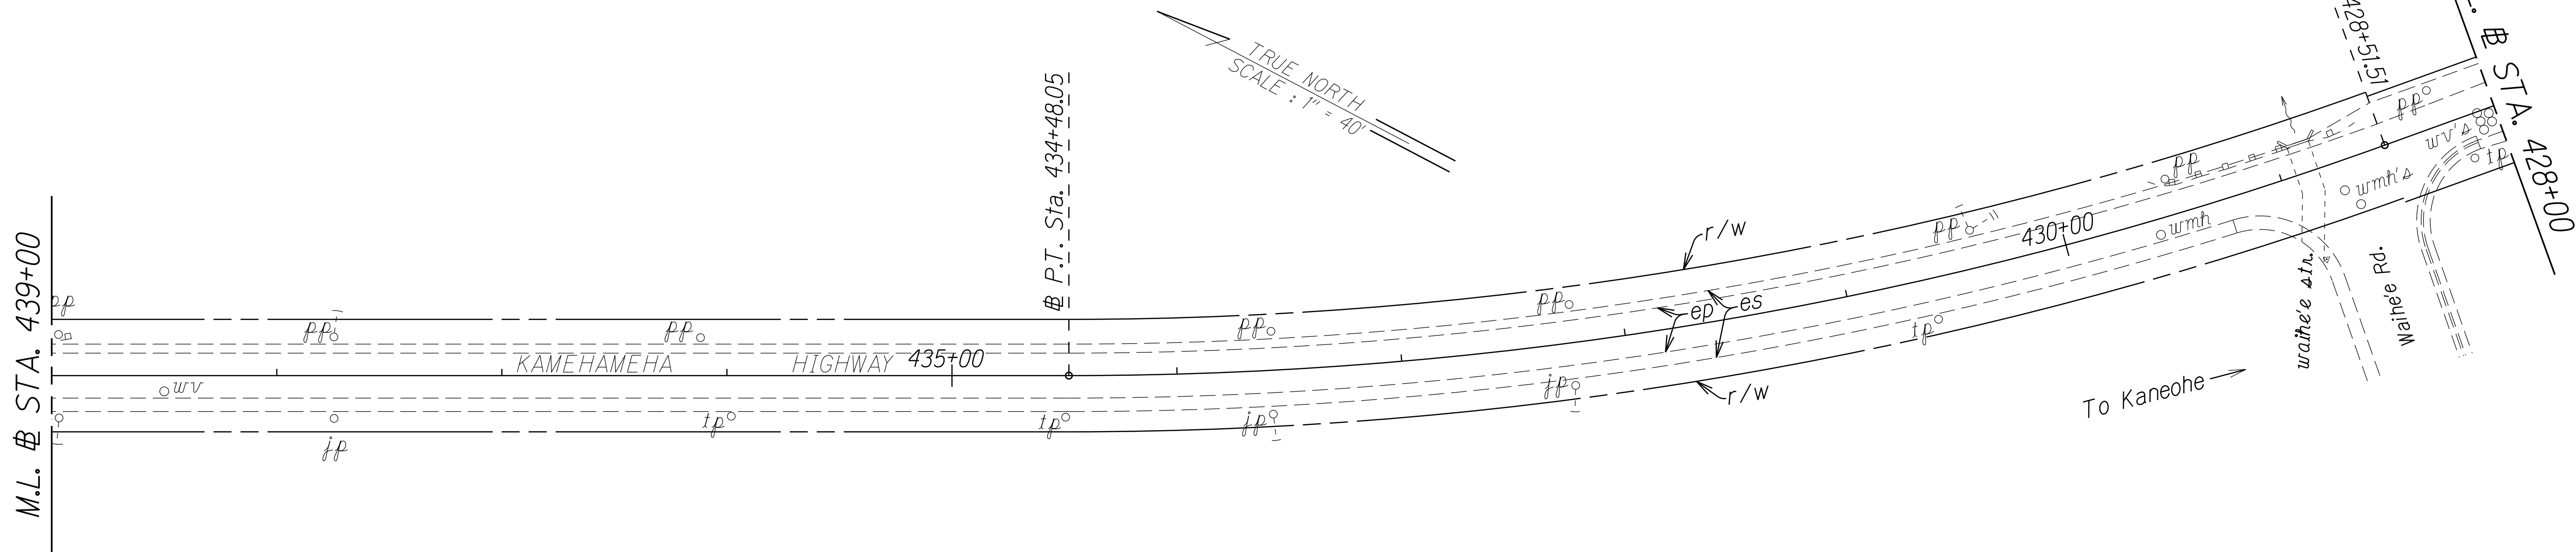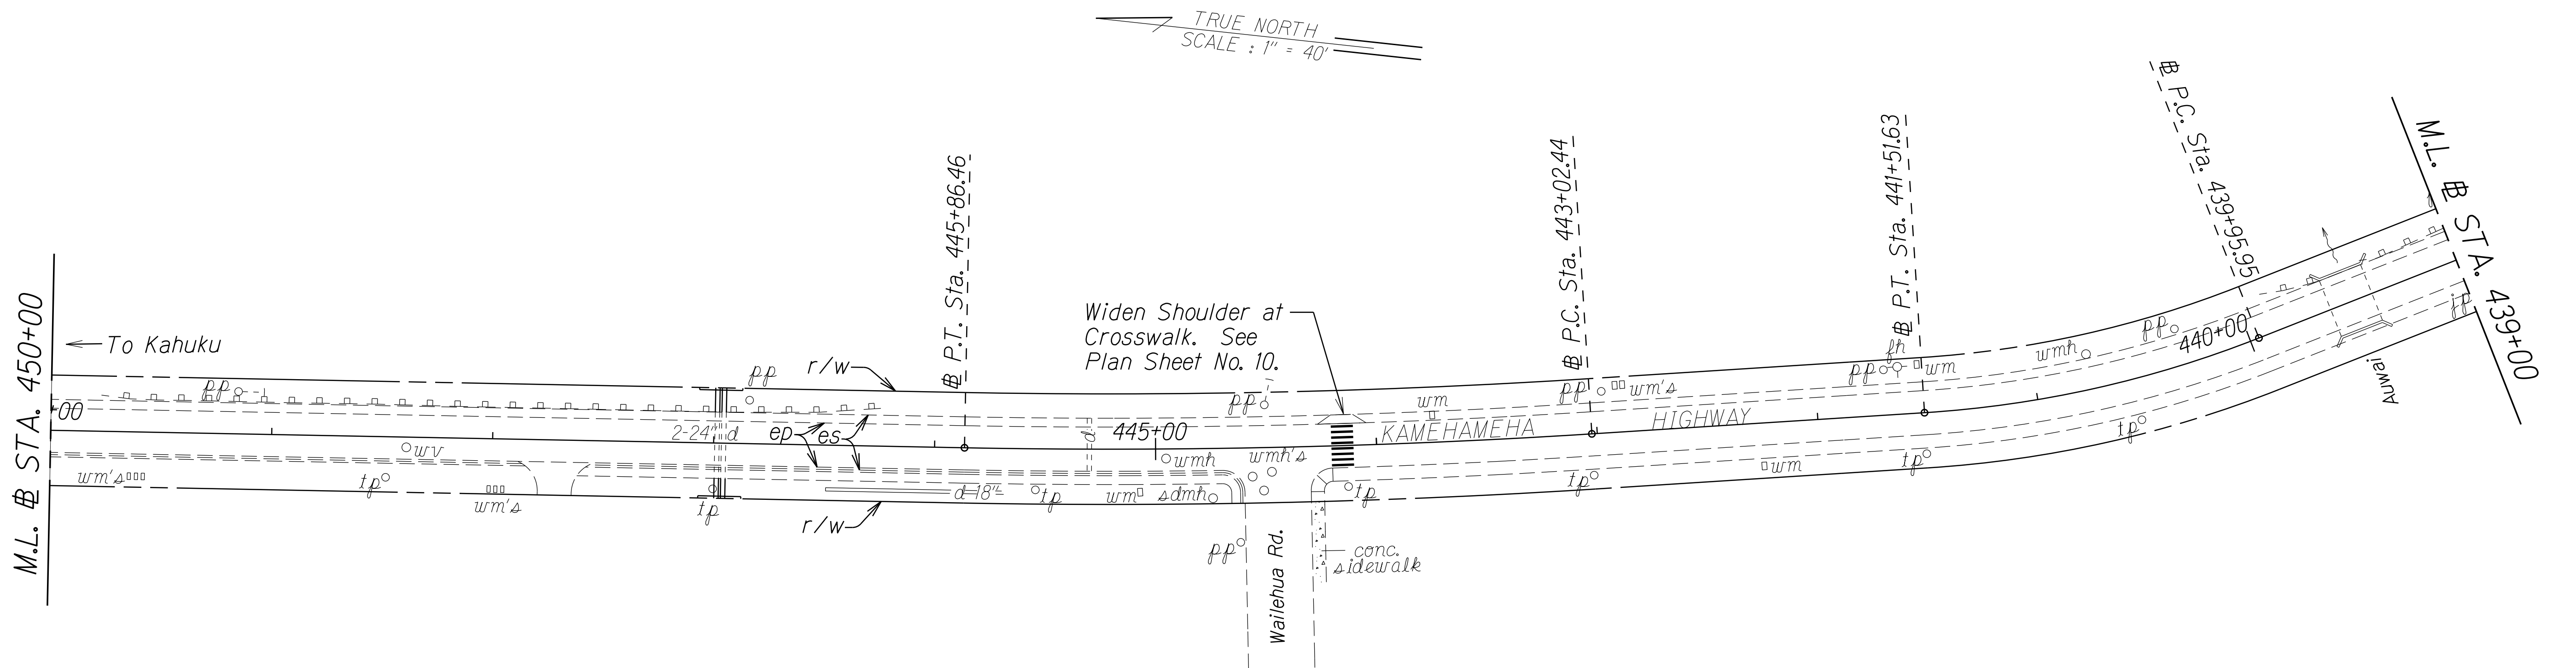

ORIGINAL PLAN	SURVEY PLOTTED BY	DATE
NOTE BOOK	DRAWN BY	1
003.pwg	DESIGNED BY	
N. Skmhdgn	CHECKED BY	

LEGEND FOR AS-BUILT POSTINGS	
	Squiggly line for as-built deletion
	Double line for as-built deletion
Roadway	Text for as-built posting

STATE OF HAWAII
DEPARTMENT OF TRANSPORTATION
HIGHWAYS DIVISION

ROADWAY PLAN

KAMEHAMEHA HIGHWAY SAFETY IMPROVEMENTS


Waikane Valley Road to
Vicinity of Kahekili Highway

Federal Aid Project No. HSIP-083-1(66)

Scale: 1" = 40' Date: Sept., 2018

SHEET No. 6 OF 9 SHEETS

FED. ROAD DIST. NO.	STATE	FED. AID PROJ. NO.	FISCAL YEAR	SHEET NO.	TOTAL SHEETS
HAWAII	HAW.	HSIP-083-1(66)	2019	17	36

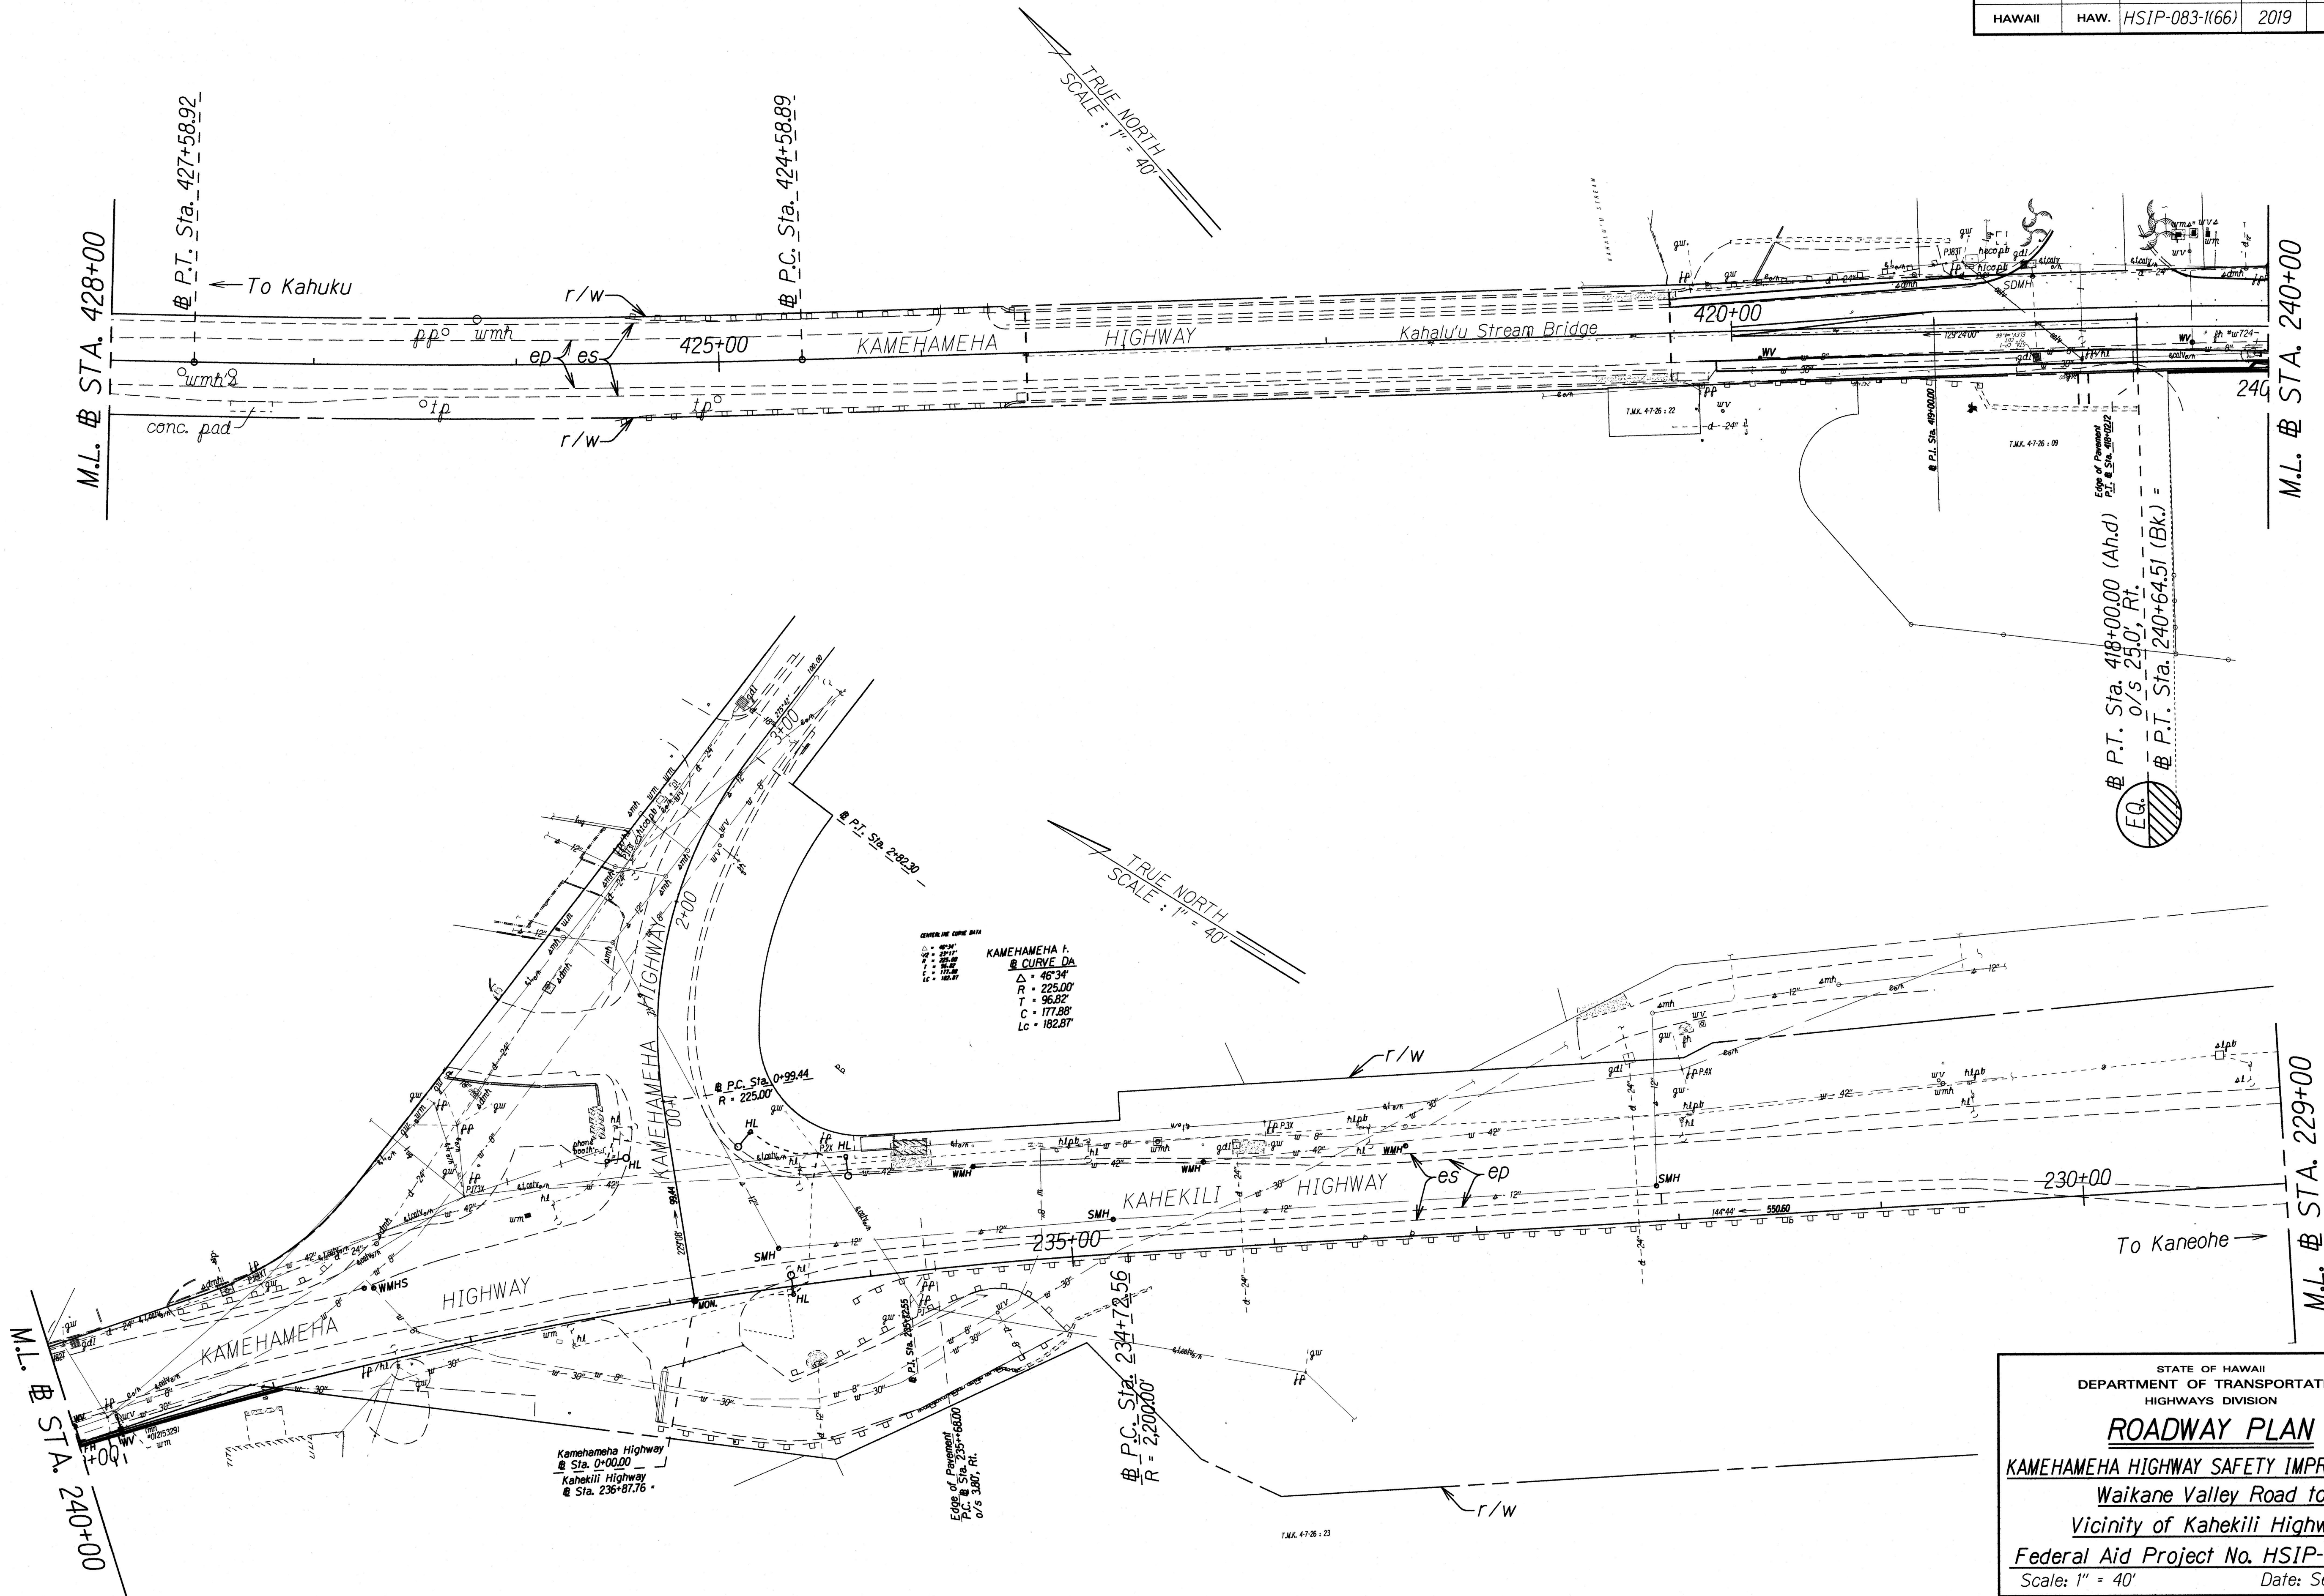

ORIGINAL PLAN	DATE
DRAWN BY	
TRACED BY	
NOTE BOOK	
QUANTITIES BY	
CHECKED BY	

STATE OF HAWAII
DEPARTMENT OF TRANSPORTATION
HIGHWAYS DIVISION

ROADWAY PLAN

KAMEHAMEHA HIGHWAY SAFETY IMPROVEMENTS



Waikane Valley Road to
Vicinity of Kahakili Highway

Federal Aid Project No. HSIP-083-1(66)

Scale: 1" = 40' Date: Sept., 2018

SHEET No. 7 OF 9 SHEETS

FED. ROAD DIST. NO.	STATE	FED. AID PROJ. NO.	FISCAL YEAR	SHEET NO.	TOTAL SHEETS
HAWAII	HAW.	HSIP-083-1(66)	2019	18	36

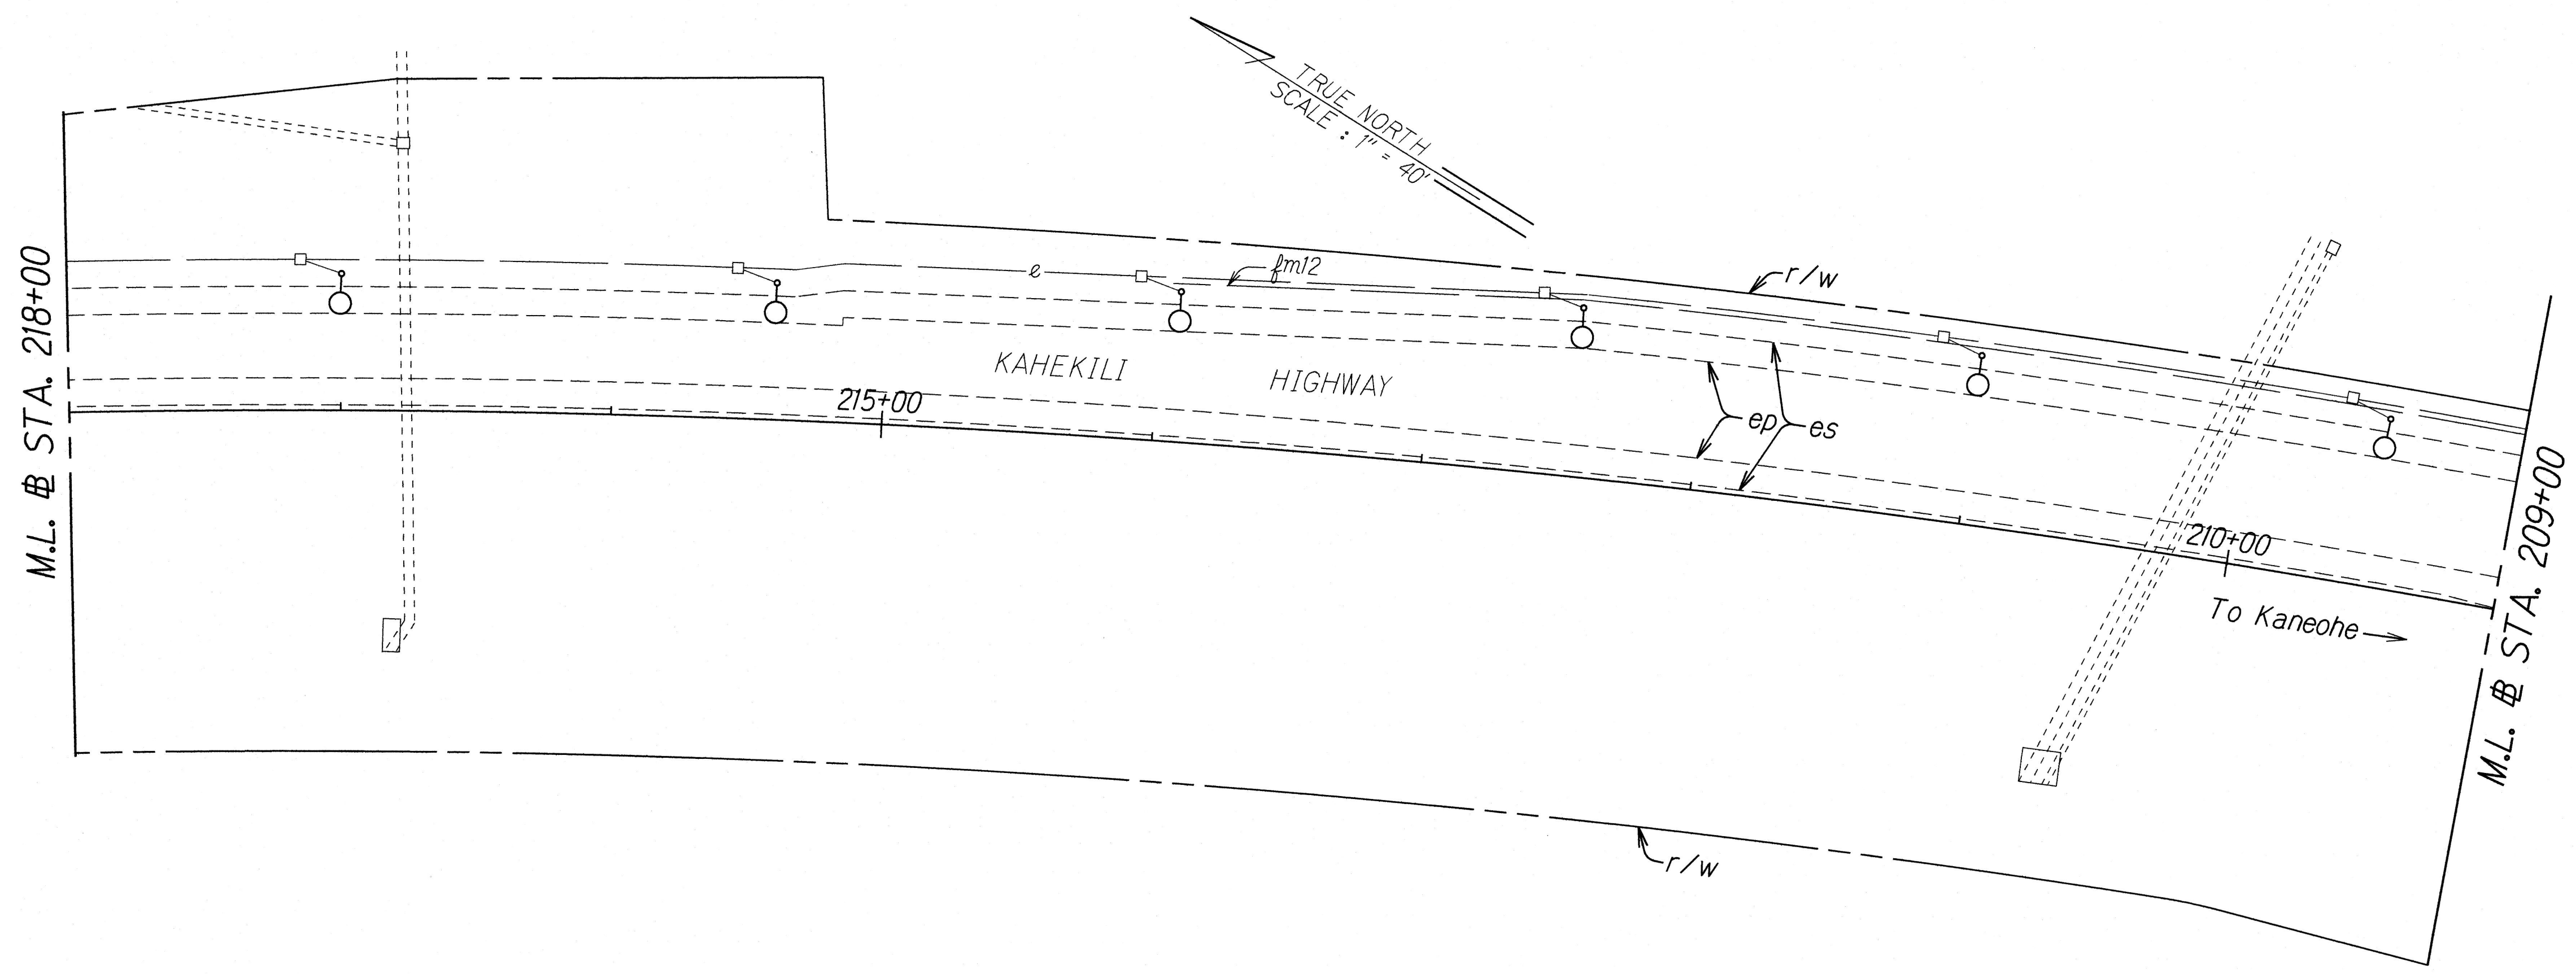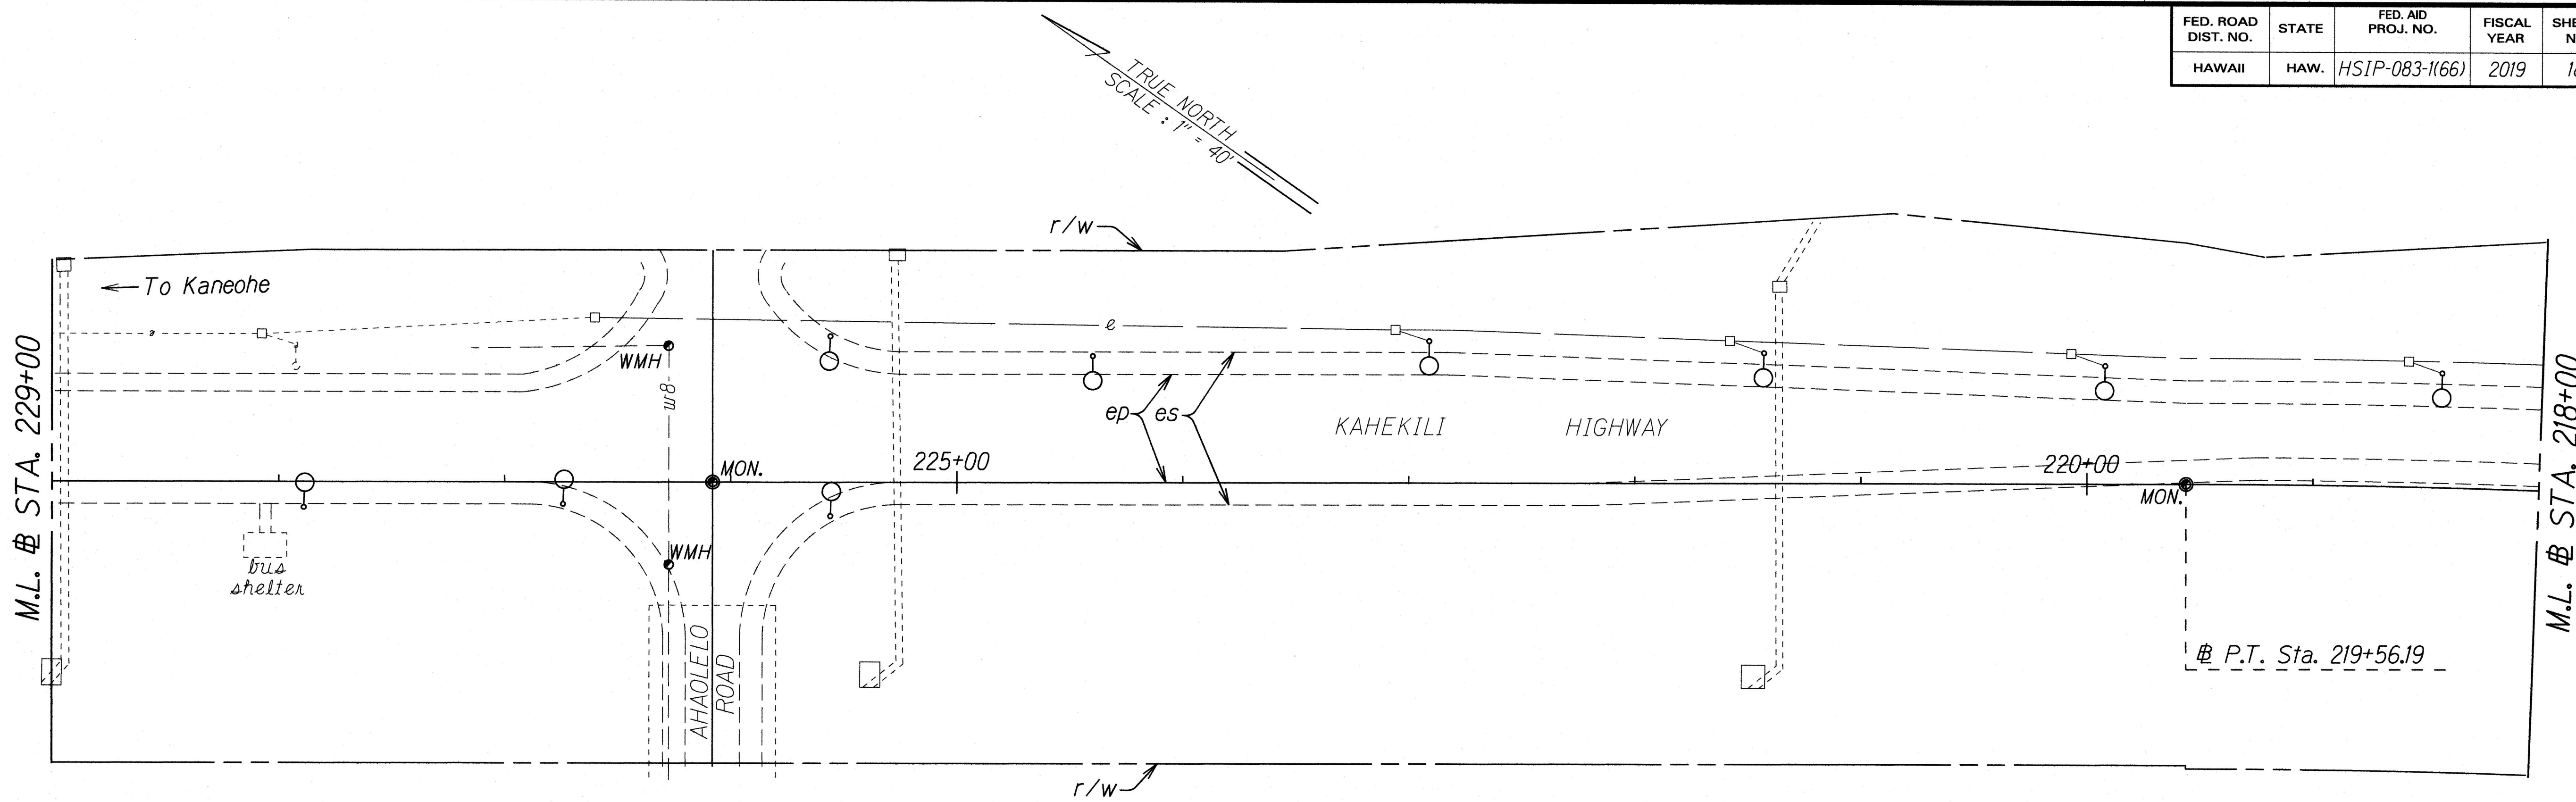

ORIGINAL PLAN	SURVEY PLOTTED BY	DATE
NOTE BOOK	DESIGNED BY	
QUANTITIES BY	CHECKED BY	

STATE OF HAWAII
DEPARTMENT OF TRANSPORTATION
HIGHWAYS DIVISION

ROADWAY PLAN

KAMEHAMEHA HIGHWAY SAFETY IMPROVEMENTS

Waikane Valley Road to
Vicinity of Kahekili Highway

Federal Aid Project No. HSIP-083-1(66)

Scale: 1" = 40' Date: Sept., 2018

