

INDEX TO DRAWINGS	
SHEET NO.	DESCRIPTION
1	TITLE SHEET
2	STANDARD PLANS SUMMARY
3 - 4	GENERAL NOTES & LEGEND
5 - 7	WATER POLLUTION & EROSION CONTROL NOTES
8 - 10	TYPICAL SECTIONS AND DETAILS
11 - 19	ROADWAY PLANS
20 - 36	PAVEMENT MARKING, SIGNING, STRIPING, RUMBLE STRIPS PLANS AND NOTES

STATE OF HAWAII

DEPARTMENT OF TRANSPORTATION

HIGHWAYS DIVISION

HONOLULU, HAWAII

"AS-BUILT"

PLANS FOR

KAMEHAMEHA HIGHWAY SAFETY IMPROVEMENTS




WAIKANE VALLEY ROAD TO VICINITY OF KAHEKILI HIGHWAY

FEDERAL AID PROJECT NO. HSIP-083-1(66)

DISTRICT OF KOOLAUPOKO

ISLAND OF OAHU

FED. ROAD DIST. NO.	STATE	FED. AID PROJ. NO.	FISCAL YEAR	SHEET NO.	TOTAL SHEETS
HAWAII	HAW.	HSIP-083-1(66)	2019	1	36

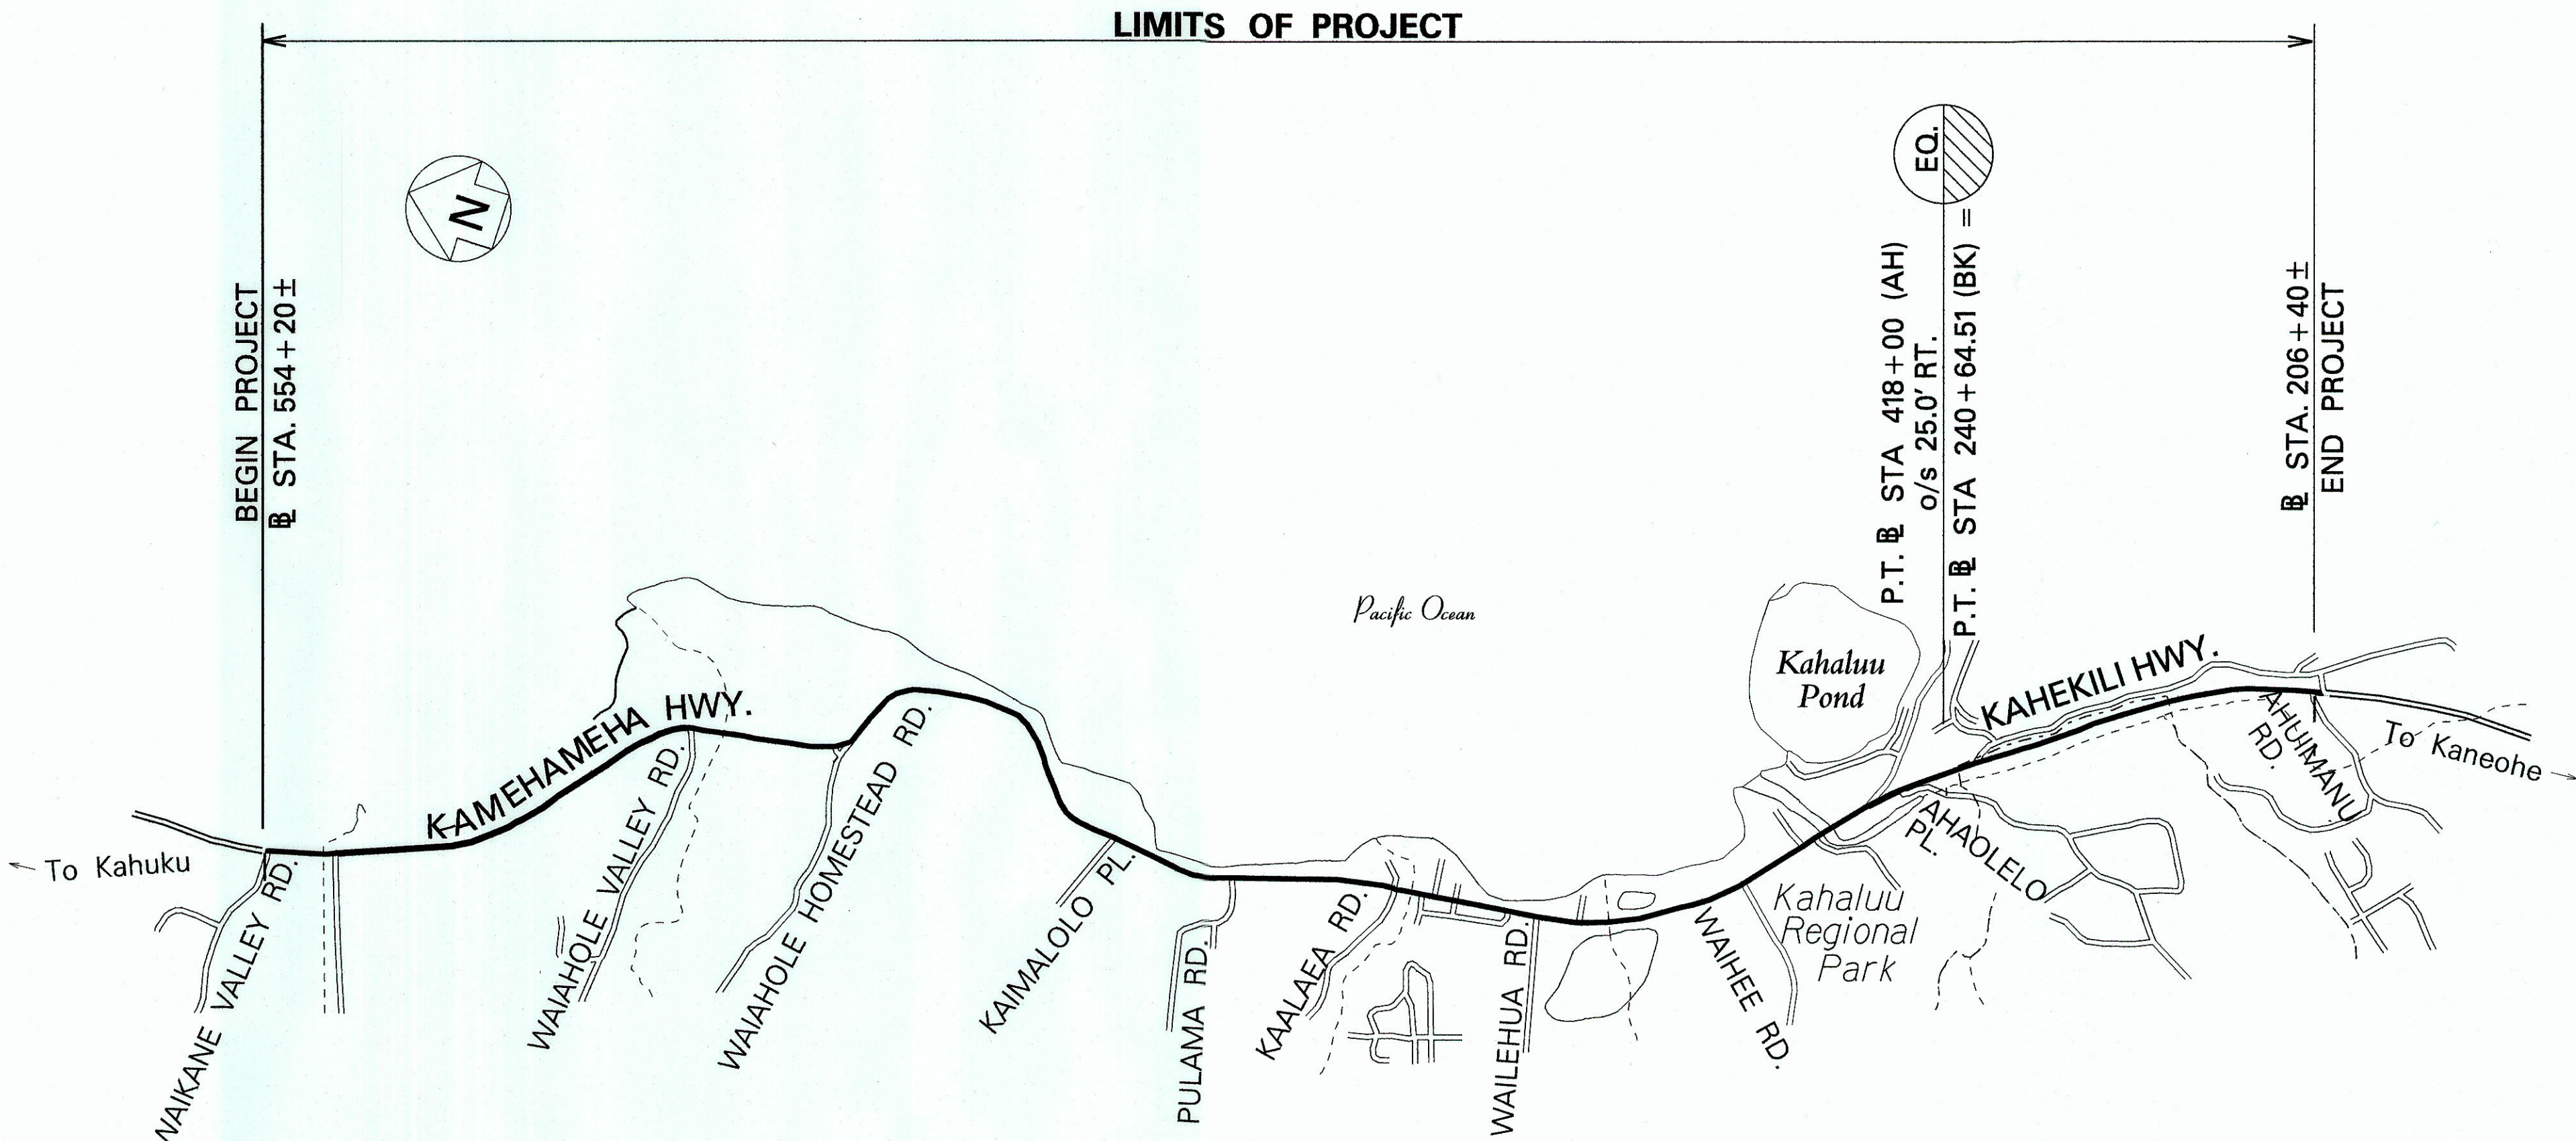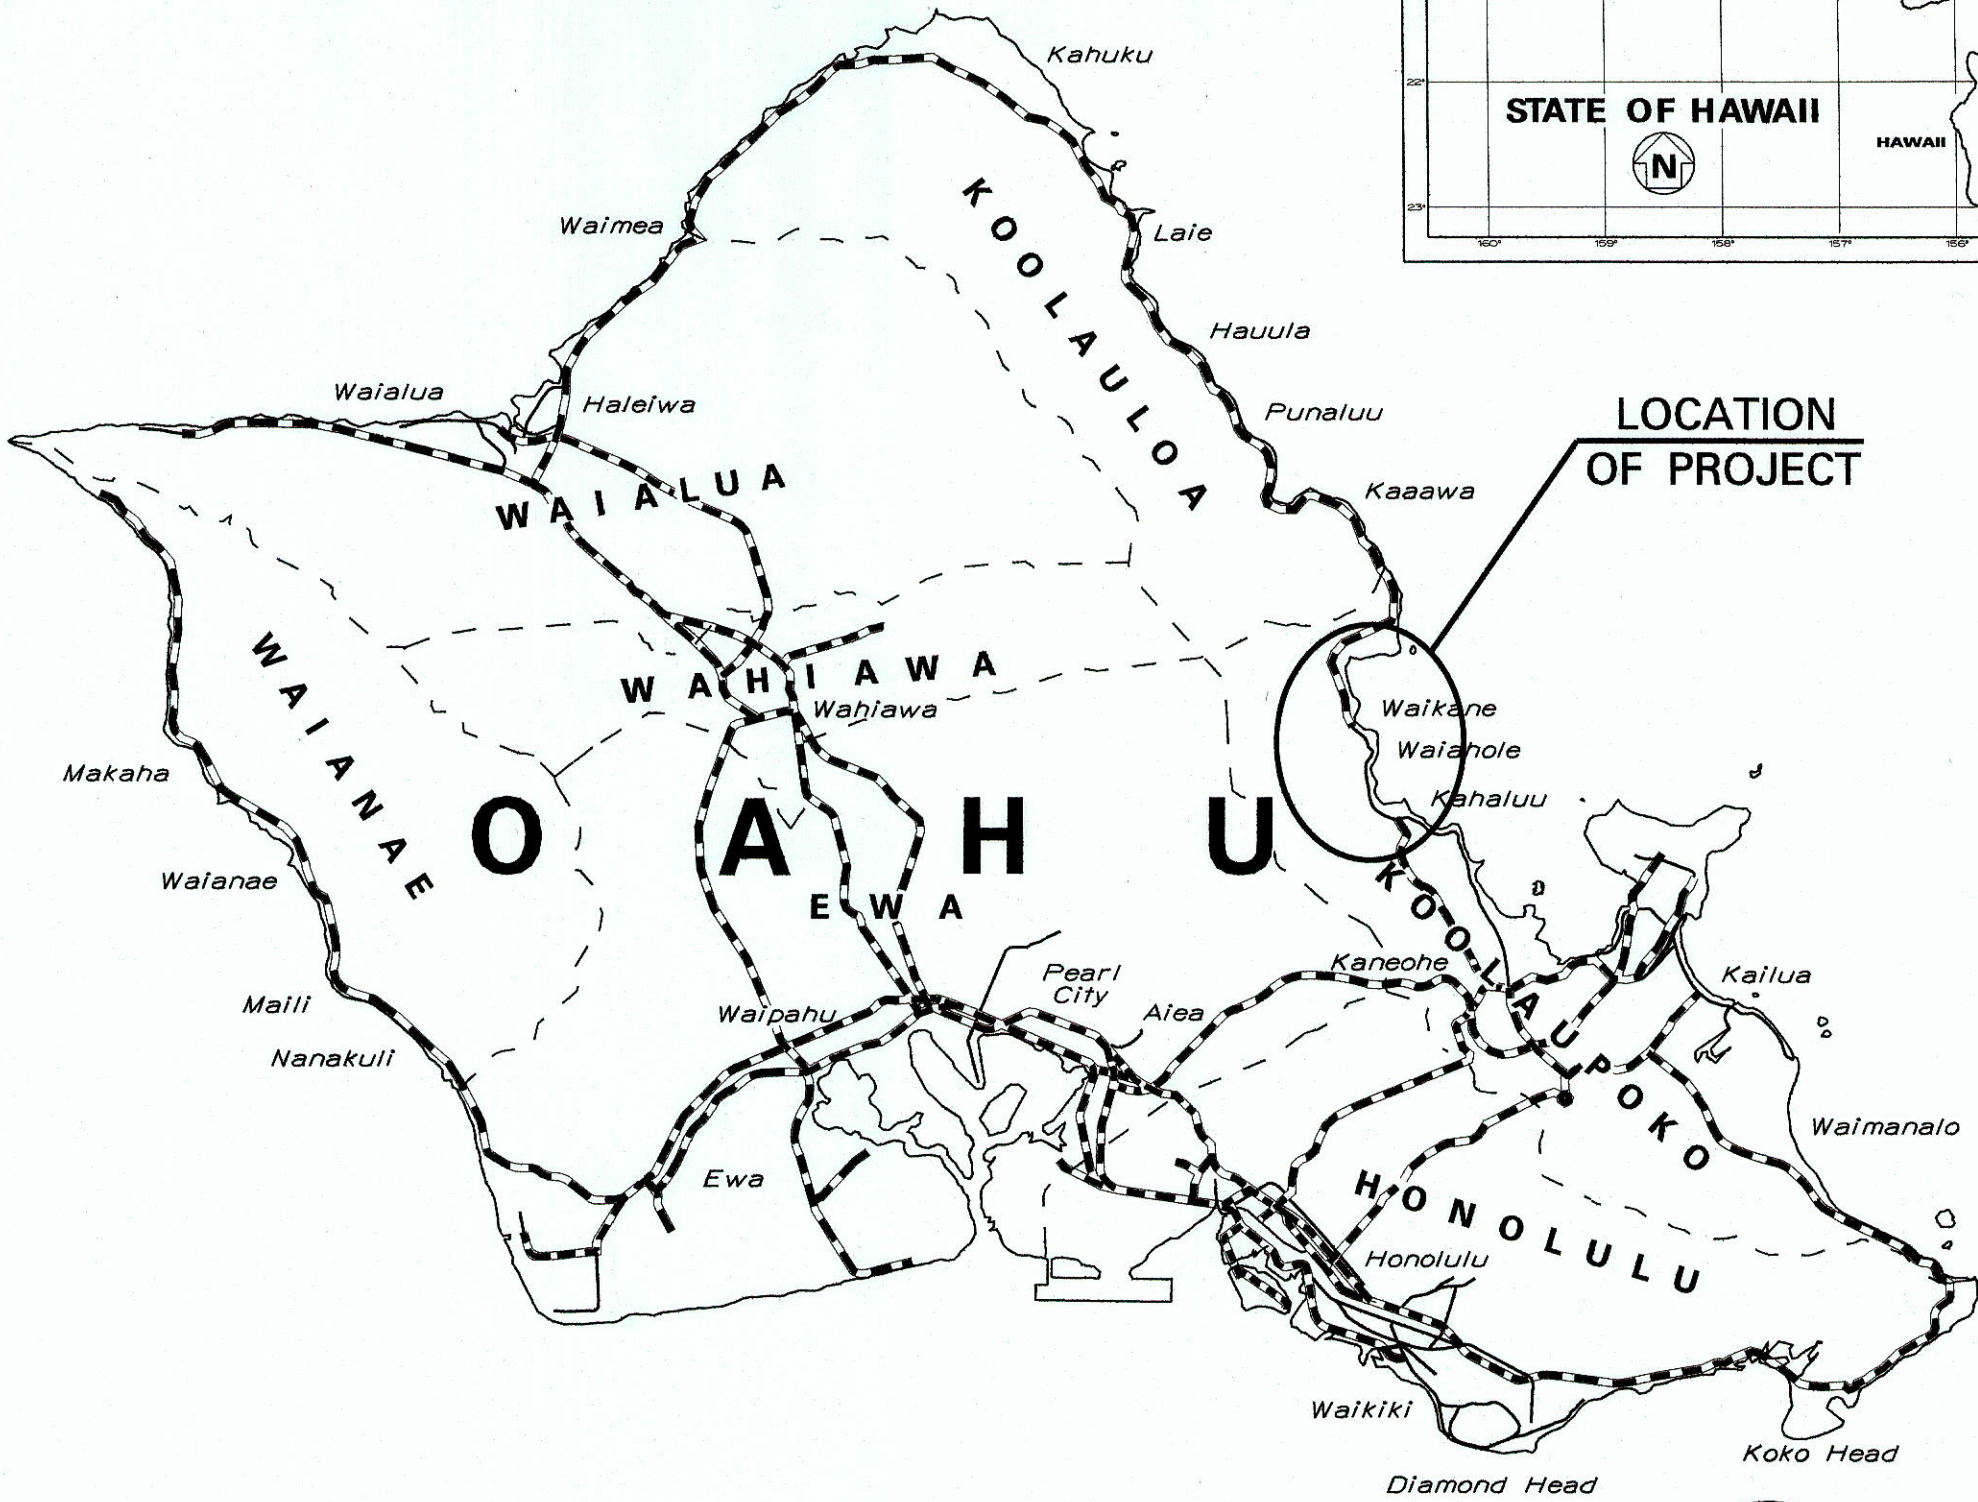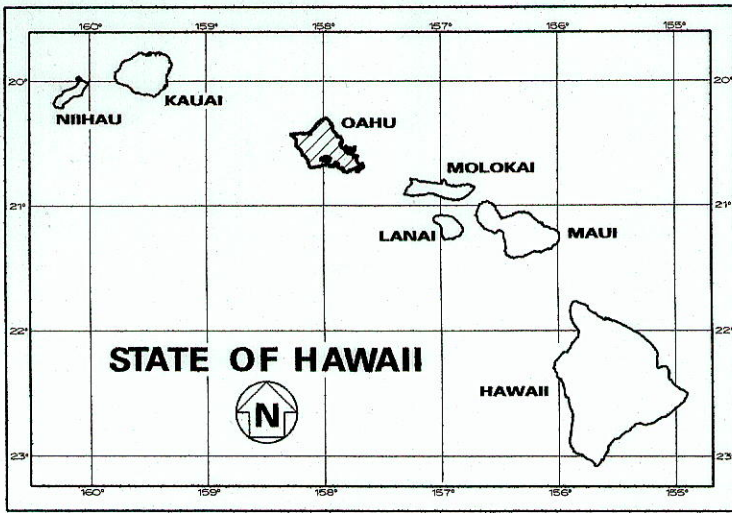


----- FEDERAL AID PROJECTS PREVIOUSLY CONSTRUCTED OR UNDER CONSTRUCTION

MILE POST 36.90 TO MILE POST 33.80

	Polinalina Rd to Waihole Valley Rd	Waihole Valley Rd to Kahekili Hwy	Kahekili Hwy to Ahuimanu Pl
ADT (2009)	13,910	18,000	18,520
ADT (2019)	15,400	18,760	19,620
DHV	1,230	1,500	1,570
D	60/40	60/40	55/45
T24	6.0%	4.5%	6.0%
K	8.0%	8.0%	8.0%
T	3.5%	3.0%	5.5%

DESIGNED BY
HWY D
MANAGED BY
HWY DD
692-7570
PHONE
Sept. 2018
DATE

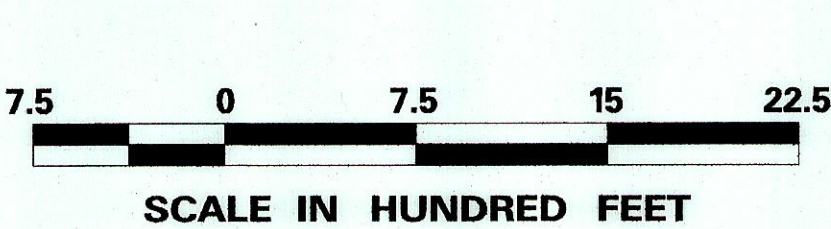

LAYOUT PLAN

GROSS LENGTH OF PROJECT..... 3.10 MILES

NET LENGTH OF PROJECT..... 3.10 MILES

CHANGES MADE DURING CONSTRUCTION HAVE BEEN INCORPORATED ON THESE PLANS EXCEPT CHANGES IN THE ORIGINAL THEORETICAL QUANTITIES. FOR ACTUAL QUANTITIES, REFER TO PROJECT LEDGER AND/OR COMPUTATION BOOK.

Matthew Monte
RESIDENT ENGINEER

3/31/2021
DATE

DEPARTMENT OF TRANSPORTATION
STATE OF HAWAII

APPROVED:

Matthew Monte
DIR. OF TRANSPORTATION

9/25/18
DATE