


INDEX TO DRAWINGS	
SHEET NO.	DESCRIPTION
1	TITLE SHEET
2	GENERAL NOTES
3	TYPICAL SECTIONS
4	ADJUSTMENT & PRESERVING OF MONUMENTS
5-7	PLANS
* 8-11	GUARDRAIL & PAVEMENT MARKINGS
** 12-22	STANDARD DETAILS
23-24	BARRICADES DETAIL
* C.O. 10 S-1, C.O. 10 S-2	
** C.O. 22 S-1, C.O. 22 S-2, C.O. 22 S-3, C.O. 22 S-4	

NEW TOTAL SHEET COUNT = 30

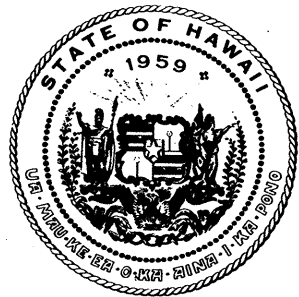

STATE OF HAWAII

DEPARTMENT OF TRANSPORTATION

HIGHWAYS DIVISION

HONOLULU, HAWAII

"AS-BUILT"

PLANS FOR

KAMEHAMEHA HIGHWAY

RESURFACING

KAHIKO STREET TO PALI HIGHWAY

FEDERAL AID PROJECT NO. FR-083-I(15)

DISTRICT OF KOOLAUPOKO




ISLAND OF OAHU

ALL CHANGES MADE DURING CONSTRUCTION HAVE BEEN INCORPORATED ON THESE PLANS IN RED EXCEPT CHANGES IN THE ORIGINAL THEORETICAL QUANTITIES. FOR ACTUAL QUANTITIES, REFER TO PROJECT LEDGER AND/OR COMPUTATION BOOK.


Robert Y. Muroaka
RESIDENT ENGINEER

4-13-82
DATE

FED. ROAD DIST. NO.	STATE	PROJ. NO.	FISCAL YEAR	SHEET NO.	TOTAL SHEETS
HAWAII	HAW.	FR-083-I(15)	1981	1	24

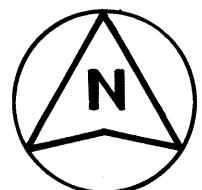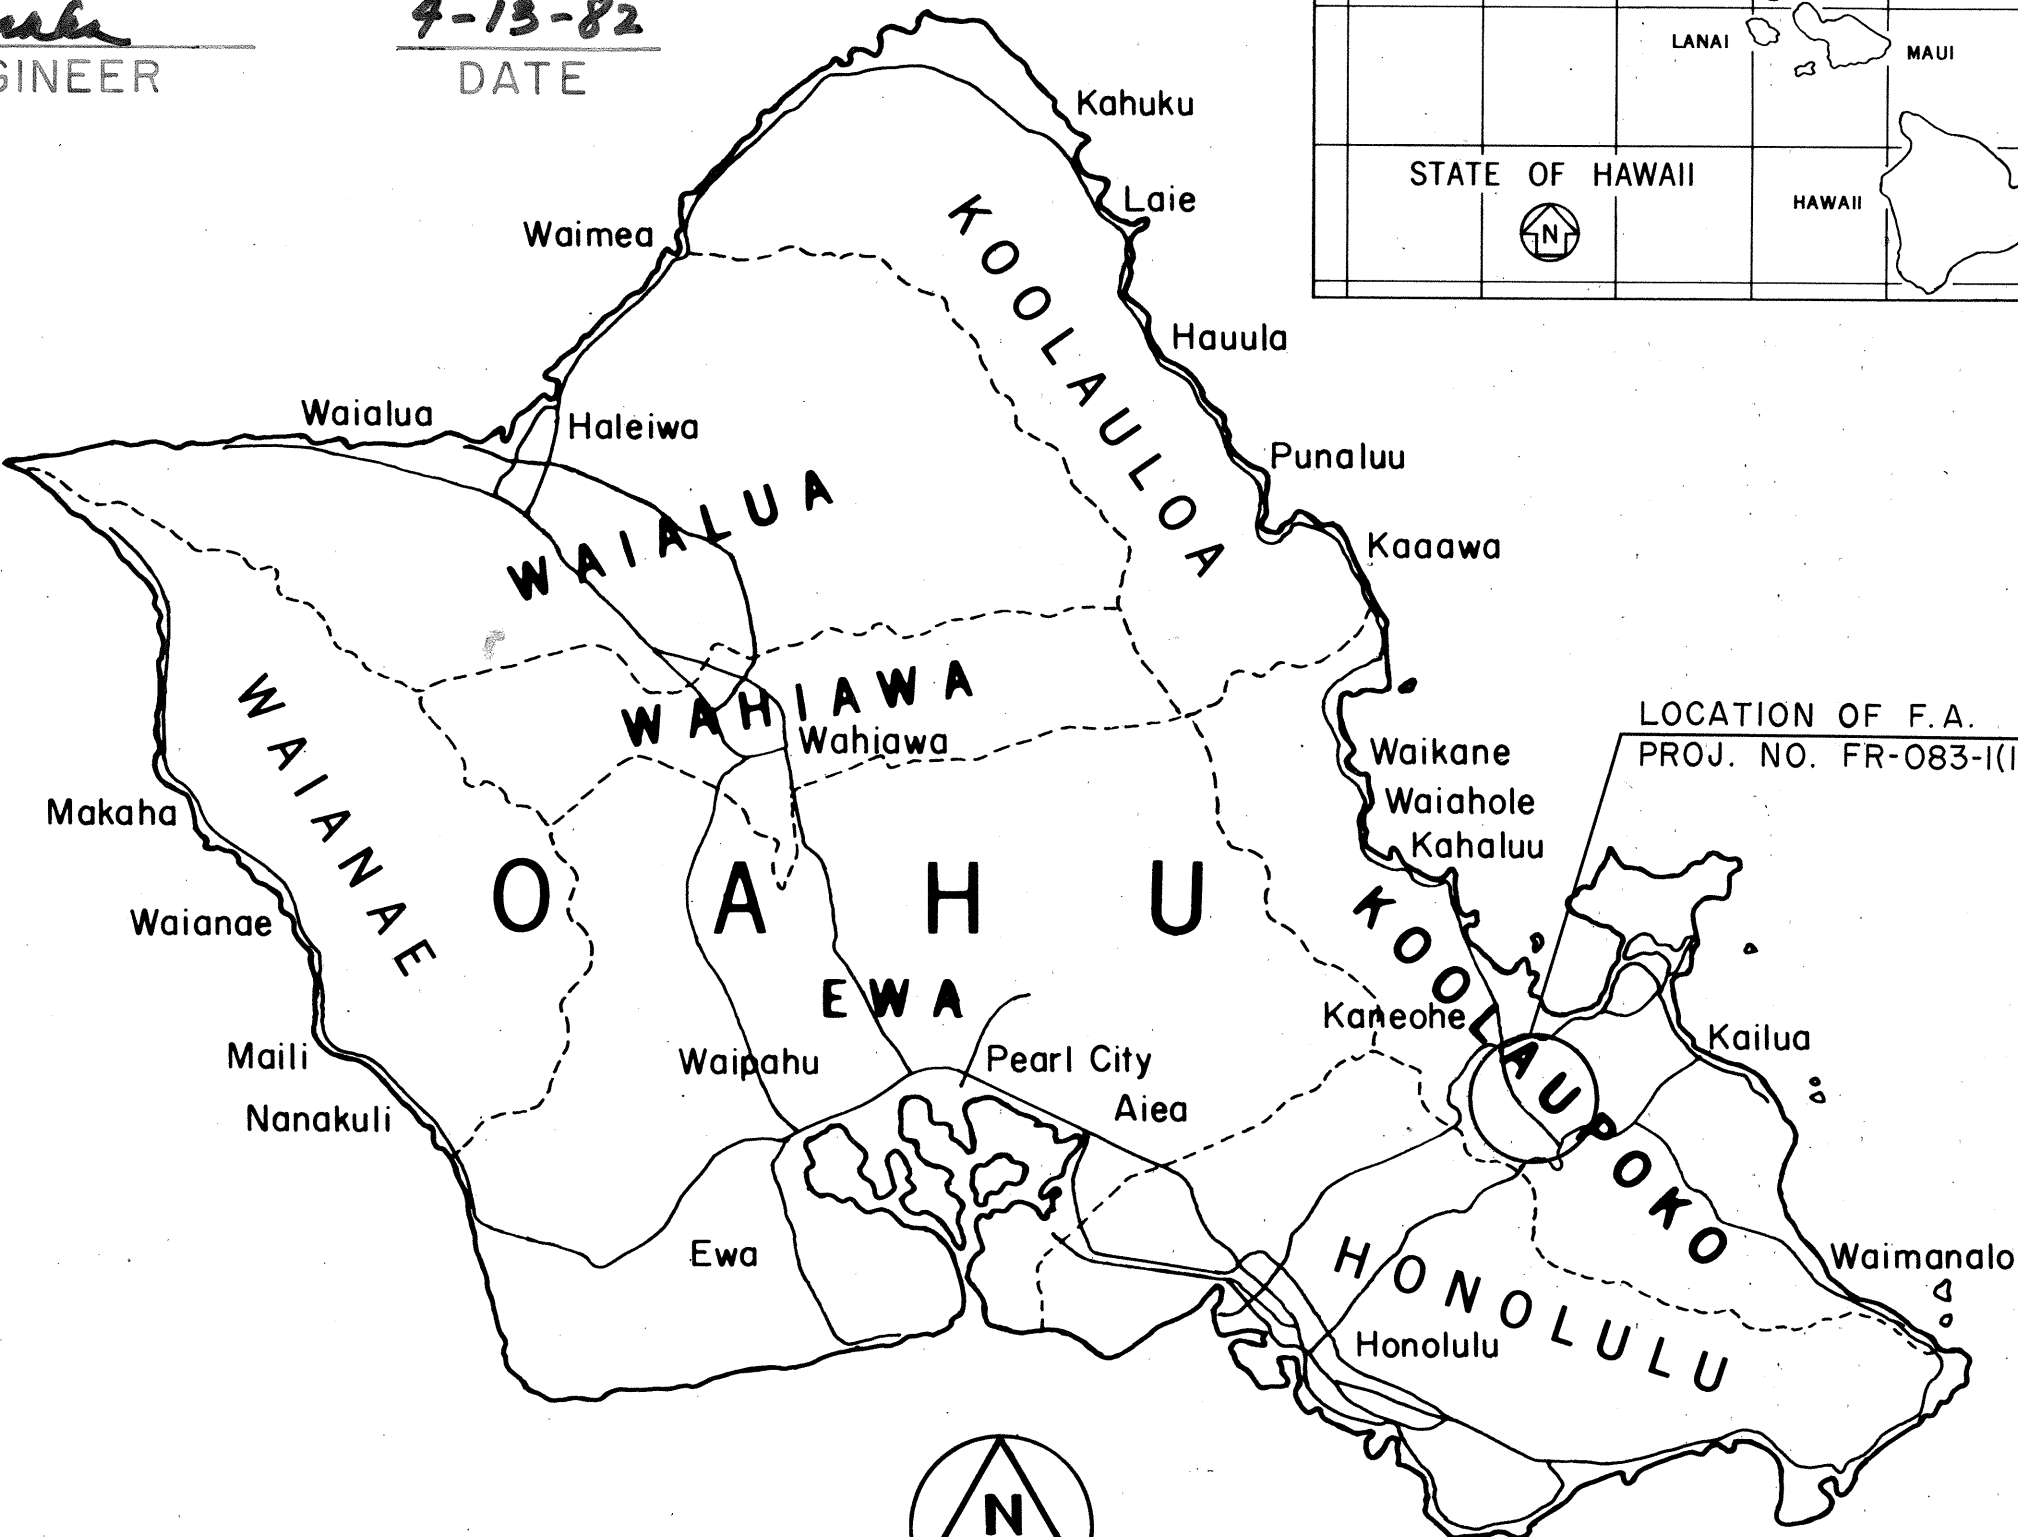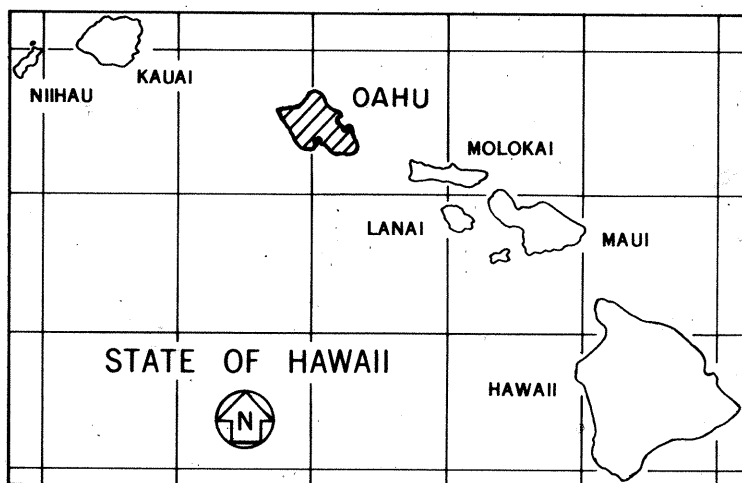

4 0 4 8
SCALE IN MILES

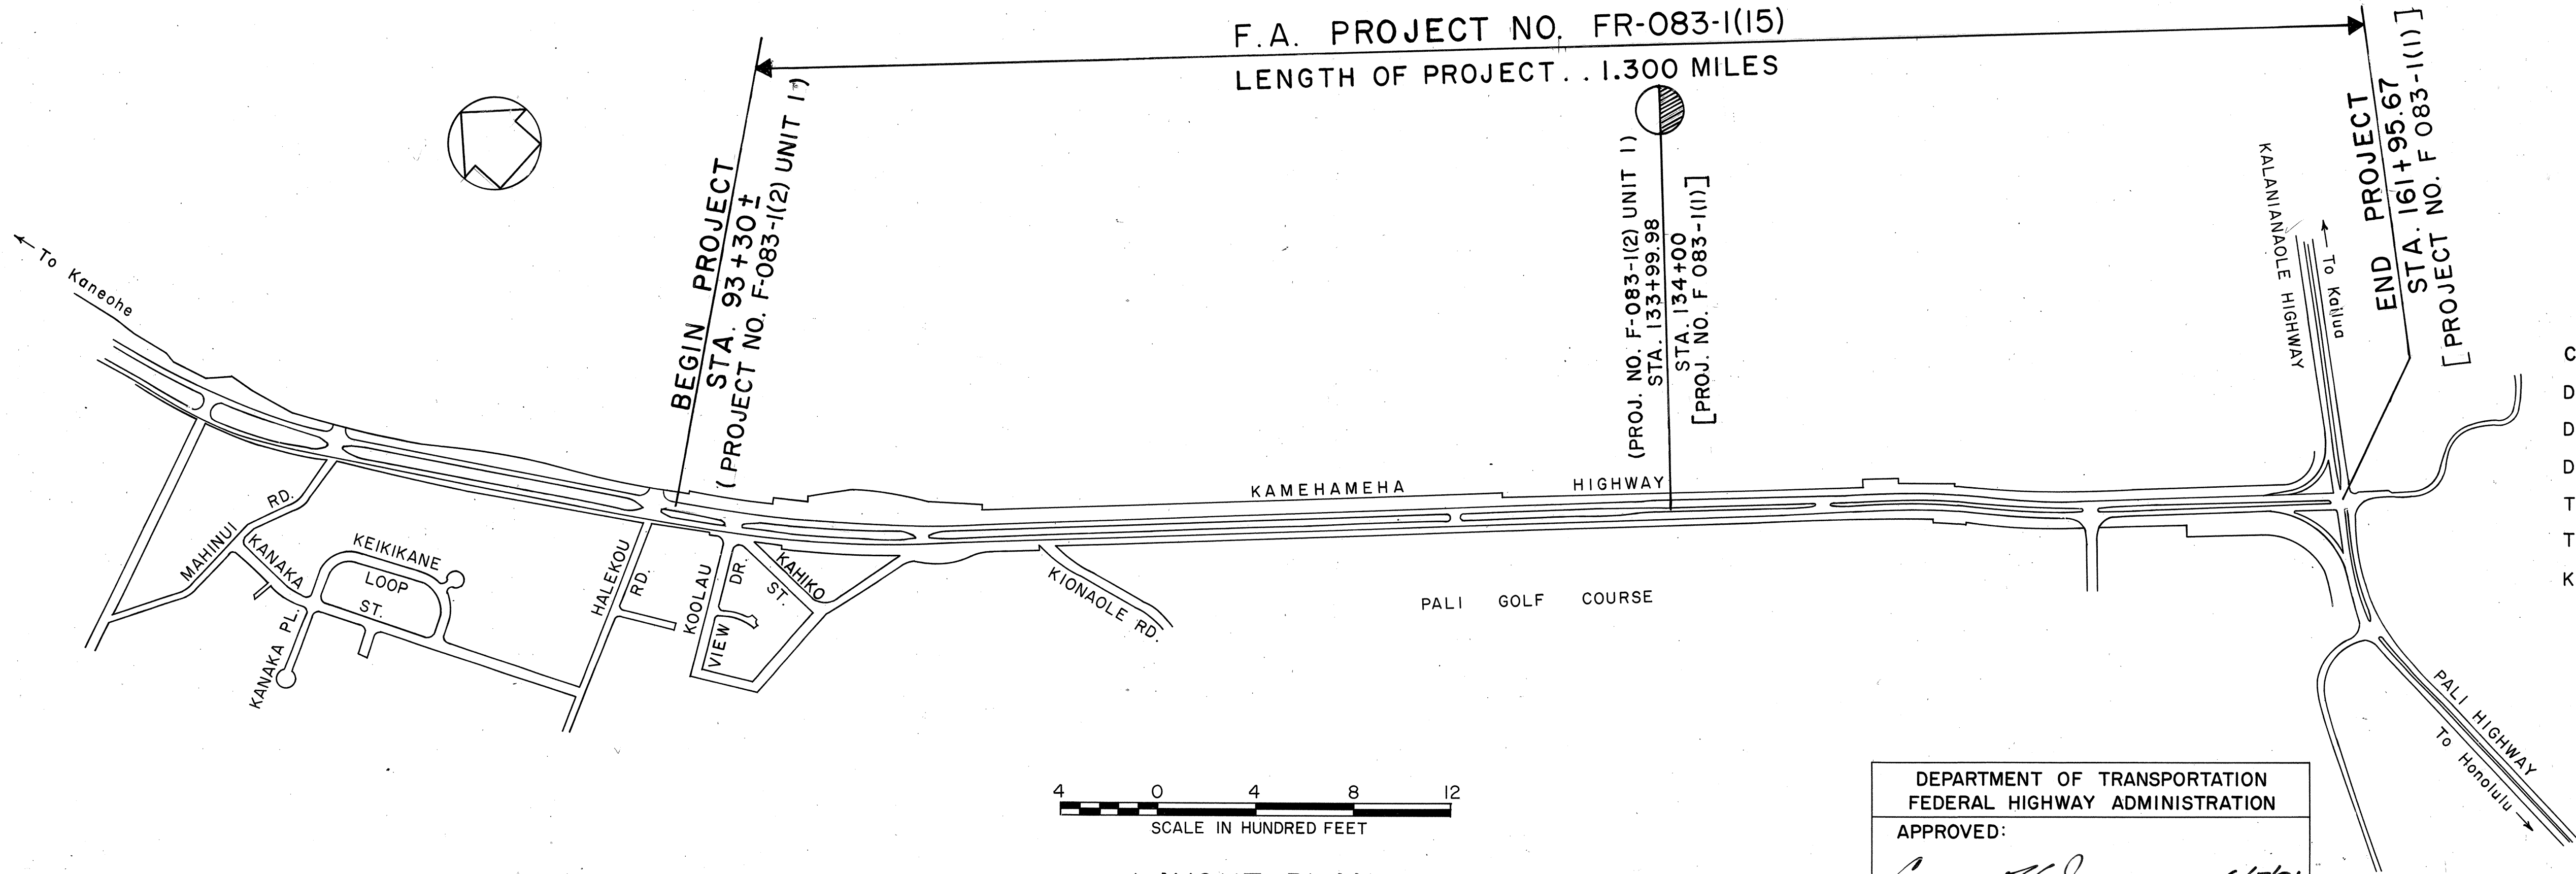

DESIGN DESIGNATION

CURRENT ADT (1981)	21,200
DESIGN ADT (2001)	23,800
DHV	2,500
D	55/45
T	2.5%
T ₂₄	4.5%
K	10.5%

UNIT "E"
DESIGNED BY
A. Yamaguchi
P. S. & E. BY
548-4125
PHONE
5/29/81
DATE

LAYOUT PLAN

DEPARTMENT OF TRANSPORTATION
FEDERAL HIGHWAY ADMINISTRATION
APPROVED:
Cannon H. Jones
DIVISION ADMINISTRATOR
6/5/81
DATE

DEPARTMENT OF TRANSPORTATION
STATE OF HAWAII
APPROVED:
James R. Canas
DIR. OF TRANSPORTATION
6/5/81
DATE