
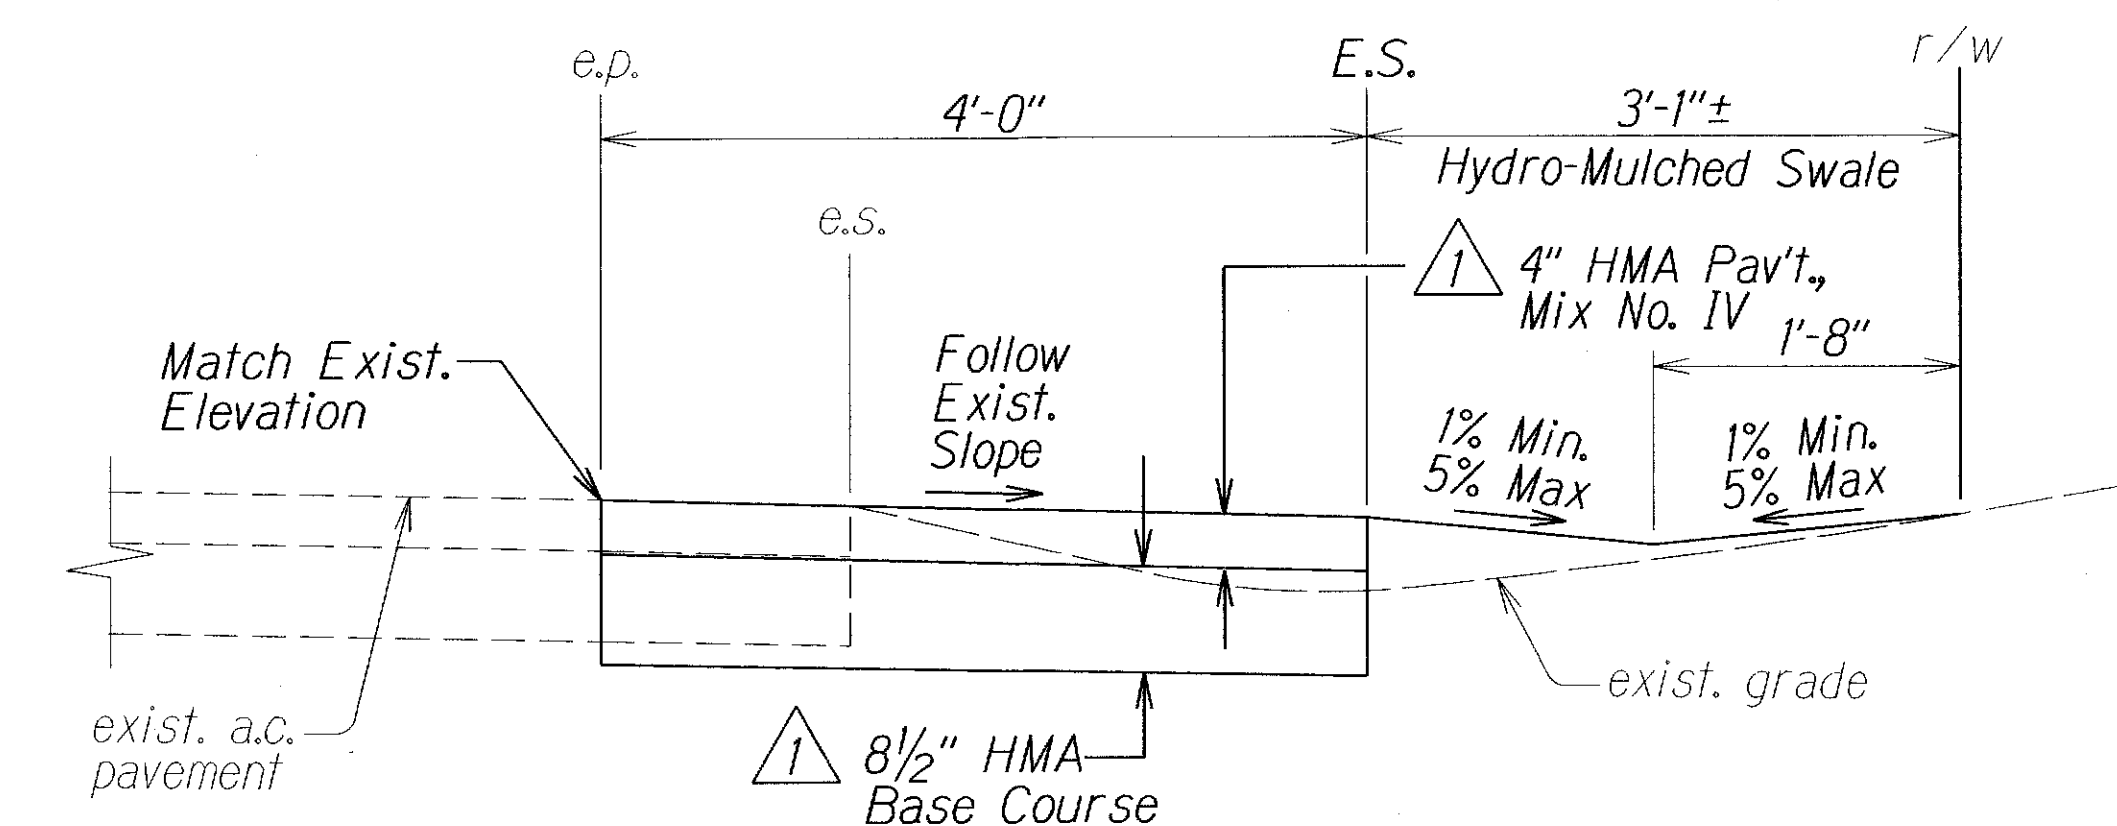
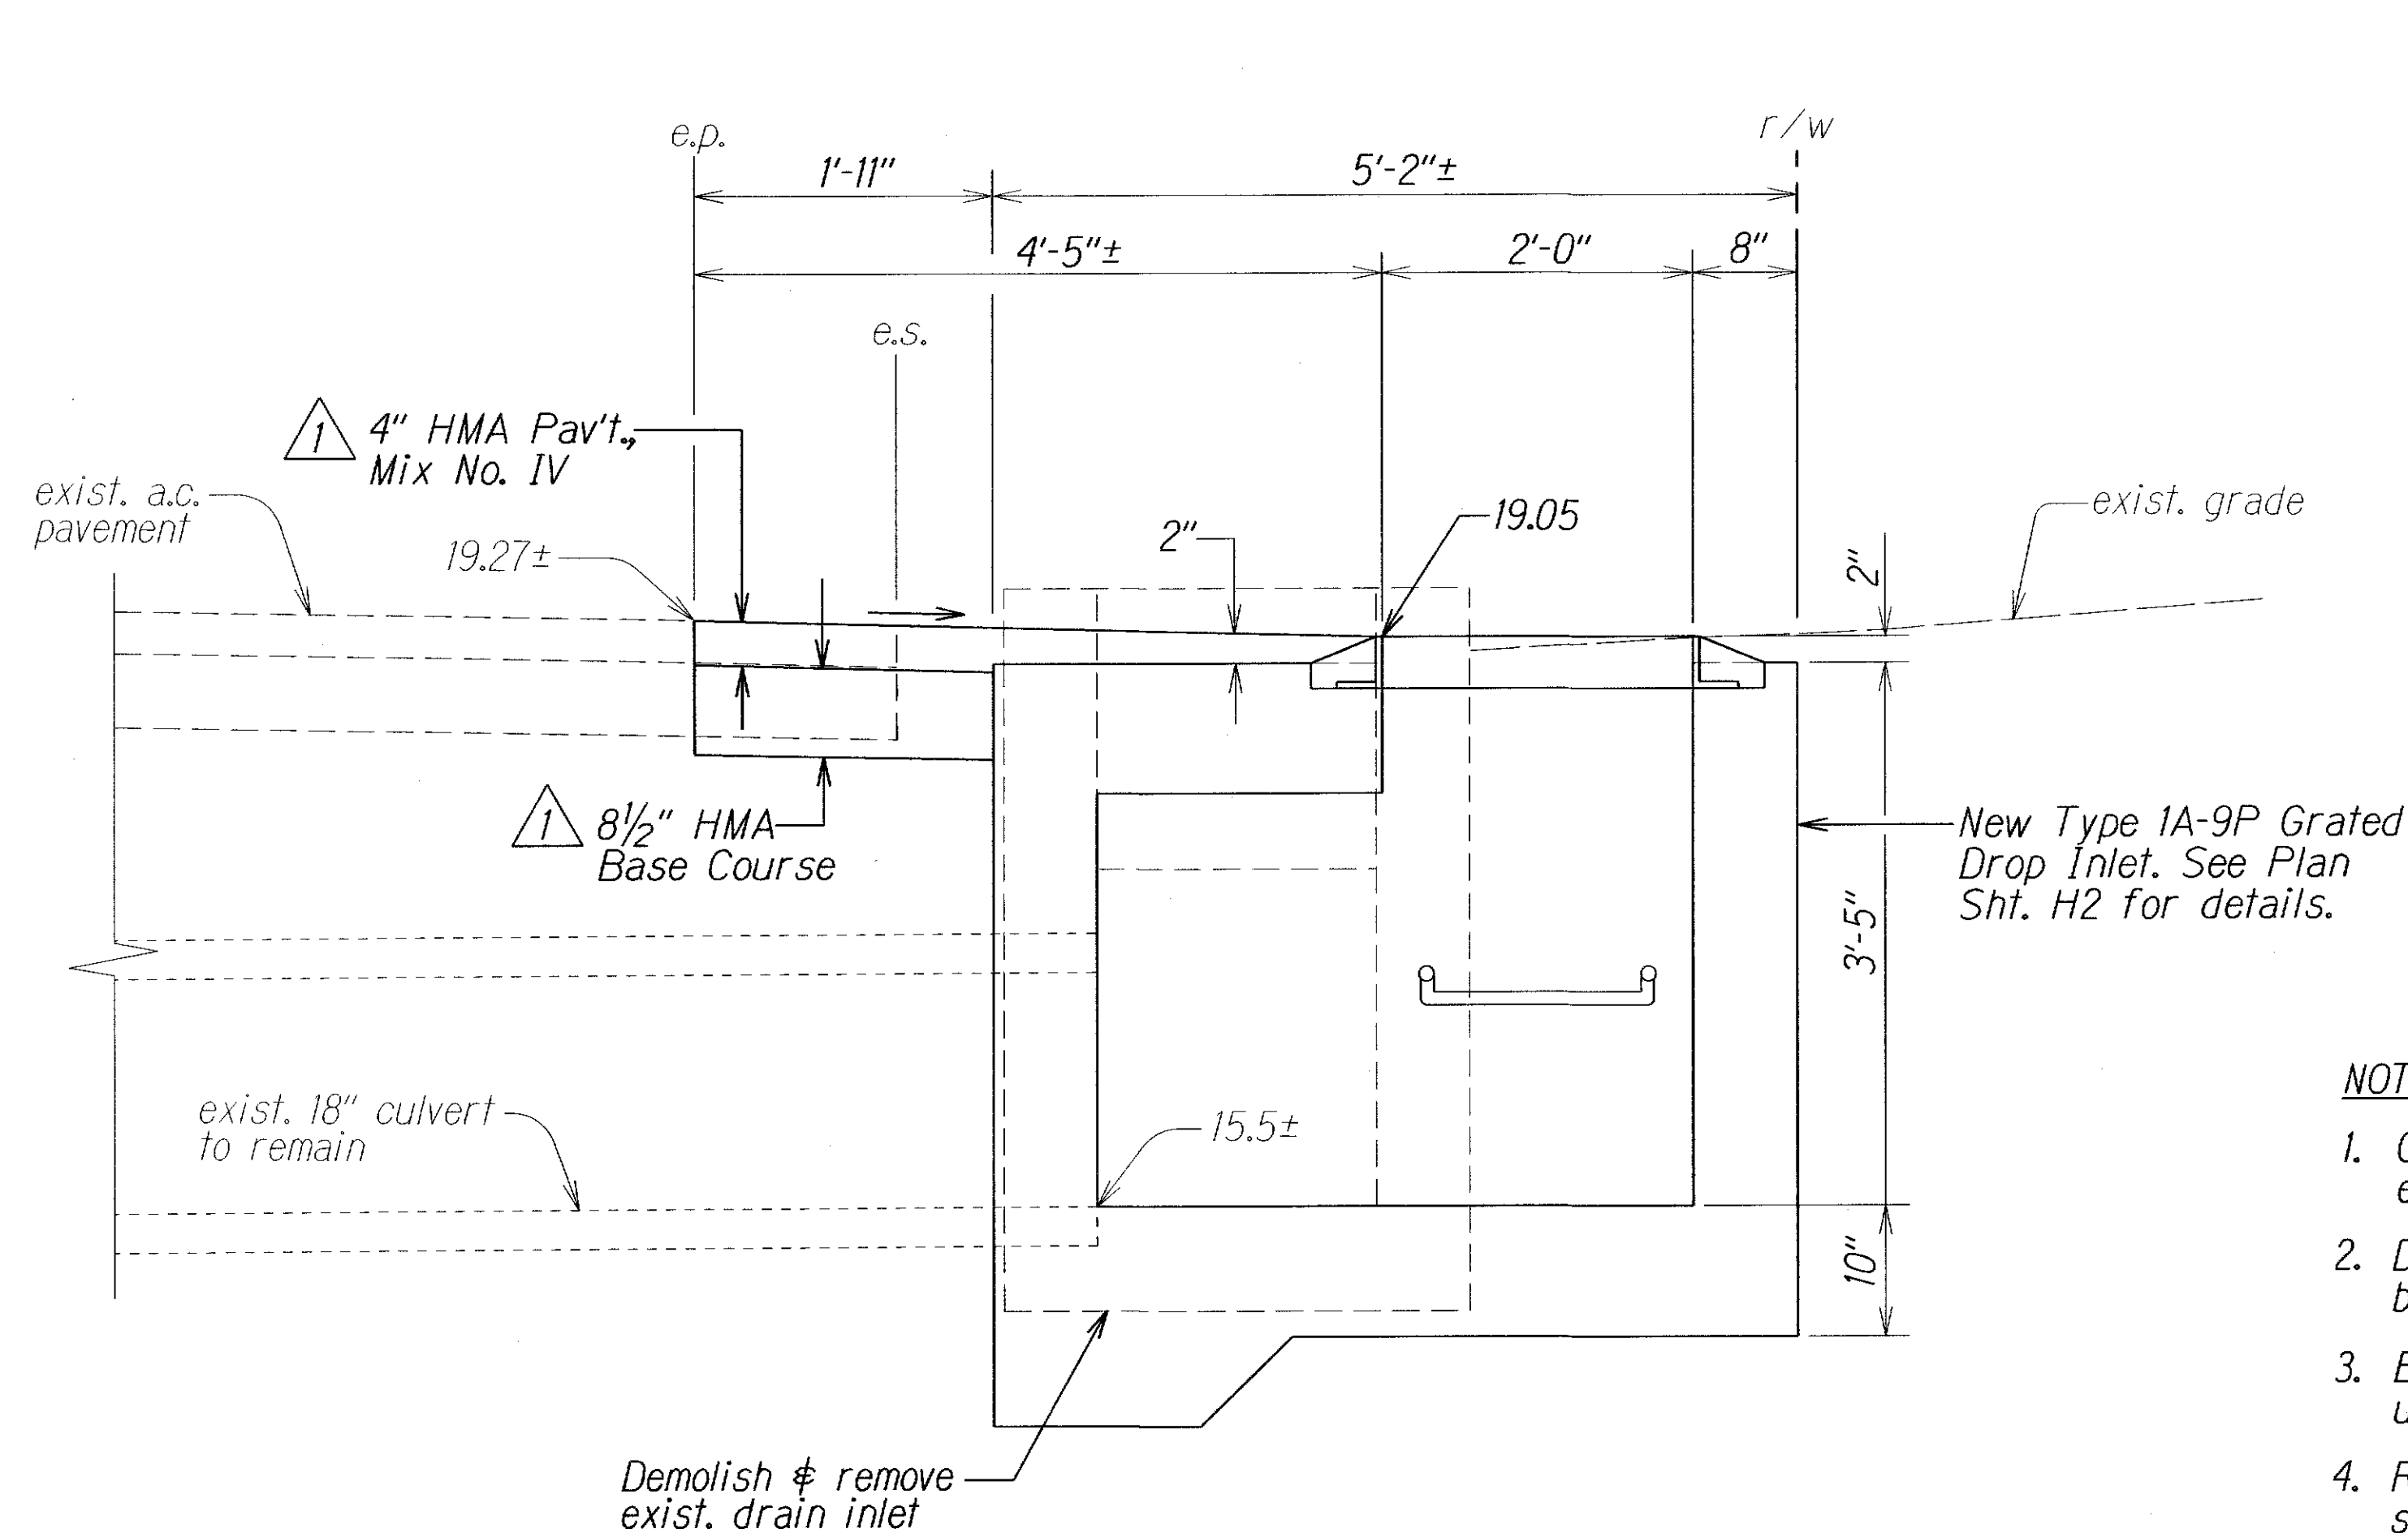


FED. ROAD DIST. NO.	STATE	FED. AID PROJ. NO.	FISCAL YEAR	SHEET NO.	TOTAL SHEETS
HAWAII	HAW.	NH-083-1(072)	2015	ADD. 50	107

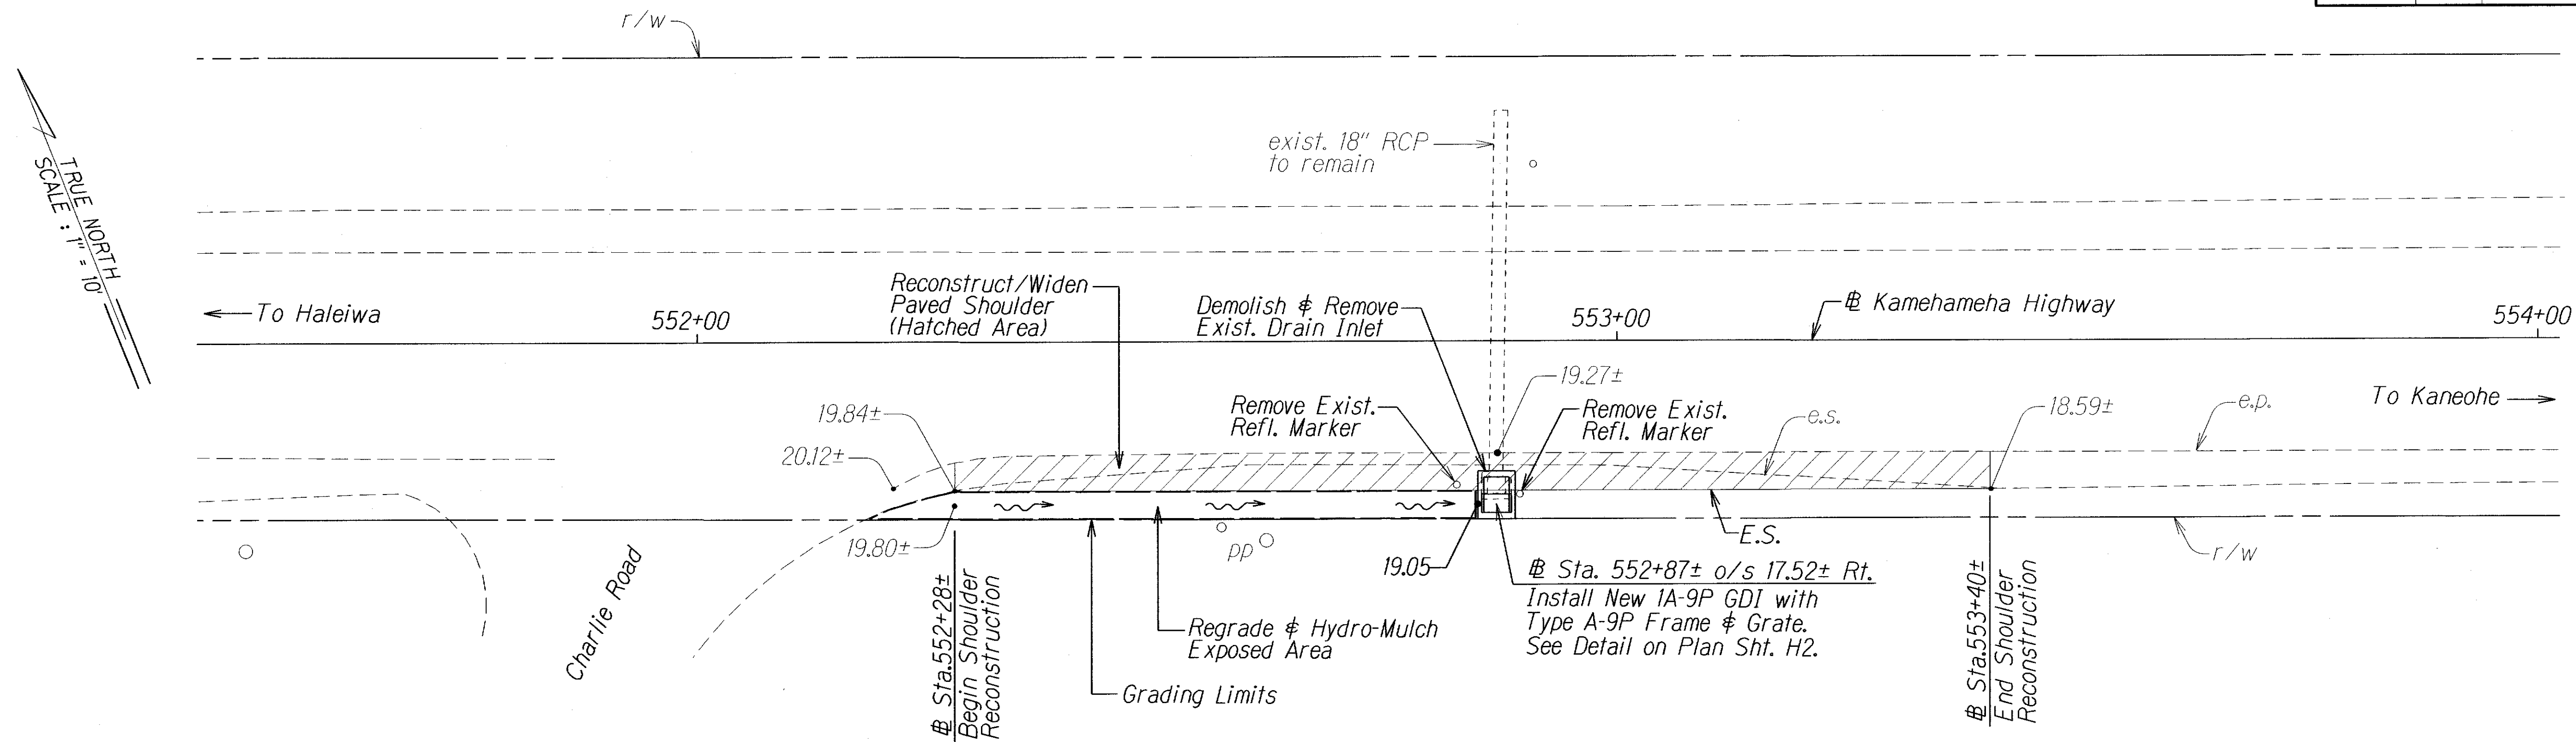

NOTES:

- Contractor shall verify in the field the actual distance between end of existing 18" reinforced concrete pipe and the State R/W.
- Demolishing, removing and disposing of existing paved shoulder shall be paid for under contract Item No. 203.0100 - Roadway Excavation.
- Excavation for new or widened paved shoulder shall be paid for under contract Item No. 203.0100 - Roadway Excavation.
- Regrading, including excavation and backfilling, for the new grassed swale shall be paid for under contract Item No. 641.0100 - Hydro-Mulch Seeding.
- Demolishing, removing and disposing of existing drain inlet and reflector marker with post shall be considered incidental to contract Item No. 604.0310 - Type 1A-9P Grated Drop Inlet.




	6/1/15	Revised Thicknesses of HMA Pav't, Mix No. IV and HMA Base Course
DATE	REVISION	
STATE OF HAWAII DEPARTMENT OF TRANSPORTATION HIGHWAYS DIVISION <u>DRAINAGE PLAN & DETAILS</u> <u>KAMEHAMEHA HIGHWAY RESURFACING</u> <i><u>Dairy Road to Laiewai Bridge</u></i> <i><u>Federal-Aid Project No. NH-083-1(072)</u></i> Scale: As Shown Date: May, 2015 SHEET No. <i>HI</i> OF <i>2</i> SHEETS		

SHOULDER CONSTRUCTION AT INLET LOCATION
Scale: 1"=1'-0"

**TYPICAL SECTION
SHOULDER & SWALE CONSTRUCTION**
Scale: 1"=1'-0"

ORIGINAL PLAN	DATE
DESIGNED BY	
CHECKED BY	
NOTED BY	
QUANTITIES BY	
DATE	

FED. ROAD DIST. NO.	STATE	FED. AID PROJ. NO.	FISCAL YEAR	SHEET NO.	TOTAL SHEETS
HAWAII	HAW.	NH-083-1(072)	2015	51	107

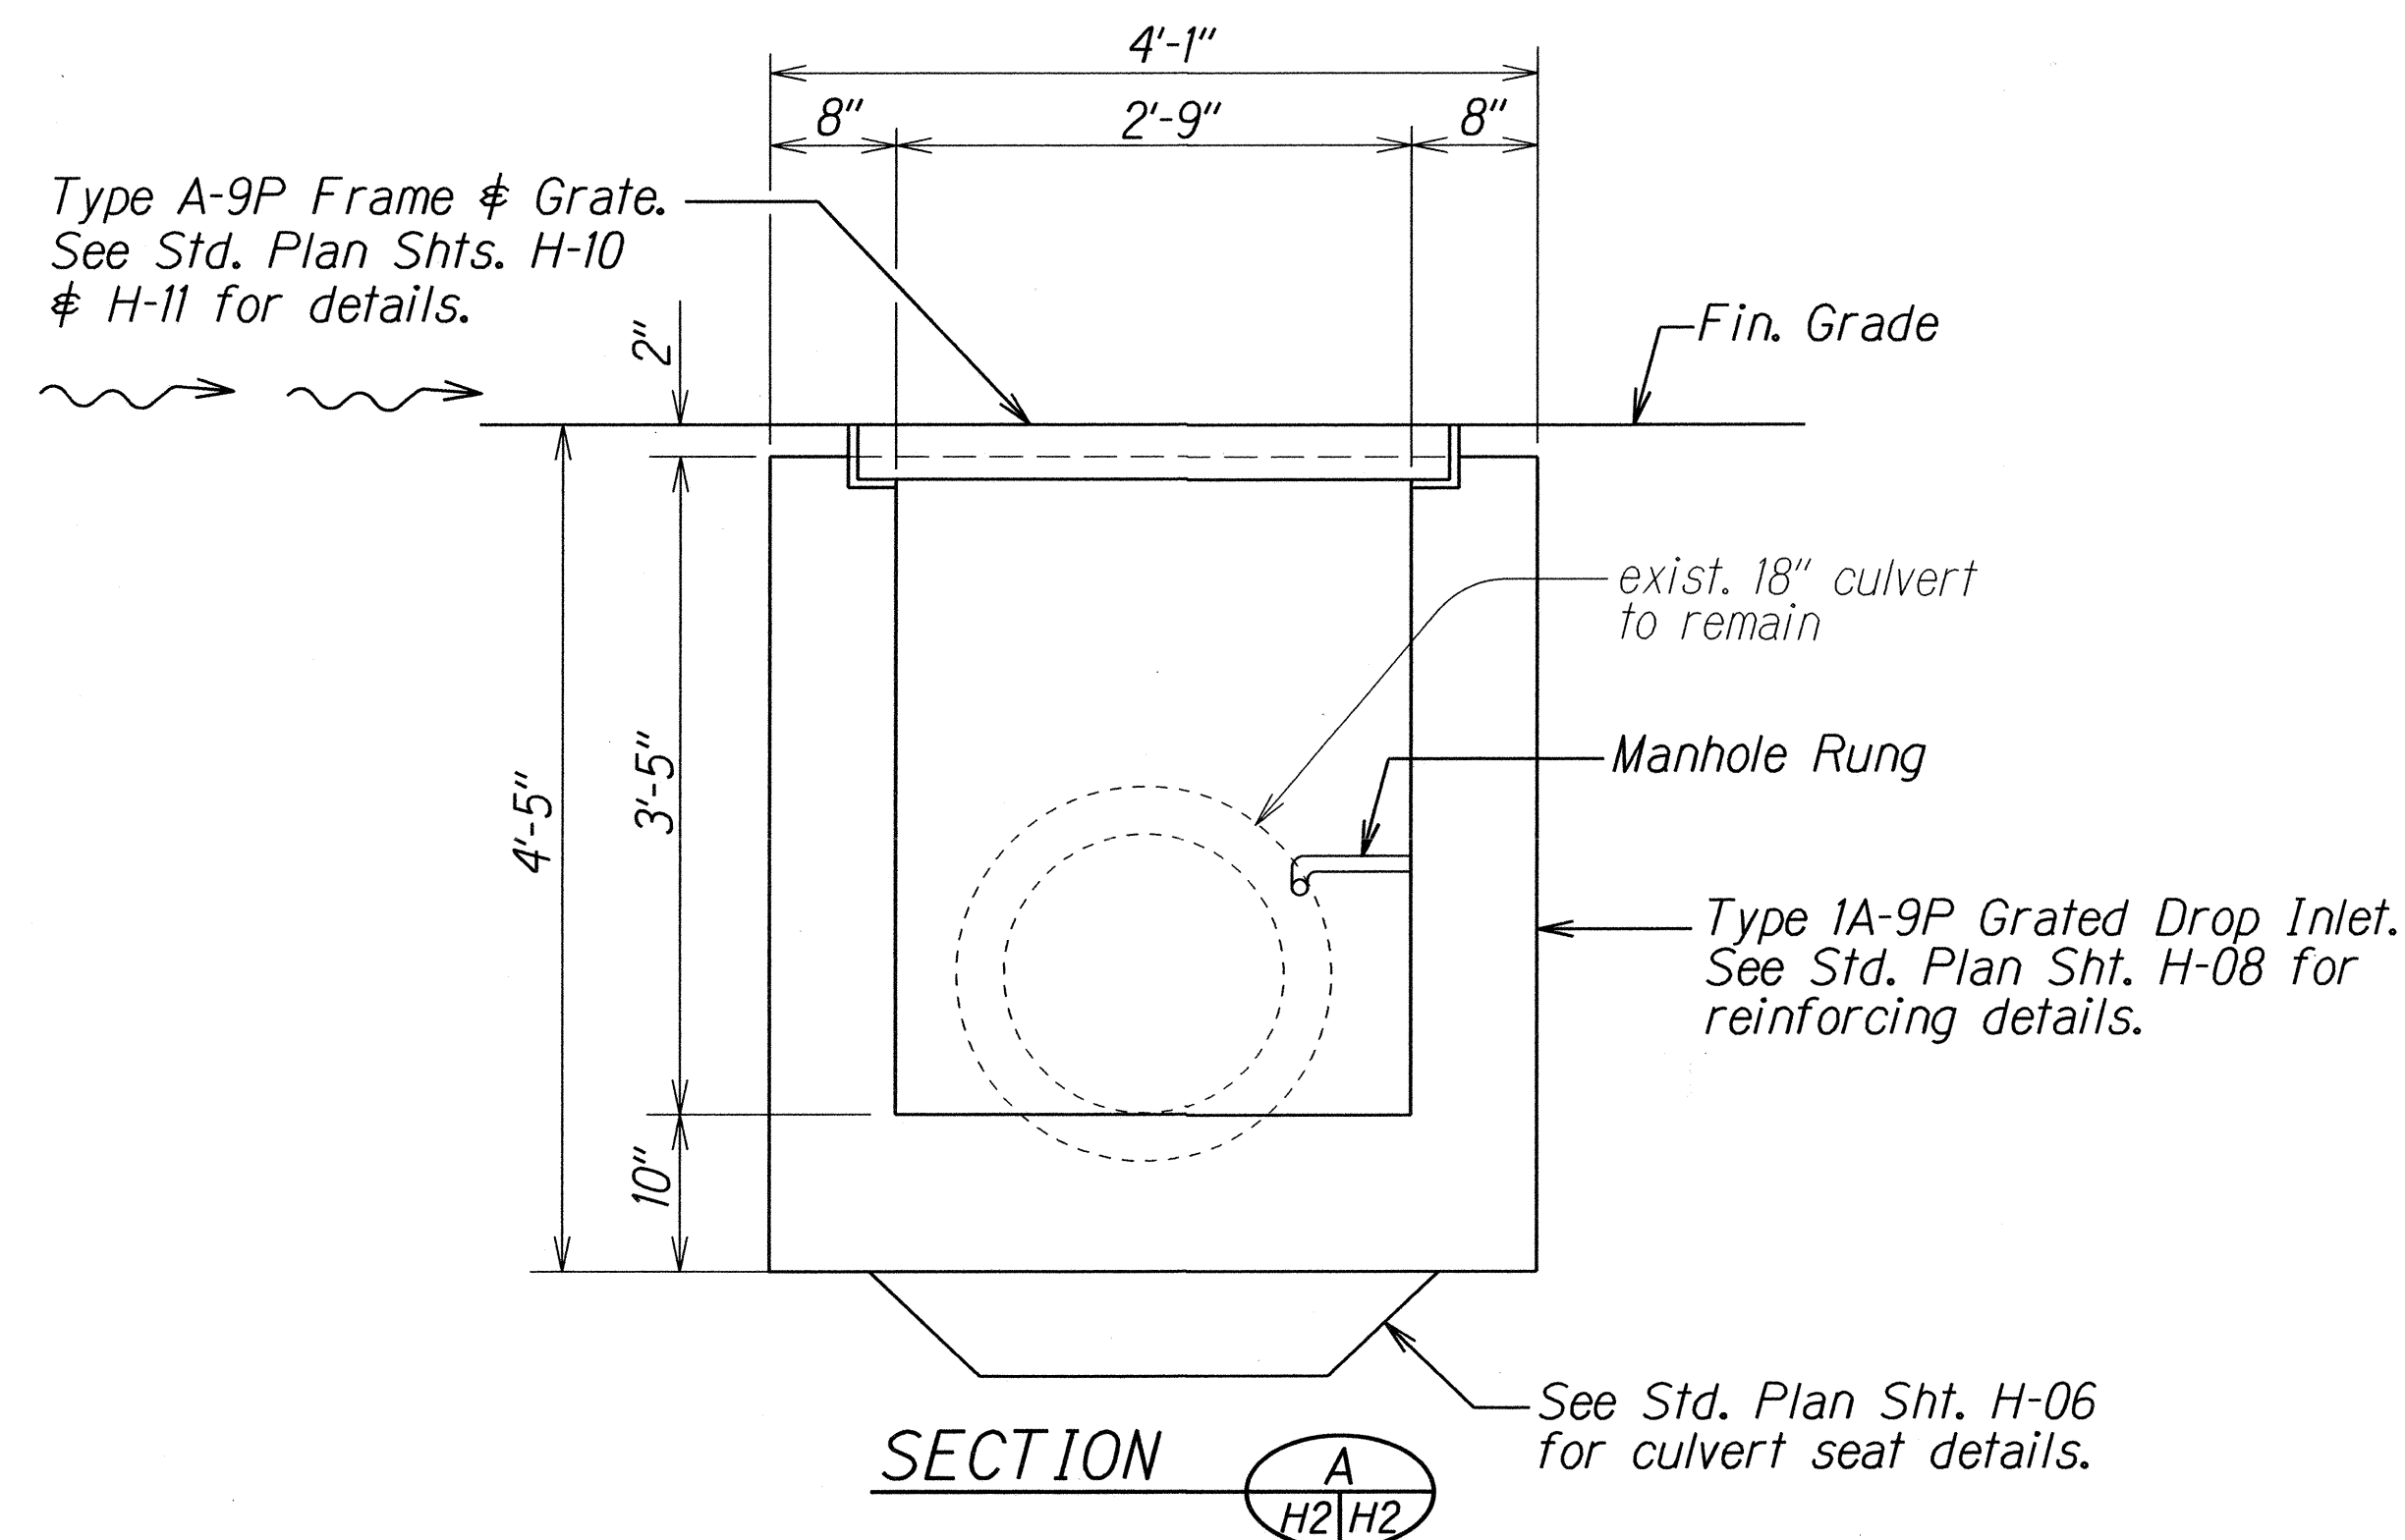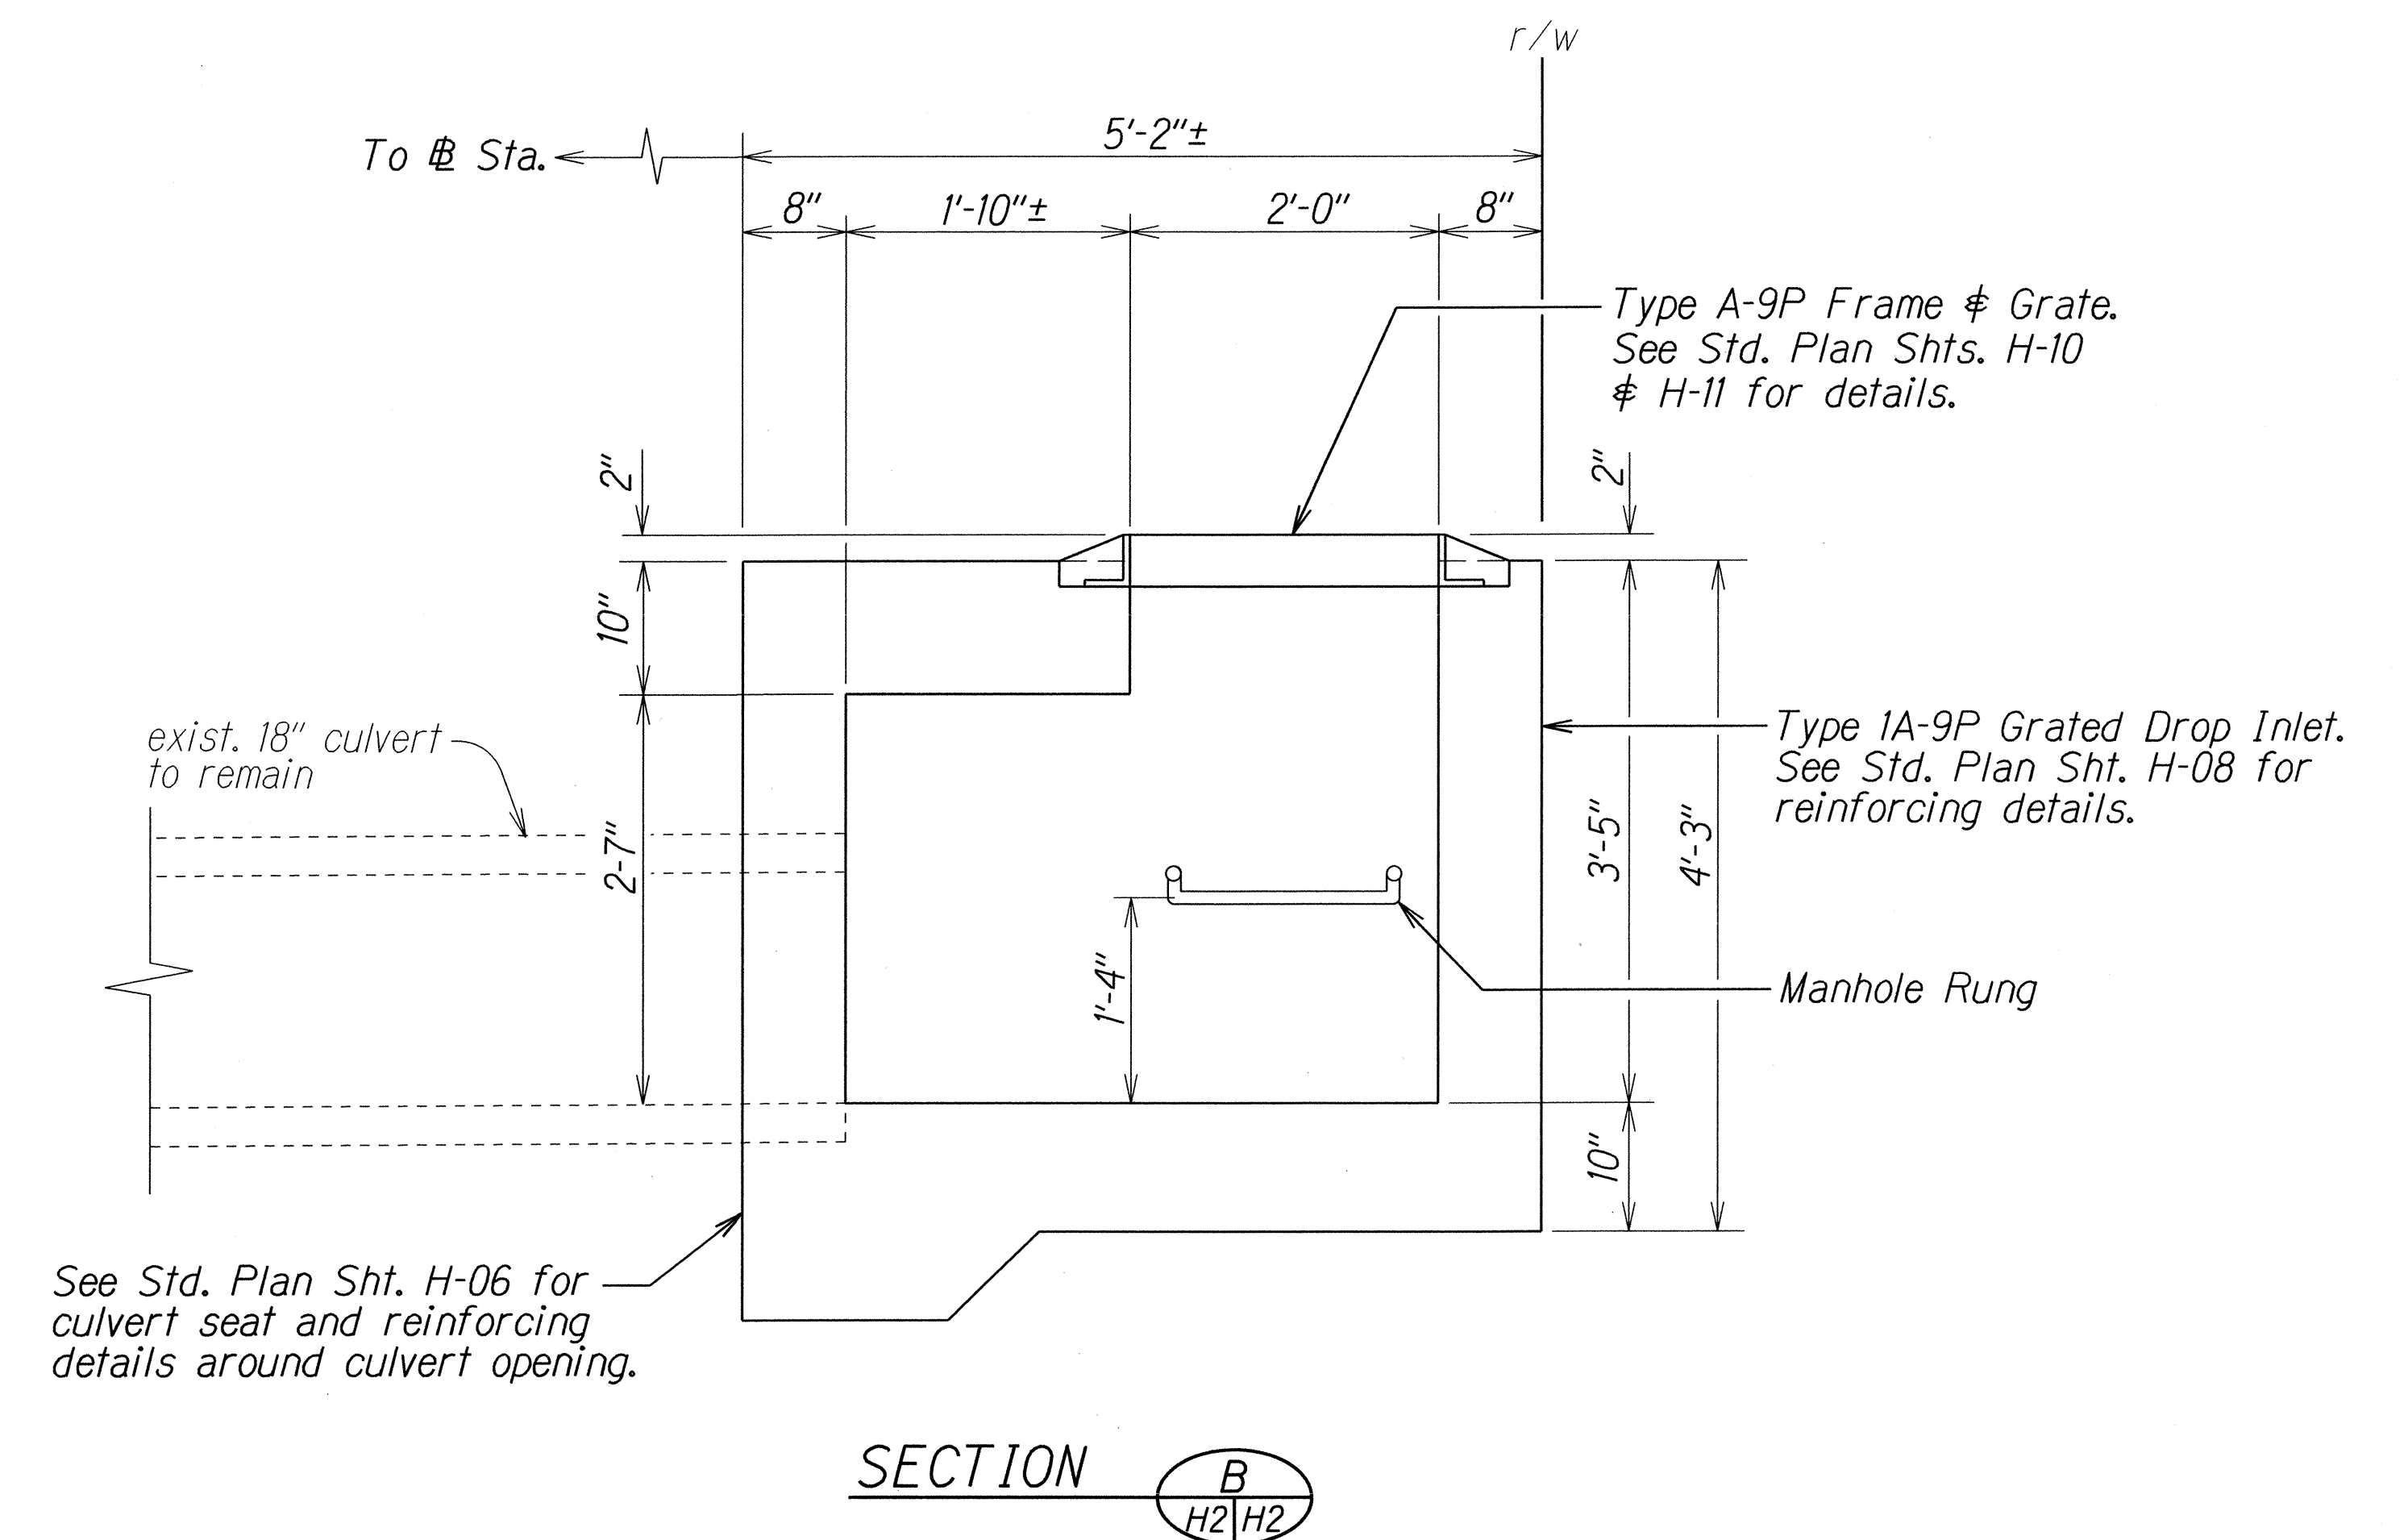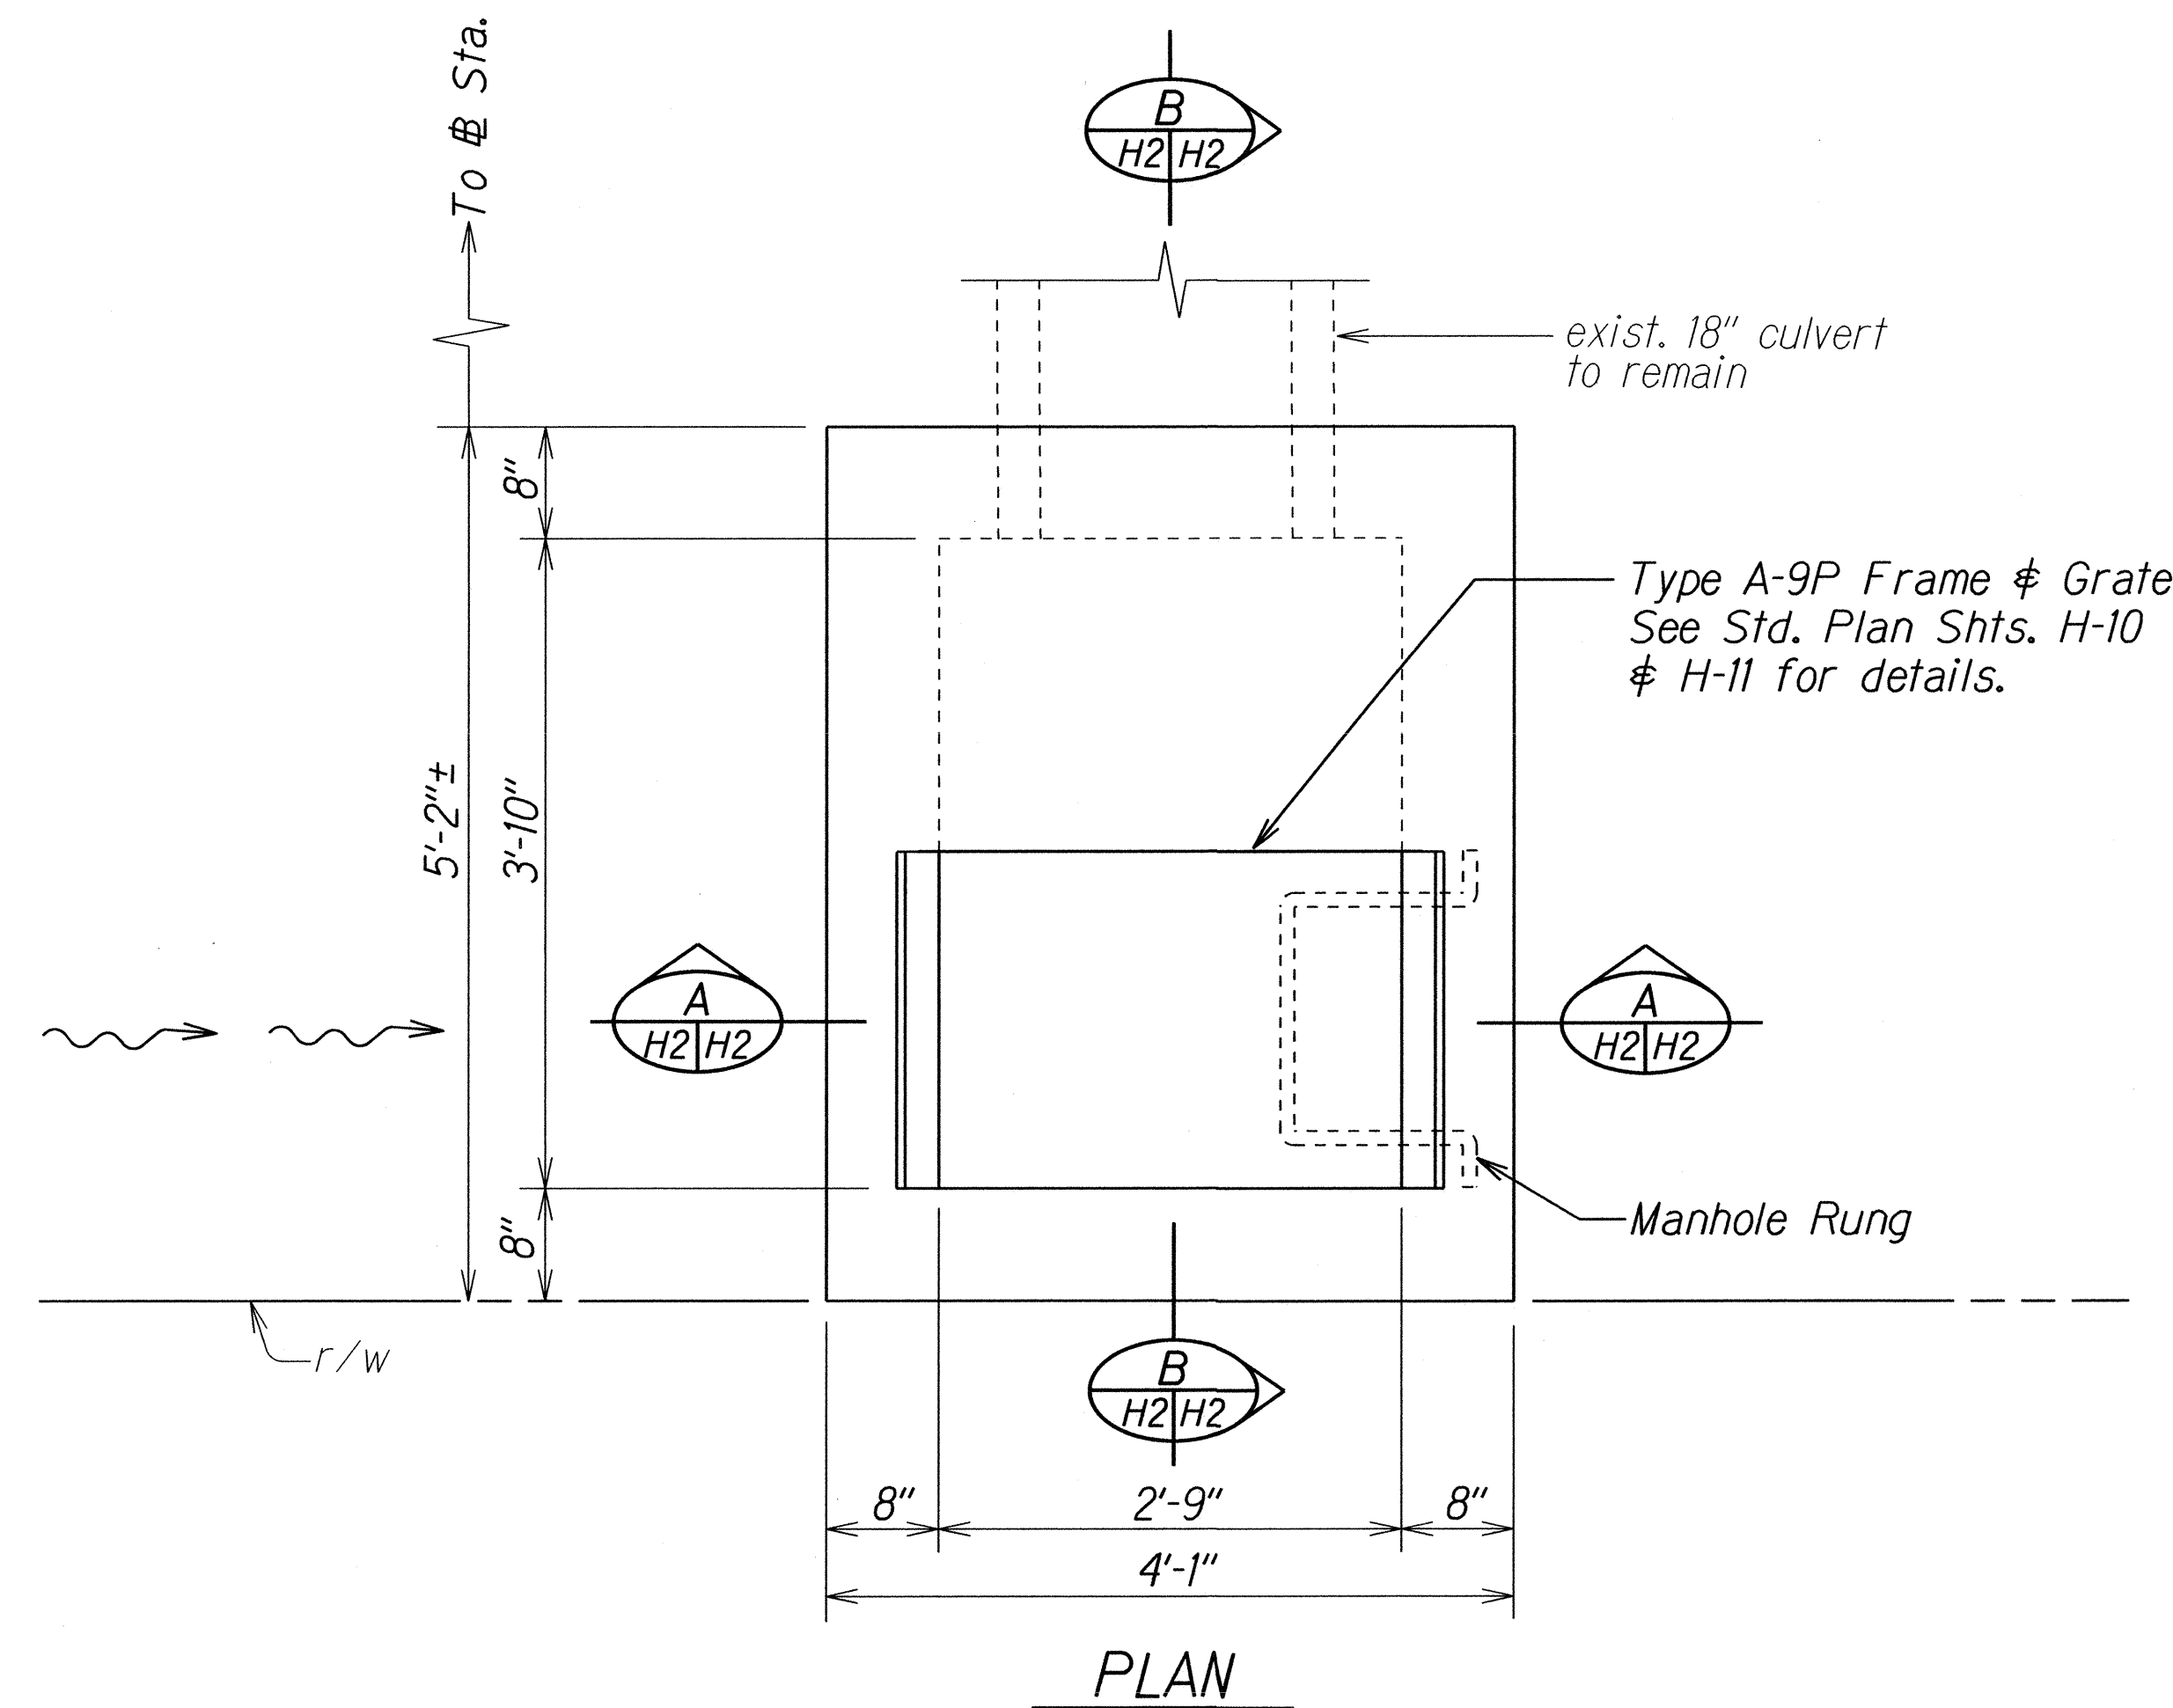

ORIGINAL PLAN	SURVEY PLOTTED BY	DATE
NOTED	DRAWN BY	2/24/15
DESIGNED BY	CHECKED BY	
CHECKED BY		

STATE OF HAWAII
DEPARTMENT OF TRANSPORTATION
HIGHWAYS DIVISION

DRAINAGE PLAN & DETAILS

KAMEHAMEHA HIGHWAY RESURFACING
Dairy Road to Laiewai Bridge
Federal-Aid Project No. NH-083-1(072)

Scale: 1"=1'-0" Date: May, 2015

SHEET No. H2 OF 2 SHEETS