

INDEX TO DRAWINGS	
SHEET NO.	DESCRIPTION
1	TITLE SHEET
2	STANDARD PLANS SUMMARY
3	GENERAL NOTES AND LEGEND
4 - 6	WATER POLLUTION AND EROSION CONTROL NOTES
① 7 - 12	GURADRAIL DETAILS
13 - 24	ROADWAY PLANS
25 - 26	TRAFFIC COUNTING STATION
27 - 33	DRAINAGE DETAILS
34 - 50	TRAFFIC PLANS



① Sheet No. 8 S-1 is a Supplementary Sheet to this Project. Total Sheet Count After "AS-BUILT" Posting 51 Sheets.

STATE OF HAWAII
DEPARTMENT OF TRANSPORTATION
HIGHWAYS DIVISION
HONOLULU, HAWAII
"AS-BUILT"
PLANS FOR

KAMEHAMEHA HIGHWAY SAFETY IMPROVEMENTS
WAIKANE VALLEY ROAD TO KAAWA BRIDGE
FEDERAL AID PROJECT NO. HSIP-083-1(069)



DISTRICTS OF KOOLAUPOKO & KOOLAULO
ISLAND OF OAHU

FED. ROAD DIST. NO.	STATE	FED. AID PROJ. NO.	FISCAL YEAR	SHEET NO.	TOTAL SHEETS
HAWAII	HAW.	HSIP-083-1(069)	2014	1	50

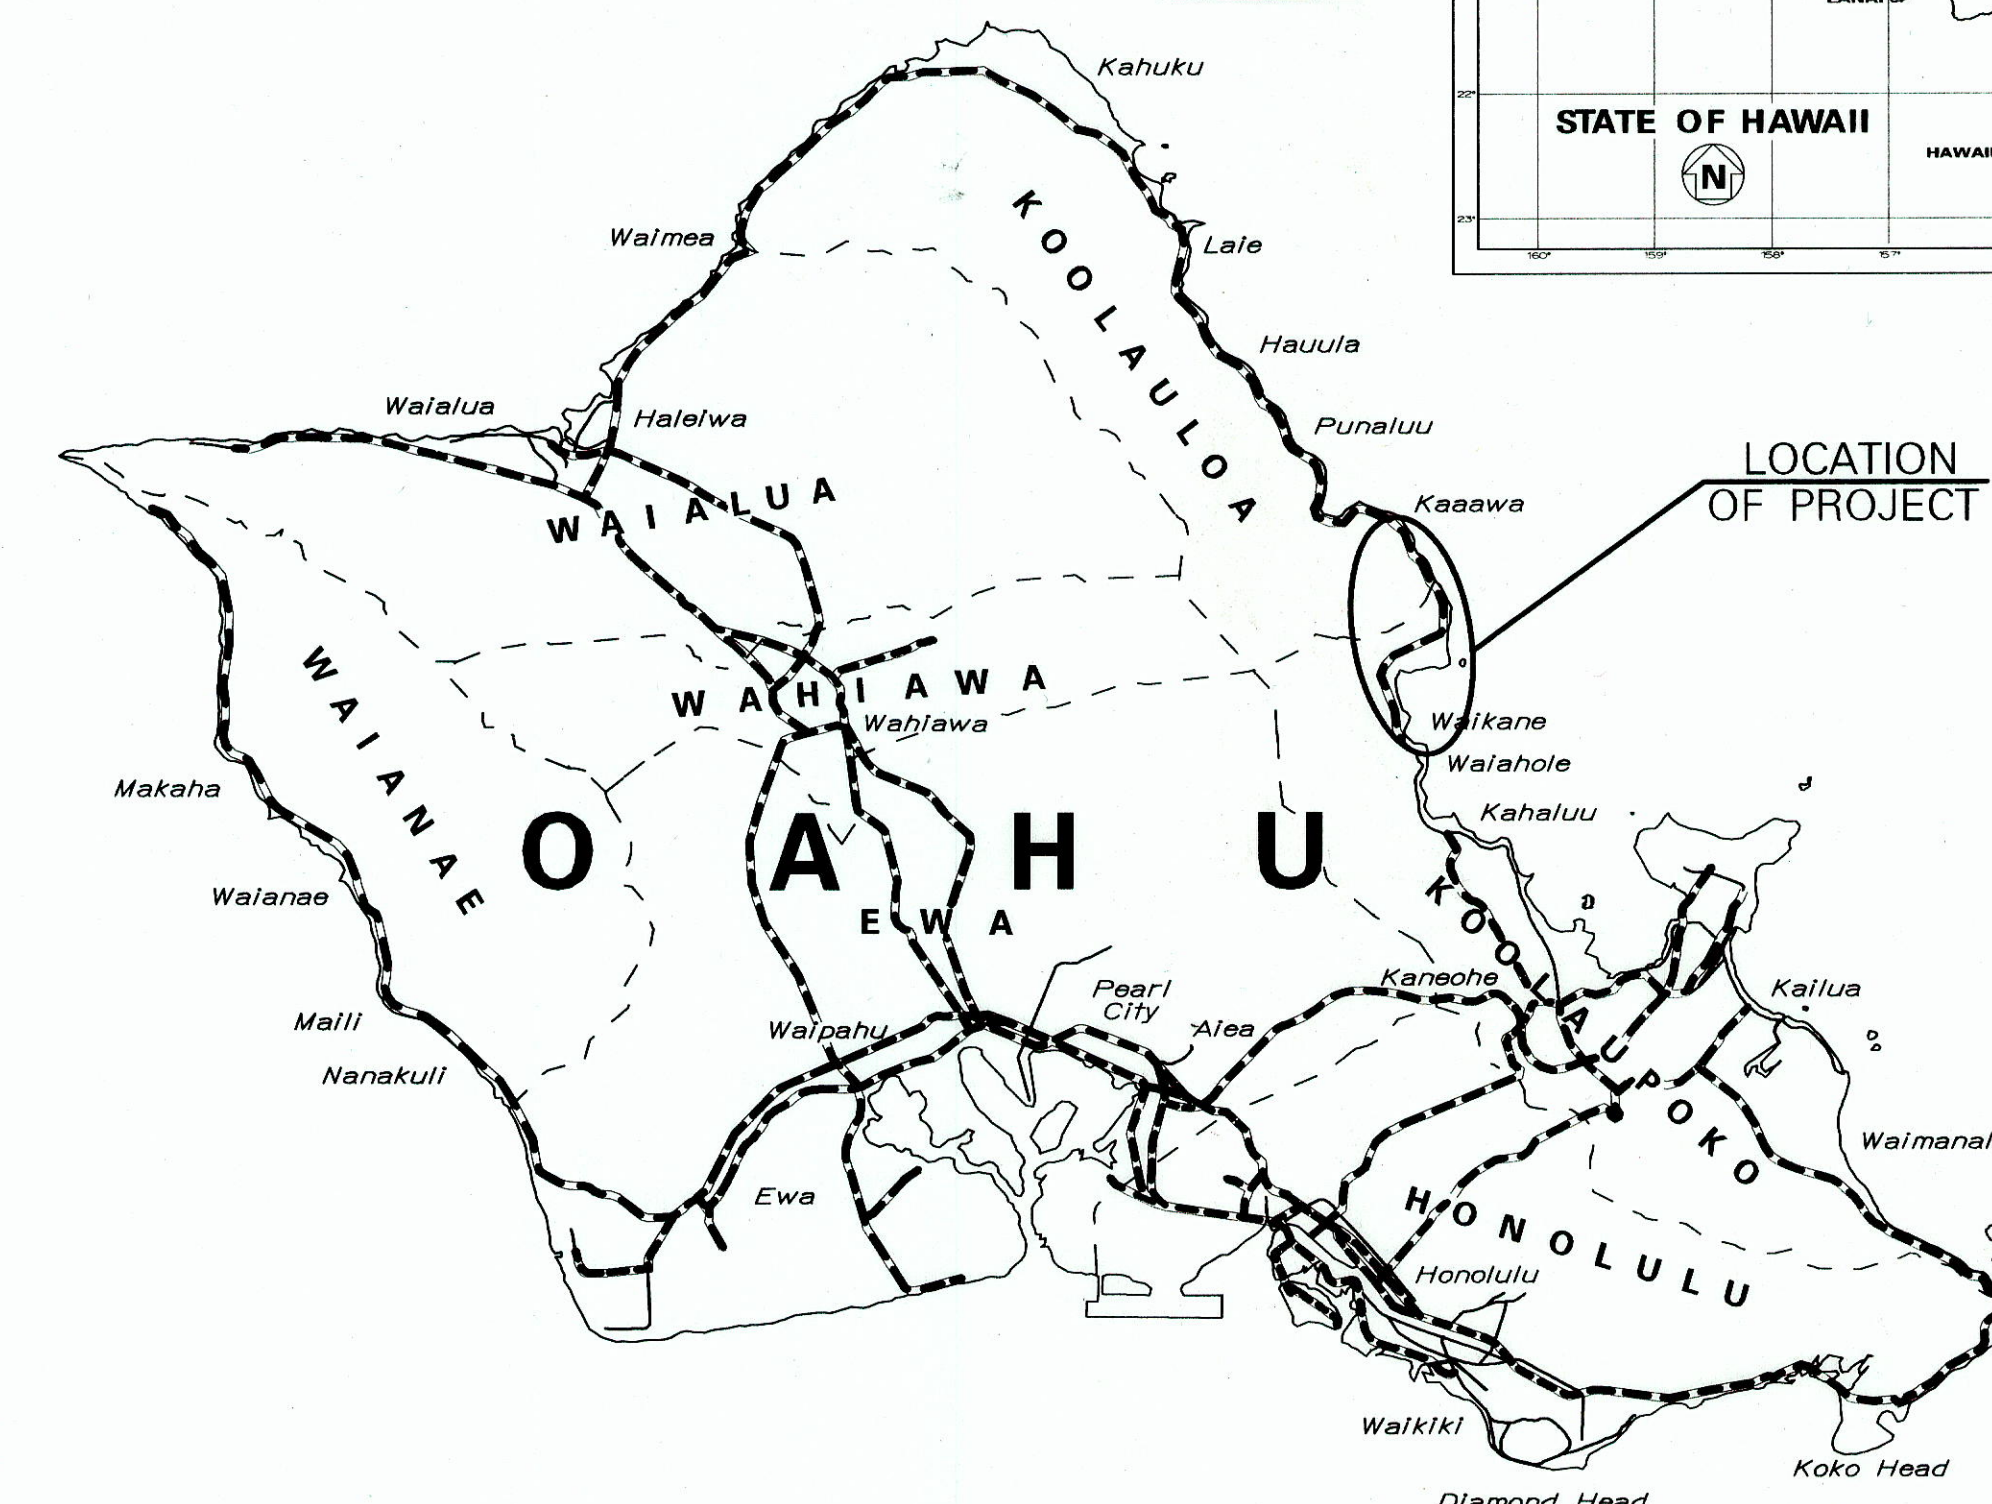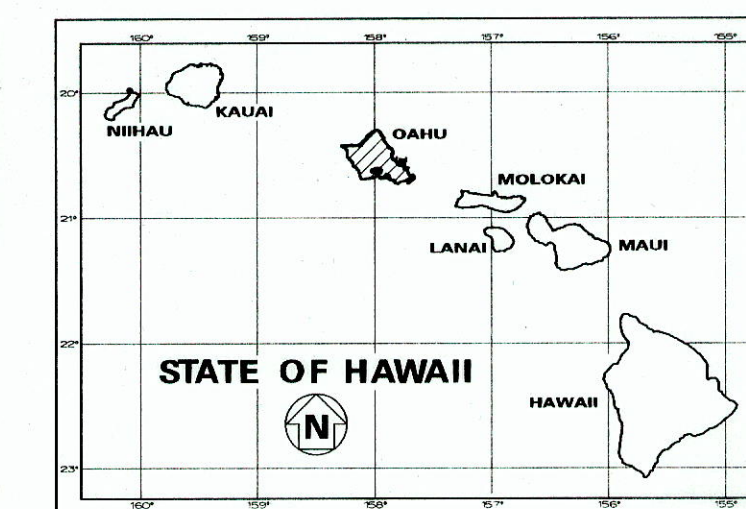

LOCATION OF PROJECT

LIMITS OF PROJECT

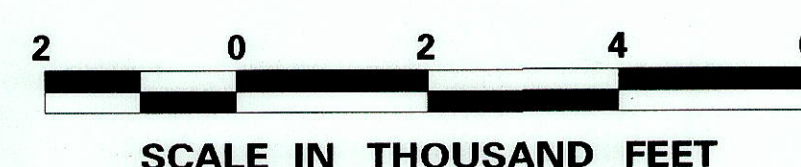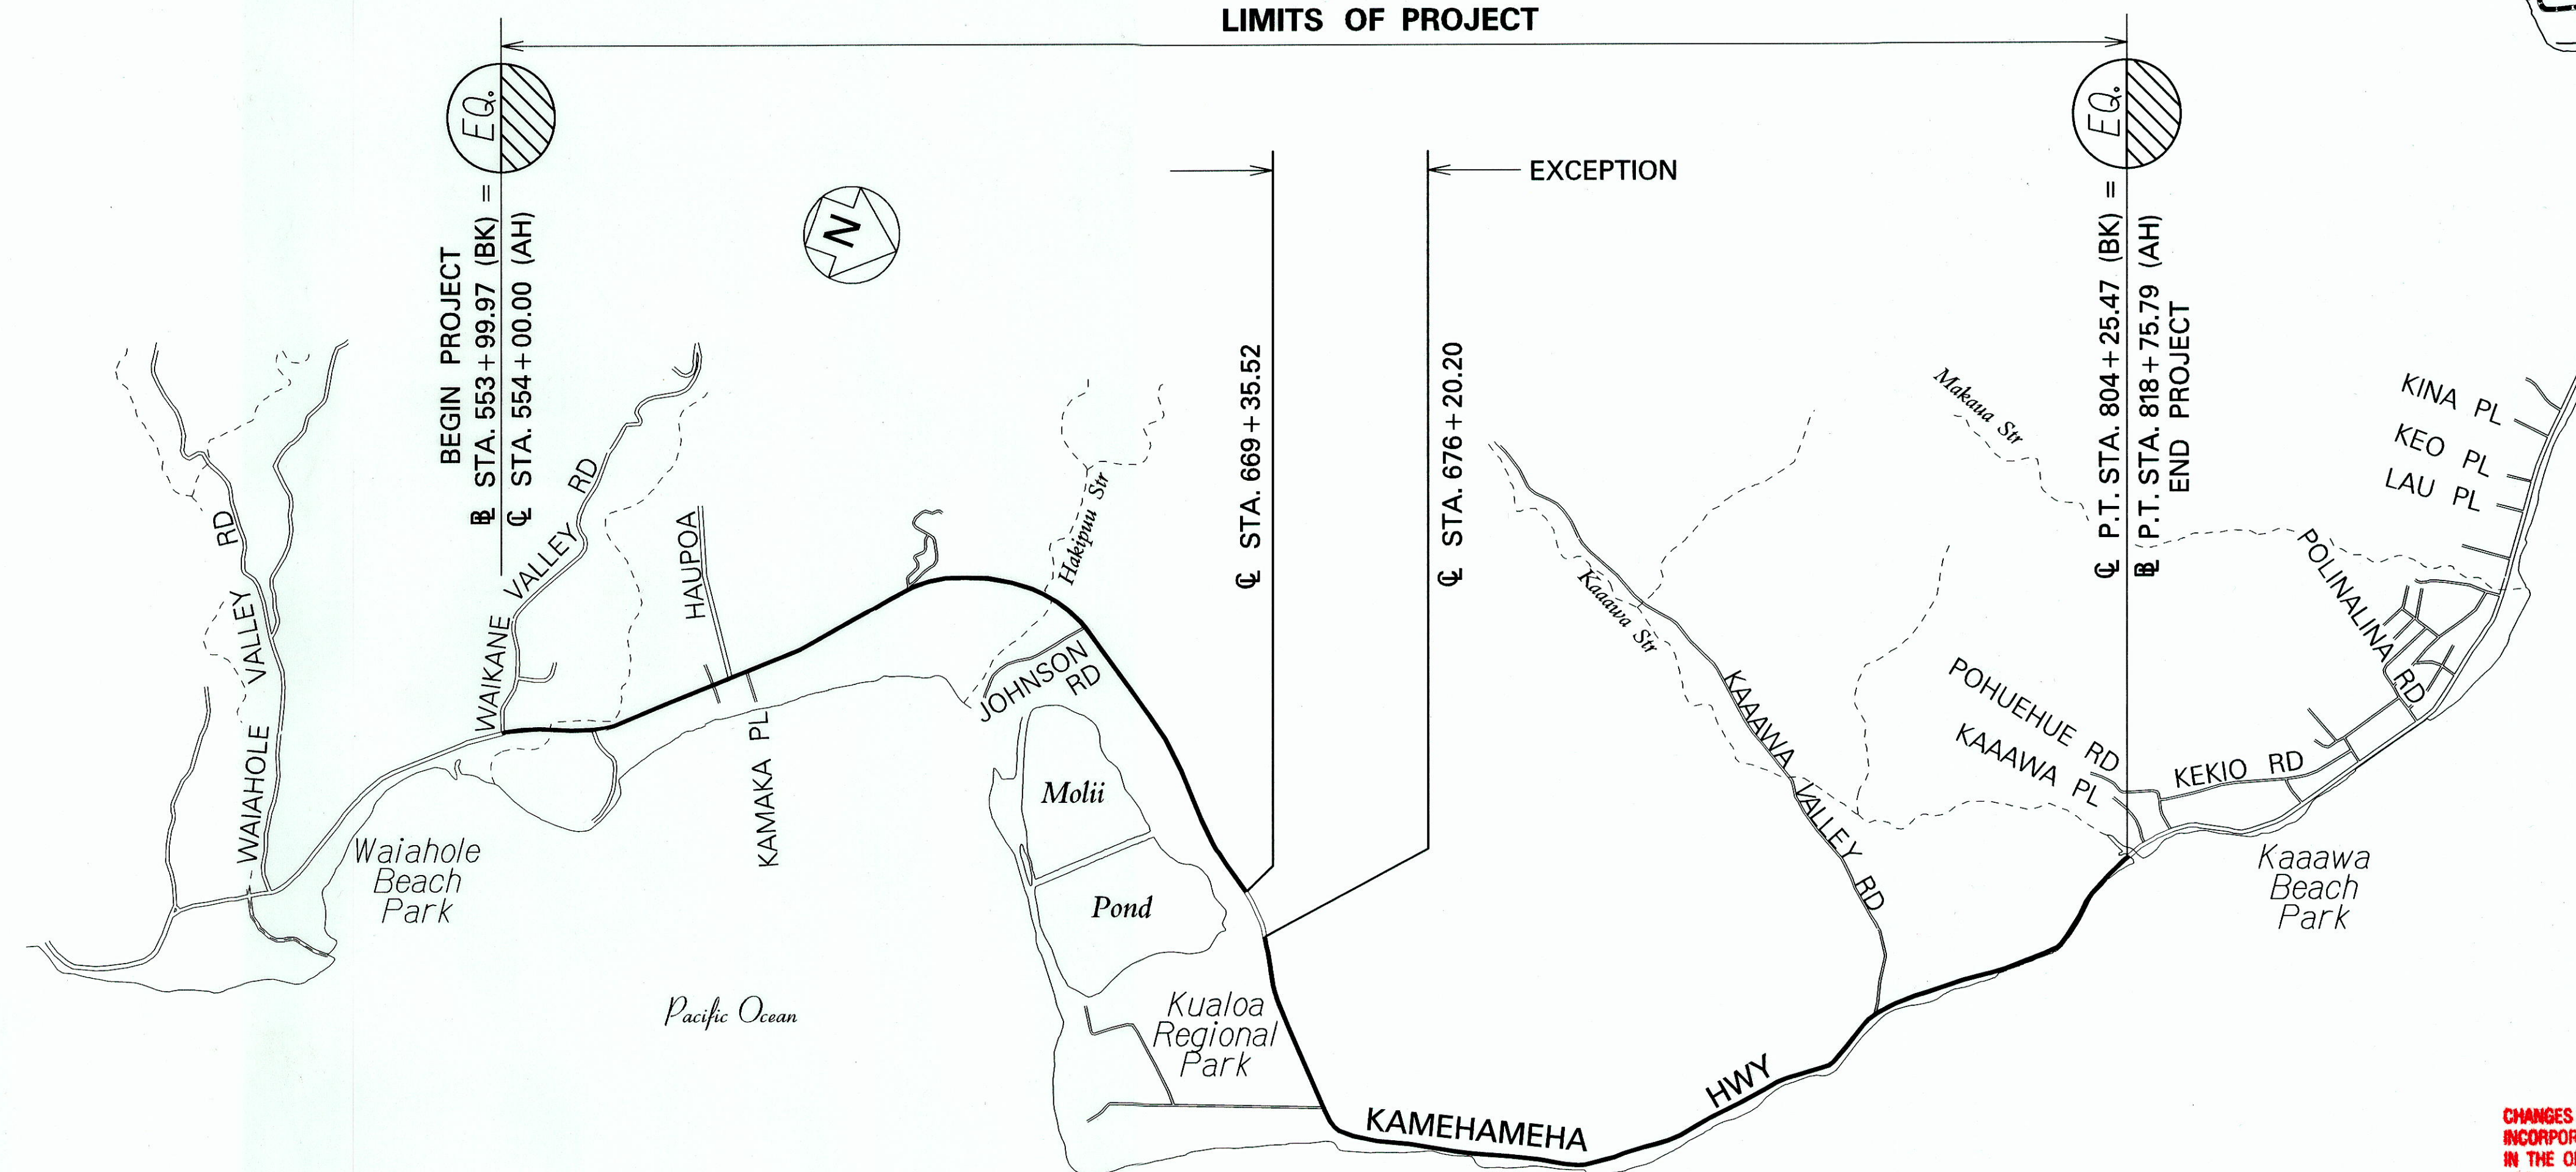

LAYOUT PLAN

GROSS LENGTH OF PROJECT..... 4.90 MILES
NET LENGTH OF PROJECT..... 4.90 MILES

----- FEDERAL AID PROJECTS PREVIOUSLY CONSTRUCTED OR UNDER CONSTRUCTION

MILE POST 33.80 TO MILE POST 28.90

DESIGN DESIGNATION

ADT (2014)..... 13,000
ADT (2024)..... 14,400
DHV 1,150
D 60/40
T 4.0 %
V 40 M.P.H.

CHANGES MADE DURING CONSTRUCTION HAVE BEEN INCORPORATED ON THESE PLANS EXCEPT CHANGES IN THE ORIGINAL THEORETICAL QUANTITIES. FOR ACTUAL QUANTITIES, REFER TO PROJECT LEDGER AND/OR COMPUTATION BOOK.

Matthew M. ...
RESIDENT ENGINEER
1/26/18
DATE

DEPARTMENT OF TRANSPORTATION
STATE OF HAWAII
APPROVED:
... ..
DIR. OF TRANSPORTATION
9/12/14
DATE

DESIGNED BY
HWY-DD
MANAGED BY
HWY-D
692-7581
PHONE
AUG., 2014
DATE