	INDEX TO DRAWINGS
SHEET NO.	DESCRIPTION
į .	TITLE SHEET AND PLAN
·	
*	
· · · · · · · · · · · · · · · · · · ·	
	у
• ,	
•	
•	
,	
	.'

AN NISHIMURA
P. S. & E. BY



STATE OF

## HAWAII

DEPARTMENT OF TRANSPORTATION HIGHWAYS DIVISION

"AS-BUILT" PLANS FOR

## KAHEKILI HIGHWAY


COORDINATION OF EXISTING TRAFFIC SIGNALS AT KEAAHALA, KAHUHIPA, AND HAIKU ROADS

PROJECT NO. 83F-03-81

DISTRICT OF KOOLAUPOKO ISLAND OF OAHU

## SCOPE OF WORK

This project consists of furnishing and installing Traffic Control Synchronizer units without the use of interconnecting cables at the existing signalized intersections of Keaahala, Kahuhipa and Haiku Roads with Kahekili Highway.

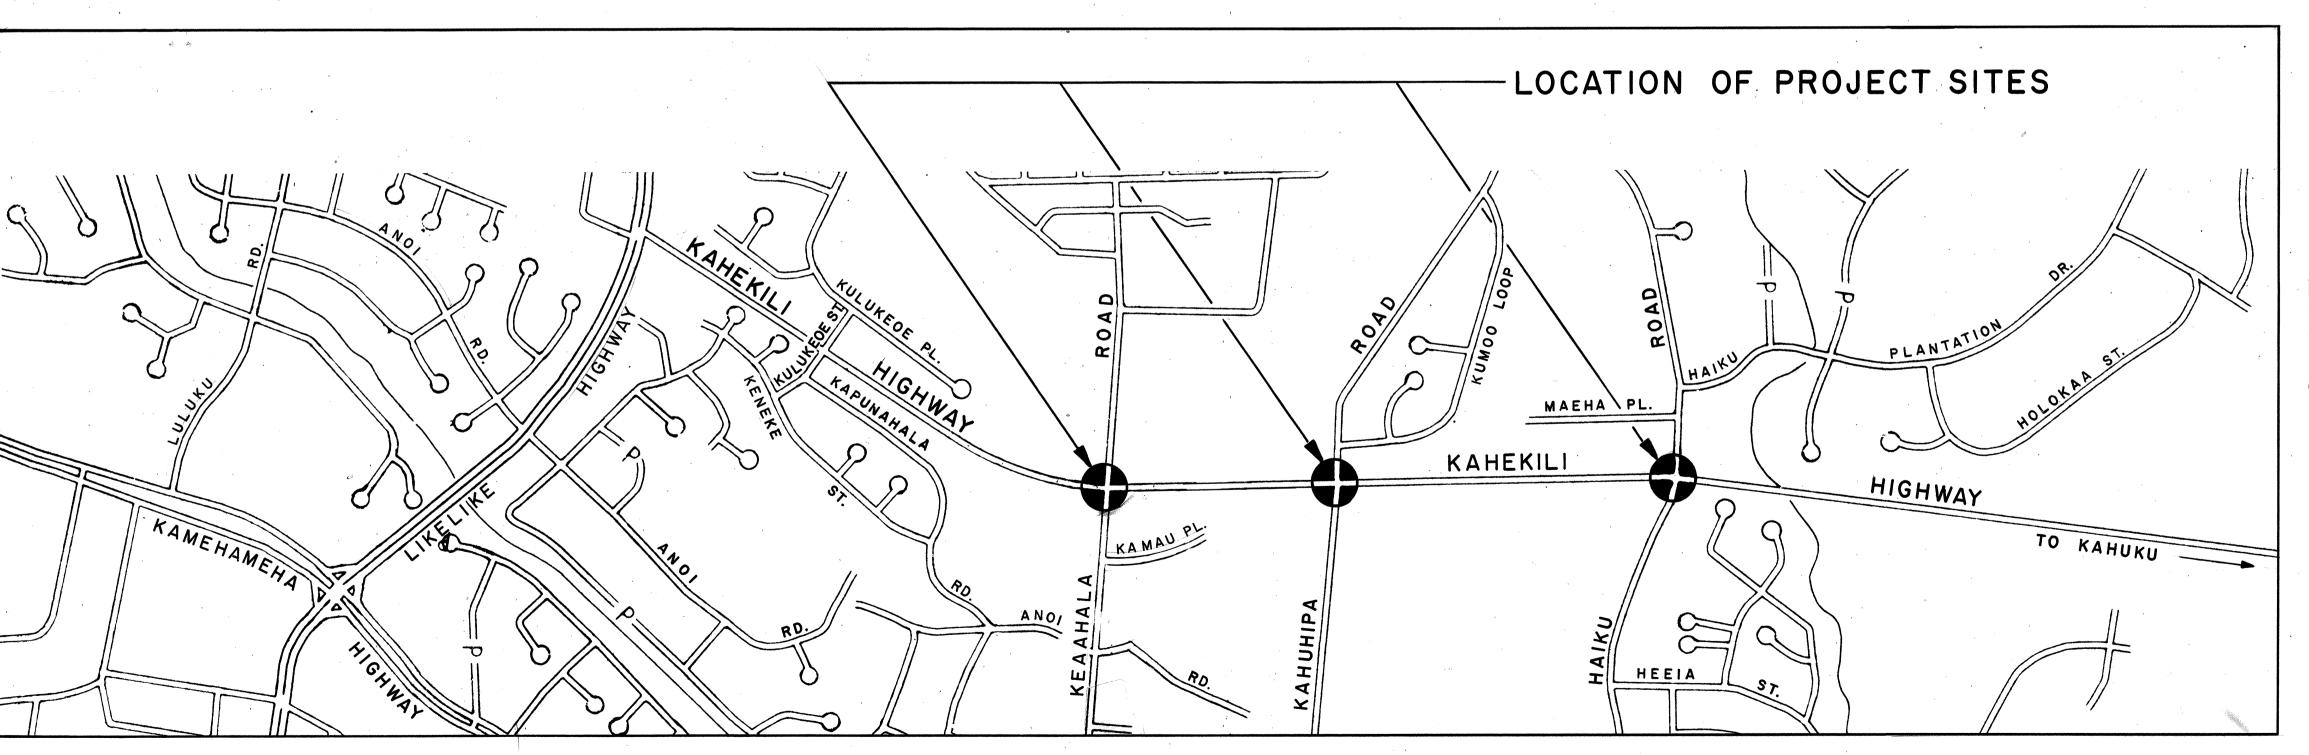

ORIGINAL THEORETICAL QUANTITIES. FOR ACTUAL QUANTITIES, REFER TO PROJECT LEDGER AND/OR COMPUTATION BOOK.

Phil allemante RESIDENT ENGINEER

FED. ROAD DIST. NO.

6/29/82 DATE

FD-F-7-6

FISCAL SHEET TOTAL YEAR NO. SHEETS

LOCATION OF

PROJECT

1982


PROJ. NO.

83F-03-81

STATE OF HAWAII

LAYOUT PLAN



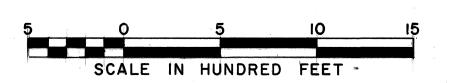

DEPARTMENT OF TRANSPORTATION STATE OF HAWAII APPROVED: DIR. OF TRANSPORTATION