




FED. ROAD DIST. NO.	STATE	PROJ. NO.	FISCAL YEAR	SHEET NO.	TOTAL SHEETS
HAWAII	HAW.	83B-01-81	1988	7	16

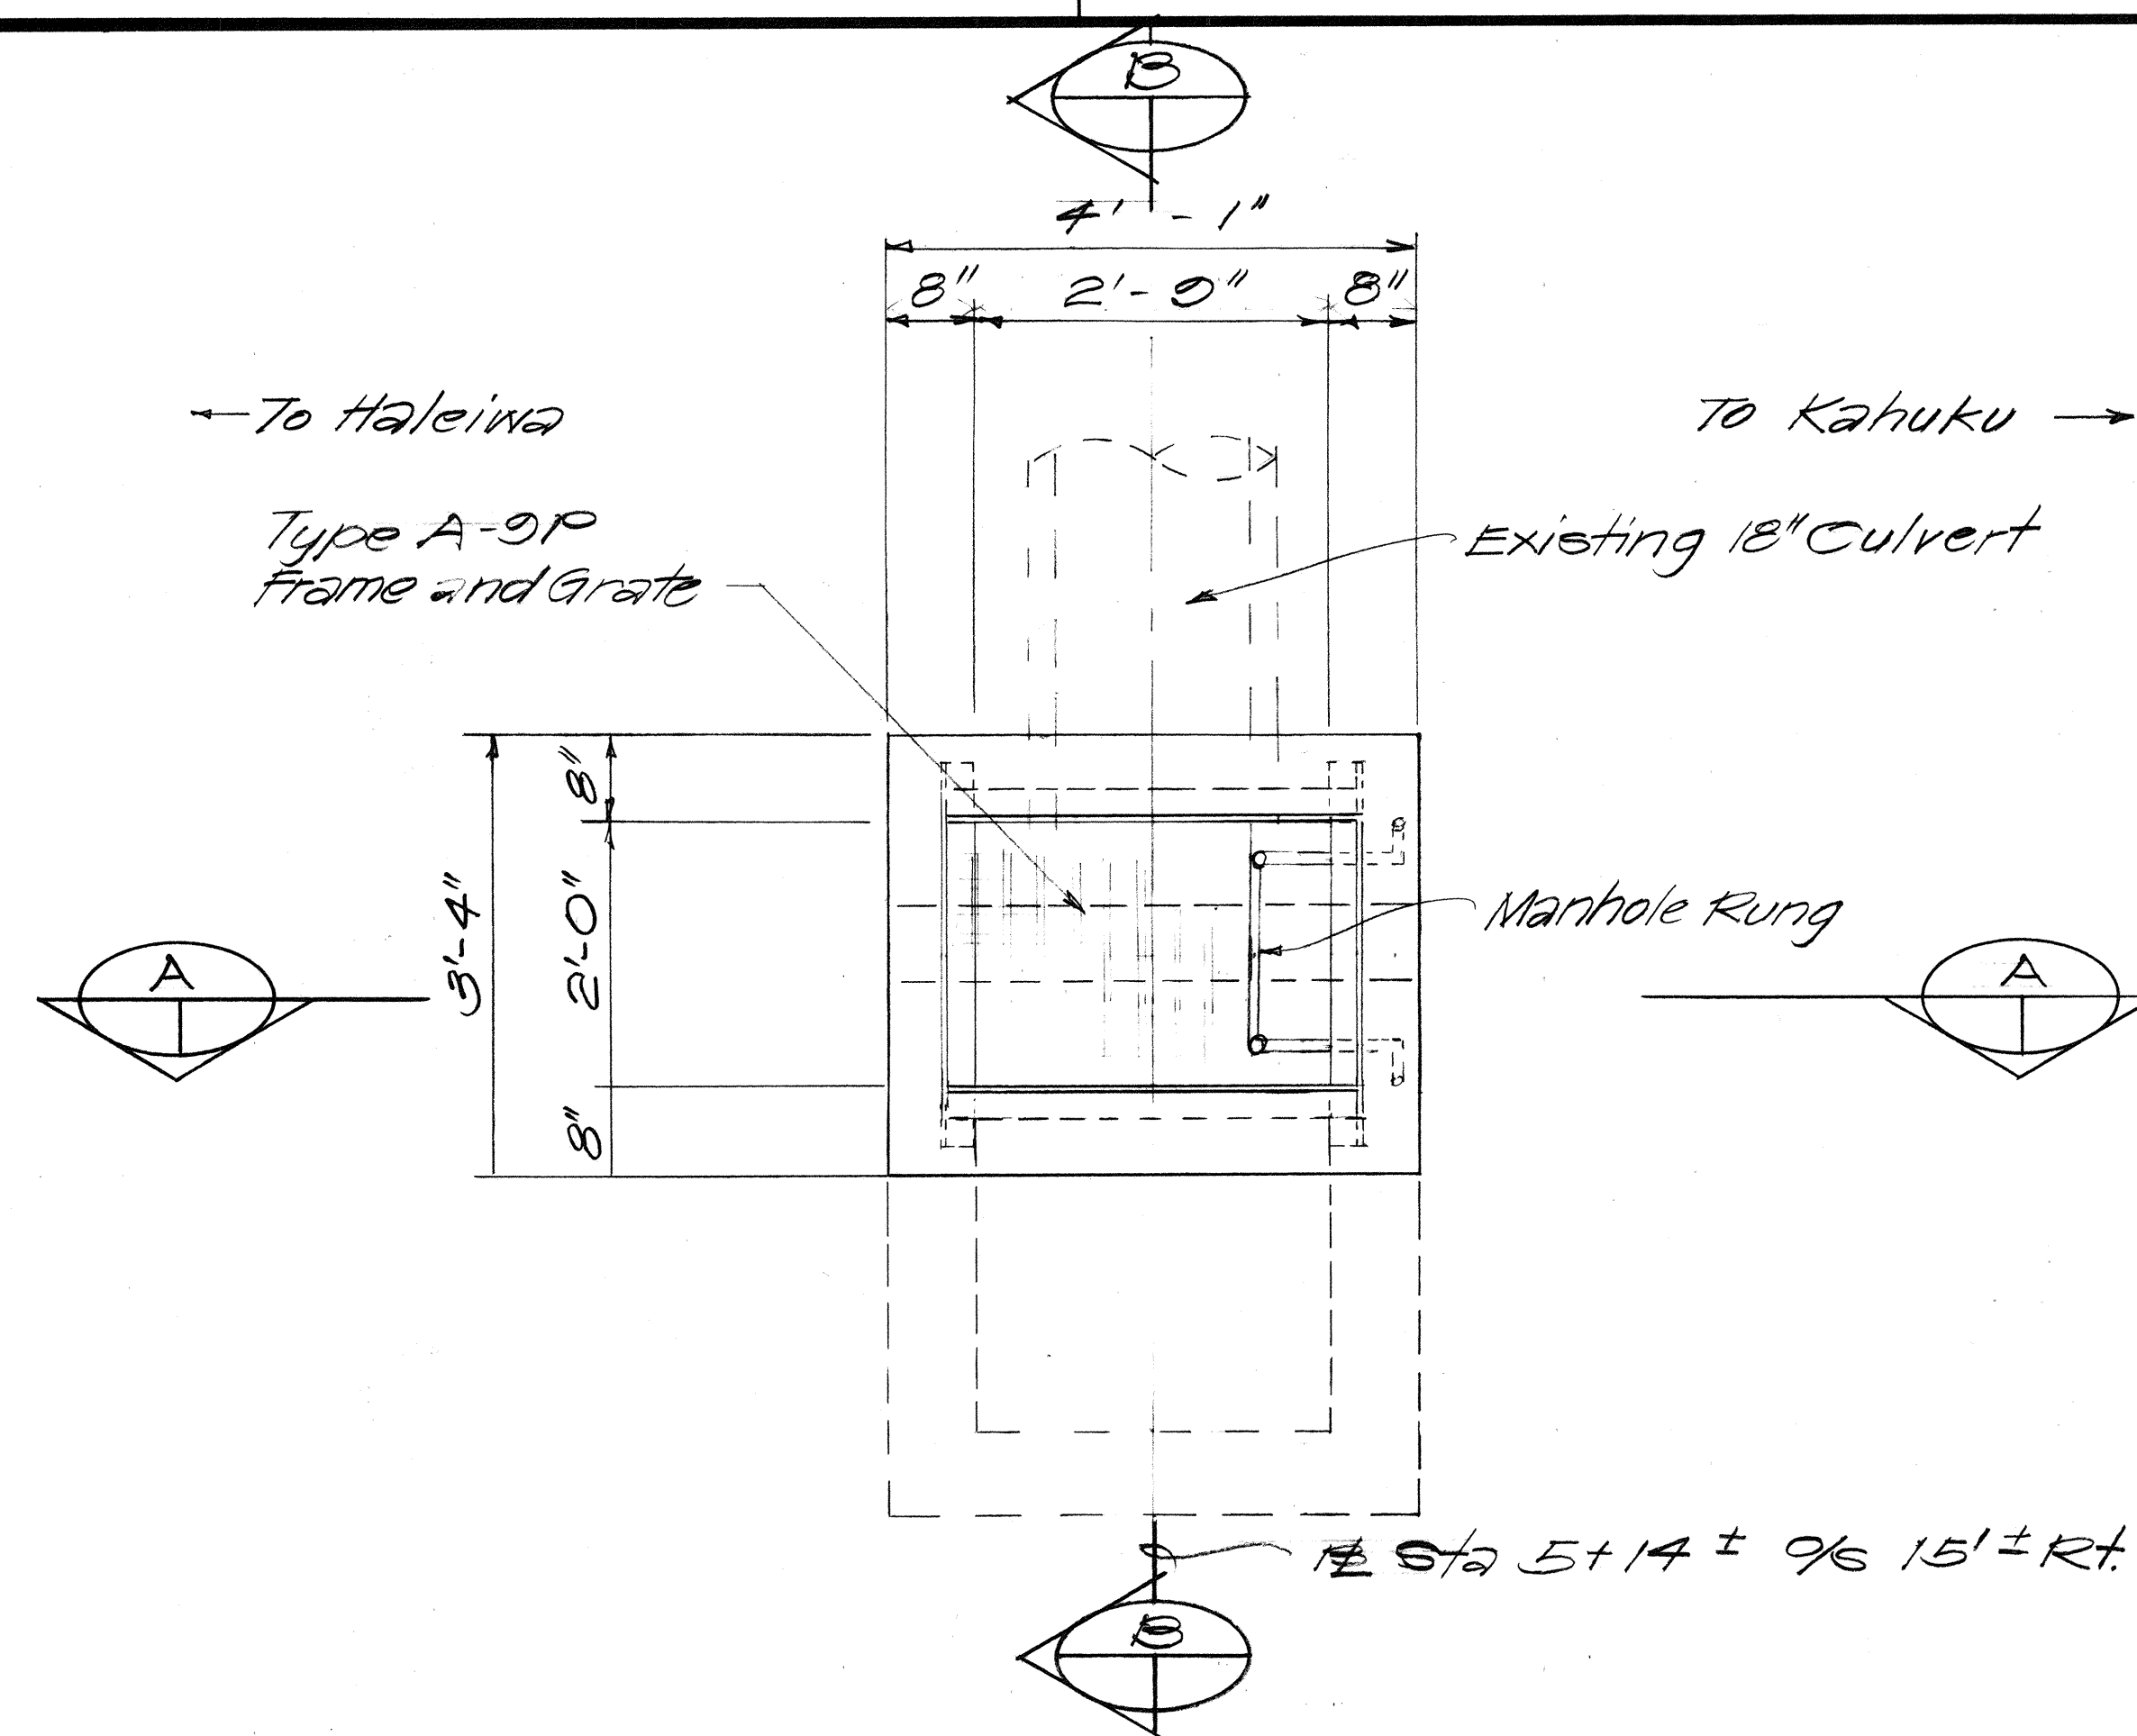

PLAN
Scale: 3/4" = 1'-0"

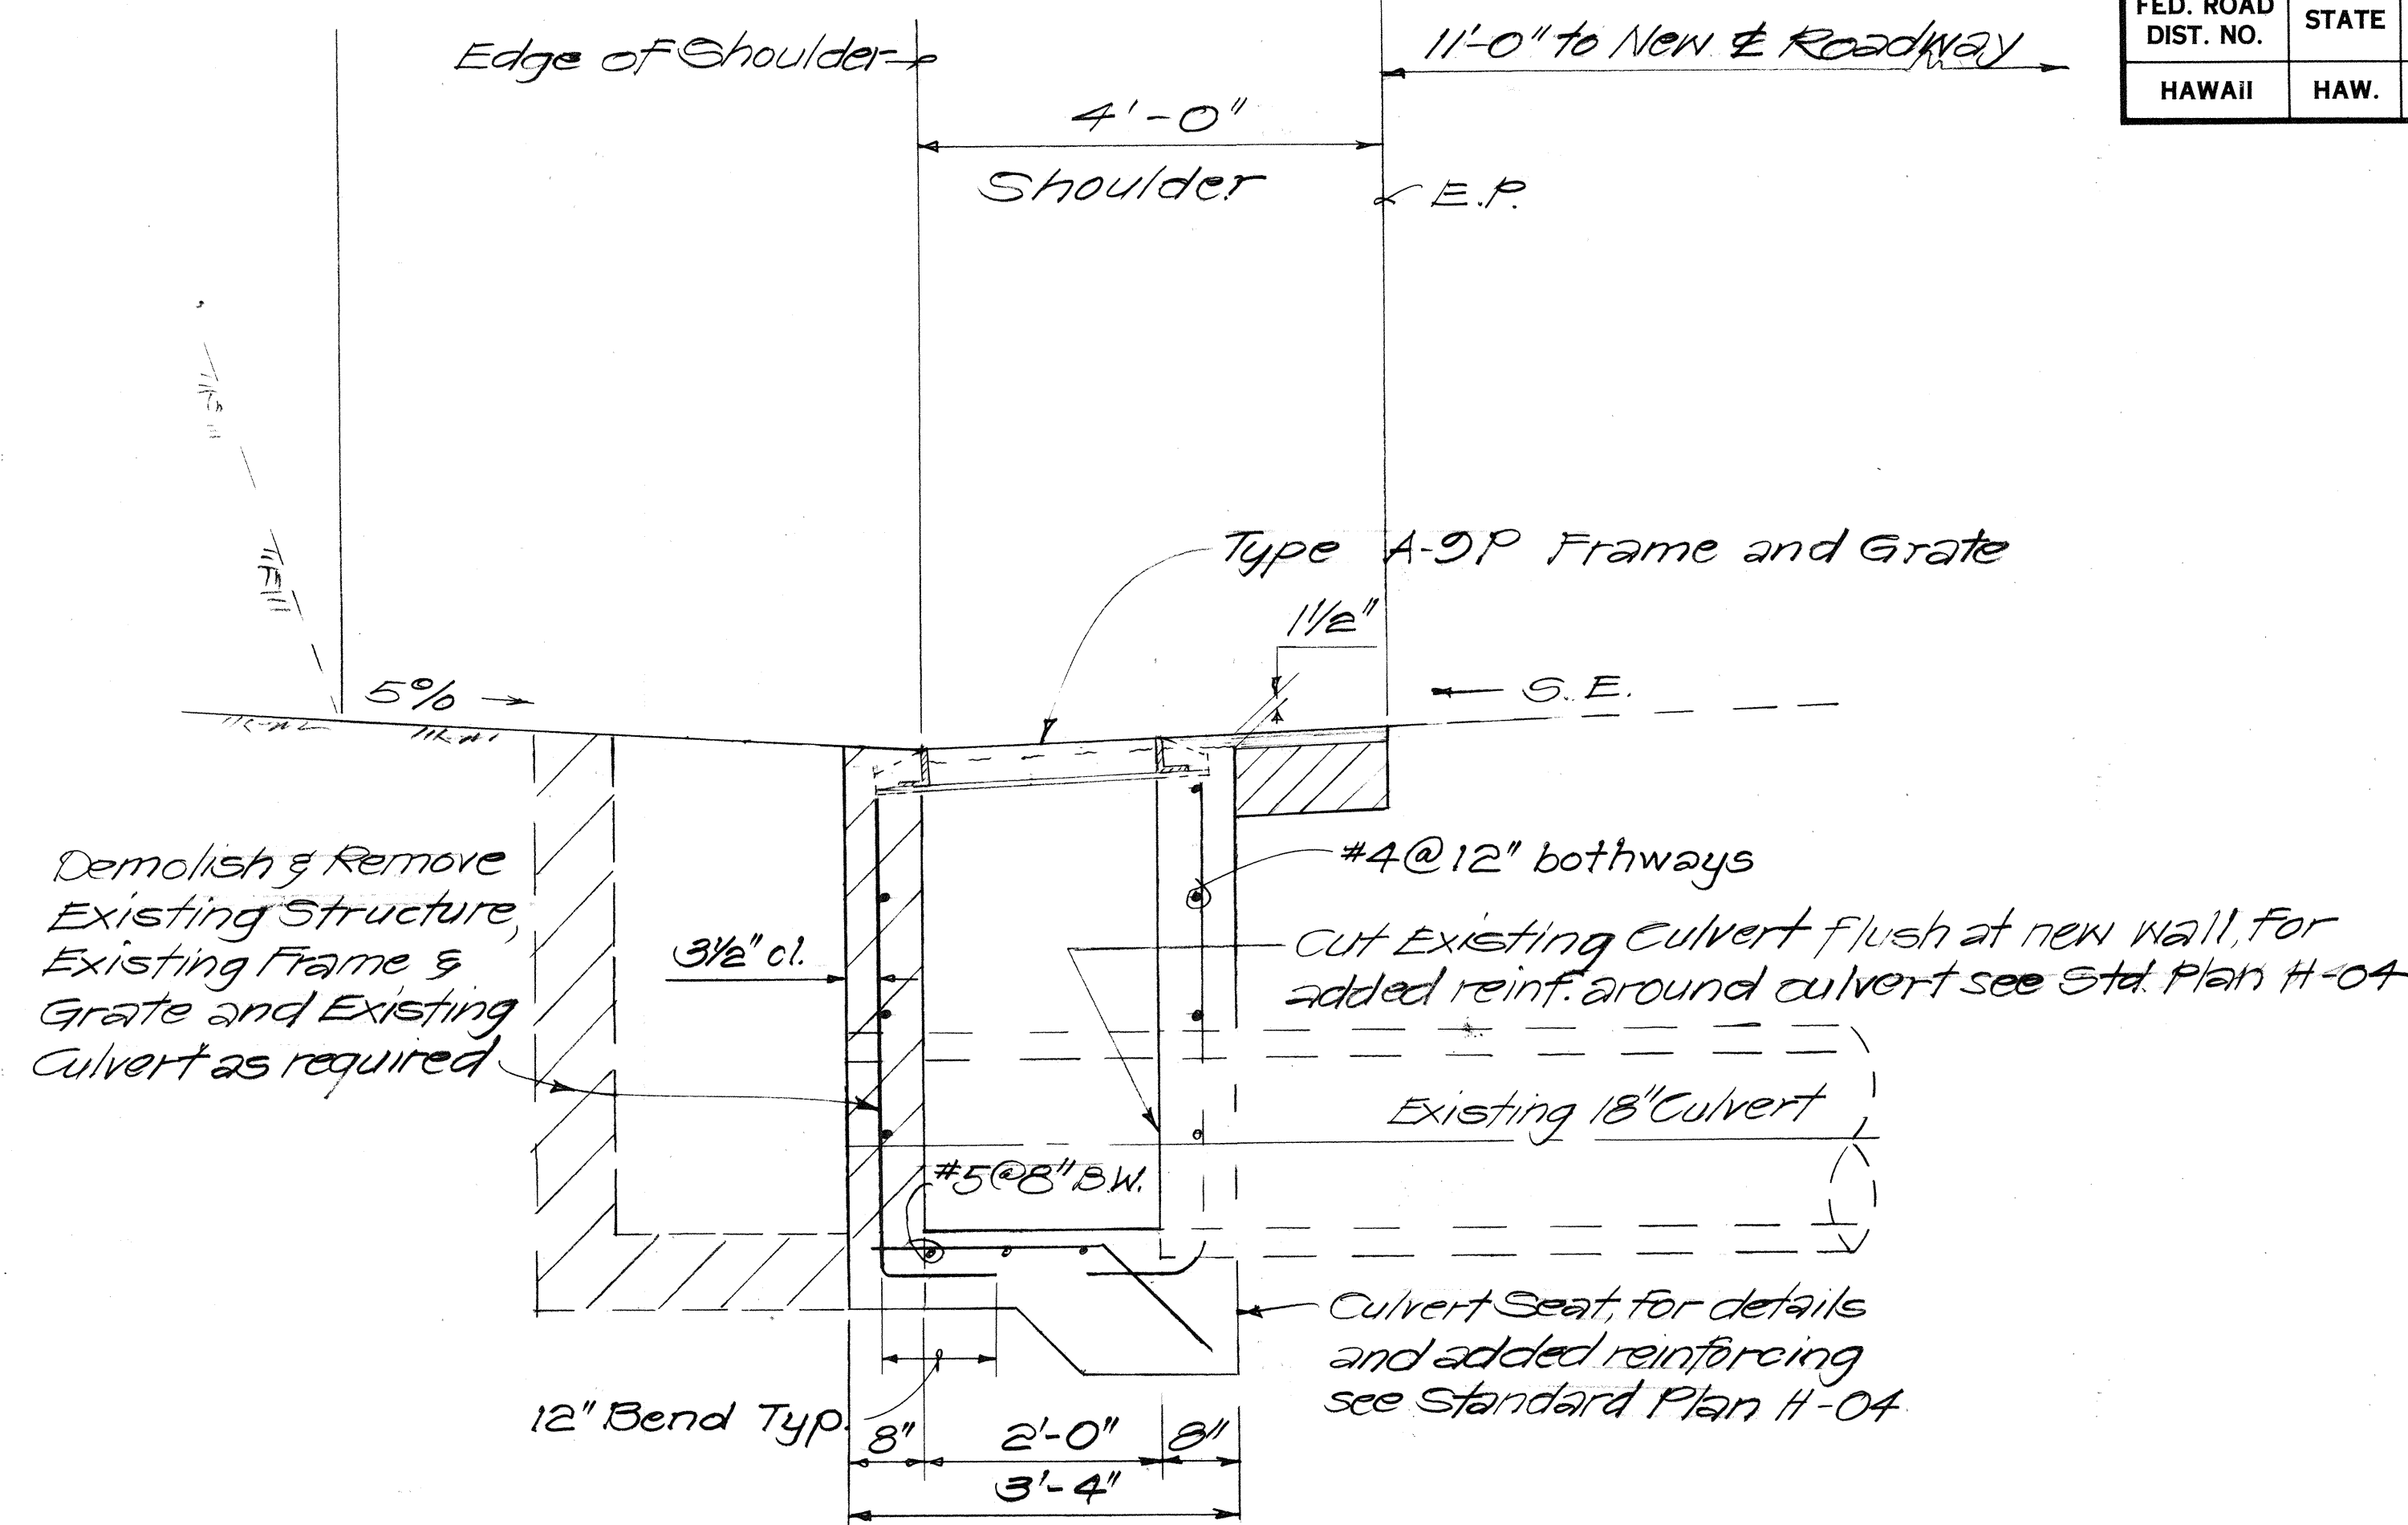

SECTION B
Scale: 3/4" = 1'-0"

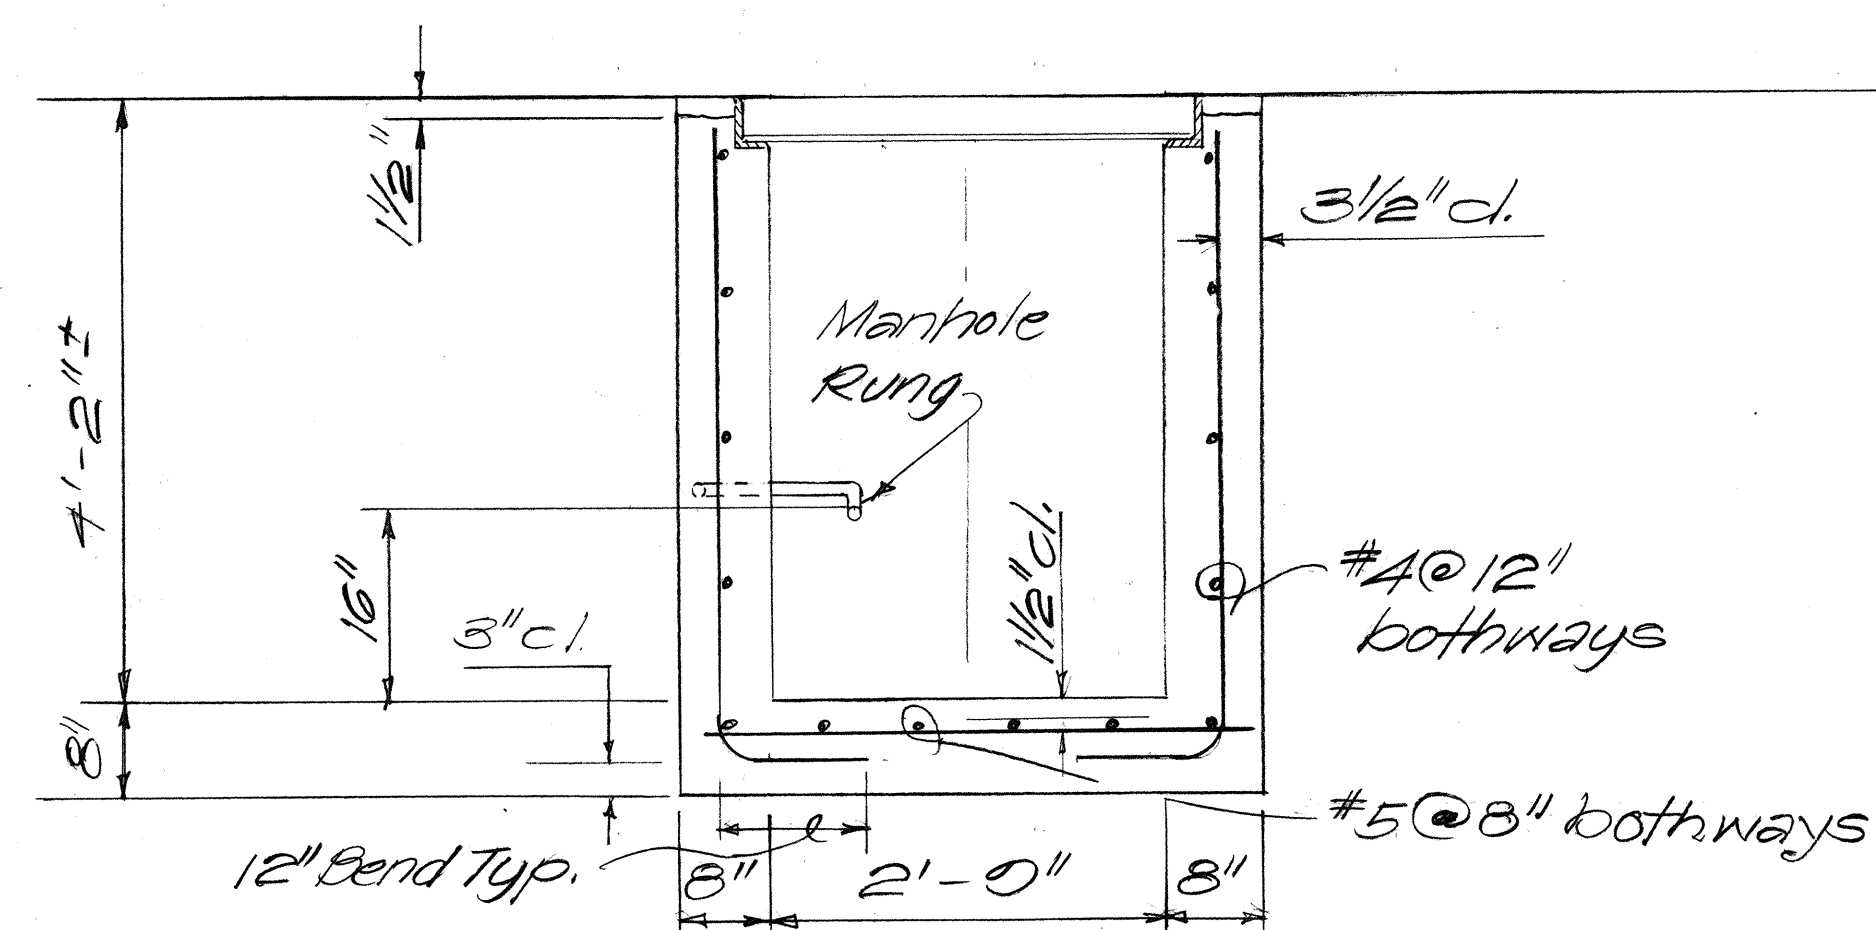

SECTION A
Scale: 3/4" = 1'-0"

DETAILS OF A-9P GRATED DROP INLET AT STA. 5+14 ±

NOTES:

- Existing drainage system will be functional at all times during construction. Contractor is to furnish materials, equipment, labor, tools and incidentals necessary to accomplish maintenance of flow, the cost of which shall be incidental to the various contract items.
- Demolishing and removing existing structure shall not be paid for separately, but shall be considered incidental to the various contract items.

STATE OF HAWAII
DEPARTMENT OF TRANSPORTATION
HIGHWAYS DIVISION

DRAINAGE DETAILS
KAMEHAMEHA HIGHWAY
REALIGNMENT AT WAIMEA BAY
PROJECT No. 83B-01-81

Scale: As Shown Date: Jan. 1987
SHEET No. 7 OF 1 SHEETS

ORIGINAL PLAN	DATE
DESIGNED BY	
NOTED BY	
CHECKED BY	
NO.	