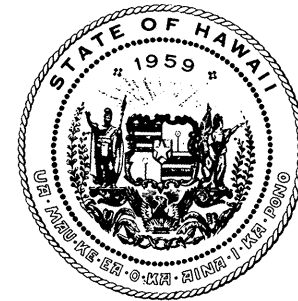


[illegible]

STATE OF HAWAII

DEPARTMENT OF TRANSPORTATION

HIGHWAYS DIVISION



HONOLULU, HAWAII

KAMEHAMEHA HIGHWAY

SLURRY SEAL

PROJECT NO. 83G-01-82M

FED. ROAD DIST. NO.	STATE	PROJ. NO.	FISCAL YEAR	SHEET NO.	TOTAL SHEETS
HAWAII	HAW.	83G-01-82M	1982	1	2

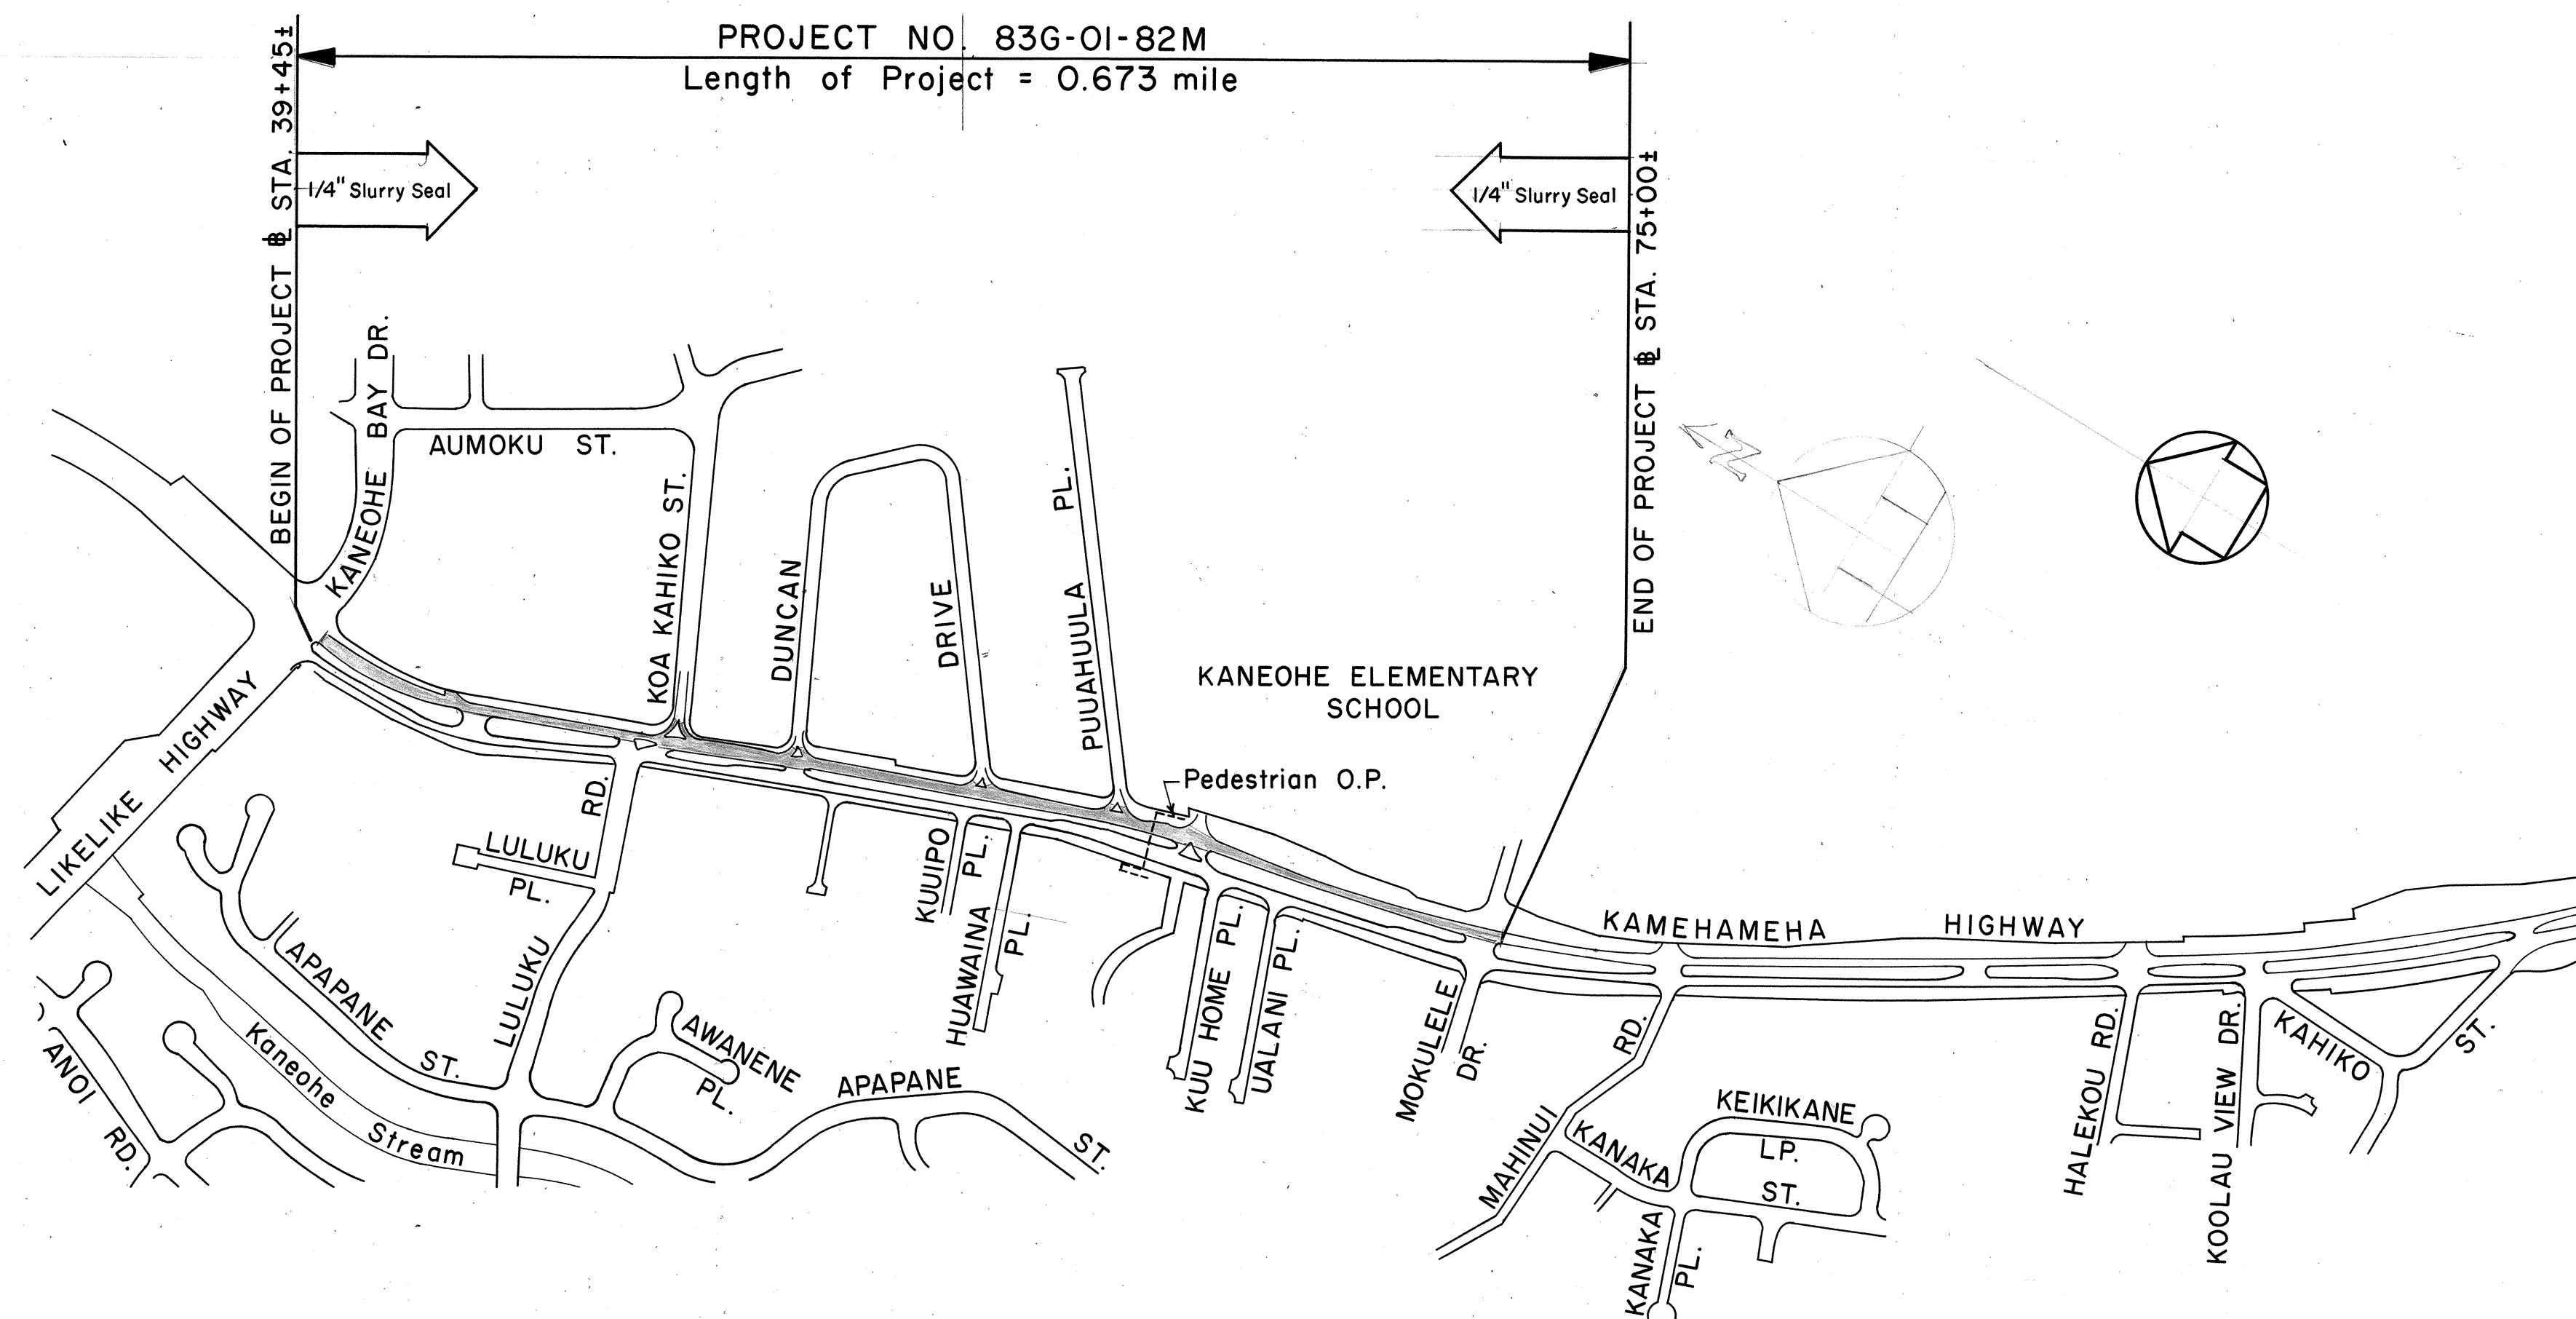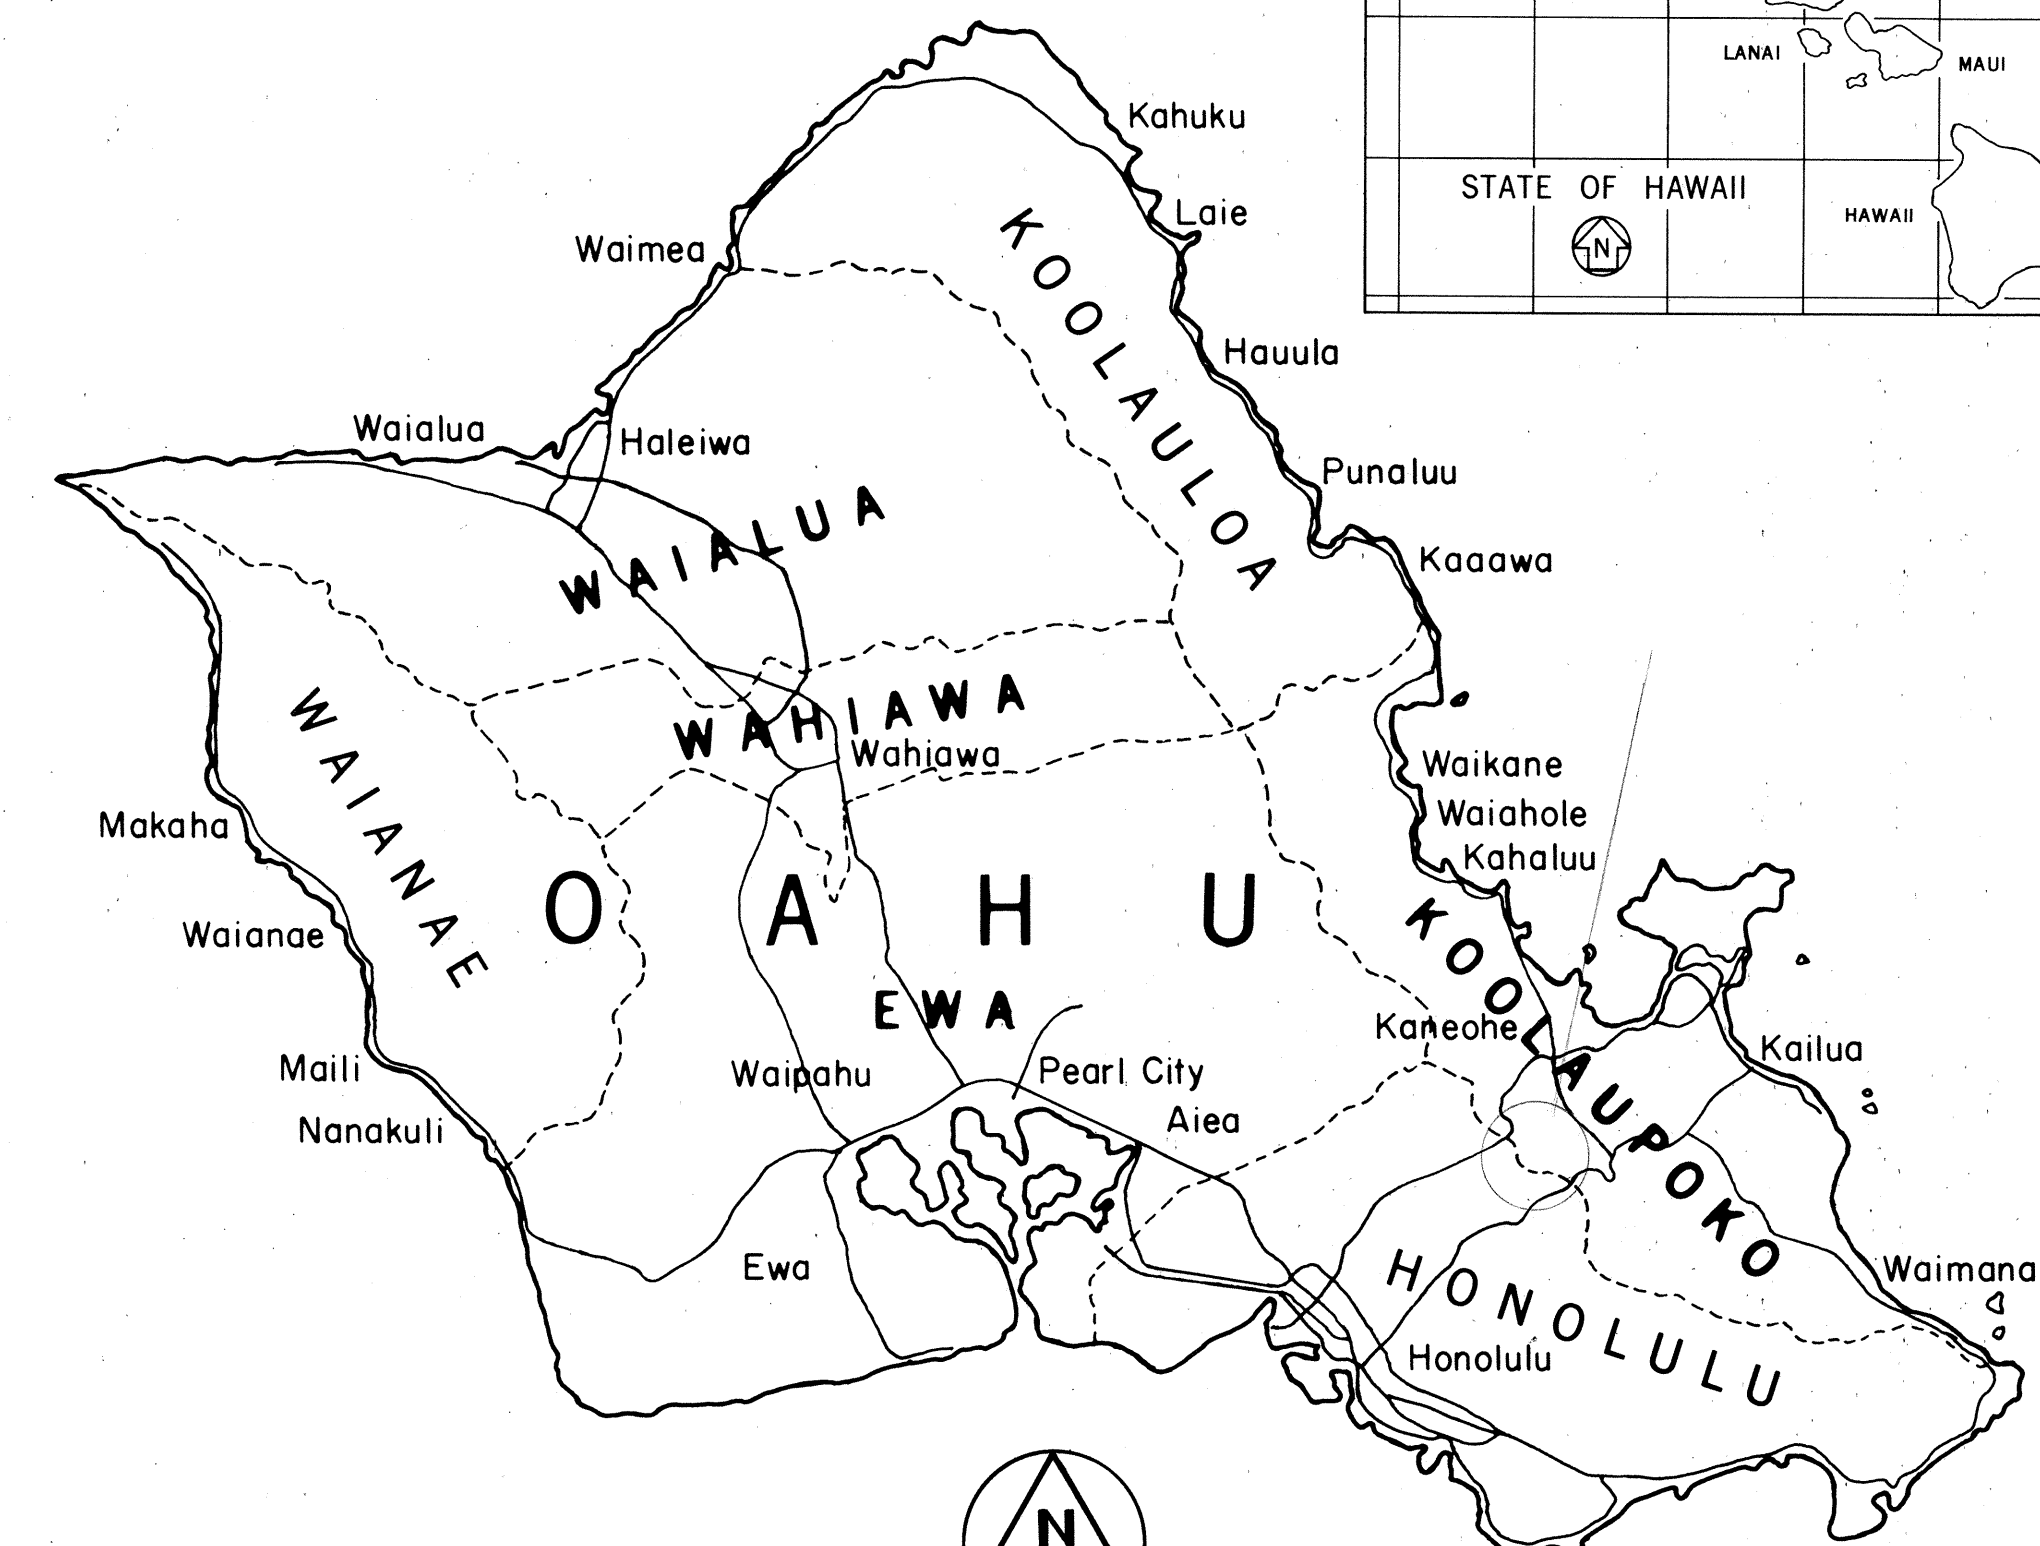

DEPARTMENT OF TRANSPORTATION STATE OF HAWAII	
APPROVED: <i>James R. Lanas</i> 4/15/86	
DIR. OF TRANSPORTATION	DATE