
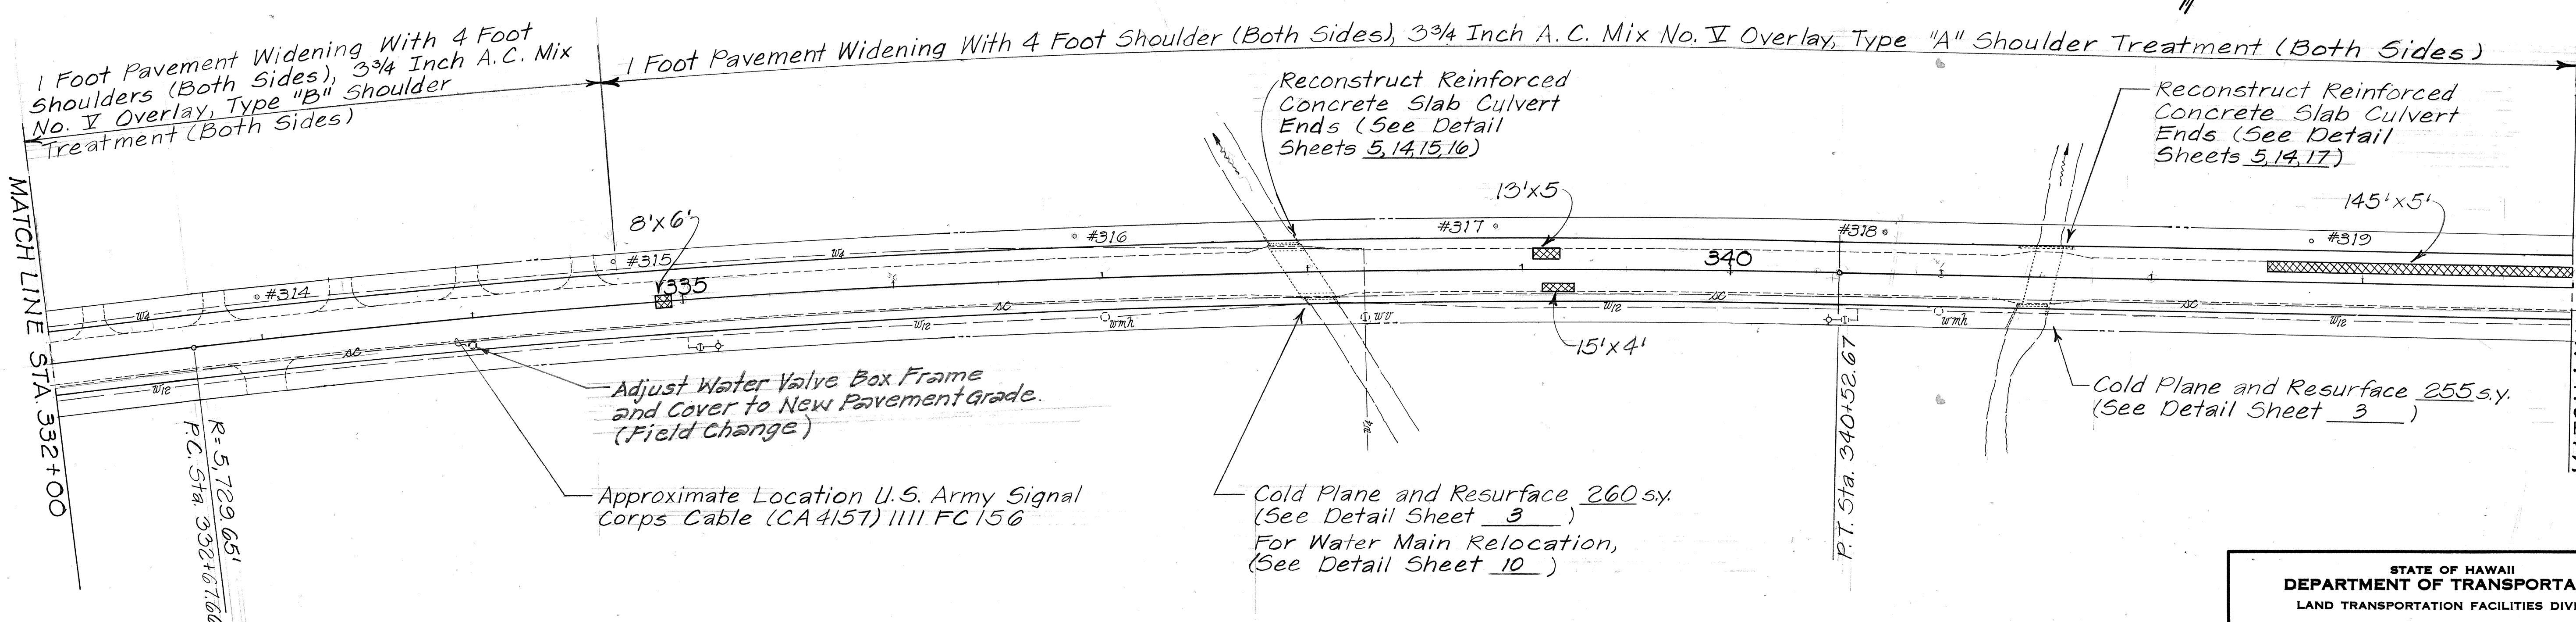


FED. ROAD DIST. NO.	STATE	FED. AID PROJ. NO.	FISCAL YEAR	SHEET NO.	TOTAL SHEETS
HAWAII	HAW.	FR-083-1(18)	1983	11	40


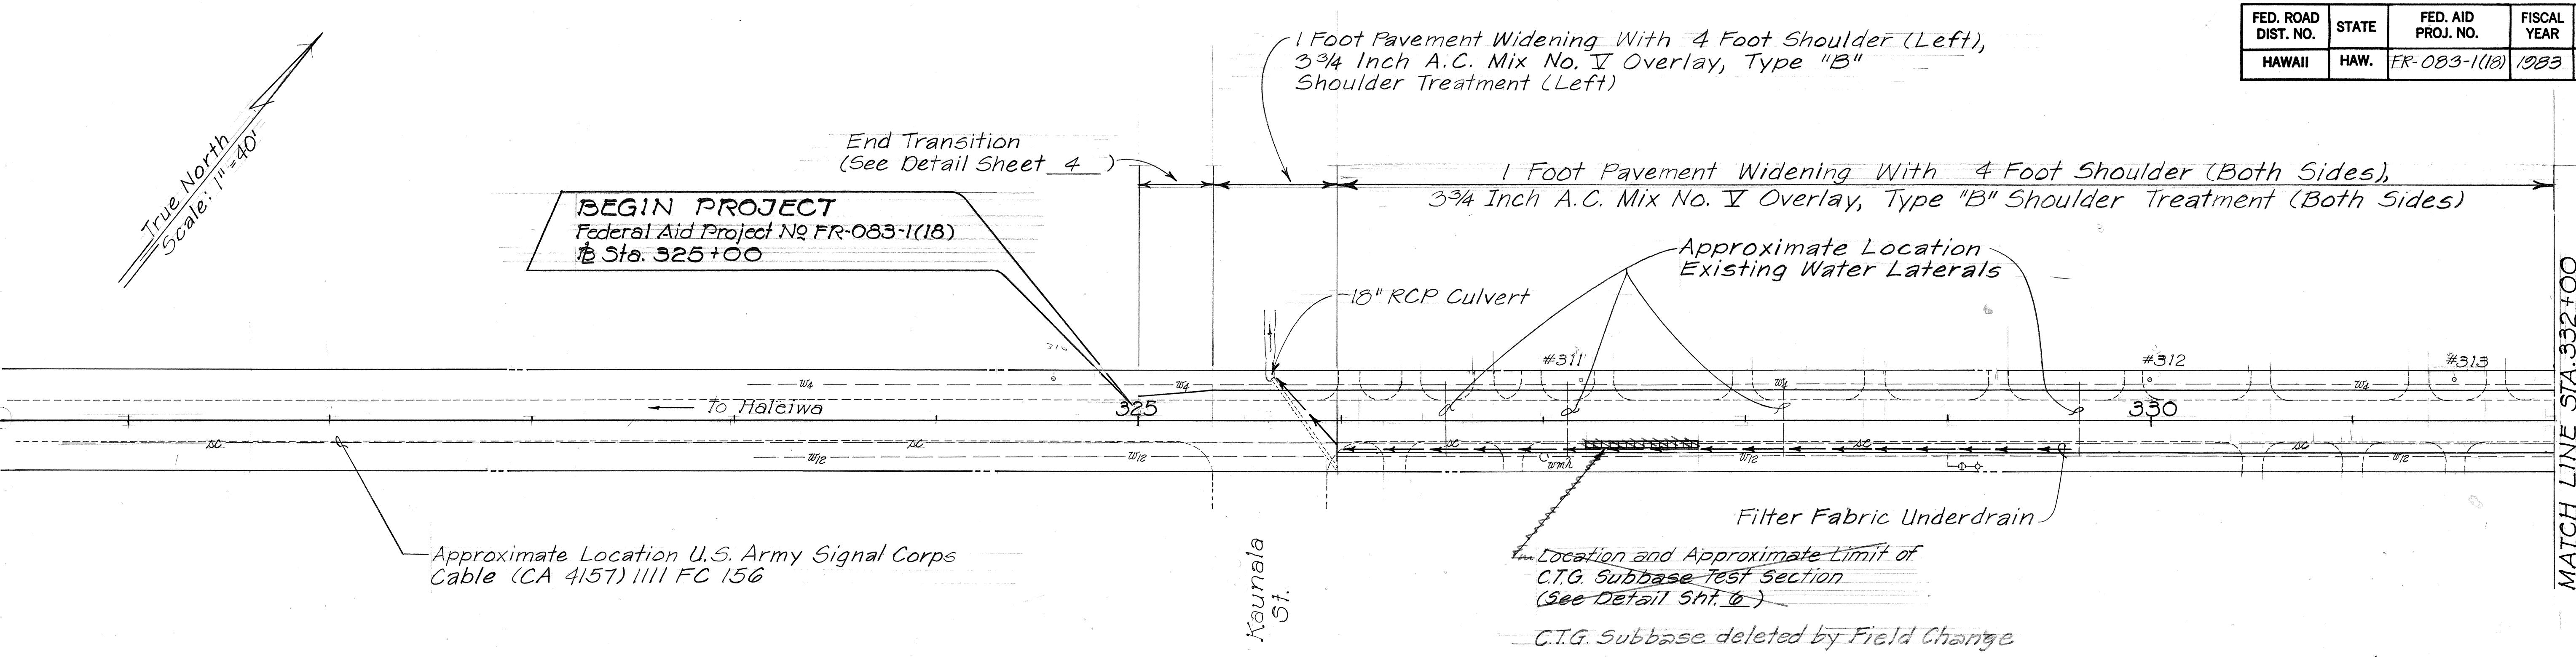


ORIGINAL PLAN	SURVEY PLOTTED BY	DATE
NOTE BOOK	DRAWN BY	
No.	DESIGNED BY	
	QUANTITIES BY	
	CHECKED BY	

APPROVED: Date 2-16-83
R. Negato
 Chief, Planning & Engineering, BWS

STATE OF HAWAII
 DEPARTMENT OF TRANSPORTATION
 LAND TRANSPORTATION FACILITIES DIVISION
 ROADWAY PLANS
 KAMEHAMEHA HWY. RESURFACING
 KAUNALA STREET TO
 VICINITY OF WAIALEE BRIDGE
 Fed. Aid Proj. No. FR-083-1(18)
 Scale: 1"=40' Date: Feb, 1983
 SHEET NO. 1 OF 3 SHEETS

FED. ROAD DIST. NO.	STATE	FED. AID PROJ. NO.	FISCAL YEAR	SHEET NO.	TOTAL SHEETS
HAWAII	HAW.	FR-083-1(18)	1983	12	40

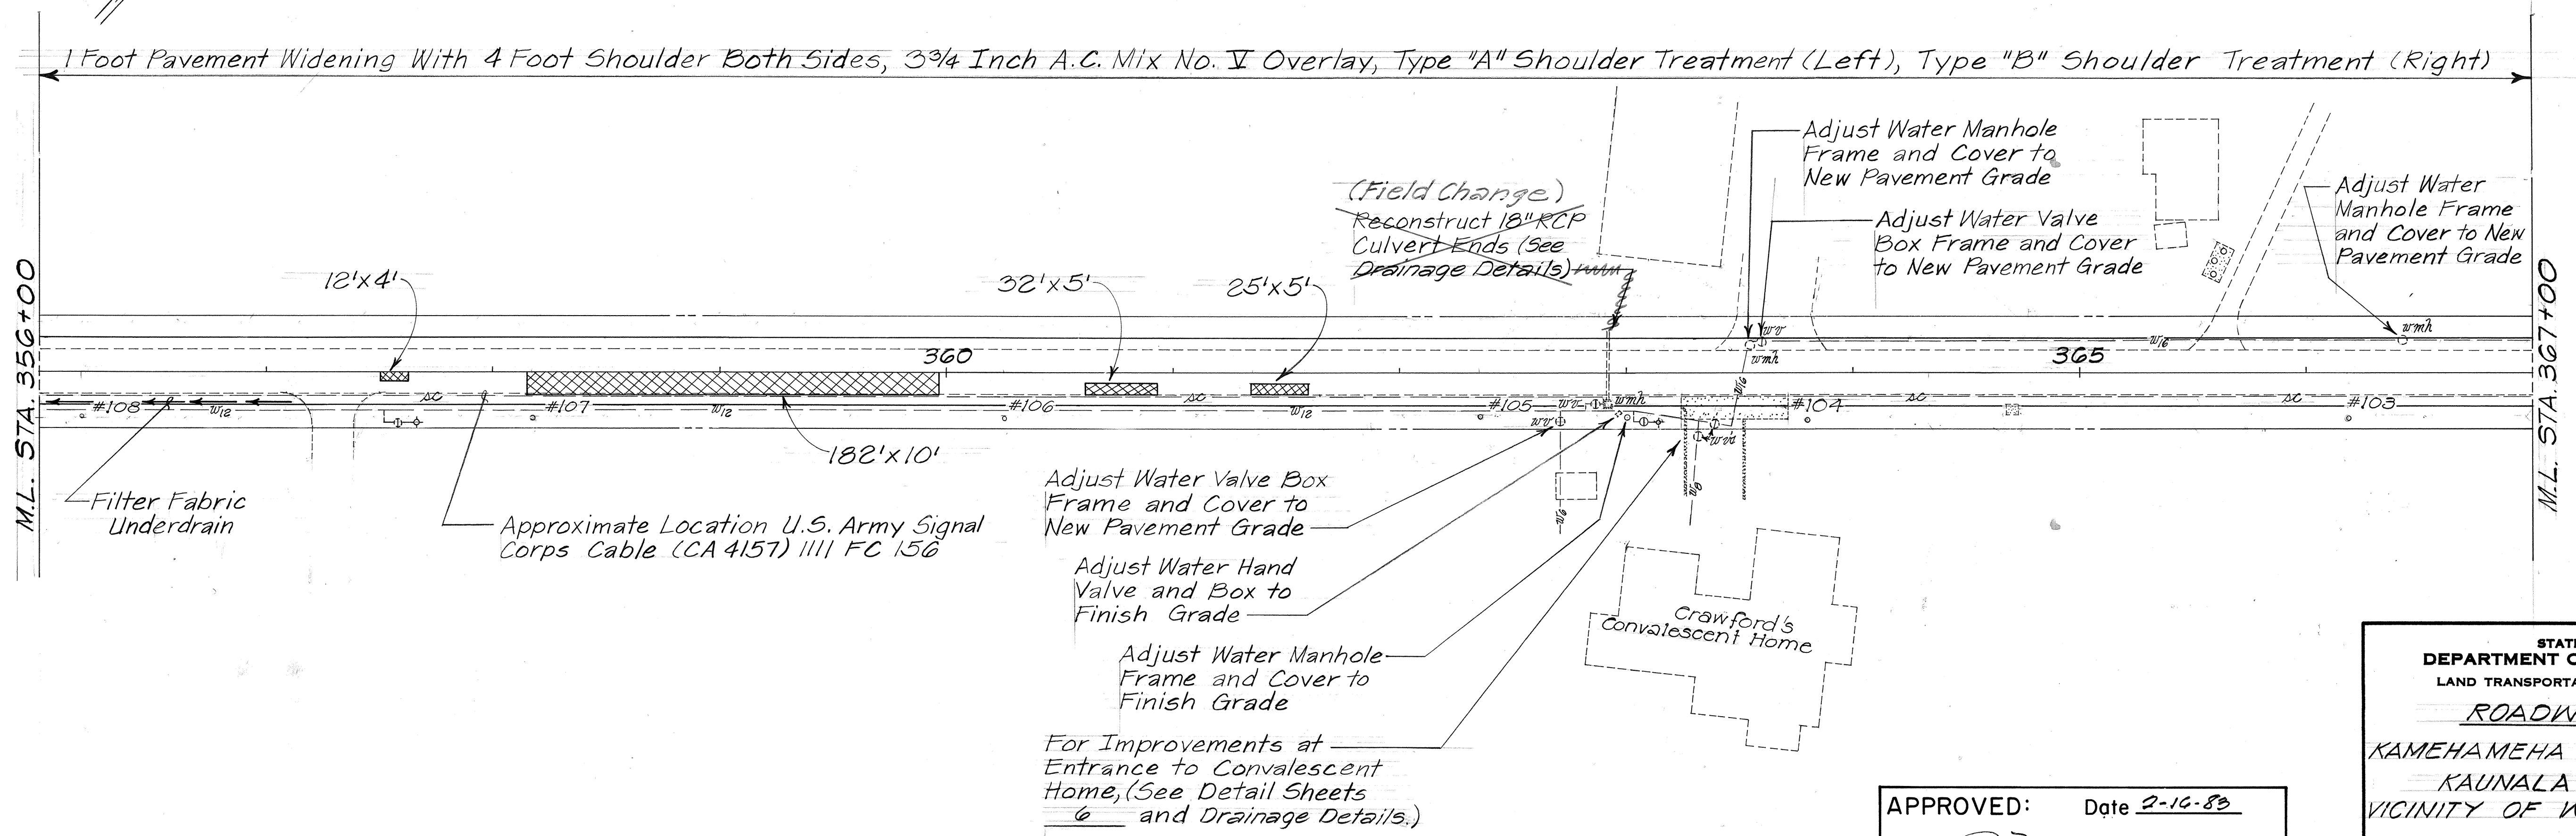
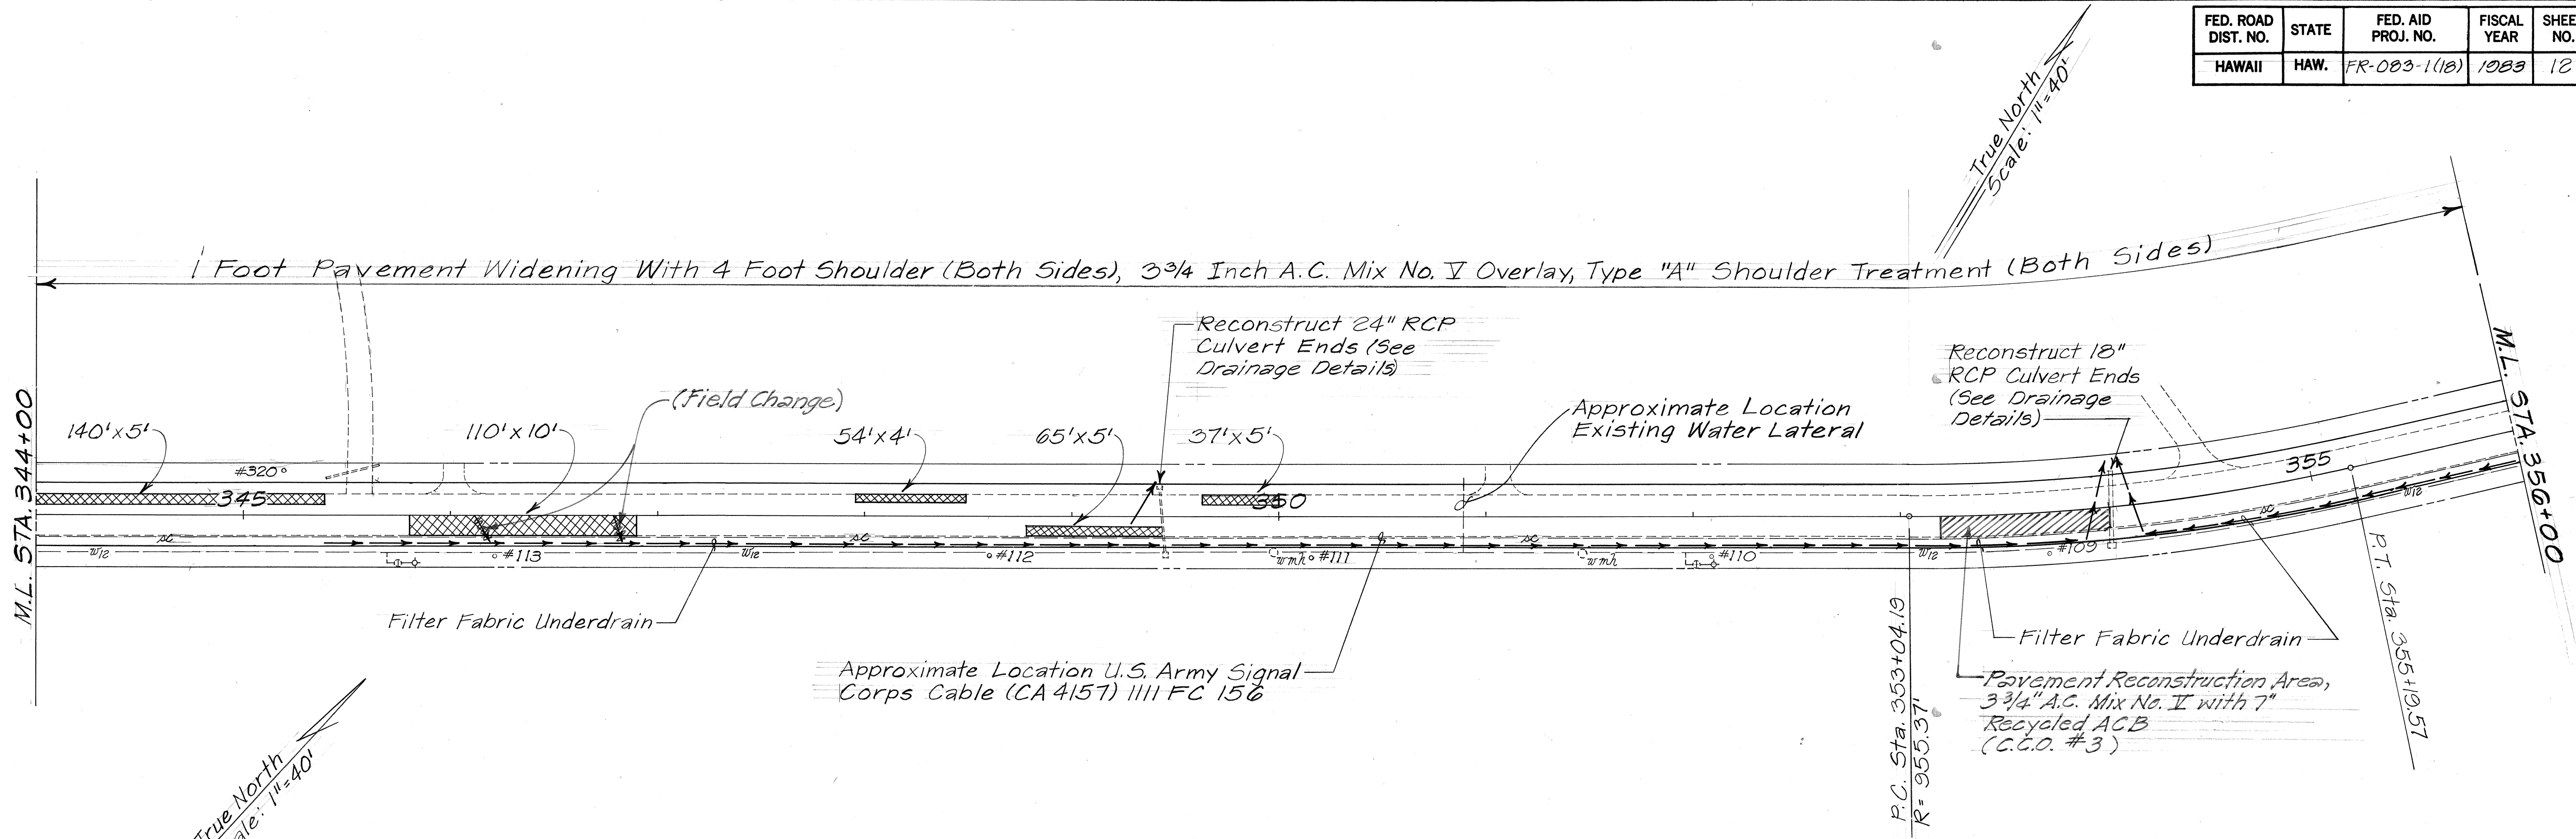


ORIGINAL PLAN	DATE
SURVEY PLOTTED BY	
DRAWN BY	
DESIGNED BY	
QUANTITIES BY	
CHECKED BY	

APPROVED: Date 2-16-83
R. Negato
 Chief, Planning & Engineering, BWS

STATE OF HAWAII
 DEPARTMENT OF TRANSPORTATION
 LAND TRANSPORTATION FACILITIES DIVISION
ROADWAY PLANS
 KAMEHAMEHA HWY. RESURFACING
 KAUNALA STREET TO
 VICINITY OF WAIALEE BRIDGE
 Fed. Aid Proj. No. FR-083-1(18)
 Scale: 1"=40' Date: Feb. 1983
 SHEET NO. 2 OF 3 SHEETS

FED. ROAD DIST. NO.	STATE	FED. AID PROJ. NO.	FISCAL YEAR	SHEET NO.	TOTAL SHEETS
HAWAII	HAW.	FR-083-1(18)	1983	13	40

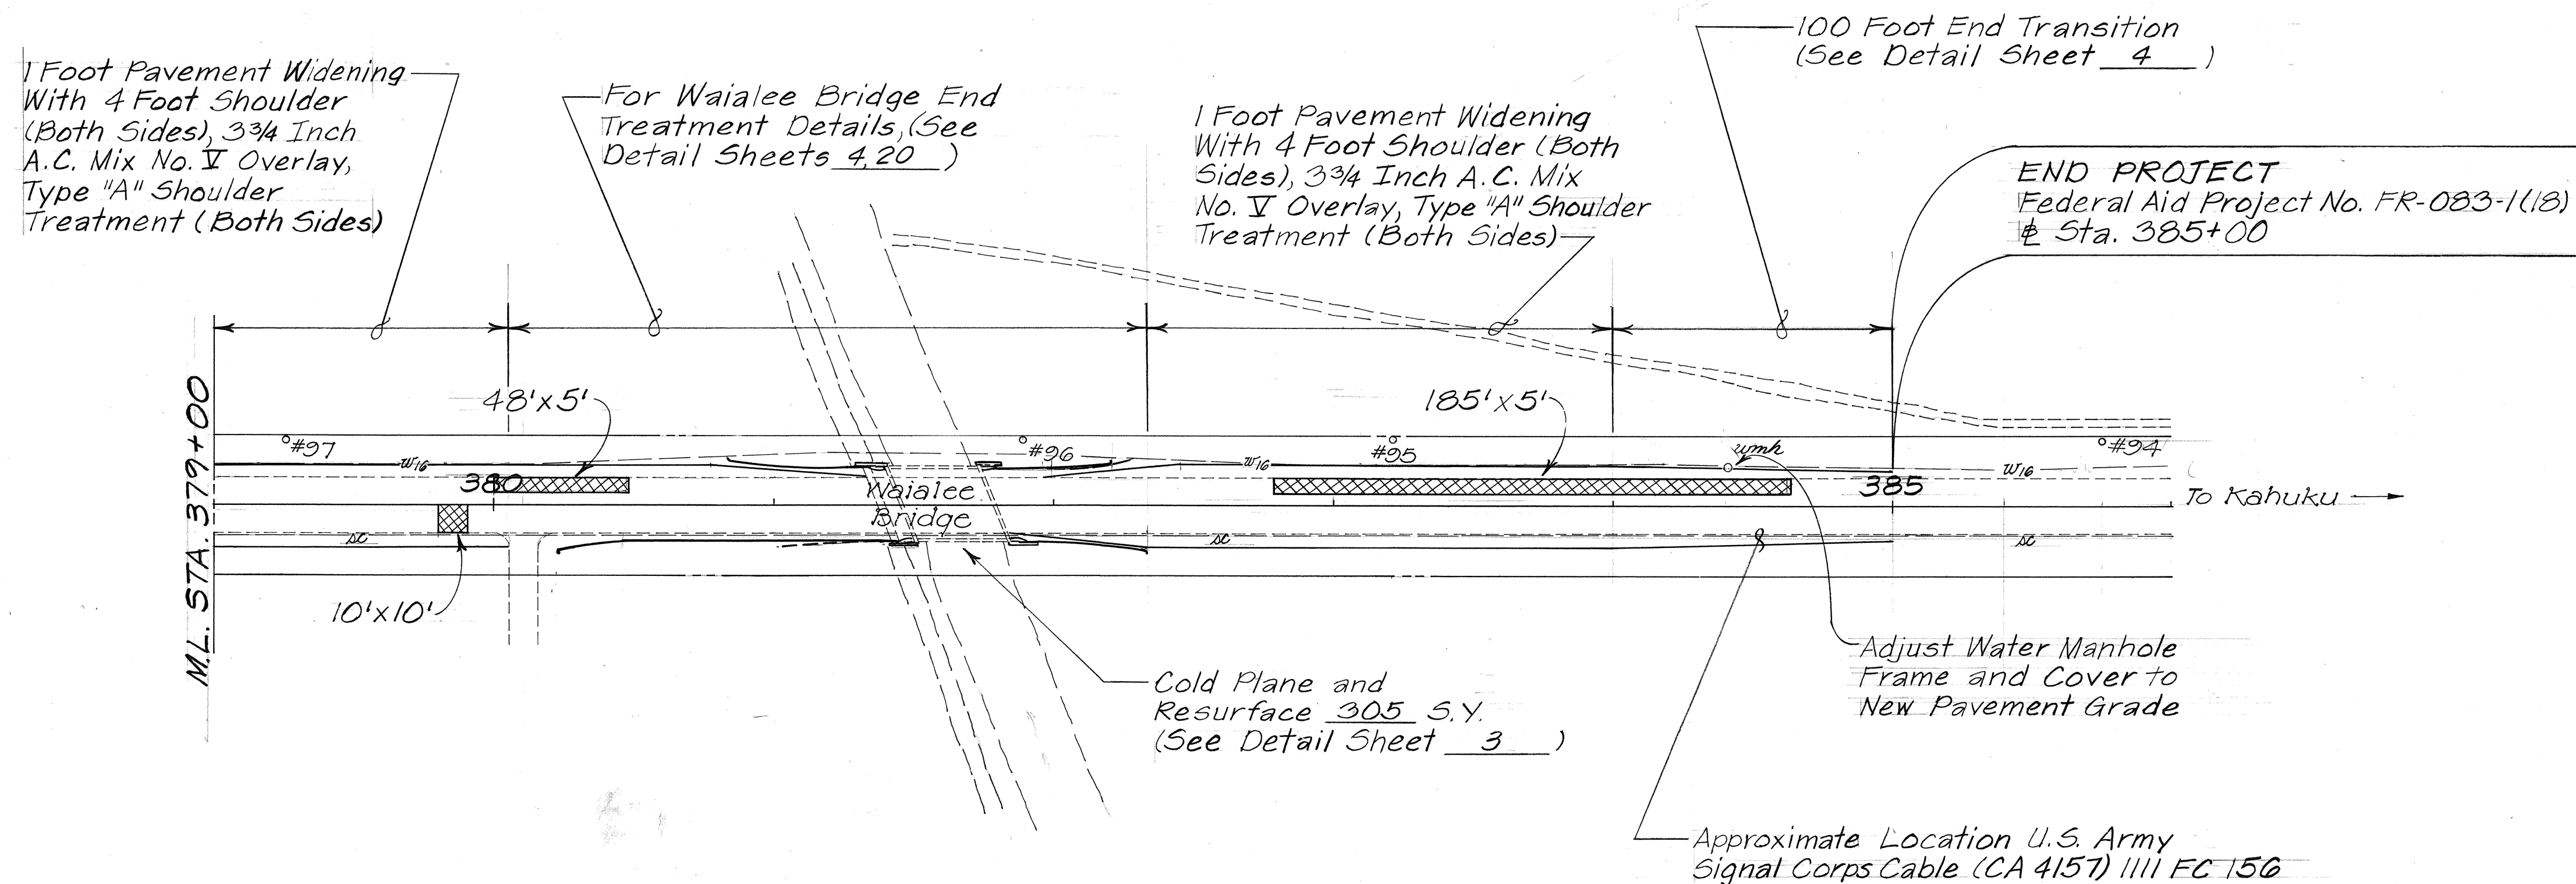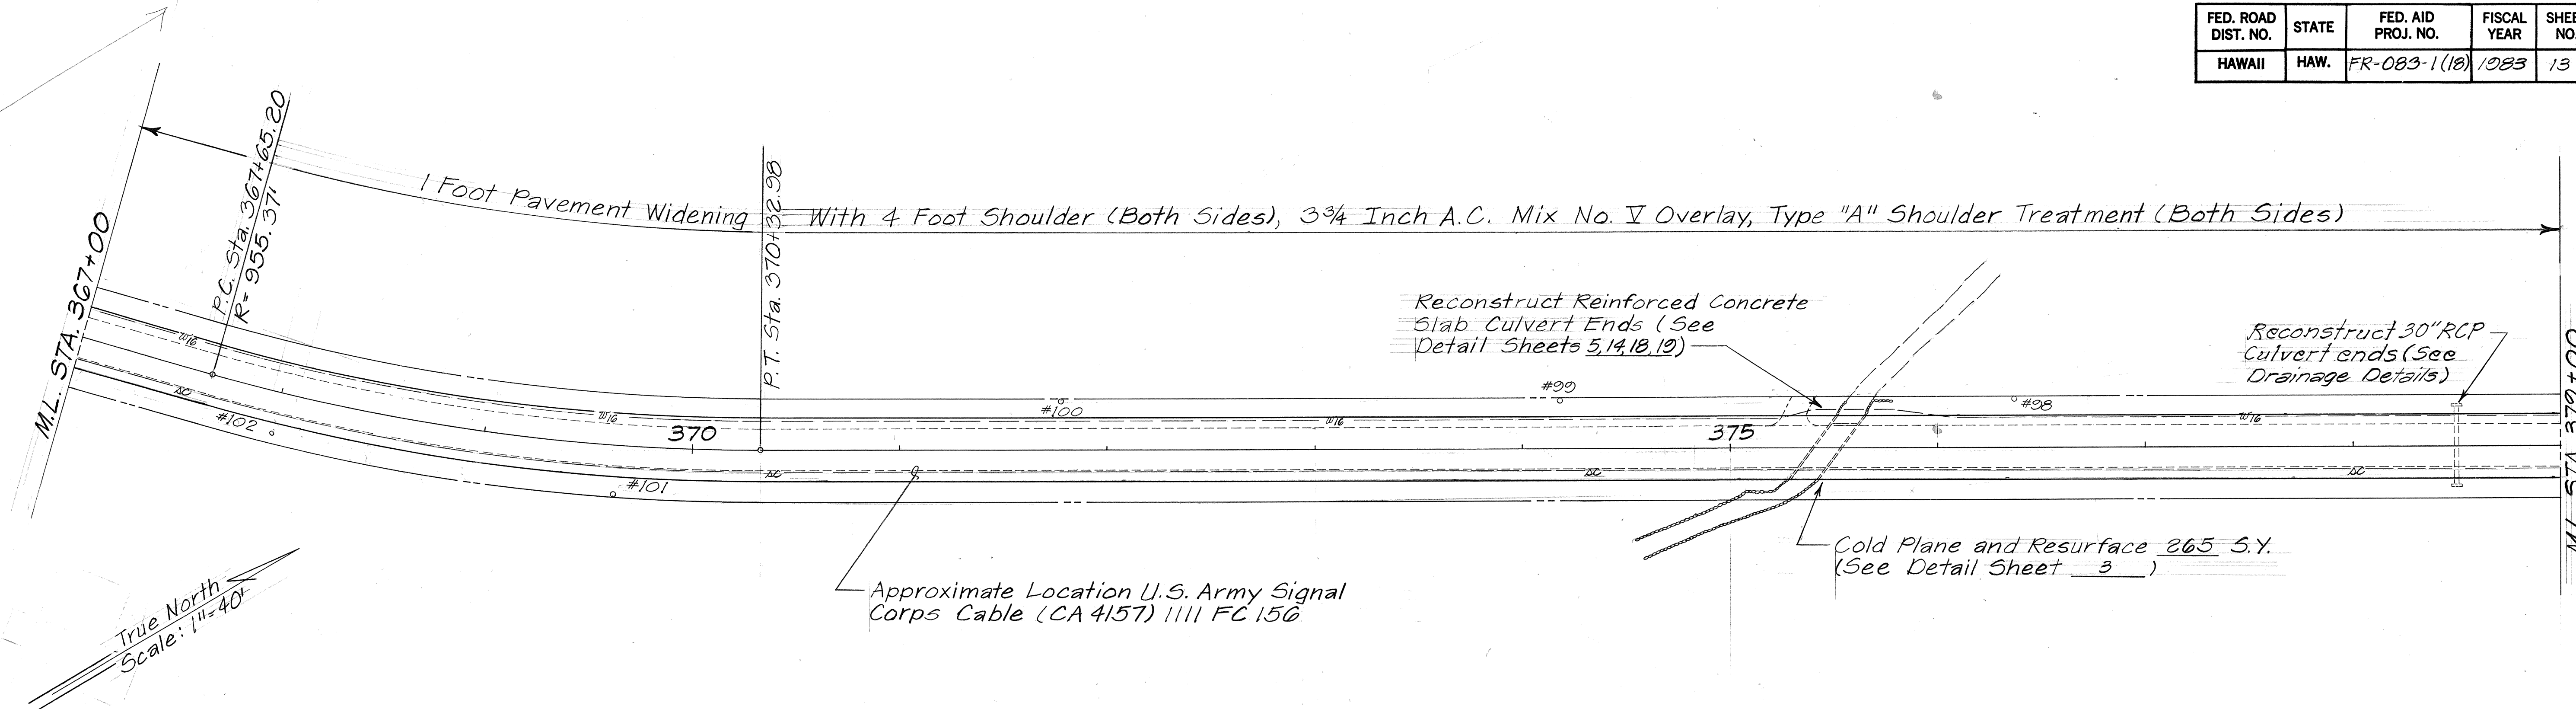

ORIGINAL PLAN	DATE
DRAWN BY	
DESIGNED BY	
QUANTITIES BY	
CHECKED BY	

APPROVED: Date 2-16-83
R. Nagata
 Chief, Planning & Engineering, BWS

STATE OF HAWAII
 DEPARTMENT OF TRANSPORTATION
 LAND TRANSPORTATION FACILITIES DIVISION
ROADWAY PLANS
 KAMEHAMEHA HWY. RESURFACING
 KAUNALA STREET TO
 VICINITY OF WAIALEE BRIDGE
 Fed. Aid Proj. No. FR-083-1(18)
 Scale: 1"=40' Date: Feb, 1983
 SHEET NO. 3 OF 3 SHEETS