,	INDEX TO DRAWINGS									
SHEET NO.	DESCRIPTION									
	TITLE SHEET									
2	NOTES AND LEGEND									
7 0	TYPICAL SECTIONS AND									
3 + 9	ROADWAY DETAILS.									
10	WATER DETAILS									
11-13	ROADWAY PLANS									
14: 24	CULVERT EXTENSION AND									
14-24	BRIDGE DETAILS									
25-29	DRAINAGE DETAILS									
70.40	PAVEMENT MARKING PLANS									
30-40	AND DETAILS									
	ч.									
ı										
E ST										
	e e e e e e e e e e e e e e e e e e e									
~	<i>d</i> *									
÷ ,										

1 C.O. 19 S-I IS SUPPLEMENT SHEET TO THE CONTRACT PLANS. NEW TOTAL = 41 SHEETS



STATE OF HAWAII

DEPARTMENT OF TRANSPORTATION

HIGHWAYS DIVISION


HONOLULU, HAWAII


"AS BUILT"

PLANS FOR

KAMEHAMEHA HIGHWAY RESURFACING KAUNALA STREET TO VICINITY OF WAIALEE BRIDGE FEDERAL AID PROJECT NO. FR-083-1(18)

> DISTRICT OF KOOLAULOA ISLAND OF OAHU

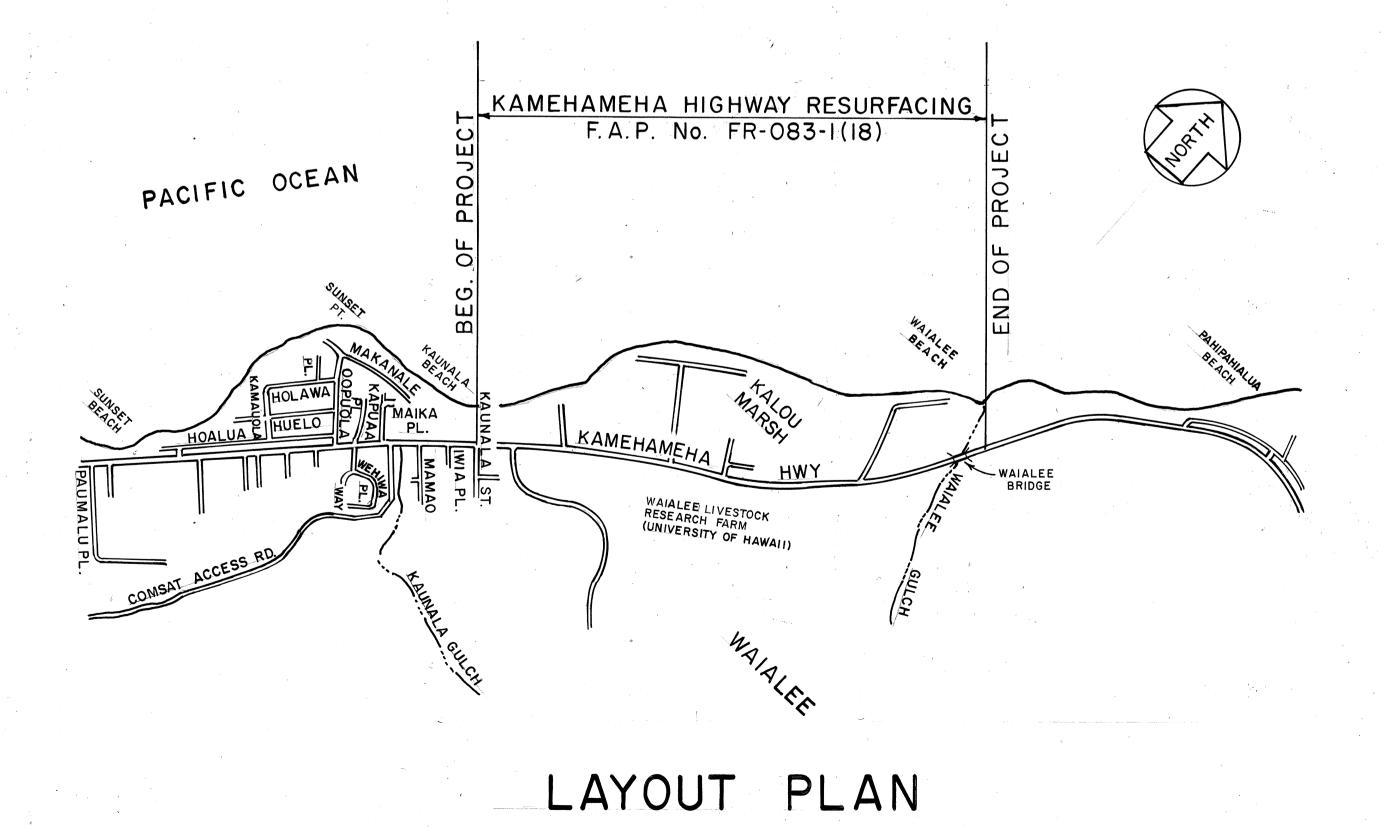

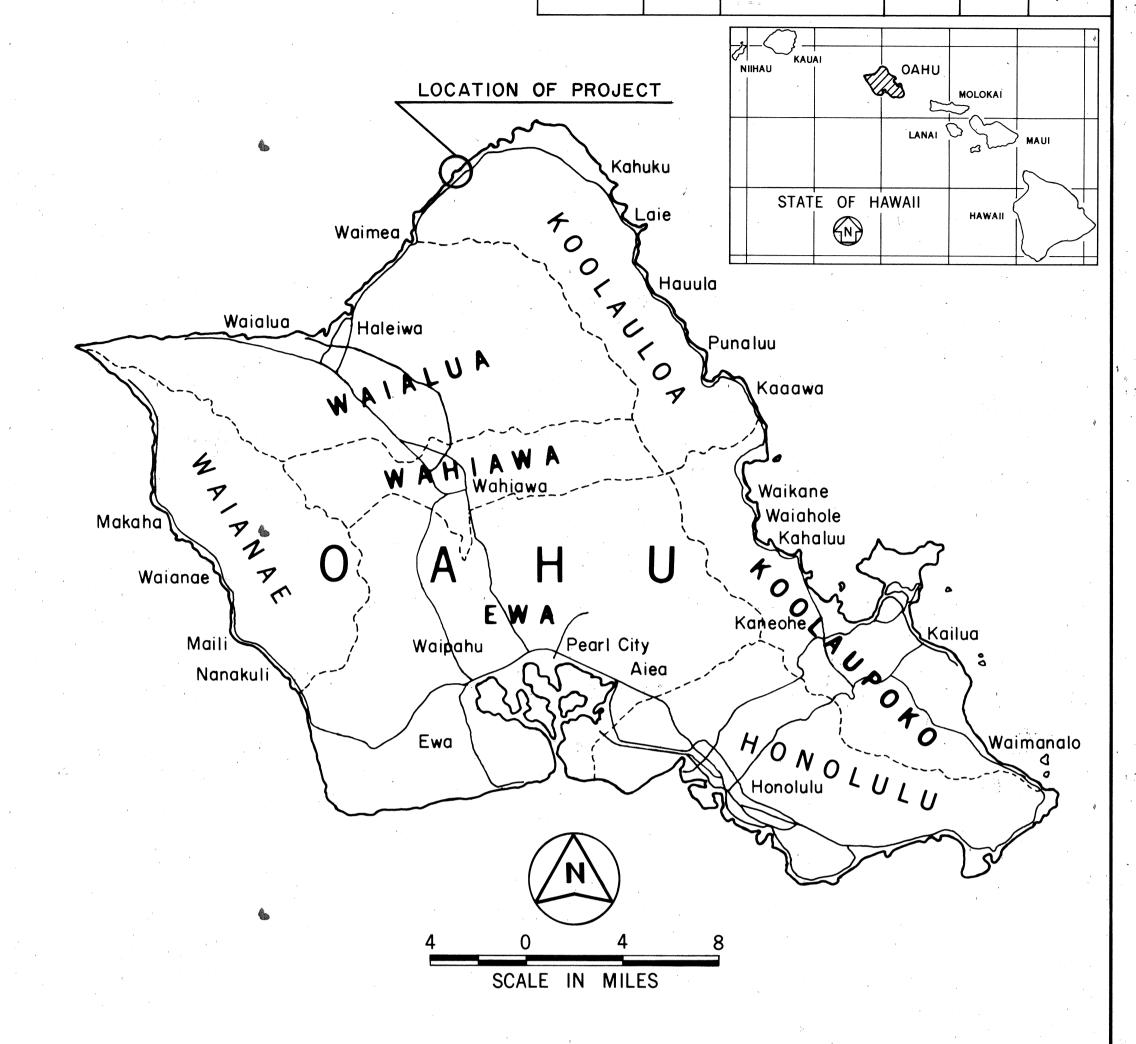

FED. ROAD DIST. NO.

ALL CHANGES MADE DURING CONSTRUCTION HAVE BEEN INCORPORATED ON THESE PLANS IN RED EXCEPT CHANGES IN THE ORIGINAL THEORETICAL QUANTITIES. FOR ACTUAL QUANTITIES, REFER TO PROJECT LEDGER AND/OR COMPUTATION BOOK.

Albert & Pushi RESIDENT ENGINEER

_DESIGN DESIGNATION

 					_								
													8,234
DESI	GN	J	Αl	TC	(15	99	3).	• *	•	•	10,800
DHV	•				•	•		•	•	•			1,300
D	•	• ,		• '	•								55/50
T			•.				·•	•		•	•		5.0%
٧	• -			•	•	. 🕊			• •		• (5 5 M.P.H.

DEPARTMENT OF TRANSPORTATION FEDERAL HIGHWAY ADMINISTRATION APPROVED: Metrhus 3/29/83

ON DIVISION ADMINISTRATOR

DEPARTMENT OF TRANSPORTATION STATE OF HAWAII APPROVED: DIR. OF TRANSPORTATION

548-7537 PHONE

GRAPHIC SCALE IN FEET