



STATE OF HAWAII


DEPARTMENT OF TRANSPORTATION

HIGHWAYS DIVISION



HONOLULU, HAWAII

"AS BUILT"

PLANS FOR

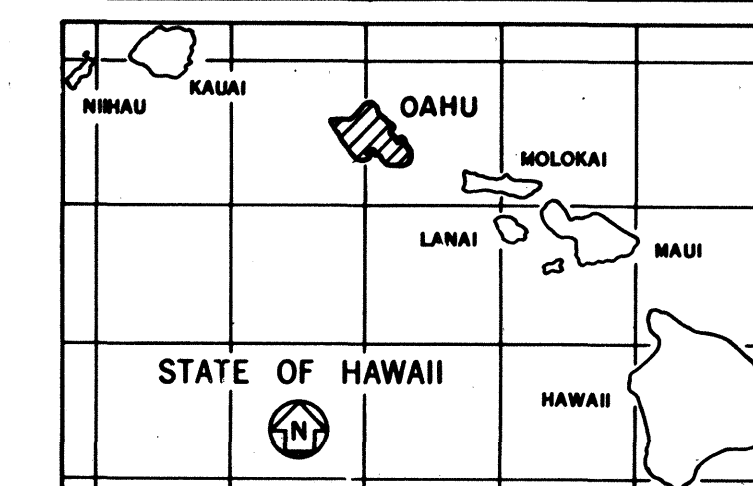

LOCATION OF PROJECT
F.A. PROJECT NO.
FR-083-1(17)

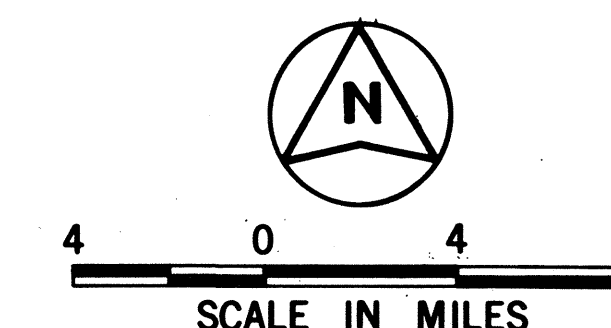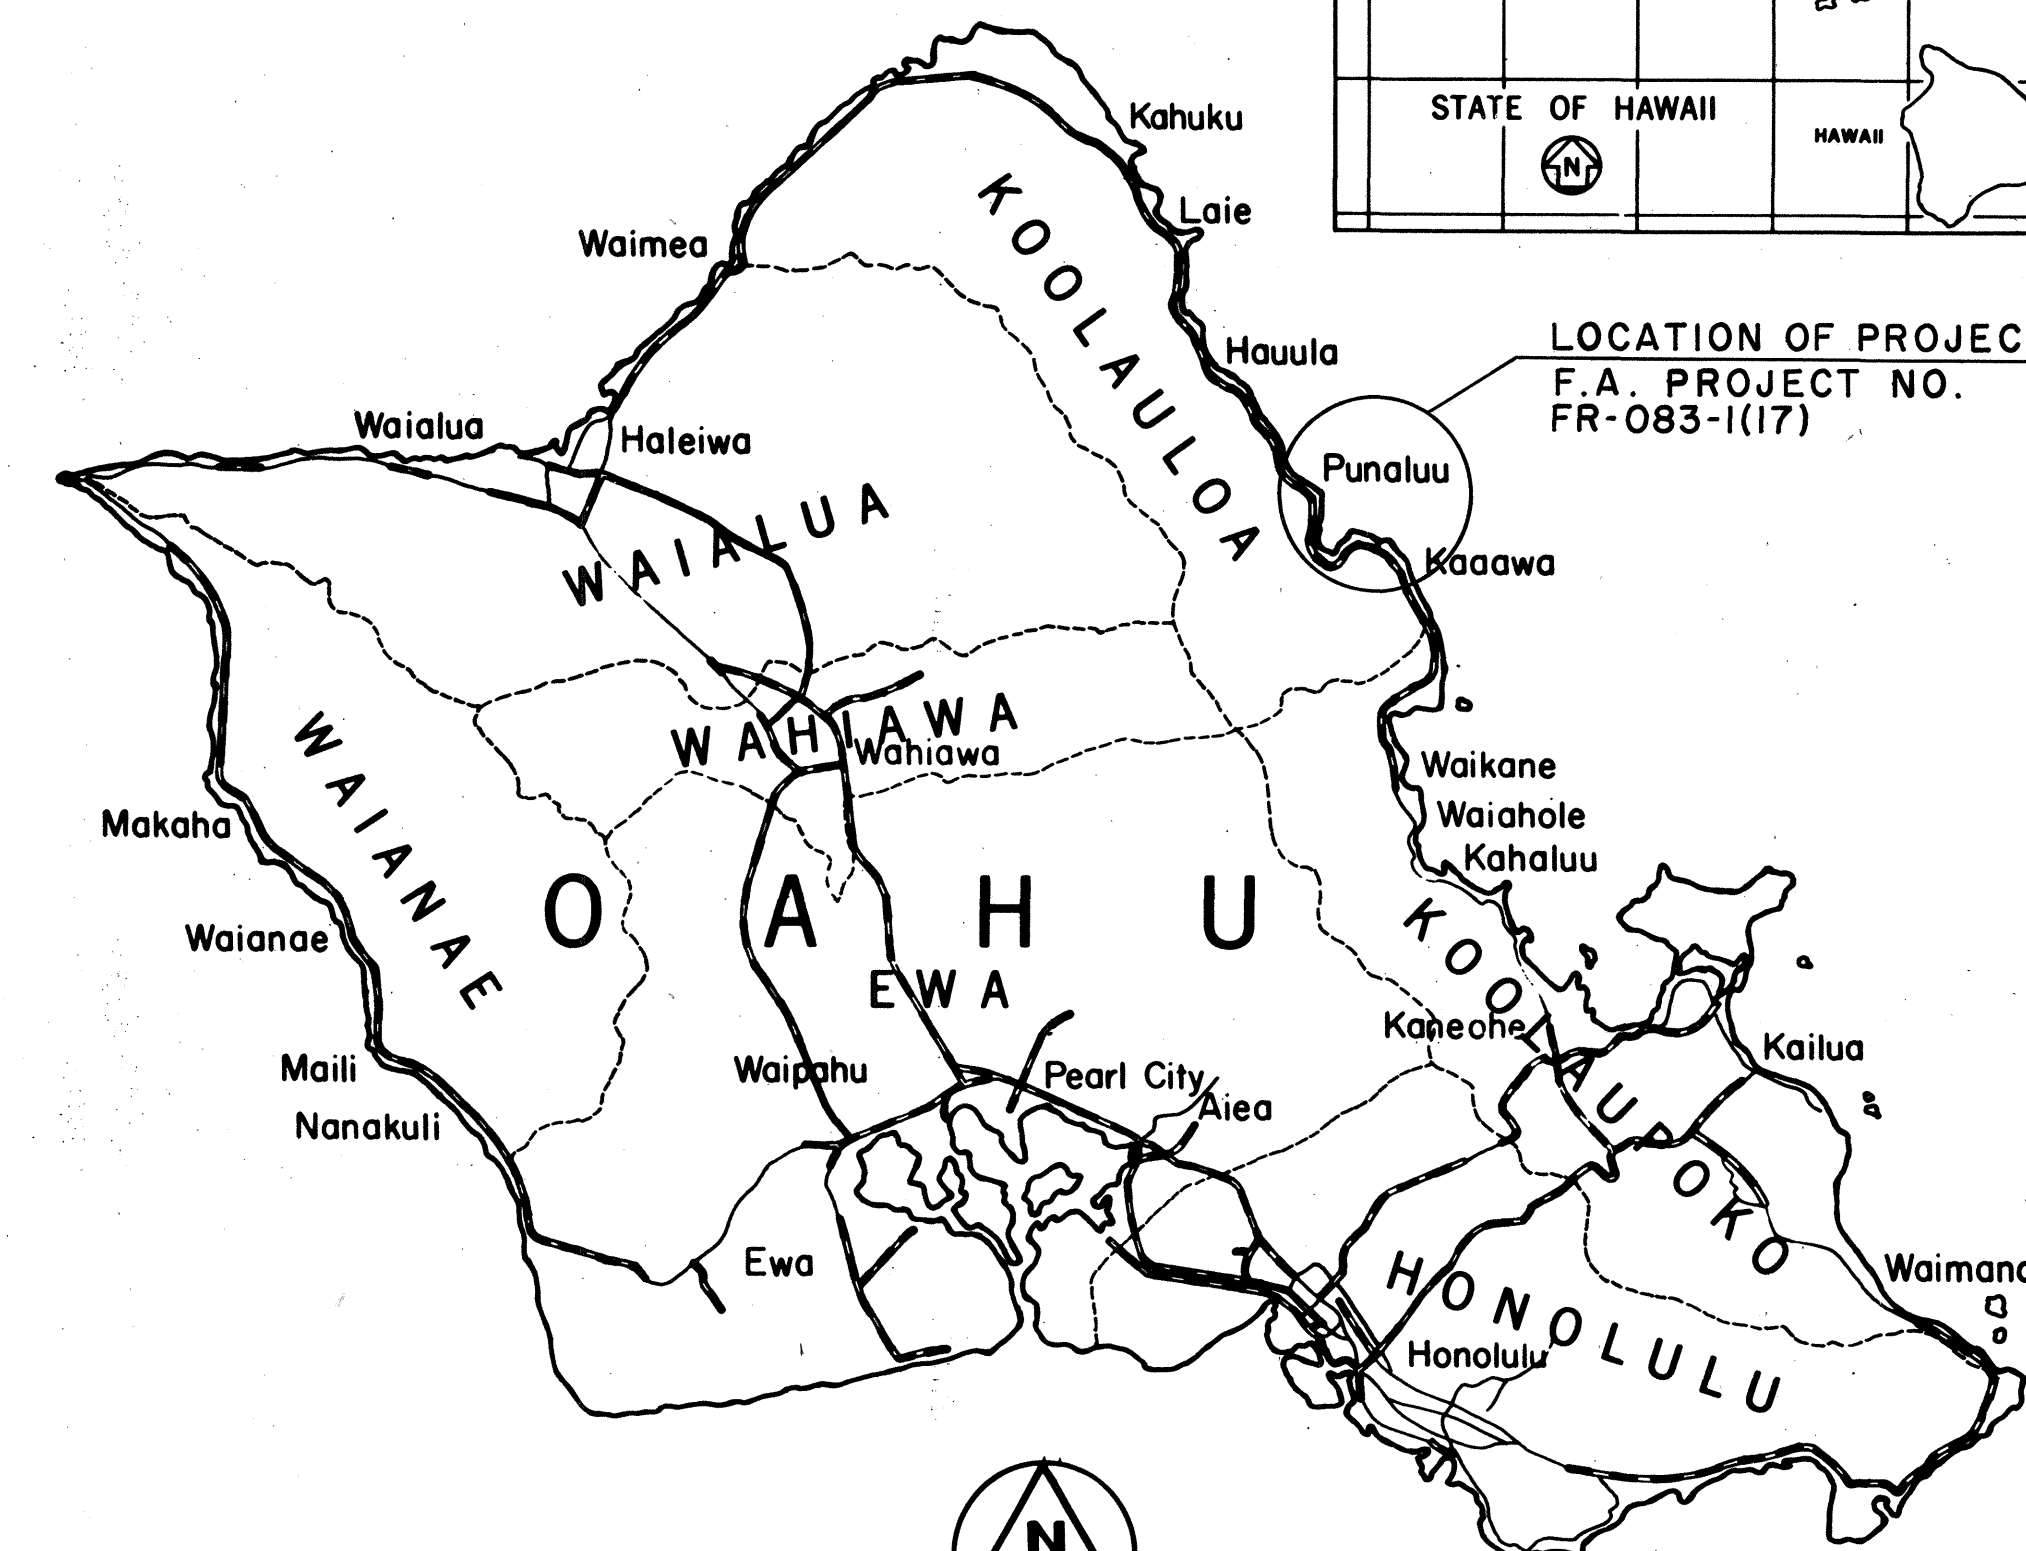

**FEDERAL AID PROJECTS PREVIOUSLY CONSTRUCTED
OR UNDER CONSTRUCTION**

CHANGES MADE DURING CONSTRUCTION HAVE BEEN INCORPORATED
ON THESE PLANS EXCEPT CHANGES IN THE ORIGINAL THEORETICAL
QUANTITIES. FOR ACTUAL QUANTITIES, REFER TO PROJECT LEDGER
AND/OR COMPUTATION BOOK.

Albert L. Nishu
PROJECT ENGINEER

5/3/84
DATE

DESIGN	DESIGNATION
DESIGN ADT (1993)	10,800
DHV	1,300
D	60/40
T	5.0%
V	55 MPH

DEPARTMENT OF TRANSPORTATION FEDERAL HIGHWAY ADMINISTRATION	
APPROVED:	
<i>[Signature]</i>	4/22/68
DIVISION ADMINISTRATOR	DATE

DEPARTMENT OF TRANSPORTATION STATE OF HAWAII	
APPROVED: <i>R. Higashimura</i>	3/29/8
DIR. OF TRANSPORTATION	DATE

