



FED. ROAD DIST. NO.	STATE	FED. AID PROJ. NO.	FISCAL YEAR	SHEET NO.	TOTAL SHEETS
HAWAII	HAW.	FR-083-1(17)	1983	3	25






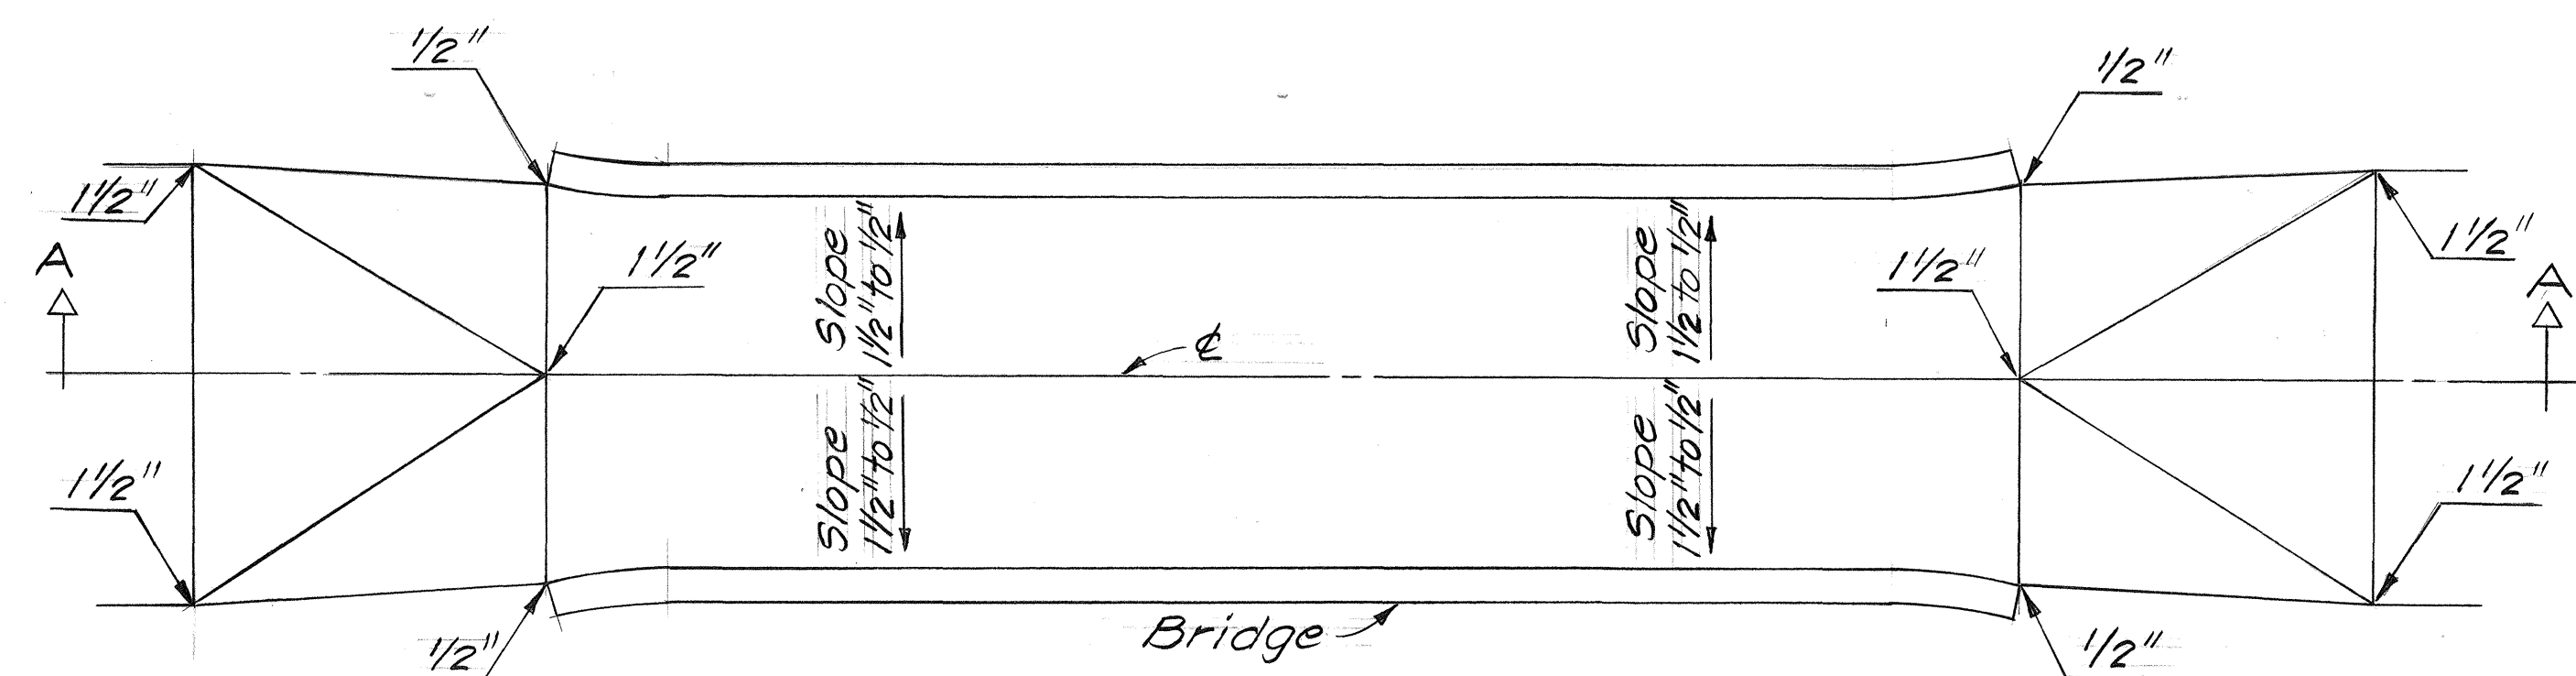


Denotes the height of new A.C. Pavement, Mix No. V above Cold Planed pavement surface.

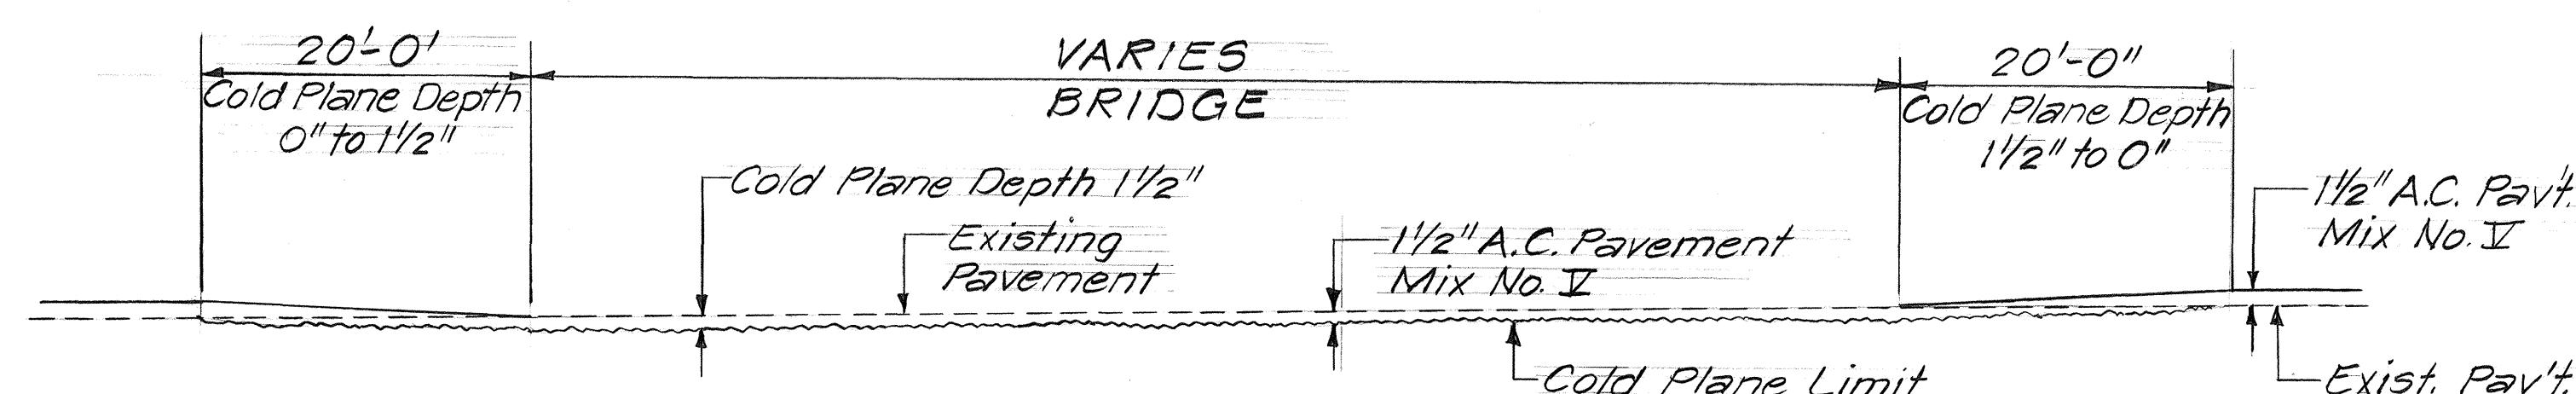


ROADWAY BRIDGES TO BE COLD PLANED	
NAME OF BRIDGE	APPROX. QUANTITIES (SQ. YD.)
Kahana Bridge No. 57	200
Kahana Bridge No. 56	196

PAVING DETAIL OVER BRIDGES

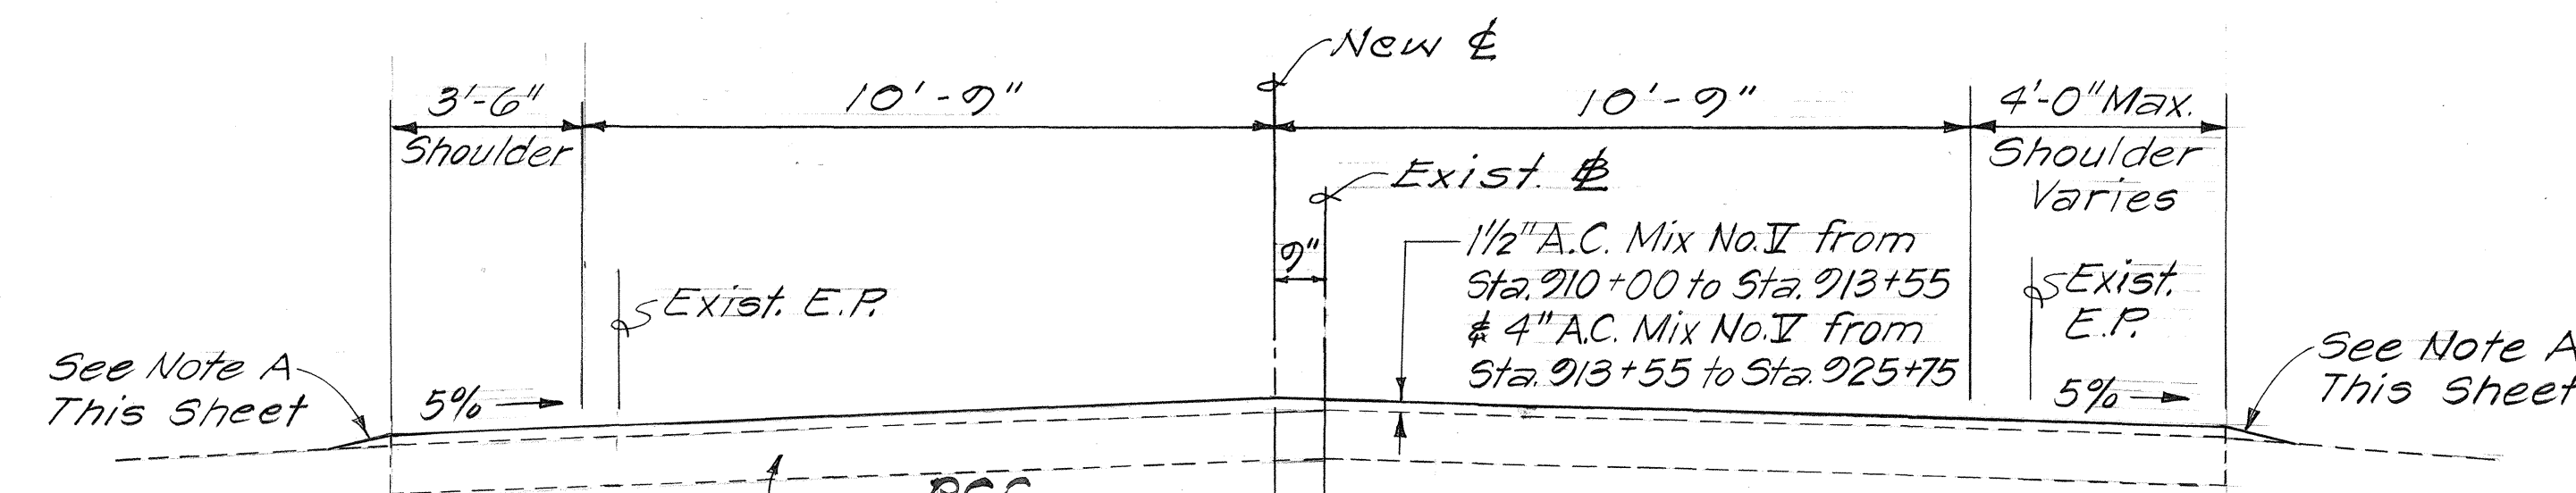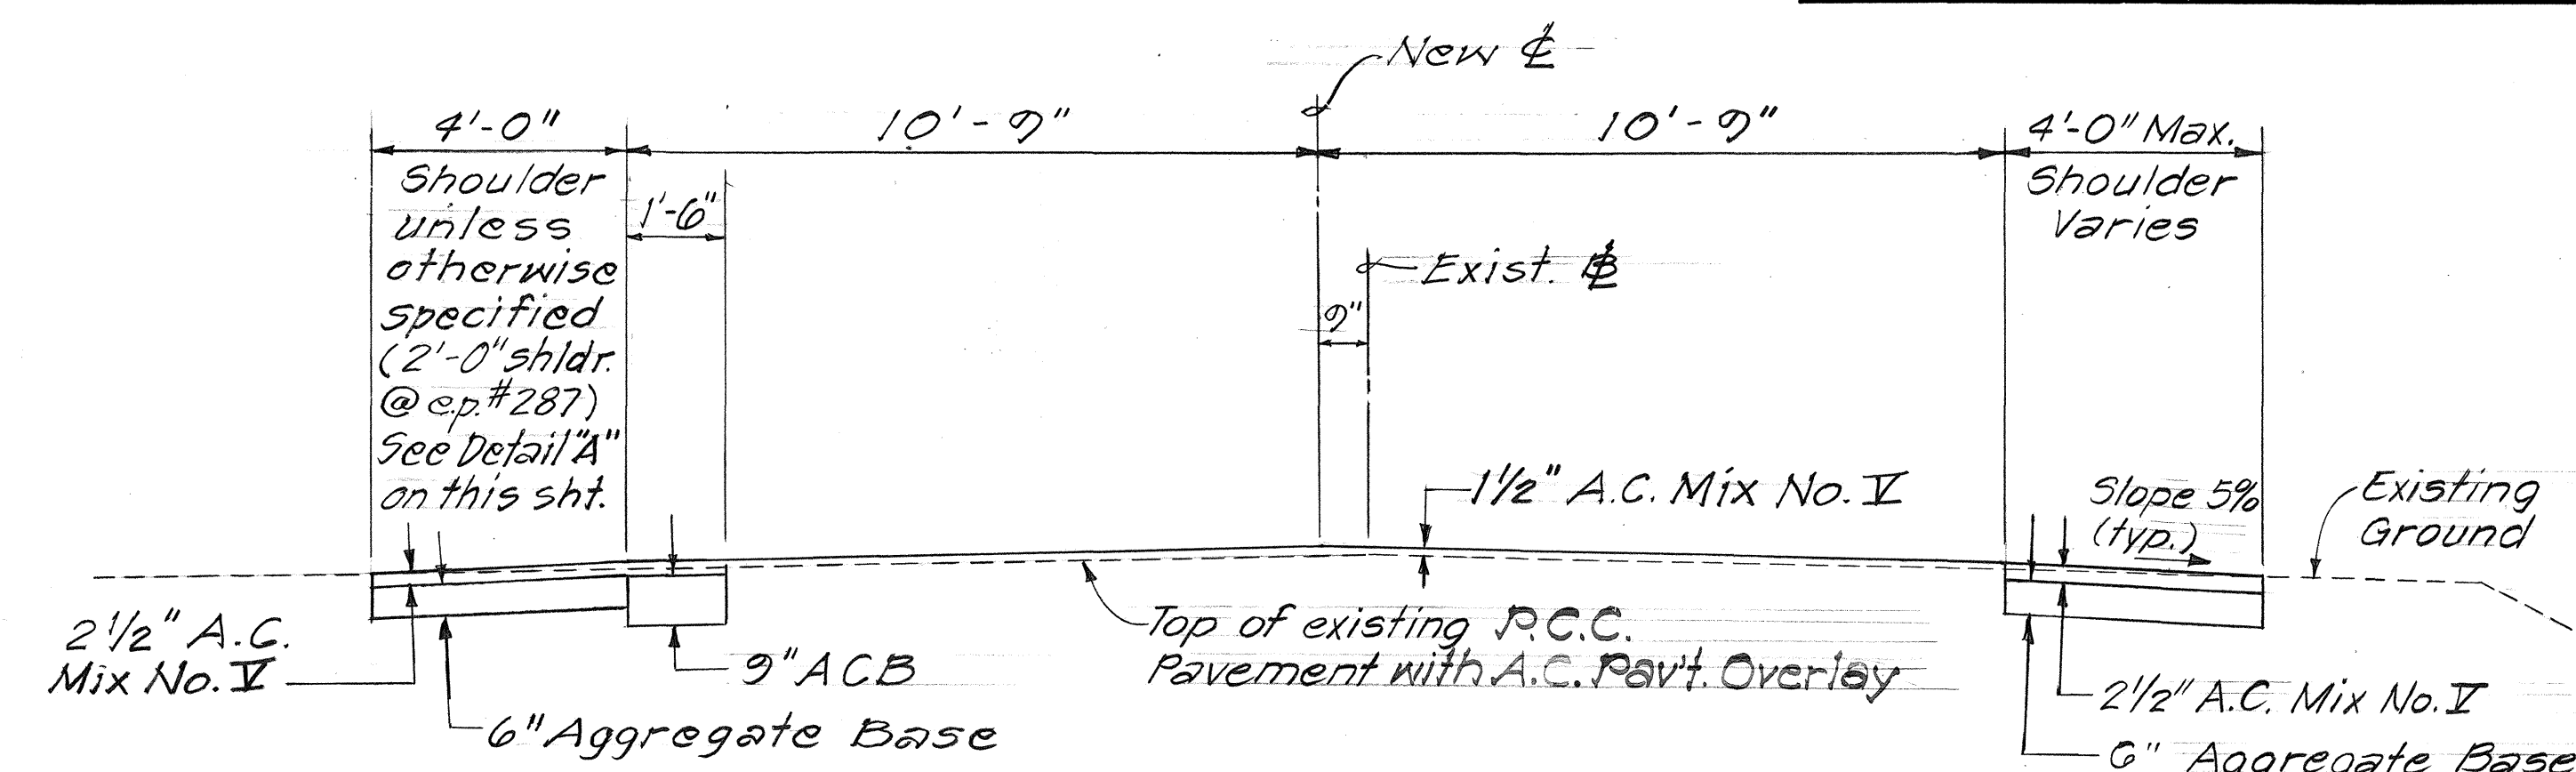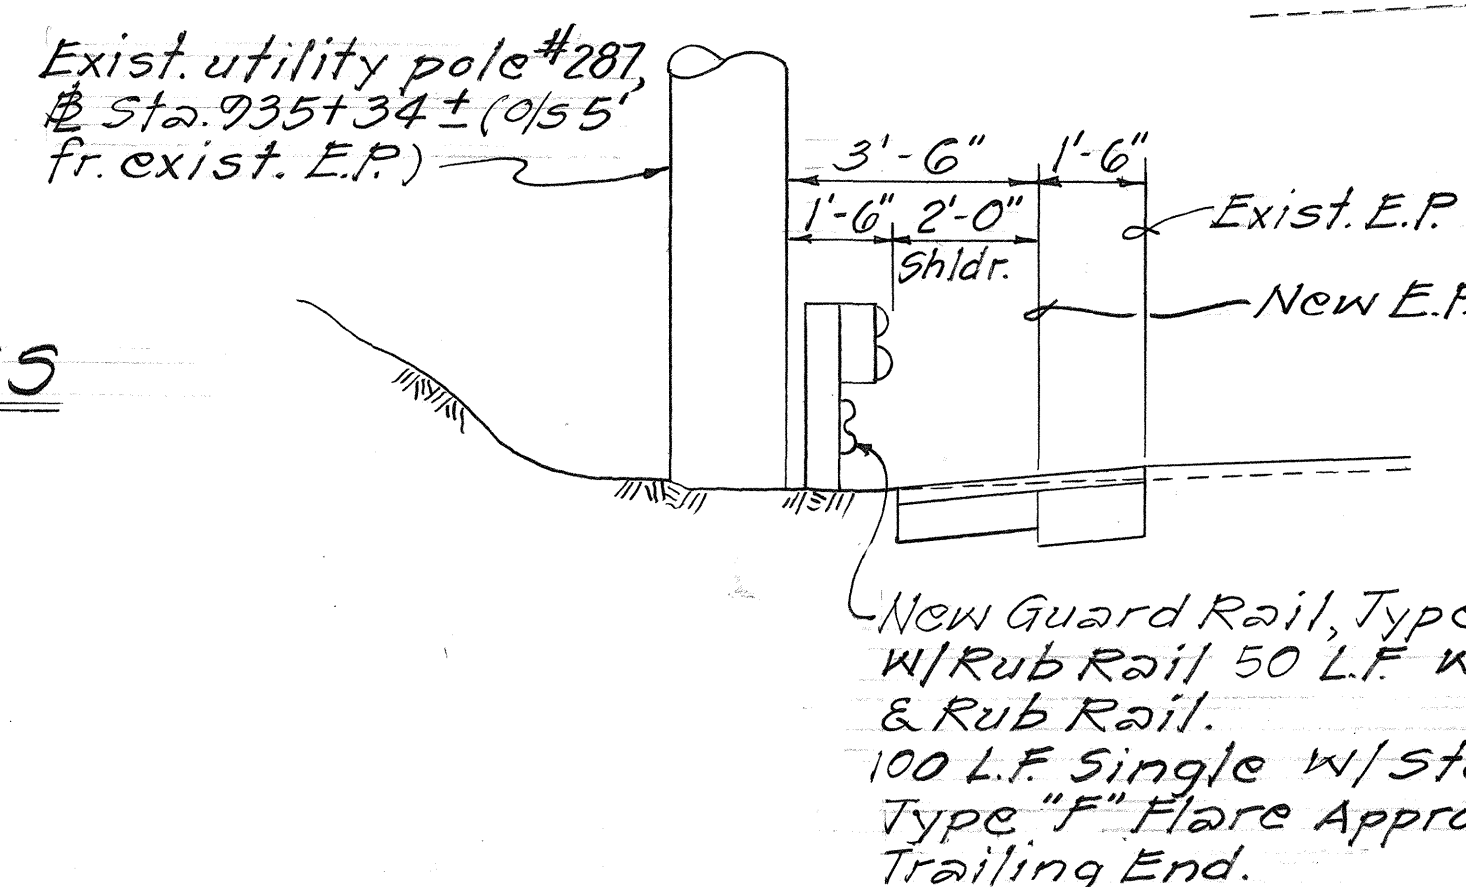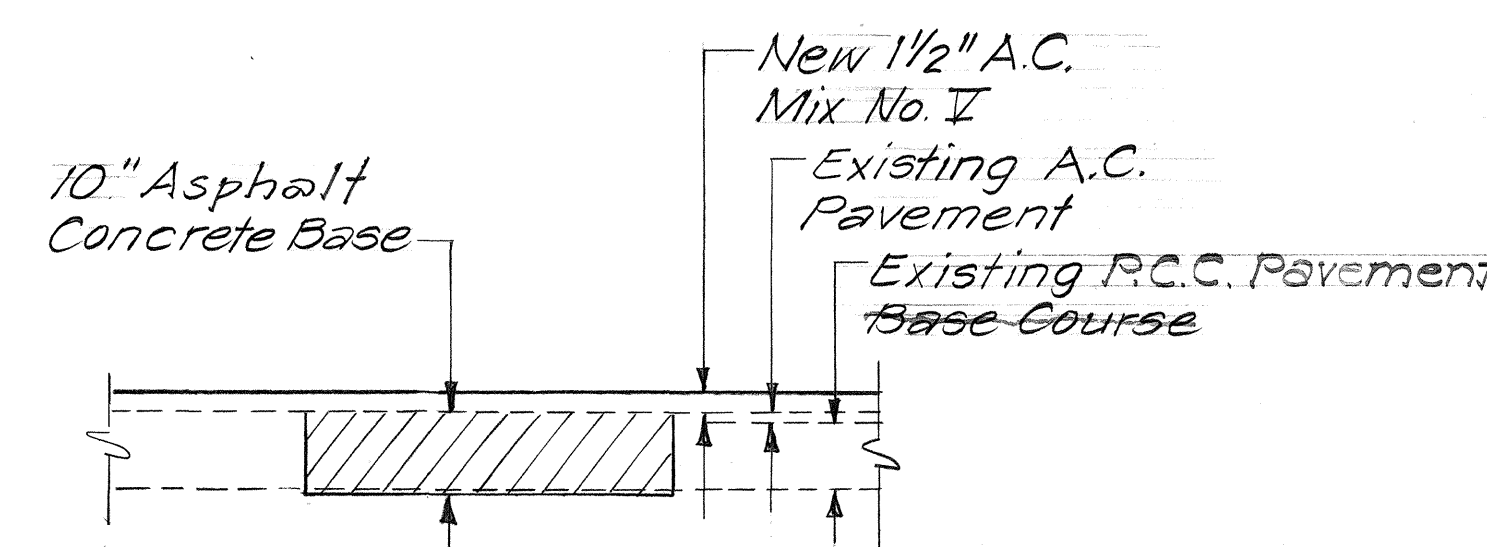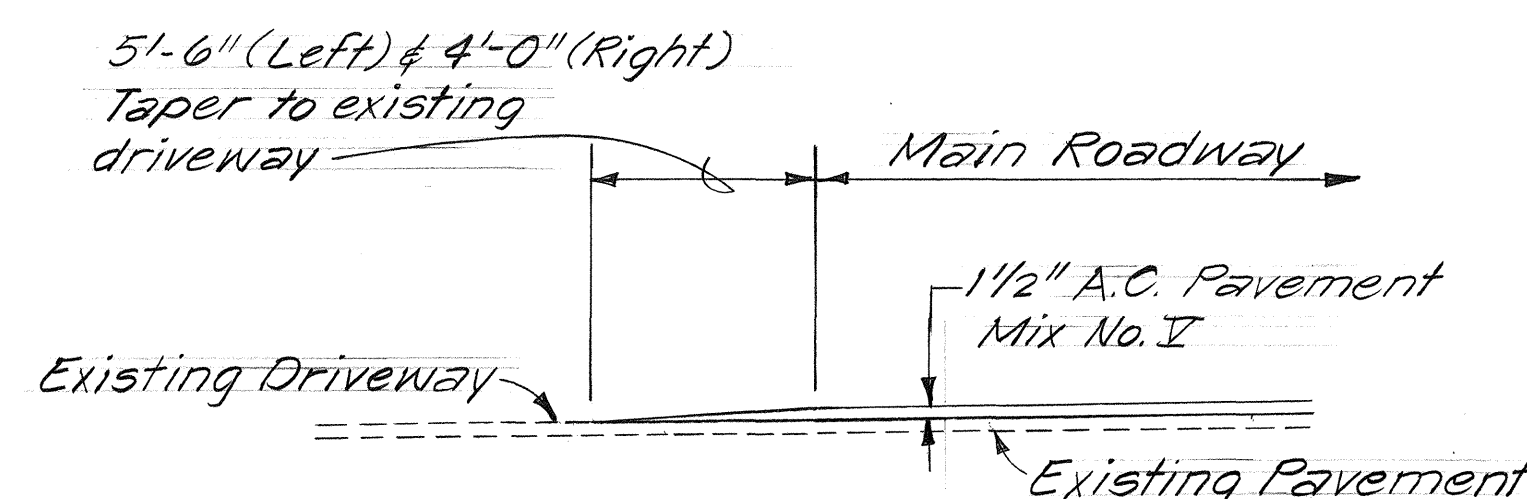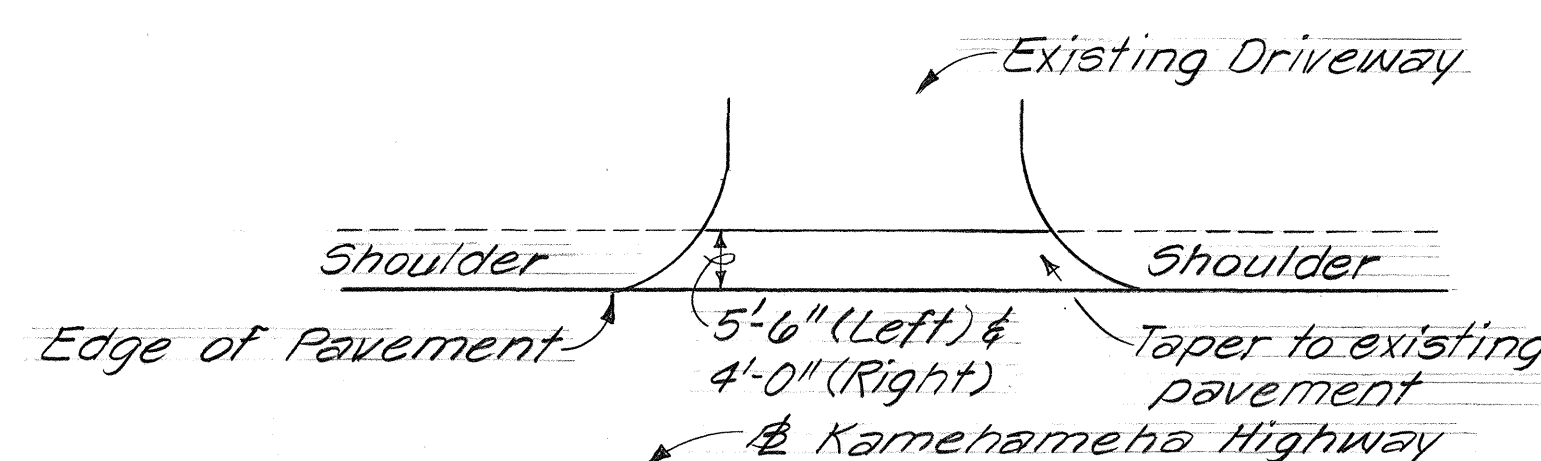

NOTE

A. Dress shoulder by clearing and grubbing and backfilling with suitable excavated material as directed by the Engineer. Backfill material shall be compacted to conform to existing ground.

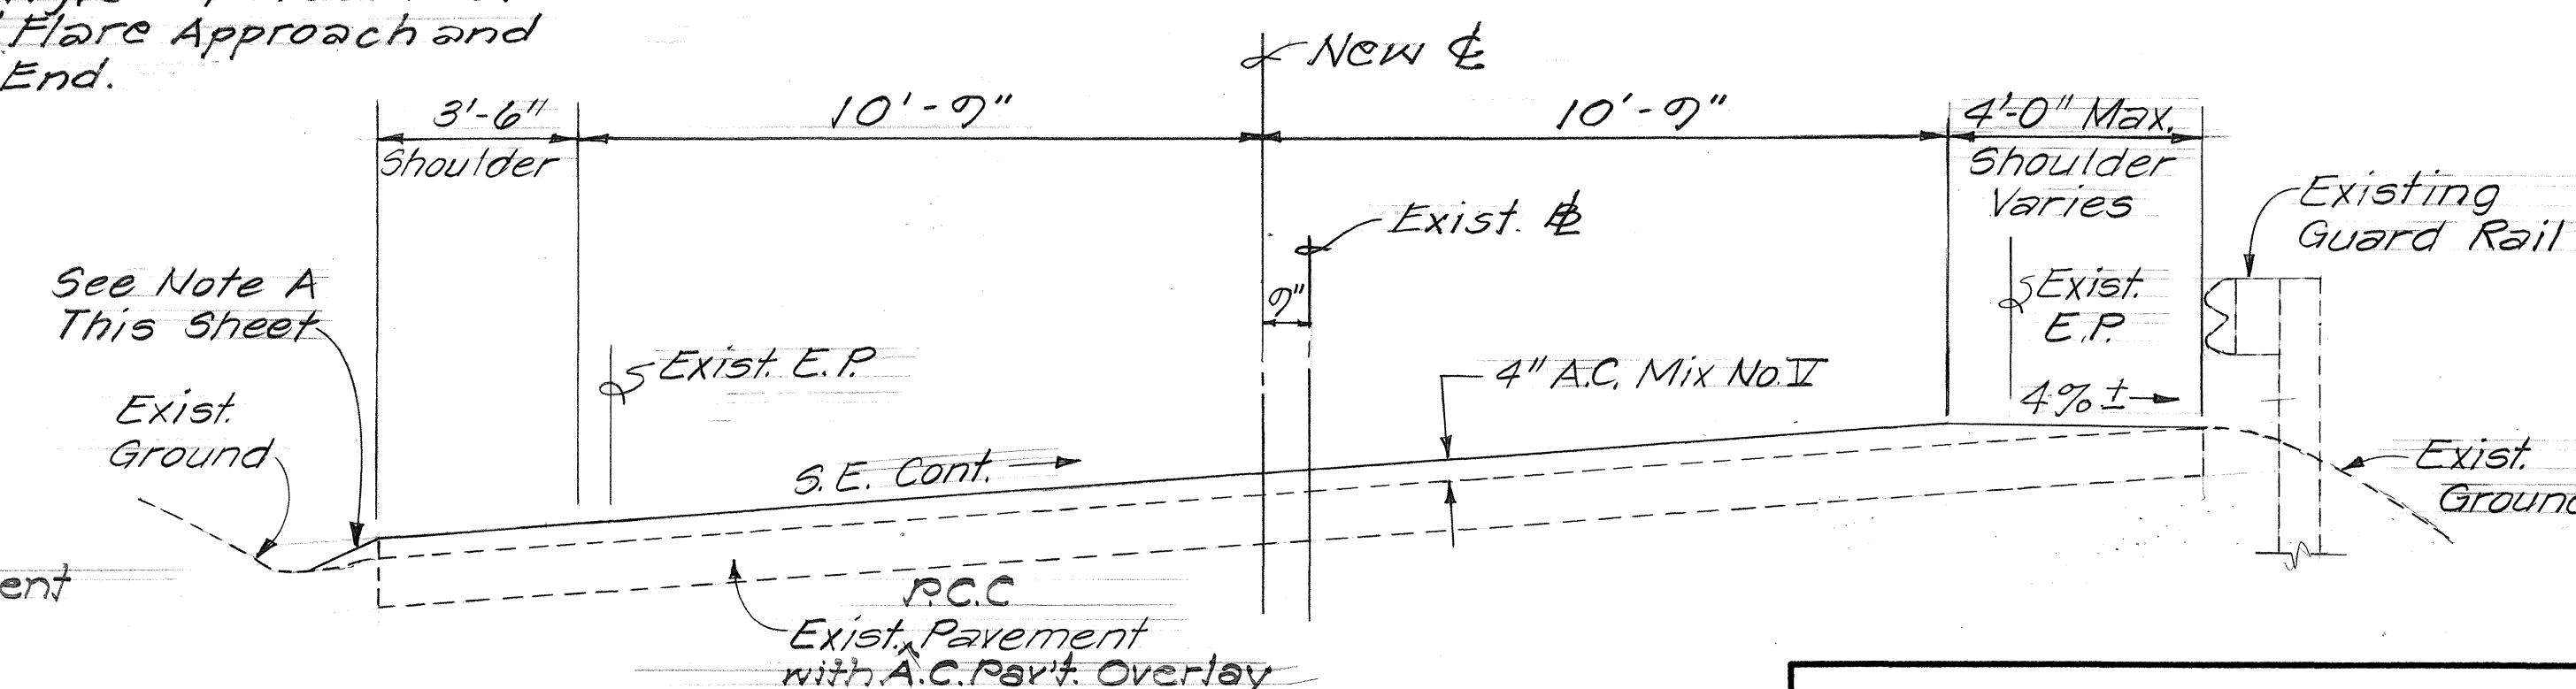

STATE OF HAWAII
DEPARTMENT OF TRANSPORTATION
LAND TRANSPORTATION FACILITIES DIVISION
TYPICAL SECTIONS & DETAILS
KAMEHAMEHA HWY RESURFACING
VICINITY OF LAU PLACE
TO KAHANA BAY
F.A. PROJECT No. FR-083-1(17)
Scale: As shown
SHEET NO. 1 OF 1 SHEETS