	INDEX TO DRAWINGS
SHEET NO.	DESCRIPTION
<u>I</u>	TITLE SHEET
2	TYPICAL SECTION NOTES AND MISC. DETAILS
	ROADWAY PLANS
	<
-	
-	
*.	
	· · · · · · · · · · · · · · · · · · ·



STATE OF HAWAII

DEPARTMENT OF TRANSPORTATION


HIGHWAYS DIVISION
"AS-BUILT"
PLANS FOR


KAMEHAMEHA HIGHWAY RESURFACING

KAALAEA ROAD TO WAIAHOLE VALLEY ROAD

FEDERAL AID PROJECT NO. F-083-1(22)

DISTRICT OF KOOLAUPOKO
ISLAND OF OAHU

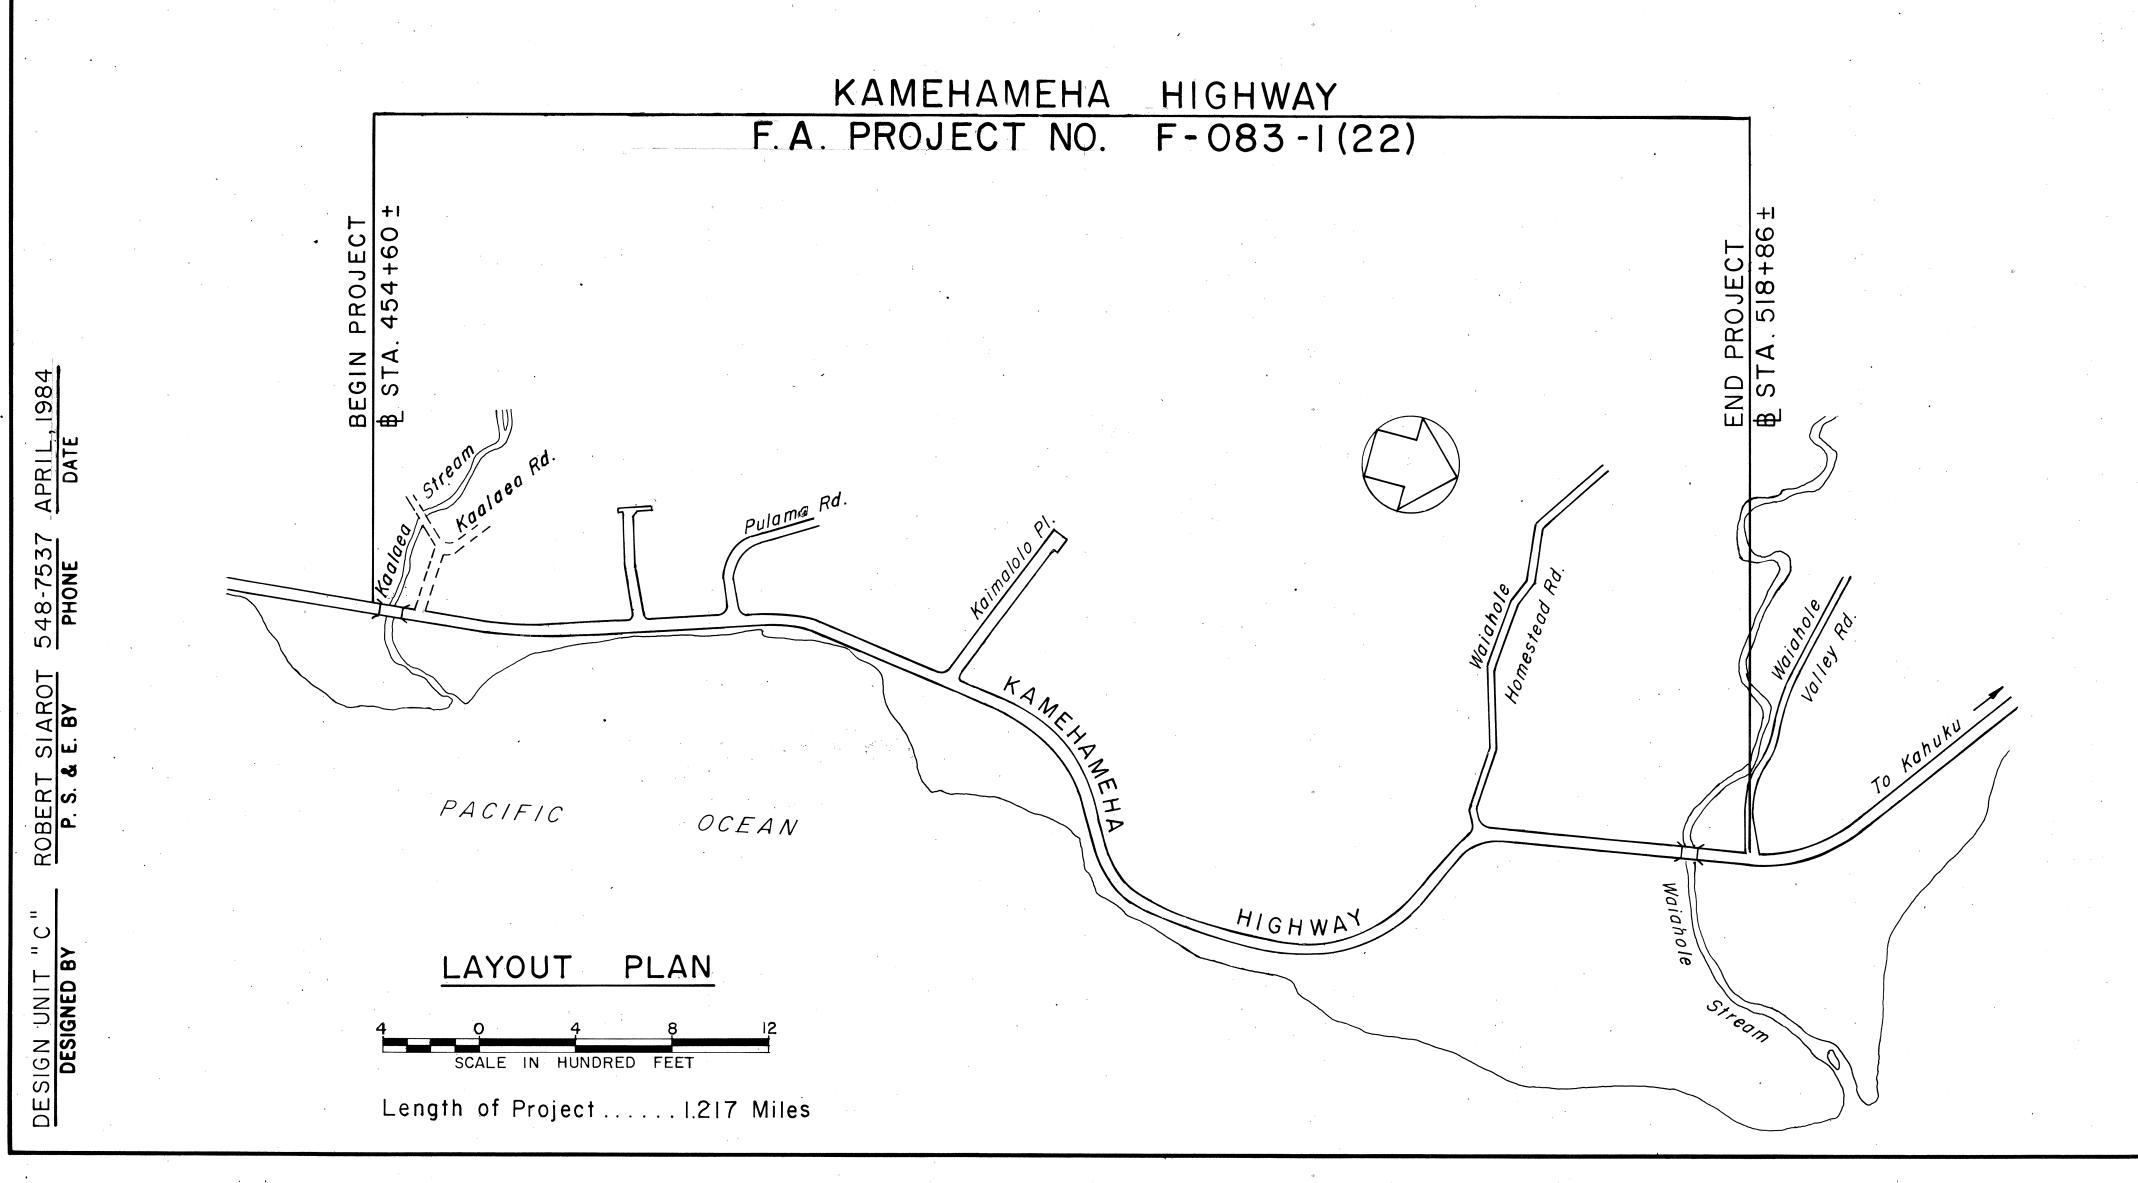

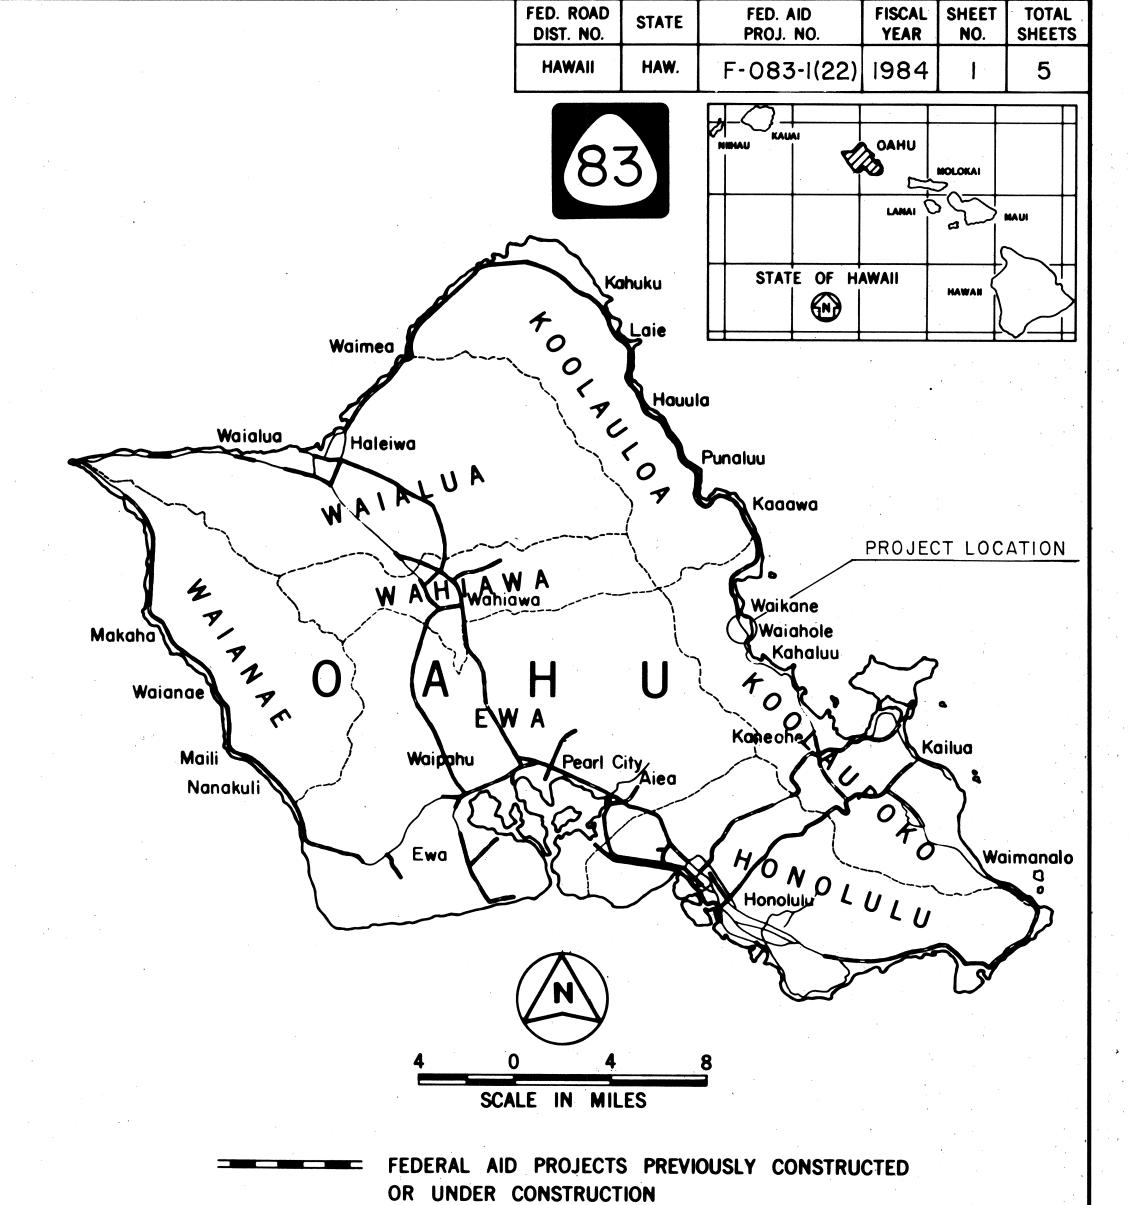

NO SIGNIFICANT CHANGES WERE MADE DURING CONSTRUCTION ON THESE PLANS EXCEPT CHANGES IN THE ORIGINAL THEORETICAL QUANTITIES. FOR ACTUAL QUANTITIES, REFER TO PROJECT LEDGER AND/OR COMPUTATION BOOK.

Deur T. High RESIDENT ENGINEER

11/25/88 DATE

	DEPARTMENT OF TRANSPORFEDERAL HIGHWAY ADMINIST	
	APPROVED:	
	Lauhn DIVISION ADMINISTRATOR	4/9/84
~	DIVISION ADMINISTRATOR	DATE

DEPARTMENT OF TRANSPORTATION STATE OF HAWAII		
APPROVED:		
Chuy D. Dom	4/2/84	
DIR. OF TRANSPORTATION	DATE	