


FED. ROAD DIST. NO.	STATE	FED. AID PROJ. NO.	FISCAL YEAR	SHEET NO.	TOTAL SHEETS
HAWAII	HAW.	F-083-1(22)	1984	2	5


GENERAL NOTES :

1. The project consists of improving a portion of Kamehameha Highway from Kaalaea Road to Waiahole Valley Road. Improvements consist of reconstructing weakened pavement areas and resurfacing existing pavement areas.
2. The Contractor shall keep all lanes open to public traffic and shall not perform any operations within the roadway during the following peak hours : 5:30 A.M. to 8:30 A.M. and 3:30 P.M. to 6:30 P.M. During working hours, the Contractor shall be allowed to close only one traffic lane. The above peak hours may be altered at the discretion of the Engineer.
3. The locations for the reconstruction of weakened areas are shown on the plans. However the exact limits shall be determined in the field by the Engineer.

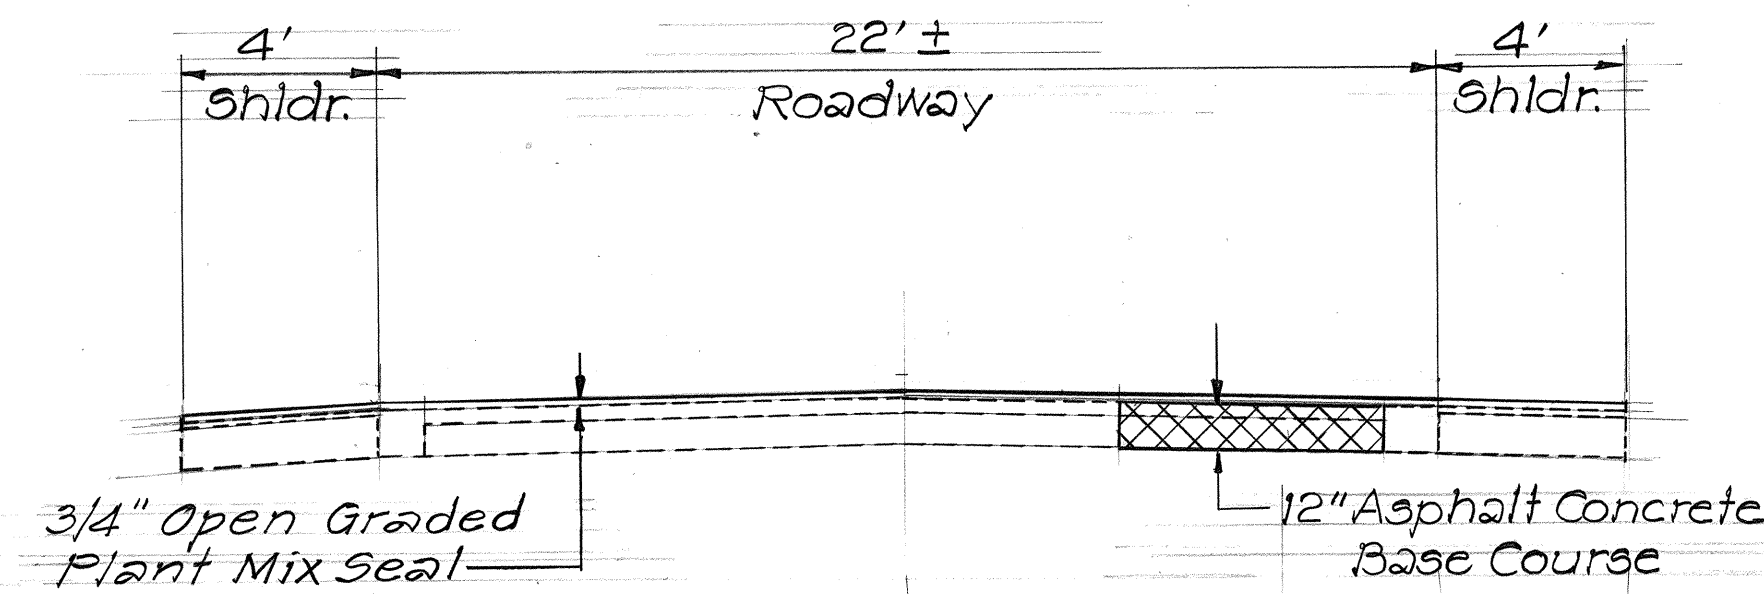


TYPICAL SECTION

N. T. S.

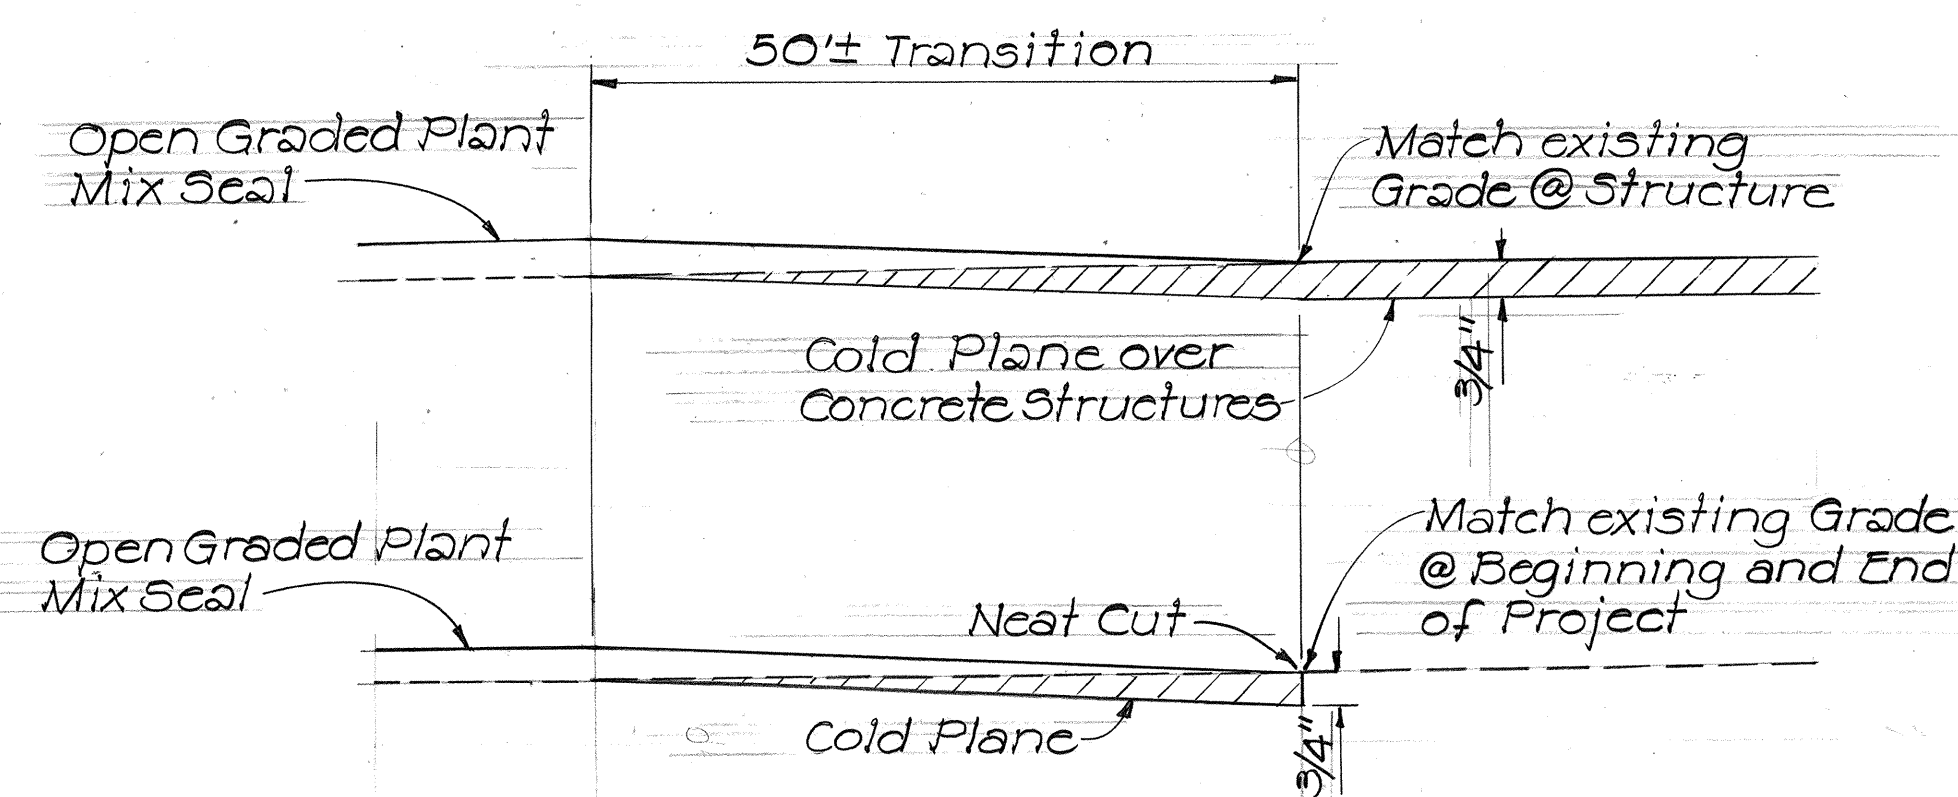

COLD PLANE TRANSITIONS

N. T. S.

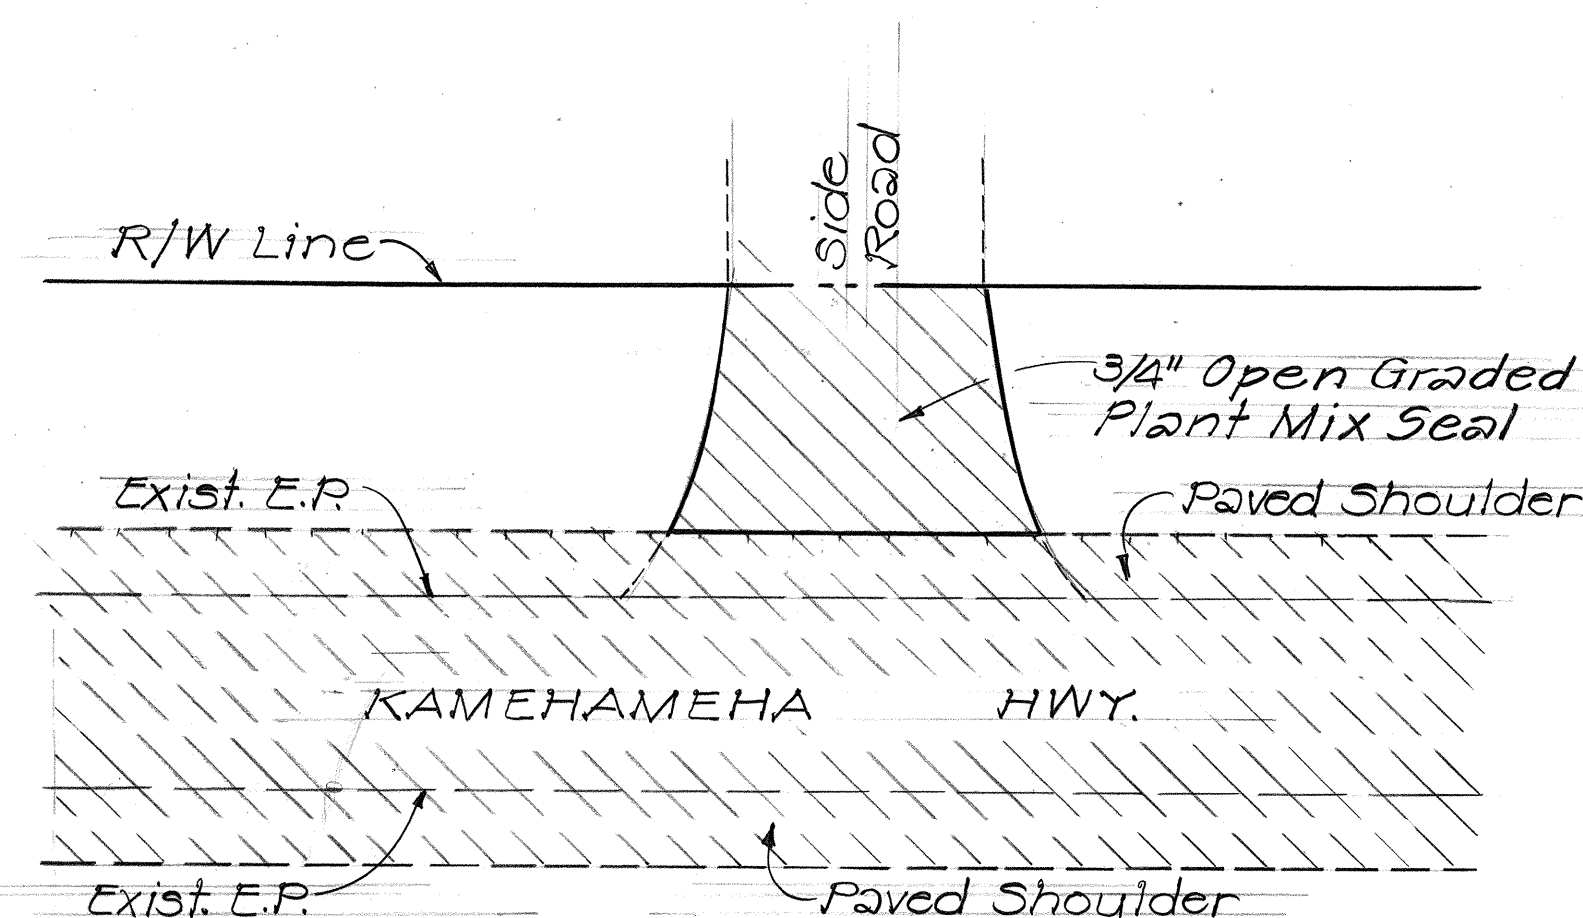

RESURFACING AT SIDEROADS

N. T. S.

STATE OF HAWAII
DEPARTMENT OF TRANSPORTATION
HIGHWAYS DIVISION
TYPICAL SECTION, MISC.
DETAILS, NOTES
KAMEHAMEHA HWY. RESURFACING
KAALAEA RD. TO WAIHOLE VALLEY RD.
F.A. PROJ. NO. F-083-1(22)

Scale: As Shown Date: Feb. 1984

SHEET No. 1 OF 1 SHEETS

ORIGINAL PLAN	DATE
SURVEY PLOTTED BY	
DRAWN BY	
DESIGNED BY	
QUANTITIES BY	
CHECKED BY	
NOTE BOOK	
No.	